


TRAFFIC CONTROL LEGEND

- WORK AREA
- TEMPORARY TRAFFIC BARRIER
- TYPE III BARRICADES
- REFLECTORIZED PLASTIC DRUM
- TYPE 1 DELINEATOR (YELLOW)
- TYPE 1 DELINEATOR (WHITE)
- FLOW OF TRAFFIC
- FLAGGER
- SIGN
- PORTABLE CHANGEABLE MESSAGE SIGN

NOTE:
1. SEE TRAFFIC CONTROL GENERAL NOTES SHEET FOR ADDITIONAL INFORMATION AND REQUIREMENTS.

POTENTIAL ACTIVITIES ASSOCIATED WITH TRAFFIC CONTROL, PHASE 1

1. PRIOR TO THE COMMENCEMENT OF ANY WORK OR THE PLACEMENT OF EQUIPMENT ON THE ROADWAY THE CONTRACTOR SHALL PROVIDE ADVANCED WARNING SIGNS IN ACCORDANCE WITH THE CONSTRUCTION APPROACH SIGNING SHEET AND THE LATEST EDITION OF THE MANUAL ON UNIFORM TRAFFIC CONTROL DEVICES (MUTCD).
2. INSTALL AND MAINTAIN ANY EROSION CONTROL MEASURES IN ACCORDANCE WITH THE EROSION CONTROL PLANS AND DETAILS. IN ADDITION TO THE VERMONT D.E.C.'S "LOW RISK SITE HANDBOOK FOR EROSION PREVENTION AND SEDIMENT CONTROL."
3. INSTALL ALL WARNING SIGNAGE, REFLECTORIZED DRUMS, TRAFFIC BARRIER, AND ANY OTHER TRAFFIC CONTROL DEVICES PER ACCEPTED TRAFFIC CONTROL PLANS OR AS DIRECTED BY THE RESIDENT ENGINEER.
4. INSTALL ANY STORMWATER TREATMENT PRACTICES AND DRAINAGE ELEMENTS AS SHOWN ON THEIR APPLICABLE PLANS.
5. CONSTRUCT PROPOSED LEFT TURN LANE EXTENSION AND NEW LEFT TURN LANE. REMOVE EXISTING CURBING AND ISLAND. INSTALL NEW CURBING. FINISH ISLAND SURFACE.
6. PLACE LEVELING COURSE OF PAVEMENT AND INSTALL TEMPORARY PAVEMENT MARKINGS AND SIGNING AS REQUIRED.

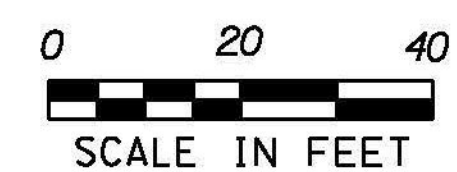

PROJECT NAME:	BERLIN	PLOT DATE:	10/28/2014
PROJECT NUMBER:	STPG SGNL (40)	DRAWN BY:	I. DEGUTIS
FILE NAME:	+lib358+cp.dgn	CHECKED BY:	M. LACROIX
PROJECT LEADER:	P. COBURN	TRAFFIC CONTROL PLAN - PHASE 1 PLAN 2	SHEET 105 OF 123
DESIGNED BY:	M. LACROIX		