

TRAFFIC CONTROL LEGEND

- WORK AREA
- TEMPORARY TRAFFIC BARRIER
- TYPE III BARRICADES
- REFLECTORIZED PLASTIC DRUM
- TYPE 1 DELINEATOR (YELLOW)
- TYPE 1 DELINEATOR (WHITE)
- FLOW OF TRAFFIC
- FLAGGER
- SIGN
- PORTABLE CHANGEABLE MESSAGE SIGN

TEMPORARY 4 INCH WHITE LINE

- STA. 65+92.66, LT - STA. 70+50.00, LT (SOLID) (452')
- STA. 65+92.66, LT - STA. 70+50.00, LT (DASHED) (454')
- STA. 67+00.00, RT - STA. 69+25.63, RT (DOTTED) (227')
- STA. 69+25.63, RT - STA. 70+50.00, RT (SOLID) (125')
- STA. 65+92.62 LT - STA. 70+50.00 LT (DASHED) (463')
- STA. 67+00.00, RT - STA. 69+25.63, RT (DOTTED) (229')
- STA. 69+25.63, RT - STA. 70+50.00, RT (SOLID) (125')
- STA. 65+92.66, LT - STA. 70+50.00, LT (SOLID) (463')

TEMPORARY 4 INCH YELLOW LINE


- STA. 65+92.66, LT - STA. 70+50.00, LT (SOLID) (456')
- STA. 65+92.66, RT - STA. 70+50.00, LT (SOLID) (460')

TEMPORARY LETTER OR SYMBOL

- STA. 69+92.99 RT ("S")
- STA. 69+92.99 RT ("S")
- STA. 69+92.99 RT ("S")
- STA. 69+92.99 RT ("S")

**BEGIN PROJECT
BERLIN STPG SGNL (40)
STA. 65+92.66**

VT ROUTE 62
TO BERLIN CORNERS

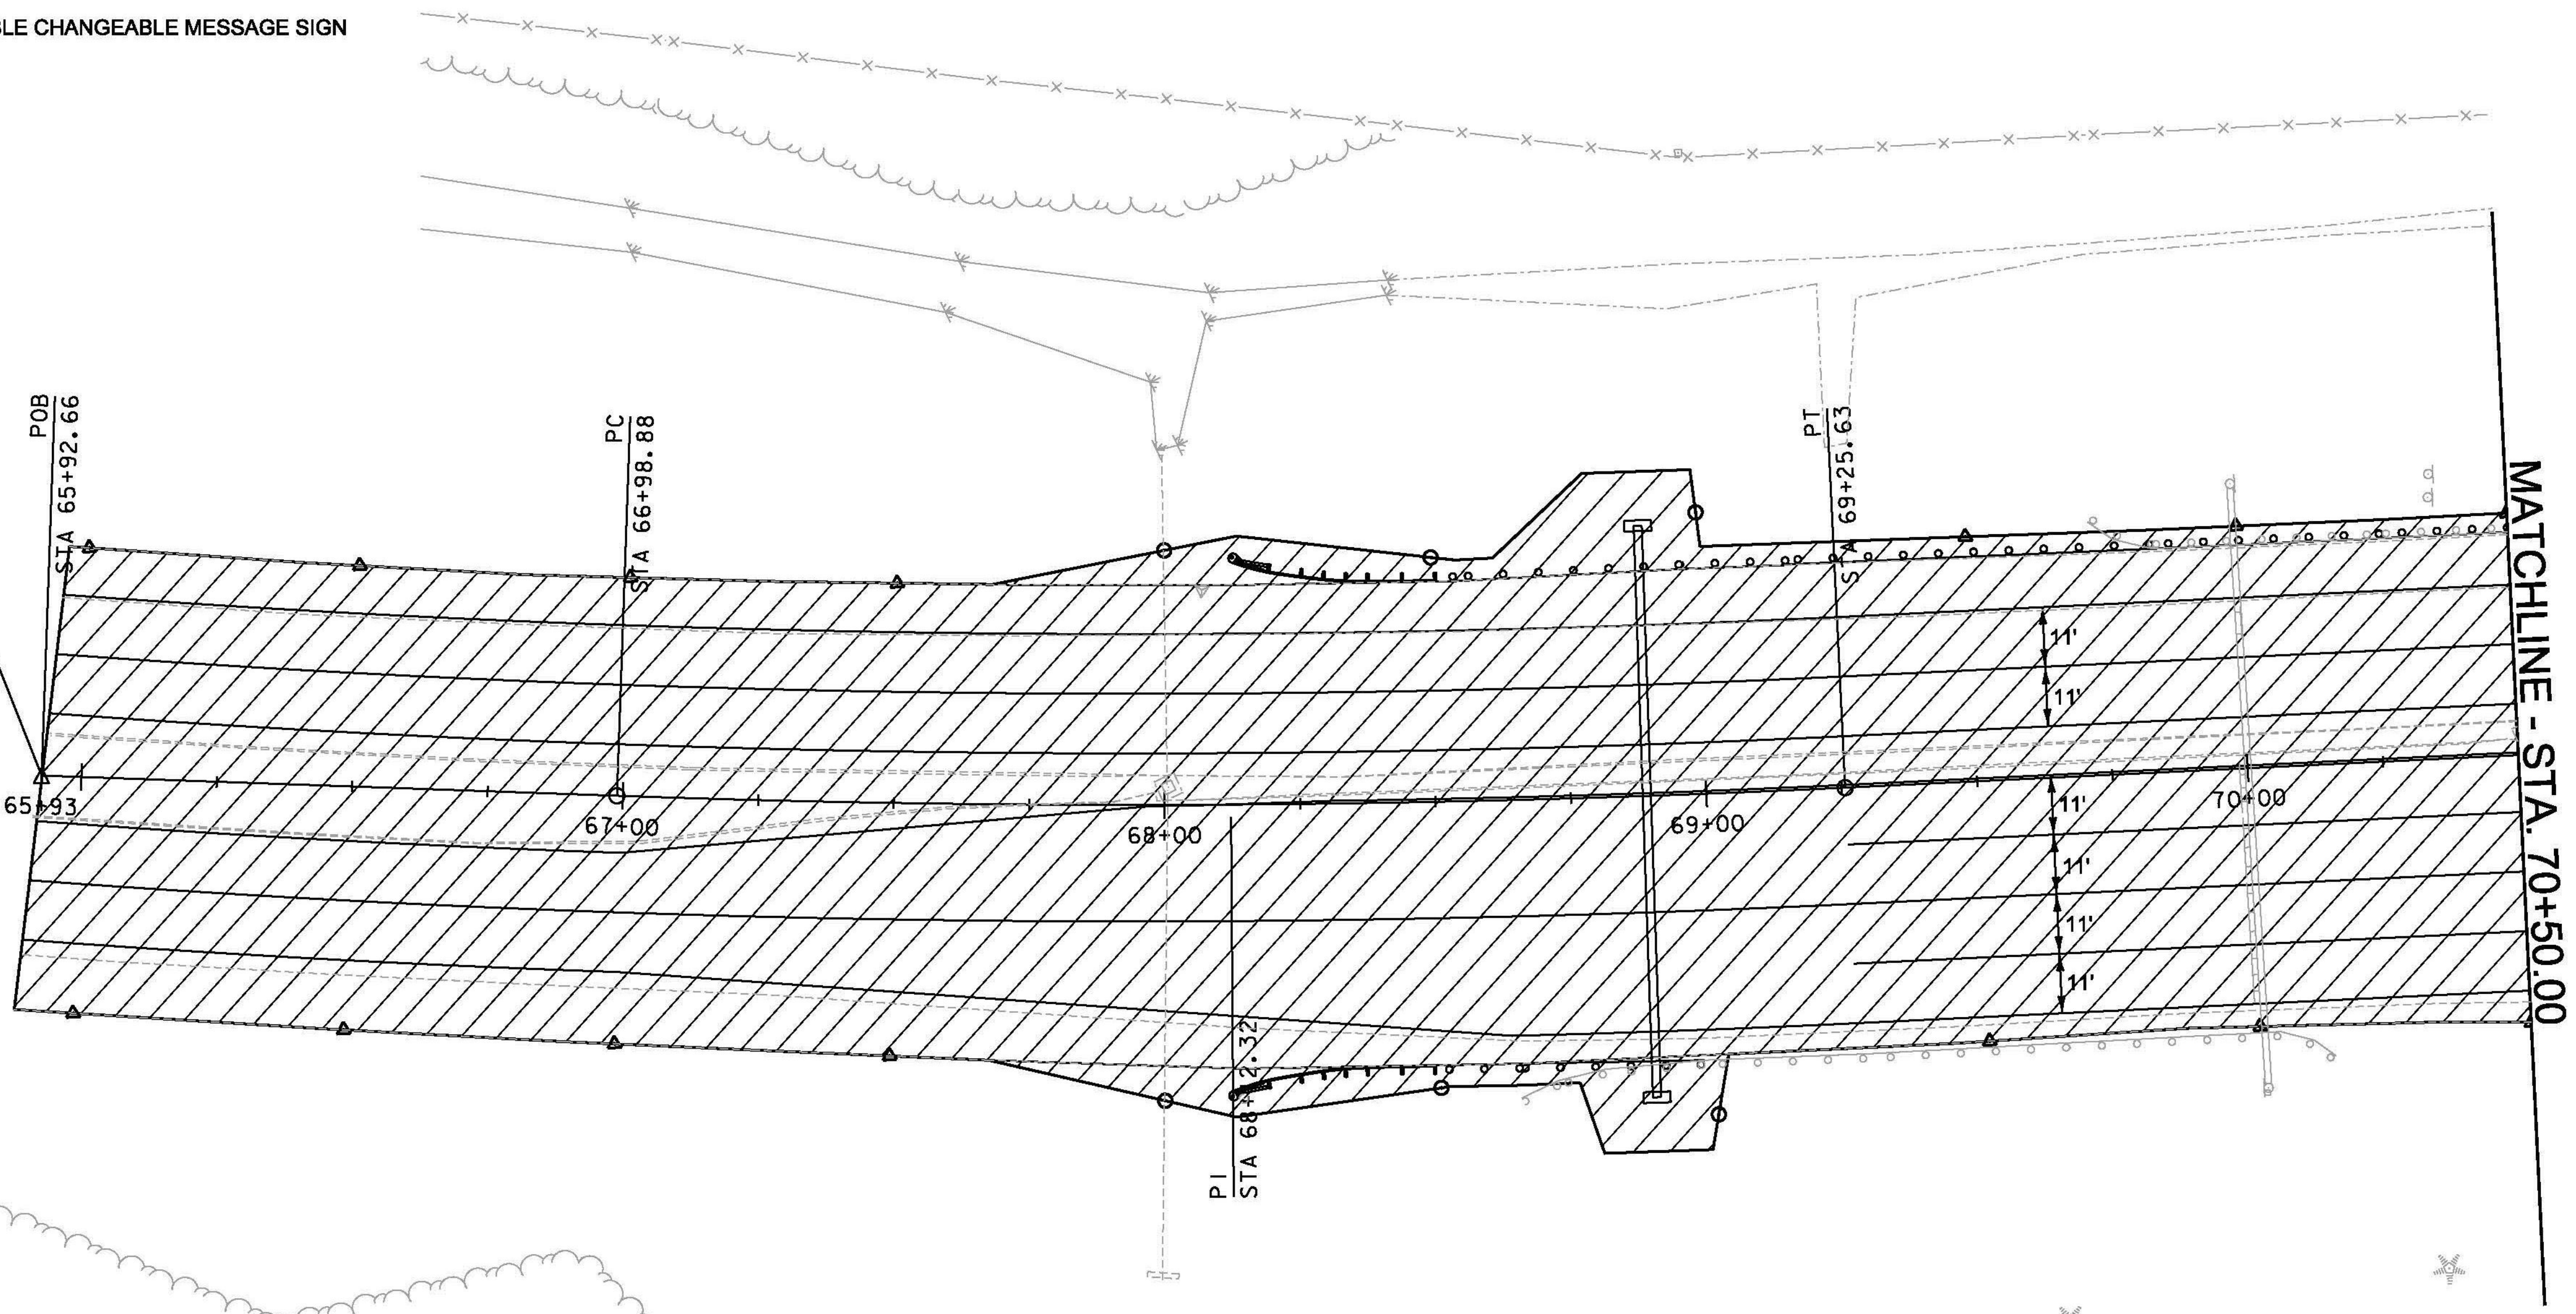


POTENTIAL ACTIVITIES ASSOCIATED WITH TRAFFIC CONTROL, PHASE 2

1. PRIOR TO THE COMMENCEMENT OF ANY WORK OR THE PLACEMENT OF EQUIPMENT ON THE ROADWAY THE CONTRACTOR SHALL PROVIDE ADVANCED WARNING SIGNS IN ACCORDANCE WITH THE CONSTRUCTION APPROACH SIGNING SHEET AND THE LATEST EDITION OF THE MANUAL ON UNIFORM TRAFFIC CONTROL DEVICES (MUTCD).
2. INSTALL AND MAINTAIN ANY EROSION CONTROL MEASURES IN ACCORDANCE WITH THE EROSION CONTROL PLANS AND DETAILS IN ADDITION TO THE VERMONT D.E.C.'S "LOW RISK SITE HANDBOOK FOR EROSION PREVENTION AND SEDIMENT CONTROL."
3. INSTALL ALL WARNING SIGNAGE, REFLECTORIZED DRUMS, TRAFFIC BARRIER, AND ANY OTHER TRAFFIC CONTROL DEVICES PER ACCEPTED TRAFFIC CONTROL PLANS OR AS DIRECTED BY THE RESIDENT ENGINEER.
4. INSTALL ANY STORMWATER TREATMENT PRACTICES AND DRAINAGE ELEMENTS AS SHOWN ON THEIR APPLICABLE PLANS.
5. COLD PLANE AND OVERLAY AS SHOWN ON THE PLANS. CONSTRUCT TRAFFIC SIGNAL AND SIGN BRIDGE AS SHOWN ON THE APPLICABLE PLANS.
6. PLACE LEVELING COURSE OF PAVEMENT AND INSTALL TEMPORARY PAVEMENT MARKINGS AND SIGNING.

NOTE:

1. SEE TRAFFIC CONTROL GENERAL NOTES SHEET FOR ADDITIONAL INFORMATION AND REQUIREMENTS.

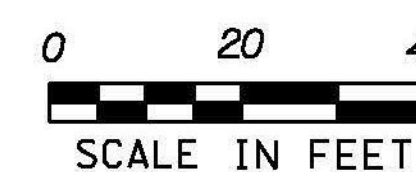

PROJECT NAME: BERLIN
PROJECT NUMBER: STPG SGNL (40)

FILE NAME: +lib358+cp.dgn PLOT DATE: 10/28/2014
PROJECT LEADER: P. COBURN DRAWN BY: I. DEGUTIS
DESIGNED BY: M. LACROIX CHECKED BY: M. LACROIX
TRAFFIC CONTROL PLAN - PHASE 2 PLAN 1 SHEET 106 OF 123