

TEMPORARY 4 INCH WHITE LINE

A9 - STA. 70+50.00, LT - STA. 31+75.00, LT (SOLID) (368')
A10 - STA. 70+50.00, LT - STA. 72+14.01, LT (DASHED) (165')
A11 - STA. 70+50.00, RT - STA. 72+13.99, RT (SOLID) (164')
A12 - STA. 70+50.00, RT - STA. 72+13.99, RT (DASHED) (164')
A13 - STA. 70+50.00, RT - STA. 71+22.70, RT (SOLID) (73')
A14 - STA. 70+50.00, RT - STA. 28+00.00, LT (SOLID) (213')
A15 - STA. 28+00.00, LT - STA. 28+24.43, LT (SOLID) (25')
A16 - STA. 28+24.43, LT - STA. 29+14.43, LT (DOTTED) (90')
A17 - STA. 28+00.00, RT - STA. 28+24.43, RT (DOTTED) (25')
A18 - STA. 28+24.43, RT - STA. 29+14.43, RT (SOLID) (90')
A19 - STA. 28+00.00, RT - STA. 29+14.43, RT (SOLID) (115')
A20 - STA. 28+00.00, RT - STA. 76+00.00, RT (SOLID) (461')
A21 - STA. 73+68.99, RT - STA. 75+49.80, RT (DASHED) (181')
A22 - STA. 75+49.80, RT - STA. 76+00.00, RT (SOLID) (51')
A23 - STA. 73+68.99, RT - STA. 76+00.00, RT (DASHED) (181')
A24 - STA. 73+68.99, LT - STA. 76+00.00, LT (SOLID) (231')
A26 - STA. 32+14.55, RT - STA. 76+00.00, LT (SOLID) (264')
A27 - STA. 31+59.22, RT - STA. 31+75.00, RT (DASHED) (17')
A28 - STA. 30+84.39, LT - STA. 31+75.00, LT (SOLID) (91')

TEMPORARY 4 INCH YELLOW LINE

B3 - STA. 70+50.00, LT - STA. 72+14.01, LT (SOLID) (165')
B4 - STA. 70+50.00, RT - STA. 72+14.01, RT (SOLID) (164')
B5 - STA. 28+00.00, LT - STA. 29+14.43, LT (DOUBLE) (230')
B6 - STA. 73+68.99, RT - STA. 76+00.00, RT (SOLID) (232')
B7 - STA. 73+68.99, RT - STA. 76+00.00, RT (SOLID) (232')
B8 - STA. 30+75.00, RT - STA. 31+75.00, RT (SOLID) (100')
B9 - STA. 30+84.39, LT - STA. 31+75.00, LT (SOLID) (91')

TEMPORARY 24" STOP BAR

STA. 29+14.43 RT (33')
STA. 30+84.39 LT (22')
STA. 72+13.99 RT (33')
STA. 73+68.99 LT (33')

TEMPORARY 6 INCH WHITE LINE


STA. 71+90.25, RT - STA. 72+43.19, RT (GORE OUTSIDE) (121')
STA. 28+47.19, LT - STA. 29+45.36, LT (GORE OUTSIDE) (99')
STA. 73+26.85, LT - STA. 73+87.59, LT (GORE OUTSIDE) (107')
STA. 30+40.90, RT - STA. 31+59.22, RT (GORE OUTSIDE) (119')

TEMPORARY 6 INCH YELLOW LINE

STA. 71+22.70, RT - STA. 28+47.19, LT (GORE OUTSIDE) (118')
STA. 31+59.22, RT - STA. 74+33.76, LT (GORE OUTSIDE) (126')

TEMPORARY LETTER OR SYMBOL

STA. 70+93.50 RT (S)	STA. 76+08.42 RT (S)
STA. 70+93.50 RT (T)	STA. 28+24.69 RT (T)
STA. 72+05.03 RT (S)	STA. 28+24.69 RT (S)
STA. 72+05.03 RT (T)	STA. 28+24.69 LT (T)
STA. 72+05.03 RT (S)	STA. 28+66.42 RT (S)
STA. 73+77.14 LT (S)	STA. 28+66.42 RT (S)
STA. 73+77.14 LT (T)	STA. 29+04.59 RT (T)
STA. 73+77.14 LT (S)	STA. 29+04.59 RT (S)
STA. 74+43.48 LT (S)	STA. 29+04.59 RT (S)
STA. 75+14.80 RT (S)	STA. 30+95.84 LT (S)
STA. 75+85.05 LT (S)	STA. 30+95.84 LT (S)
STA. 75+85.05 LT (T)	

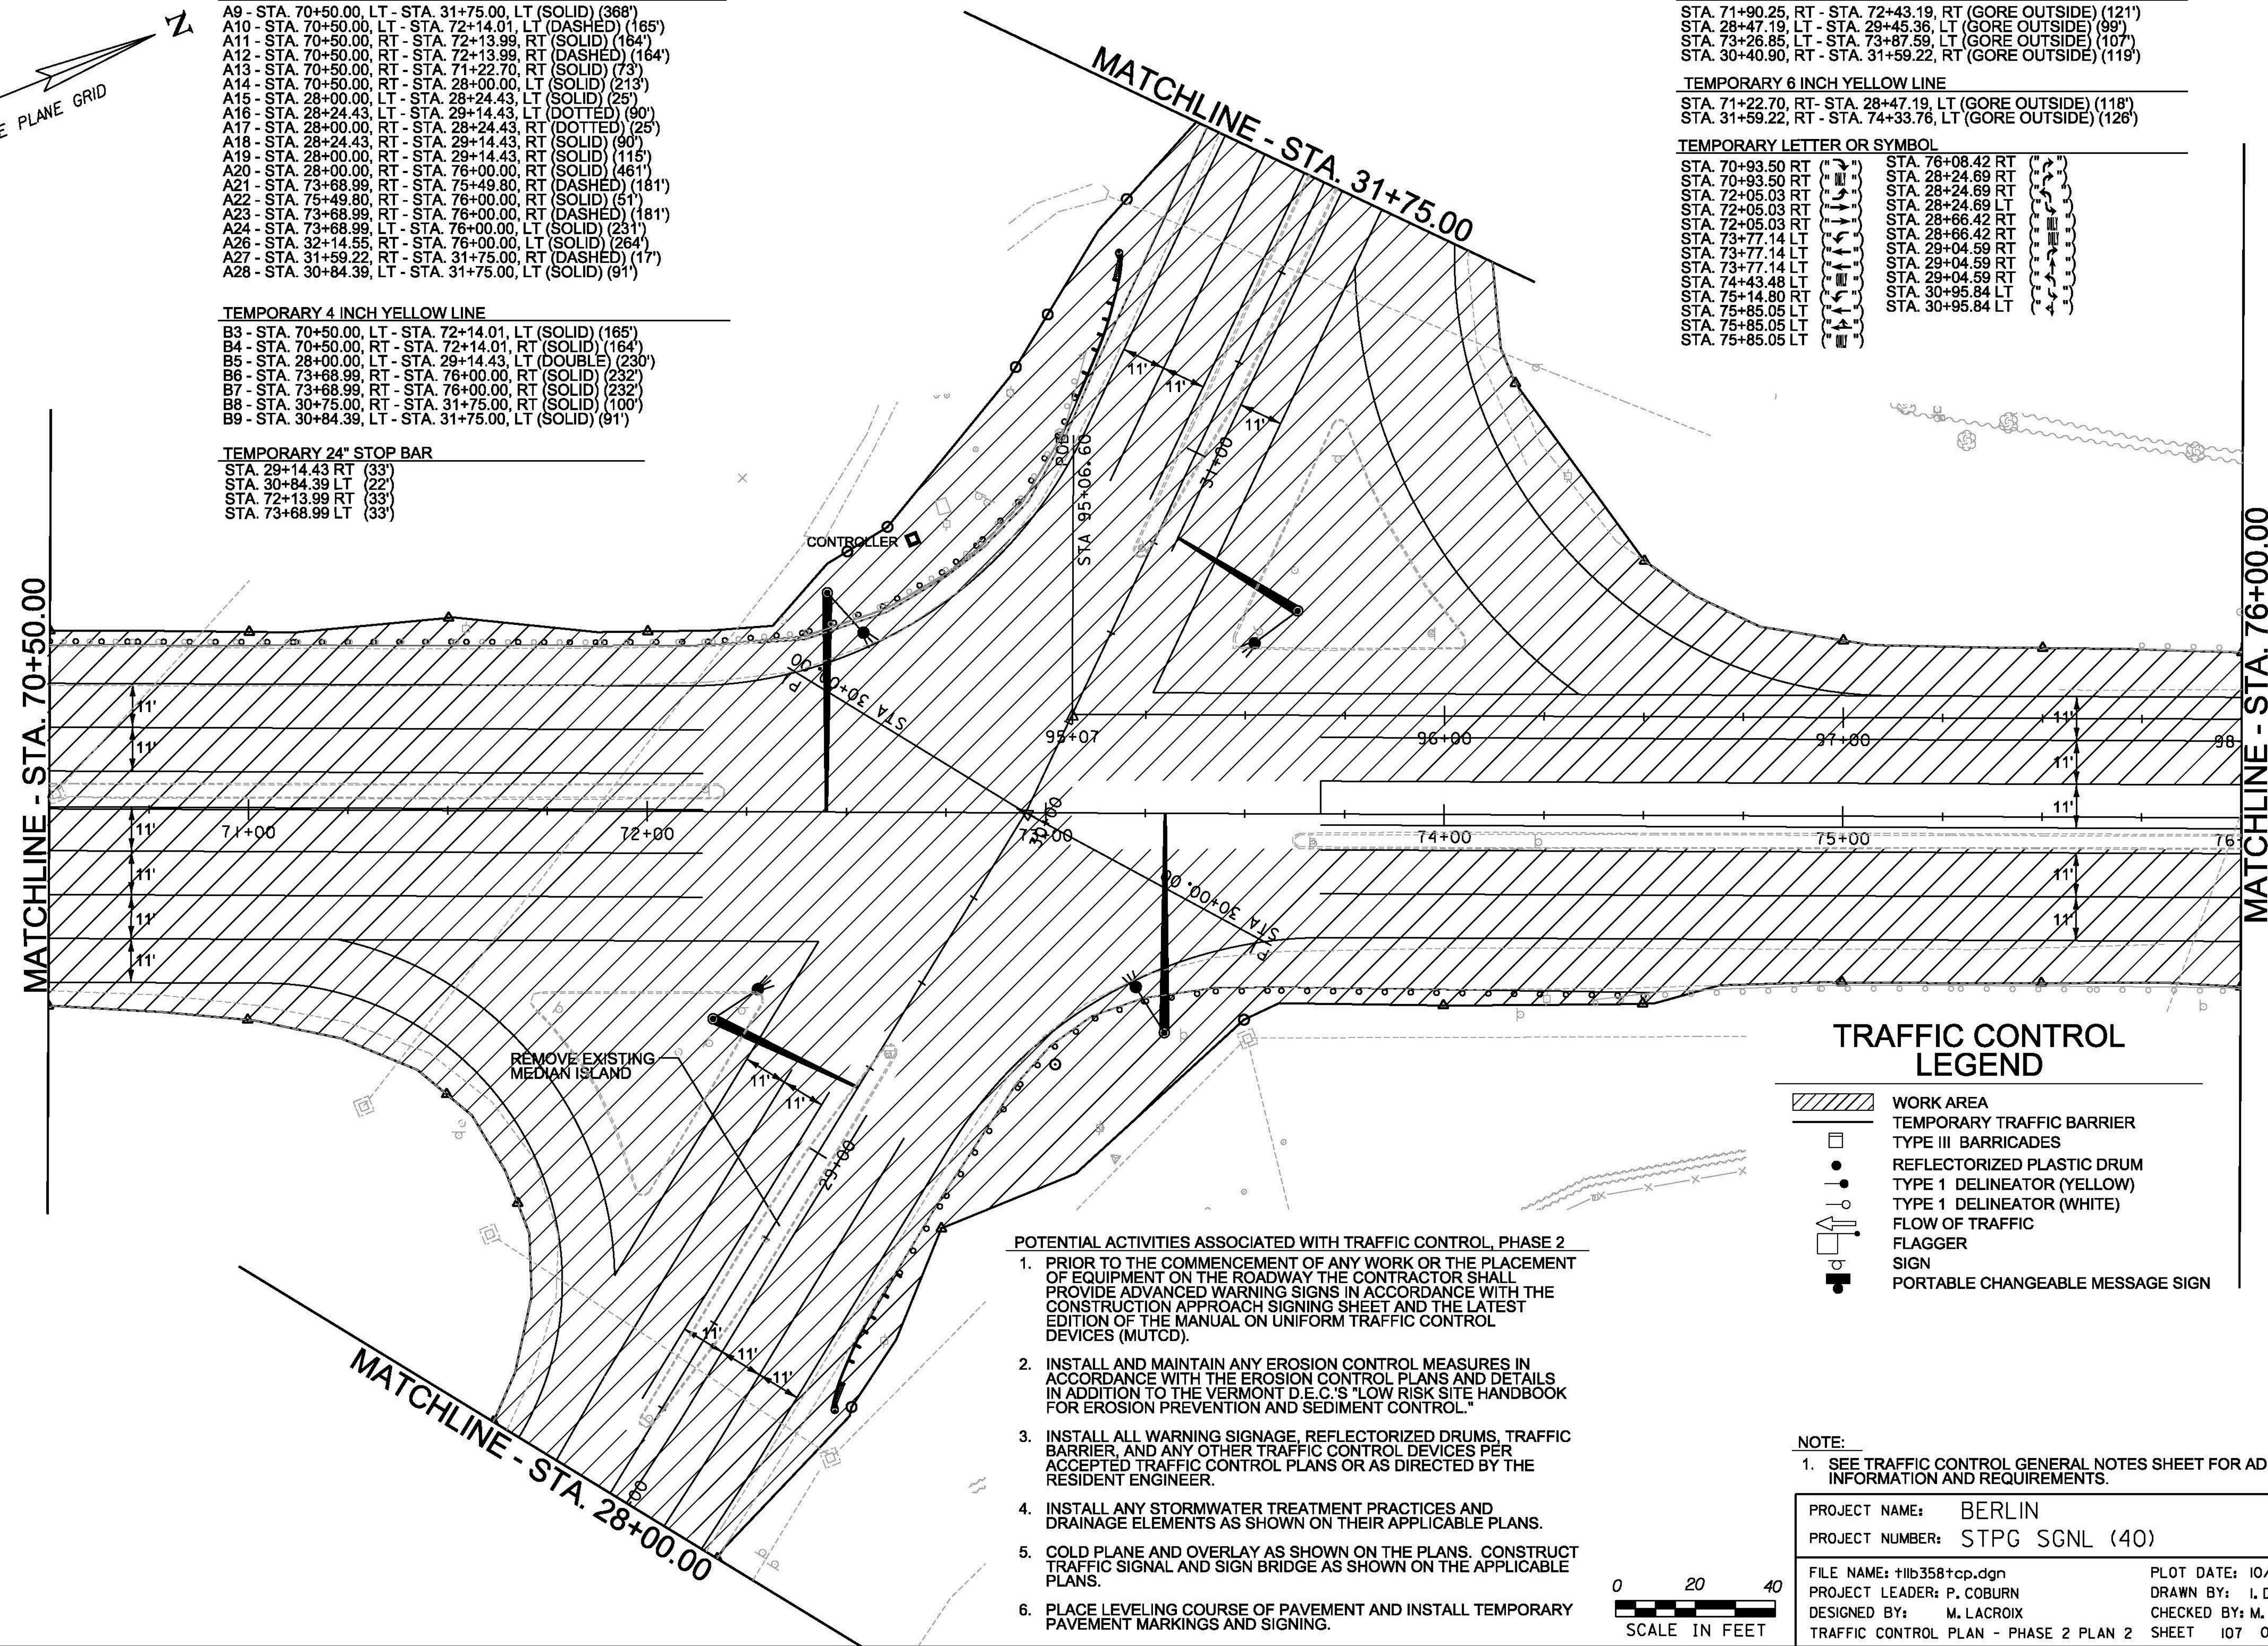

- POTENTIAL ACTIVITIES ASSOCIATED WITH TRAFFIC CONTROL, PHASE 2**
1. PRIOR TO THE COMMENCEMENT OF ANY WORK OR THE PLACEMENT OF EQUIPMENT ON THE ROADWAY THE CONTRACTOR SHALL PROVIDE ADVANCED WARNING SIGNS IN ACCORDANCE WITH THE CONSTRUCTION APPROACH SIGNING SHEET AND THE LATEST EDITION OF THE MANUAL ON UNIFORM TRAFFIC CONTROL DEVICES (MUTCD).
 2. INSTALL AND MAINTAIN ANY EROSION CONTROL MEASURES IN ACCORDANCE WITH THE EROSION CONTROL PLANS AND DETAILS IN ADDITION TO THE VERMONT D.E.C.'S "LOW RISK SITE HANDBOOK FOR EROSION PREVENTION AND SEDIMENT CONTROL."
 3. INSTALL ALL WARNING SIGNAGE, REFLECTORIZED DRUMS, TRAFFIC BARRIER, AND ANY OTHER TRAFFIC CONTROL DEVICES PER ACCEPTED TRAFFIC CONTROL PLANS OR AS DIRECTED BY THE RESIDENT ENGINEER.
 4. INSTALL ANY STORMWATER TREATMENT PRACTICES AND DRAINAGE ELEMENTS AS SHOWN ON THEIR APPLICABLE PLANS.
 5. COLD PLANE AND OVERLAY AS SHOWN ON THE PLANS. CONSTRUCT TRAFFIC SIGNAL AND SIGN BRIDGE AS SHOWN ON THE APPLICABLE PLANS.
 6. PLACE LEVELING COURSE OF PAVEMENT AND INSTALL TEMPORARY PAVEMENT MARKINGS AND SIGNING.

TRAFFIC CONTROL LEGEND

	WORK AREA
	TEMPORARY TRAFFIC BARRIER
	TYPE III BARRICADES
	REFLECTORIZED PLASTIC DRUM
	TYPE 1 DELINEATOR (YELLOW)
	TYPE 1 DELINEATOR (WHITE)
	FLOW OF TRAFFIC
	FLAGGER
	SIGN
	PORTABLE CHANGEABLE MESSAGE SIGN

NOTE:
1. SEE TRAFFIC CONTROL GENERAL NOTES SHEET FOR ADDITIONAL INFORMATION AND REQUIREMENTS.

PROJECT NAME:	BERLIN	PLOT DATE:	10/28/2014
PROJECT NUMBER:	STPG SGNL (40)	DRAWN BY:	I. DEGUTIS
FILE NAME:	tlb358+cp.dgn	CHECKED BY:	M. LACROIX
PROJECT LEADER:	P. COBURN	TRAFFIC CONTROL PLAN - PHASE 2 PLAN 2 SHEET	107 OF 123

