

**TEMPORARY 4 INCH WHITE LINE**  
 STA. 106+32.81, LT - STA. 109+68.00, LT (DIAGONALS) (242')  
 STA. 81+77.14, LT - STA. 109+68.00, LT (SOLID) (591')  
 STA. 106+76.73, LT - STA. 109+68.00, LT (DOTTED) (292')  
 STA. 82+64.99, LT - STA. 85+00.00, LT (SOLID) (241')  
 STA. 81+77.14, RT - STA. 85+00.00, RT (SOLID) (326')  
 STA. 81+77.14, RT - STA. 83+87.61, RT (DIAGONALS) (240')


**TEMPORARY 4 INCH YELLOW LINE**  
 STA. 104+75.00, RT - STA. 109+68.00, RT (SOLID) (494')  
 STA. 81+77.14, LT - STA. 83+75.00, LT (SOLID) (208')  
 STA. 81+77.14, RT - STA. 83+75.00, RT (SOLID) (204')  
 STA. 83+75.00, LT - STA. 85+00.00, LT (DOUBLE) (252')  
 STA. 83+75.00, RT - STA. 85+00.00, RT (DOUBLE) (248')

**TEMPORARY 8 INCH YELLOW LINE**  
 STA. 83+75.00, LT - STA. 85+00.00, LT (ISLAND DIAGONALS) (162')

**TEMPORARY 12 INCH WHITE LINE**  
 STA. 103+89.70, RT - STA. 104+75.00, RT (GORE OUTSIDE) (88')  
 STA. 81+83.11, LT - STA. 82+64.72, LT (GORE OUTSIDE) (85')

**TEMPORARY LETTER OR SYMBOL**  
 STA. 108+65.94, LT ("E")  
 STA. 109+61.64, LT ("E")

**LIMITS OF CONSTRUCTION**  
**STA. 109 + 68.33**

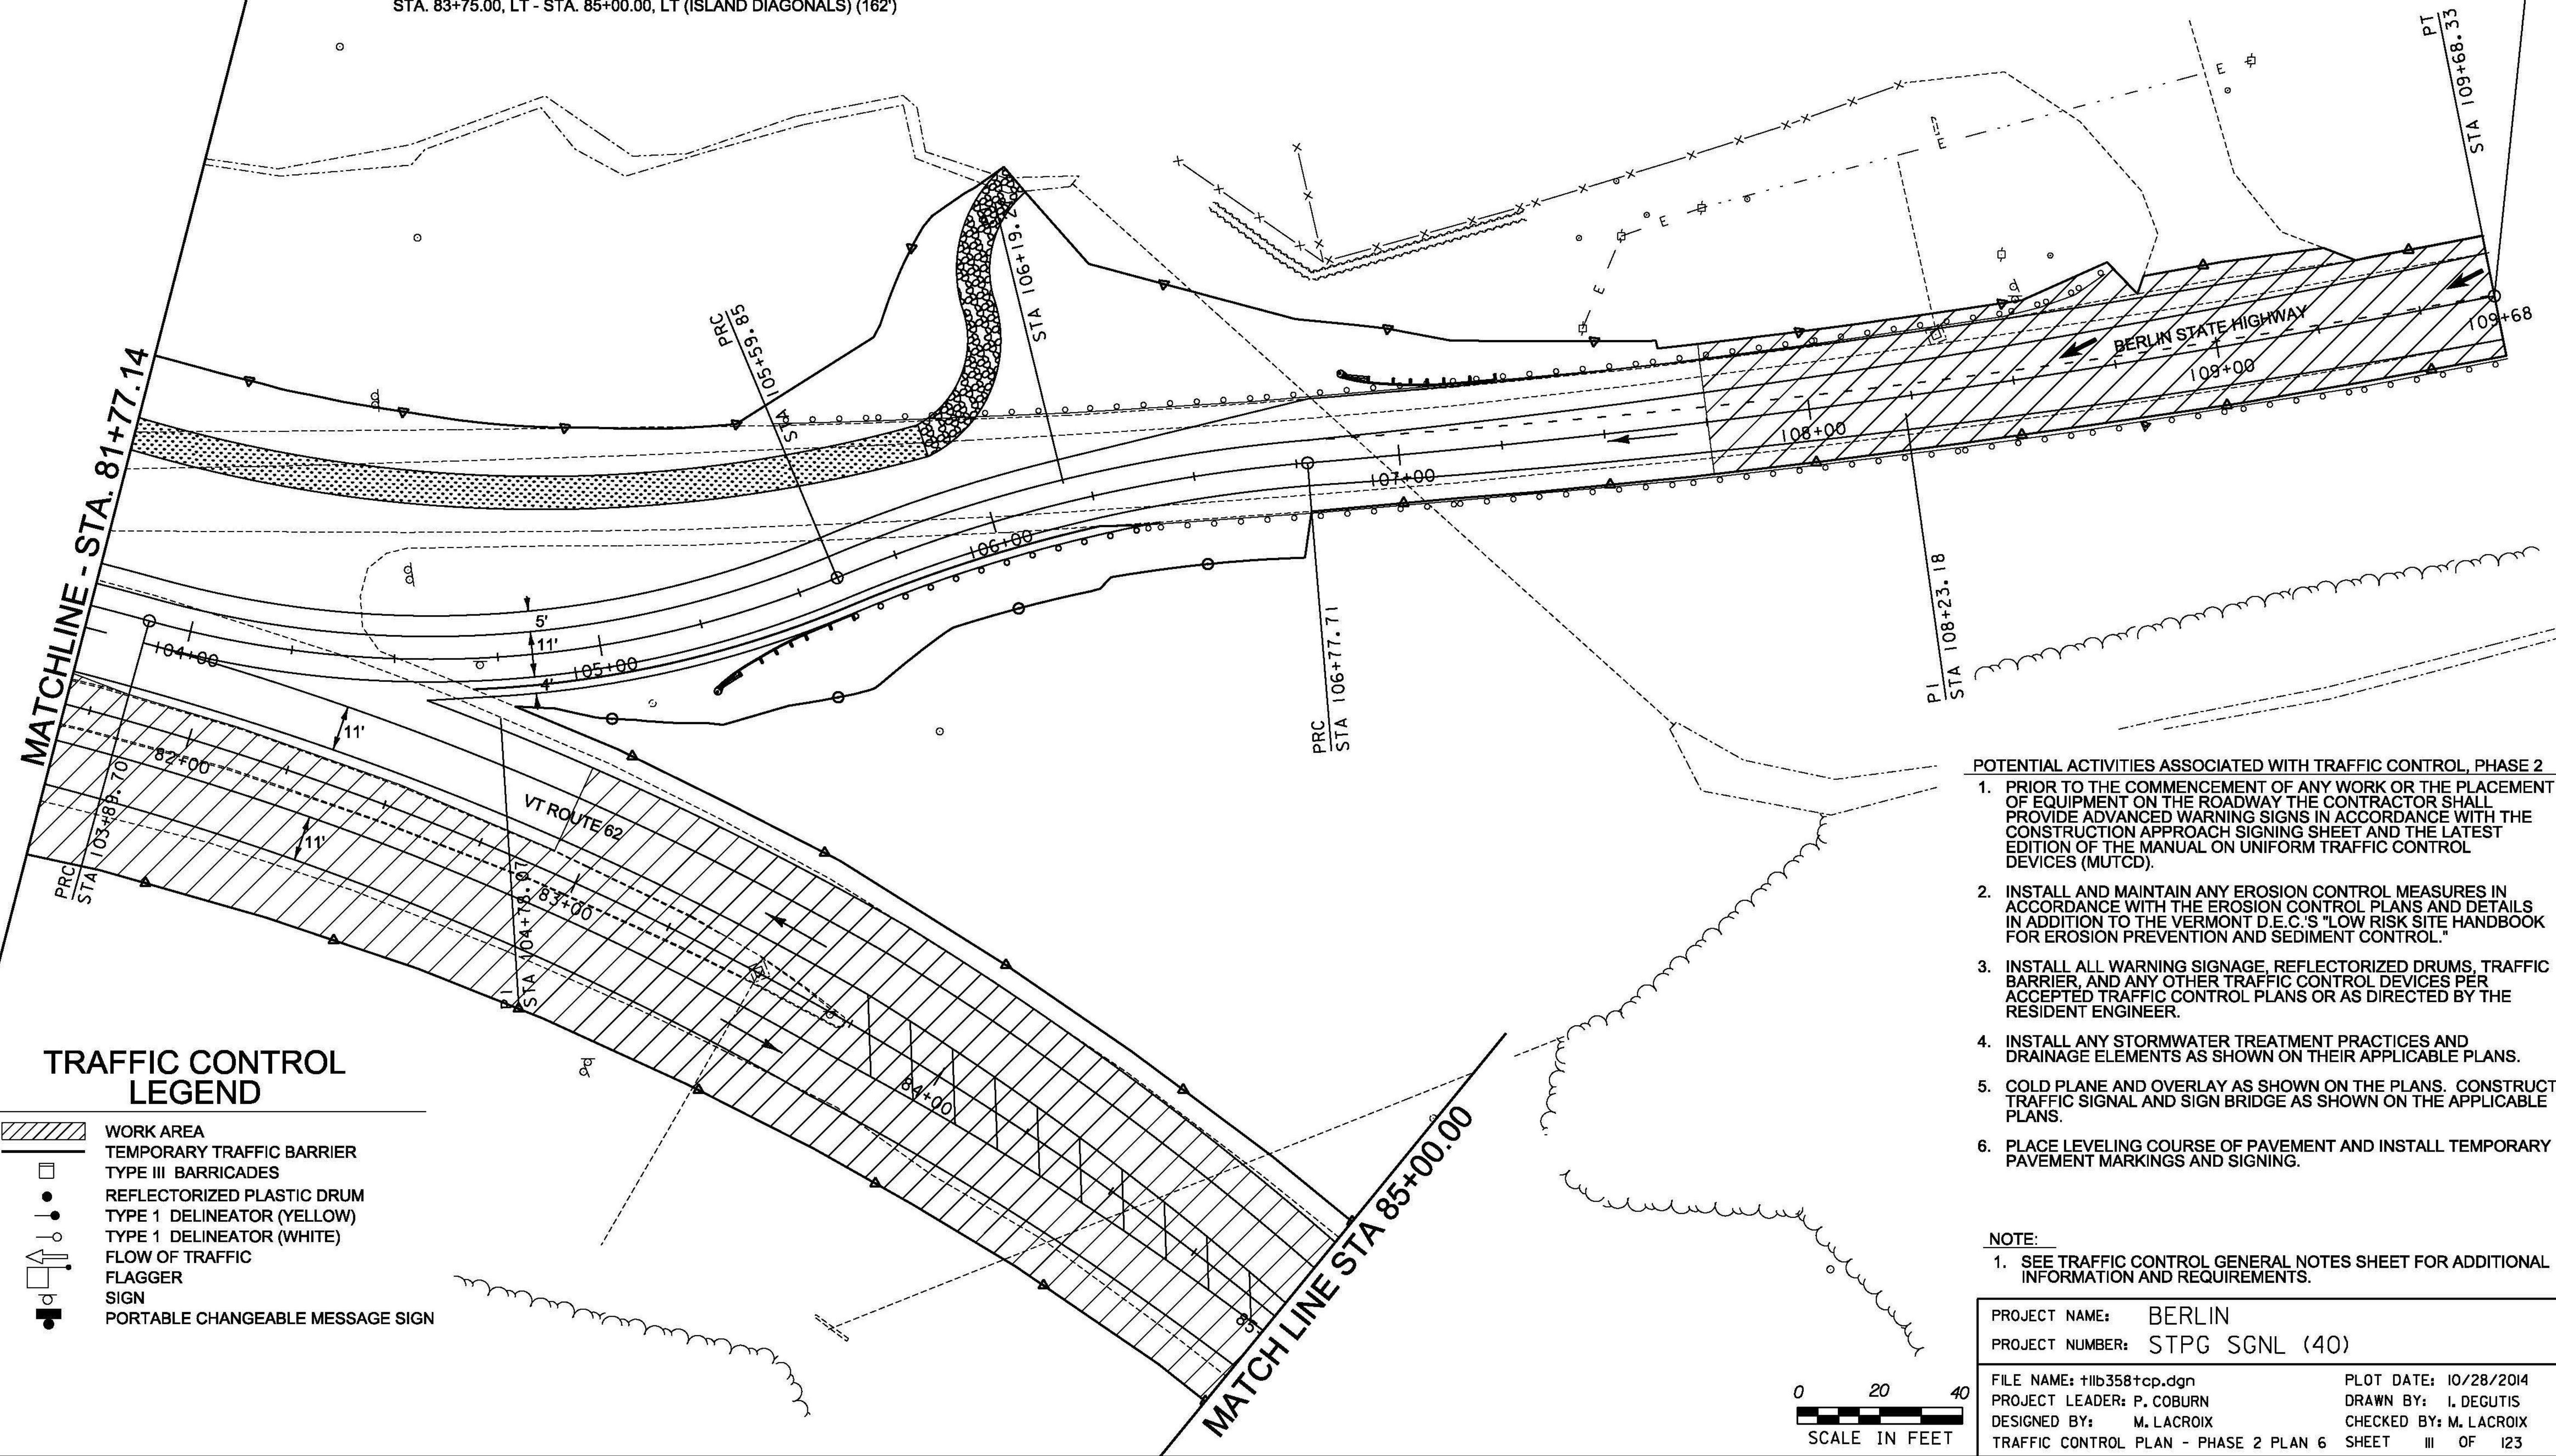


- POTENTIAL ACTIVITIES ASSOCIATED WITH TRAFFIC CONTROL, PHASE 2**
1. PRIOR TO THE COMMENCEMENT OF ANY WORK OR THE PLACEMENT OF EQUIPMENT ON THE ROADWAY THE CONTRACTOR SHALL PROVIDE ADVANCED WARNING SIGNS IN ACCORDANCE WITH THE CONSTRUCTION APPROACH SIGNING SHEET AND THE LATEST EDITION OF THE MANUAL ON UNIFORM TRAFFIC CONTROL DEVICES (MUTCD).
  2. INSTALL AND MAINTAIN ANY EROSION CONTROL MEASURES IN ACCORDANCE WITH THE EROSION CONTROL PLANS AND DETAILS IN ADDITION TO THE VERMONT D.E.C.'S "LOW RISK SITE HANDBOOK FOR EROSION PREVENTION AND SEDIMENT CONTROL."
  3. INSTALL ALL WARNING SIGNAGE, REFLECTORIZED DRUMS, TRAFFIC BARRIER, AND ANY OTHER TRAFFIC CONTROL DEVICES PER ACCEPTED TRAFFIC CONTROL PLANS OR AS DIRECTED BY THE RESIDENT ENGINEER.
  4. INSTALL ANY STORMWATER TREATMENT PRACTICES AND DRAINAGE ELEMENTS AS SHOWN ON THEIR APPLICABLE PLANS.
  5. COLD PLANE AND OVERLAY AS SHOWN ON THE PLANS. CONSTRUCT TRAFFIC SIGNAL AND SIGN BRIDGE AS SHOWN ON THE APPLICABLE PLANS.
  6. PLACE LEVELING COURSE OF PAVEMENT AND INSTALL TEMPORARY PAVEMENT MARKINGS AND SIGNING.

**NOTE:**  
 1. SEE TRAFFIC CONTROL GENERAL NOTES SHEET FOR ADDITIONAL INFORMATION AND REQUIREMENTS.

**TRAFFIC CONTROL LEGEND**

- WORK AREA
- TEMPORARY TRAFFIC BARRIER
- TYPE III BARRICADES
- REFLECTORIZED PLASTIC DRUM
- TYPE 1 DELINEATOR (YELLOW)
- TYPE 1 DELINEATOR (WHITE)
- FLOW OF TRAFFIC
- FLAGGER
- SIGN
- PORTABLE CHANGEABLE MESSAGE SIGN

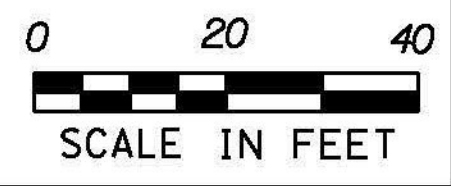

PROJECT NAME:	BERLIN	FILE NAME:	tlb358+cp.dgn	PLOT DATE:	10/28/2014
PROJECT NUMBER:	STPG SGNL (40)	PROJECT LEADER:	P. COBURN	DRAWN BY:	I. DEGUTIS
		DESIGNED BY:	M. LACROIX	CHECKED BY:	M. LACROIX
TRAFFIC CONTROL PLAN - PHASE 2 PLAN 6			SHEET III OF 123		