

STATE OF VERMONT
AGENCY OF TRANSPORTATION




PROPOSED IMPROVEMENT
BRIDGE PROJECT

TOWN OF ROXBURY
COUNTY OF WASHINGTON

PROJECT LOCATION: ROUTE VT 12A BR 15 : .65 MILES NORTHEAST OF GRANVILLE/ROXBURY TOWN LINE
ROUTE VT 12A BR 22 : 3.27 MILES NORTHEAST OF GRANVILLE/ROXBURY TOWN LINE

PROJECT DESCRIPTION: ROUTE VT 12A BR 15 : REPLACEMENT OF EXISTING BRIDGE SUPERSTRUCTURE,
ROADWAY WORK, AND RETAINING WALL REPLACEMENT.
ROUTE VT 12A BR 22 : REPLACEMENT OF CULVERT WITH RELATED ROADWAY AND
CHANNEL WORK.
LENGTH OF STRUCTURE : ROUTE VT 12A BR 15 : 56.66' ROUTE VT 12A BR 22 : 33.30'
TOTAL LENGTH OF STRUCTURES : 90'

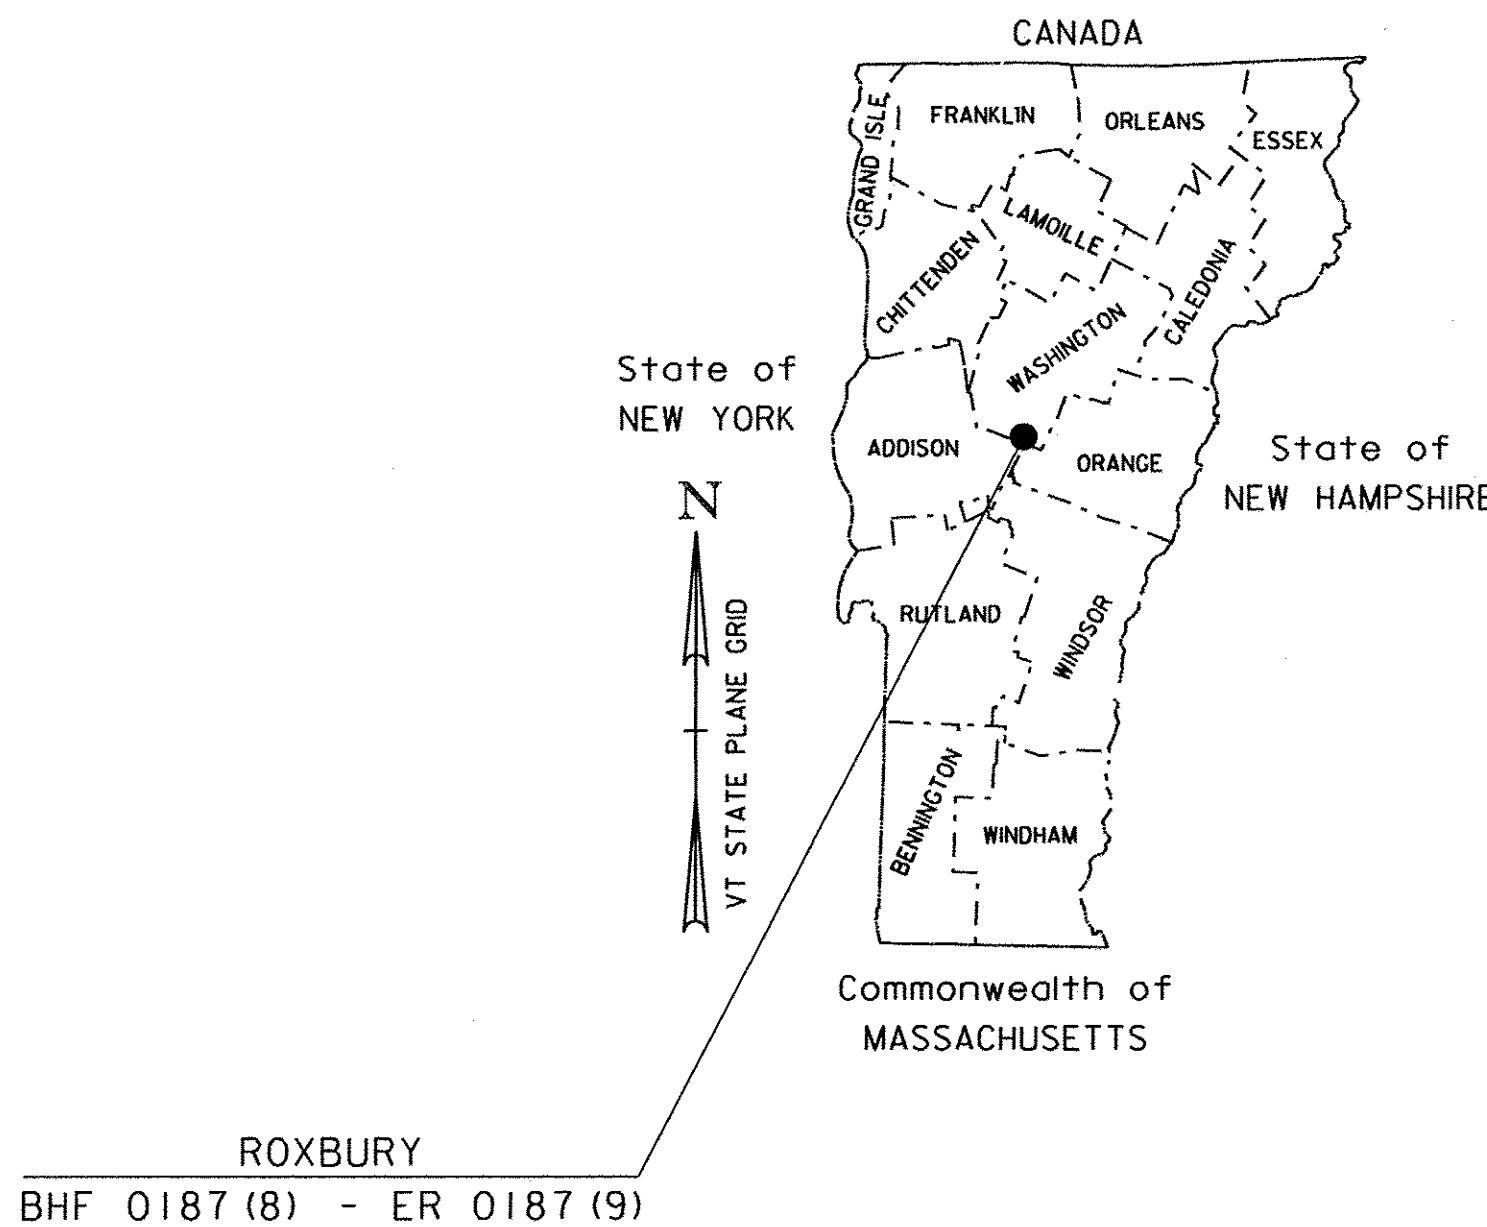

ROXBURY
BHF 0187 (8) - ER 0187 (9)

RECORD PLANS

CONTRACTOR: LUCK BROTHERS, INC. - PLATTSBURGH, NY
RESIDENT ENGINEER: TOM MANCINI
CONSTRUCTION BEGAN: OCTOBER 17, 2011
CONSTRUCTION COMPLETE: AUGUST 6, 2012
RECORD PLANS BY: TOM MANCINI & JENNA HYDE

I HEREBY CERTIFY THAT ALL THE CONSTRUCTION REQUIRED BY THIS SET
OF DRAWINGS HAS BEEN ACCOMPLISHED AS INDICATED HEREIN.

BY Tom Mancini RESIDENT ENGINEER
DATE 4/1/13

NOTE: Any further information concerning final quantities, amounts or other details
relative to this project may be found at Central Files in the electronic archives.

QUALITY ASSURANCE PROGRAM: LEVEL 2



CONVENTIONAL SYMBOLS

COUNTY LINE	
TOWN LINE	
LIMITS OF ACCESS	
POINT OF ACCESS	
FENCE LINE	
STONE WALL	
TRAVELED WAY	
GUARD RAIL	
RAILROAD	
SURVEY LINE	
CULVERT	
POWER POLE	
TELEPHONE POLE	
TREES	
CONTROL OF ACCESS	
PROPERTY LINE	
R.O.W. TAKING LINE	
SLOPE RIGHTS	
TOP OF CUT	
TOE OF SLOPE	

SURVEYED BY : N/A
SURVEYED DATE : N/A

DATUM

VERTICAL
HORIZONTAL SEE SHEET 6 AND 41

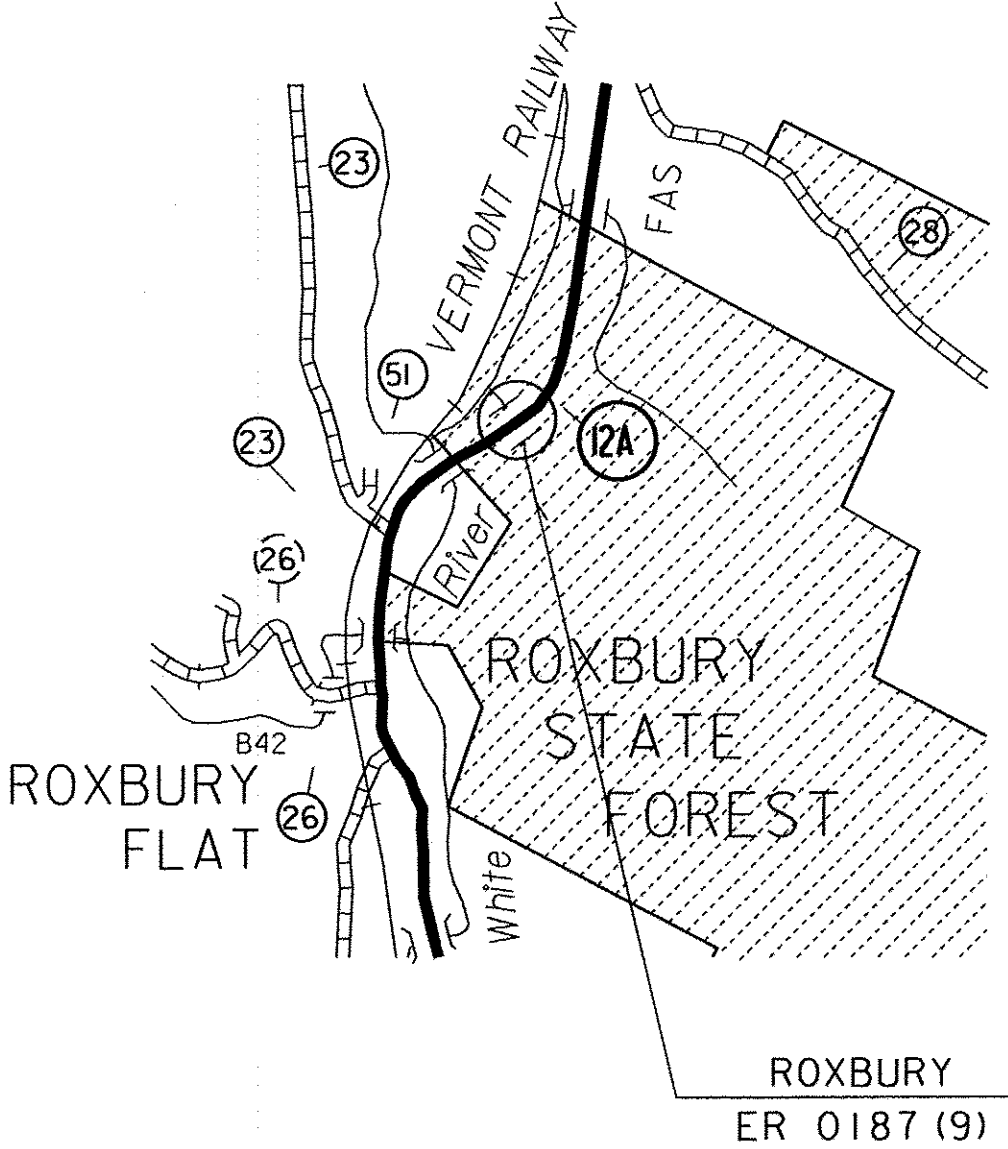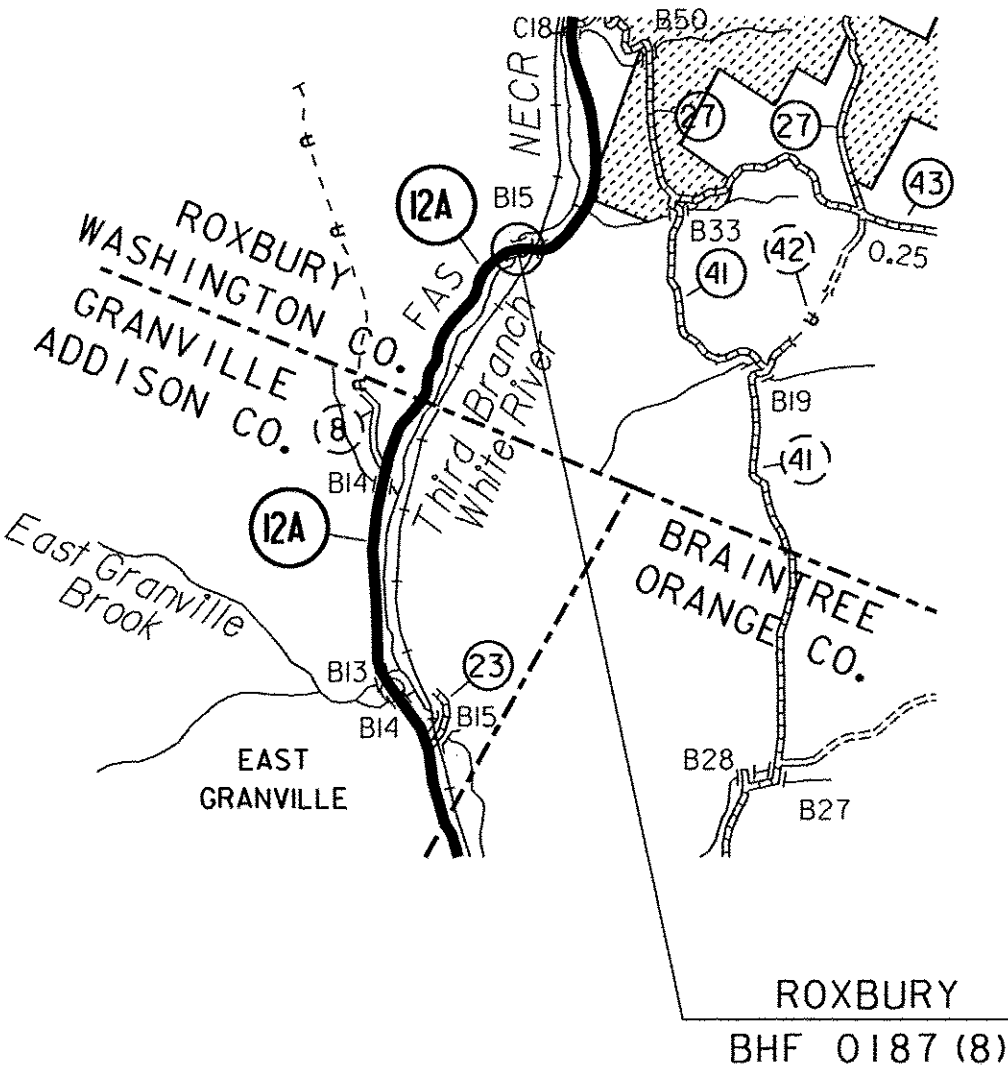

THESE PLANS ARE SUBJECT TO SUCH ENGINEERING
CHANGES AS MAY BE REQUIRED BY THE FEDERAL HIGHWAY
ADMINISTRATION OR THE DIRECTOR OF PROGRAM
DEVELOPMENT.
CONSTRUCTION IS TO BE CARRIED ON IN ACCORDANCE
WITH THESE PLANS AND THE STANDARD SPECIFICATIONS
FOR CONSTRUCTION DATED 2006, AS APPROVED BY THE
FEDERAL HIGHWAY ADMINISTRATION ON JUNE 15, 2006
FOR USE ON THIS PROJECT, INCLUDING ALL SUBSEQUENT
REVISIONS AND SUCH REVISED SPECIFICATIONS AND
SPECIAL PROVISIONS AS ARE INCORPORATED IN THESE
PLANS.

PLOTTED 19-SEP-2011

DIRECTOR OF PROGRAM DEVELOPMENT

APPROVED John Stetson DATE 9/9/11

PROJECT MANAGER : C.P. WILLIAMS

PROJECT NAME : ROXBURY
PROJECT NUMBER : BHF 0187 (8) / ER 0187 (9)

SHEET 1 OF 54 SHEETS