



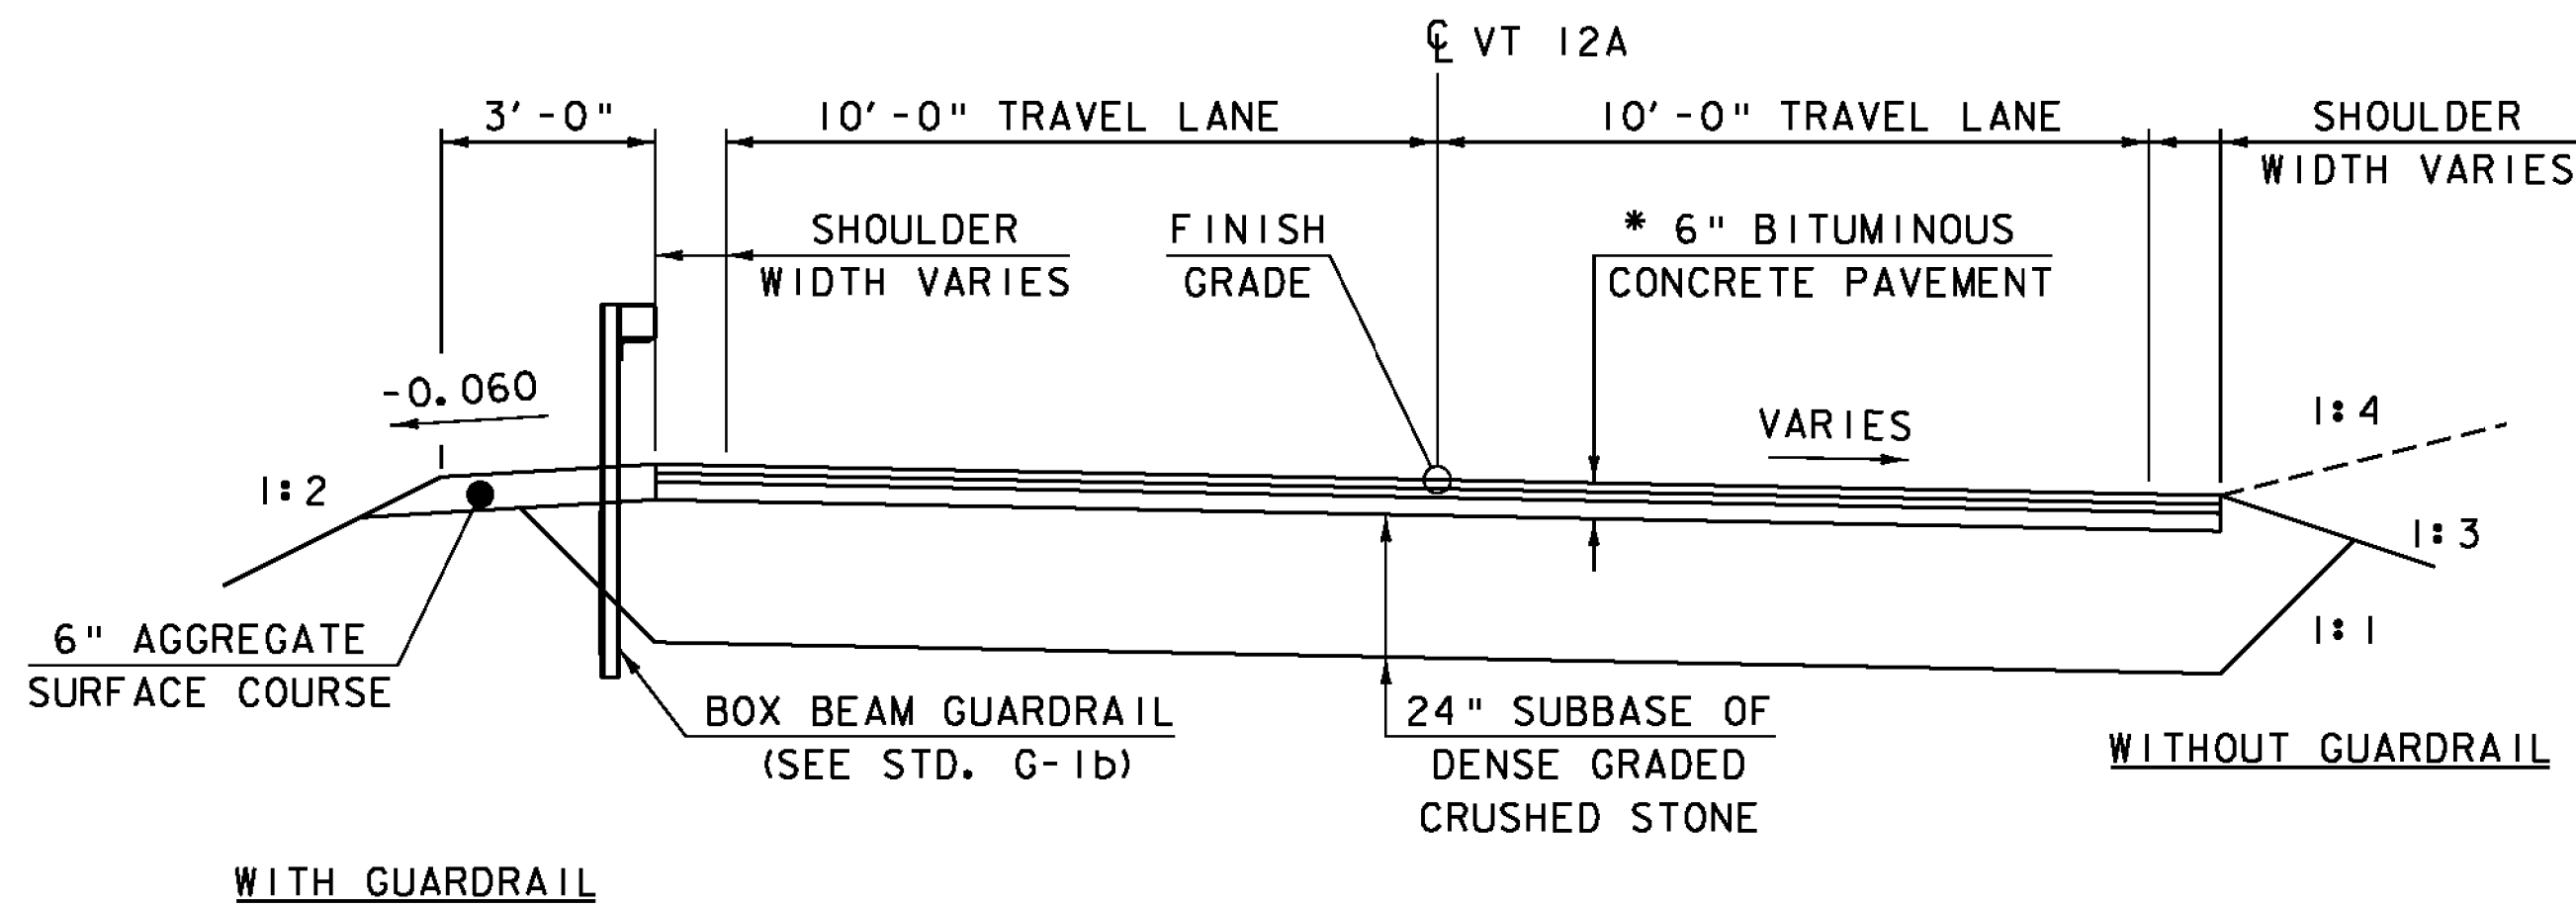

ROADWAY TYPICAL SECTION


*2 LIFTS OF 1½" BITUM. CONC. PAVEMENT TYPE IIIS OVER
1 LIFT OF 3" BITUM. CONC. PAVEMENT TYPE IS OR IIS
PAID UNDER SPECIAL PROVISION (BITUMINOUS CONCRETE
PAVEMENT, SMALL QUANTITY).

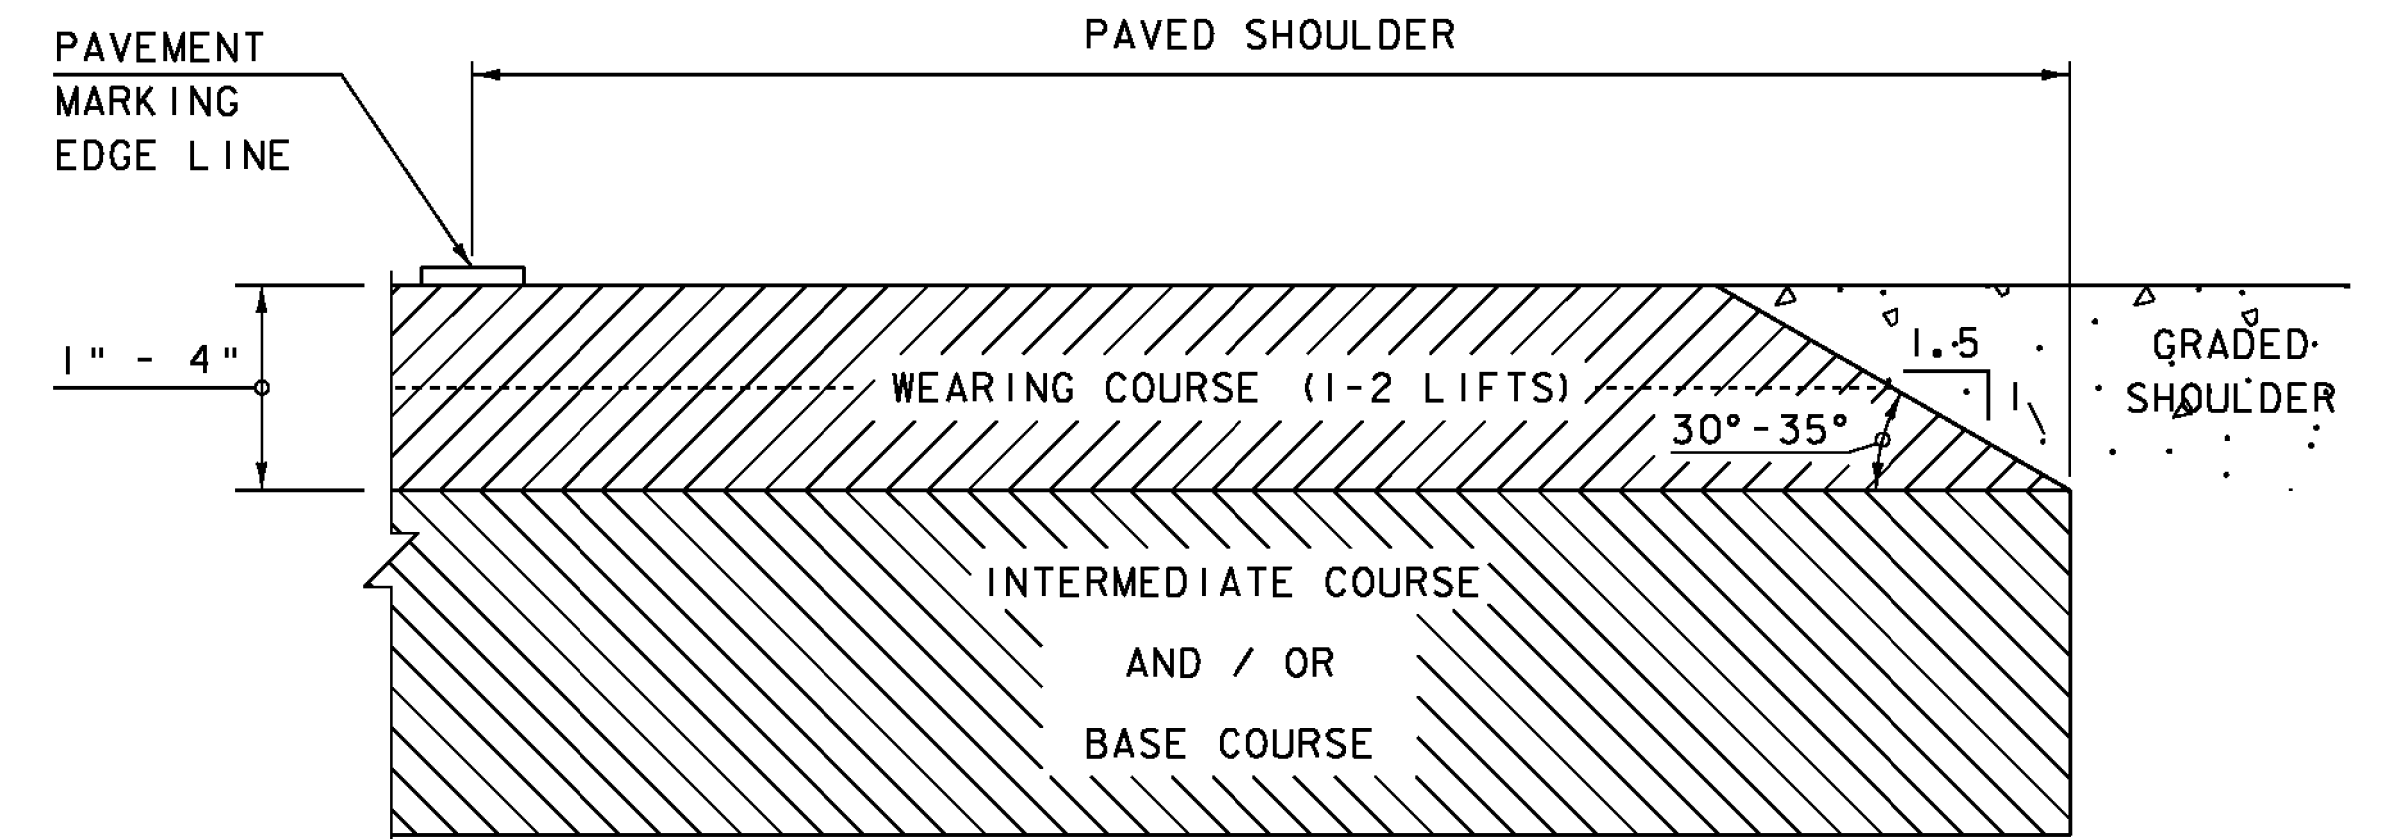

SAFETY EDGE DETAIL

NOT TO SCALE

NOTE: LEVELING COURSE MAY INCLUDE THE "SAFETY EDGE"
AT THE CONTRACTOR'S CHOICE.

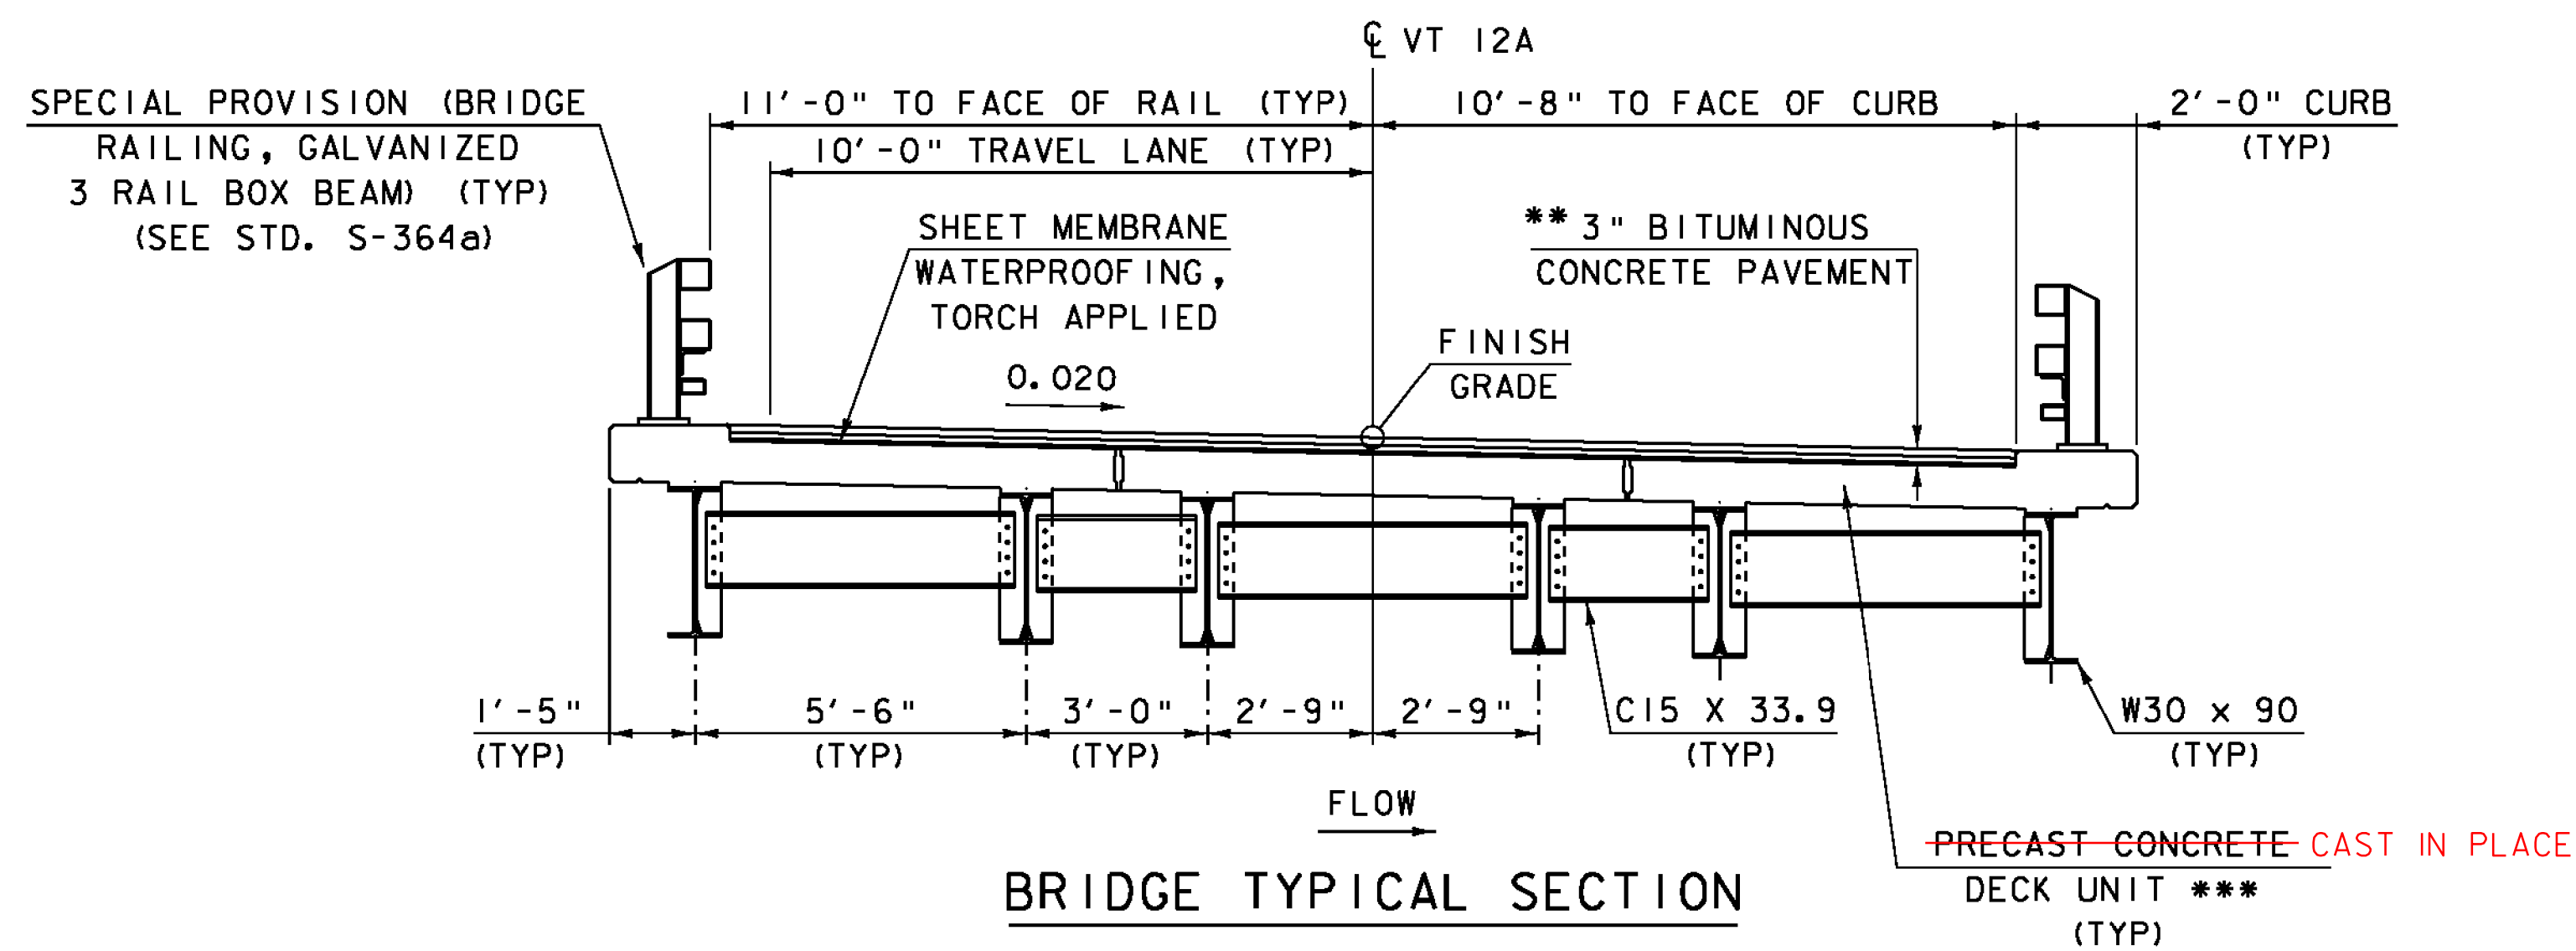

BRIDGE TYPICAL SECTION

** 2 LIFTS OF 1½" BITUM. CONC. PAVEMENT TYPE IIIS
PAID UNDER SPECIAL PROVISION (BITUMINOUS CONCRETE
PAVEMENT, SMALL QUANTITY).
*** SEE PRECAST CONCRETE/STEEL COMPOSITE SUPERSTRUCTURE
OF SECTION 900 OF THE SPECIAL PROVISIONS.

MATERIAL TOLERANCES

(IF USED ON PROJECT)

SURFACE	
- PAVEMENT (TOTAL THICKNESS)	+/- ¼"
- AGGREGATE SURFACE COURSE	+/- ½"
SUBBASE	+/- 1"
SAND BORROW	+/- 1"
GRANULAR BORROW	+/- 1"

PROJECT NAME: ROXBURY
PROJECT NUMBER: BHF 0187(8)

FILE NAME: sl0c420+yp.dgn
PROJECT LEADER: C. P. WILLIAMS
DESIGNED BY: G. ROY
PROJECT TYPICAL SECTIONS

PLOT DATE: 21-SEP-2011
DRAWN BY: G. ROY
CHECKED BY: T. FILLBACH
SHEET 13 OF 54