



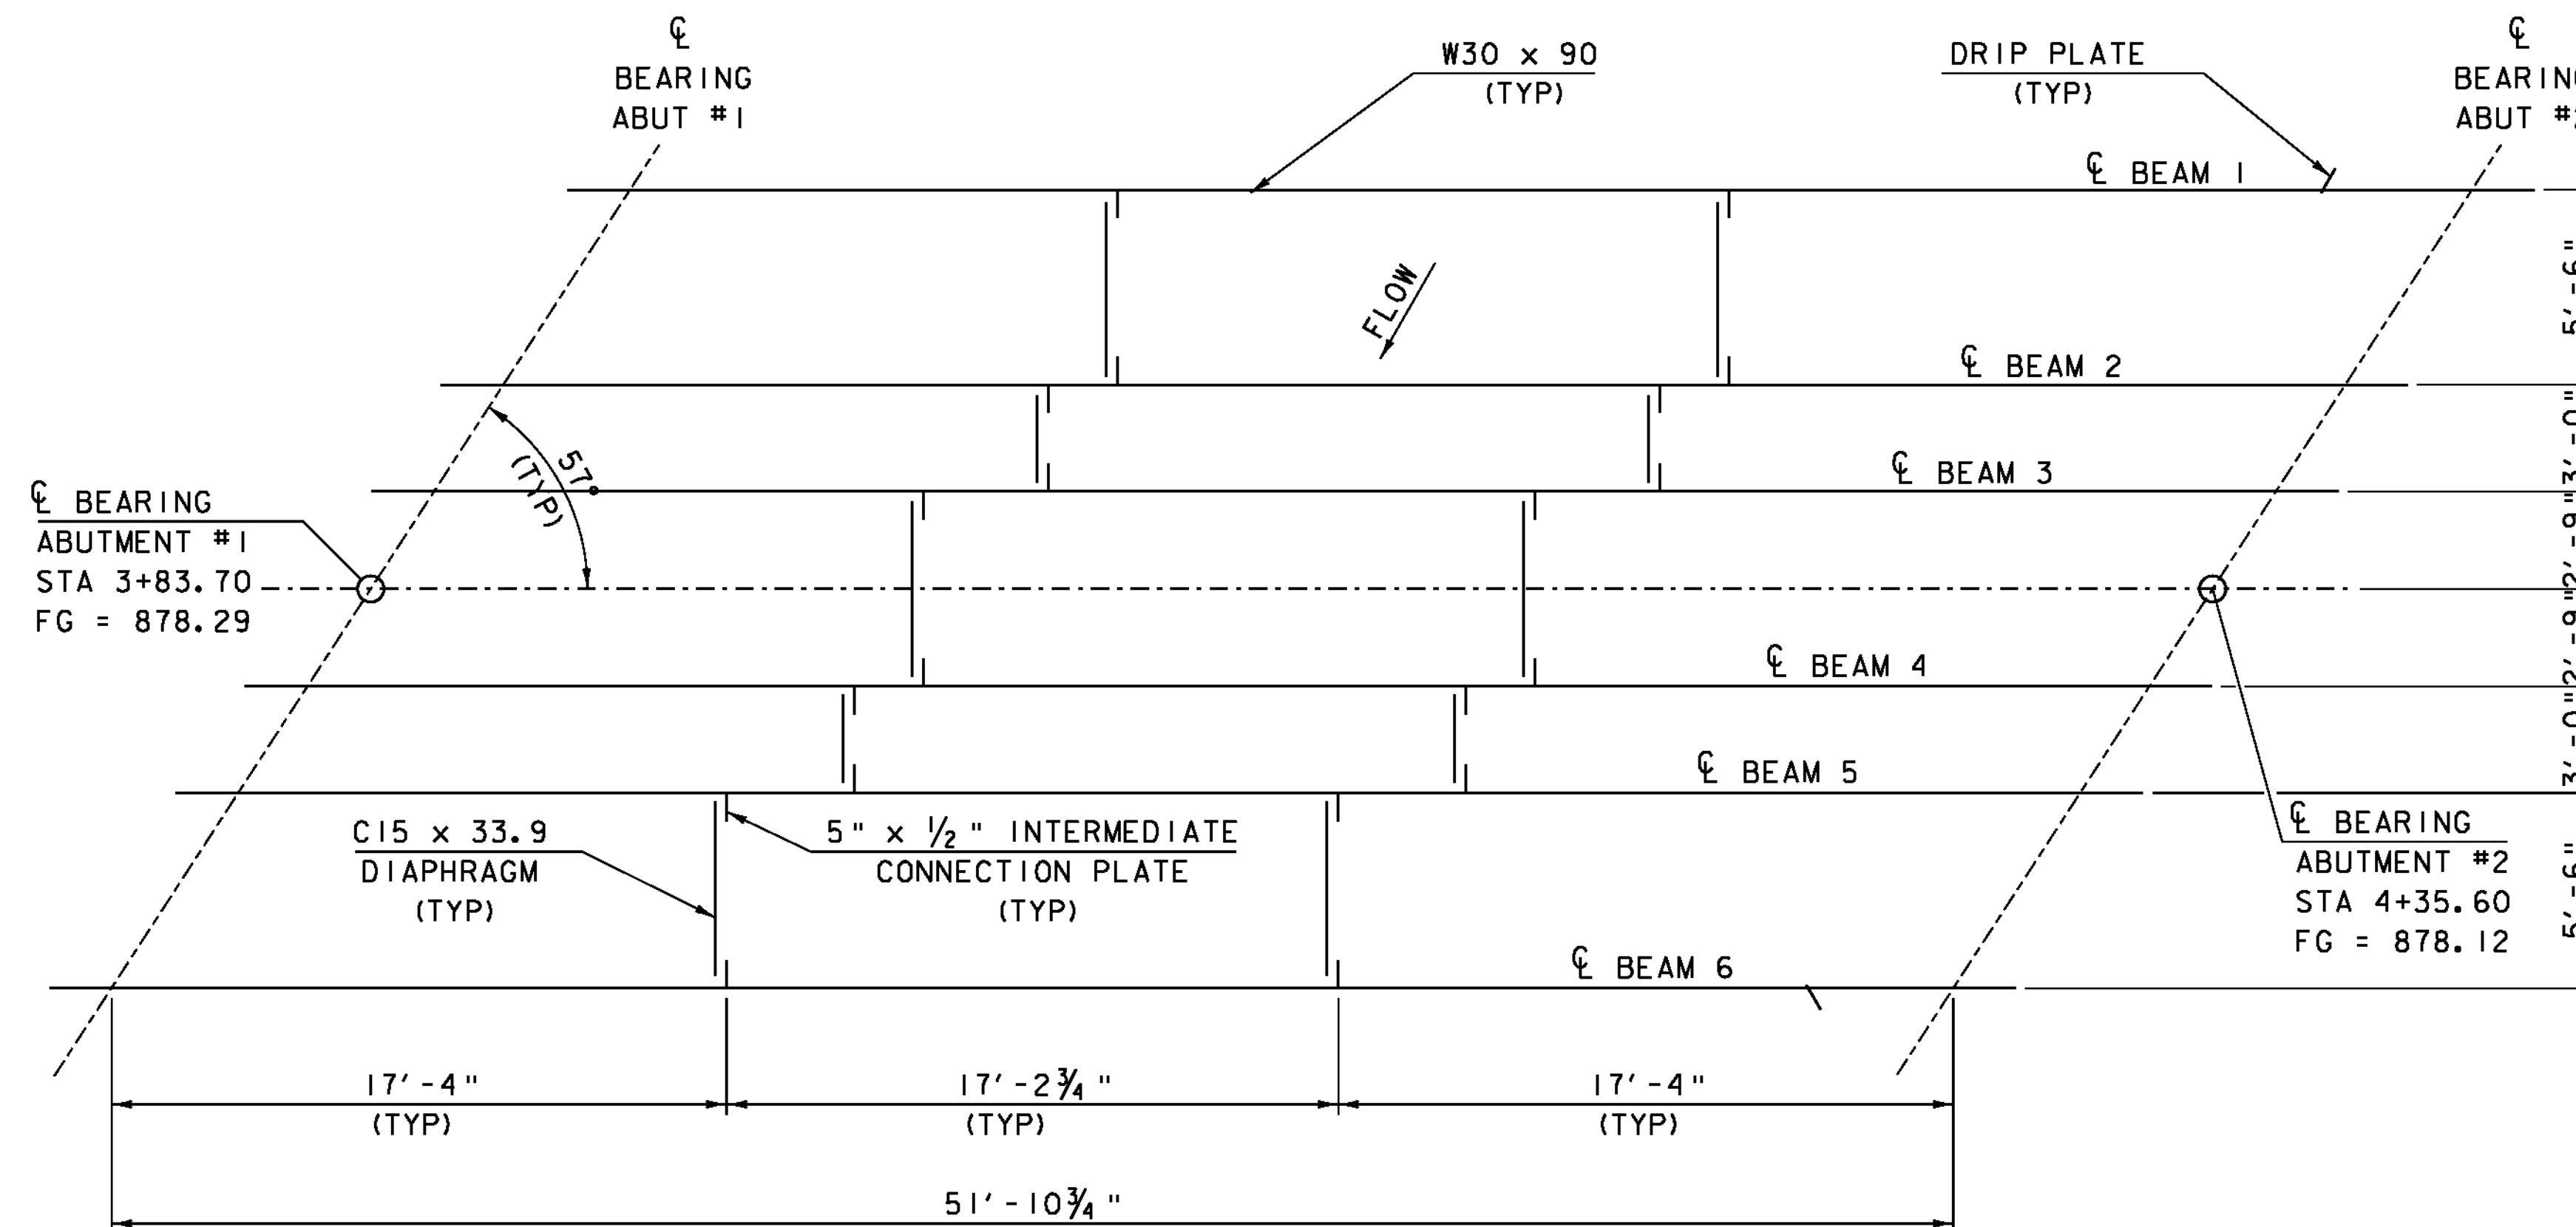


DECK FRAMING PLAN

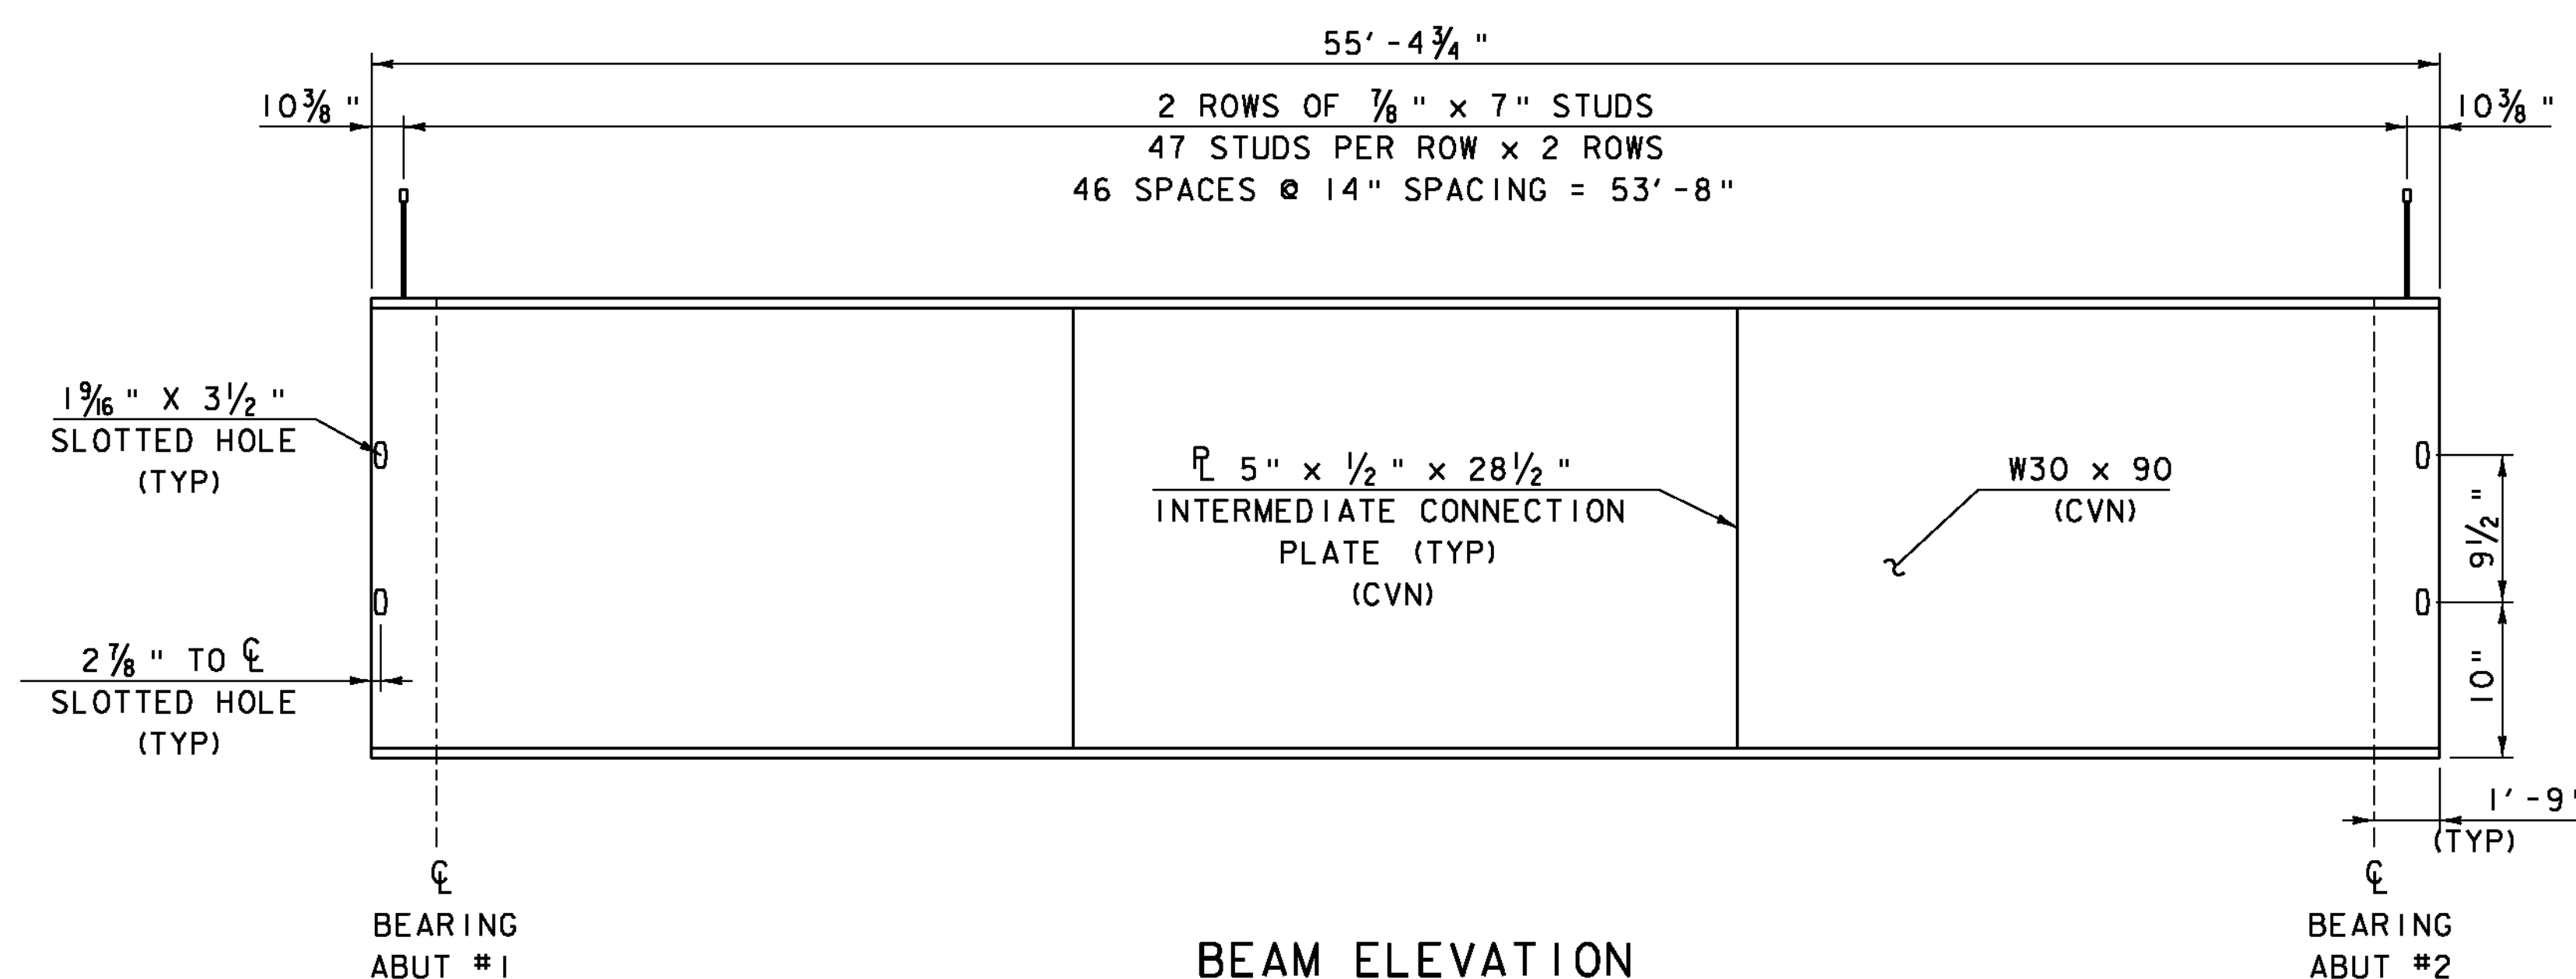


BEAM ELEVATION

(VERTICAL EXAGGERATED 5X)
NOTE: ALL STEEL MARKED "CVN" SHALL
BE CHARPY V-NOTCH TESTED

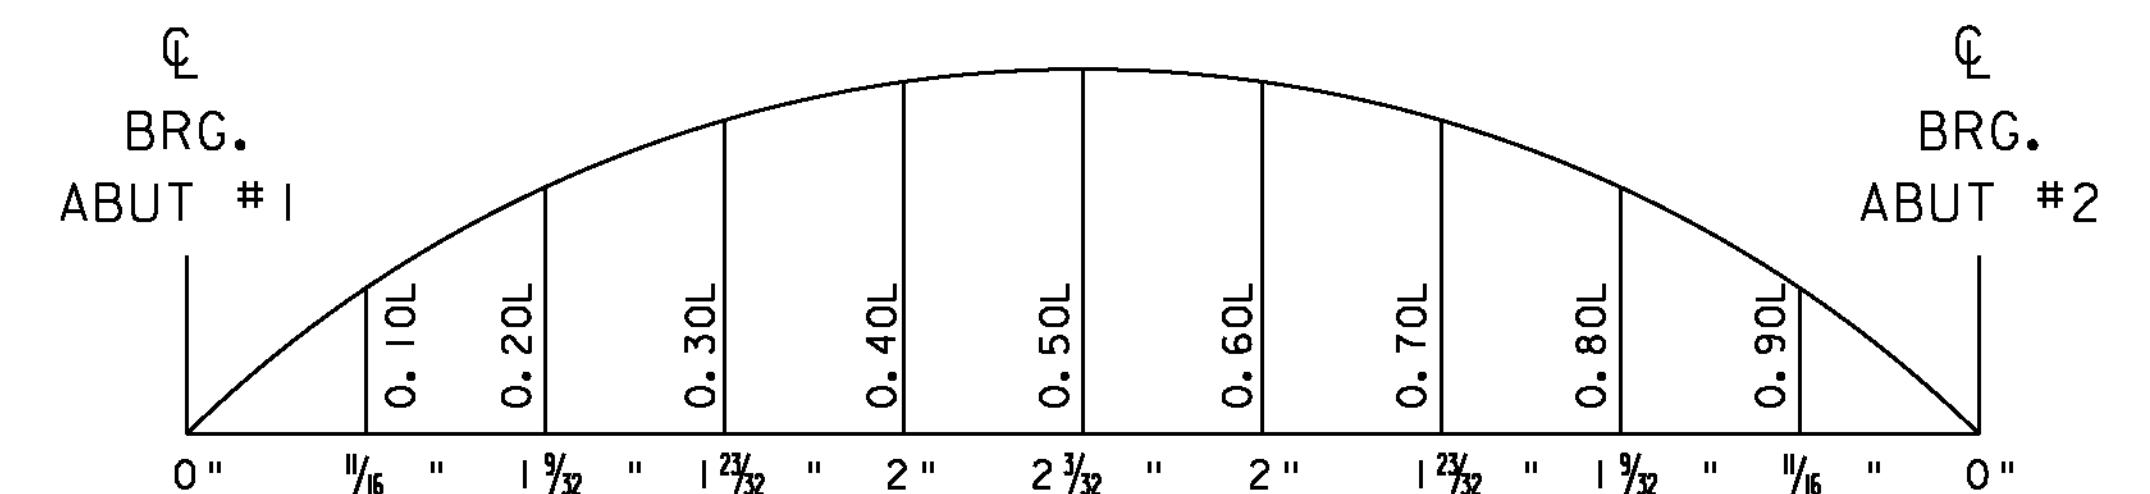

CAMBER DIAGRAM

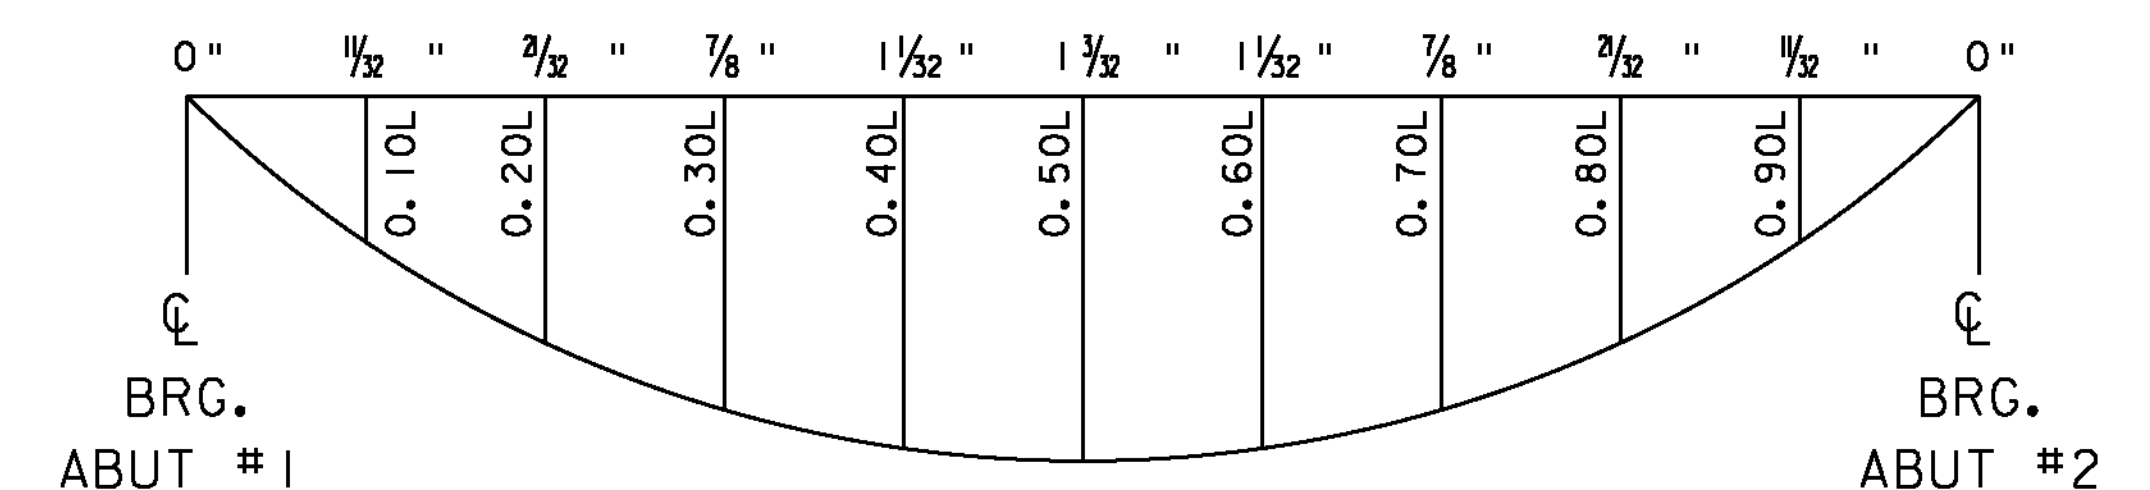

DEAD LOAD DEFLECTION DIAGRAM

DEFLECTION IS AFTER DEAD
LOADS HAVE BEEN APPLIED

PROJECT NAME: ROXBURY	
PROJECT NUMBER: BHF 0187(8)	
FILE NAME: slOc420sup.dgn	PLOT DATE: 21-SEP-2011
PROJECT LEADER: C.P.WILLIAMS	DRAWN BY: D.D.BEARD
DESIGNED BY: R.S.YOUNG	CHECKED BY: E.R.Charbonneau
FRAMING DETAILS	SHEET 18 OF 54