
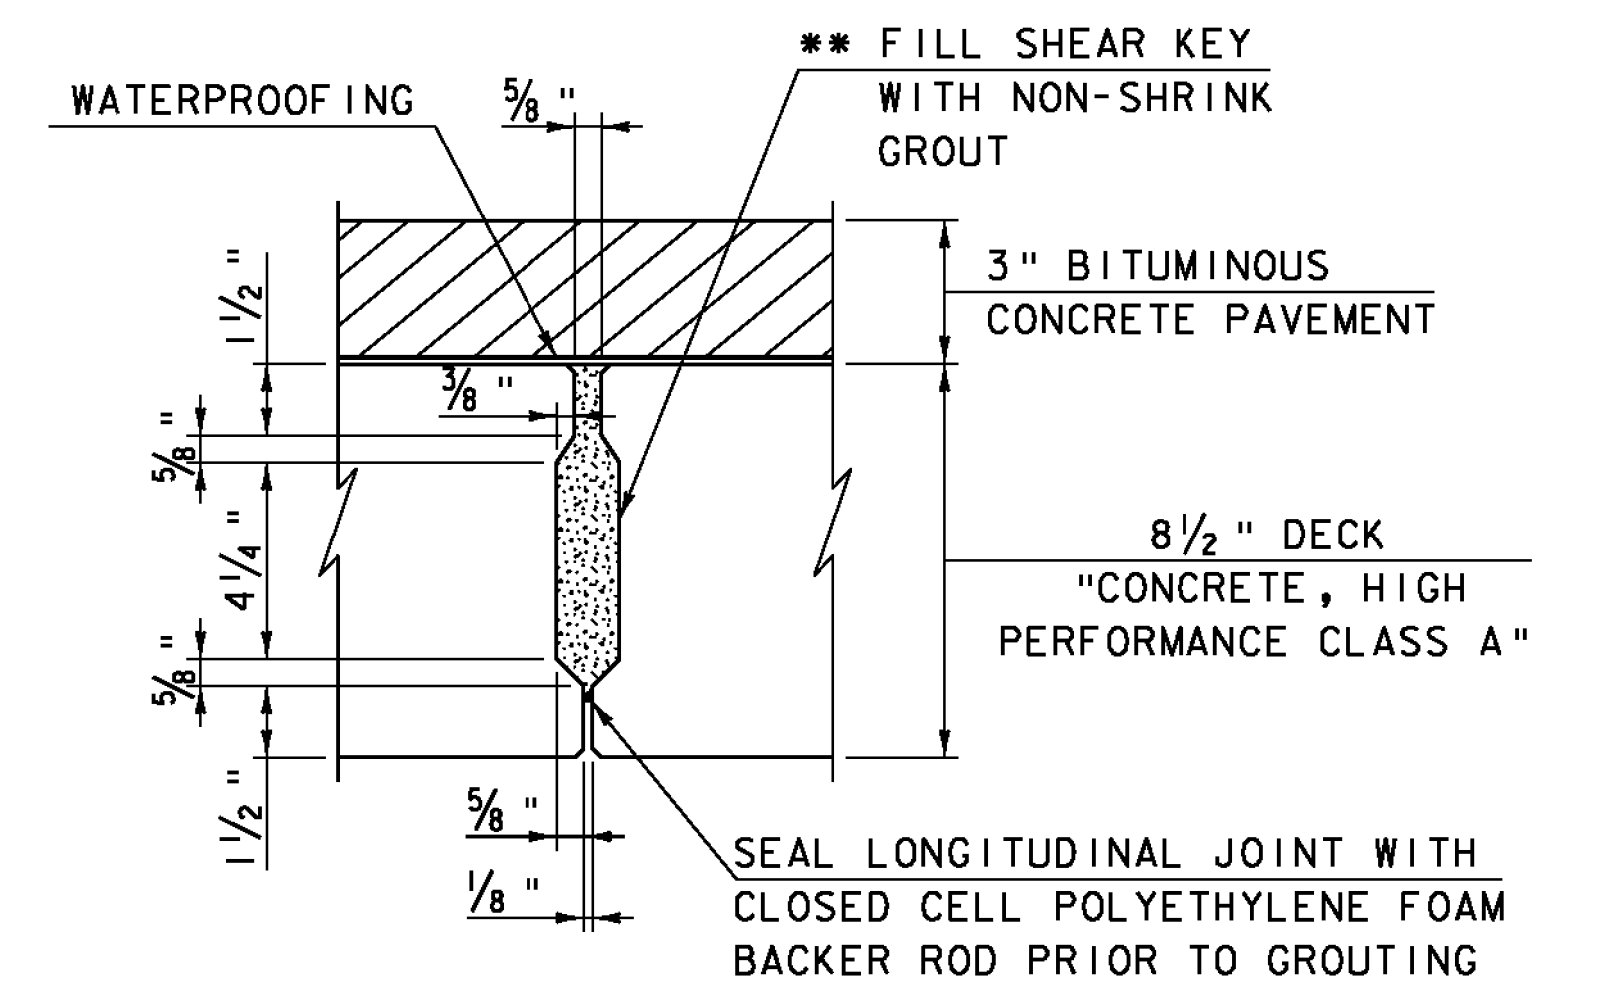


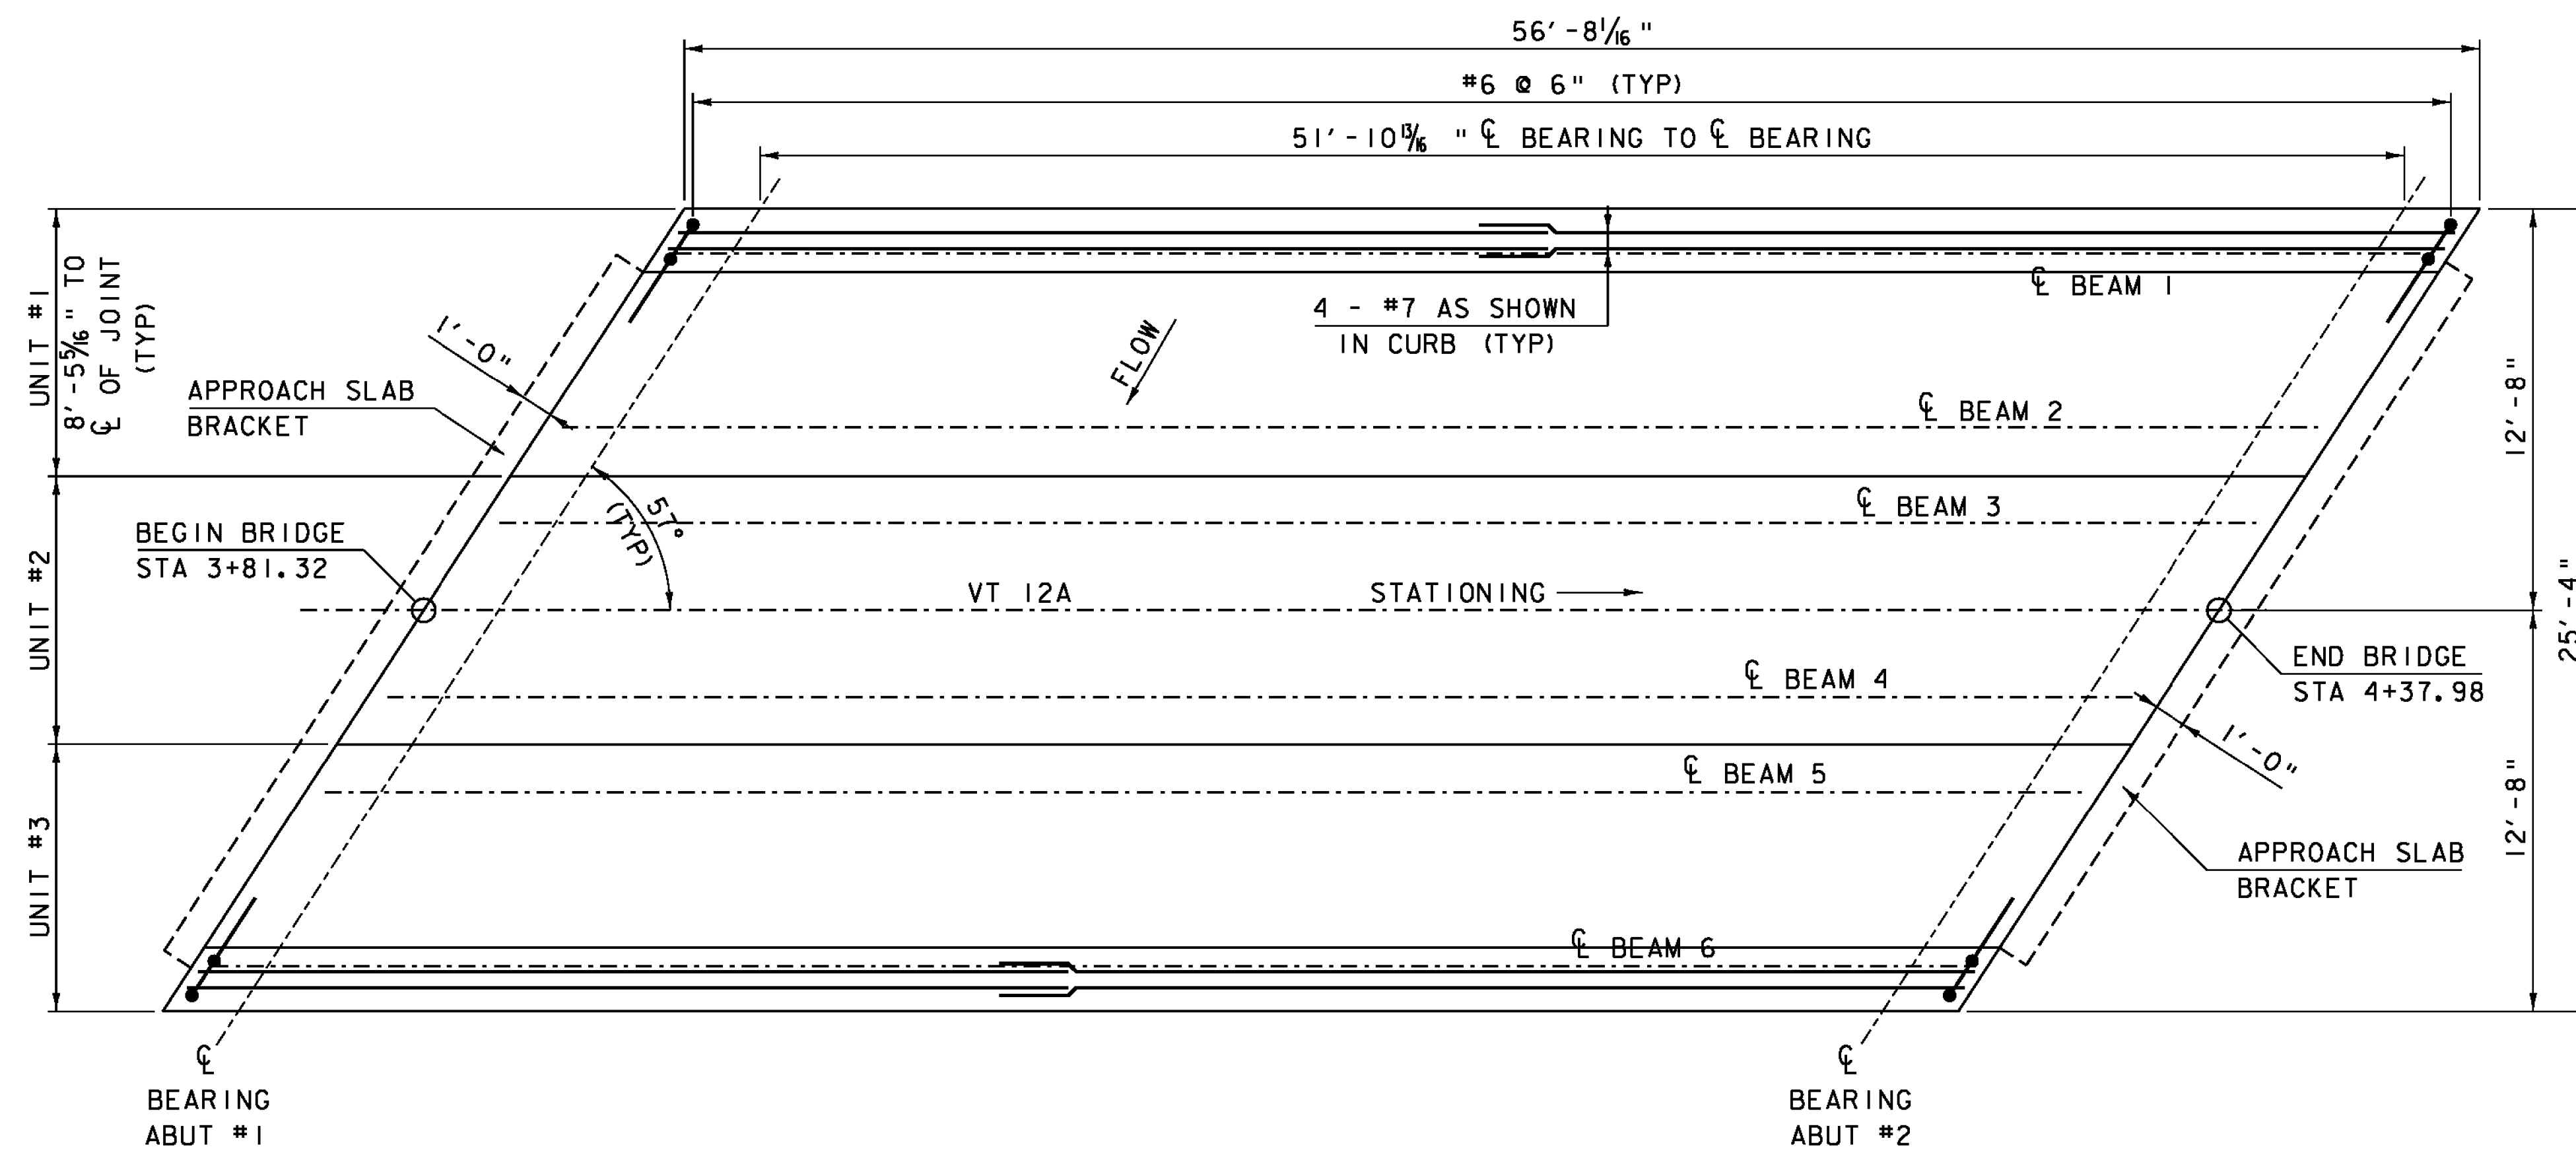


*** NON-SHRINK GROUT AND BACKER ROD SHALL BE CONSIDERED
INCIDENTAL TO PAY ITEM 900.675 "SPECIAL PROVISION
(PRECAST CONCRETE/STEEL COMPOSITE SUPERSTRUCTURE)".

NOTE

1. THE SLABS SHALL BE PLACED AT THE NOMINAL SPACING SHOWN ON THE PLANS WITH A 1/4" WIDE GAP BETWEEN THE SLABS. THE WIDTH OF THE GAP CAN VARY DUE TO TOLERANCES OF THE SLABS.
2. GROUT FOR THE SHEAR KEYS SHALL BE RODDED OR VIBRATED TO ENSURE THAT ALL VOIDS IN THE SHEAR KEYS ARE FILLED.

* CAST IN PLACE DECK

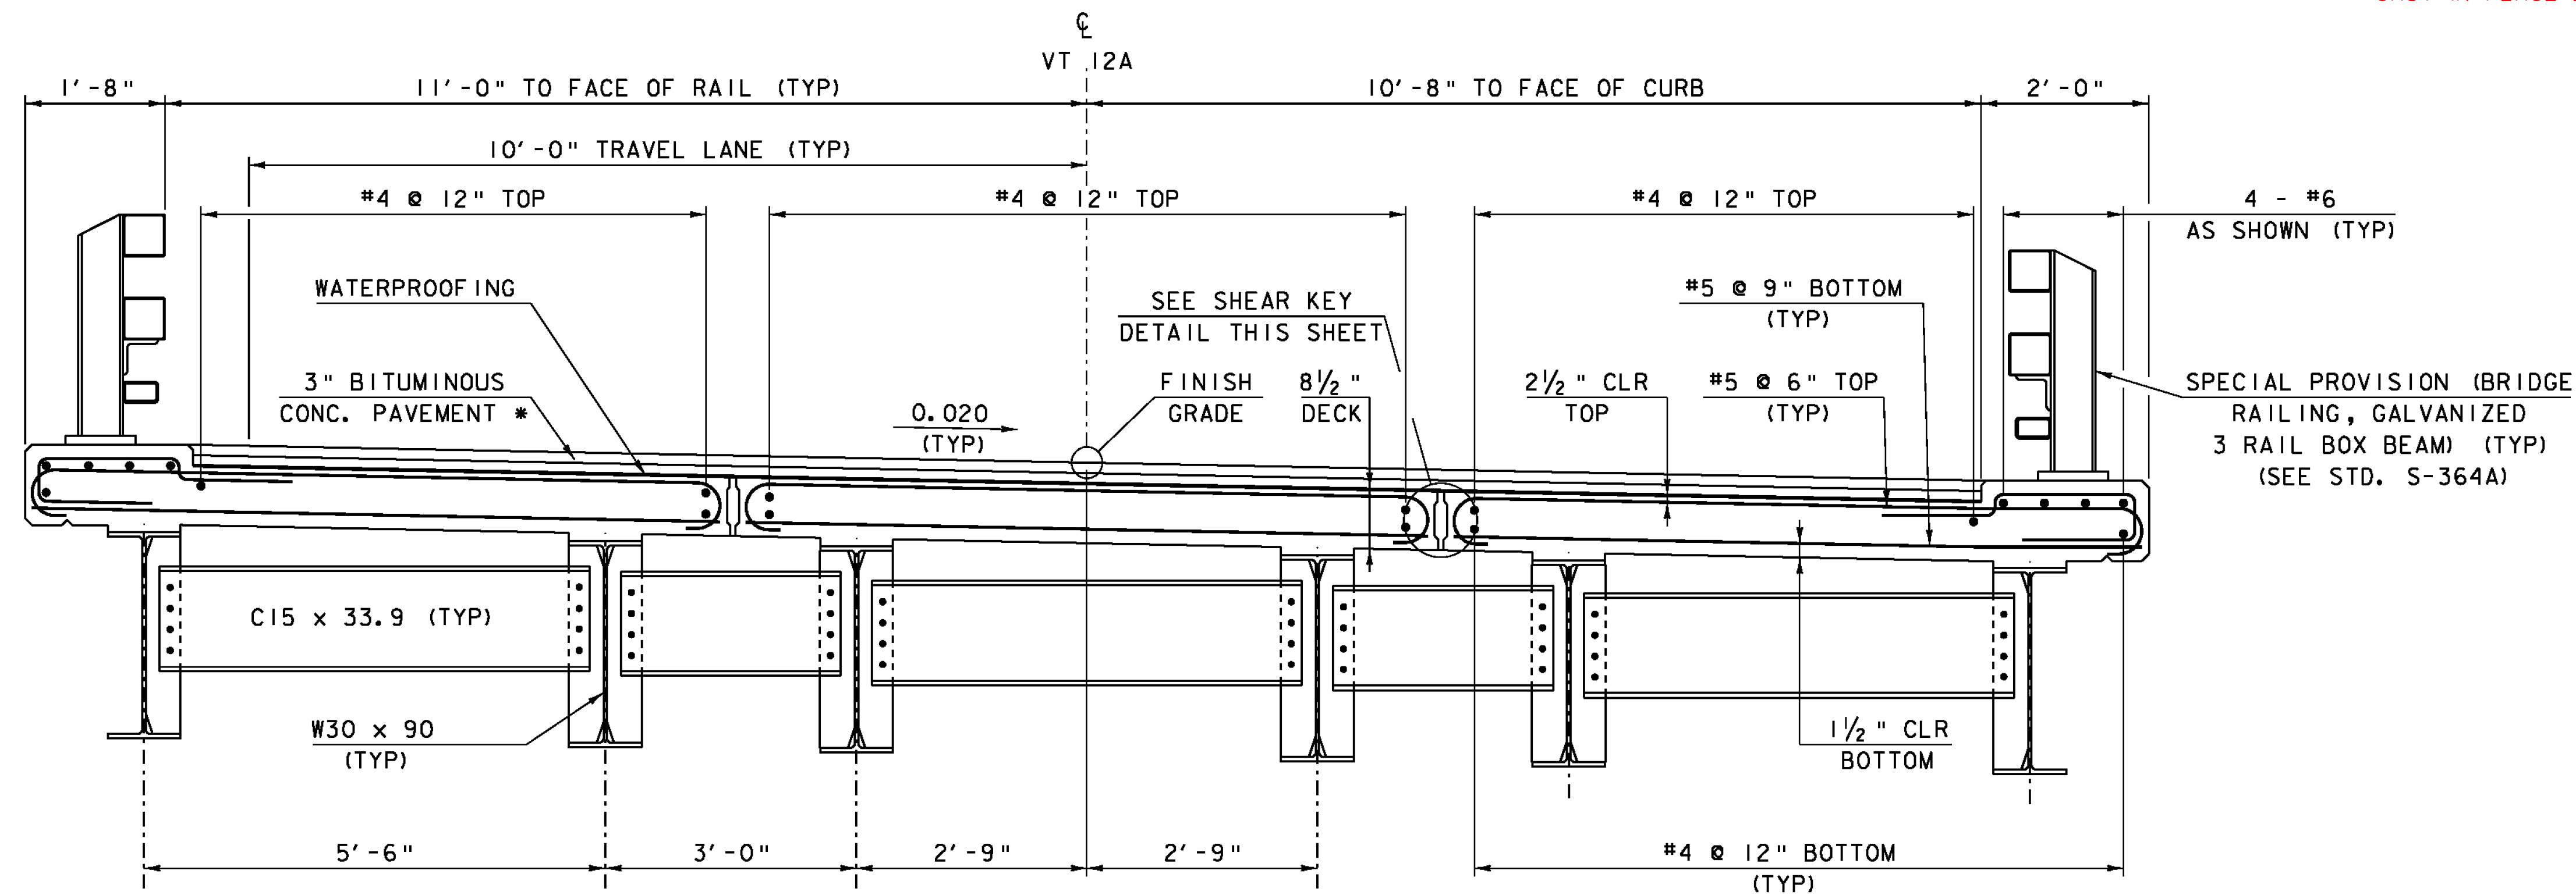

* 1 1/2" TYPE IIIS OVER
1 1/2" TYPE IIIS

NOTE:

NF = NEAR FACE
FF = FAR FACE
EF = EACH FACE
▲ = CUT TO FIT IN FIELD
3" CLEAR, UNLESS OTHERWISE
SPECIFIED ON THE PLANS.
2'-2" BAR LAP UNLESS OTHERWISE
SPECIFIED ON THE PLANS.
ALL REBAR IN PRECAST SUPERSTRUCTURE
SHALL BE EPOXY COATED

PROJECT NAME:	ROXBURY
PROJECT NUMBER:	BHF 0187(8)

FILE NAME: s\0c420sup.dgn	PLOT DATE: 21-SEP-2011
PROJECT LEADER: C.P.WILLIAMS	DRAWN BY: D.D.BEARD
DESIGNED BY: R.S.YOUNG	CHECKED BY: E.Charbonneau
DECK STRUCTURAL DETAILS	SHEET 19 OF 54