

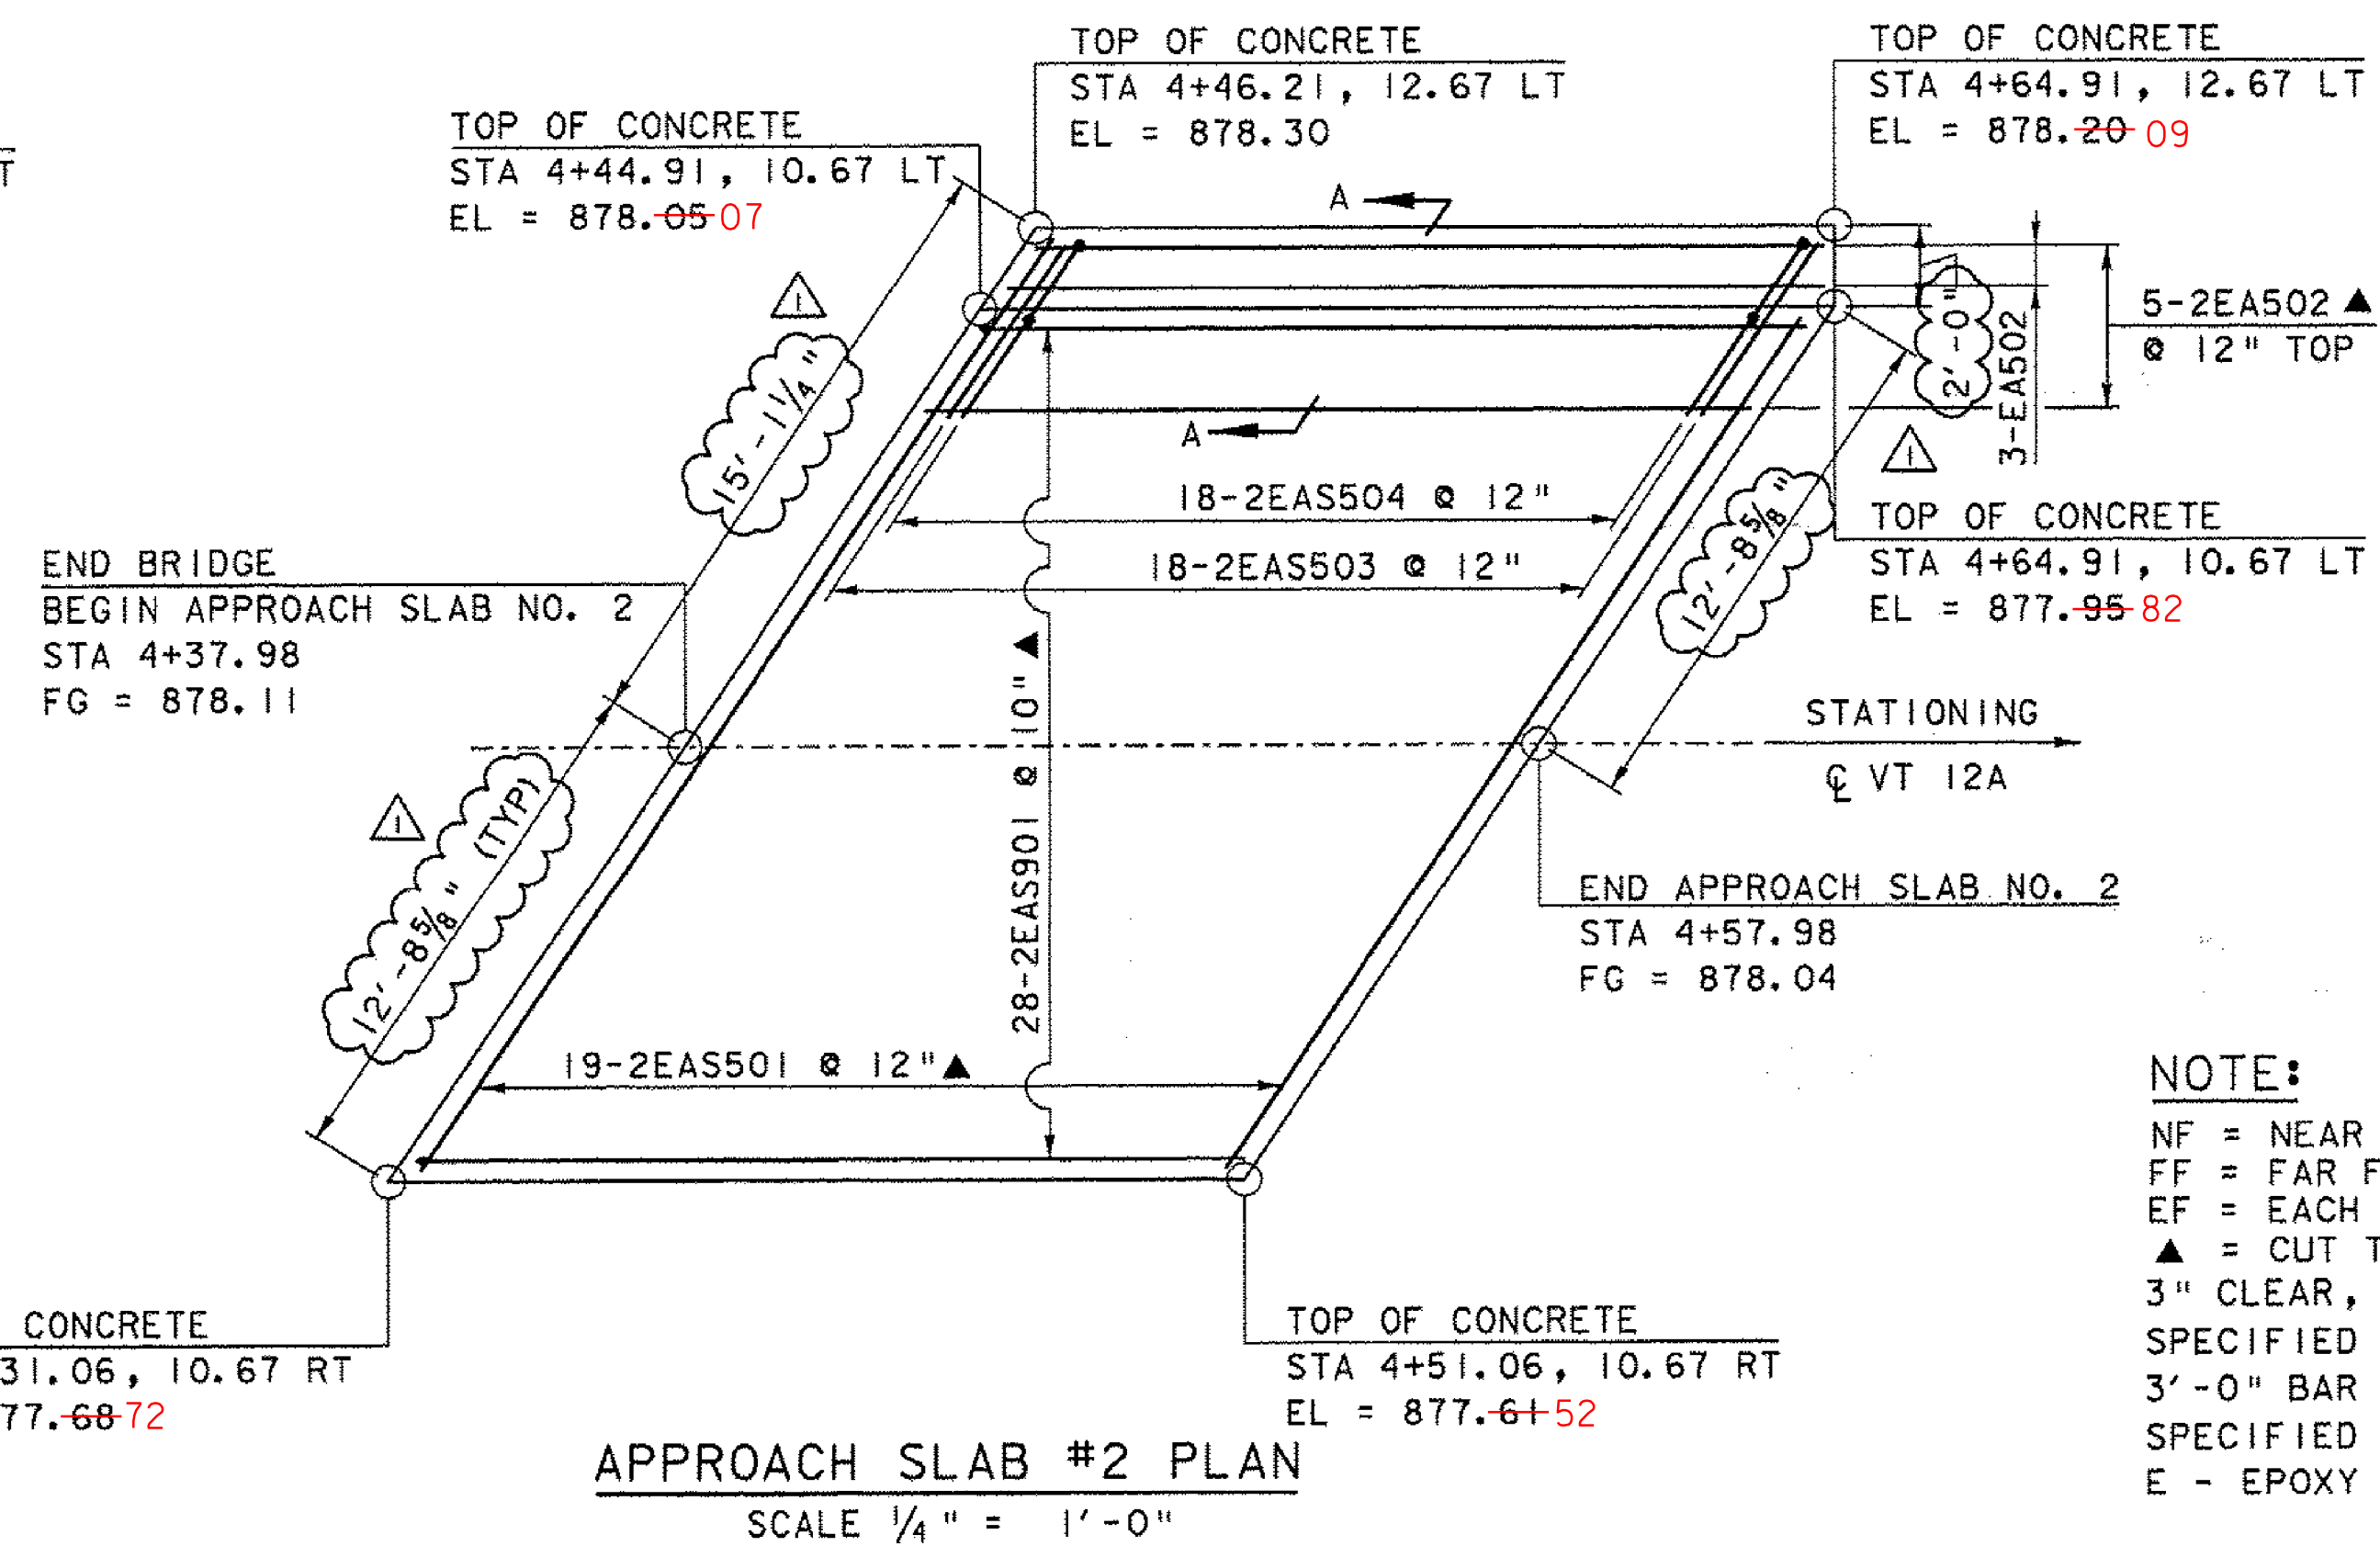
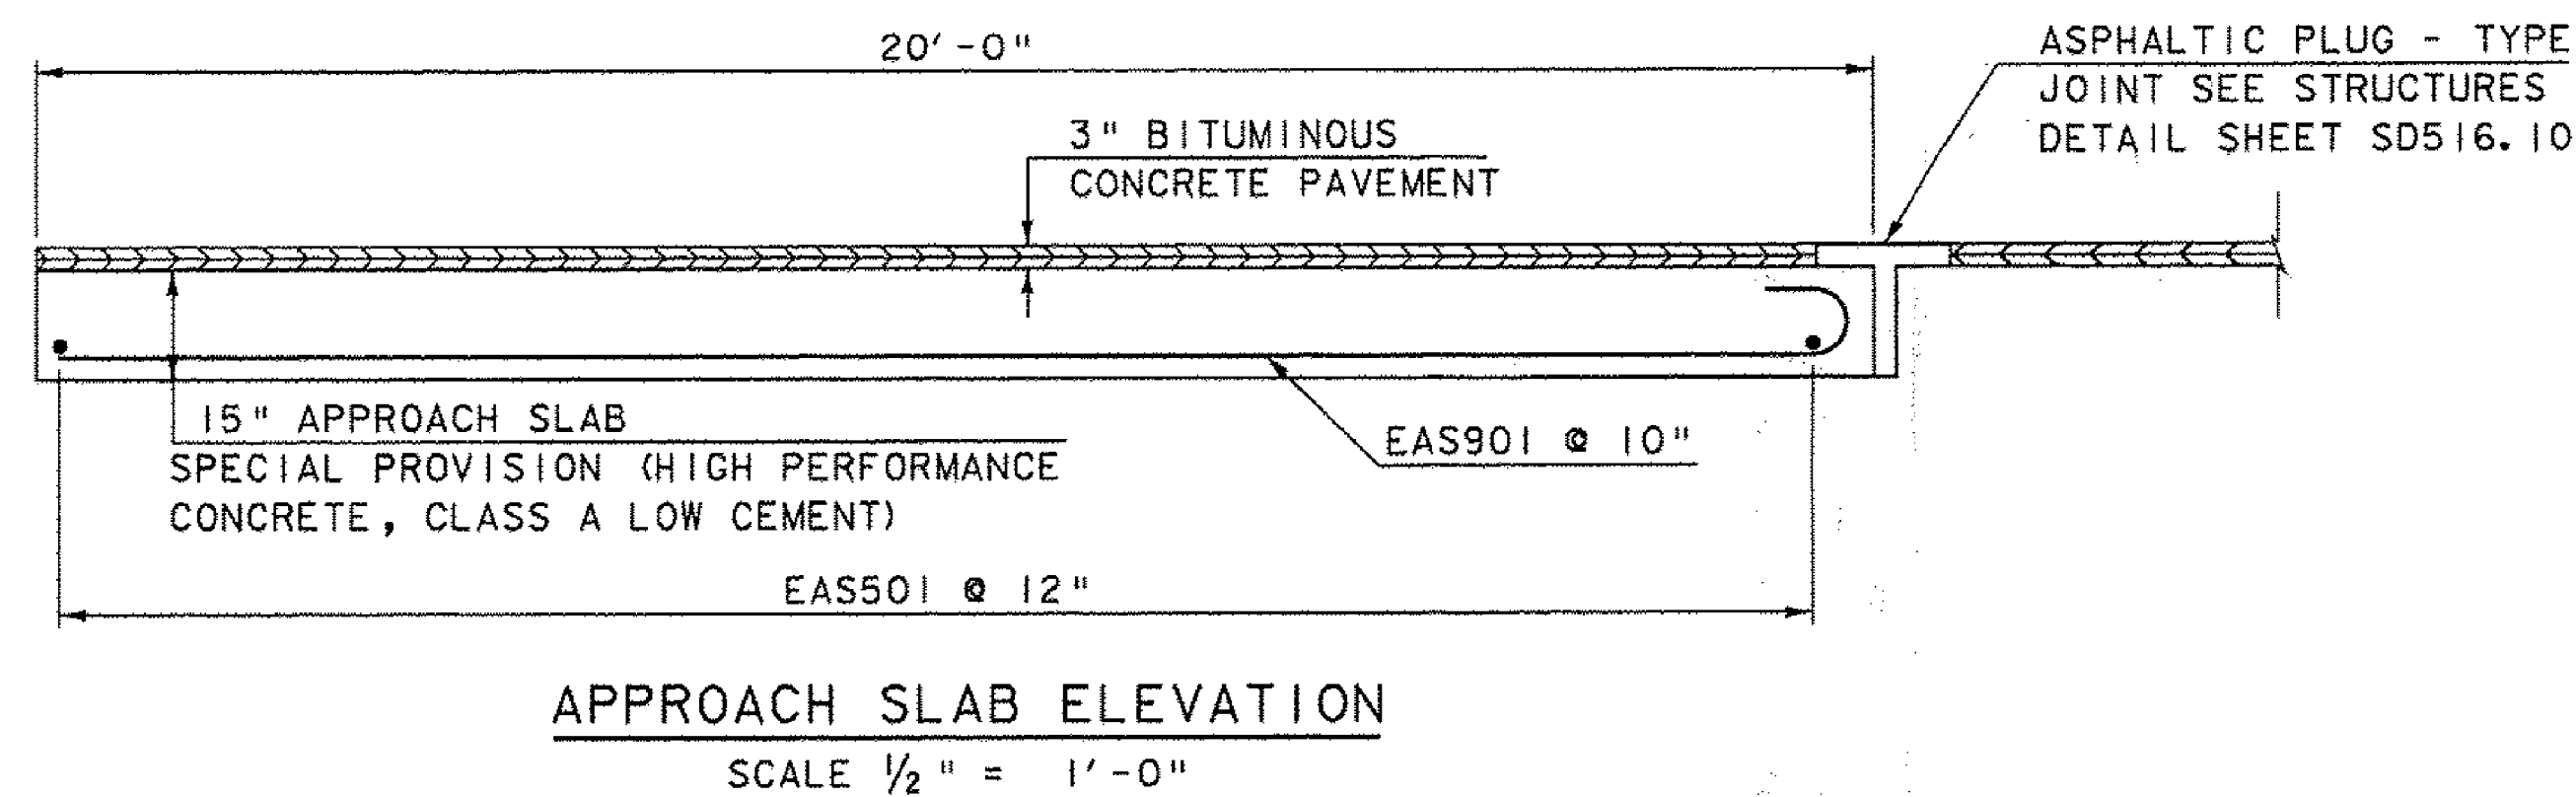


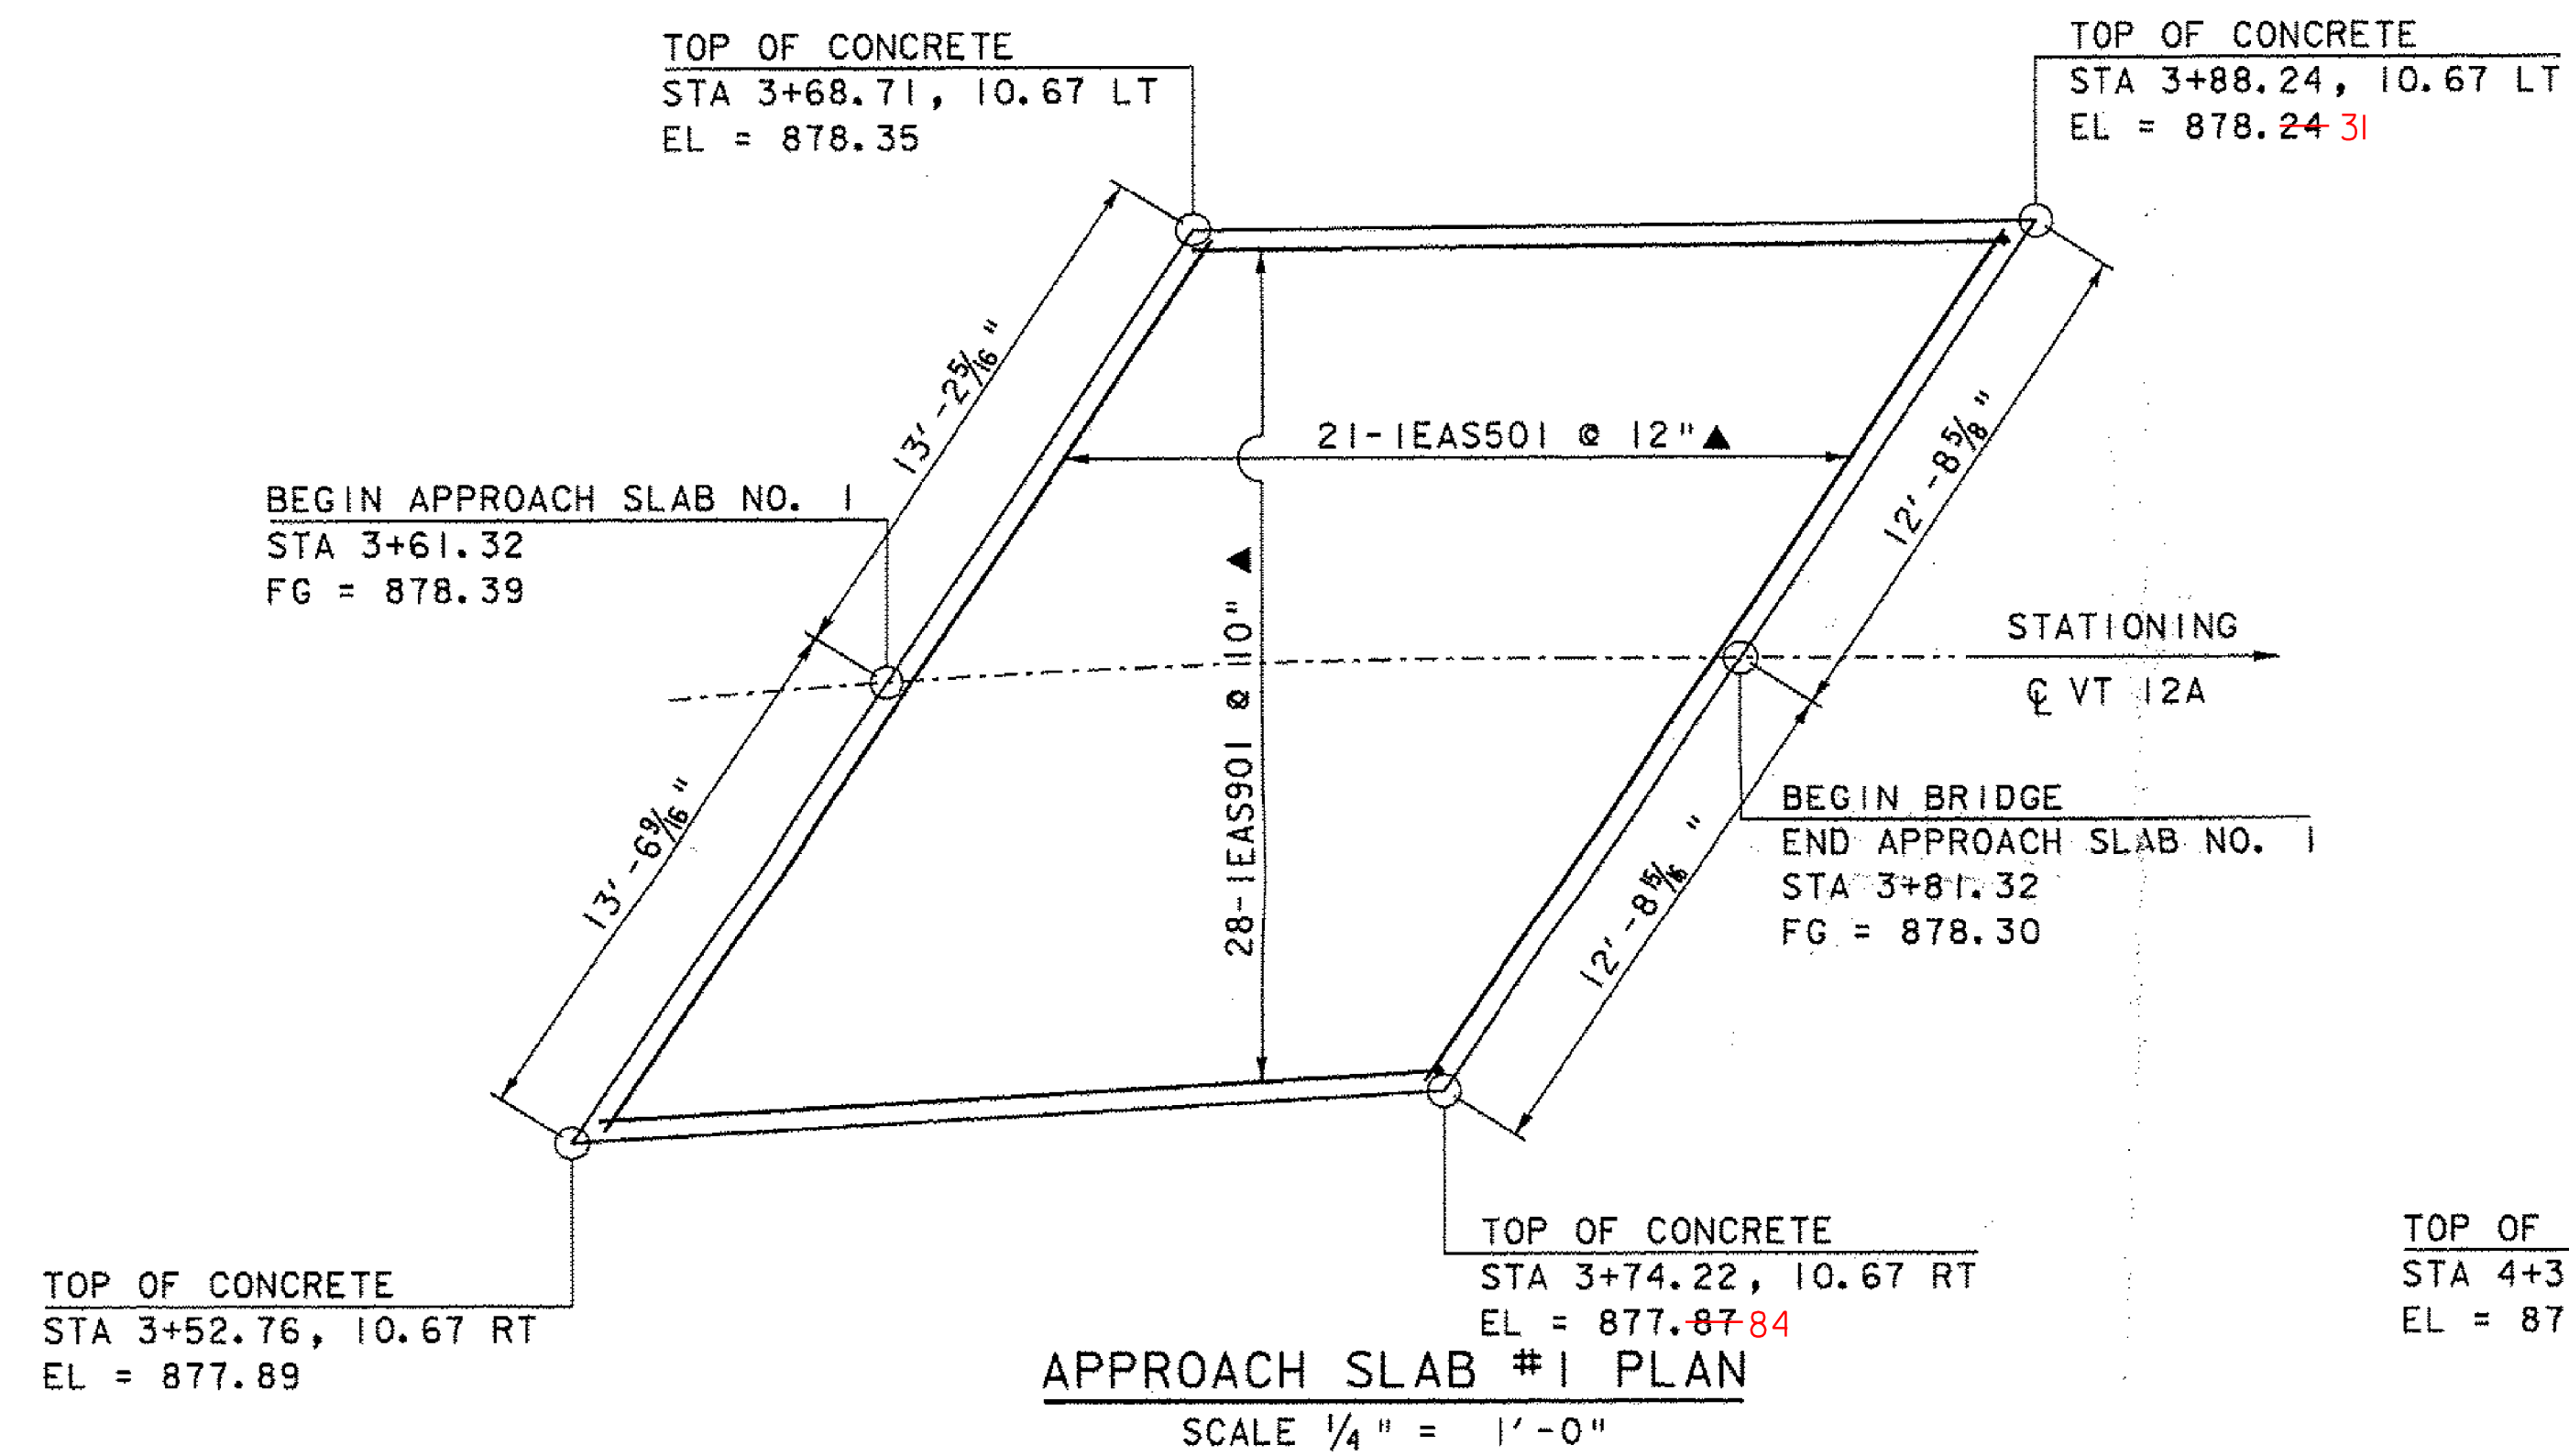

NOTE:
NF = NEAR FACE
FF = FAR FACE
EF = EACH FACE
▲ = CUT TO FIT IN FIELD
3" CLEAR, UNLESS OTHERWISE SPECIFIED ON THE PLANS.
3'-0" BAR LAP UNLESS OTHERWISE SPECIFIED ON THE PLANS.
E - EPOXY

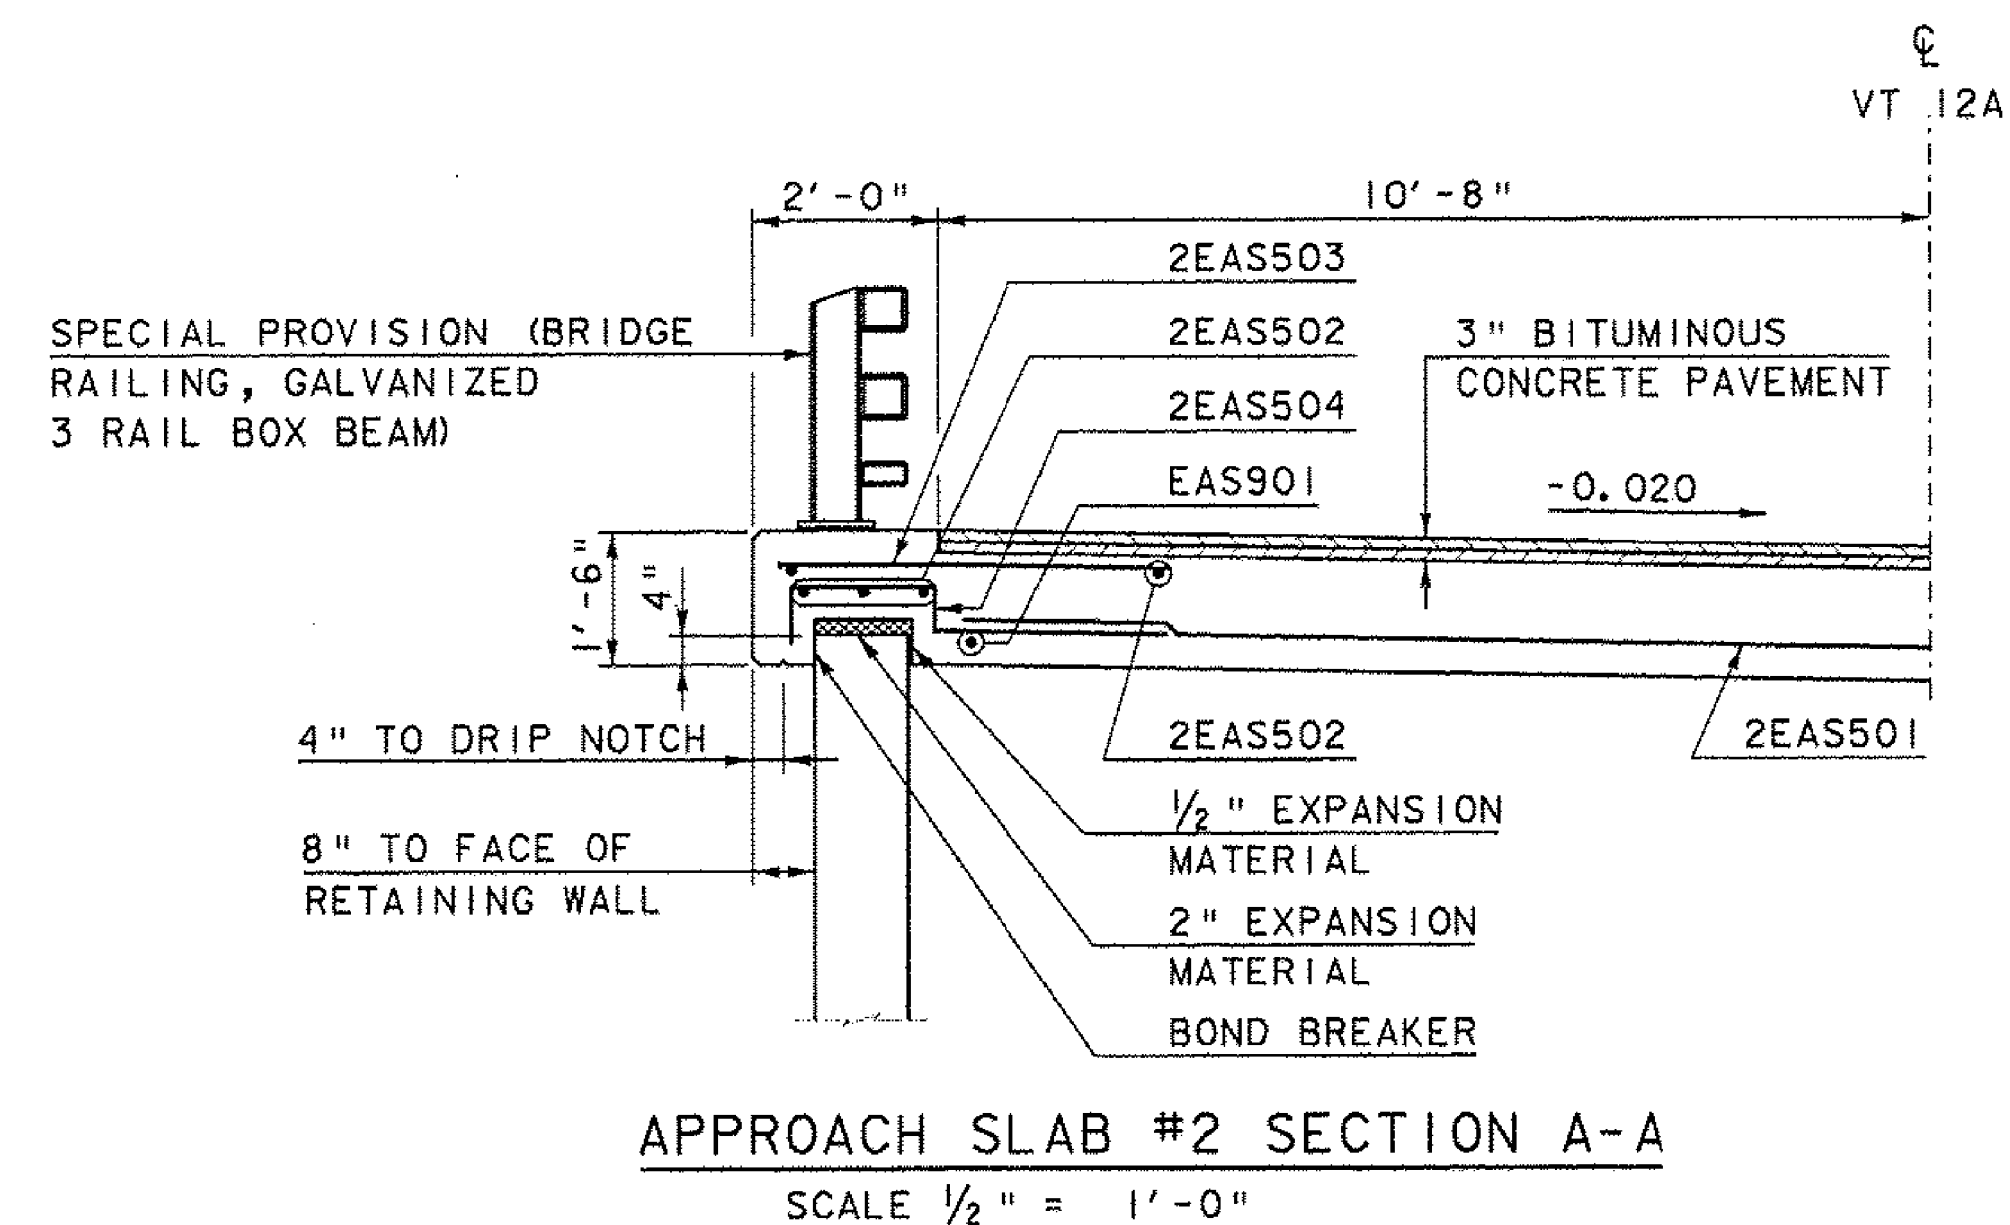

PROJECT NAME: ROXBURY
PROJECT NUMBER: BHF 0187(8)

FILE NAME: s10c420slab>dgn
PROJECT LEADER: C. WILLIAMS
DESIGNED BY: R. YOUNG
APPROACH SLAB DETAILS

PLOT DATE: 07-NOV-2011
DRAWN BY: J. SALVATORI
CHECKED BY: E. CHARBONNEAU
SHEET 17 OF 38 54

REVISION	DATE	DESCRIPTION	BY
1	11-7-2011	DIMENSION APPROACH SLAB WIDTH	MCL