
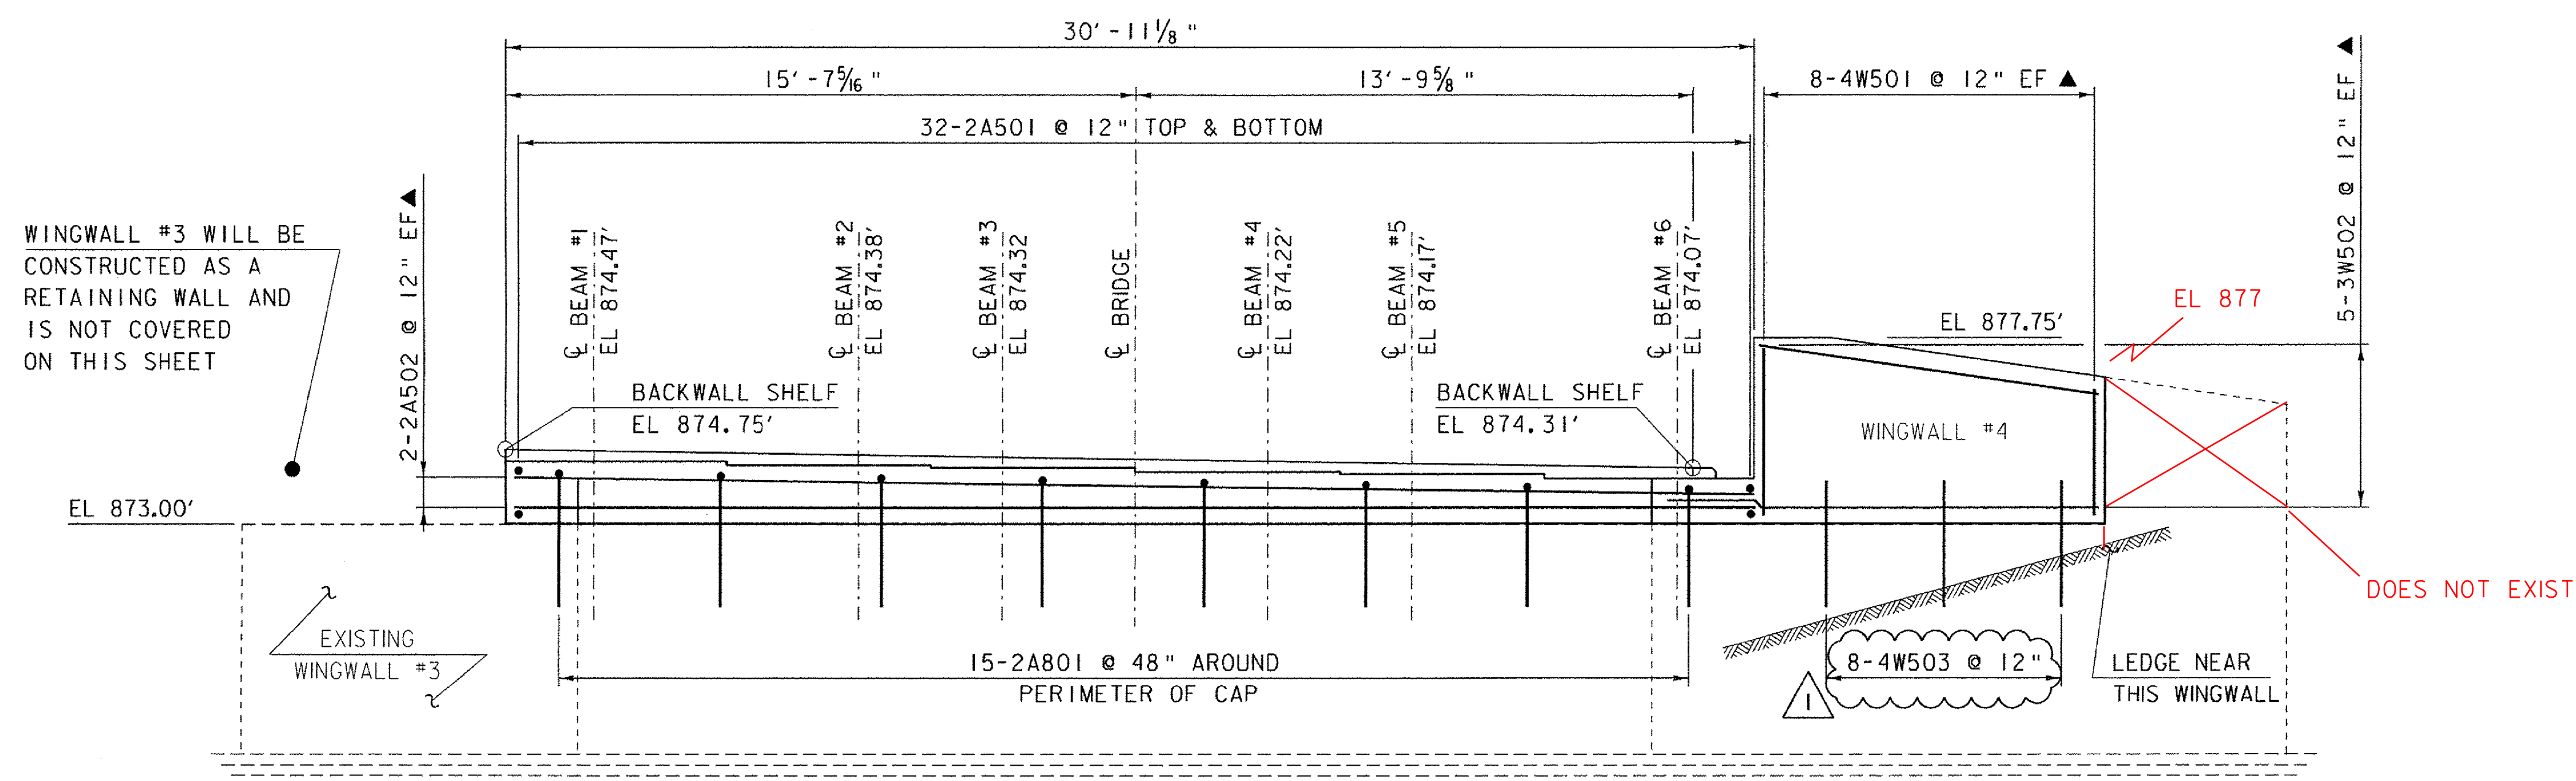
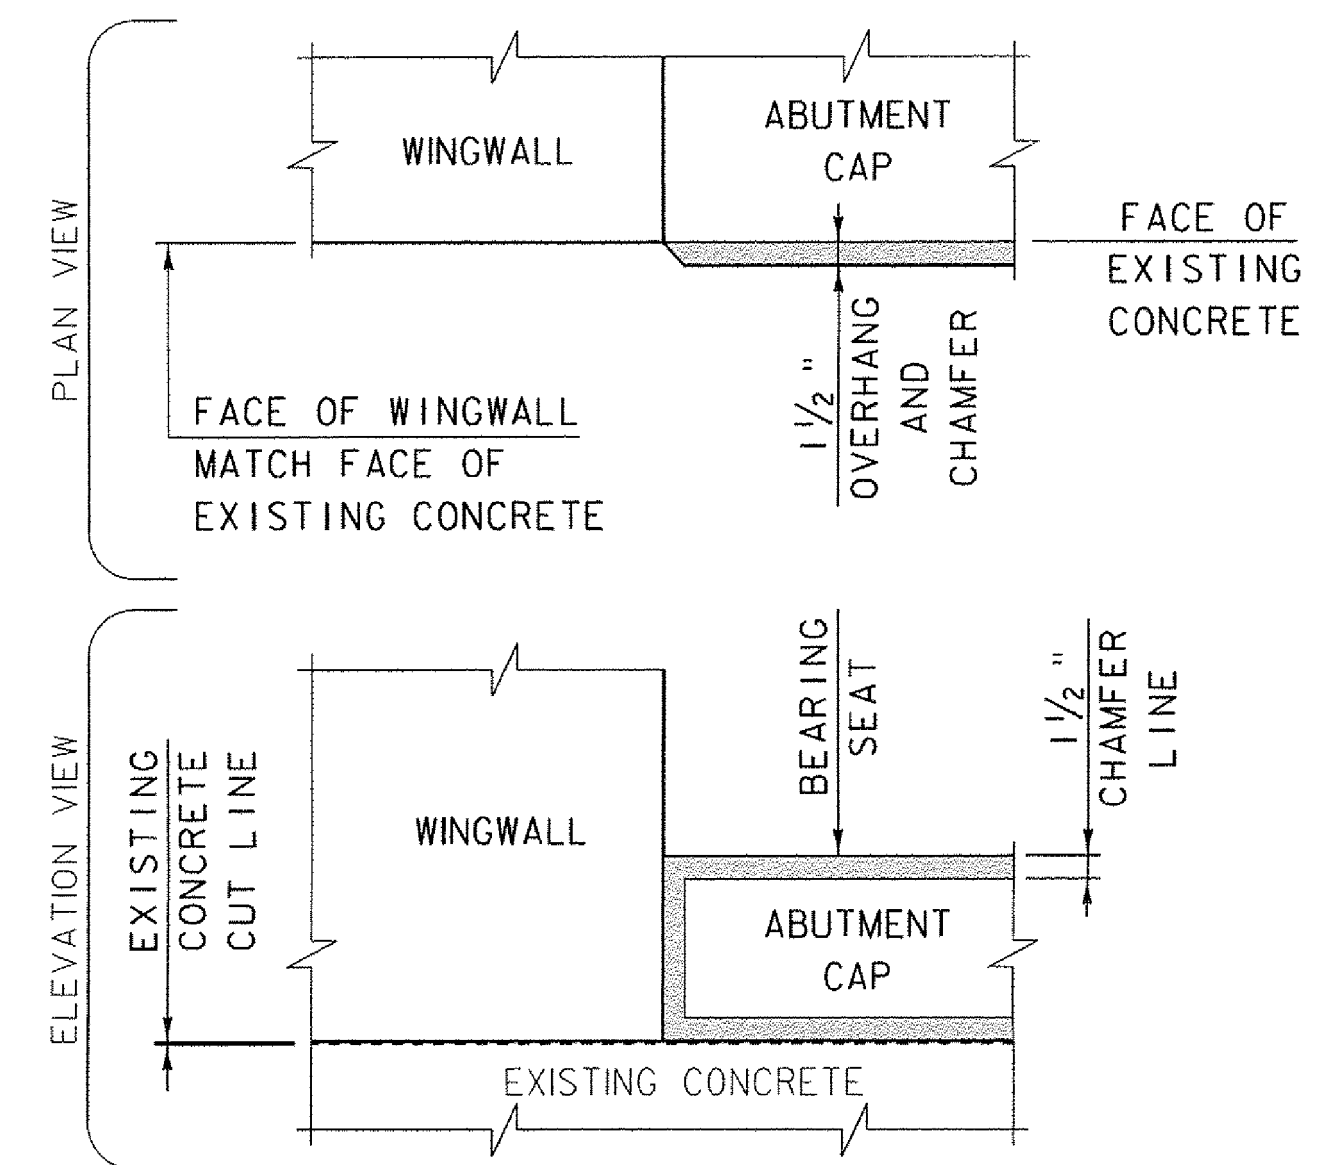


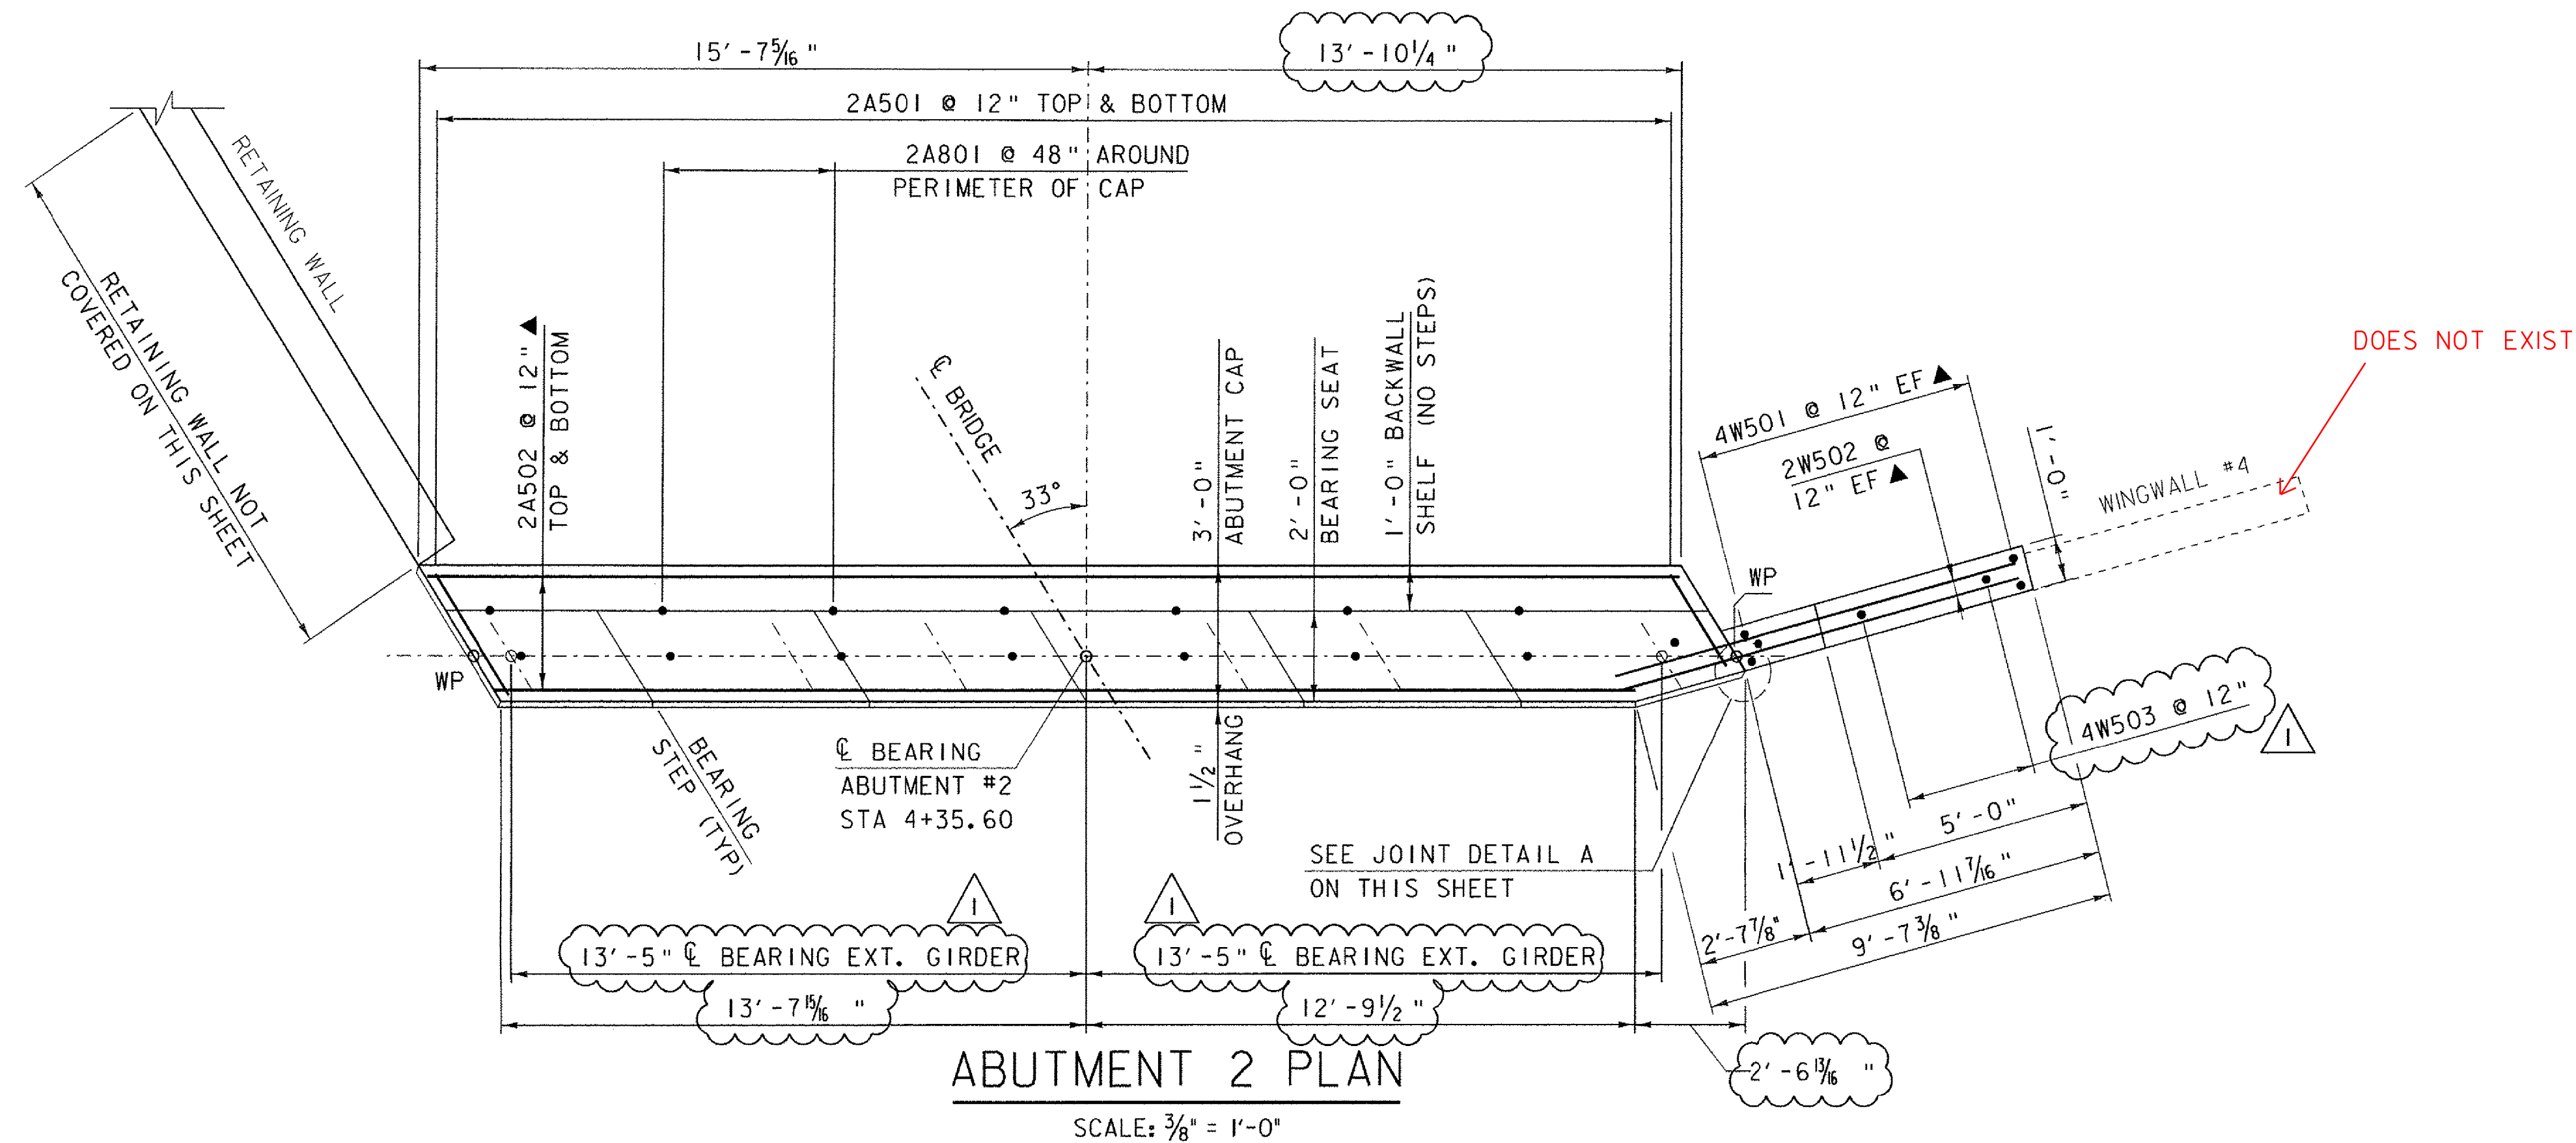

NOTE:

NF = NEAR FACE
FF = FAR FACE
EF = EACH FACE
▲ = CUT TO FIT IN FIELD
3" CLEAR, UNLESS OTHERWISE
SPECIFIED ON THE PLANS.
2'-2" BAR LAP UNLESS OTHERWISE
SPECIFIED ON THE PLANS.

ABUTMENT 2 ELEVATION

SCALE: $\frac{3}{8}" = 1'-0"$

REVISION	DATE	DESCRIPTION	BY
1	11-7-2011	WW REBAR REV. AND DIMENSION CL EXTERIOR BEAM BEARING LOCATION	MCL

PROJECT NAME:	ROXBURY
PROJECT NUMBER:	BHF 0187 (8)

FILE NAME: si0c420sub.dgn	PLOT DATE: 07-NOV-2011
PROJECT LEADER: C.P. WILLIAMS	DRAWN BY: M. LONGSTREET
DESIGNED BY: R.S. YOUNG	CHECKED BY: E.R. CHARBONNEAU
ABUTMENT #2 PLAN & ELEVATION	SHEET 19 OF 35