




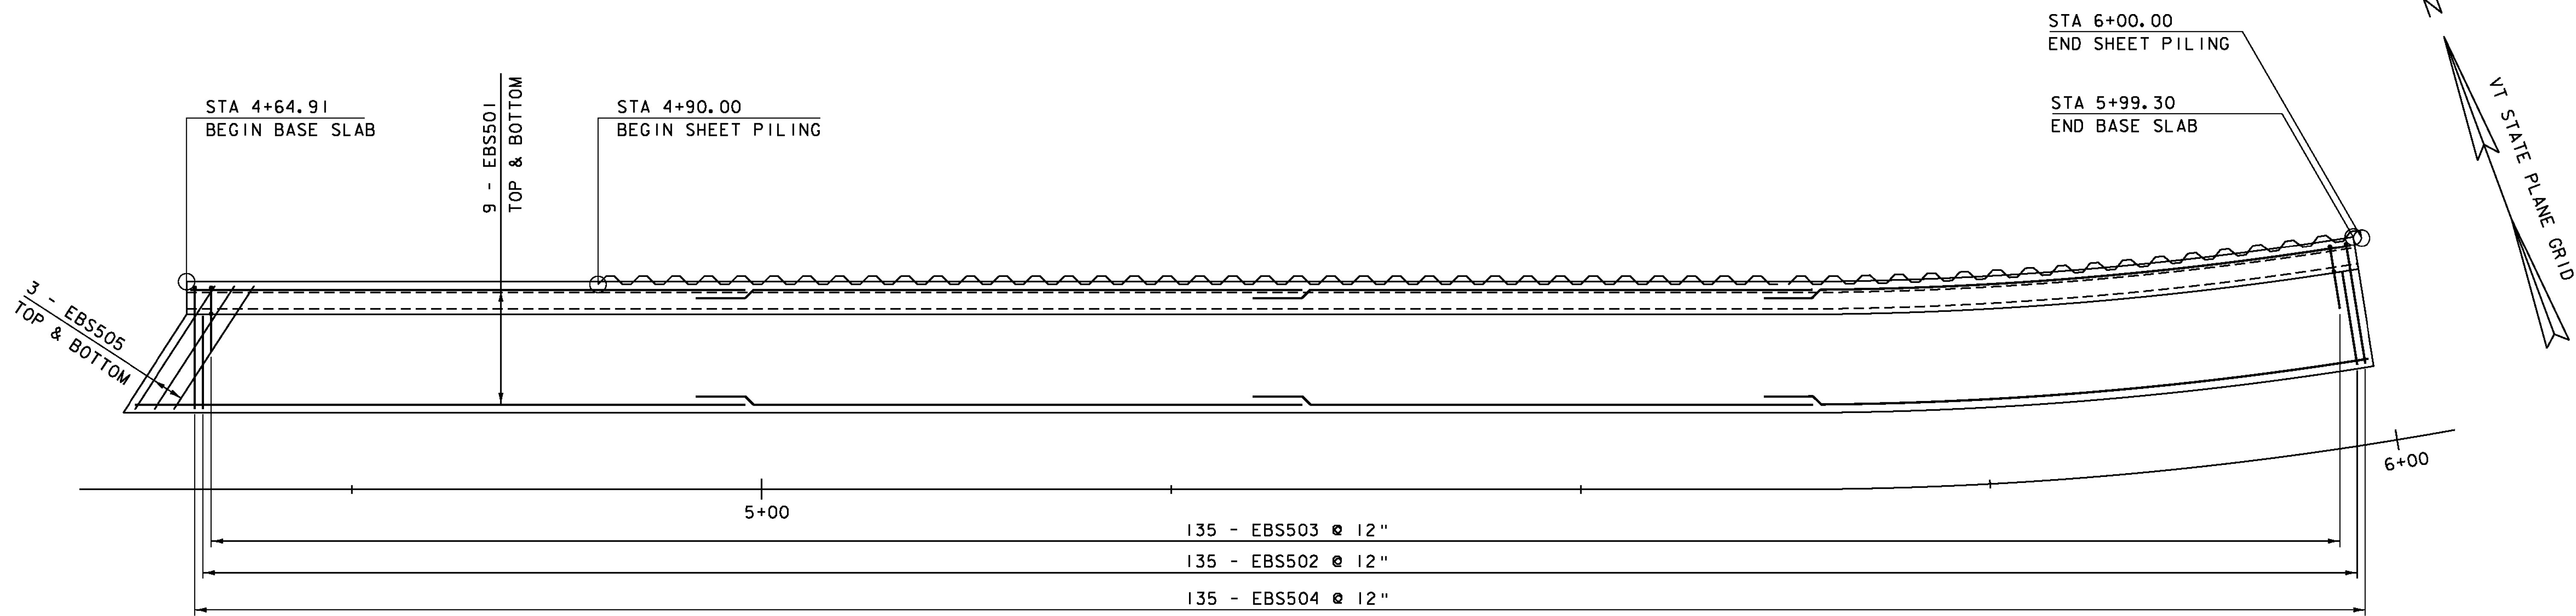

BASE SLAB LAYOUT

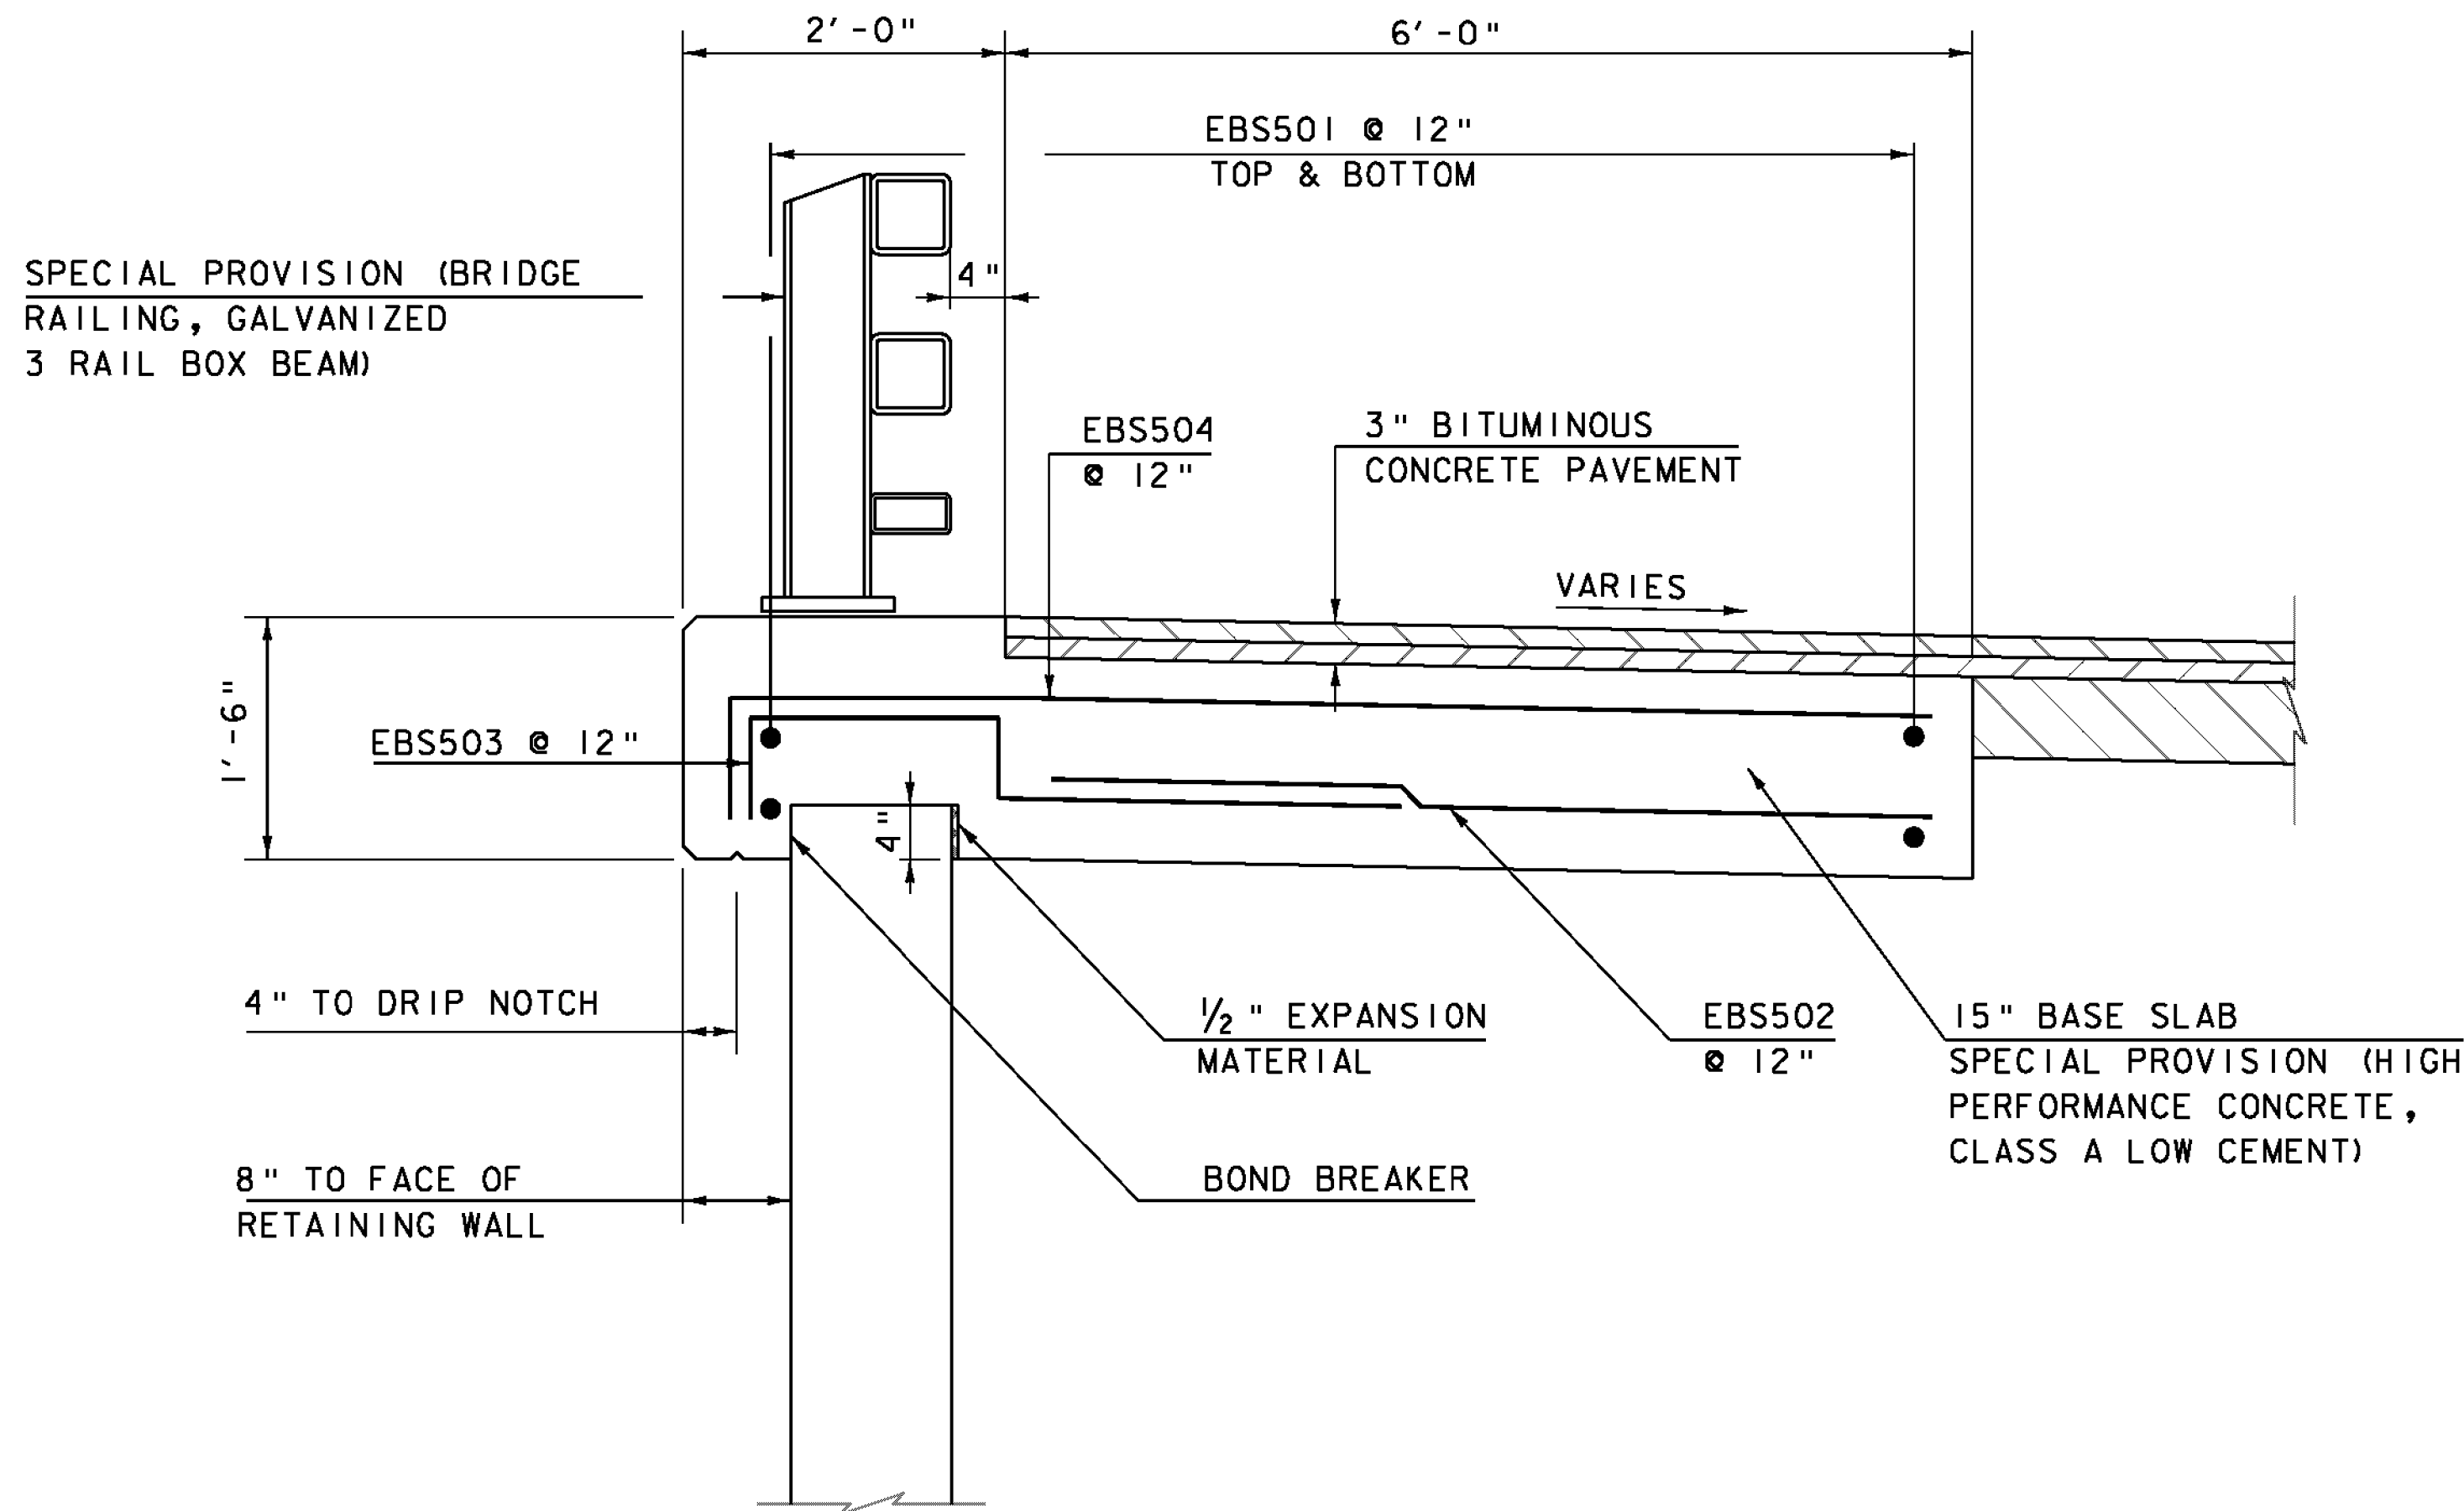

BASE SLAB TYPICAL

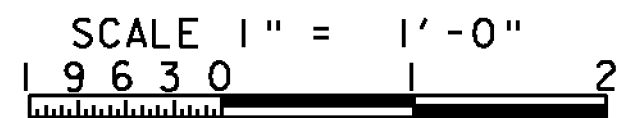

STATION	RETAINING WALL		BASE SLAB	
	ELEVATION	OFFSET	ELEVATION	OFFSET
4+64.91	877.04	12.00 LT	878.20-09	12.67 LT
4+75.00	876.89	12.00 LT	877.09-06	12.67 LT
5+00.00	876.43	12.00 LT	877.59	12.67 LT
5+25.00	875.94	12.00 LT	877.10	12.67 LT
5+50.00	875.60	12.00 LT	876.76-78	12.67 LT
5+75.00	875.41	12.00 LT	876.58-61	12.67 LT
5+99.30	875.35	12.00 LT	876.52-55	12.67 LT

PROJECT NAME: ROXBURY
PROJECT NUMBER: BHF 0187(8)

FILE NAME: sl0c420ret.dgn	PLOT DATE: 21-SEP-2011
PROJECT LEADER: C. WILLIAMS	DRAWN BY: J. SALVATORI
DESIGNED BY: R. YOUNG	CHECKED BY: E. CHARBONNEAU
BASE SLAB LAYOUT & DETAILS	SHEET 26 OF 54