


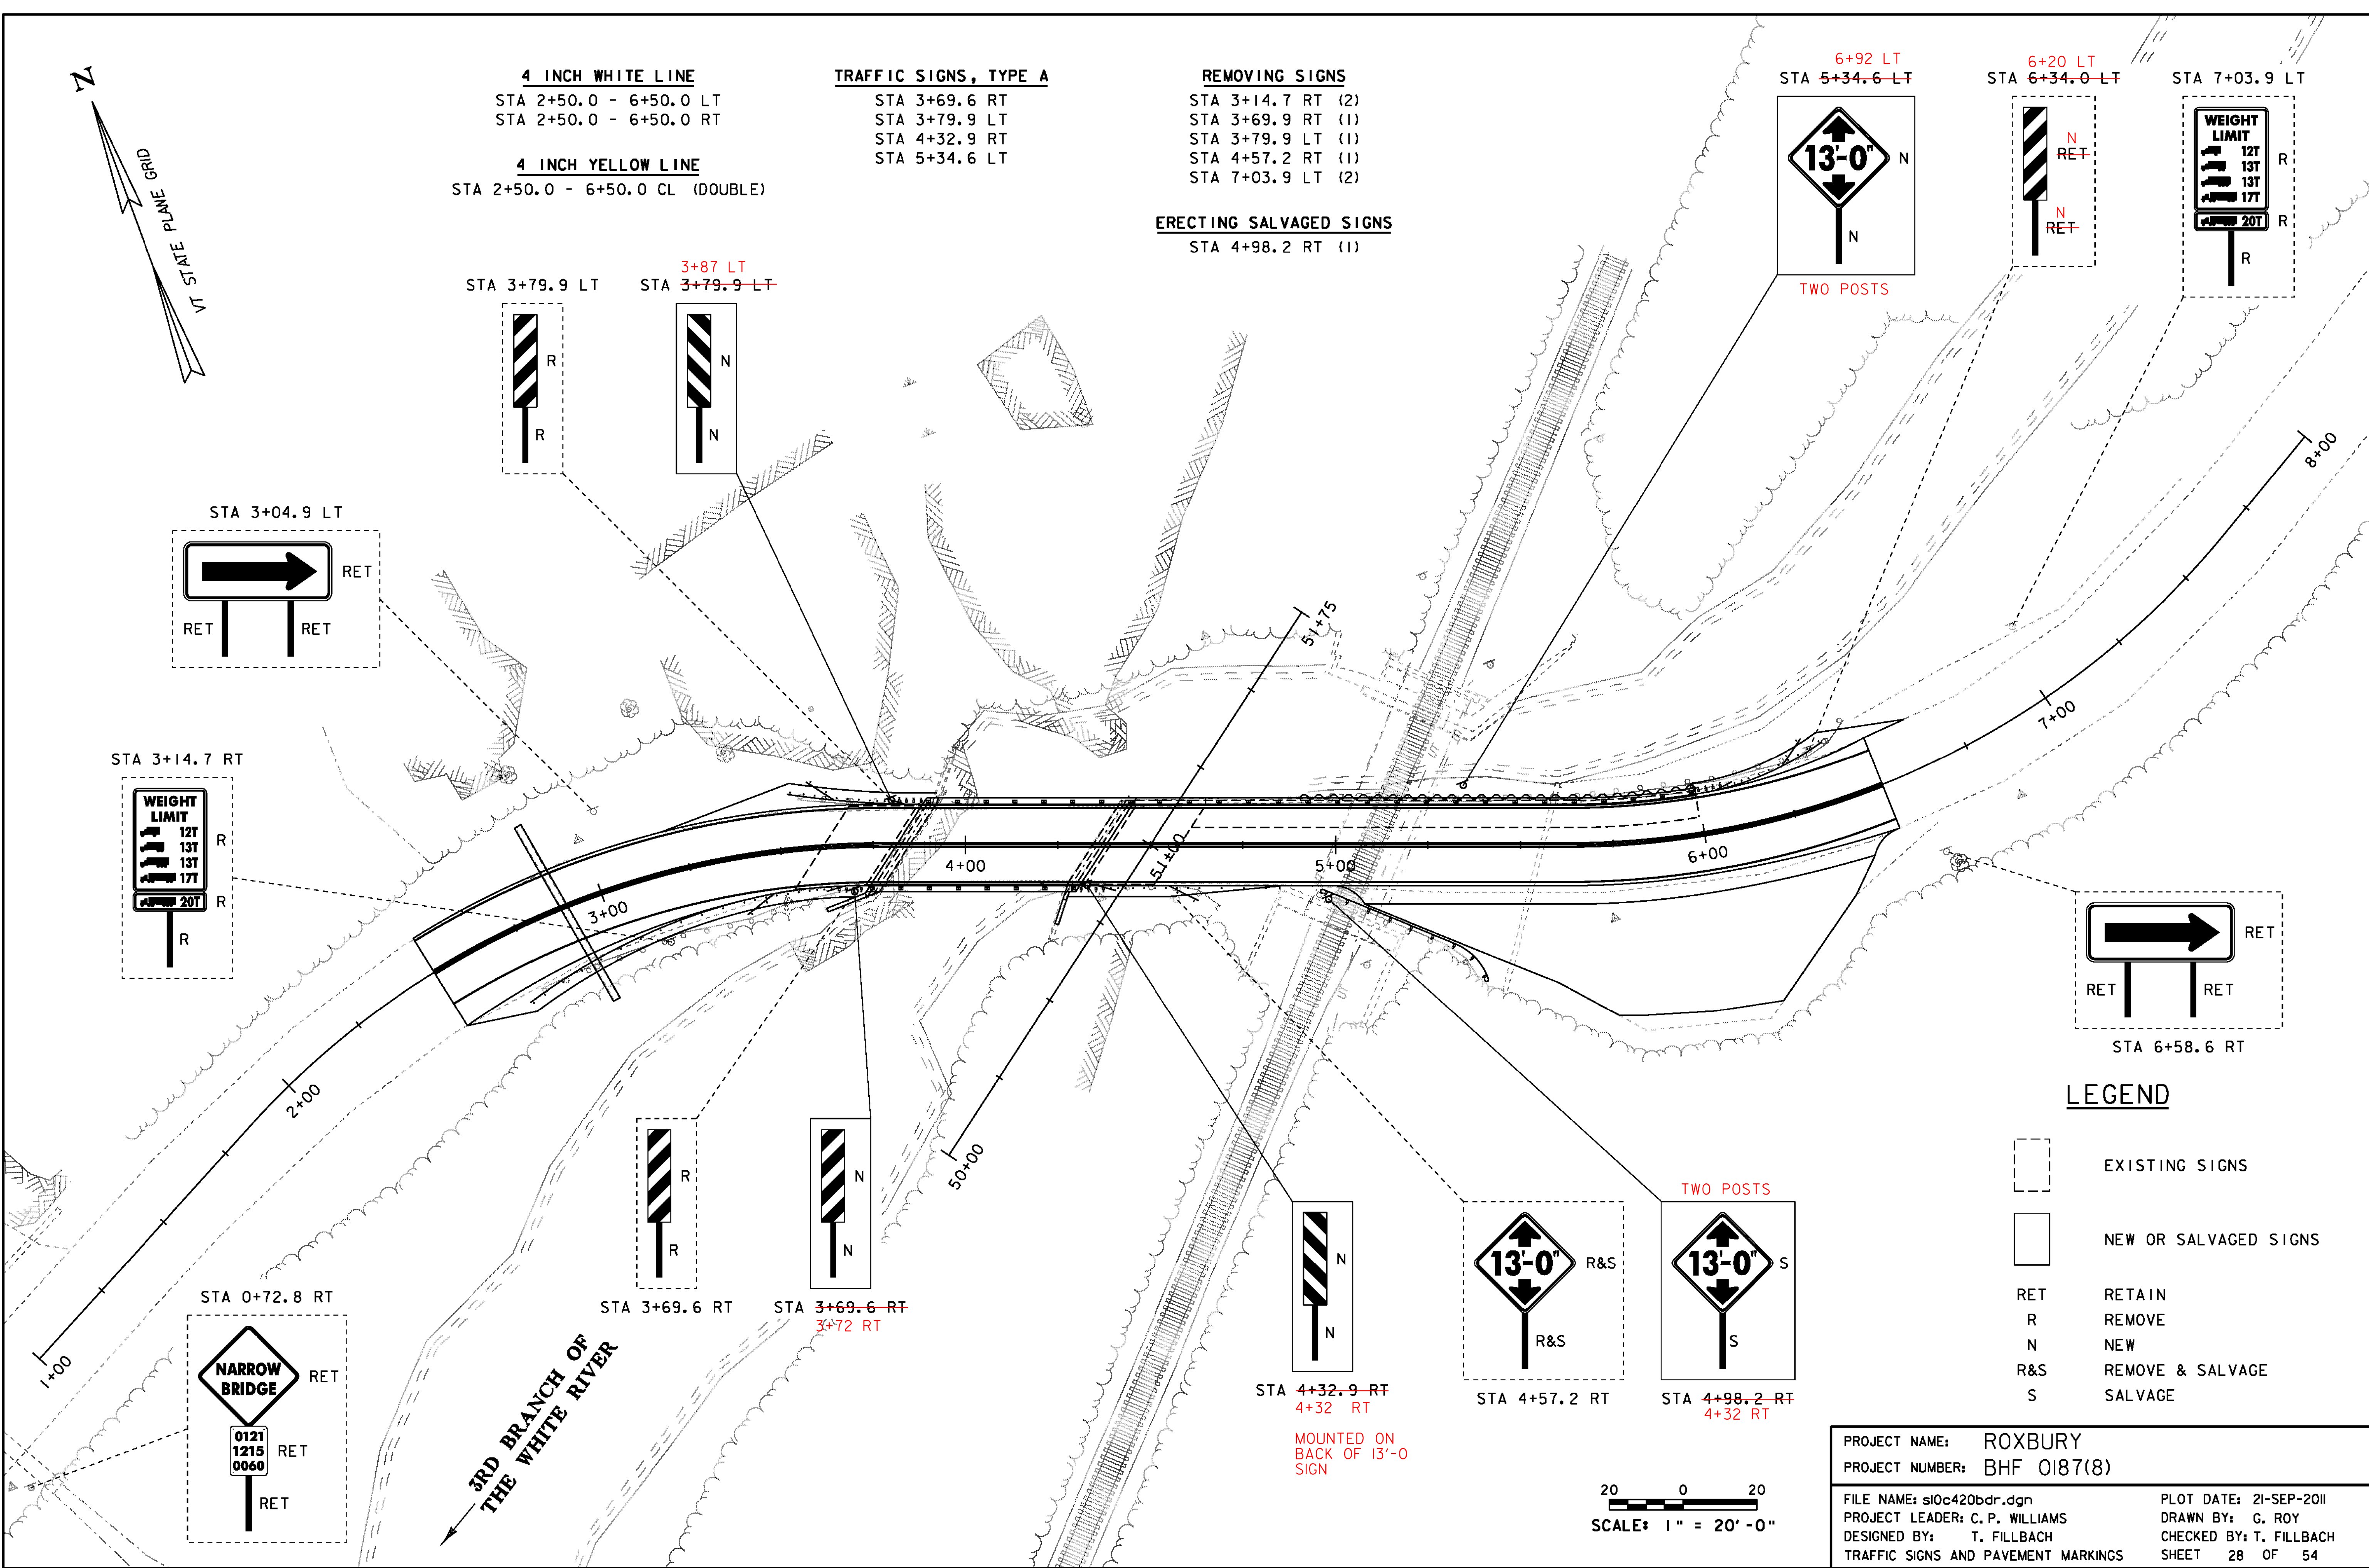

4 INCH WHITE LINE
STA 2+50.0 - 6+50.0 LT
STA 2+50.0 - 6+50.0 RT

4 INCH YELLOW LINE
STA 2+50.0 - 6+50.0 CL (DOUBLE)

TRAFFIC SIGNS, TYPE A
STA 3+69.6 RT
STA 3+79.9 LT
STA 4+32.9 RT
STA 5+34.6 LT

REMOVING SIGNS
STA 3+14.7 RT (2)
STA 3+69.9 RT (1)
STA 3+79.9 LT (1)
STA 4+57.2 RT (1)
STA 7+03.9 LT (2)

ERECTING SALVAGED SIGNS
STA 4+98.2 RT (1)

6+92 LT
STA ~~5+34.6~~ LT
13'-0"
N
N
TWO POSTS

6+20 LT
STA ~~6+34.0~~ LT
N
RET
N
RET

STA 7+03.9 LT
WEIGHT LIMIT
12T
13T
13T
17T
20T
R
R

STA 3+04.9 LT
RET
RET
RET

STA 3+14.7 RT
WEIGHT LIMIT
12T
13T
13T
17T
20T
R
R

RET
RET
RET
STA 6+58.6 RT

LEGEND

	EXISTING SIGNS
	NEW OR SALVAGED SIGNS
RET	RETAIN
R	REMOVE
N	NEW
R&S	REMOVE & SALVAGE
S	SALVAGE

STA 0+72.8 RT
NARROW BRIDGE
0121
1215
0060
RET
RET

STA 3+69.6 RT

STA ~~3+69.6~~ RT
3+72 RT

STA ~~4+32.9~~ RT
4+32 RT
MOUNTED ON
BACK OF 13'-0"
SIGN

13'-0"
R&S
R&S
STA 4+57.2 RT

TWO POSTS
13'-0"
S
S
STA ~~4+98.2~~ RT
4+32 RT

20 0 20
SCALE: 1" = 20'-0"

PROJECT NAME: ROXBURY	PLOT DATE: 21-SEP-2011
PROJECT NUMBER: BHF 0187(8)	DRAWN BY: G. ROY
FILE NAME: sl0c420bdr.dgn	CHECKED BY: T. FILLBACH
PROJECT LEADER: C. P. WILLIAMS	SHEET 28 OF 54
DESIGNED BY: T. FILLBACH	
TRAFFIC SIGNS AND PAVEMENT MARKINGS	