




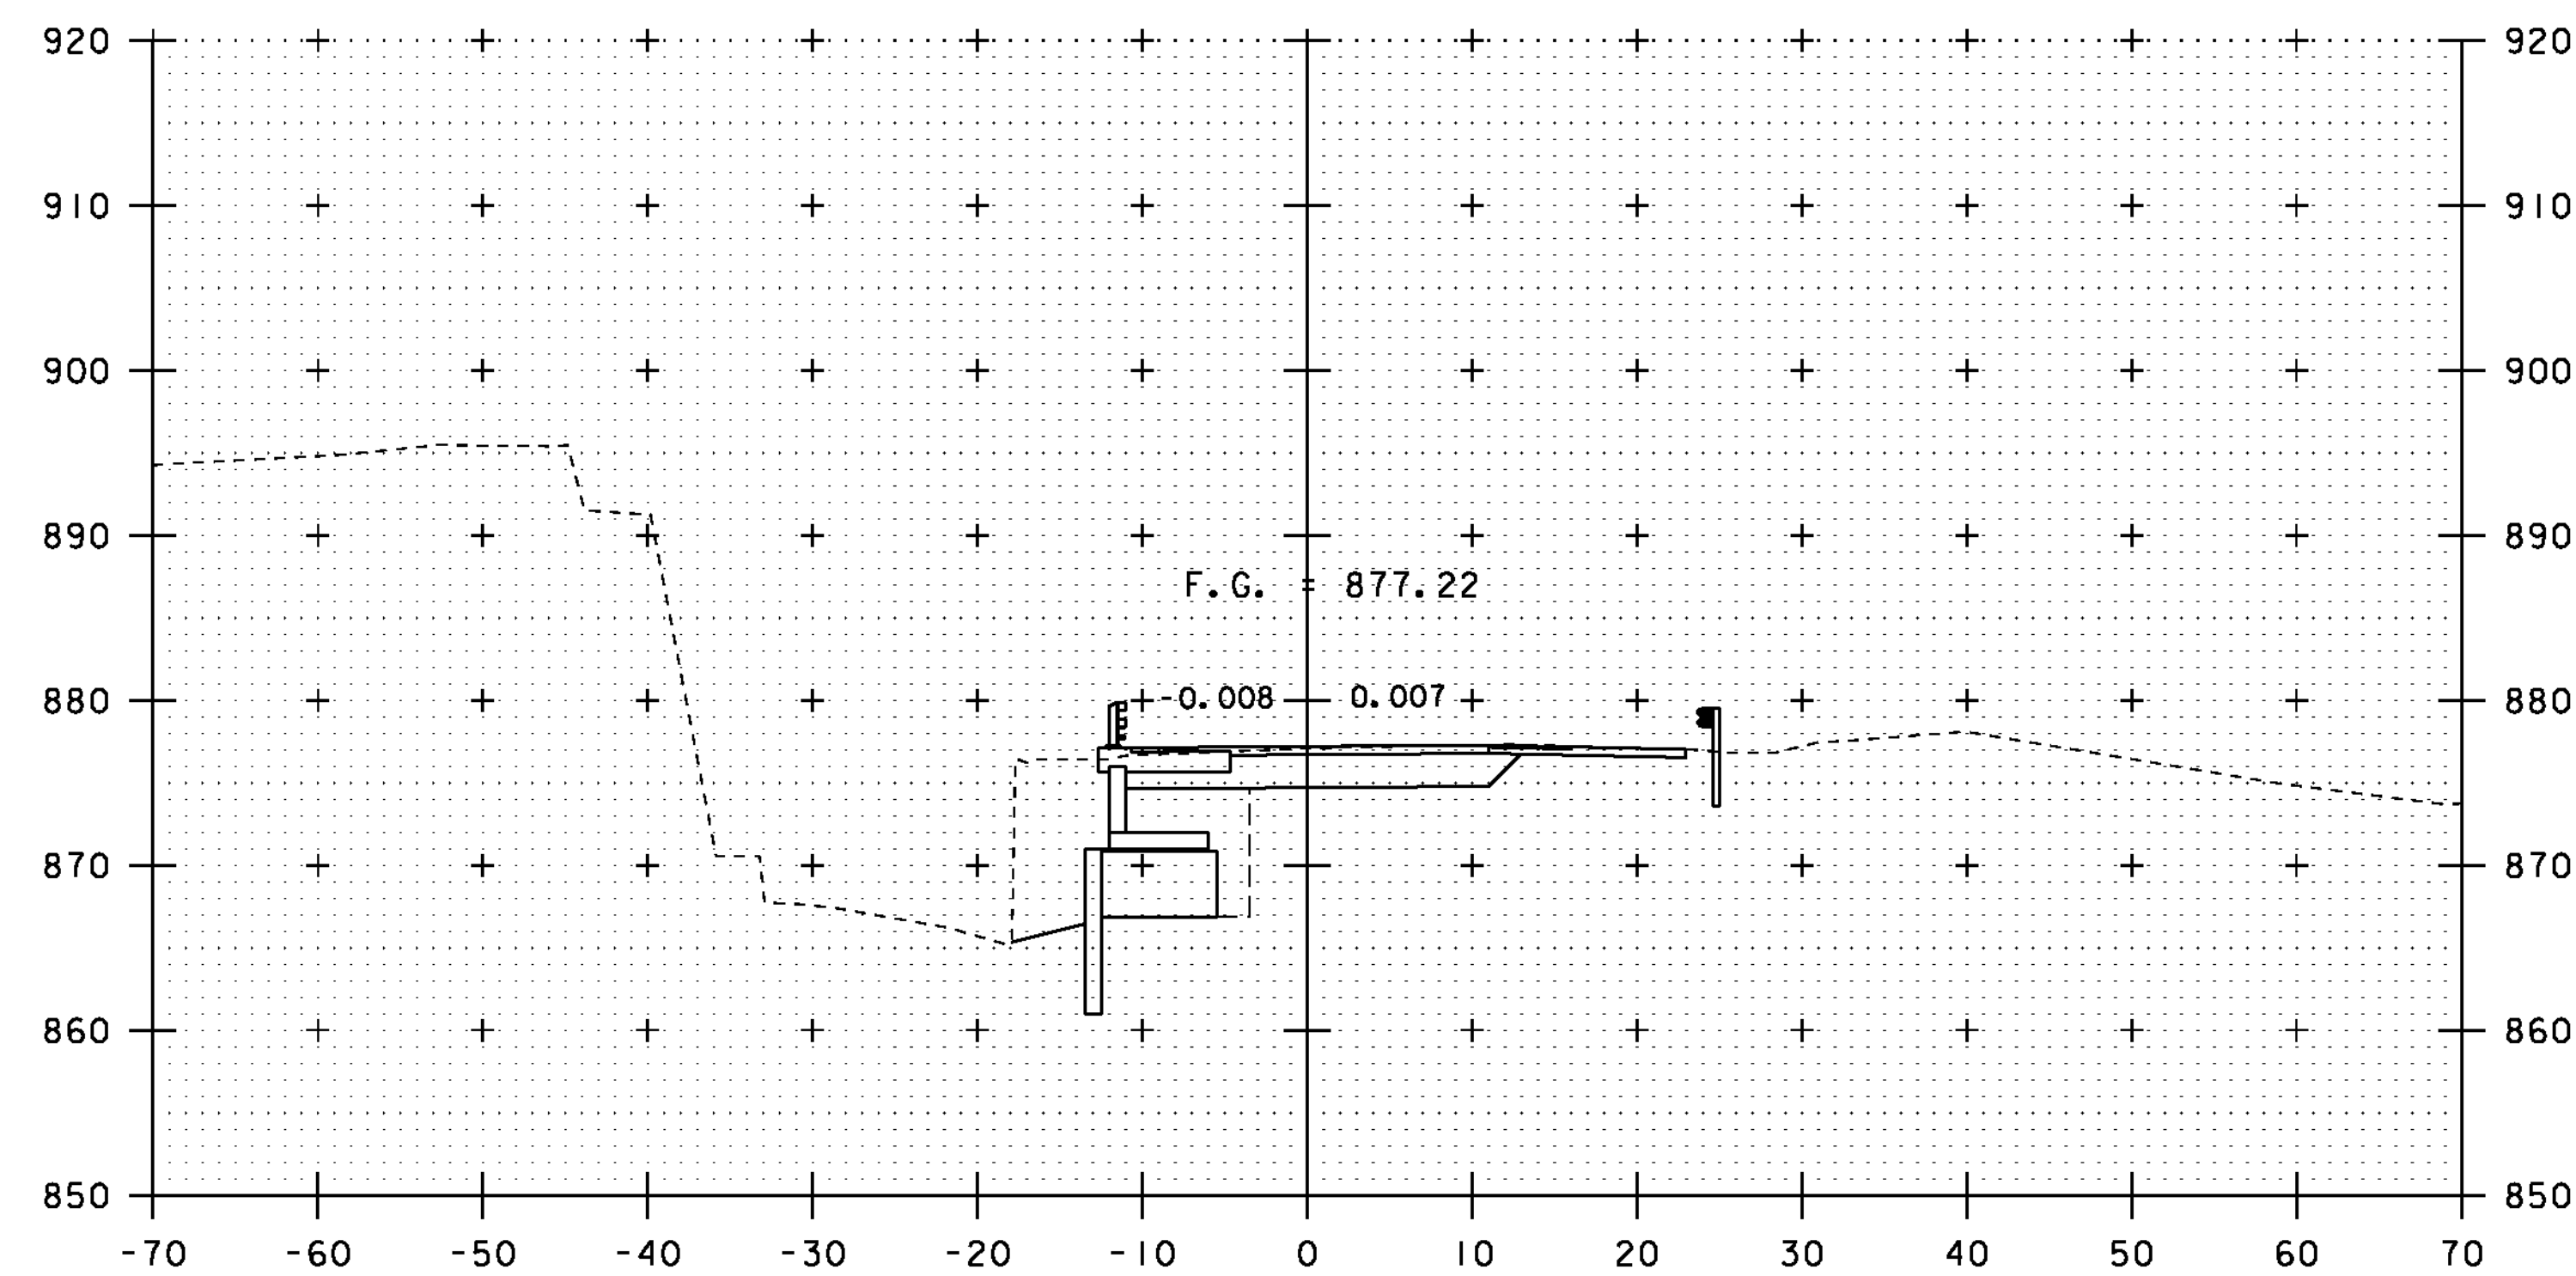


5+25

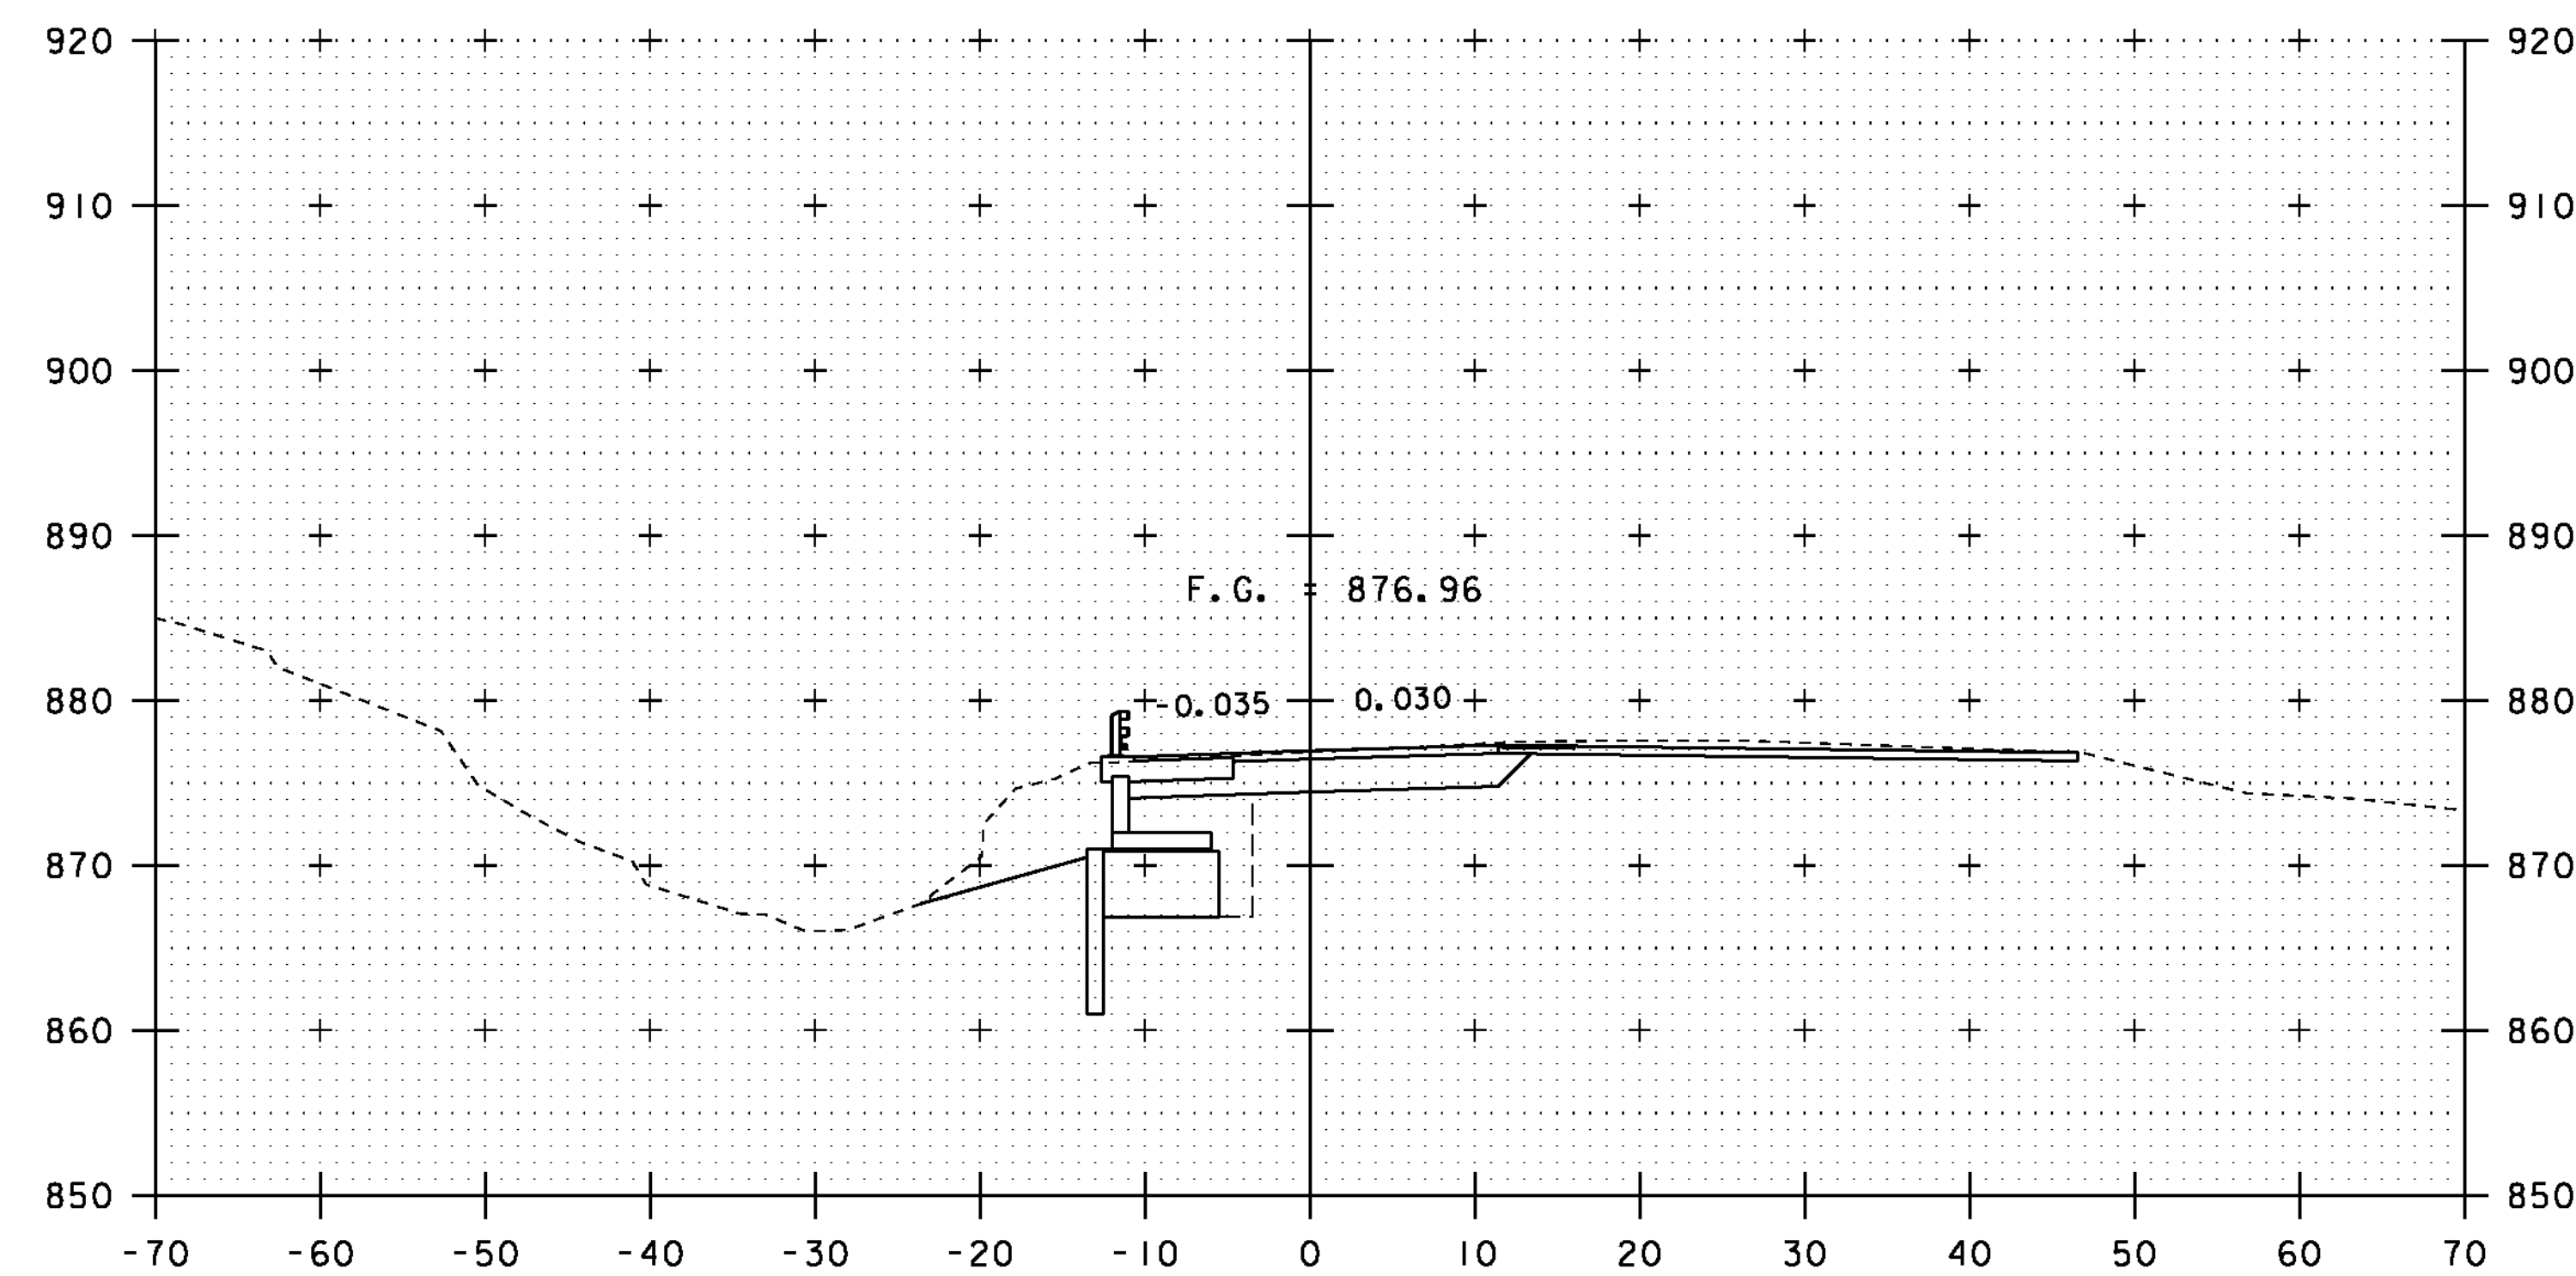

5+75

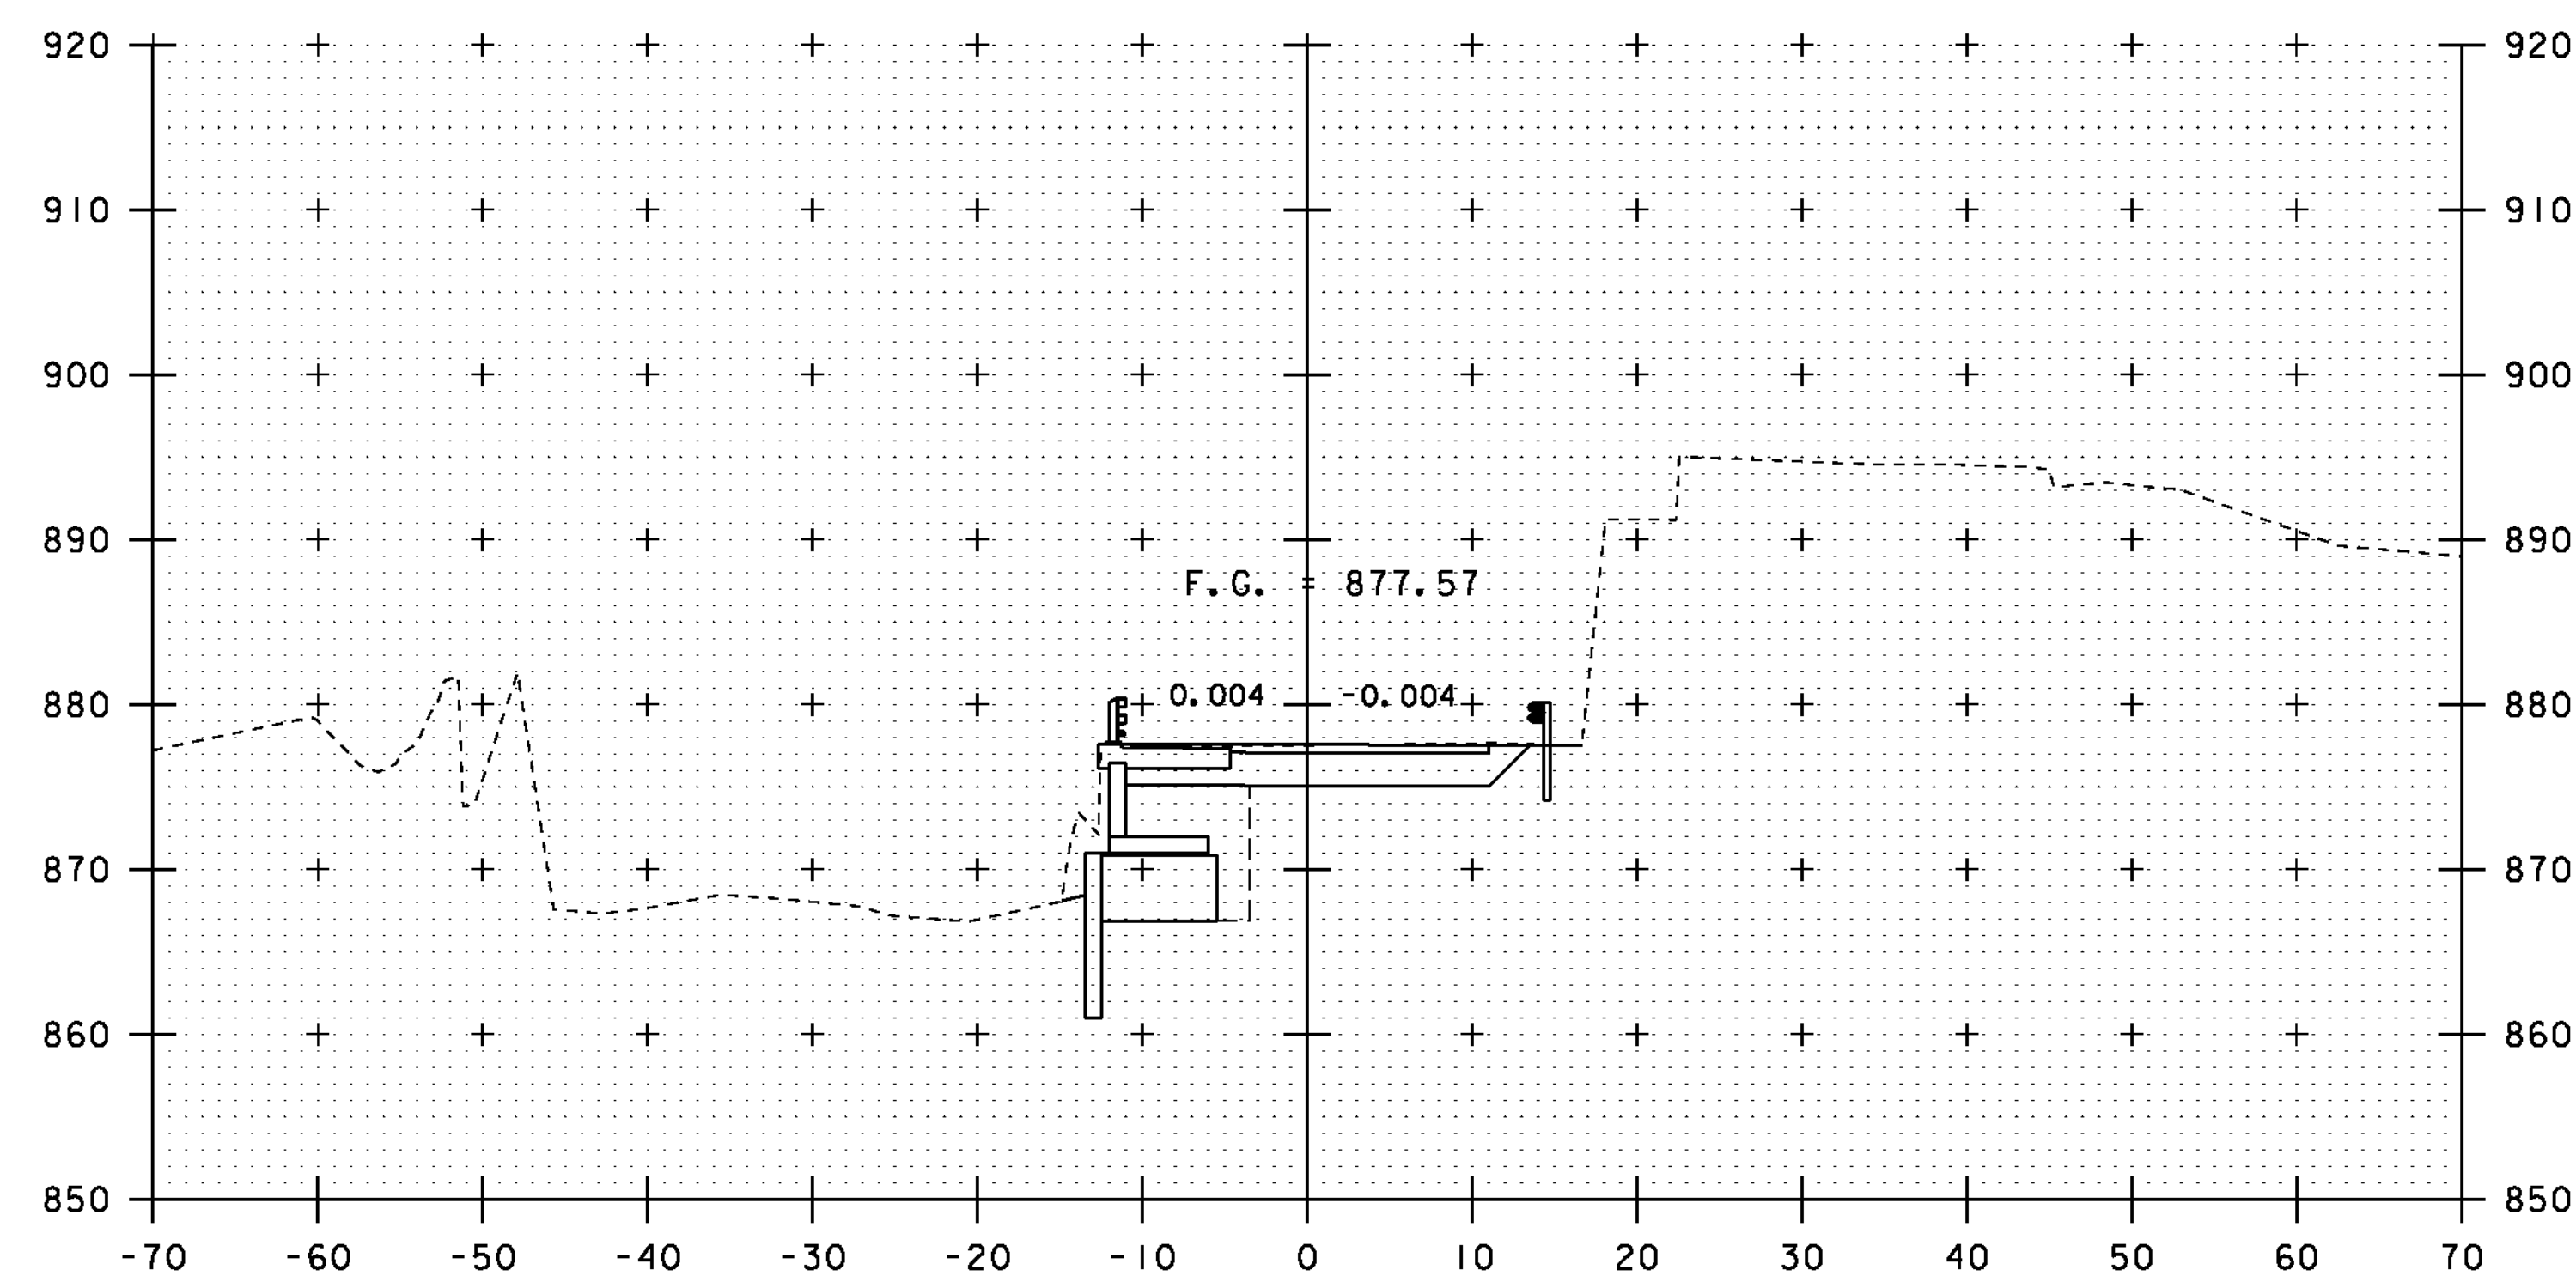

5+00

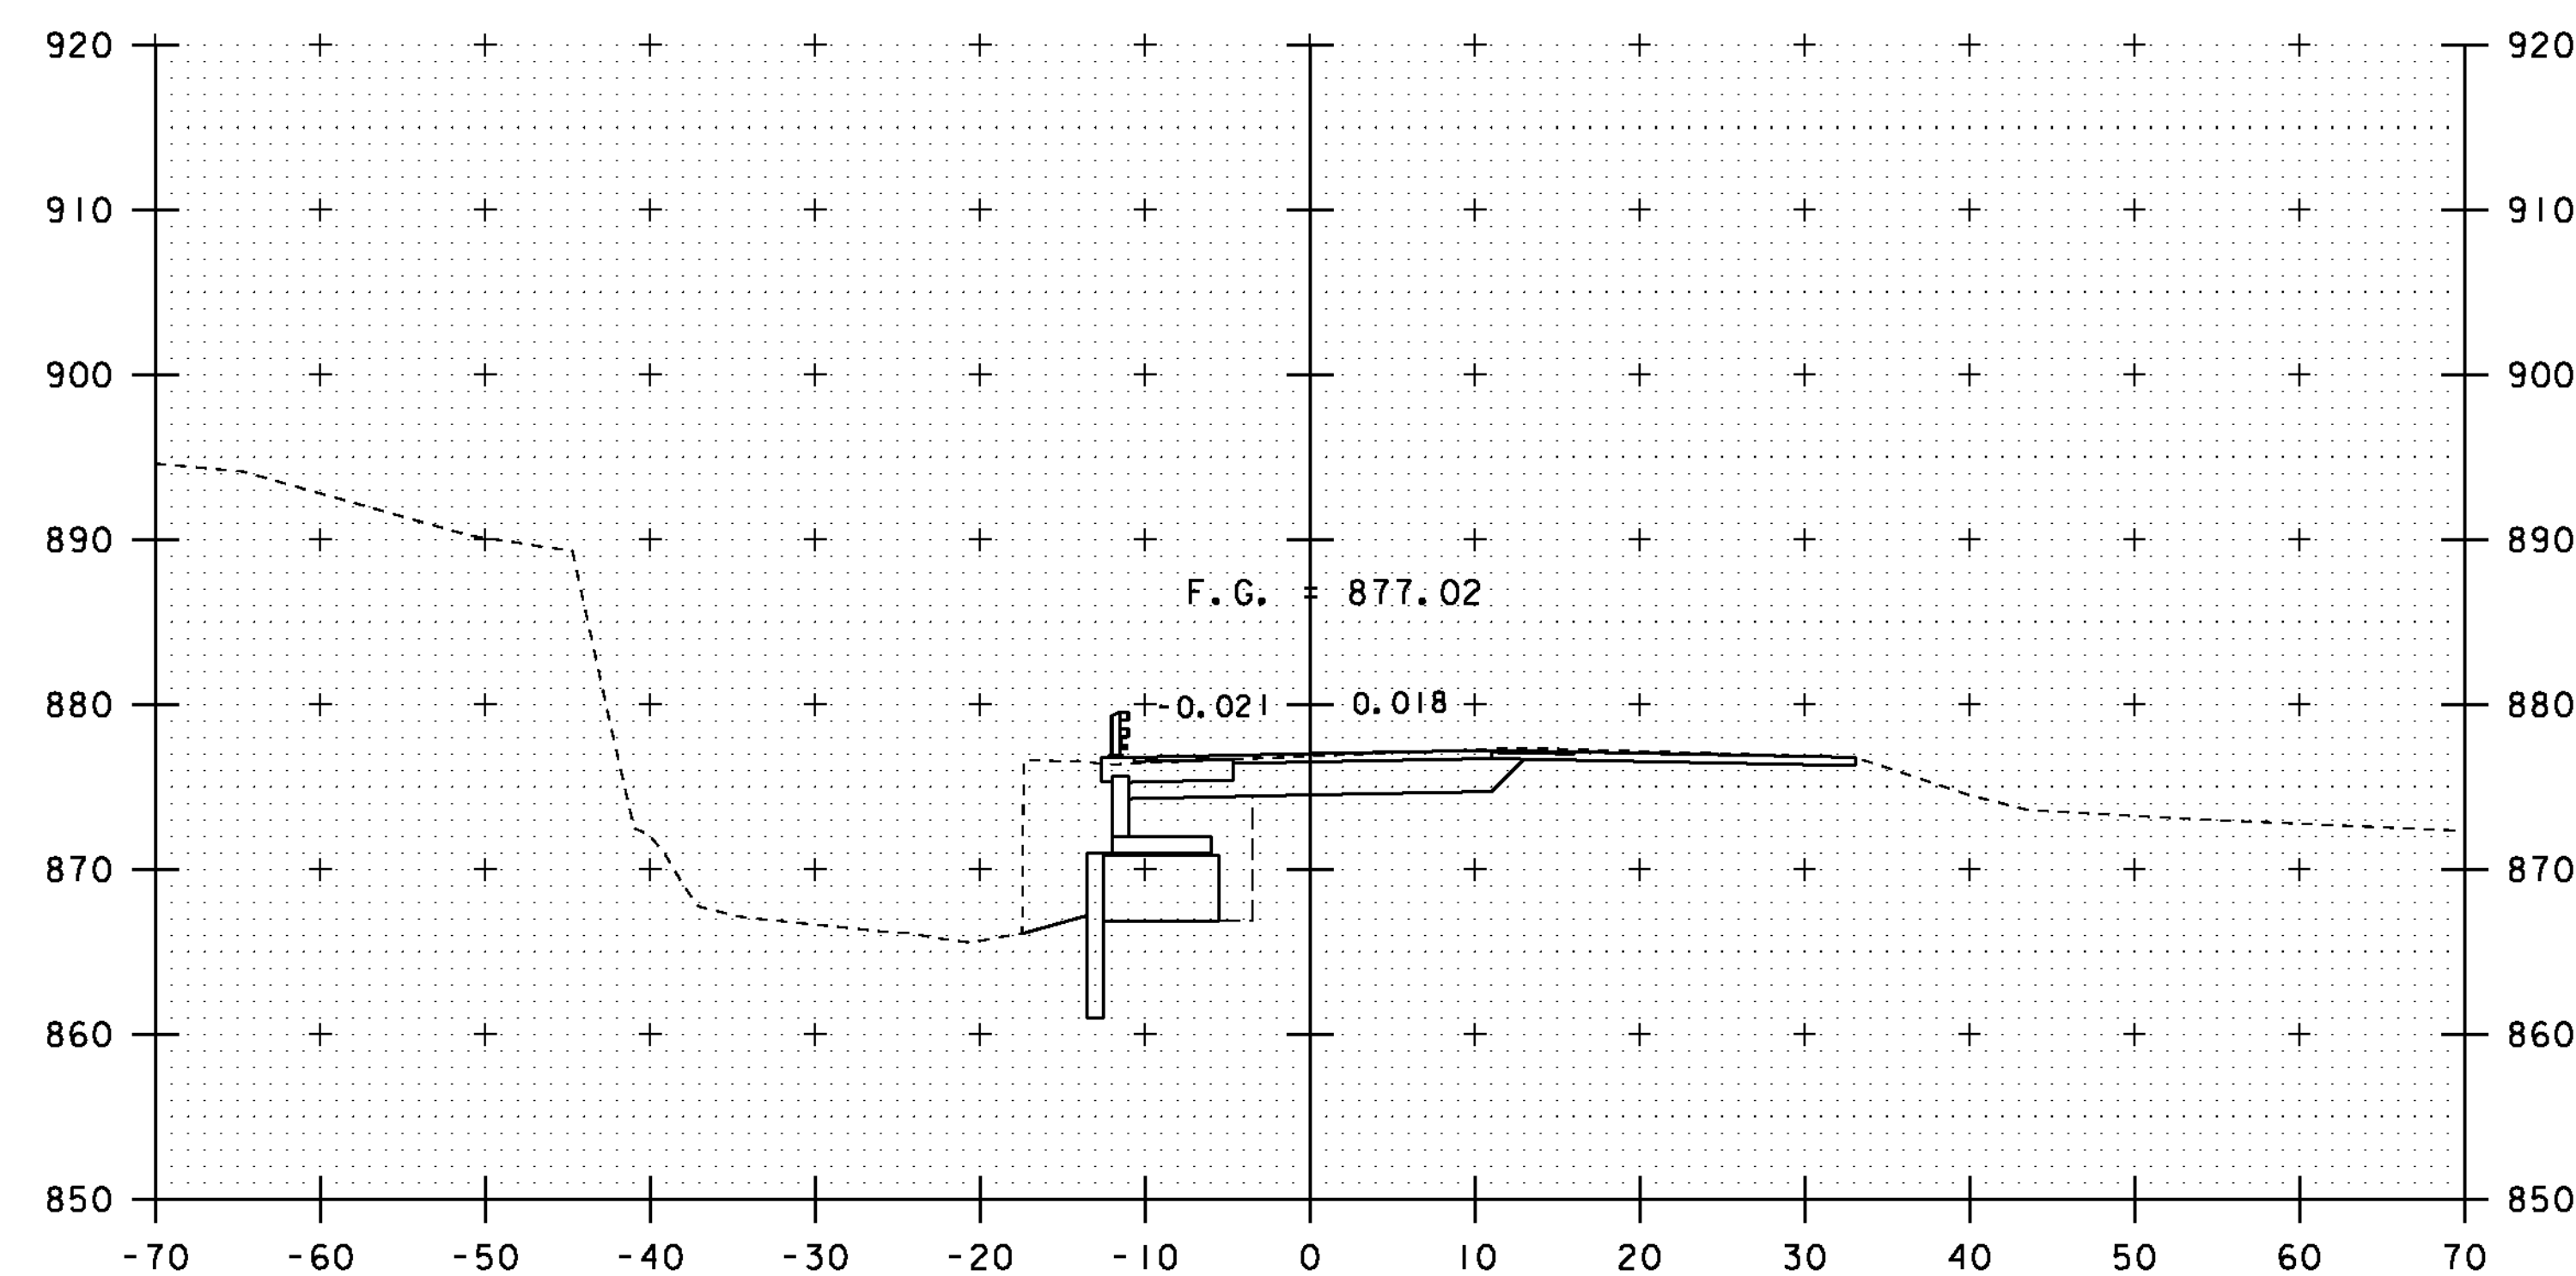

5+50

BEGIN PERMANENT STEEL SHEET PILING  
STA 4+90.0 LT

STA. 5+00 TO STA. 5+75

|                                |                         |
|--------------------------------|-------------------------|
| PROJECT NAME: ROXBURY          |                         |
| PROJECT NUMBER: BHF 0187(8)    |                         |
| FILE NAME: sl0c420xsl.dgn      | PLOT DATE: 21-SEP-2011  |
| PROJECT LEADER: C. P. WILLIAMS | DRAWN BY: G. ROY        |
| DESIGNED BY: G. ROY            | CHECKED BY: T. FILLBACH |
| VT 12A CROSS SECTIONS (4)      | SHEET 35 OF 54          |