




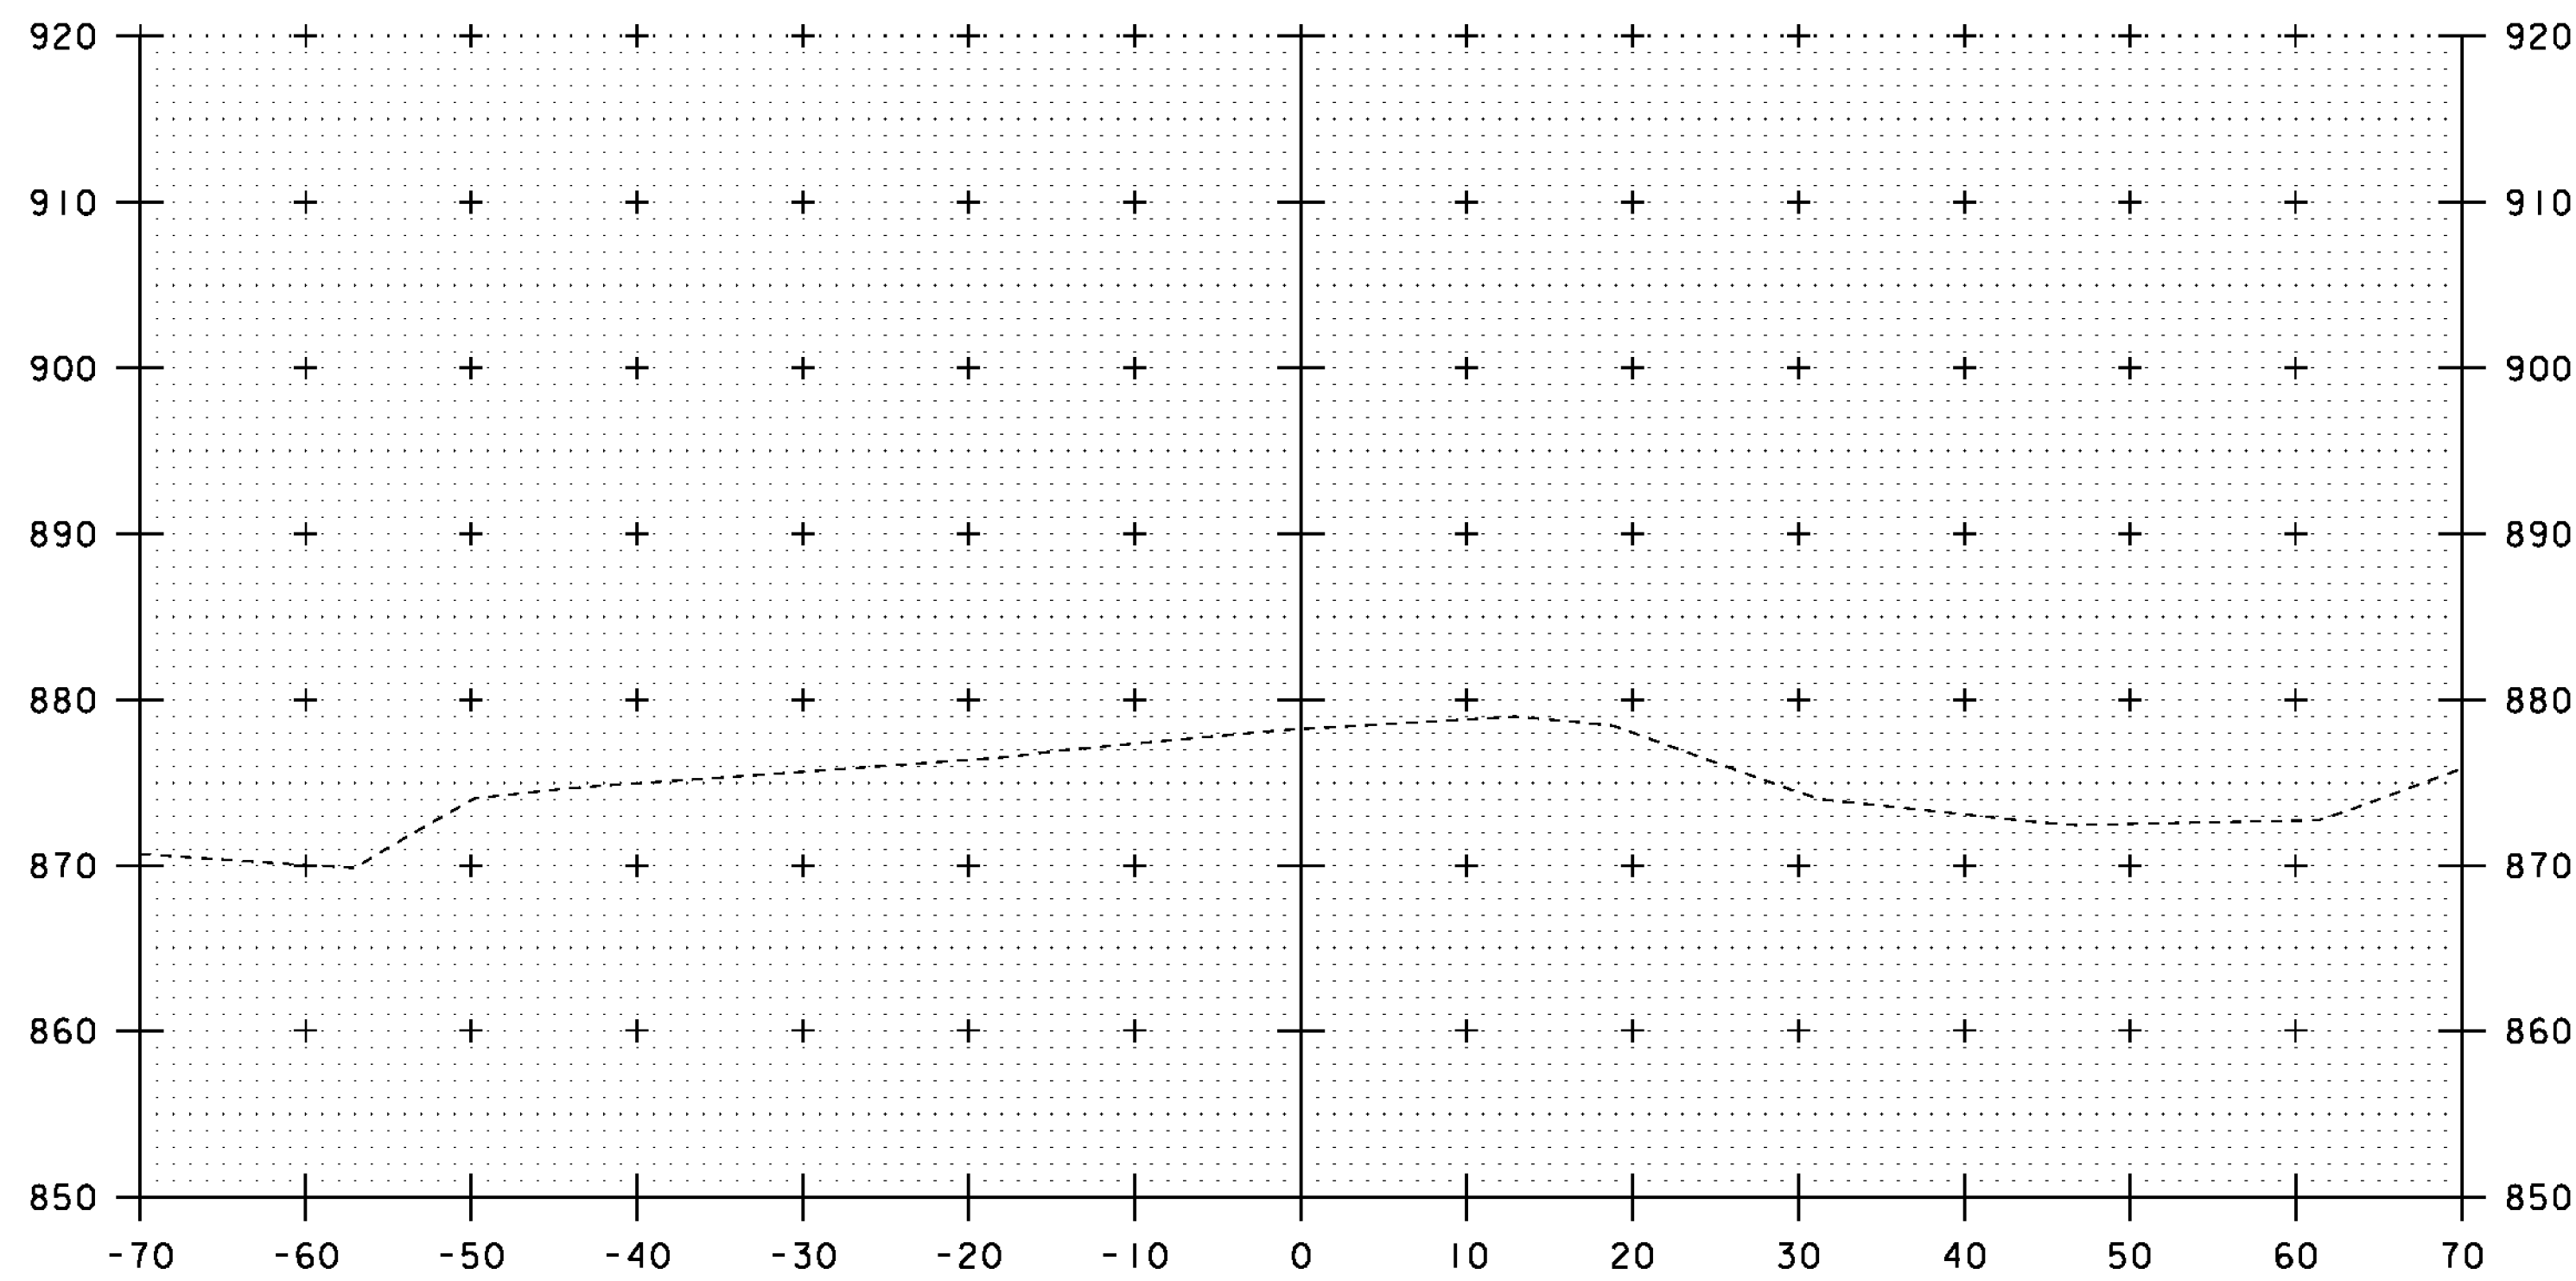

7+25

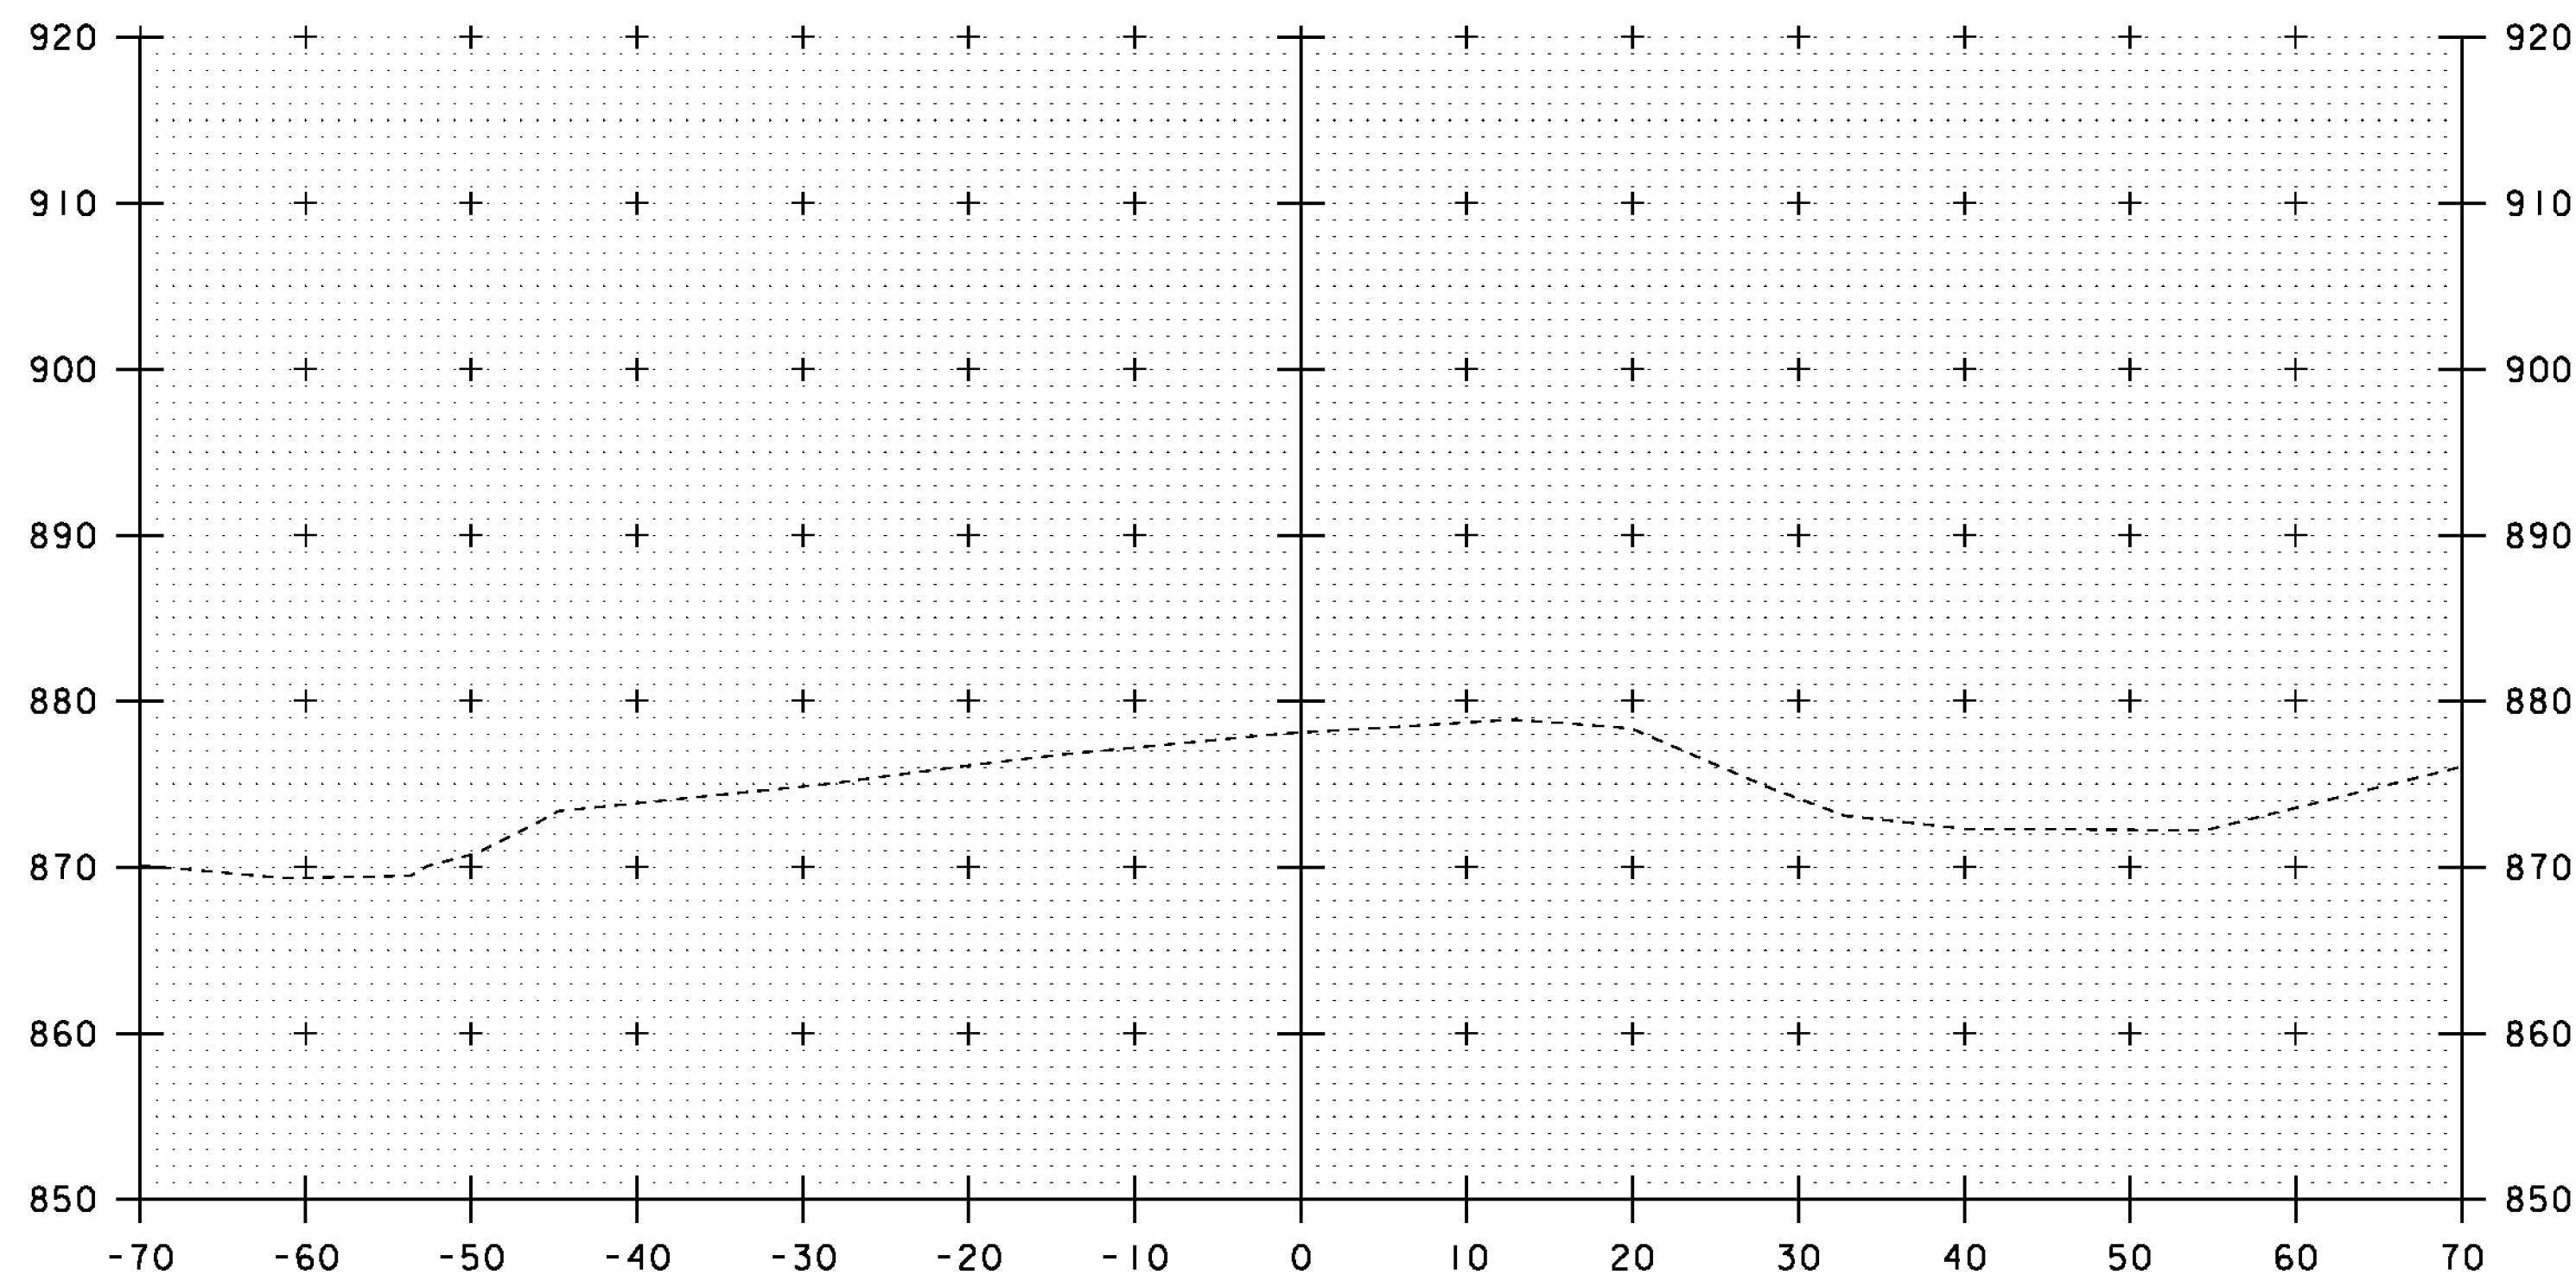

7+00

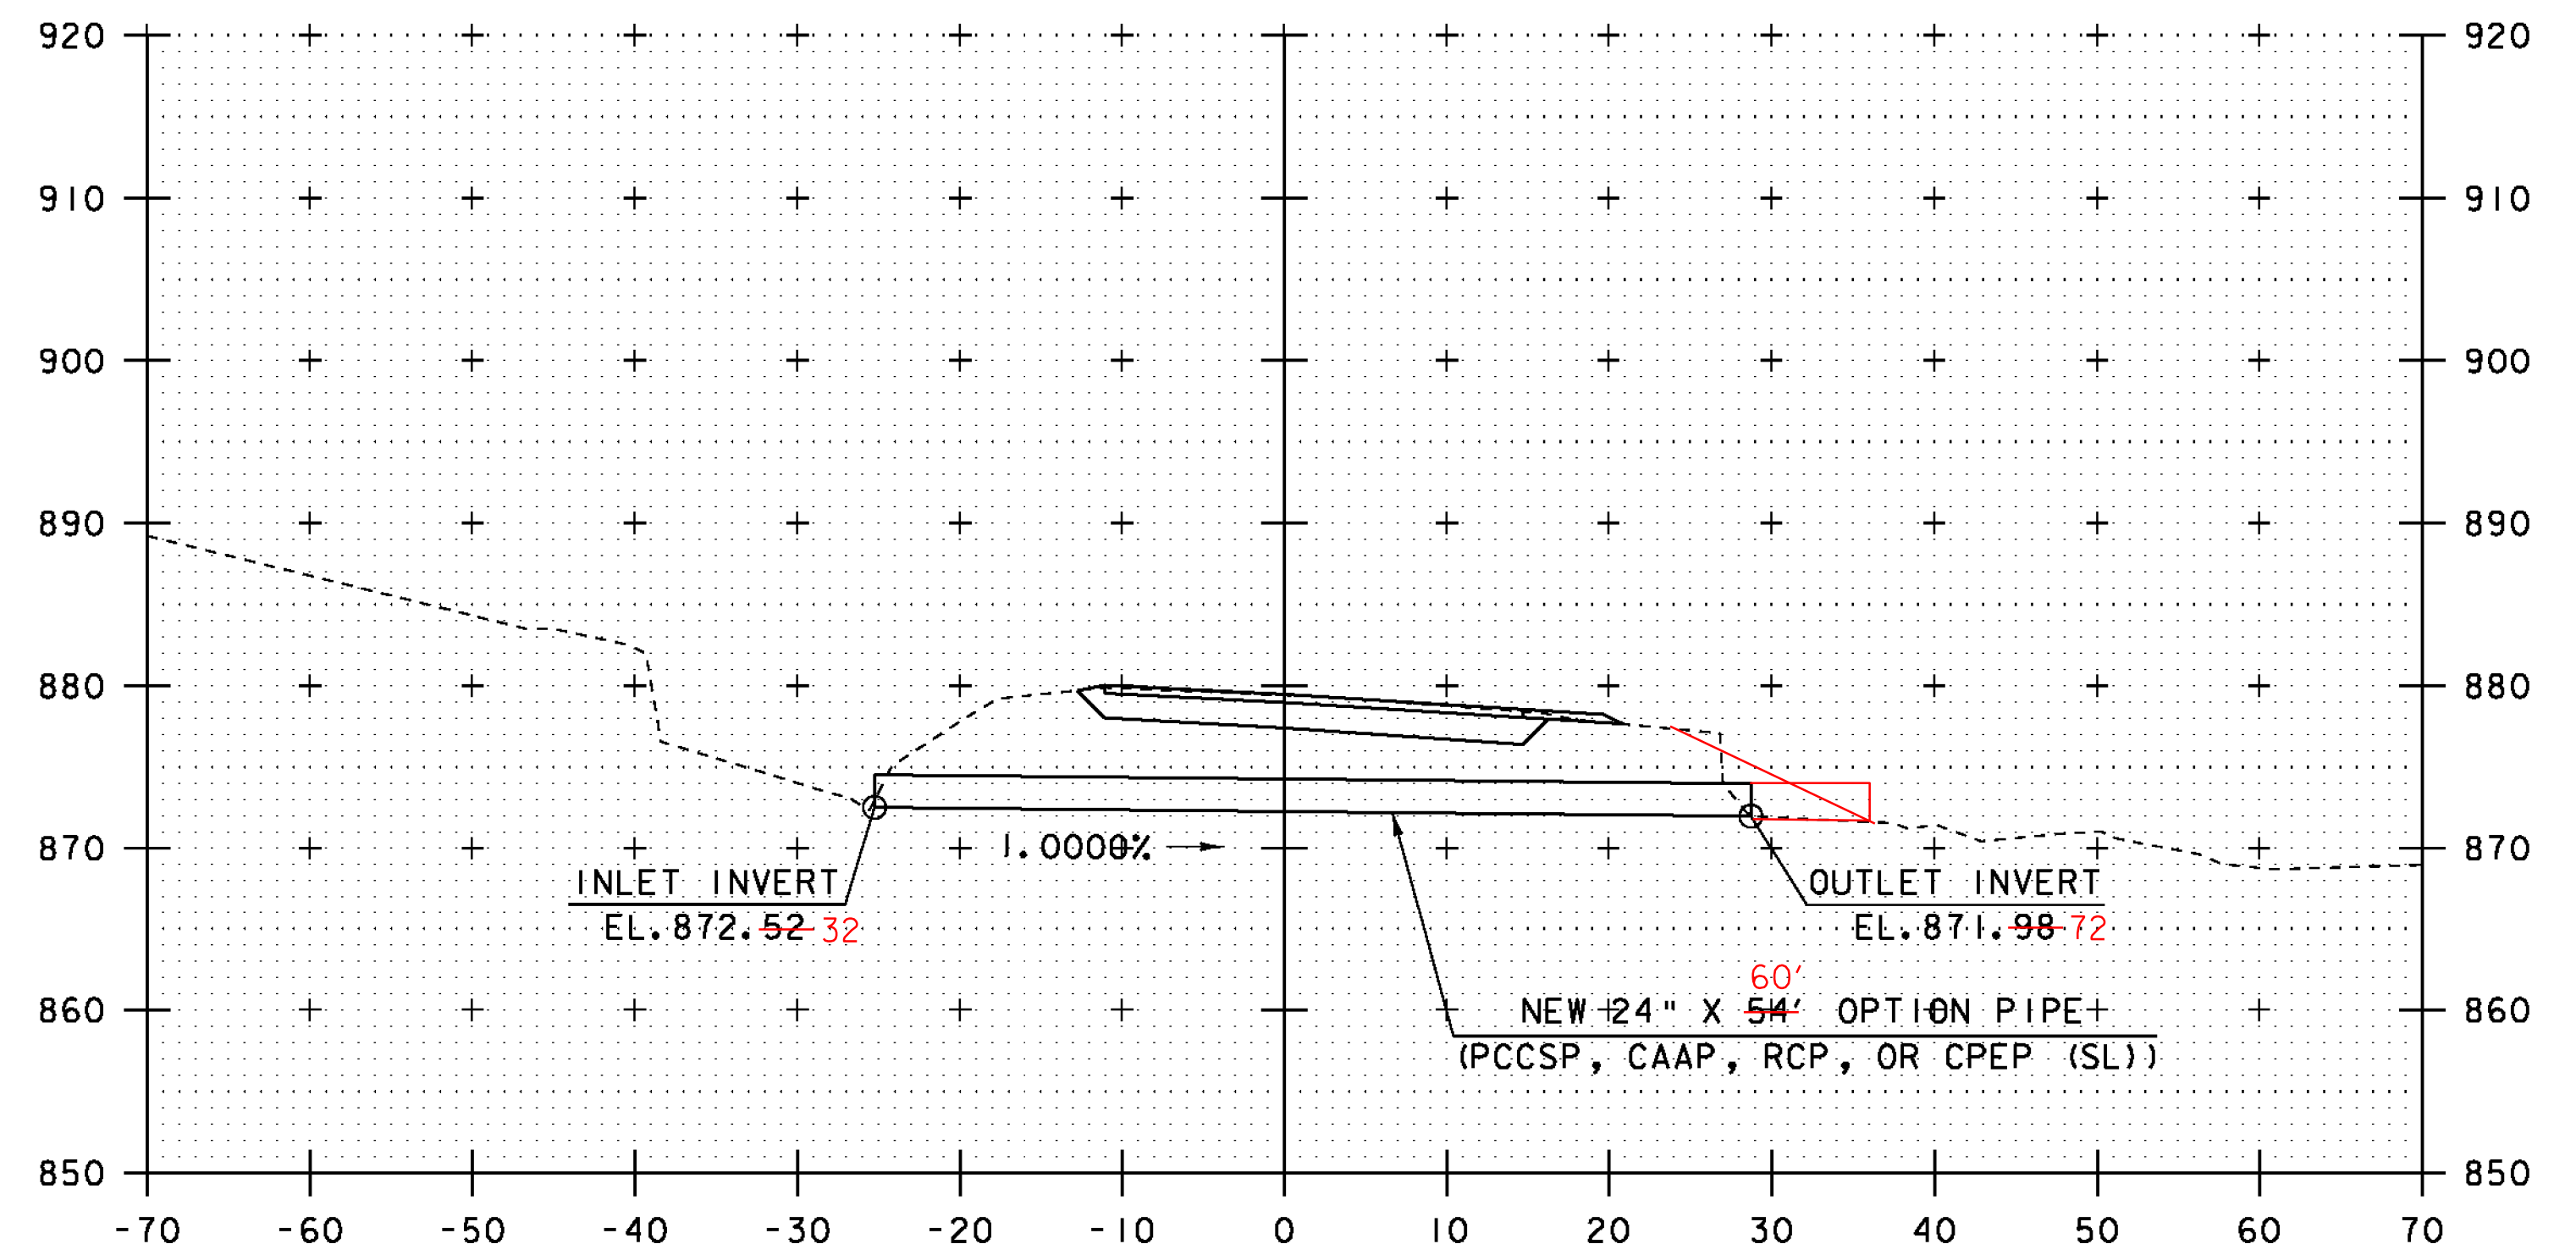

2+89.2 , SKEW 7° 48' LT

|                                |                         |
|--------------------------------|-------------------------|
| PROJECT NAME: ROXBURY          |                         |
| PROJECT NUMBER: BHF 0187(8)    |                         |
| FILE NAME: sl0c420xsl.dgn      | PLOT DATE: 21-SEP-2011  |
| PROJECT LEADER: C. P. WILLIAMS | DRAWN BY: G. ROY        |
| DESIGNED BY: G. ROY            | CHECKED BY: T. FILLBACH |
| VT I2A CROSS SECTIONS (6)      | SHEET 37 OF 54          |

STA. 7+00 TO STA. 7+25