




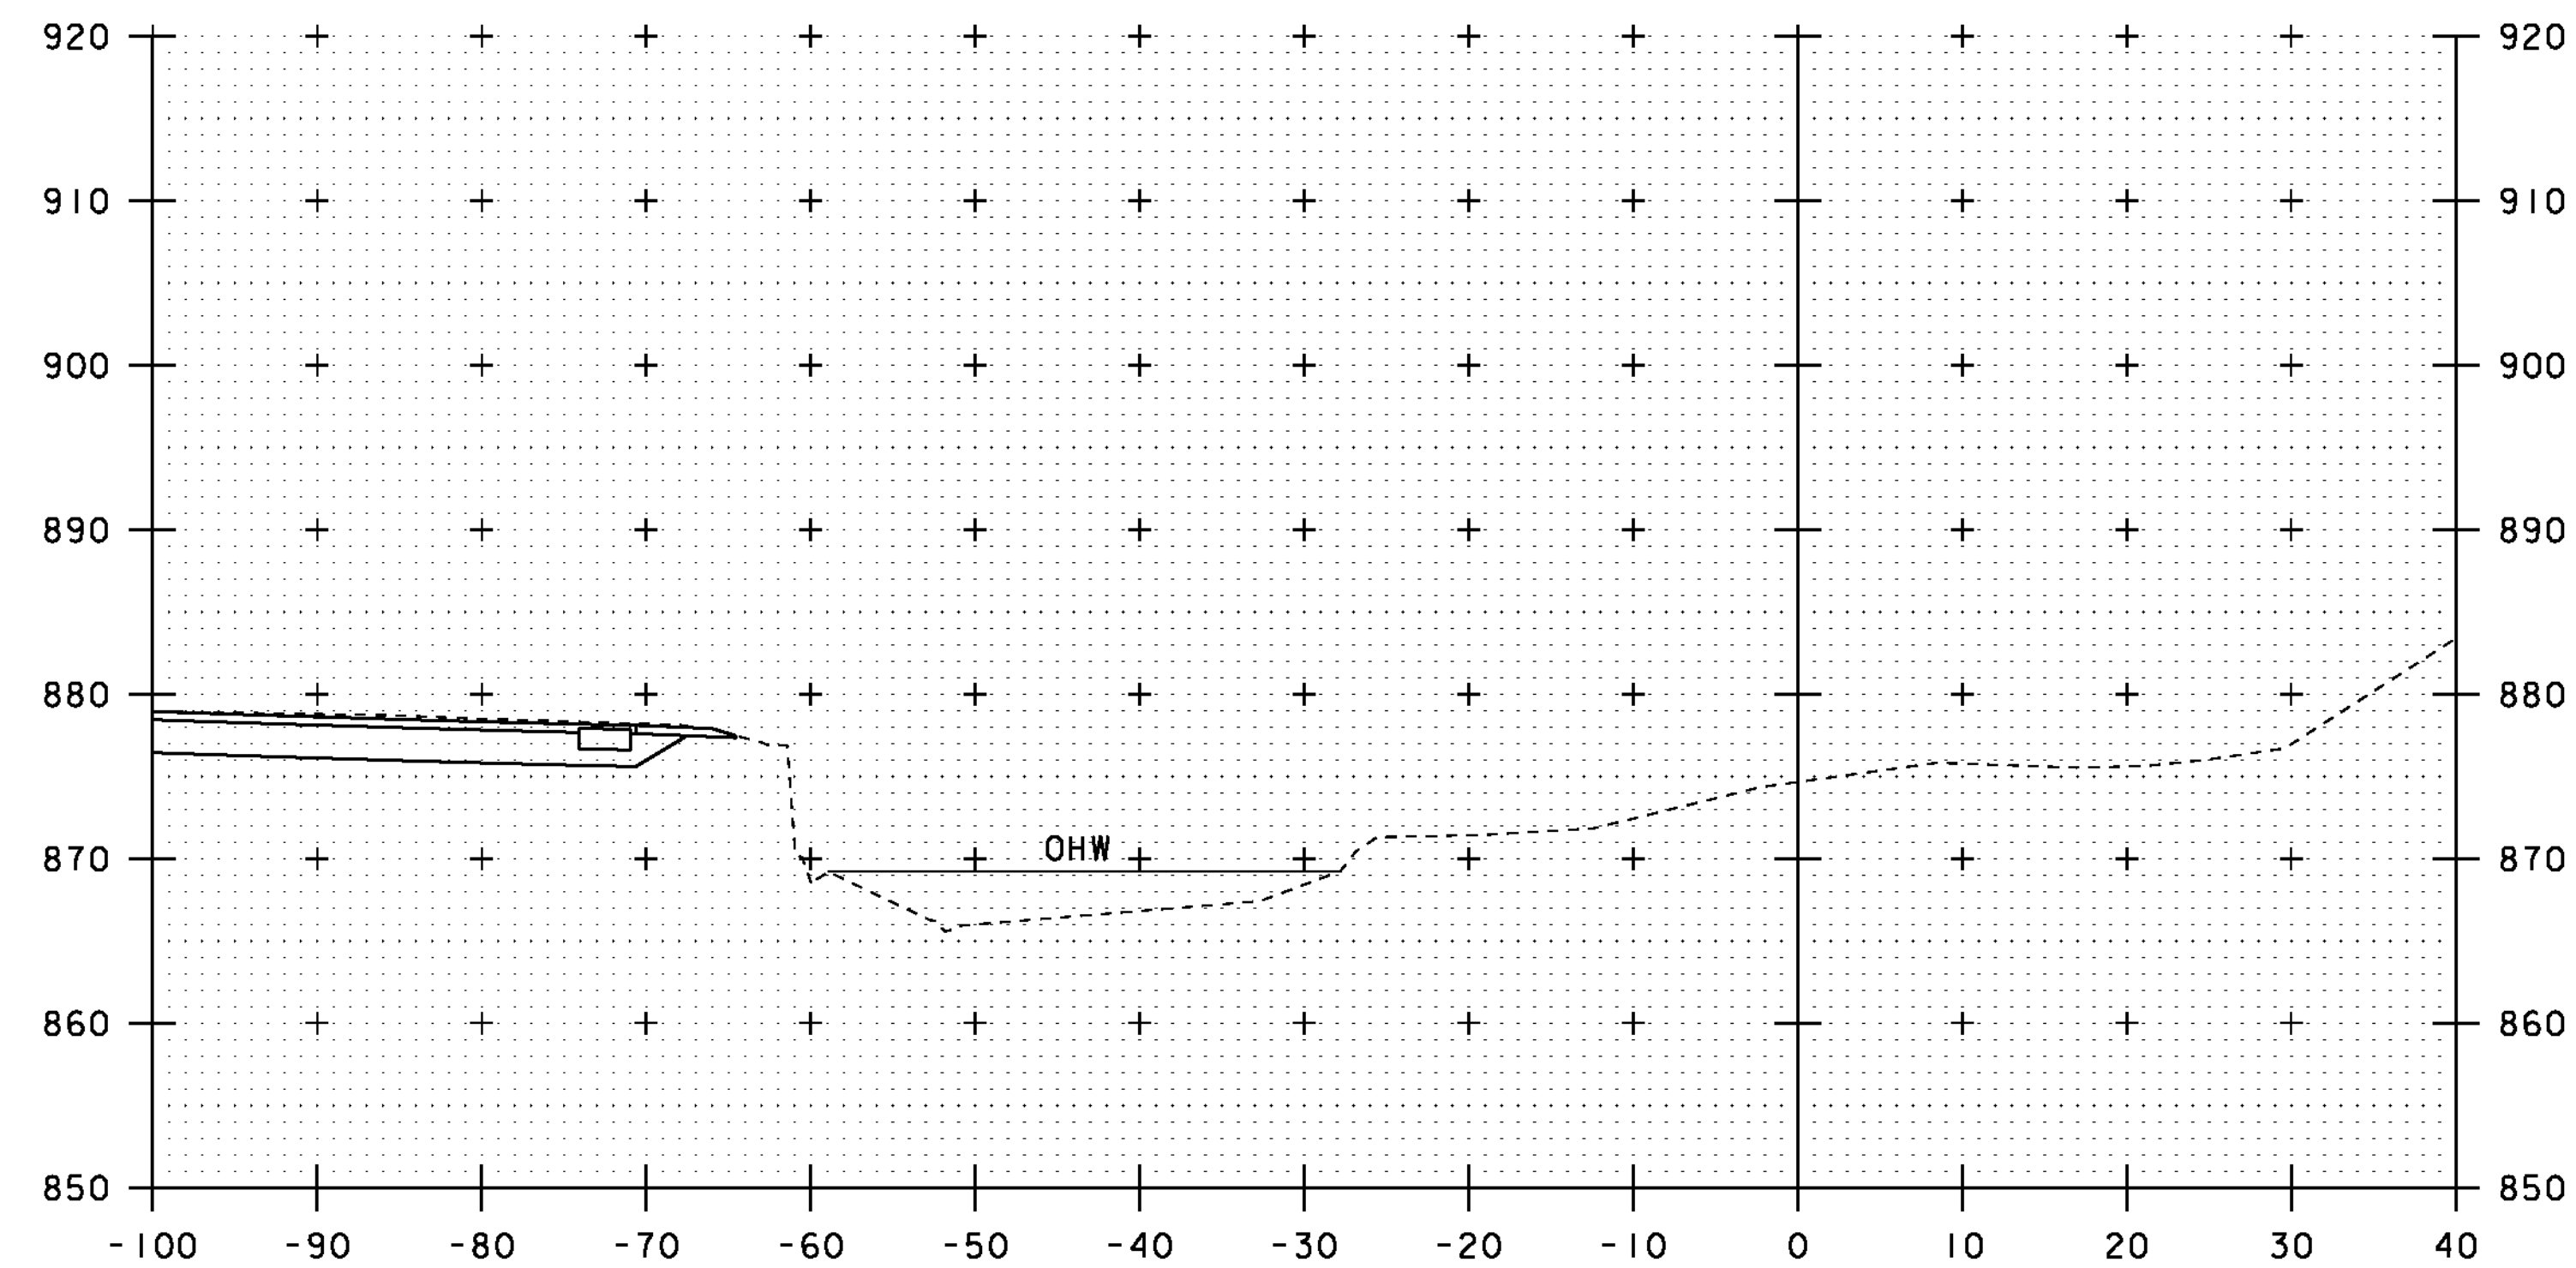


50+40

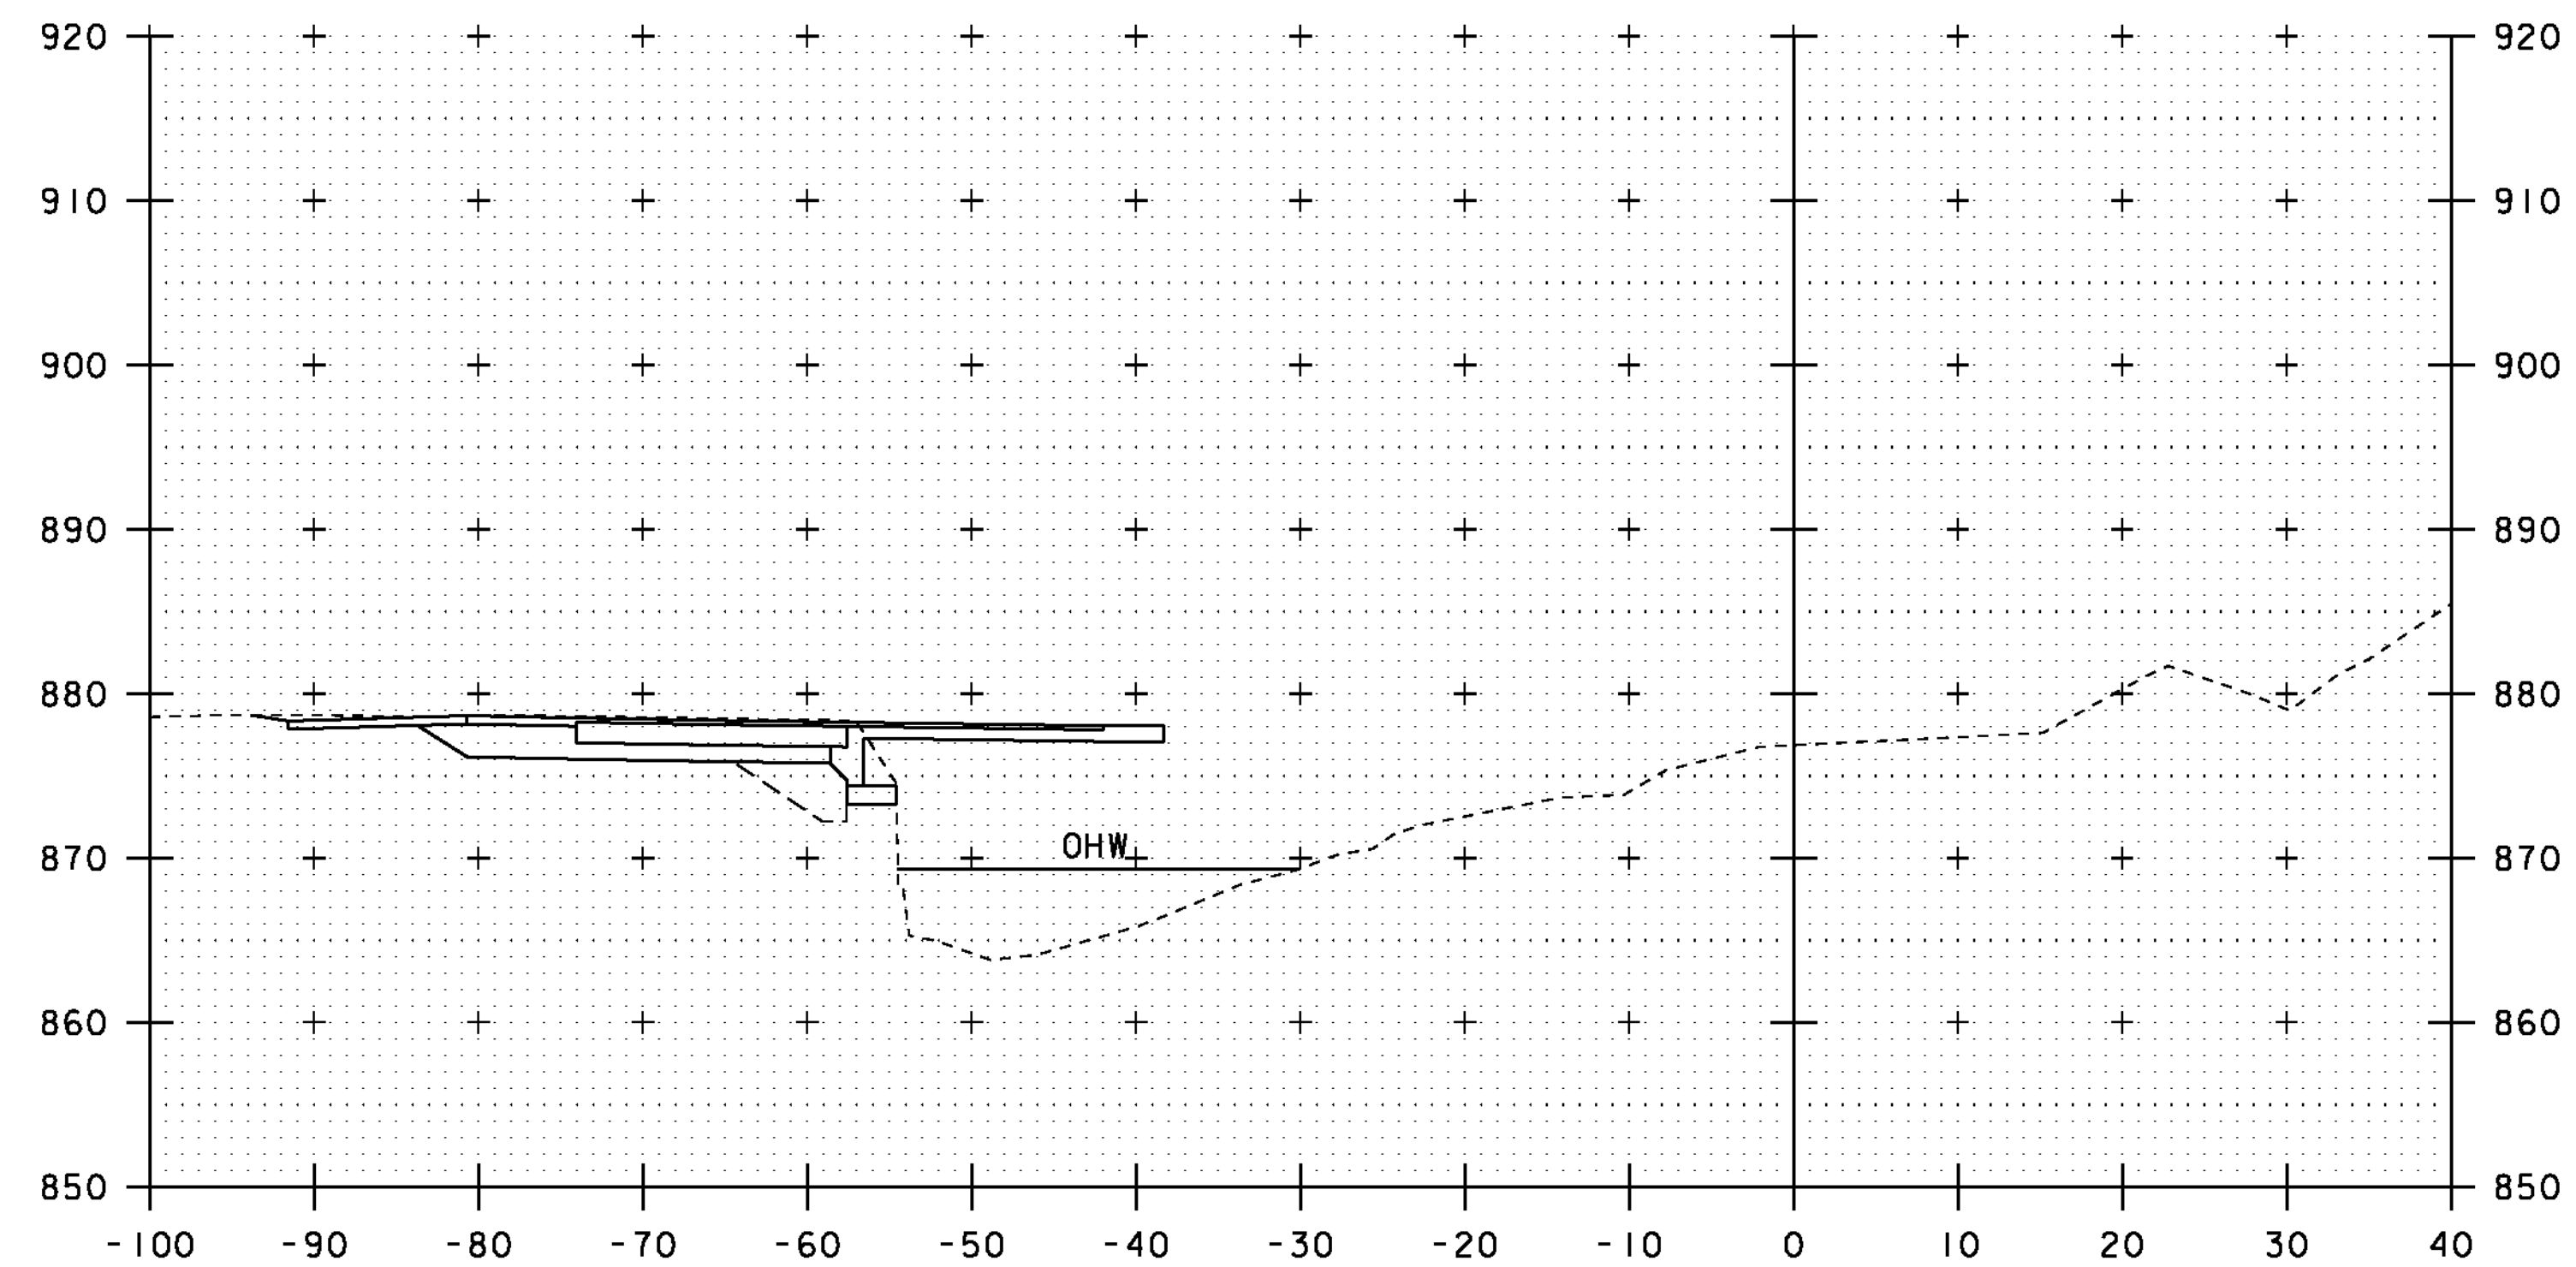


50+60

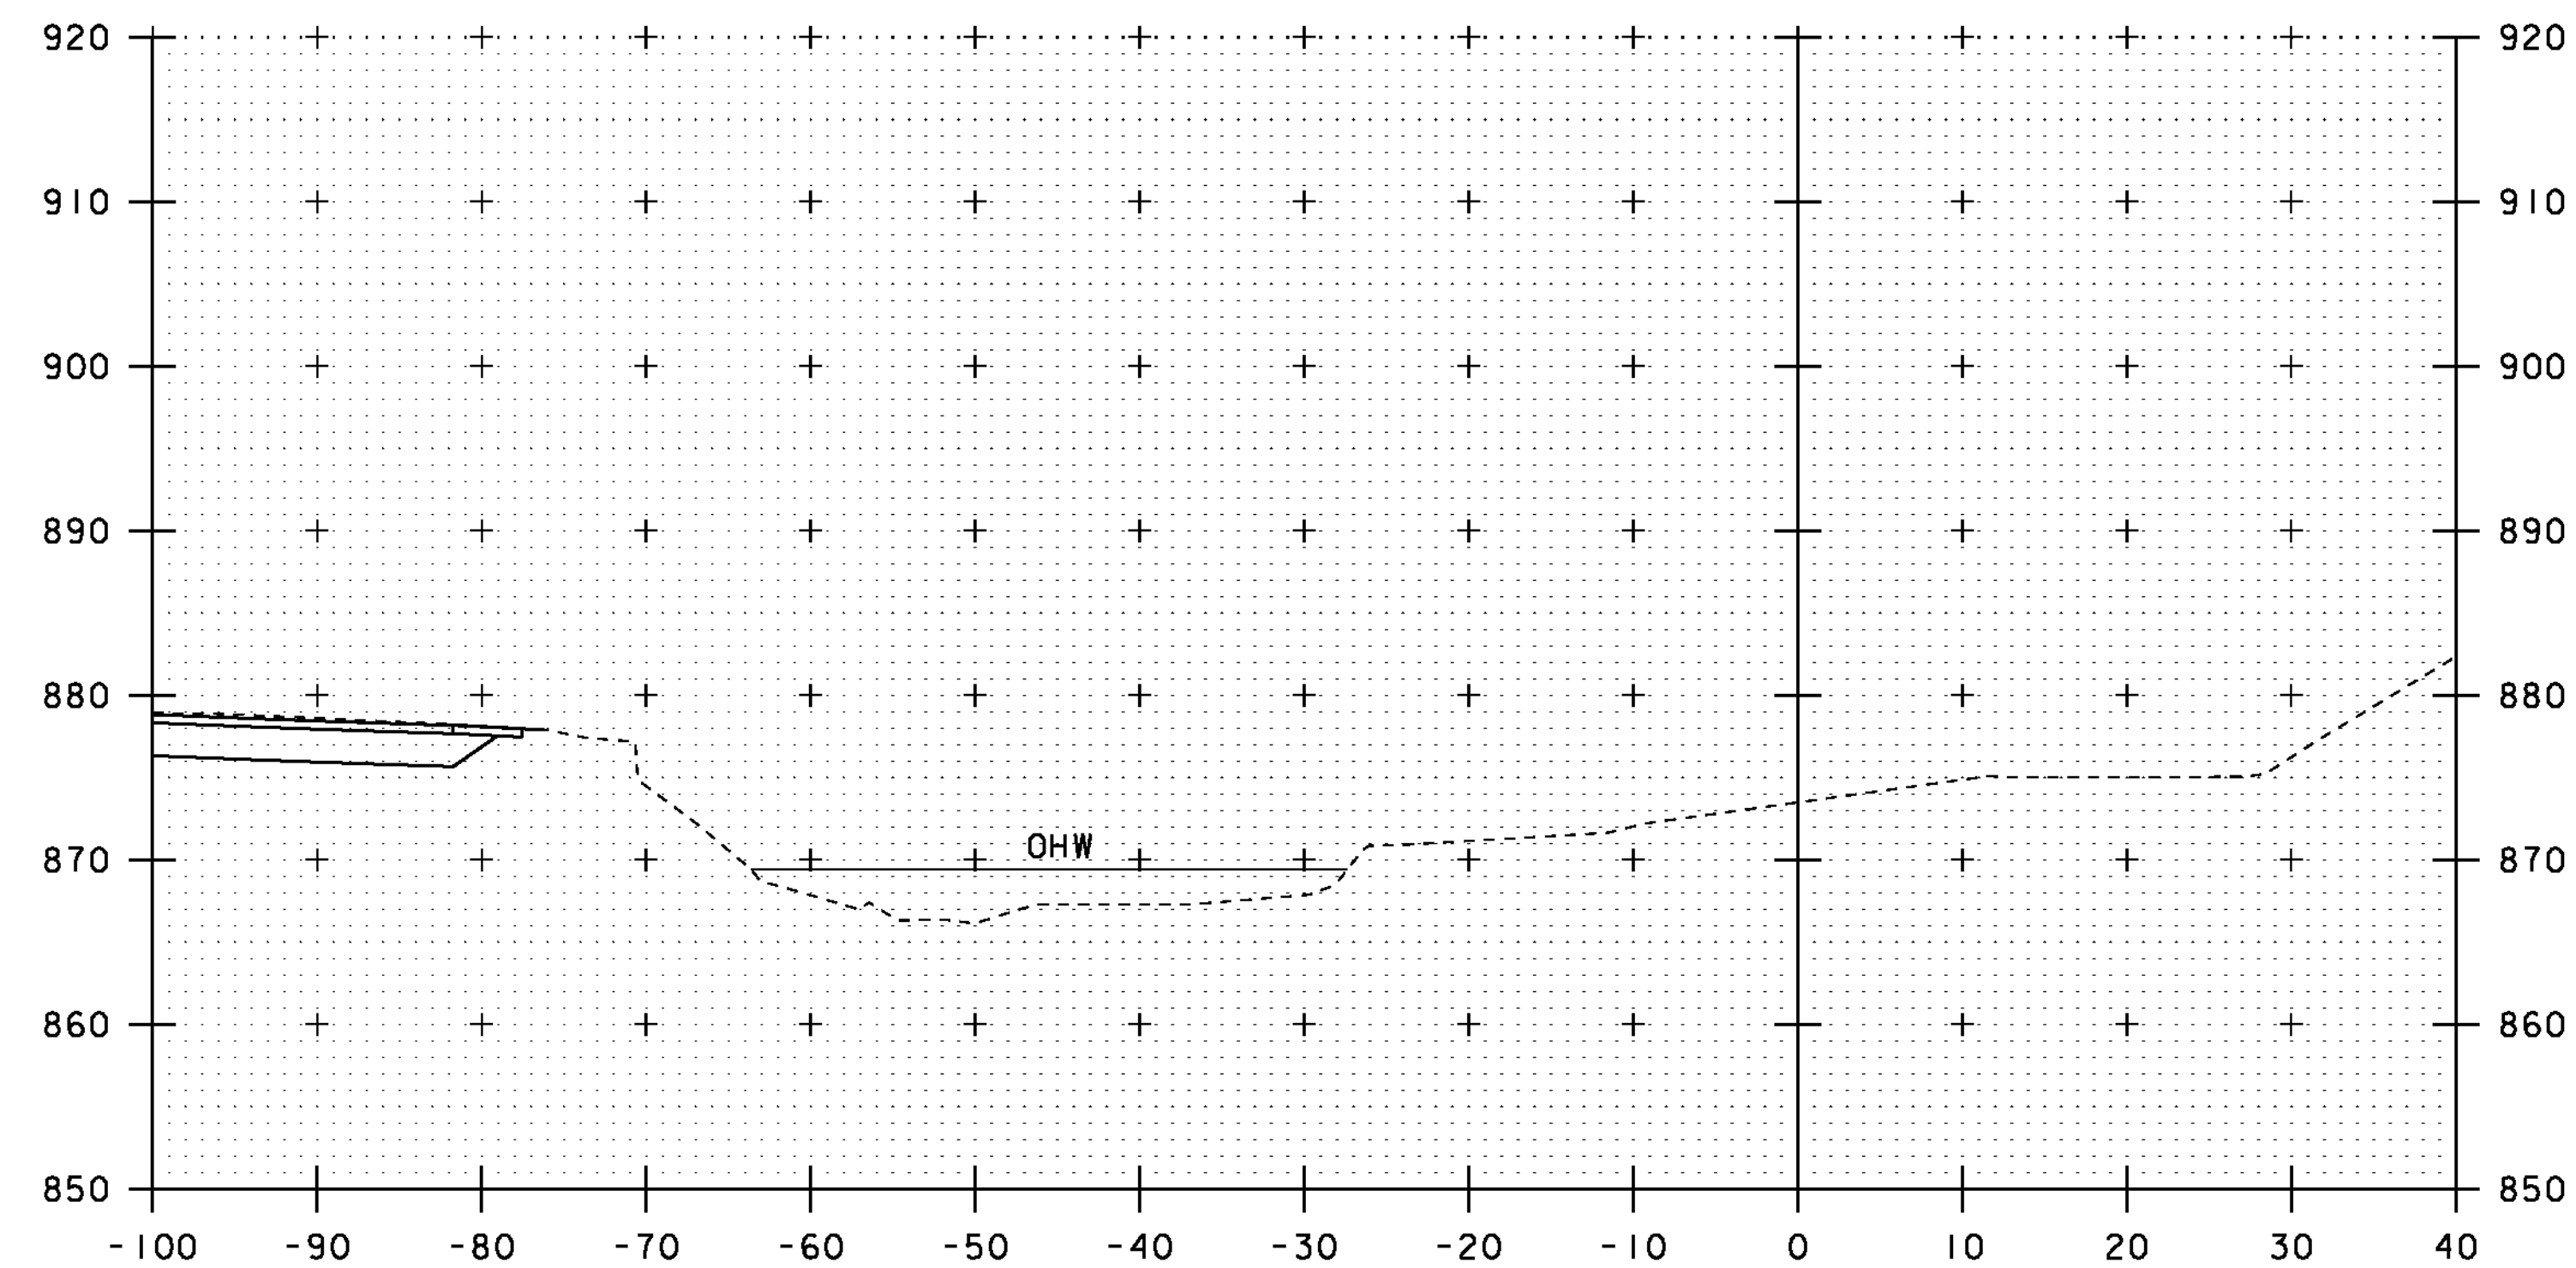

50+30

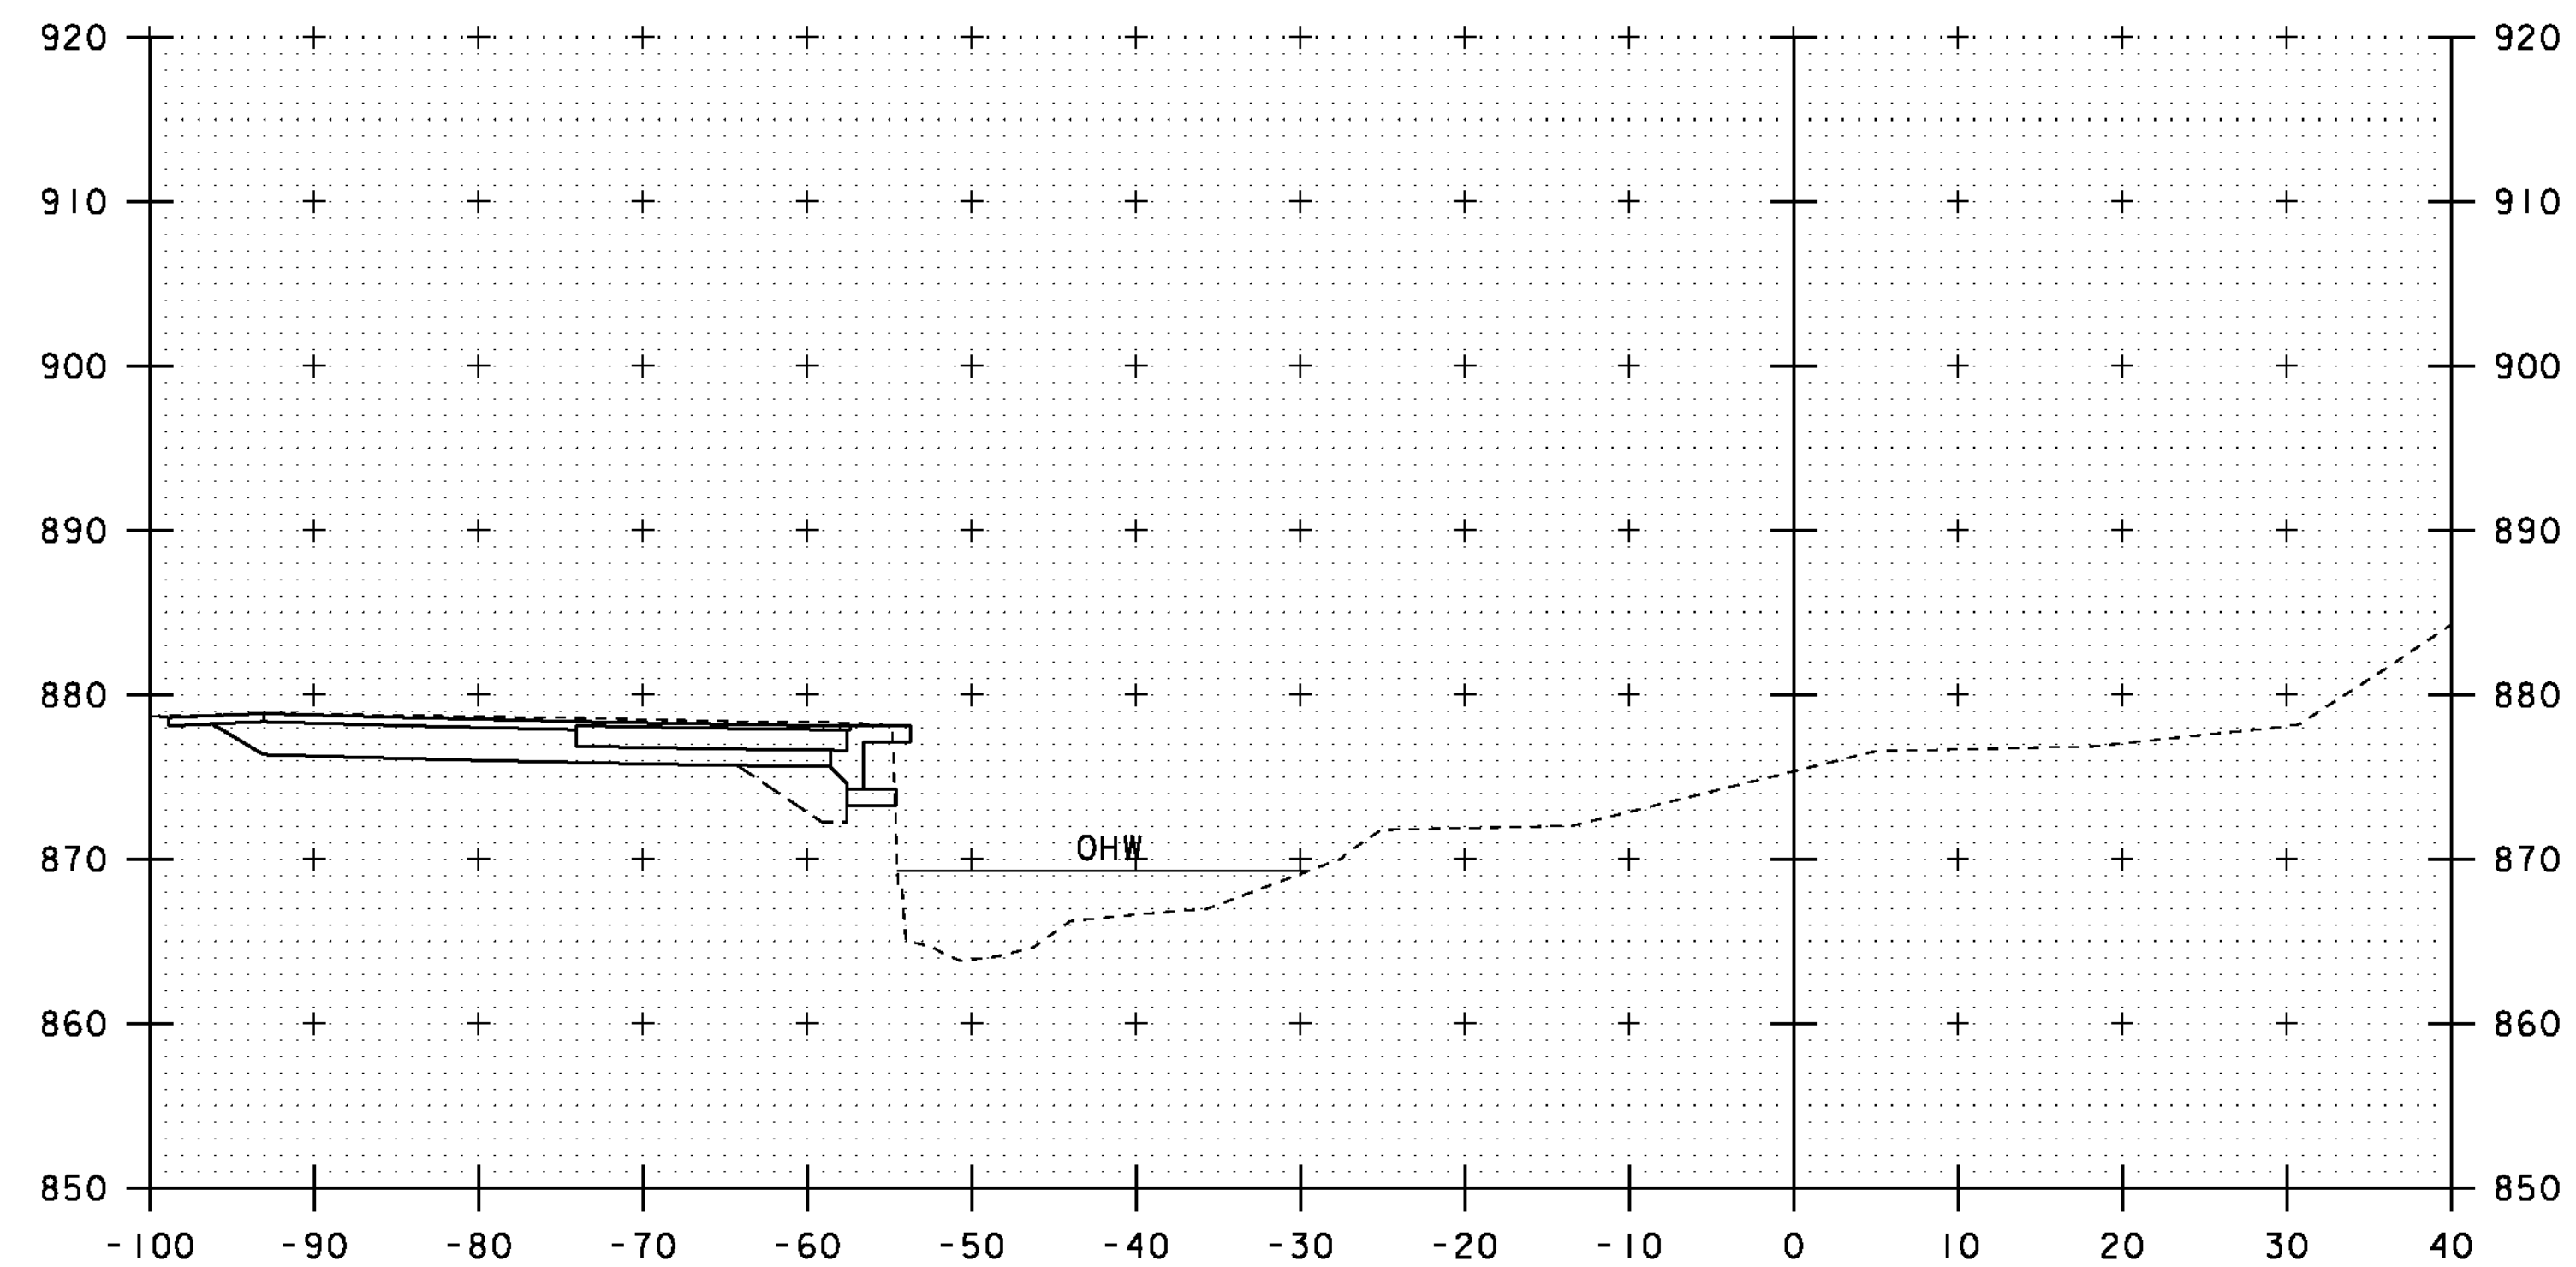

50+50

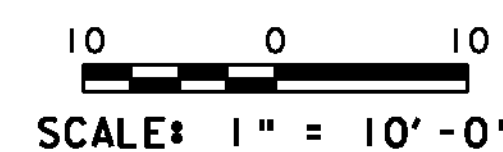

STA. 50+30 TO STA. 50+60

PROJECT NAME: ROXBURY	
PROJECT NUMBER: BHF 0187(8)	
FILE NAME: slOc420xsl.dgn	PLOT DATE: 21-SEP-2011
PROJECT LEADER: C. P. WILLIAMS	DRAWN BY: G. ROY
DESIGNED BY: G. ROY	CHECKED BY: T. FILLBACH
CHANNEL LINE CROSS SECTIONS (1)	SHEET 38 OF 54