




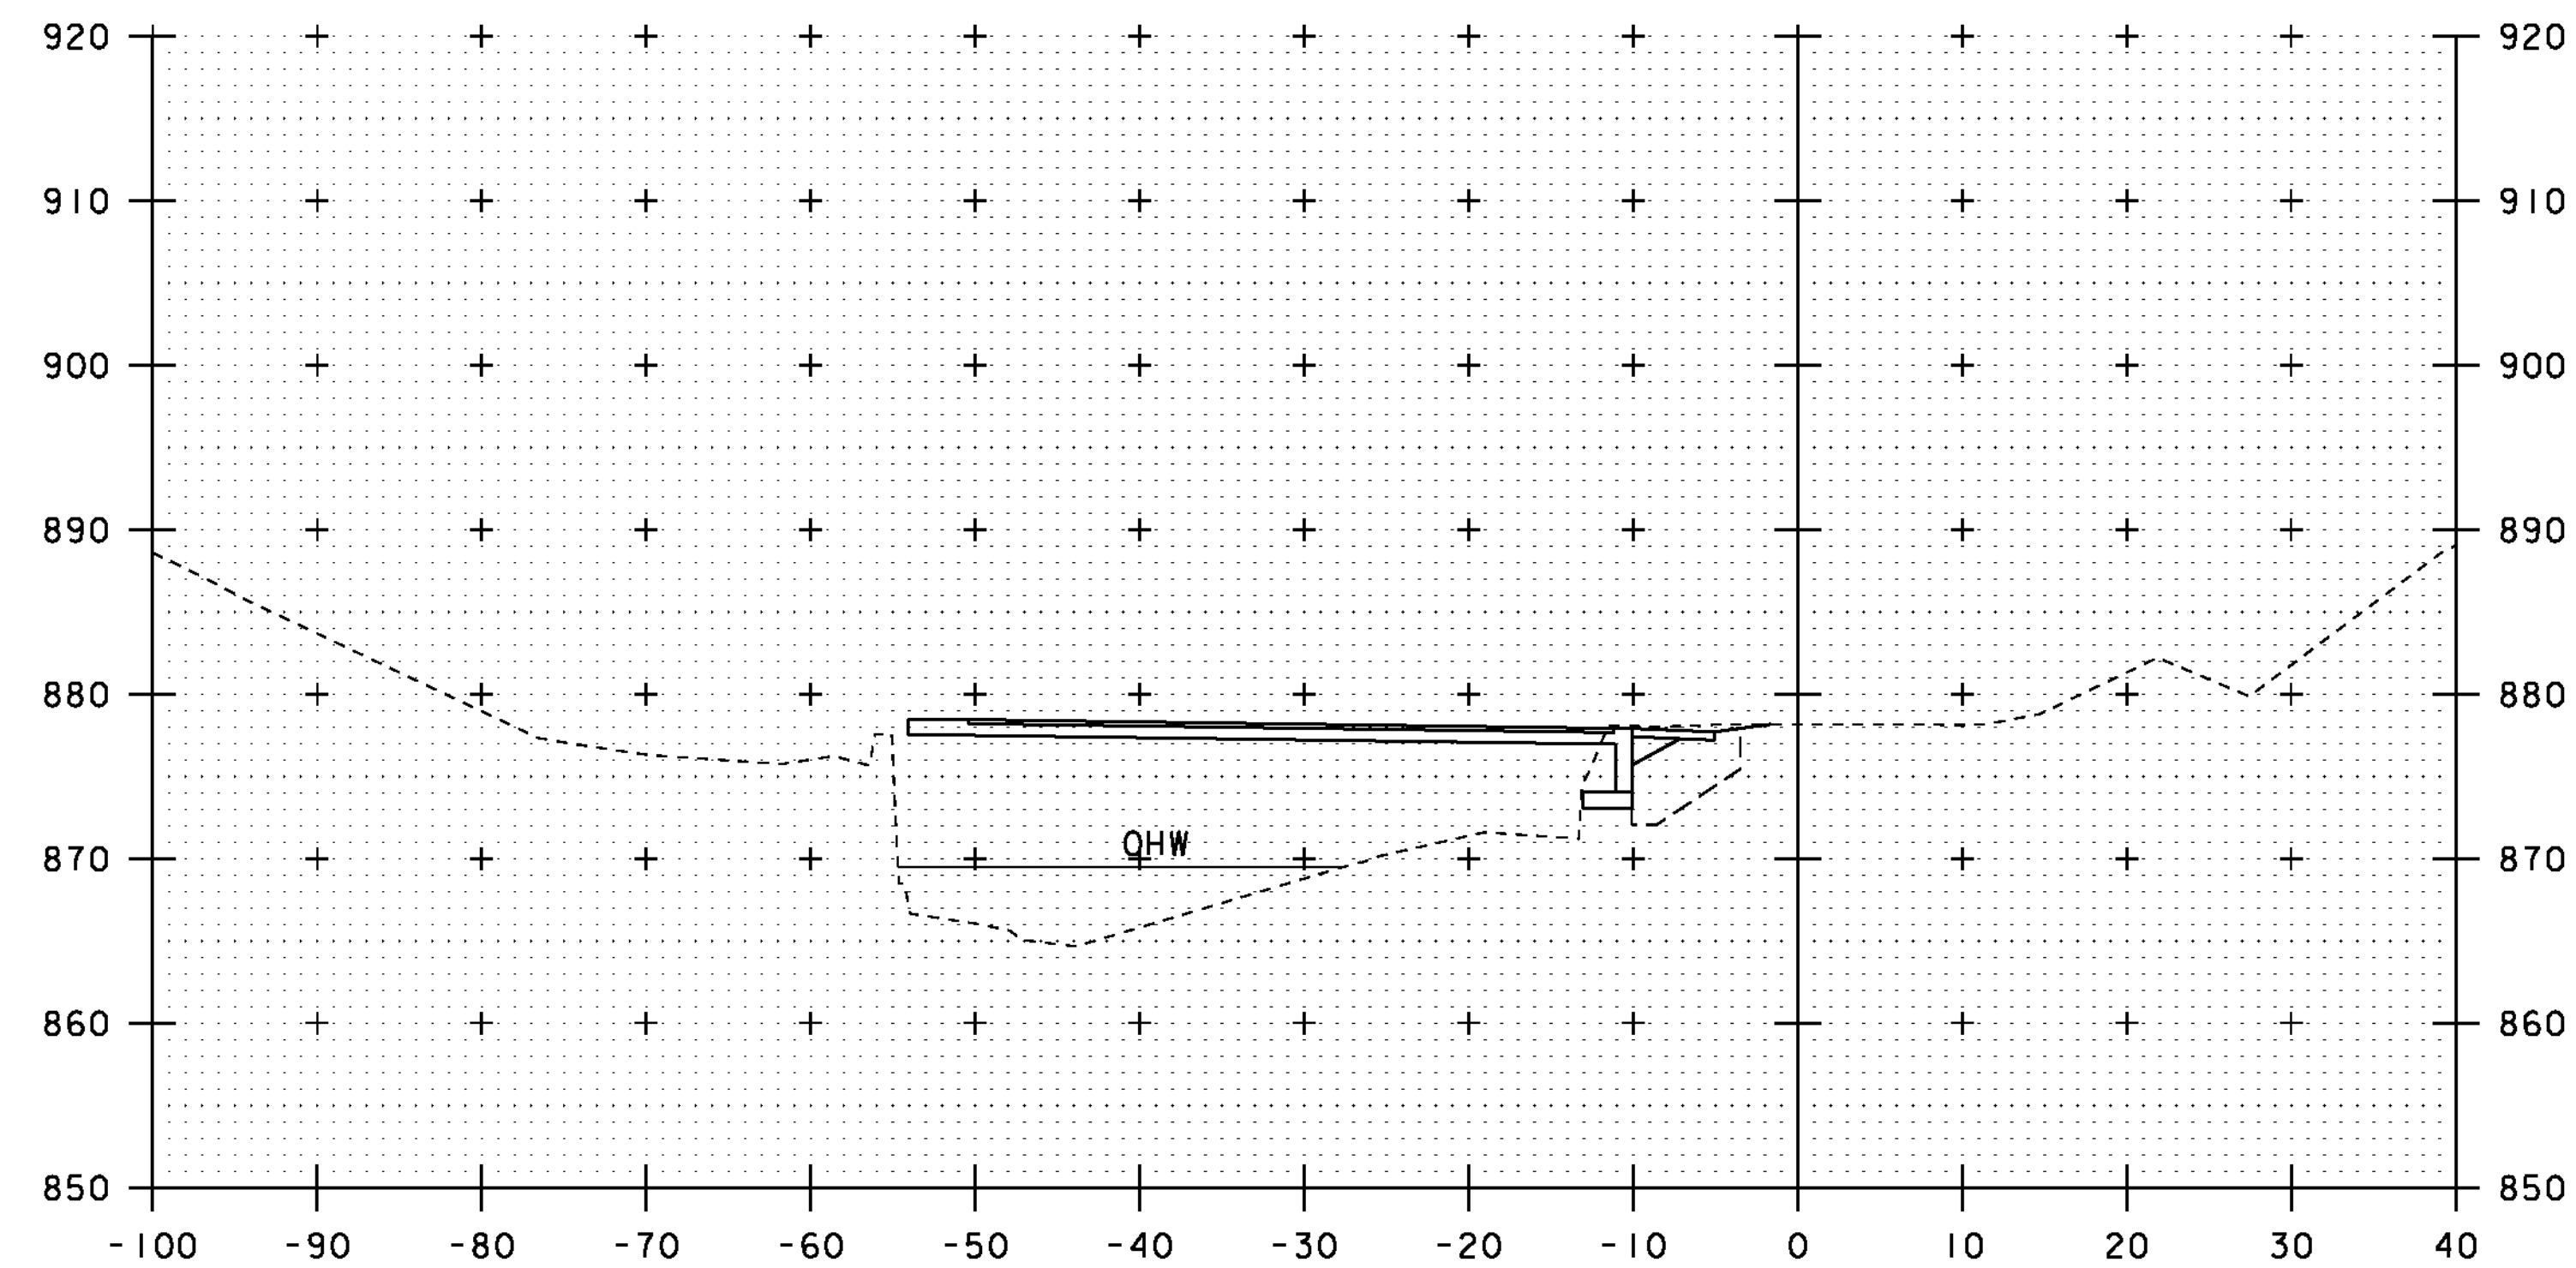


50+80

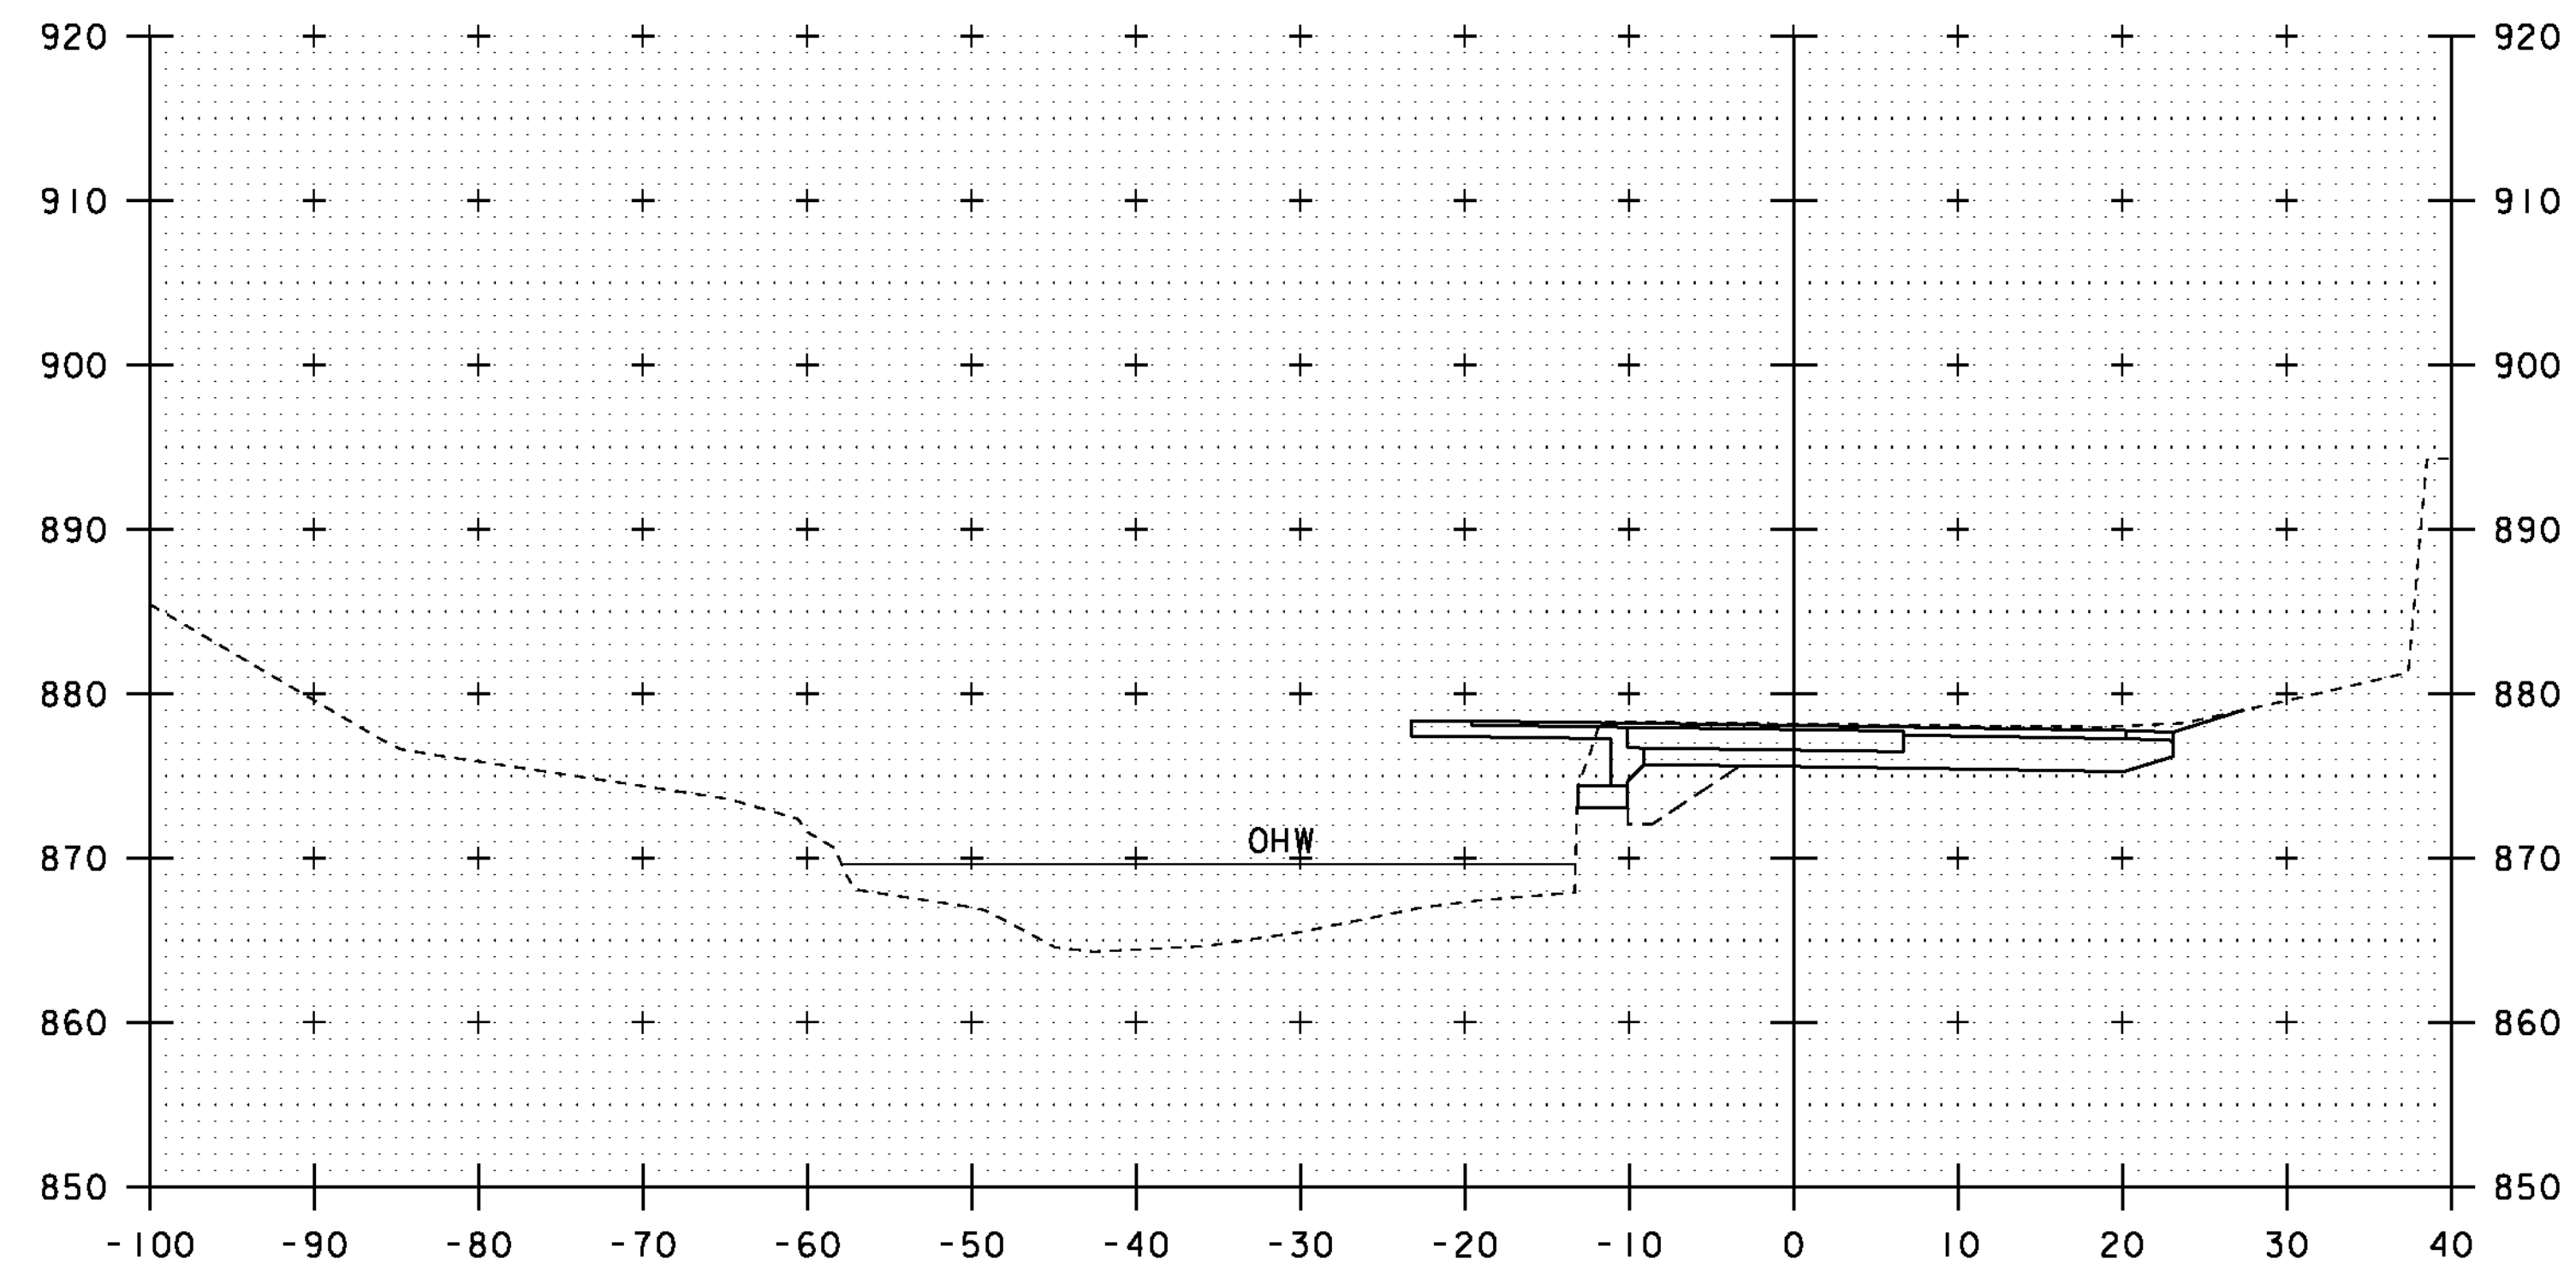


51+00

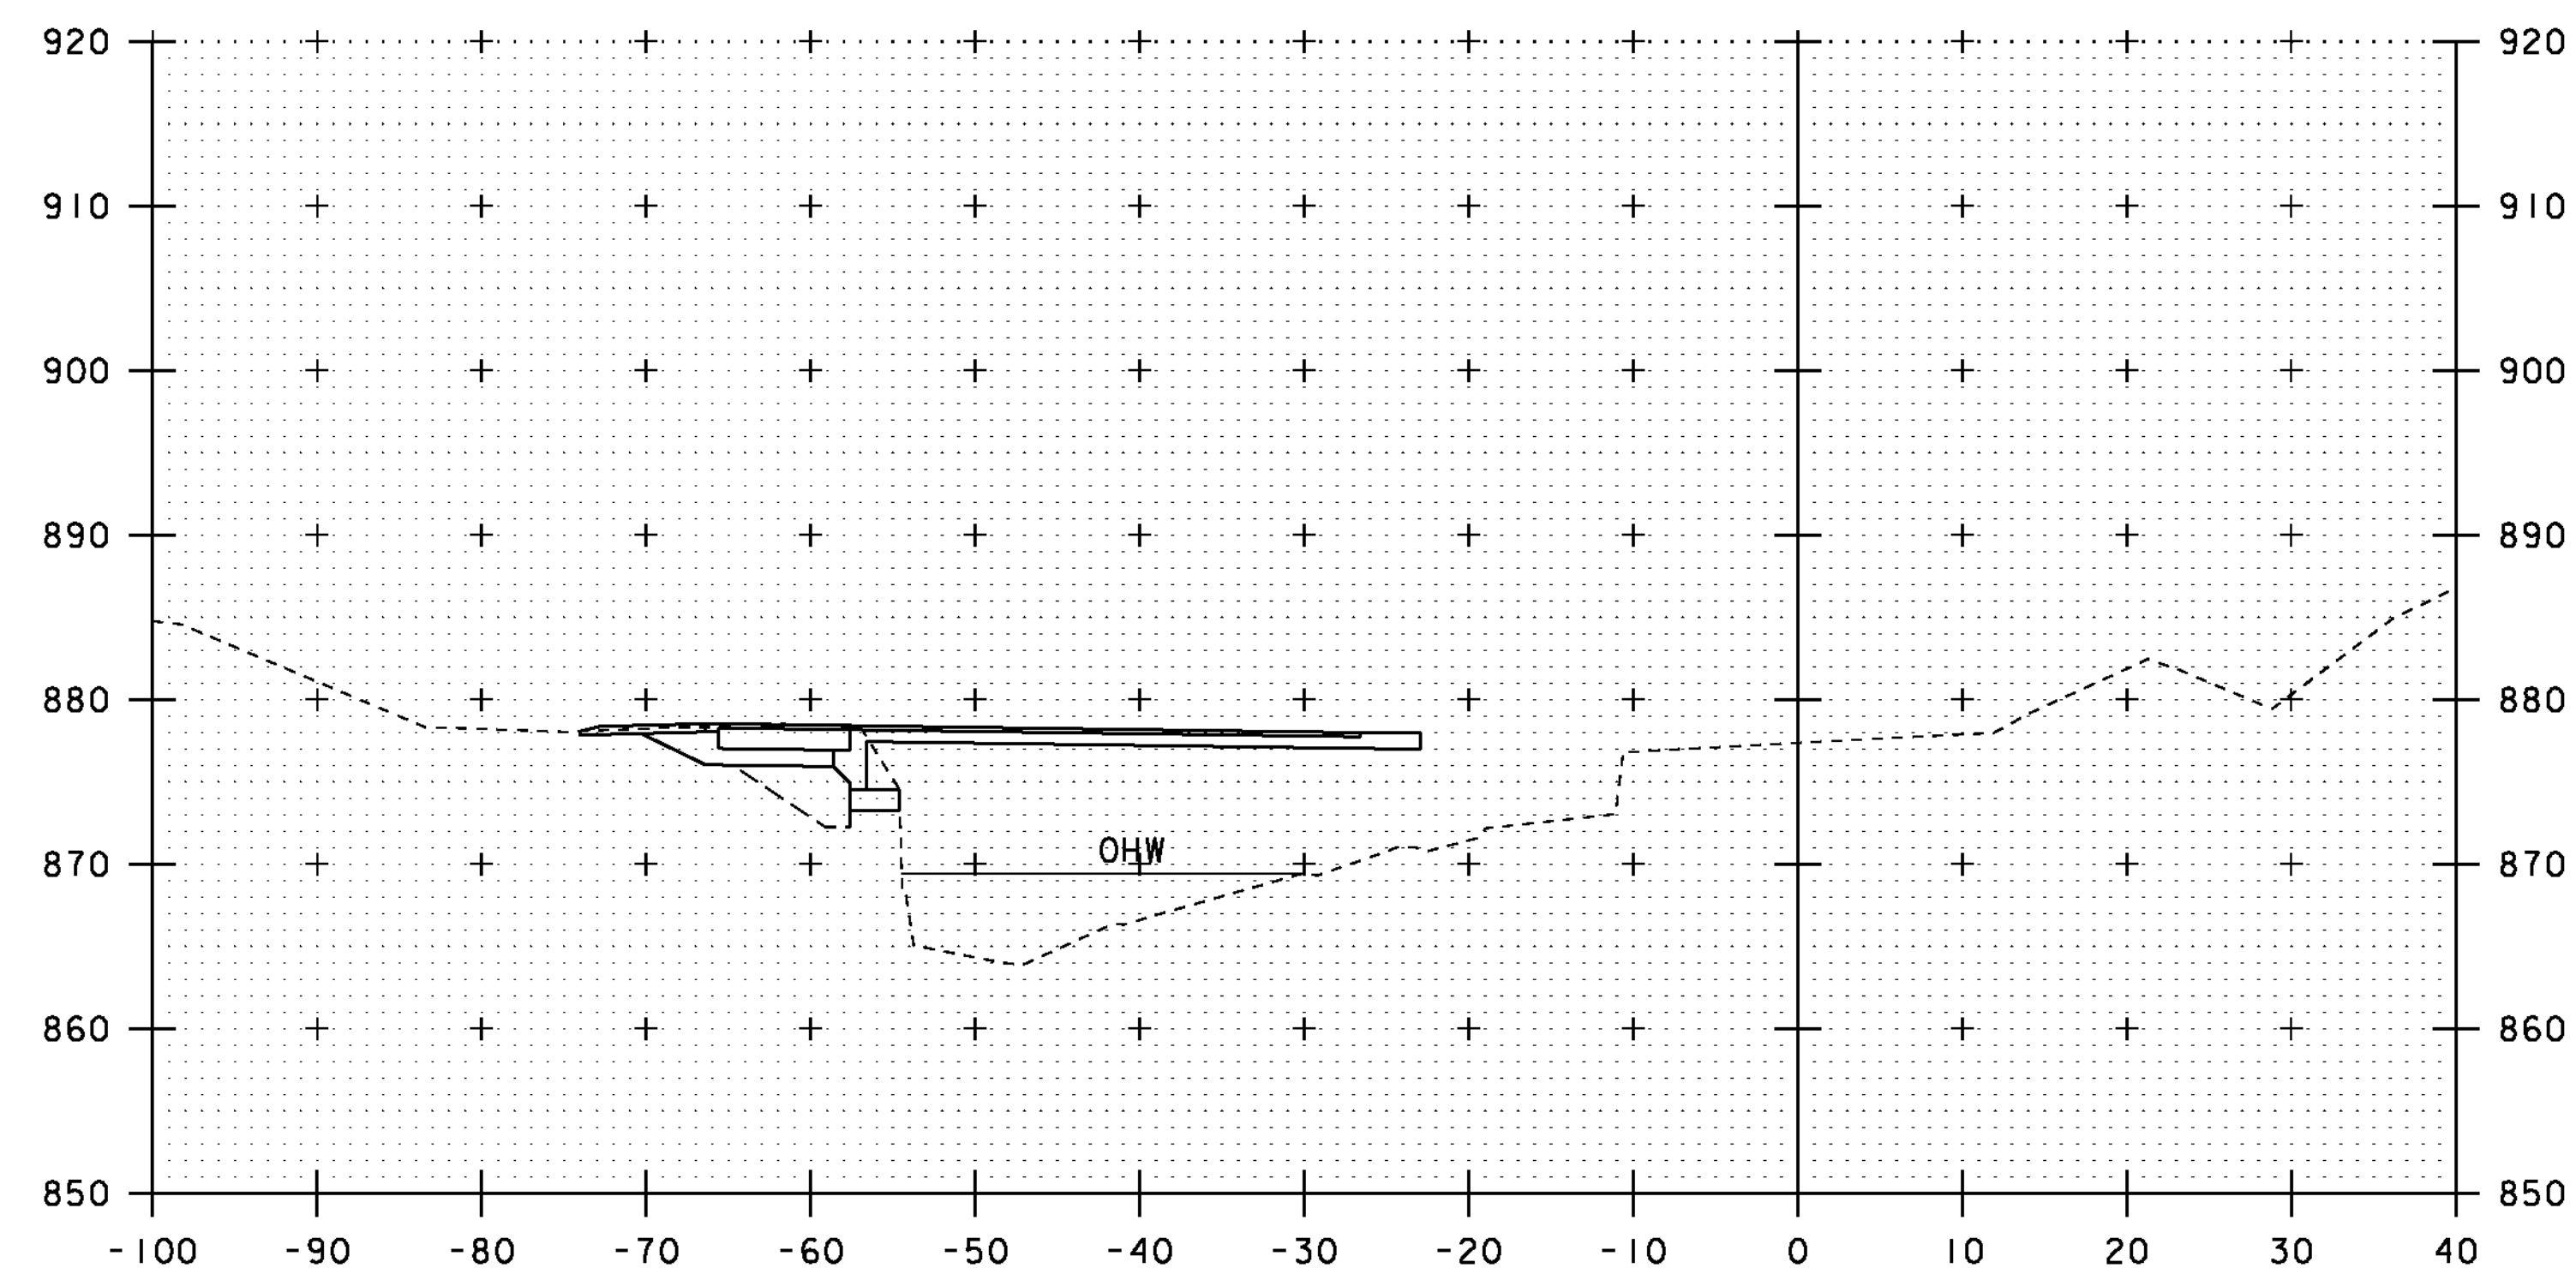

50+70

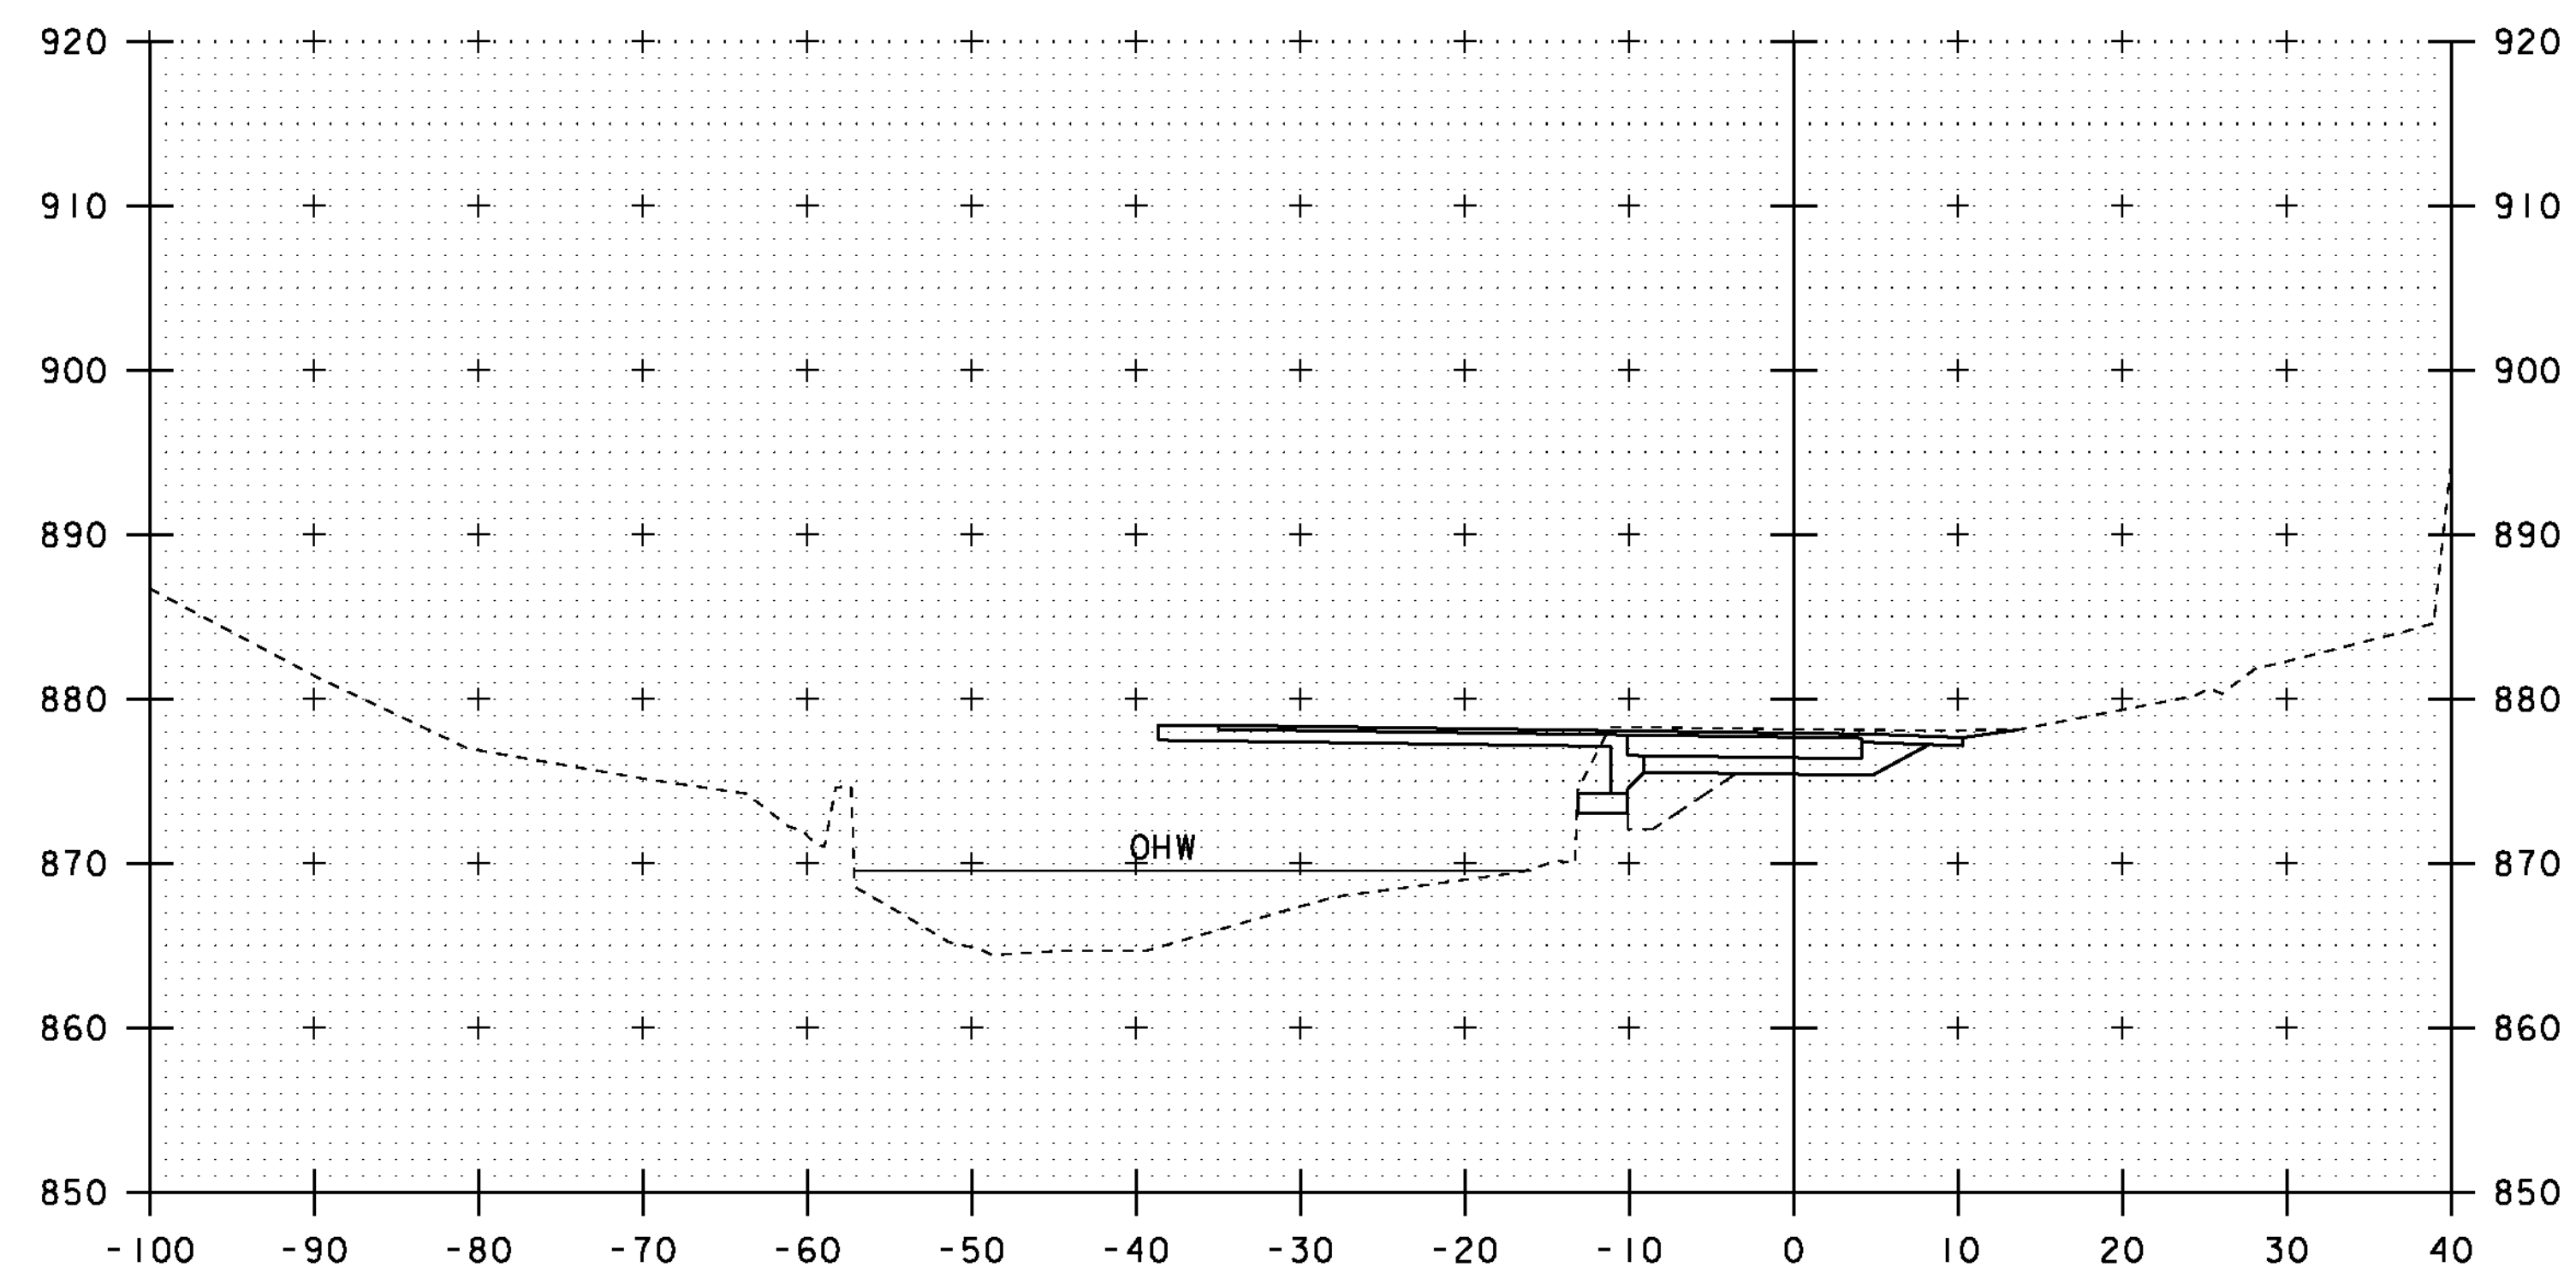

50+90

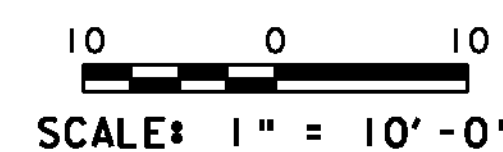

STA. 50+70 TO STA. 51+00

PROJECT NAME: ROXBURY	
PROJECT NUMBER: BHF 0187(8)	
FILE NAME: slOc420xsl.dgn	PLOT DATE: 21-SEP-2011
PROJECT LEADER: C. P. WILLIAMS	DRAWN BY: G. ROY
DESIGNED BY: G. ROY	CHECKED BY: T. FILLBACH
CHANNEL LINE CROSS SECTIONS (2)	SHEET 39 OF 54