


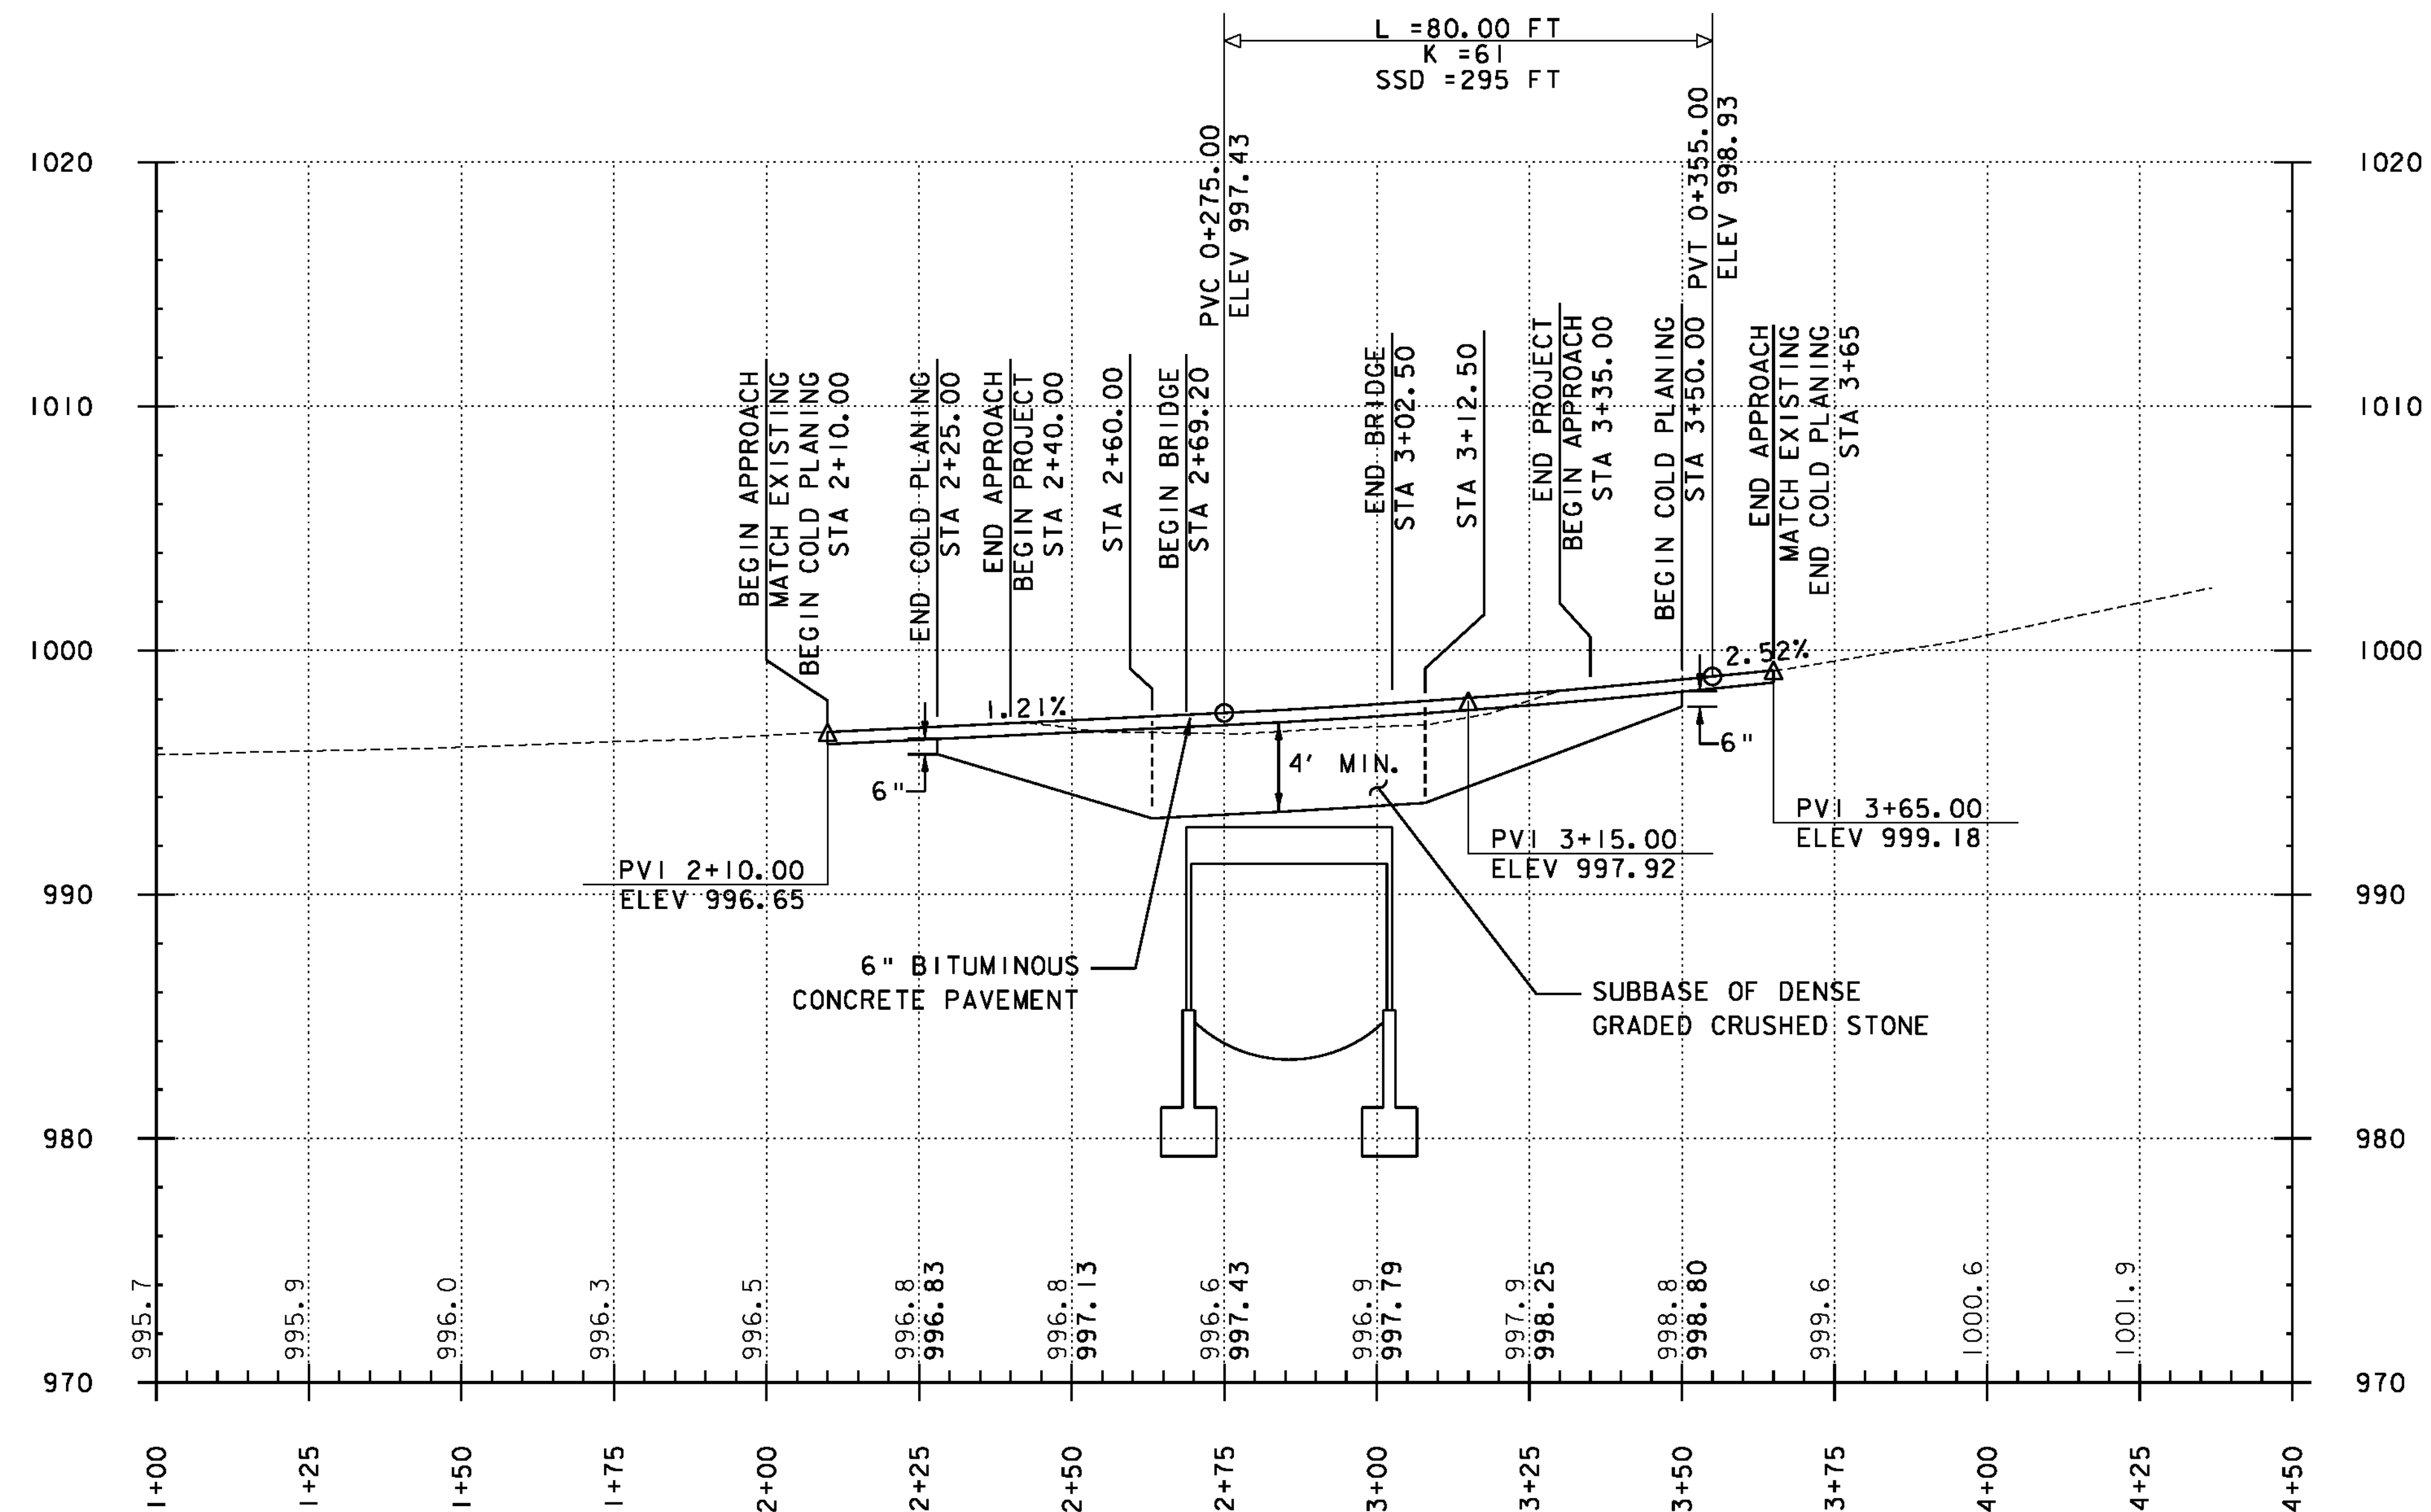


NOTE:

ELEVATION SHOWN TO THE NEAREST TENTHS ARE
EXISTING GROUND ALONG PROPOSED CENTERLINE.

ELEVATIONS SHOWN TO THE NEAREST HUNDREDTHS ARE
FINISH GRADE ALONG PROPOSED CENTERLINE.

PROFILE ALONG VT 12A

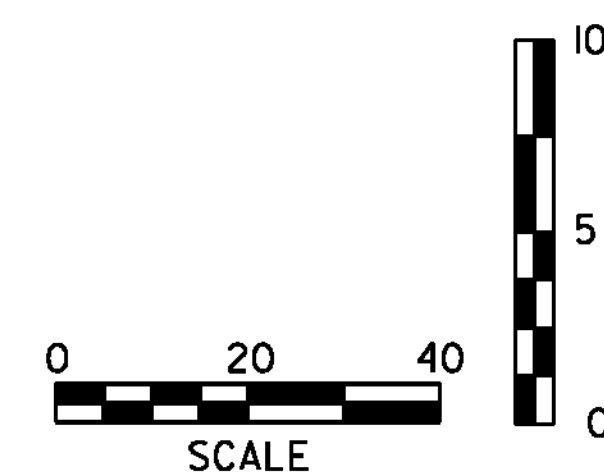

PROJECT NAME: ROXBURY	
PROJECT NUMBER: ER 0187(9)	
FILE NAME: ...drawing\plotfiles\pro.dgn	PLOT DATE: 9/21/2011
PROJECT LEADER: G. BOGUE	DRAWN BY: JTS/ISM
DESIGNED BY: M. CHENETTE	CHECKED BY: G. BOGUE
PROFILE	SHEET 47 OF 54