


27 18" x 10" BASE PLATES @ 1'-2" A 36
6 1/2" x 4" EXP FILL PLATE @ 2'-11" A 572 Gr SO

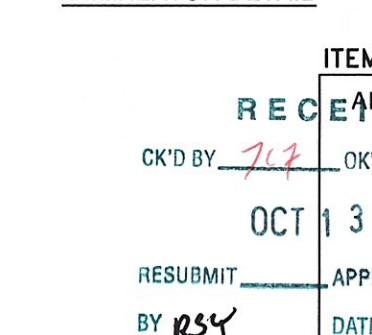

0		GEN CONTR: F.R. Lafayette		SH	
BY:		BRIDGE RAIL DETAILS SHEET ROUTE 12A, BR 15 & BR 22 TOWN OF ROXBURY, WASHINGTON COUNTY, VT			
R	NO.	DATE	DESCRIPTION	BY	R
E	V			E	V
		 ELDERLEE, INC. OAKS CONCRETE NEW YORK 15178 E-Mail: doug@elderlee.com		 DRAWN CHECKED APPROVED SCALE	

Tel: 315-789-6670 Fax: 315-789-6615 DRAWING NO. FR Lafayette EM1' 220