
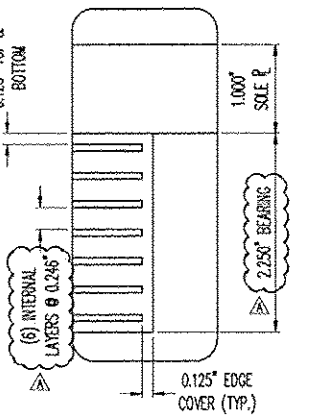
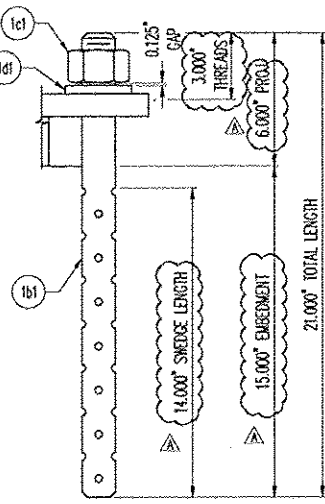


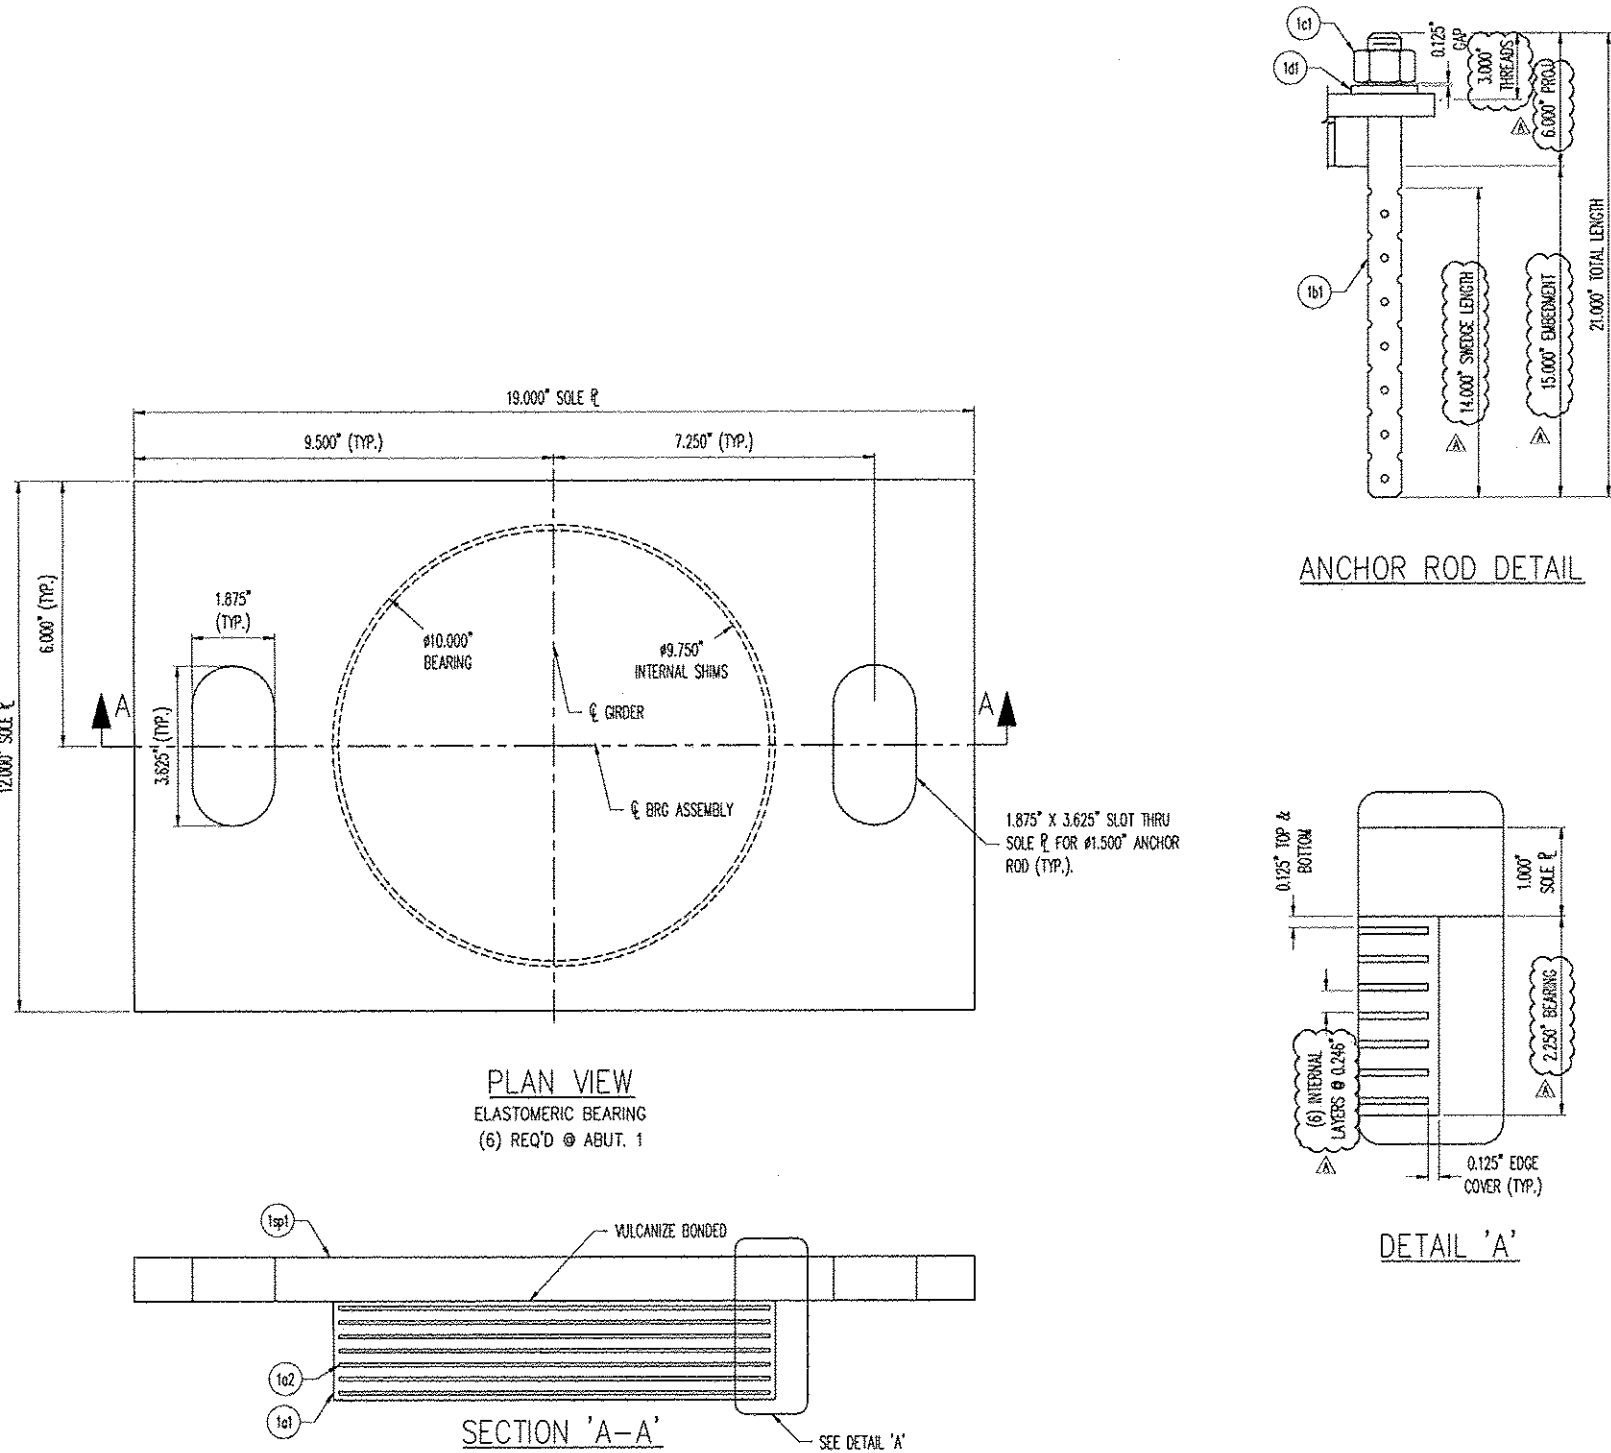

LOAD TABLE	
LIVE LOAD (KIPS)	60.0
DEAD LOAD (KIPS)	20.0

NO.	QTY	DESCRIPTION	MATERIAL	LENGTH	REMARKS	REV.
1A	6	ELASTOMERIC BEARING			50% ± 5% ELONGATION PER INCH	-
1a1	6	1.250\"	NATURAL RUBBER		50% ± 5% ELONGATION PER INCH	A
1a2	6	14 GA. X 0.015\"	ADHESIVE		ADHESIVE	A
1a3	6	1.000\" X 0.015\"	ADHESIVE		ADHESIVE	A
1B	12	SHEAR ROD			3\" TENSILE STRENGTH	-
1B1	12	0.500\" X 21.000\" SHEAR ROD	A307 (A307)		3\" TENSILE STRENGTH	A
1C	12	HEX NUT			HEX NUT	-
1C1	12	0.500\" HEX NUT	A307 (A307)		HEX NUT	A
1D	12	WASHER PLATE			WASHER PLATE	-
1D1	12	0.125\" X 1.000\"	A307 (A307)		WASHER PLATE	A

SEE SH. QNT FOR GENERAL NOTES.

NO.	QTY	DESCRIPTION	MATERIAL	LENGTH	REMARKS	REV.
1A	6	ELASTOMERIC BEARING			50% ± 5% ELONGATION PER INCH	-
1a1	6	1.250\"	NATURAL RUBBER		50% ± 5% ELONGATION PER INCH	A
1a2	6	14 GA. X 0.015\"	ADHESIVE		ADHESIVE	A
1a3	6	1.000\" X 0.015\"	ADHESIVE		ADHESIVE	A
1B	12	SHEAR ROD			3\" TENSILE STRENGTH	-
1B1	12	0.500\" X 21.000\" SHEAR ROD	A307 (A307)		3\" TENSILE STRENGTH	A
1C	12	HEX NUT			HEX NUT	-
1C1	12	0.500\" HEX NUT	A307 (A307)		HEX NUT	A
1D	12	WASHER PLATE			WASHER PLATE	-
1D1	12	0.125\" X 1.000\"	A307 (A307)		WASHER PLATE	A

RECEIVED
OCT 12 2011
RESUBMIT BY PSY DATE 10/13/2011
APPROVED [Signature]

D.B. BROWN
200 E. 10TH STREET
NORTH DAVENPORT, IOWA 50601
PH 515.251.5511
FAX 515.251.5512
WWW.DBBROWN.COM

NO.	QTY	DESCRIPTION	MATERIAL	LENGTH	REMARKS	REV.
1A	6	ELASTOMERIC BEARING			50% ± 5% ELONGATION PER INCH	-
1a1	6	1.250\"	NATURAL RUBBER		50% ± 5% ELONGATION PER INCH	A
1a2	6	14 GA. X 0.015\"	ADHESIVE		ADHESIVE	A
1a3	6	1.000\" X 0.015\"	ADHESIVE		ADHESIVE	A
1B	12	SHEAR ROD			3\" TENSILE STRENGTH	-
1B1	12	0.500\" X 21.000\" SHEAR ROD	A307 (A307)		3\" TENSILE STRENGTH	A
1C	12	HEX NUT			HEX NUT	-
1C1	12	0.500\" HEX NUT	A307 (A307)		HEX NUT	A
1D	12	WASHER PLATE			WASHER PLATE	-
1D1	12	0.125\" X 1.000\"	A307 (A307)		WASHER PLATE	A