



* NO WELD FOR $\frac{3}{8}$ " MIN.
OR $\frac{7}{8}$ " MAX.

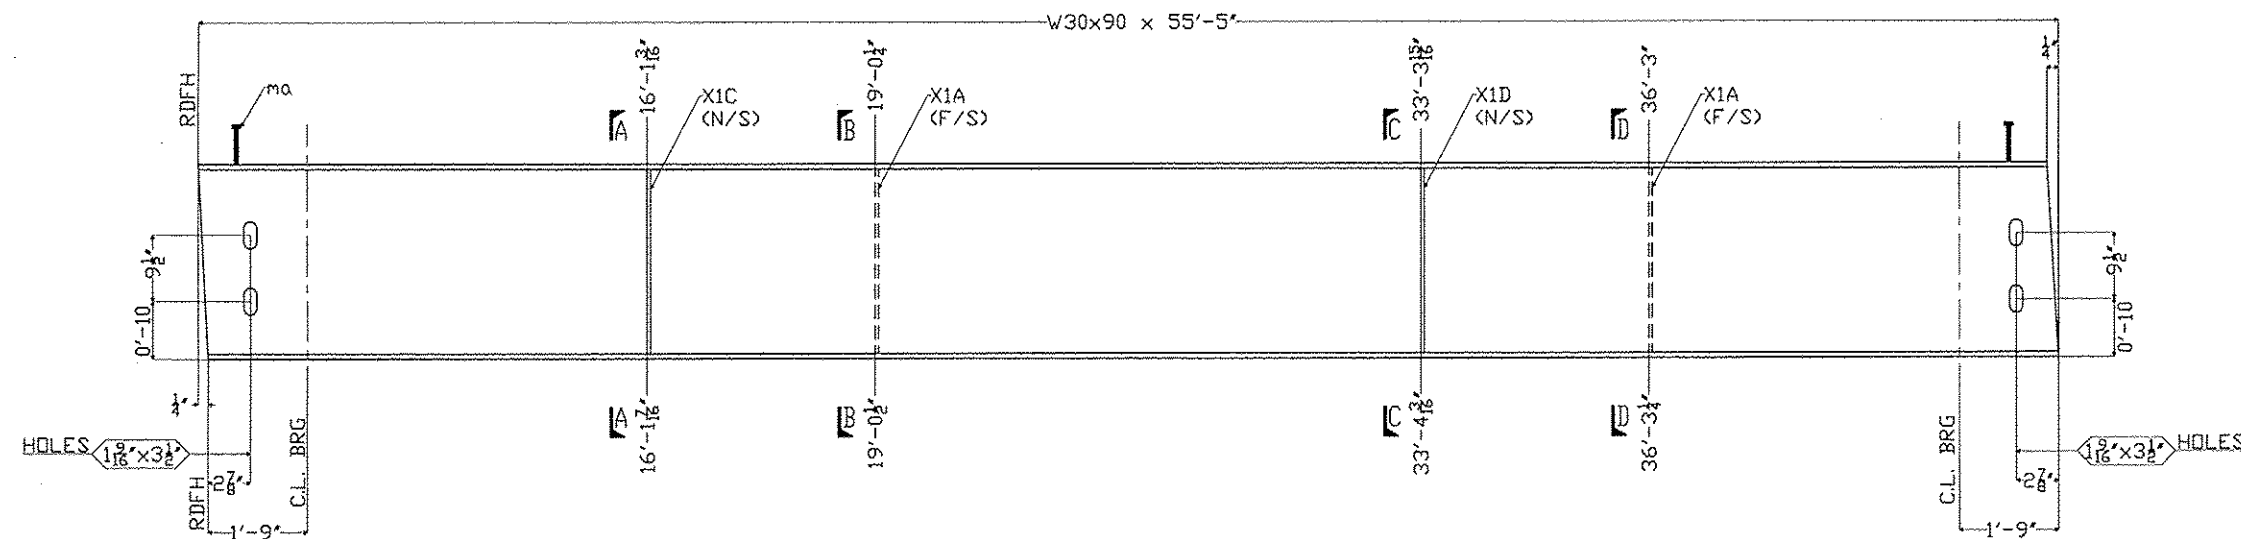


ONE ~ GIRDER DETAIL ~ 2B1

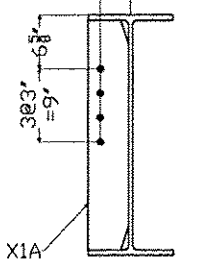

SECTION A-A

SECTION B-E

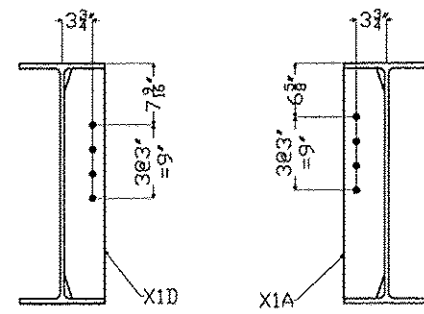

SECTION C-C

SECTION D-D

[illegible]

RECEIVED
CK'D BY _____ OK'D BY RSY
OCT 17 2011
RESUBMIT _____ APPROVED ✓
BY _____ DATE 10/19/2011

					
REVISION DATE		REVISION			
GIRDER DETAIL					
TOWN OF ROXBURY, HAMPSHIRE COUNTY, VT					
PROJECT NUMBER: BHF 0187(8)					
VT 124, MAJOR COLLECTOR - BRIDGE 15					
PRECISE STRUCTURAL PRODUCTS					
3 FARM LANE					
GEORGETOWN, MA 01833					
978-252-2591					
					
OWNER: VT AGENCY OF TRANSPORTATION					
CONTRACTOR: LUCK BROTHERS INC					
DESIGNED BY	CHECKED BY	APPR.	SHOP	DIST.	SHEET NO.
KC	MC				
10/27/11	10/10/11				
				3590	2