

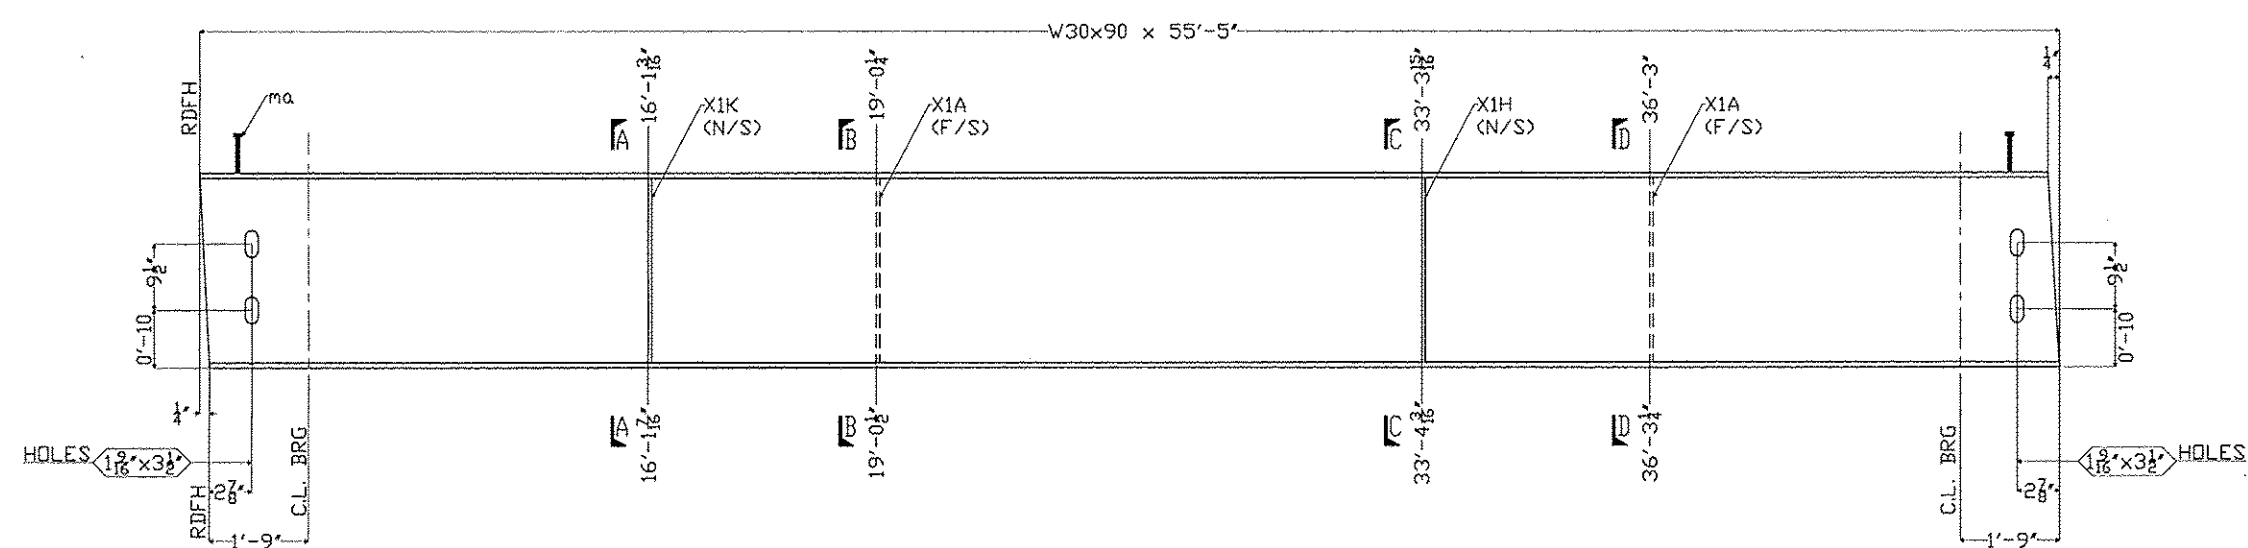


TYP. DIAPHRAGM STIFFENER
WELD DETAIL


* NO WELD FOR $\frac{3}{8}$ " MIN.
OR $\frac{7}{8}$ " MAX.

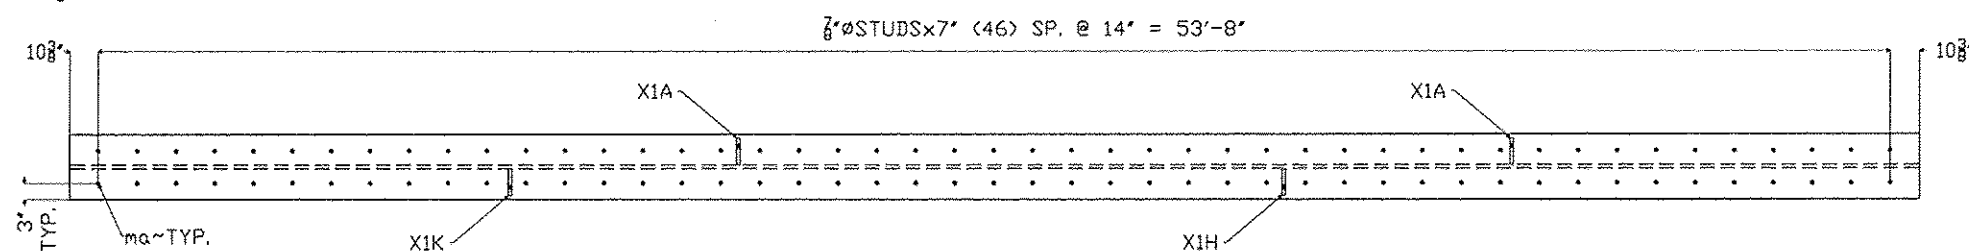


ONE ~ GIRDER DETAIL ~ 4B1

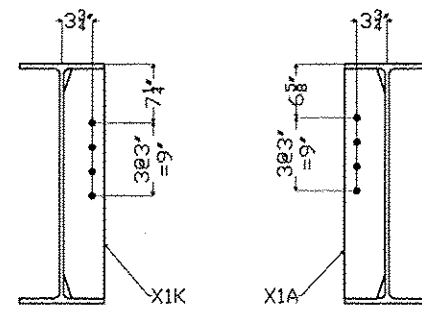


SECTION A-A

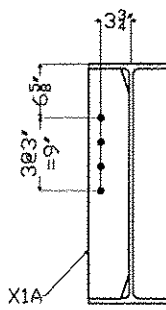

SECTION B-E

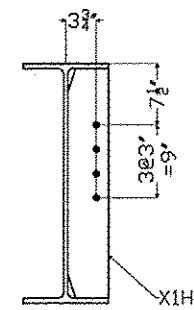

SECTION C-C

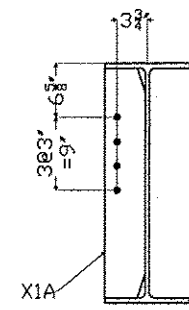

SECTION D-D

SHIPPER		BILL OF MATERIAL						
NO.	MARK	NO.	MARK	SIZE	LENGTH	REMARKS	ITEM	WEIGHT
1	4B1	2	XIA	V30x90	55'-5"	CVN		
		1	XIH	PL 4"x5	2'-4 1/8"	CVN		
		1	XIK	PL 4"x5	2'-4 1/8"	CVN		
		94	no	2" STUD	0'-7"	CVN		

RECEIVED
CK'D BY _____ OK'D BY RSY
OCT 17 2011
RESUBMIT _____ APPROVED ☒
BY _____ DATE 10/18/2011

			
TOWN OF ROXBURY, WASHINGTON COUNTY, VT PROJECT NUMBER: BH# 0187(8) VT 12A, MAJOR COLLECTOR - BRIDGE 15			
REVISION DATE: _____ REVISION: _____			
GIRDER DETAIL			
PRECISE STRUCTURAL PRODUCTS			
3 FARM LANE GEORGETOWN, MA 01833 978-552-2581			
OWNER: VT AGENCY OF TRANSPORTATION CONTRACTOR: LUCK BROTHERS INC			
DRAWN BY: _____ 10/27/11	CHECKED BY: _____ 10/10/11	APPR. _____ SHOP _____ DIST. _____	CONTRACT NO. _____ 3590
			SHEET NO. _____ 4