
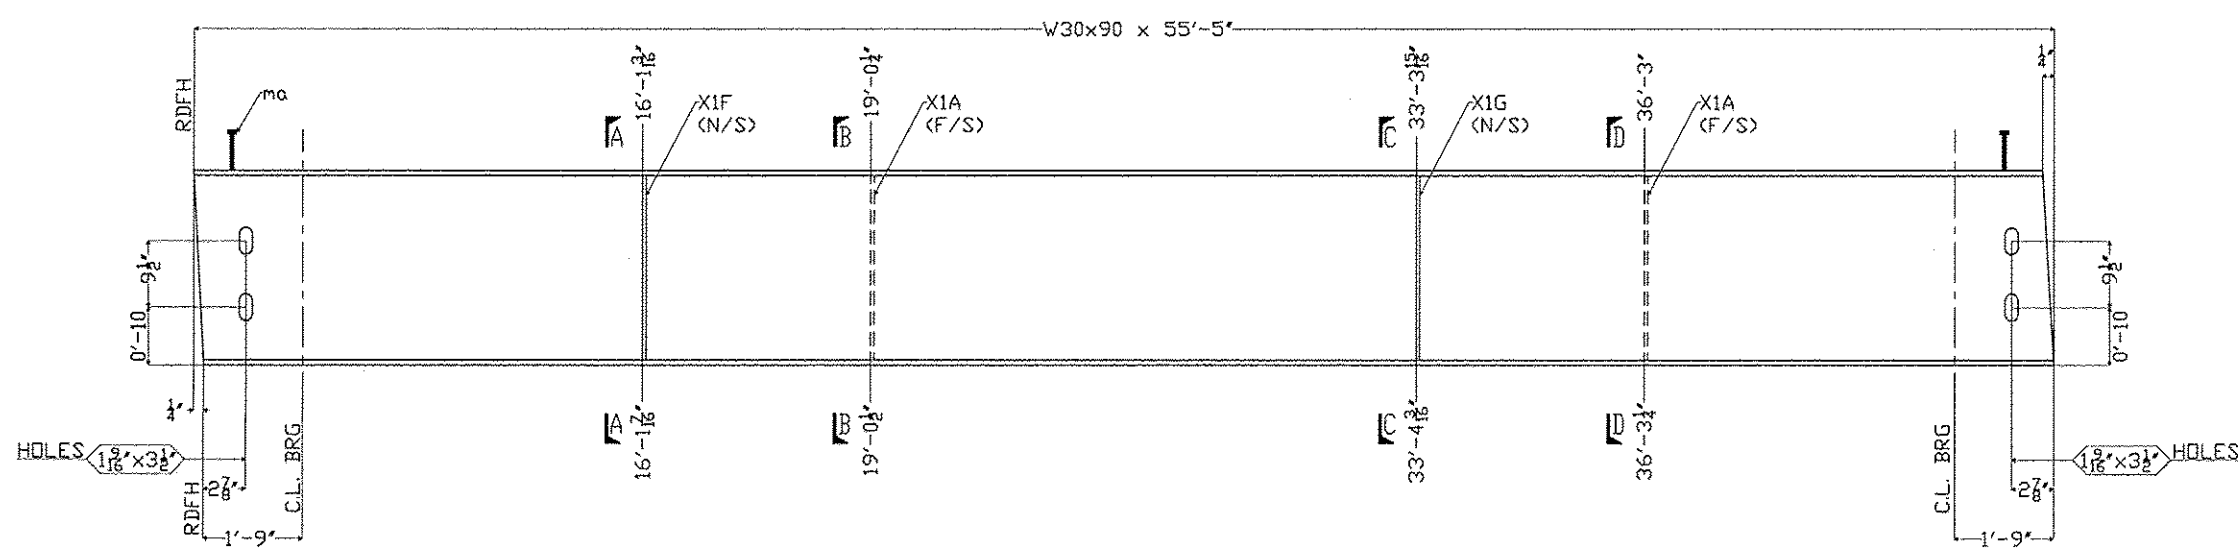
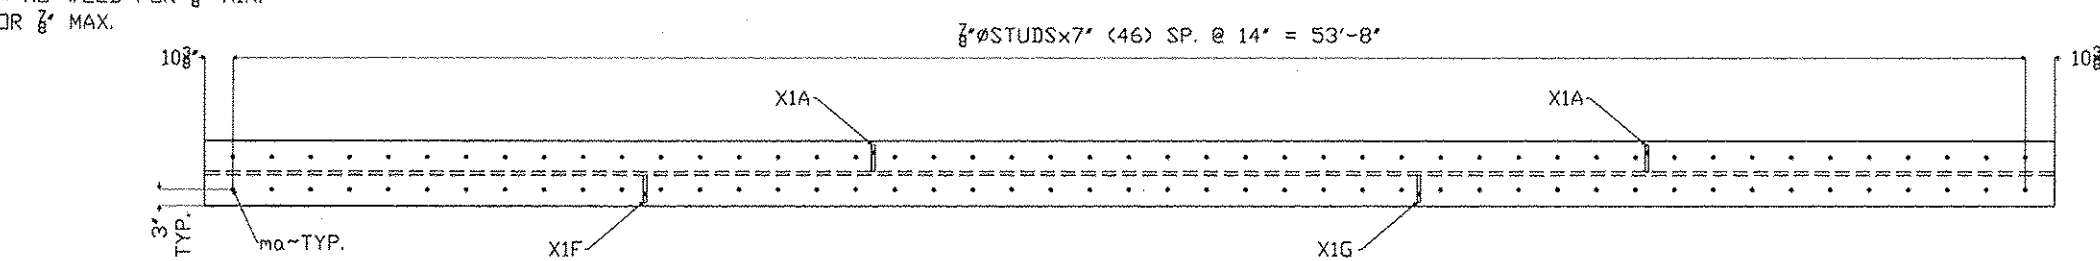


TYP. DIAPHRAGM STIFFENER
WELD DETAIL

* NO WELD FOR 3' MIN.
OR 2' MAX.

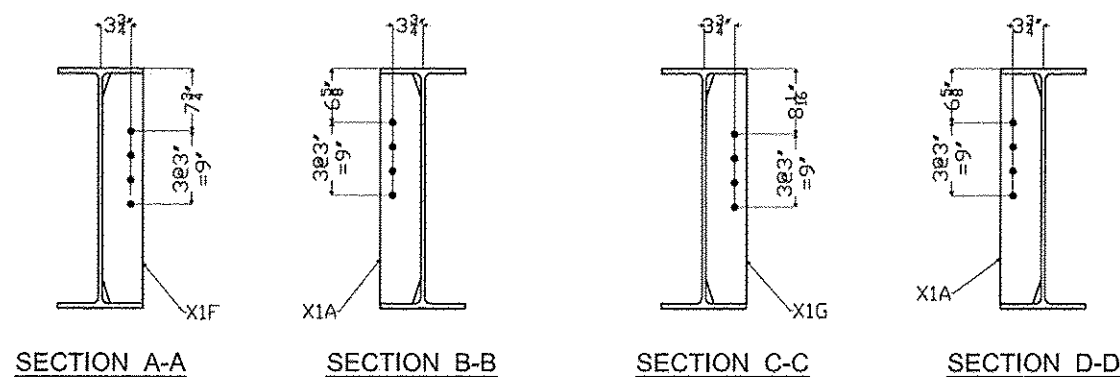

ONE ~ GIRDER DETAIL ~ 5B1

[illegible]

RECEIVED
OK'D BY _____ OK'D BY RSY
OCT 17 2011
RESUBMIT _____ APPROVED ✓
BY _____ DATE 10/18/2011

									
									
									
REV/NO		DATE		-		REVISION			
GIRDER DETAIL									
TOWN OF ROXBURY, WASHINGTON COUNTY, VT									
PROJECT NUMBER: BHF 0187(S)									
VT 124, MAJOR COLLECTOR - BRIDGE 15									
PRECISE STRUCTURAL PRODUCTS									
3 FARM LANE									
GEORGETOWN, MA 01833									
(978) 252-7501									
									
OWNER: VT AGENCY OF TRANSPORTATION									
CONTRACTOR: LUCK BROTHERS INC									
DOWN BY	CHECKED BY	APP.	SHOP	DET.	CONTRACT NO.	SHEET NO.			
10/07/11	KL	10/10/11			3590	5			