


SEE REVISED SHEET

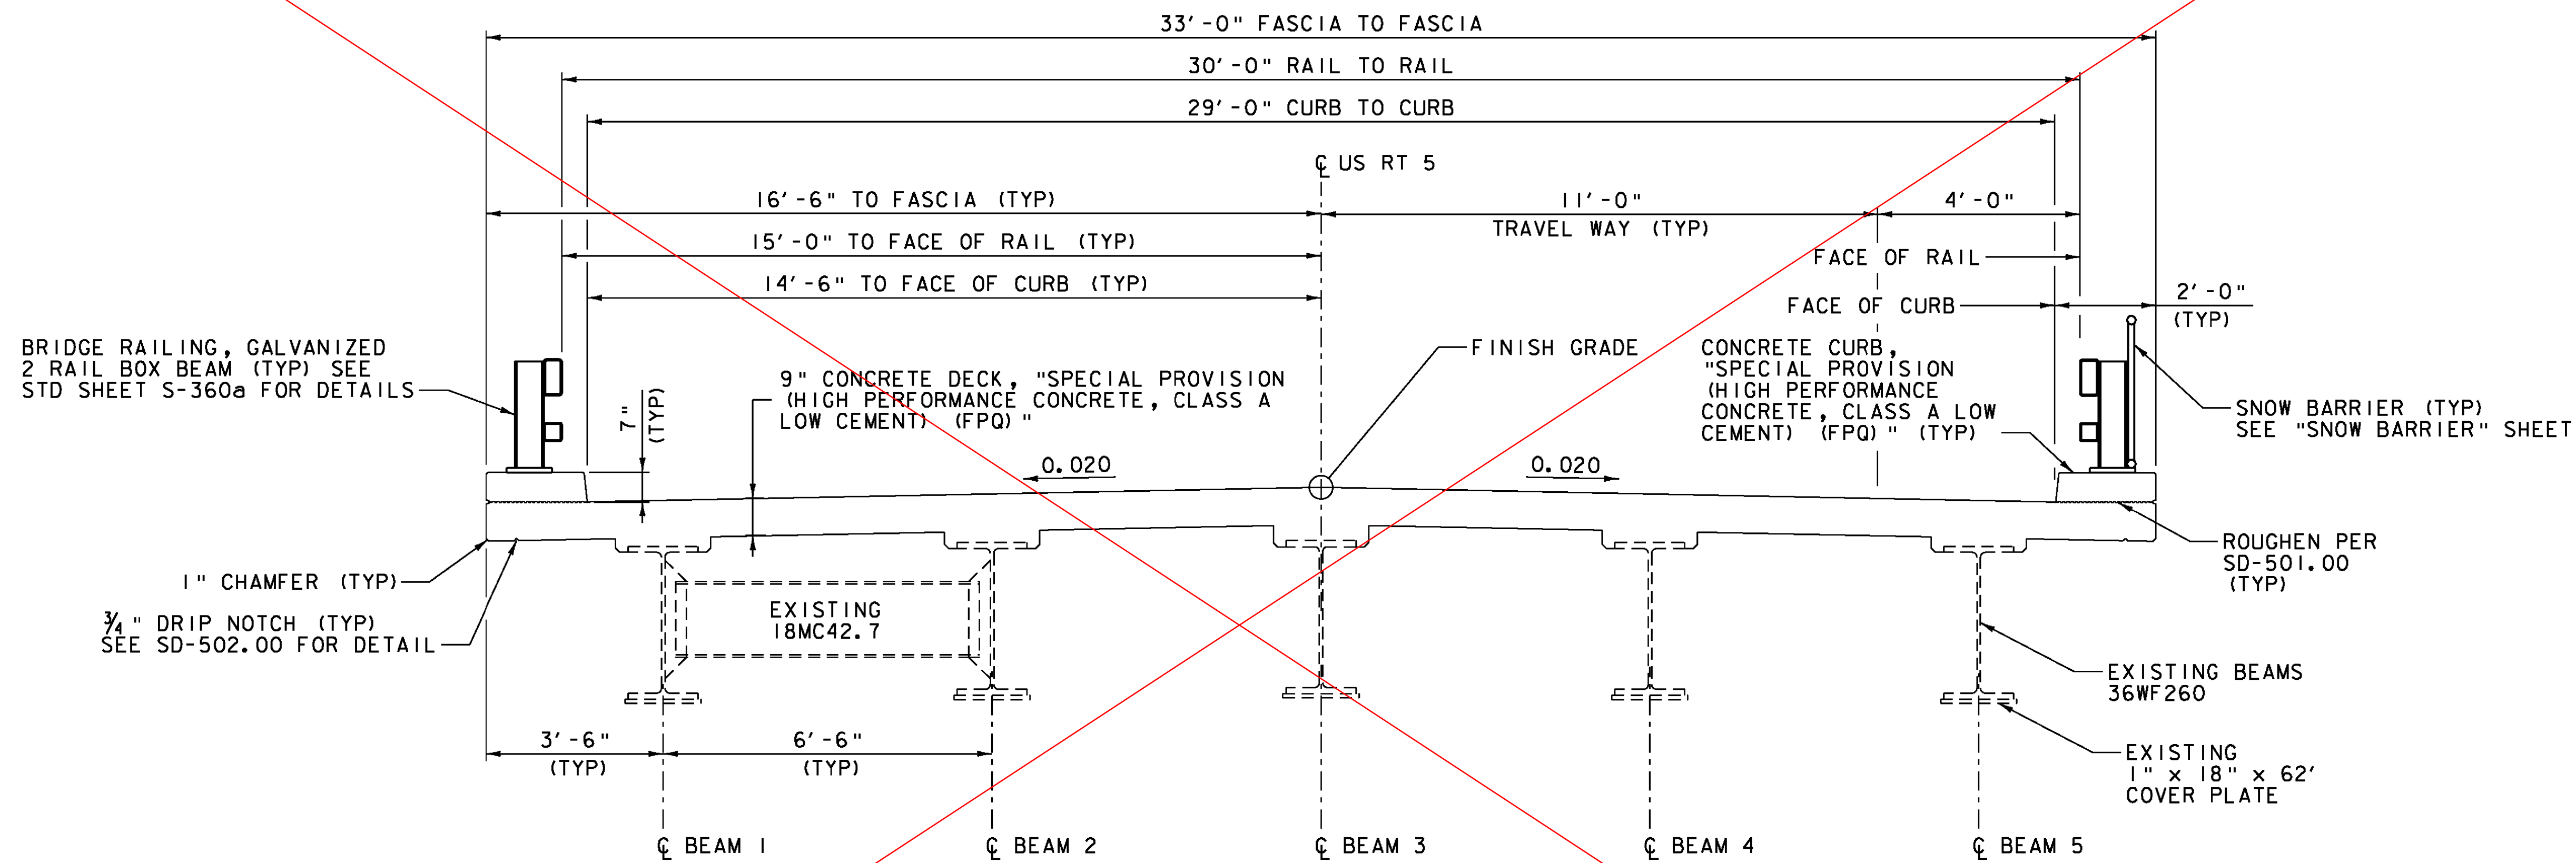

TYPICAL BRIDGE SECTION
 SCALE: 1/2" = 1'-0"

PROJECT NAME: HARTLAND	PLOT DATE: 1/2/2014
PROJECT NUMBER: BHF BPNT(12)	DRAWN BY: A.J. GOUDREAU
FILE NAME: zllc2601yp.dgn	CHECKED BY: S.G. FARNSWORTH
PROJECT LEADER: M.A. COLGAN	SHEET 3 OF 55
DESIGNED BY: A.J. GOUDREAU	
BR 62A TYPICAL BRIDGE SECTION	

