

GPS CONTROL POINTS

HVCTRL #1

NORTH = 20000.00  
 EAST = 10000.00  
 ELEV. = 100.00




HVCTRL #2

NORTH = 19825.030  
 EAST = 9863.306  
 ELEV. = 114.457

HVCTRL #3

NORTH = 19930.980  
 EAST = 9856.446  
 ELEV. = 76.262

TRAVERSE TIES

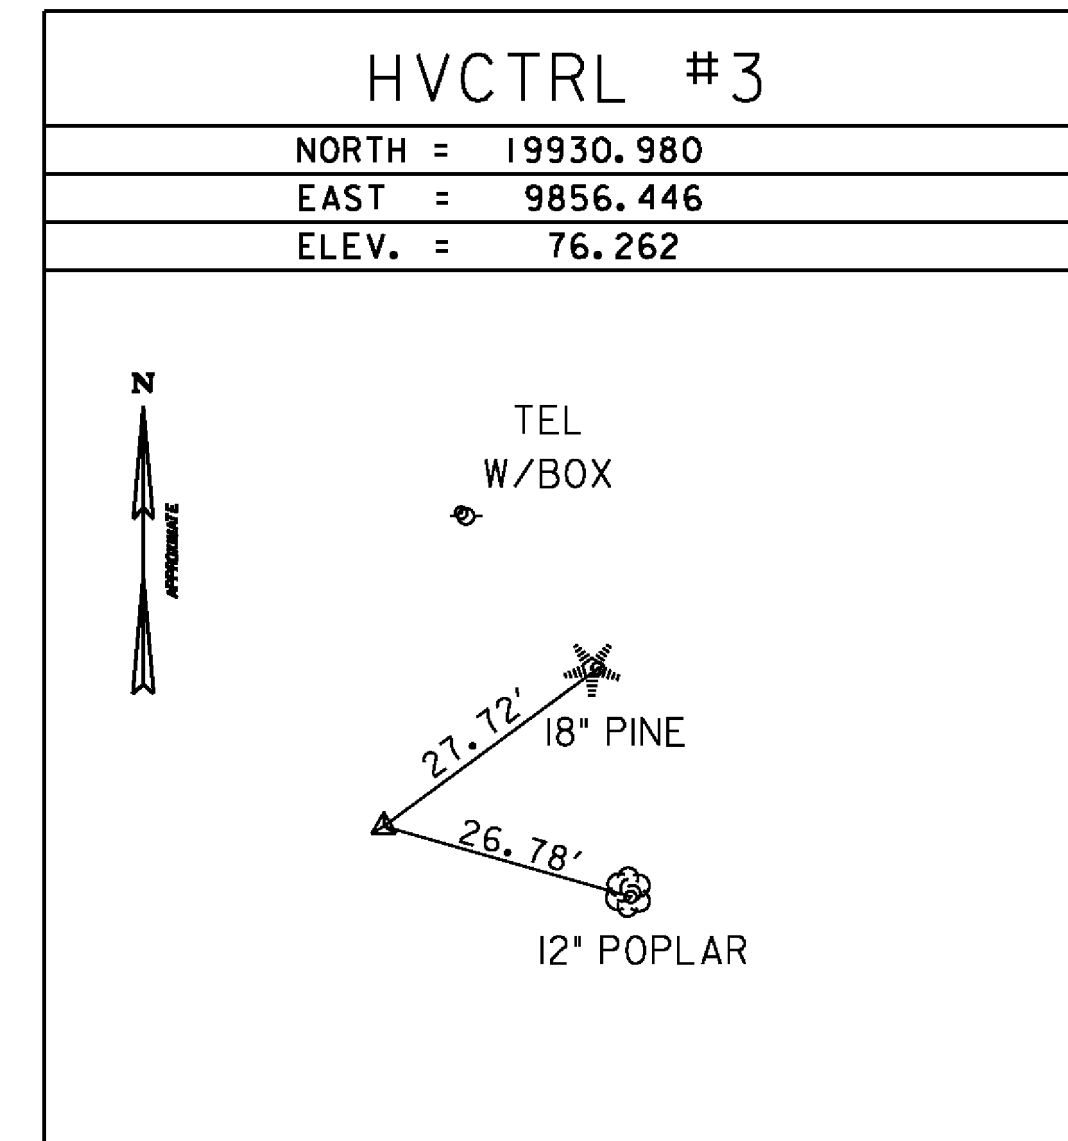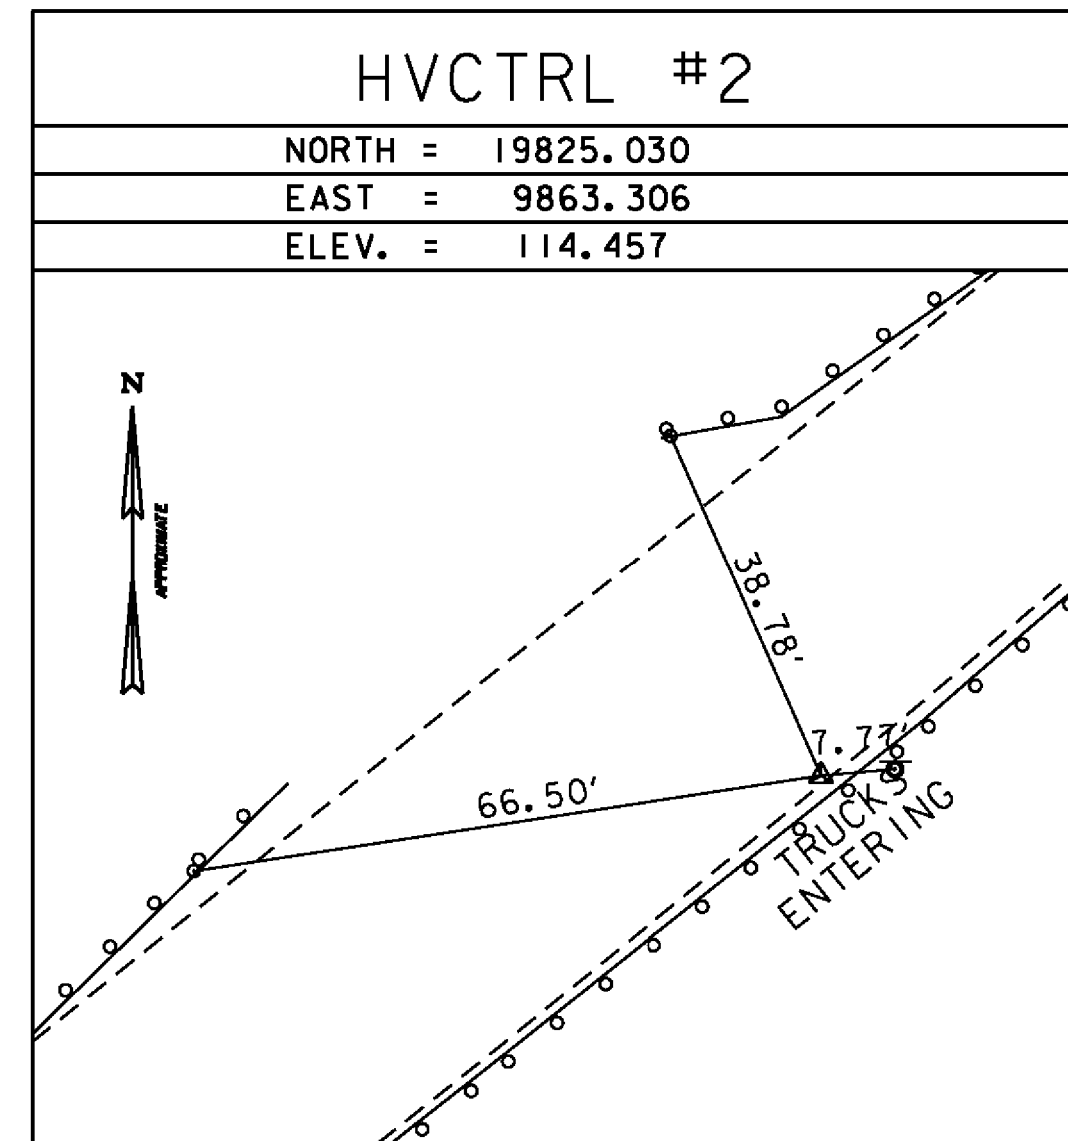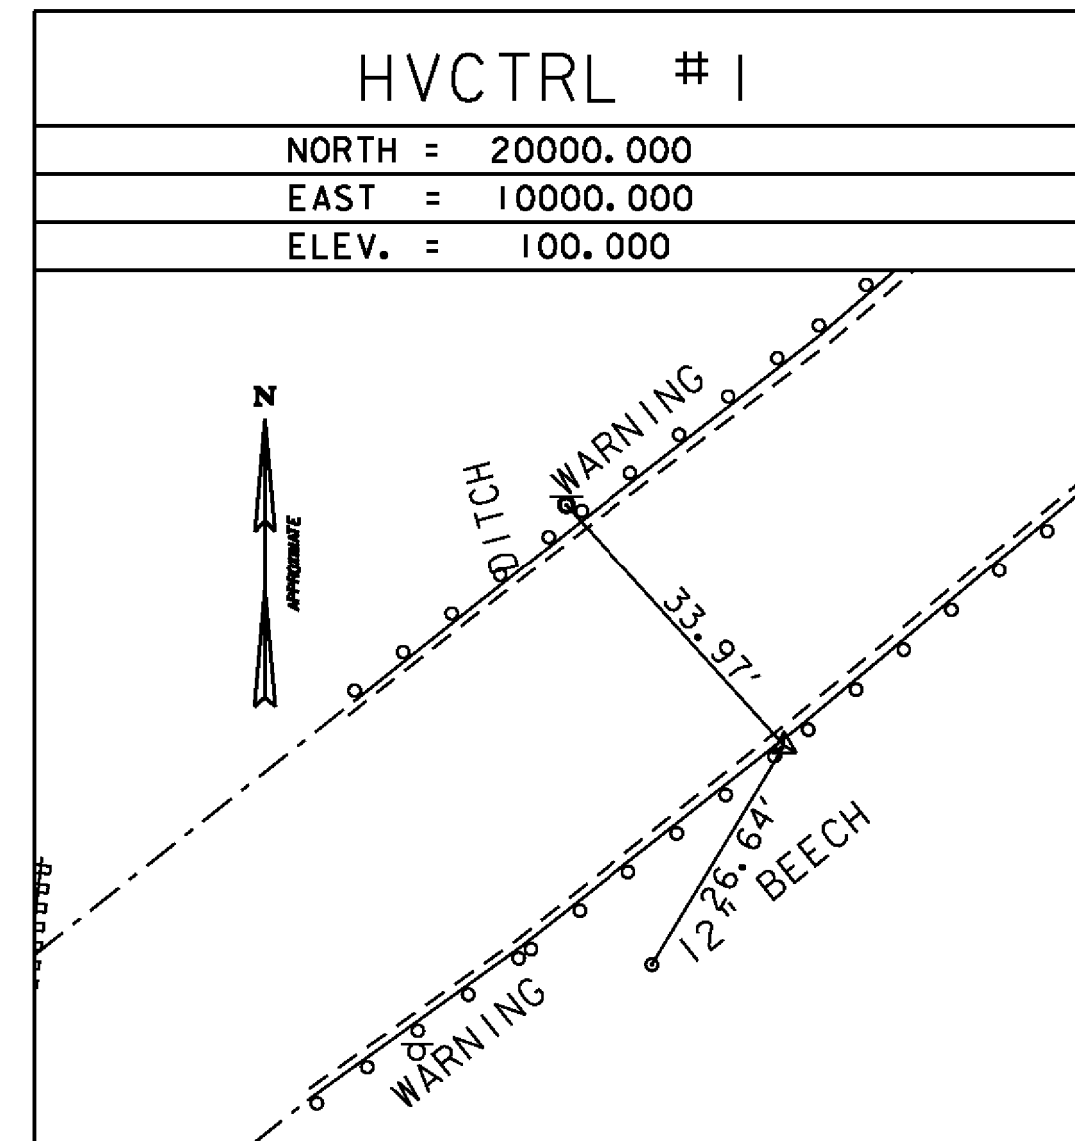

DATUM	
VERTICAL	ASSUMED
HORIZONTAL	ASSUMED
ADJUSTMENT	COMPASS

PROJECT NAME: HARTLAND	PLOT DATE: 12/17/2013
PROJECT NUMBER: BHF BPNT(12)	DRAWN BY: A.J. GOUDREAU
FILE NAME: z1lc260+1.dgn	CHECKED BY: S. FARNSWORTH
PROJECT LEADER: M.A. COLGAN	SHEET 10 OF 55
DESIGNED BY: VHB	
BR 62A TIE SHEET	

