



SEE REVISED SHEET

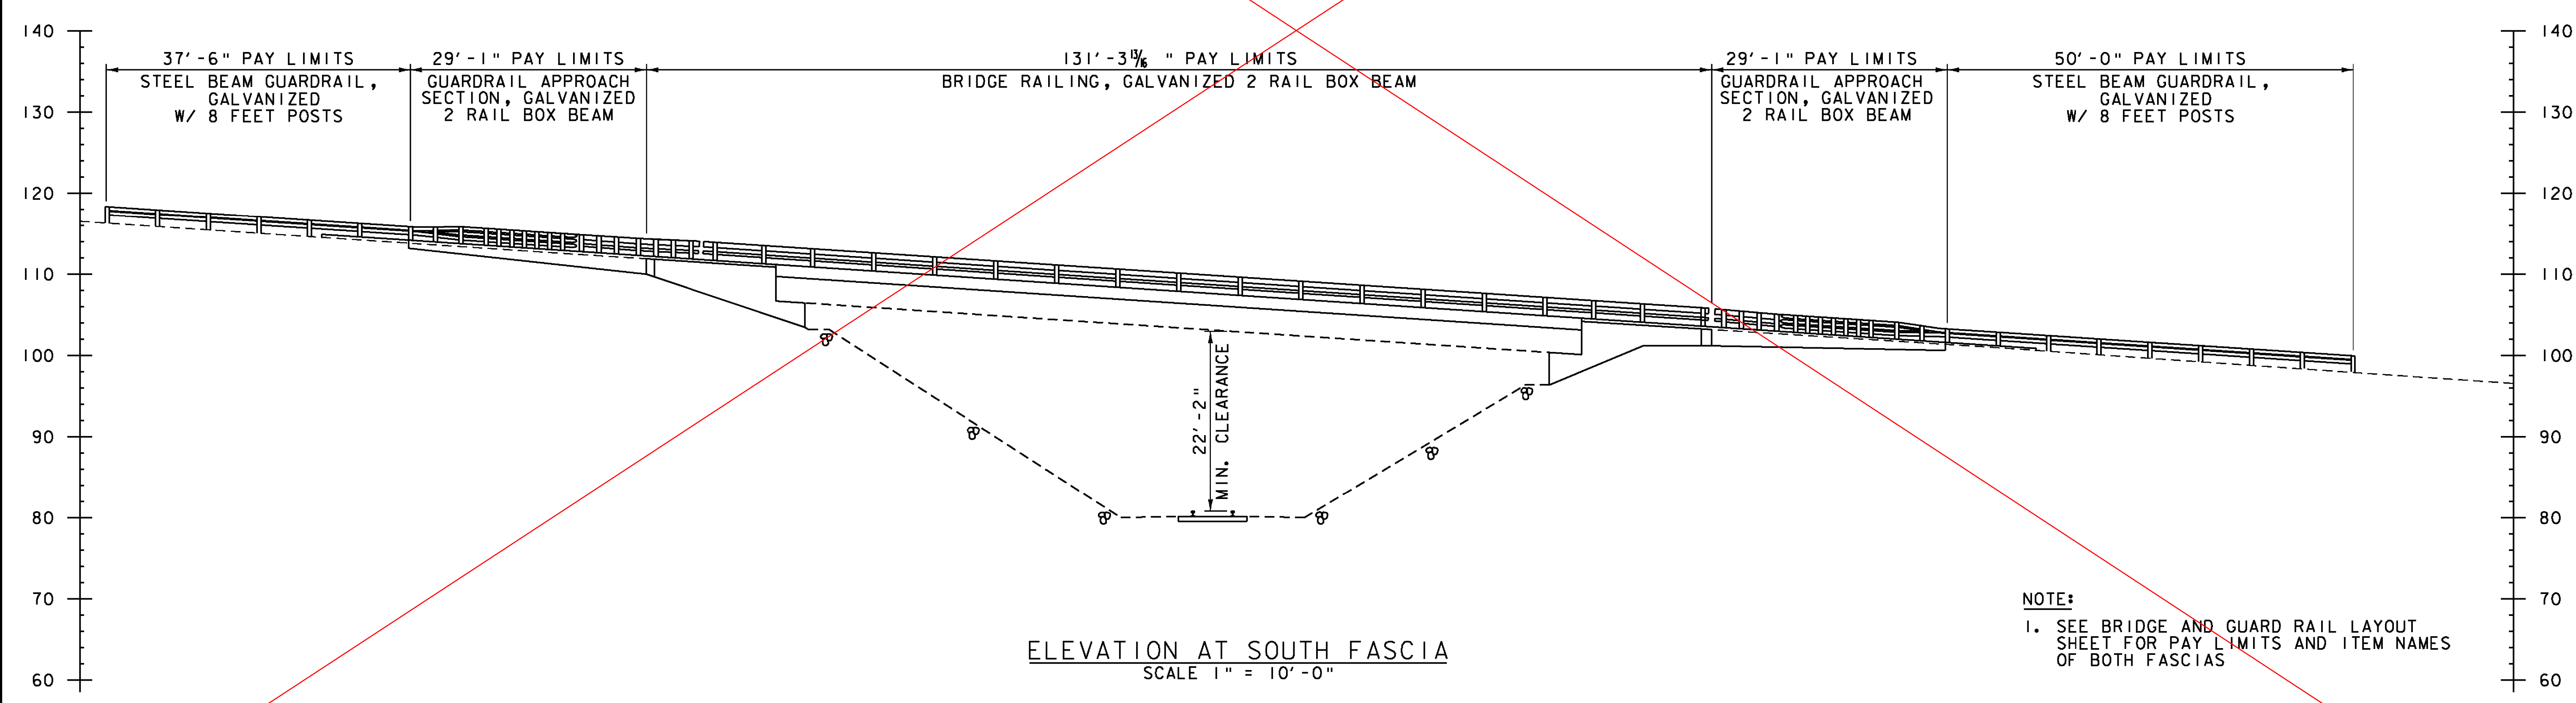

**NOTE:**  
1. SEE BRIDGE AND GUARD RAIL LAYOUT SHEET FOR PAY LIMITS AND ITEM NAMES OF BOTH FASCIAS

DATUM	
VERTICAL	ASSUMED
HORIZONTAL	ASSUMED

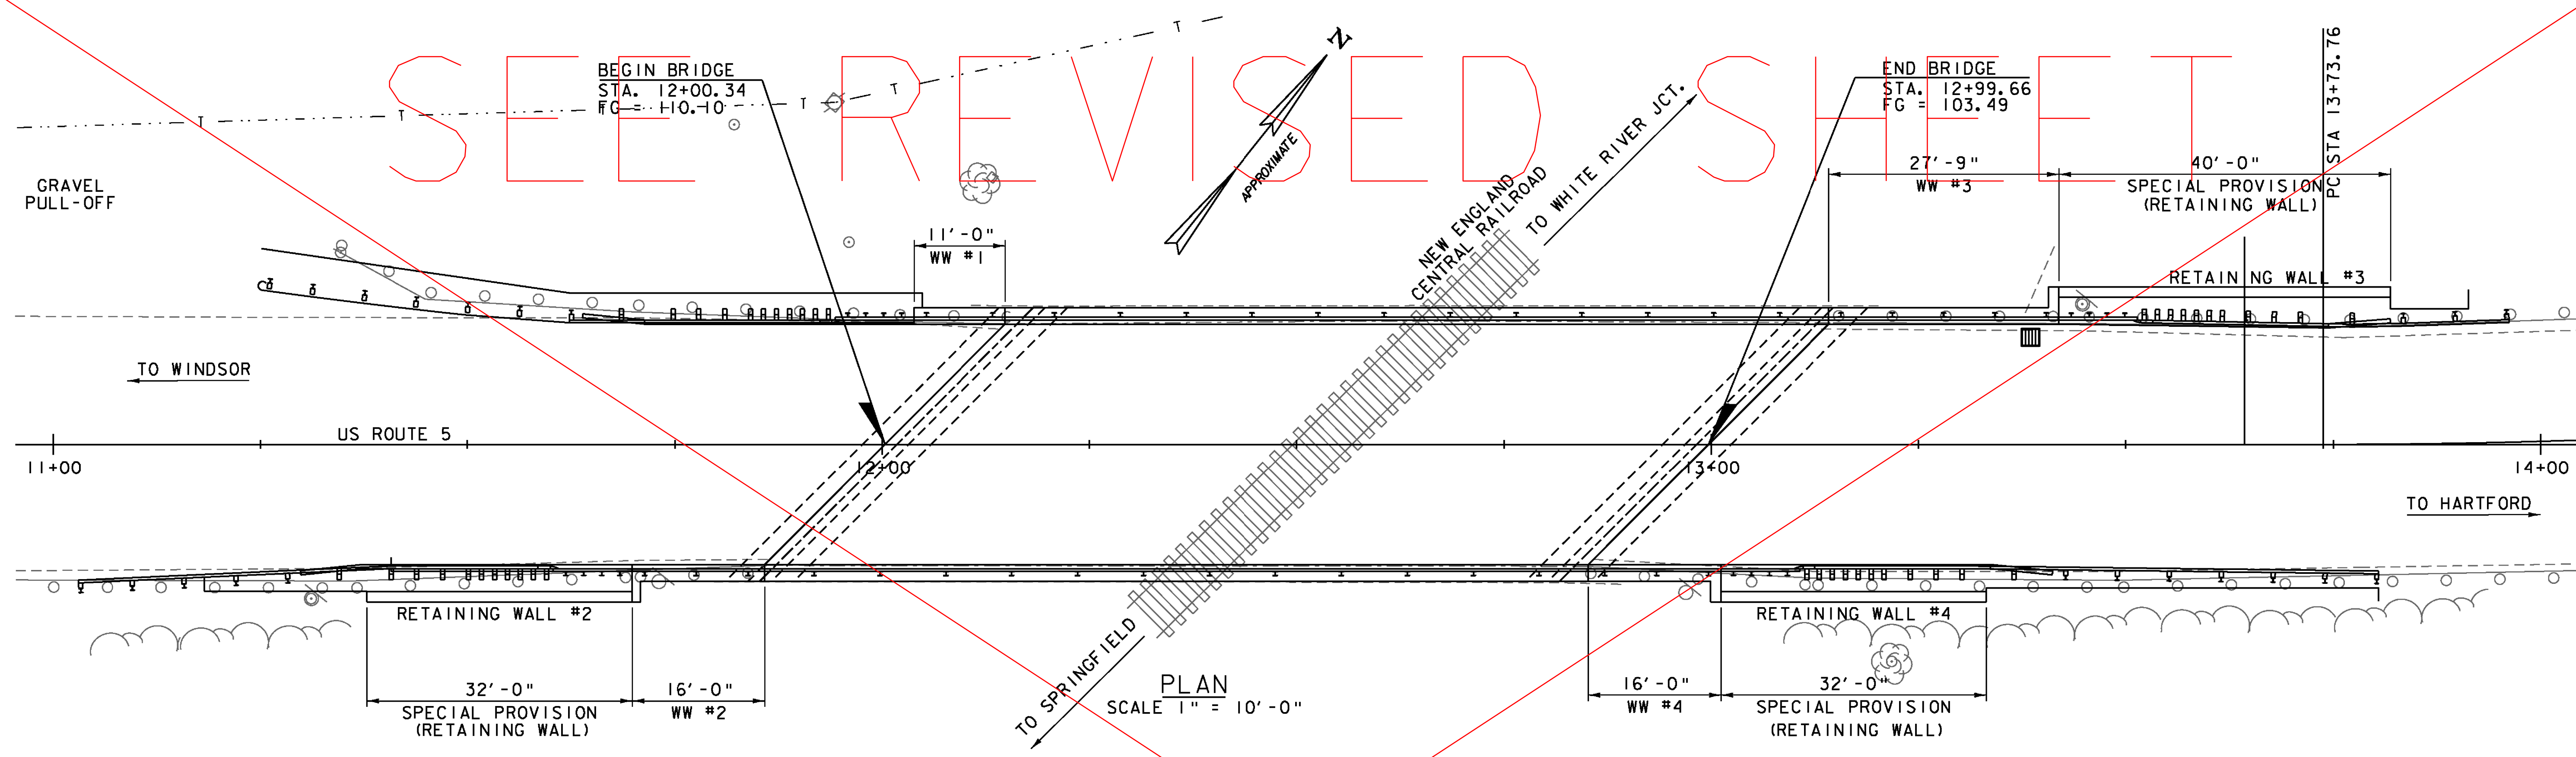

PROJECT NAME: HARTLAND	FILE NAME: zllc260pe.dgn	PLOT DATE: 12/17/2013
PROJECT NUMBER: BHF BPNT(12)	PROJECT LEADER: M.A. COLGAN	DRAWN BY: A.J. GOUDREAU
	DESIGNED BY: S.G. FARNSWORTH	CHECKED BY: S.G. FARNSWORTH
	BR 62A PLAN AND ELEVATION	SHEET 23 OF 55