


PLAN
SCALE 1" = 10'-0"

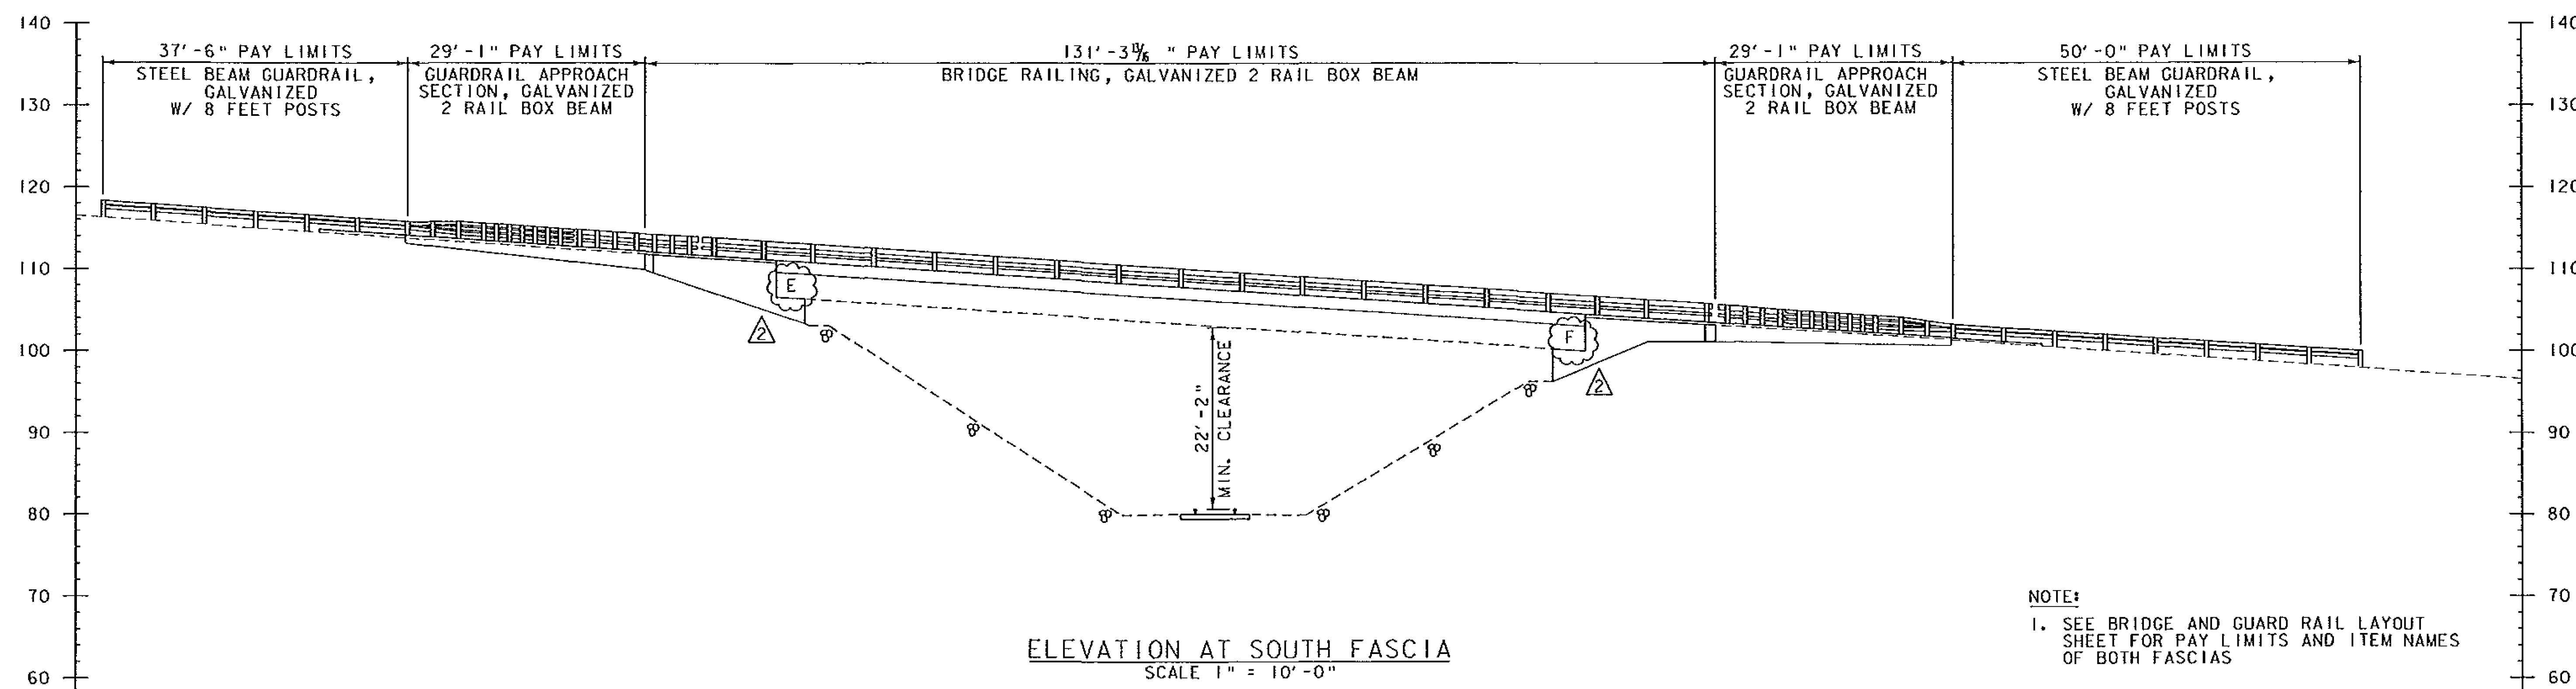

ELEVATION AT SOUTH FASCIA
SCALE 1" = 10'-0"

NOTE:
1. SEE BRIDGE AND GUARD RAIL LAYOUT SHEET FOR PAY LIMITS AND ITEM NAMES OF BOTH FASCIAS

DATUM	
VERTICAL	ASSUMED
HORIZONTAL	ASSUMED

REV.	DESCRIPTION	DATE
2	FIXED AND EXPANSION NOTATION	3/3/2014



PROJECT NAME: HARTLAND	PLOT DATE: 3/3/2014
PROJECT NUMBER: BHF BPNT(12)	DRAWN BY: A.J. GOUDREAU
FILE NAME: zllc260pe.dgn	CHECKED BY: S.G. FARNSWORTH
PROJECT LEADER: M.A. COLGAN	SHEET 23 OF 55
DESIGNED BY: S.G. FARNSWORTH	
BR 62A PLAN AND ELEVATION	