



SEE REVISION SHEET

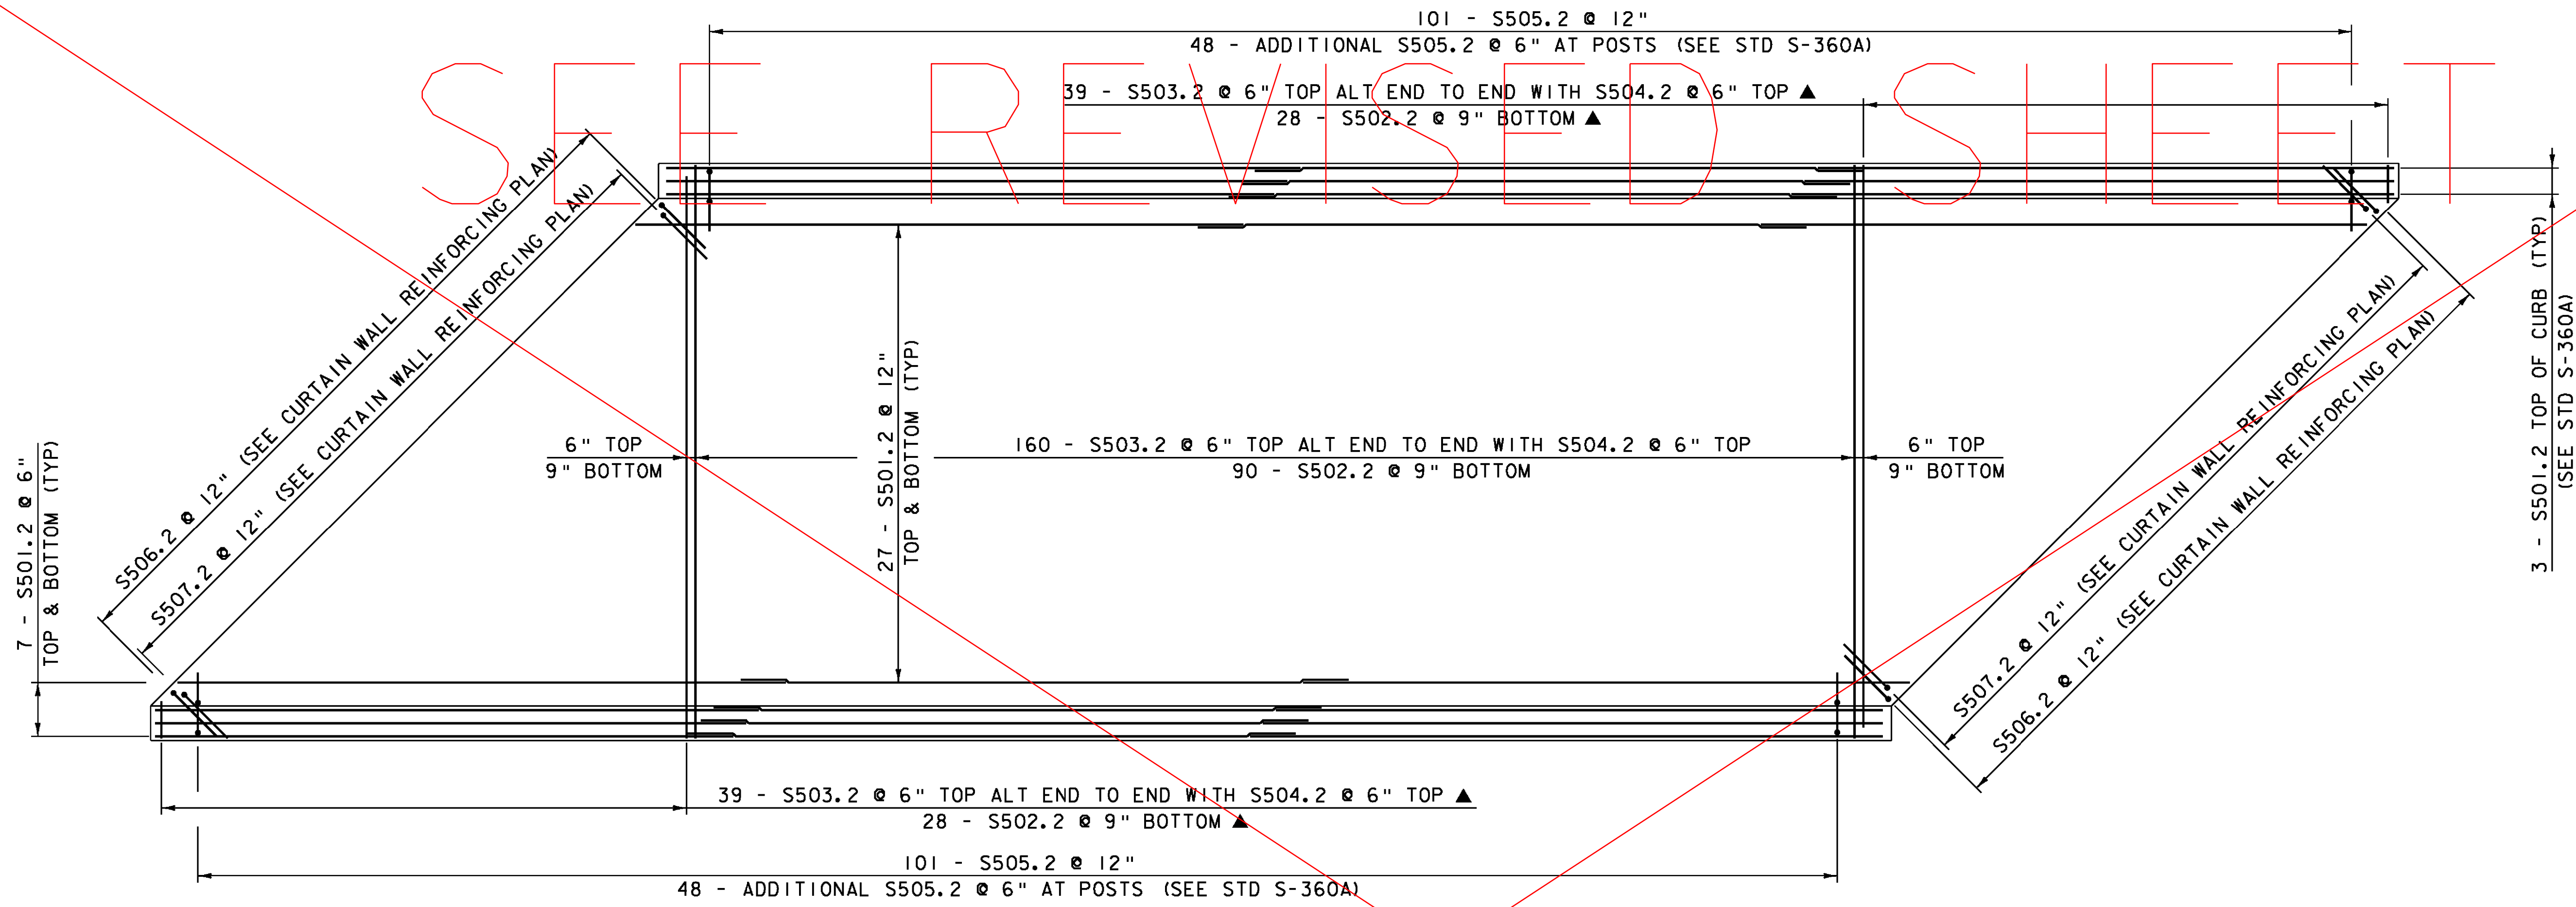

DECK REINFORCING PLAN

SCALE: 3/16" = 1'-0"

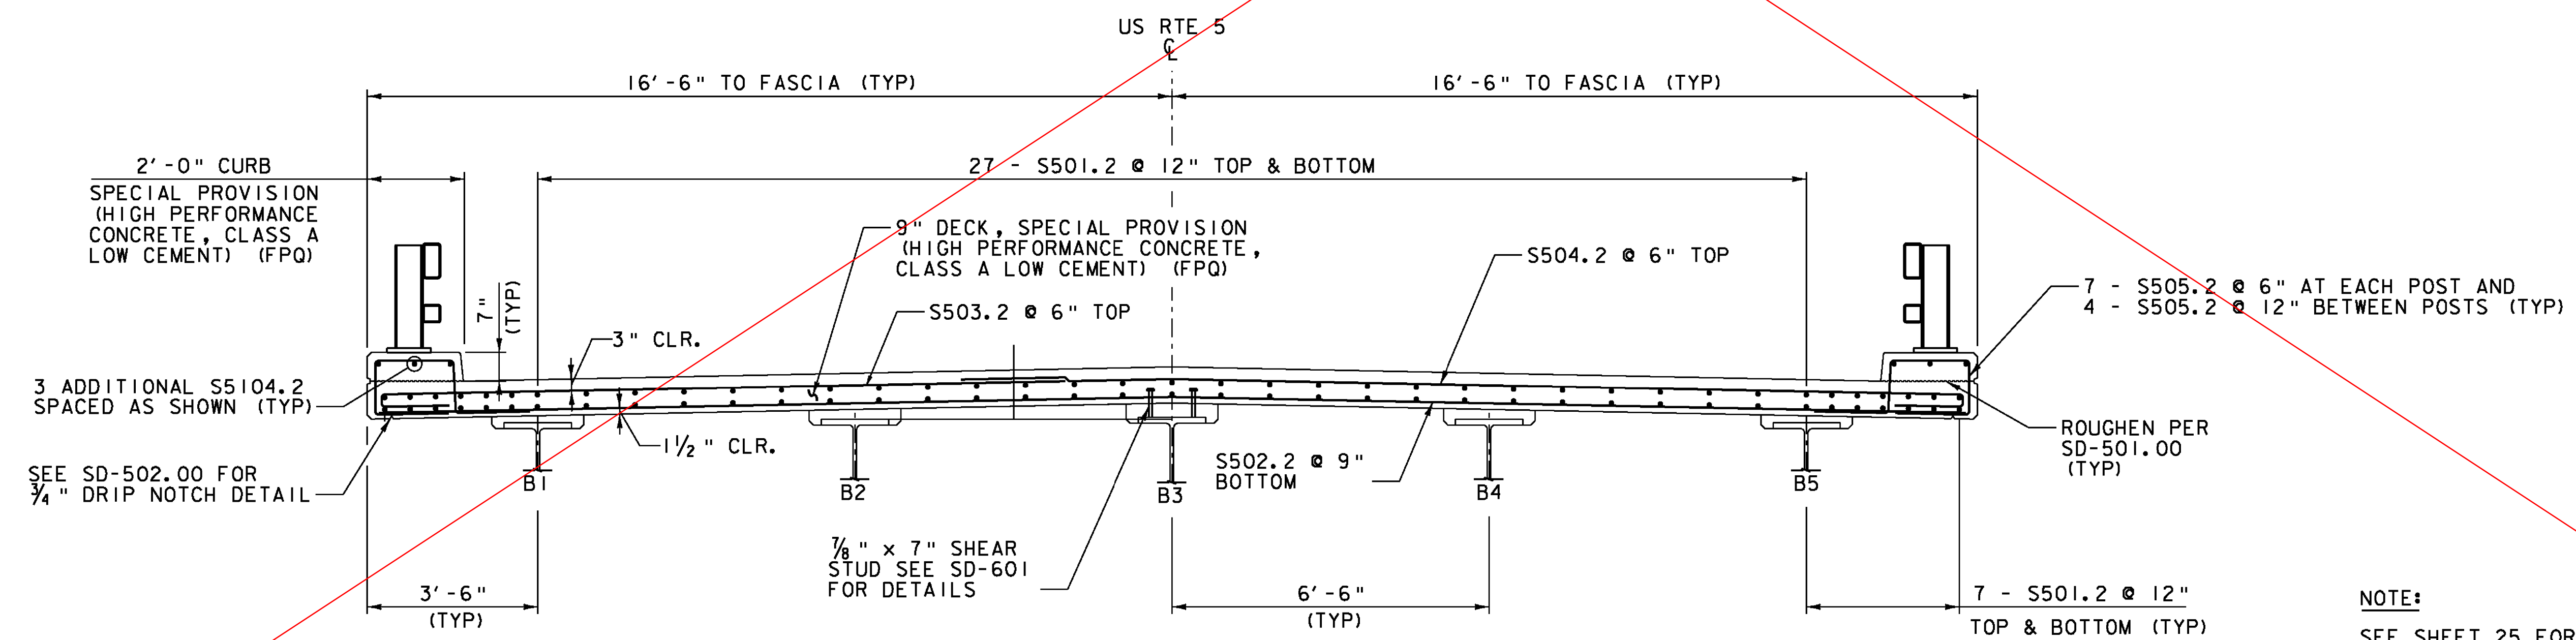

TYPICAL DECK REINFORCEMENT

SCALE: 1/2" = 1'-0"

NOTE:
 NF = NEAR FACE
 FF = FAR FACE
 EF = EACH FACE
 ▲ = CUT TO FIT IN FIELD
 3" CLEAR, UNLESS OTHERWISE SPECIFIED ON THE PLANS.
 2'-2" BAR LAP UNLESS OTHERWISE SPECIFIED ON THE PLANS.

NOTE:
 SEE SHEET 25 FOR CURTAIN WALL REINFORCING PLAN

PROJECT NAME:	HARTLAND
PROJECT NUMBER:	BHF BPNT (I2)
FILE NAME:	zllc260deck.dgn
PROJECT LEADER:	M.A. COLGAN
DESIGNED BY:	A.J. GOUDREAU
BR 62A DECK REINFORCING	
PLOT DATE:	12/17/2013
DRAWN BY:	A.J. GOUDREAU
CHECKED BY:	E.A. FIALA
SHEET	24 OF 55

