


RETAINING WALL 3 PLAN
SCALE 1/2" = 1'-0"

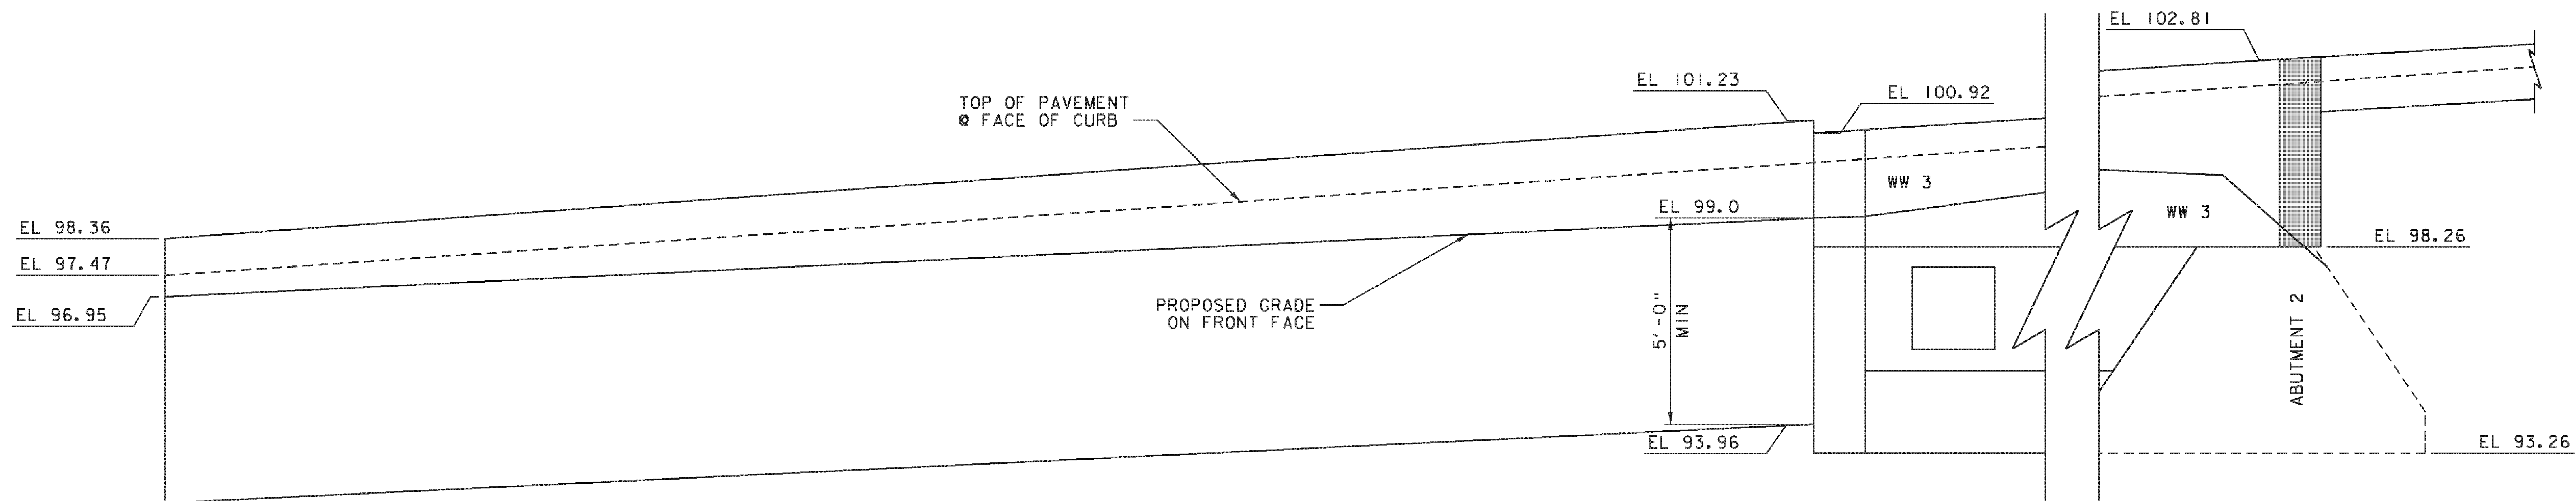

RETAINING WALL 3 ELEVATION
SCALE 1/2" = 1'-0"

KEY

 CURTAIN WALL

NOTE:

SEE SHEET 4 FOR SPECIAL PROVISION (RETAINING WALL) EXCAVATION DETAIL.

PROJECT NAME:	HARTLAND
PROJECT NUMBER:	BHF BPNT(12)
FILE NAME:	zllc260sub.dgn
PROJECT LEADER:	M.A. COLGAN
DESIGNED BY:	S.G. FARNSWORTH
BR 62A RETAINING WALL DETAILS (2 OF 3)	
PLOT DATE:	12/17/2013
DRAWN BY:	A.J. GOUDREAU
CHECKED BY:	S.E. BURBANK
SHEET	32 OF 55

