

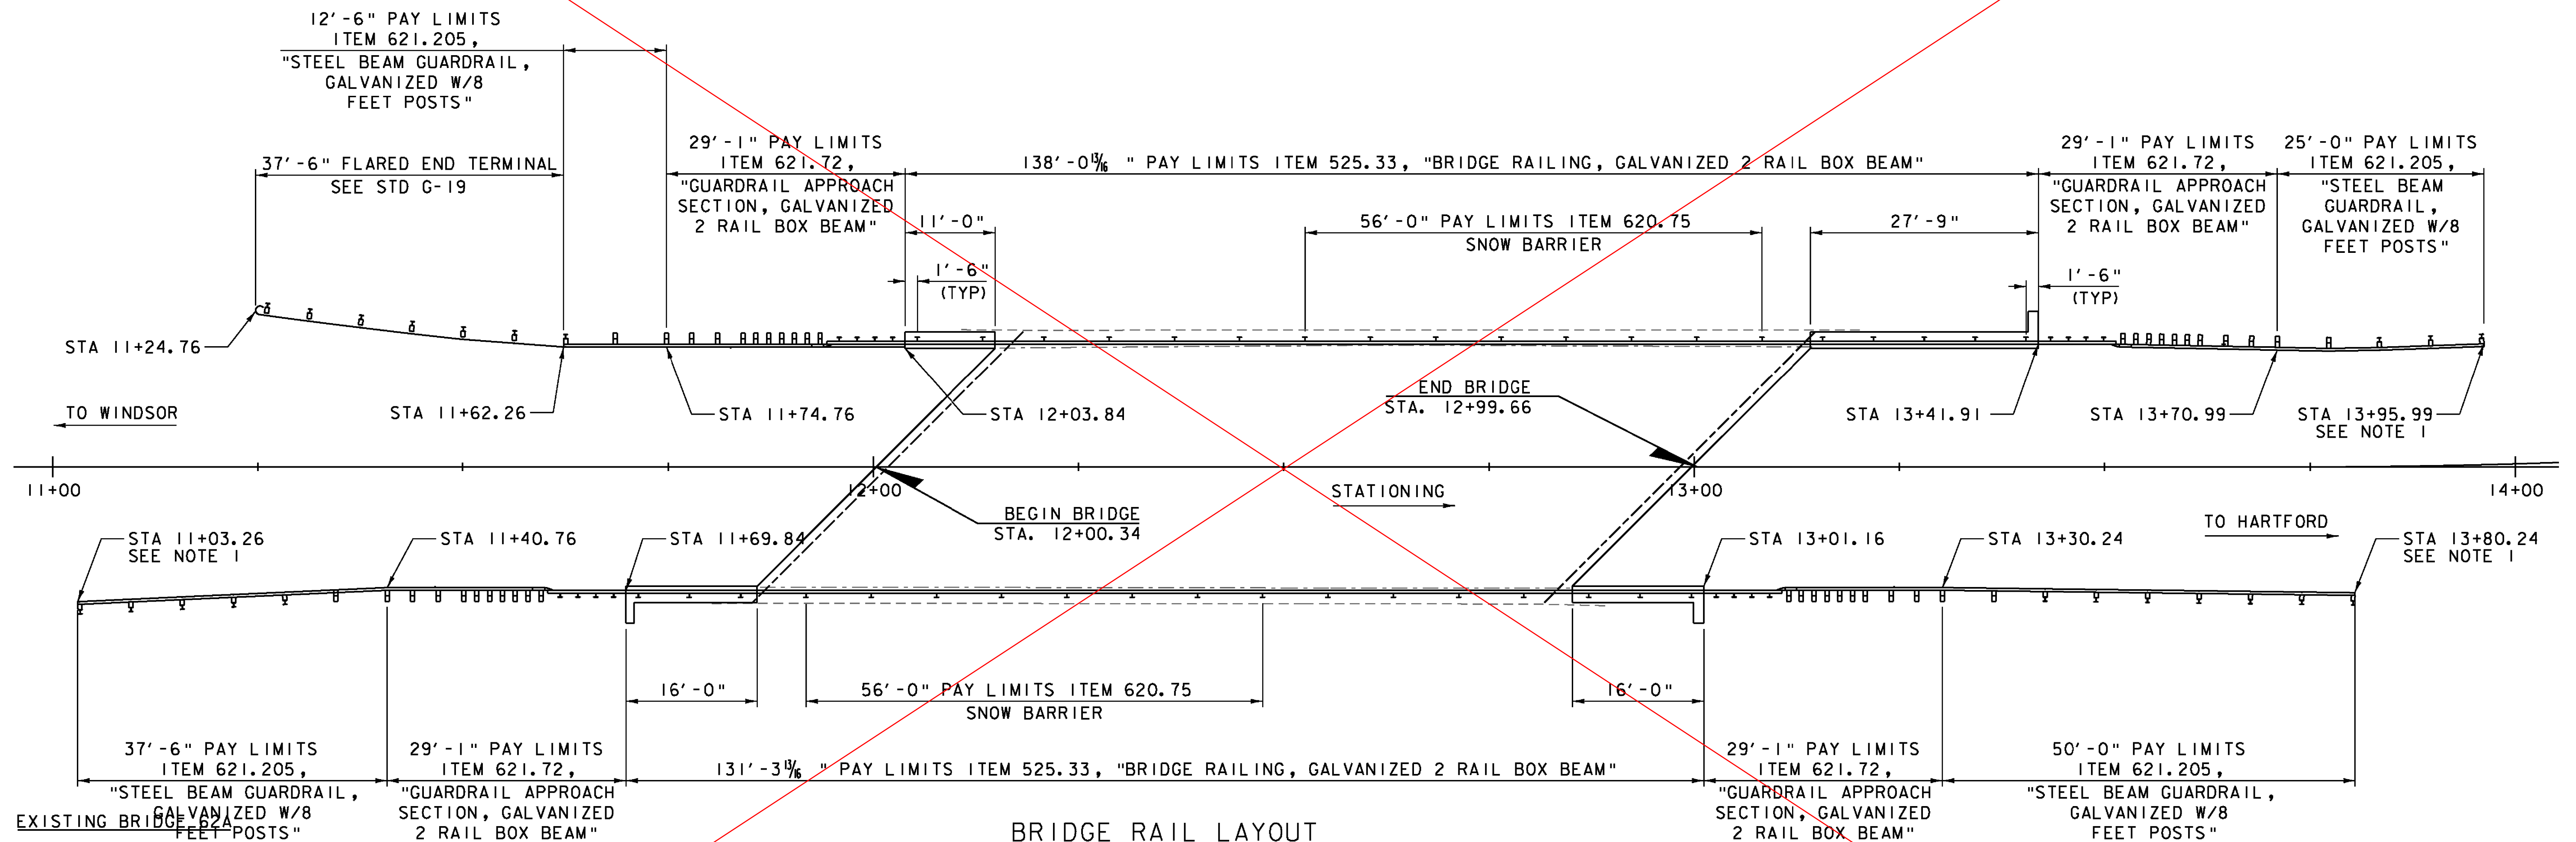


SEE REVISED SHEET

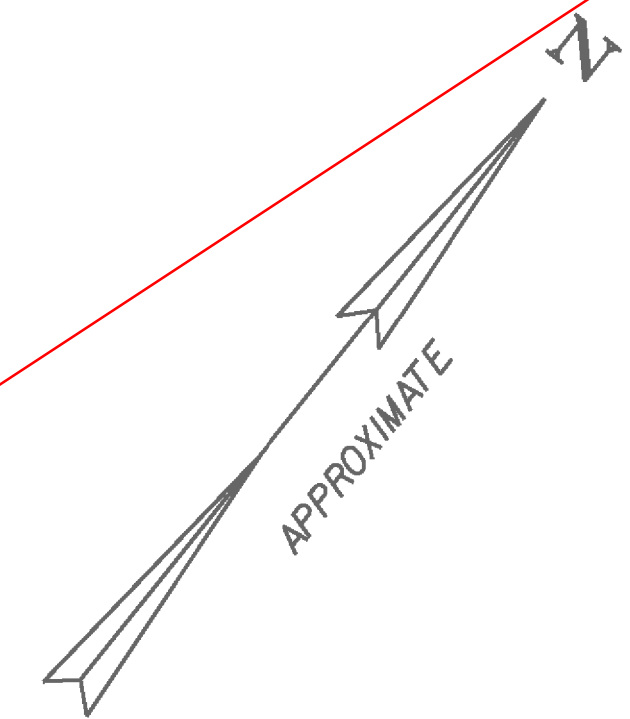

BRIDGE RAIL LAYOUT

SCALE: 1" = 10'-0"

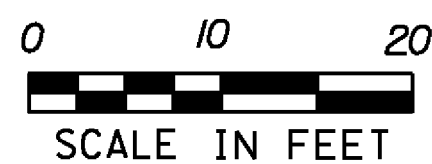

EXISTING BRIDGE
SINGLE SPAN
ROLLED BEAM
CONCRETE DECK
99'-4" LENGTH
29'-6" ROADWAY WIDTH
22'-2" VERTICAL CLEARANCE TO RAILROAD RAIL
BUILT 1955

NOTES:

- 1. MATCH INTO EXISTING STEEL BEAM GUARDRAIL

PROJECT NAME: HARTLAND	PLOT DATE: 12/17/2013
PROJECT NUMBER: BHF BPNT(12)	DRAWN BY: A.J. GOUDREAU
FILE NAME: zllc260br.dgn	CHECKED BY: S.E. BURBANK
PROJECT LEADER: M.A. COLGAN	SHEET 35 OF 55
DESIGNED BY: S.G. FARNSWORTH	
BR 62A BRIDGE AND GUARD RAIL LAYOUT	

