


BRIDGE RAIL LAYOUT
SCALE: 1" = 10'-0"

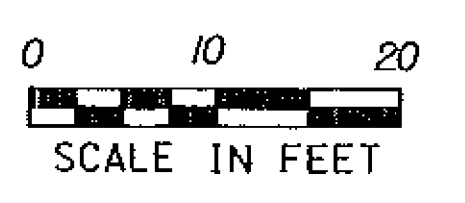

EXISTING BRIDGE 62A
SINGLE SPAN
ROLLED BEAM
CONCRETE DECK
99'-4" LENGTH
29'-6" ROADWAY WIDTH
22'-2" VERTICAL CLEARANCE TO RAILROAD RAIL
BUILT 1955

NOTES:

- MATCH INTO EXISTING STEEL BEAM GUARDRAIL

REV.	DESCRIPTION	DATE
△	NOTED EXPANSION AND FIXED SPLICE LOCATION	3/3/2014

PROJECT NAME: HARTLAND
PROJECT NUMBER: BHF BPNT(12)

FILE NAME: z1lc260brall.dgn PLOT DATE: 3/3/2014
PROJECT LEADER: M.A. COLGAN DRAWN BY: A.J. GOUDREAU
DESIGNED BY: S.G. FARNSWORTH CHECKED BY: S.E. BURBANK
BR 62A BRIDGE AND GUARD RAIL LAYOUT SHEET 35 OF 55

