


**SOIL CLASSIFICATION**  
 WINDSOR LOAMY FINE SAND  
 8% TO 15% SLOPES  
 "K FACTOR" 0.17  
 CLASSIFIED AS LOW EROSION POTENTIAL

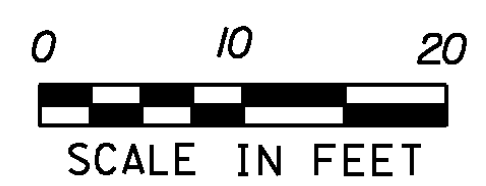

|                                      |                          |
|--------------------------------------|--------------------------|
| PROJECT NAME: HARTLAND               |                          |
| PROJECT NUMBER: BHF BPNT(12)         |                          |
| FILE NAME: zllc260bdr_ero.dgn        | PLOT DATE: 12/17/2013    |
| PROJECT LEADER: M.A. COLGAN          | DRAWN BY: M.C. SCOTT     |
| DESIGNED BY: S.G. FARNSWORTH         | CHECKED BY: S.E. BURBANK |
| BR 62A EPSC EXISTING CONDITIONS PLAN | SHEET 41 OF 55           |