


**NOTE:**  
SEE PREVIOUS SHEET FOR EROSION PREVENTION AND SEDIMENT CONTROL NOTES.

**EROSION CONTROL PLAN**

**SOIL CLASSIFICATION**  
WINDSOR LOAMY FINE SAND  
8% TO 15% SLOPES  
"K FACTOR" 0.17  
CLASSIFIED AS LOW EROSION POTENTIAL

TELEGRAPH POLE  
W/BOX

HVCTRL#3  
18" PINE

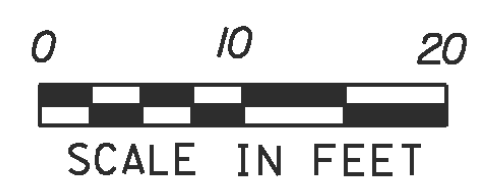

PROJECT NAME: HARTLAND	PLOT DATE: 1/2/2014
PROJECT NUMBER: BHF BPNT(12)	DRAWN BY: M.C. SCOTT
FILE NAME: zllc260bdr_ero.dgn	CHECKED BY: S.E. BURBANK
PROJECT LEADER: M.A. COLGAN	SHEET 43 OF 55
DESIGNED BY: S.G. FARNSWORTH	
BR 62A EPSC FINAL CONDITIONS PLAN	