



PLAN SCALE 3/8"=1'-0"


SECTION A-A SCALE 3/8"=1'-0"

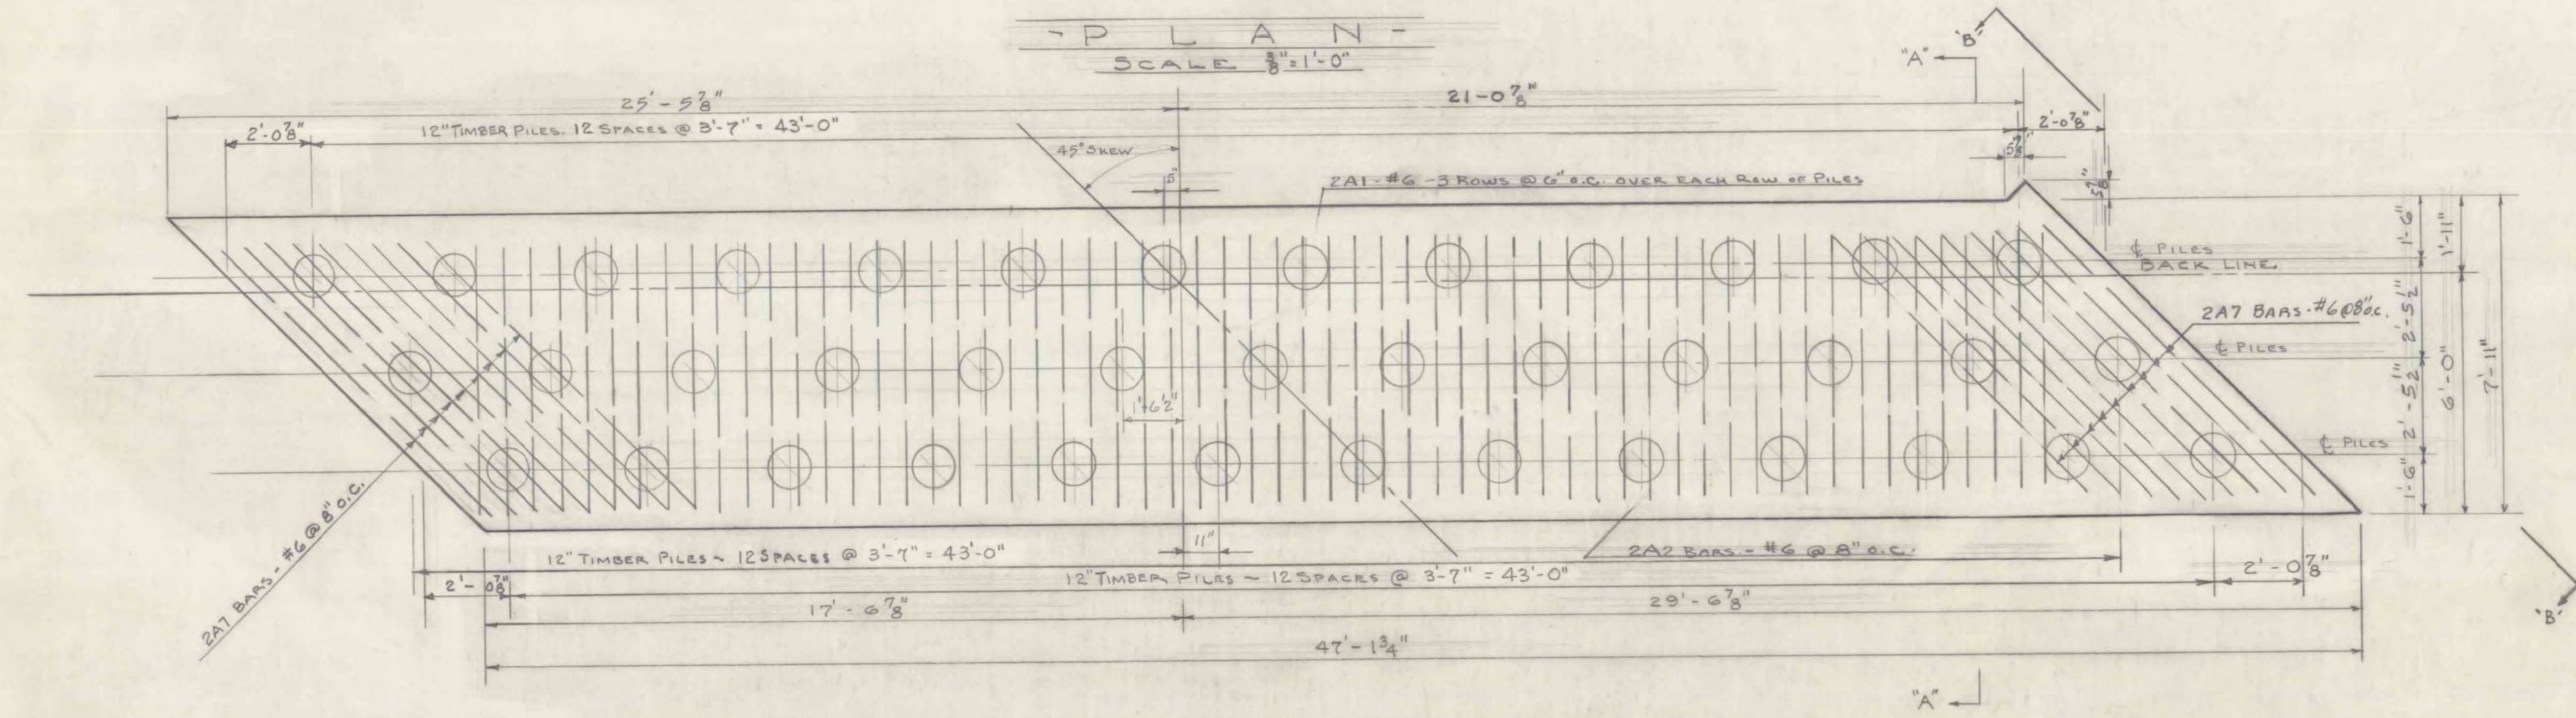

FOUNDATION PLAN SCALE 3/8"=1'-0"

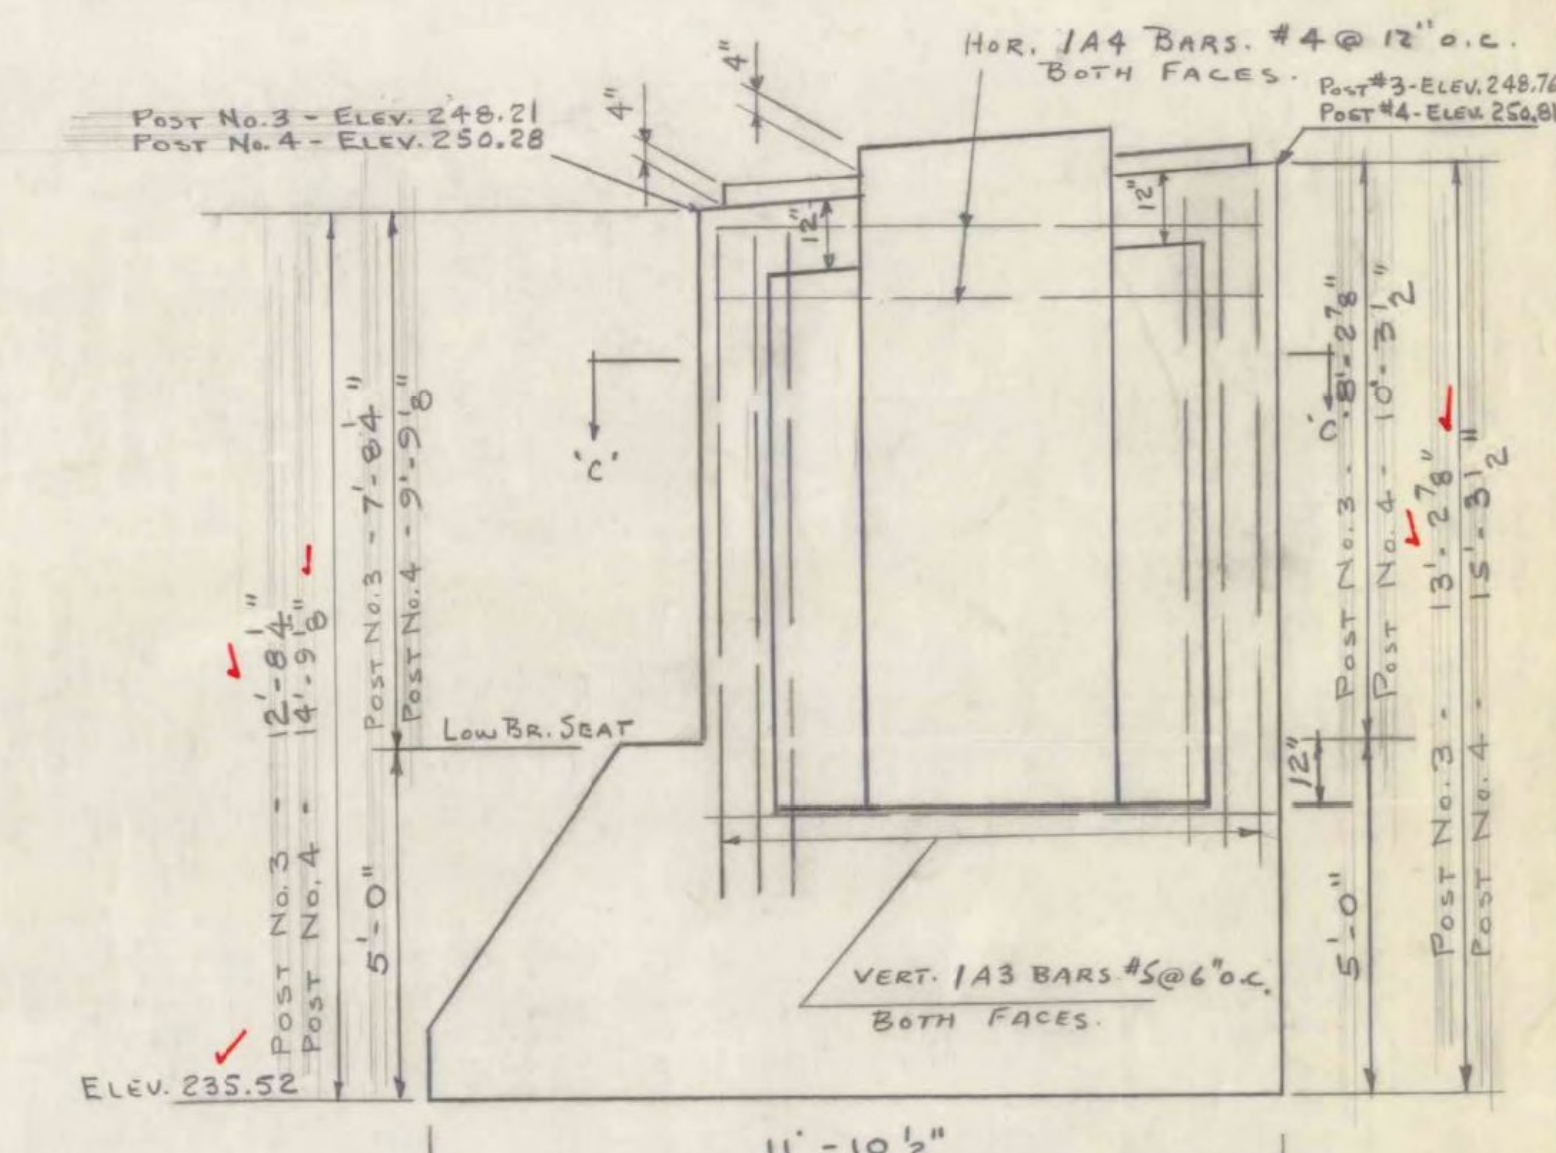

ELEVATION B-B SCALE 3/8"=1'-0"

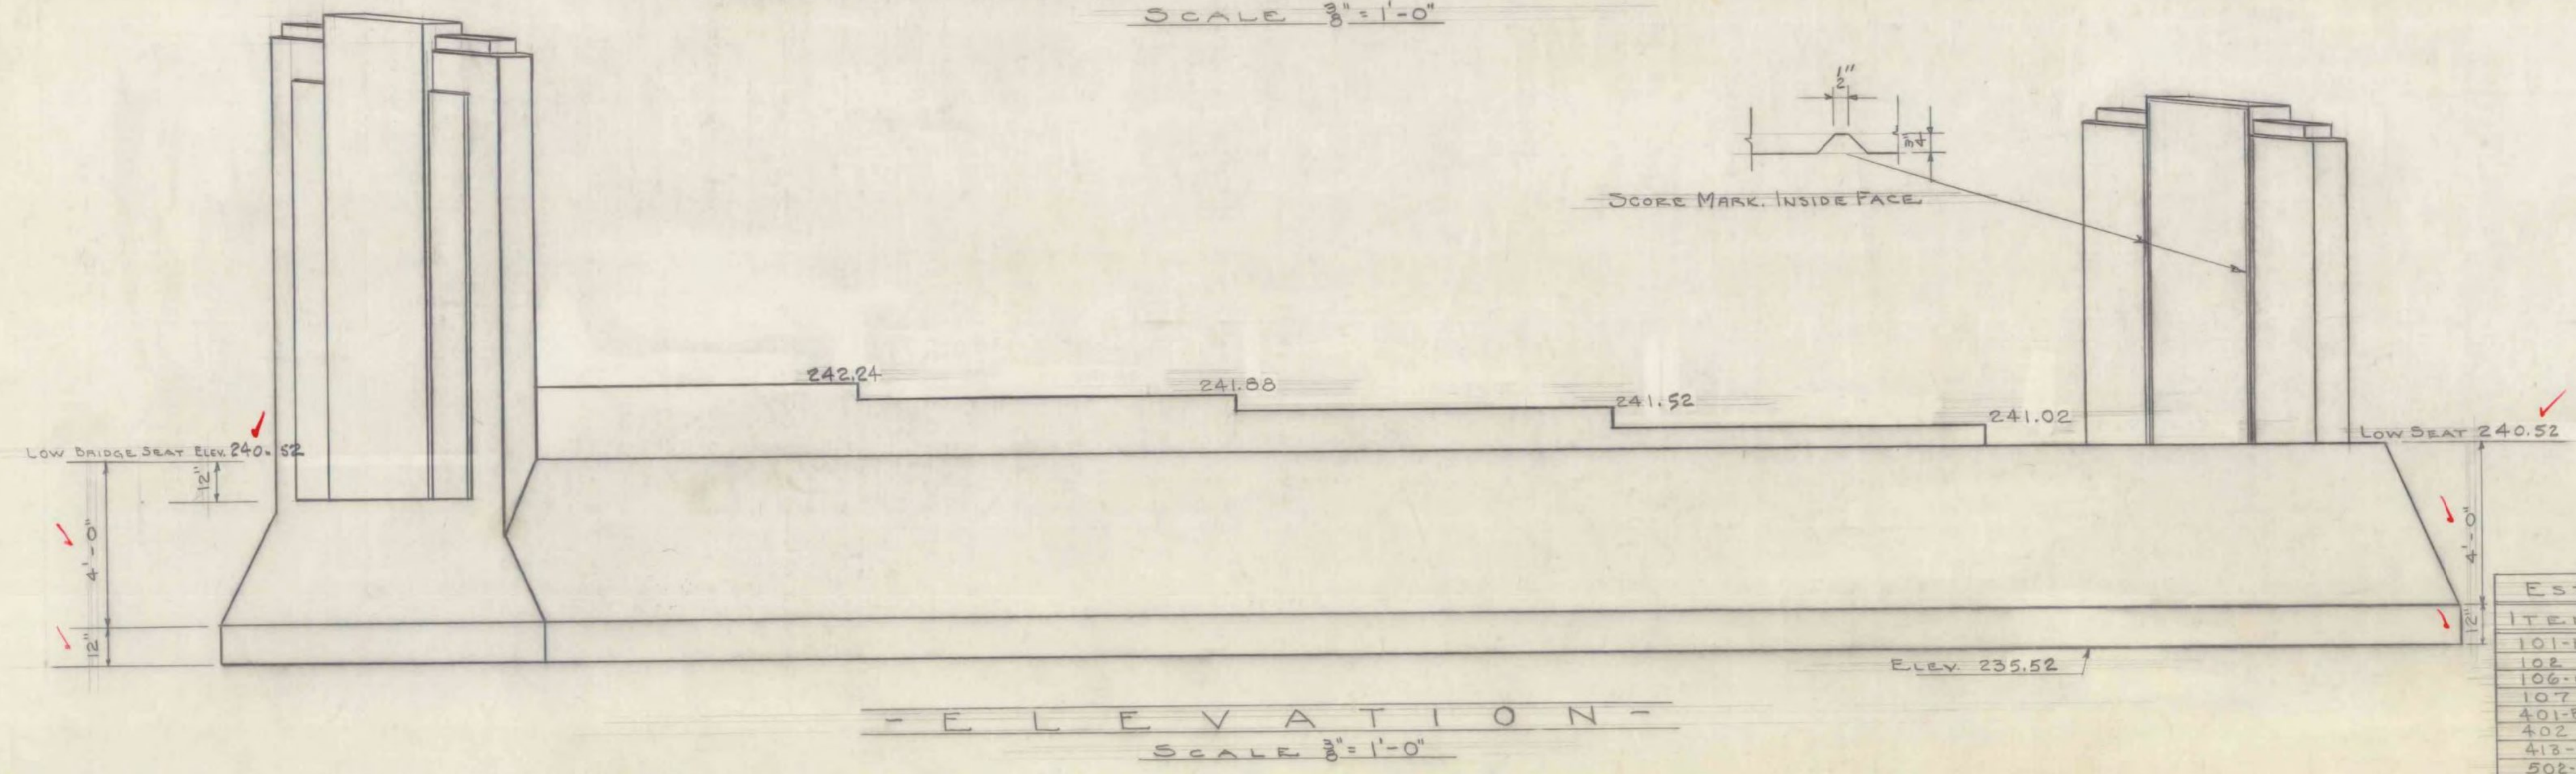

ELEVATION SCALE 3/8"=1'-0"

HARTLAND
BRIDGE 62A
BHF BPNT(12)
SHEET 51 OF 55
FOR REFERENCE
ONLY

FOR SECTION 'C-C', SEE ABUT. NO. 1
FOR GENERAL NOTES SEE ABUTMENT NO. 1.

STATE OF VERMONT
DEPARTMENT OF HIGHWAYS

TOWN OF HARTLAND
ROUTE No. 105-5 LOG STA.
ABUTMENT NO. 2

ITEM	DESCRIPTION	QUANTITY	UNIT
101-B	SOLID ROOF EXCAV.	26	C.Y.
102	BORROW	662	C.Y.
106-C	UNCL. CHANNEL EXCAVATION	89	C.Y.
107	STRUCTURE EXCAV. MODIFIED	25	C.Y.
401-B	CONCRETE CLASS. MODIFIED	70	C.Y.
402	REIN. STEEL	DEE SHEET	
413-A	PLAIN RUBBLE PAVING	136	C.Y.
502-B	TREATED TIMBER PILING	1053	S.F.
502-B1	CUT OFF - TREATED TIMBER PILING	117	S.F.
502-C	METAL SHIPS FOR TIMBER PILING	39	

SCALE 3/8"=1'-0"
SURVEYED BY FUNK
DRAWN BY R.B.M. CHECKED BY J.L.H.
PROJECT NO. FG-77(11)
SHEET 17 OF 54