


STATE OF VERMONT AGENCY OF TRANSPORTATION



PROPOSED IMPROVEMENT BRIDGE PROJECT TOWN OF HARTLAND COUNTY OF WINDSOR

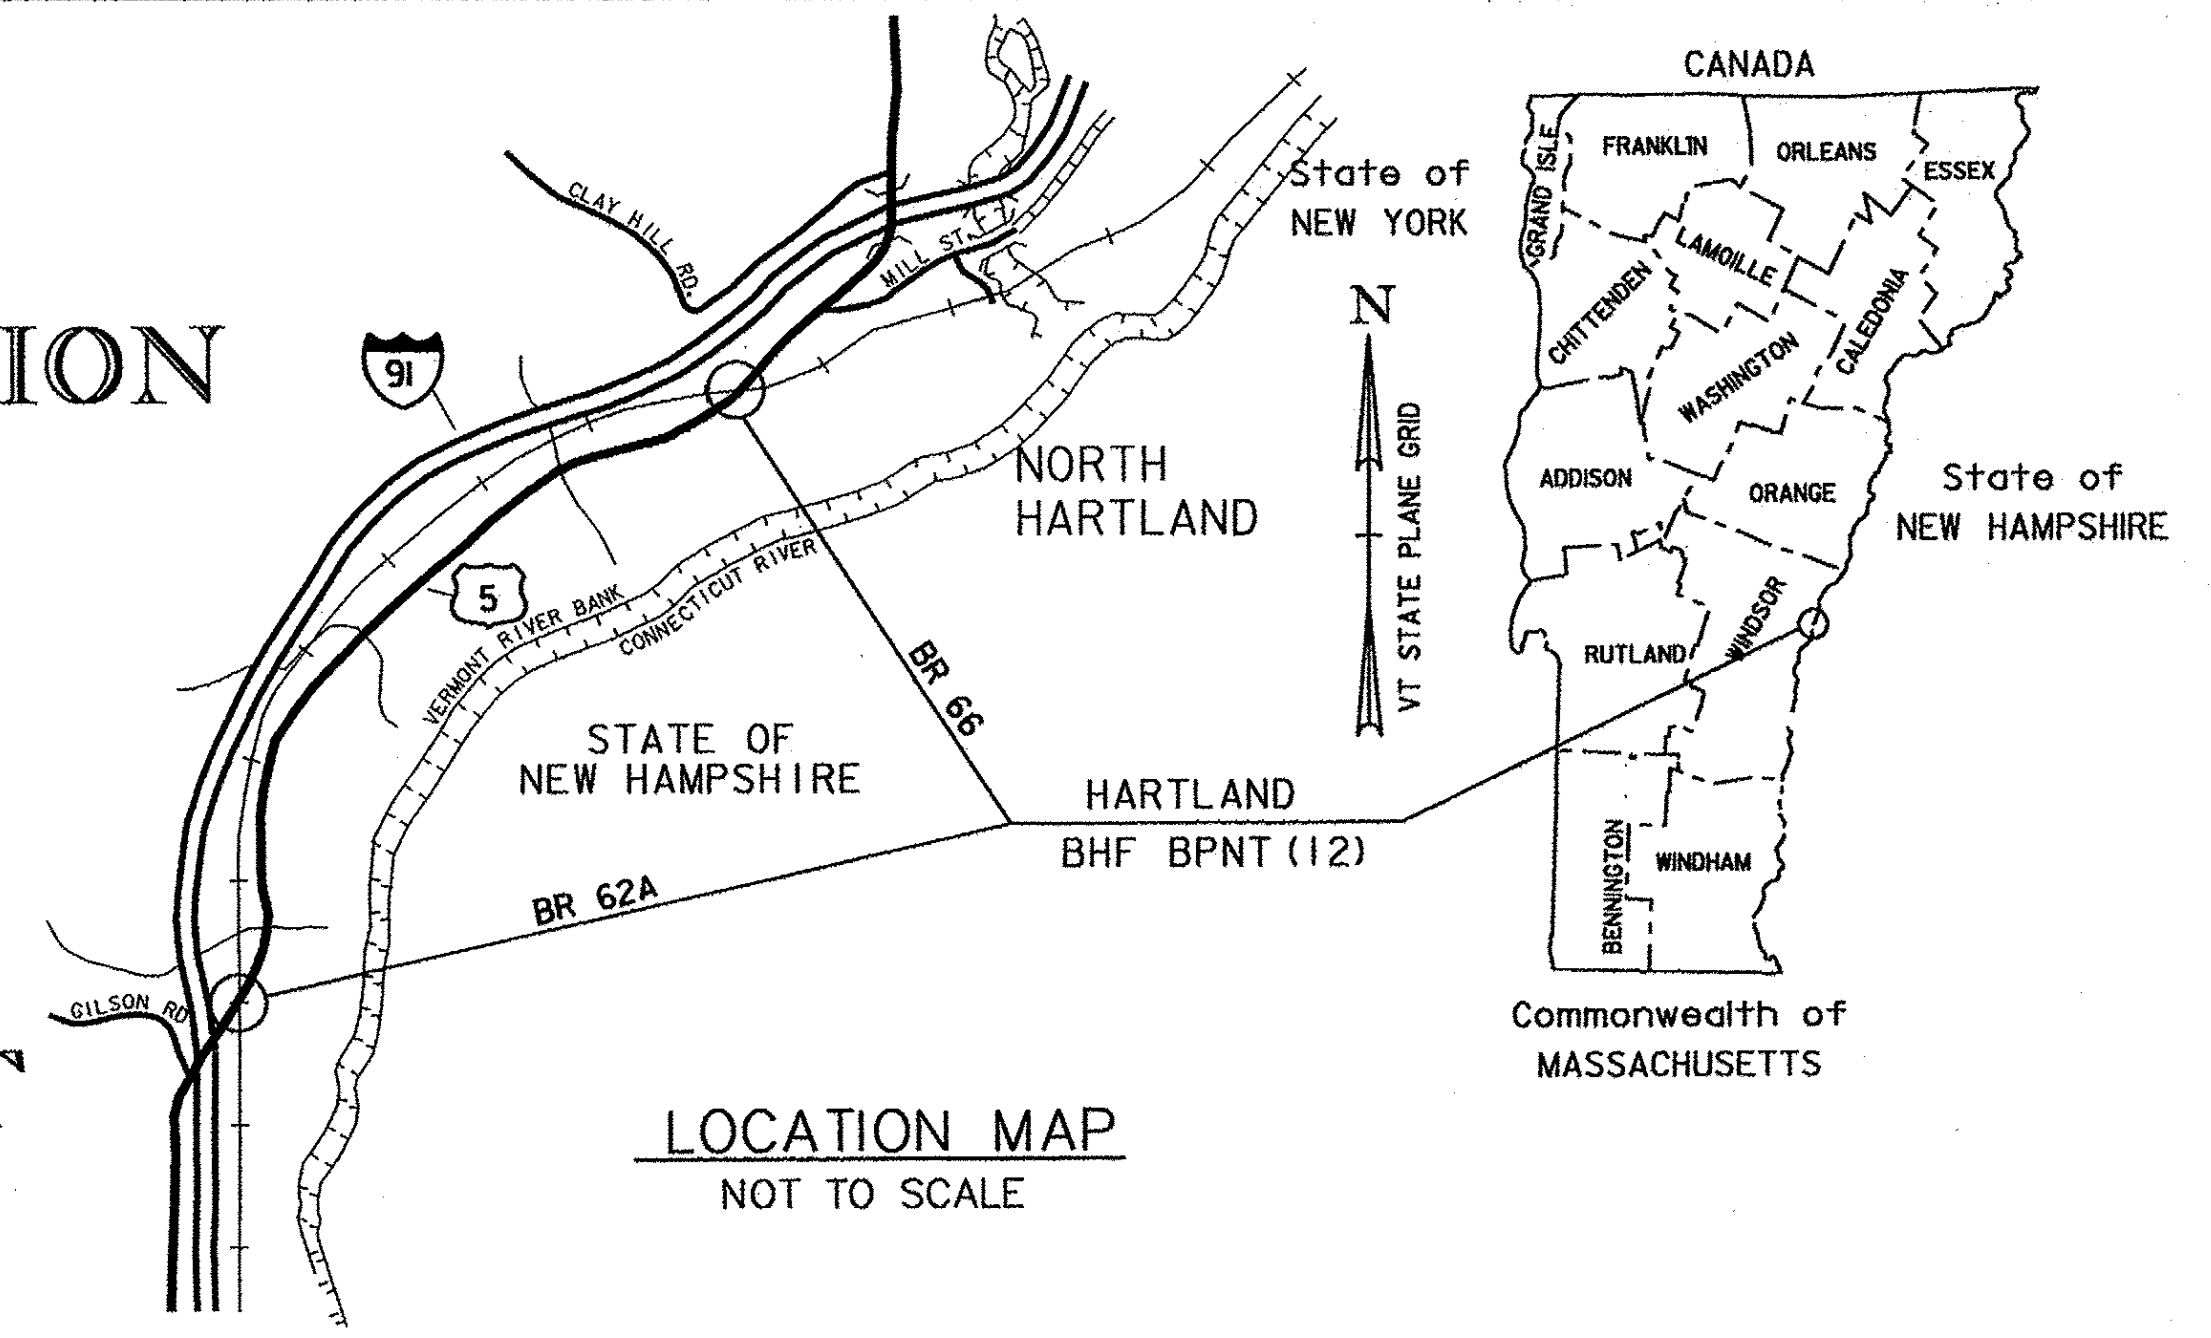


RECORD PLANS	
CONTRACTOR:	KUBRICKY CONSTRUCTION CORP. - WILTON, NY
RESIDENT ENGINEER:	DARYL BASSETT
CONSTRUCTION BEGAN:	JUNE 10, 2014
CONSTRUCTION COMPLETE:	NOVEMBER 5, 2014
RECORD PLANS BY:	DARYL BASSETT & KEVIN KING
I HEREBY CERTIFY THAT ALL THE CONSTRUCTION REQUIRED BY THIS SET OF DRAWINGS HAS BEEN ACCOMPLISHED AS INDICATED HEREIN.	
BY	RESIDENT ENGINEER
DATE	2/22/16
NOTE: Any further information concerning final quantities, amounts or other details relative to this project may be found by contacting Vtrans Records Management.	

US ROUTE 5 (MAJOR COLLECTOR), BRIDGE NUMBERS 62A AND 66

PROJECT LOCATIONS: BRIDGE NO. 62A IS BEGINNING AT A POINT ON US ROUTE 5 APPROXIMATELY 3.900 MILES NORTH OF THE WINDSOR/HARTLAND TOWN LINE EXTENDING NORTHERLY 0.038 MILES. BRIDGE NO. 66 IS LOCATED ON US ROUTE 5 APPROXIMATELY 5.940 MILES NORTH OF THE WINDSOR/HARTLAND TOWN LINE. BOTH BRIDGES CROSS OVER THE NEW ENGLAND CENTRAL RAILROAD (NECR) AT ROXBURY SUB-DIVISION MILE POST 7.16 AND 9.29.

LENGTH OF STRUCTURE:	BR 62A	99.32 FEET	(0.019 MILES)
	BR 66	222.0 FEET	(0.042 MILES)
TOTAL LENGTH OF STRUCTURES:		321.32 FEET	(0.061 MILES)
LENGTH OF ROADWAY:	BR 62A	157.68 FEET	(0.030 MILES)
LENGTH OF PROJECT:		479.00 FEET	(0.0907 MILES)

PROJECT DESCRIPTION: BRIDGE NO. 62A INVOLVES THE REMOVAL AND REPLACEMENT OF THE EXISTING CONCRETE DECK, WINGWALLS, AND ASSOCIATED ROADWAY WORK. BRIDGE NOS. 62A AND 66 INVOLVE CLEANING AND REPAINTING THE EXISTING STEEL SUPERSTRUCTURE MEMBERS AND MINOR ASSOCIATED WORK.

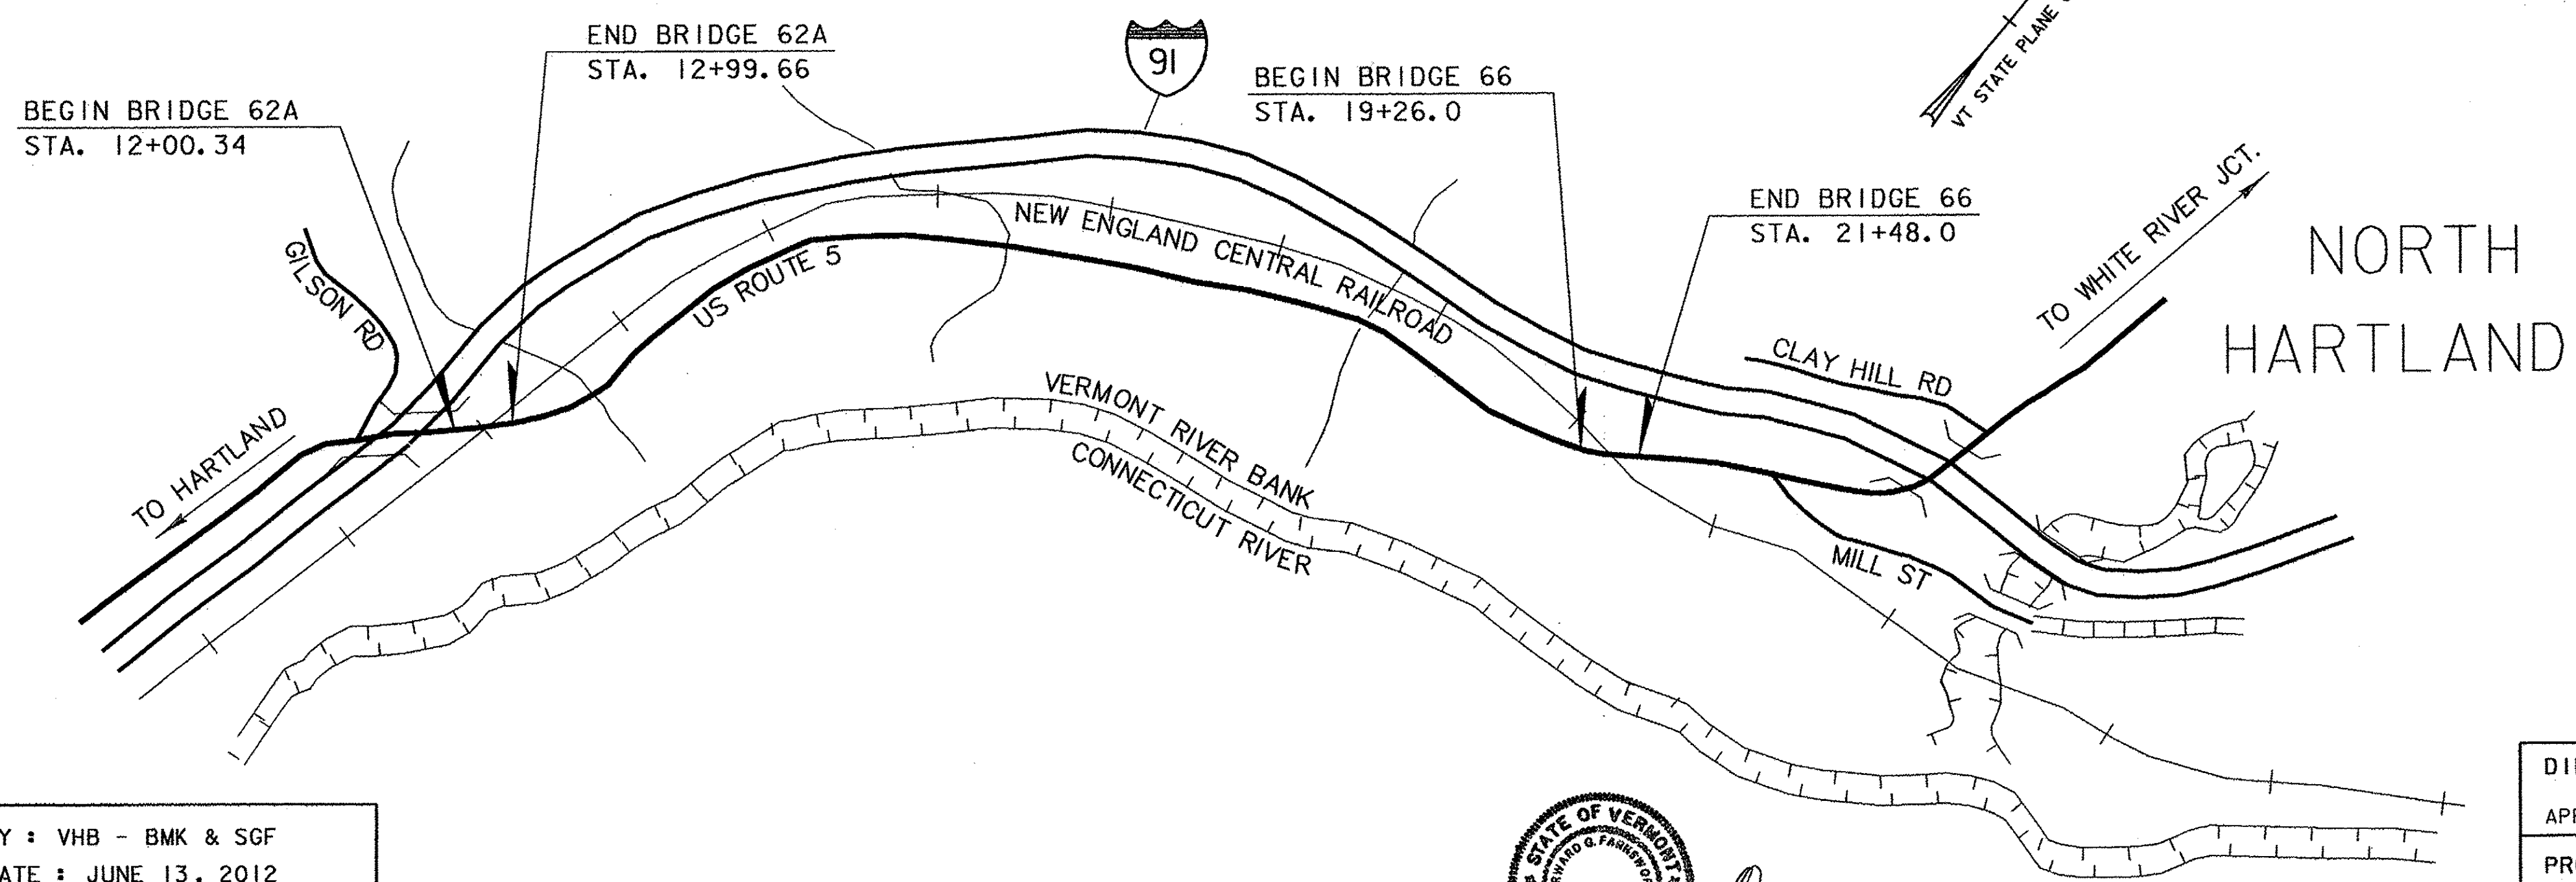


QUALITY ASSURANCE PROGRAM: LEVEL 2

CONVENTIONAL SYMBOLS	
COUNTY LINE	
TOWN LINE	
LIMITS OF ACCESS	
POINT OF ACCESS	
FENCE LINE	
STONE WALL	
TRAVELED WAY	
GUARD RAIL	
RAILROAD	
SURVEY LINE	
CULVERT	
POWER POLE	
TELEPHONE POLE	
TREES	
CONTROL OF ACCESS	
PROPERTY LINE	
R.O.W. TAKING LINE	
SLOPE RIGHTS	
TOP OF CUT	
TOE OF SLOPE	

SURVEYED BY : VHB - BMK & SGF
 SURVEYED DATE : JUNE 13, 2012

DATUM
 VERTICAL: ASSUMED
 HORIZONTAL: ASSUMED

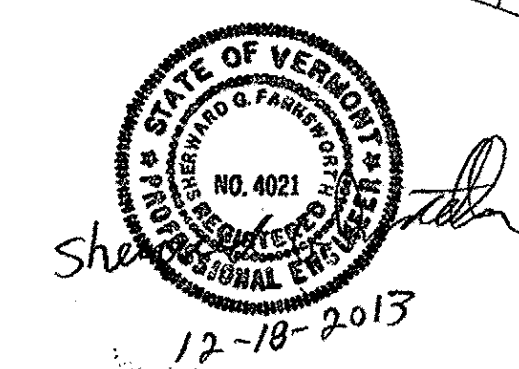

THESE PLANS ARE SUBJECT TO SUCH ENGINEERING CHANGES AS MAY BE REQUIRED BY THE FEDERAL HIGHWAY ADMINISTRATION OR THE DIRECTOR OF PROGRAM DEVELOPMENT.
 CONSTRUCTION IS TO BE CARRIED ON IN ACCORDANCE WITH THESE PLANS AND THE STANDARD SPECIFICATIONS FOR CONSTRUCTION DATED 2011, AS APPROVED BY THE FEDERAL HIGHWAY ADMINISTRATION ON JULY 20, 2011 FOR USE ON THIS PROJECT, INCLUDING ALL SUBSEQUENT REVISIONS AND SUCH REVISED SPECIFICATIONS AND SPECIAL PROVISIONS AS ARE INCORPORATED IN THESE PLANS.

DIRECTOR OF PROGRAM DEVELOPMENT	
APPROVED	DATE 12-18-13
PROJECT MANAGER : MARK SARGENT	
PROJECT NAME : HARTLAND	
PROJECT NUMBER : BHF BPNT (12)	
SHEET 1 OF 55 SHEETS	

PRELIMINARY INFORMATION SHEET (BRIDGE)

INDEX OF SHEETS

PLAN SHEETS

1	TITLE SHEET
2	BR 62A PRELIMINARY INFORMATION SHEET
3	BR 62A TYPICAL BRIDGE SECTION
4	BR 62A TYPICAL ROADWAY SECTIONS
5 - 6	PROJECT NOTES
7 - 8	QUANTITY SHEETS
9	CONVENTIONAL SYMBOLOLOGY LEGEND
10	BR 62A TIE SHEET
11	BR 62A ALIGNMENT LAYOUT PLAN
12	BR 62A LAYOUT SHEET
13	BR 62A PROFILE SHEET
14	BR 62A MATERIAL TRANSITION DIAGRAM
15	TRAFFIC CONTROL WITH FLAGGERS
16	TRAFFIC CONTROL WITH TEMP. SIGNALS
17 - 20	BR 62A TRAFFIC DETOUR PLAN
21	BR 62A TRAFFIC SIGNS & LINE STRIPING
22	BR 62A TRAFFIC SIGN SUMMARY SHEET
23	BR 62A PLAN AND ELEVATION
24	BR 62A DECK REINFORCING
25	BR 62A CURTAIN WALL/SHEAR STUD LAYOUT
26	BR 62A ABUTMENT 1 PLAN
27	BR 62A ABUTMENT 2 PLAN
28 - 29	BR 62A WINGWALL DETAILS
30	BR 62A FOOTING REINFORCING PLAN
31 - 33	BR 62A RETAINING WALL DETAILS
34	BR 62A REINFORCING STEEL SCHEDULE
35	BR 62A BRIDGE AND GUARDRAIL LAYOUT
36	BR 62A SNOW BARRIER
37 - 39	BR 62A US 5 CROSS SECTIONS
40	BR 62A EPSC NARRATIVE
41	BR 62A EPSC EXISTING CONDITIONS PLAN
42	BR 62A EPSC CONSTRUCTION CONDITIONS PLAN
43	BR 62A EPSC FINAL CONDITIONS PLAN
44 - 45	EPSC DETAILS
46	BR 66 DRAIN TROUGH DETAILS

PROJECT REFERENCE SHEETS

47 - 51	BRIDGE 62A - 1955 PLANS
52 - 55	BRIDGE 66 - 1967 PLANS

NOTE: THE STATIONING ON THE TITLE SHEET IS BASED ON AN ASSUMED STATIONING FOR BRIDGE 62A AND RECORD PLAN STATIONING FOR BRIDGE 66. THE BRIDGES ARE 3 MILES APART.

STRUCTURE DETAILS

SD-501.00	CONCRETE DETAILS AND NOTES	02-09-2012
SD-502.00	CONCRETE DETAILS AND NOTES	10-10-2012
SD-516.10	BRIDGE JOINT ASPHALTIC PLUG	08-29-2011
SD-601.00	STRUCTURAL STEEL DETAILS AND NOTES	06-04-2010

STANDARDS LIST

B-5	SLOPE GRADING, EMBANKMENTS, MUCK	06-01-1994
B-71	STANDARD FOR RESIDENTIAL AND COMMERCIAL DRIVES	07-08-2005
C-10	CURBING	02-11-2008
D-16	DRAINAGE DETAILS INCLUDING DROP INLETS, IRON GRATE TYPE B&C, CONC END SECTIONS, ETC.	06-01-1994
E-121	STANDARD SIGN PLACEMENT - CONVENTIONAL ROAD	08-08-1995
E-134	BRIDGE NUMBER PLAQUE	08-08-1995
E-136A	U.S. ROUTE MARKER SIGN DETAILS	08-08-1995
E-136B	STATE ROUTE MARKER SIGN DETAILS	08-08-1995
E-136C	STATE NUMBERED TOWN HIGHWAY SIGN DETAILS	08-08-1995
E-155	WARNING SIGN DETAILS	05-01-2004
E-193	PAVEMENT MARKING DETAILS	08-18-1995
G-1	STEEL BEAM GUARDRAIL DETAILS (POST, DELINEATOR, TYPICALS)	01-03-2000
G-1D	STEEL BEAM GUARDRAIL DETAILS (END TERMINAL, ANCHOR, MEDIAN)	01-03-2000
G-19	GENERIC GRADING PLANS FOR GUARDRAIL END TERMINALS	11-15-2002
S-360a	BRIDGE RAILING, GALVANIZED 2 RAIL BOX BEAM	04-23-2012
S-360b	GUARDRAIL APPROACH SECTION, GALVANIZED 2 RAIL BOX BEAM	04-23-2012
S-363	THREE BEAM TO STANDARD STEEL BEAM TRANSITION SECTION	12-14-2009
T-1	TRAFFIC CONTROL GENERAL NOTES	08-06-2012
T-10	CONVENTIONAL ROADS CONSTRUCTION APPROACH SIGNING	08-06-2012
T-17	TRAFFIC CONTROL MISCELLANEOUS DETAILS	08-06-2012
T-28	CONSTRUCTION SIGN DETAILS	08-06-2012
T-30	CONSTRUCTION SIGN DETAILS	08-06-2012
T-31	CONSTRUCTION SIGN DETAILS	08-06-2012
T-35	CONSTRUCTION ZONE LONGITUDINAL DROP OFFS	08-06-2012
T-45	SQUARE TUBE SIGN POST AND ANCHOR	01-02-2013

FINAL HYDRAULIC REPORT

HYDROLOGIC DATA

Date: _____

DRAINAGE AREA : _____
 CHARACTER OF TERRAIN : _____
 STREAM CHARACTERISTICS : _____
 NATURE OF STREAMBED : _____

PEAK FLOW DATA

Q 2.33 =	_____	Q 50 =	_____
Q 10 =	_____	Q 100 =	_____
Q 25 =	_____	Q 500 =	_____

DATE OF FLOOD OF RECORD : _____
 ESTIMATED DISCHARGE : _____
 WATER SURFACE ELEV. : _____
 NATURAL STREAM VELOCITY : @ Q?? = _____
 ICE CONDITIONS : _____
 DEBRIS : _____
 DOES THE STREAM REACH MAXIMUM HIGHWATER ELEV. RAPIDLY? _____
 IS ORDINARY RISE RAPID? _____
 IS STAGE AFFECTED BY UPSTREAM OR DOWNSTREAM CONDITIONS? _____
 IF YES, DESCRIBE : _____

WATERSHED STORAGE: 0% HEADWATERS: _____
 UNIFORM: _____
 IMMEDIATELY ABOVE SITE: _____

EXISTING STRUCTURE INFORMATION

STRUCTURE TYPE: Single span composite rolled beam
 YEAR BUILT: 1955
 CLEAR SPAN(NORMAL TO STREAM): _____ N/A
 VERTICAL CLEARANCE ABOVE R.R. TRACKS: 22'-2"
 WATERWAY OF FULL OPENING: _____ N/A
 DISPOSITION OF STRUCTURE: Retain existing steel
 TYPE OF MATERIAL UNDER SUBSTRUCTURE: _____

WATER SURFACE ELEVATIONS AT:

Q2.33 =	_____	VELOCITY =	_____
Q10 =	_____	"	_____
Q25 =	_____	"	_____
Q50 =	_____	"	_____
Q100 =	_____	"	_____

LONG TERM STREAMBED CHANGES:

IS THE ROADWAY OVERTOPPED BELOW Q100: _____
 FREQUENCY: _____
 RELIEF ELEVATION: _____
 DISCHARGE OVER ROAD @Q100: NO

UPSTREAM STRUCTURE

TOWN: _____ DISTANCE: _____
 HIGHWAY #: _____ STRUCTURE #: _____
 CLEAR SPAN: _____ CLEAR HEIGHT: _____
 YEAR BUILT: _____ FULL WATERWAY: _____
 STRUCTURE TYPE: _____

DOWNSTREAM STRUCTURE

TOWN: _____ DISTANCE: _____
 HIGHWAY #: _____ STRUCTURE #: _____
 CLEAR SPAN: _____ CLEAR HEIGHT: _____
 YEAR BUILT: _____ FULL WATERWAY: _____
 STRUCTURE TYPE: _____

LRFR LOAD RATING FACTORS

LOADING LEVELS	TRUCK						
	H-20	HL-93	3S2	6 AXLE	3A STR.	4A STR.	5A SEHH
TONNAGE	20	36	36	66	30	34.5	38
INVENTORY	3.73	1.68					
POSTING							
OPERATING	4.83	2.18	2.66	1.55	2.62	2.34	2.37
COMMENTS:							

PROPOSED STRUCTURE

STRUCTURE TYPE: Retain existing with new deck

CLEAR SPAN(NORMAL TO STREAM): _____
 VERTICAL CLEARANCE ABOVE STREAMBED: _____ NA
 WATERWAY OF FULL OPENING: _____ NA

WATER SURFACE ELEVATIONS AT:

Q2.33 =	_____	VELOCITY=	_____
Q10 =	_____	"	_____
Q25 =	_____	"	_____
Q50 =	_____	"	_____
Q100 =	_____	"	_____

IS THE ROADWAY OVERTOPPED BELOW Q100: NA
 FREQUENCY: _____
 RELIEF ELEVATION: _____
 DISCHARGE OVER ROAD @Q100: _____

AVERAGE LOW ELEVATION OF SUPERSTRUCTURE: _____
 VERTICAL CLEARANCE: @ Q?? = _____

SCOUR:

REQUIRED CHANNEL PROTECTION: _____

PERMIT INFORMATION

AVERAGE DAILY FLOW: _____ DEPTH OR ELEVATION: _____
 ORDINARY LOW WATER: _____
 ORDINARY HIGH WATER: _____

TEMPORARY BRIDGE REQUIREMENTS

STRUCTURE TYPE: None - Detour will be in place during construction for 62A deck
 CLEAR SPAN (NORMAL TO STREAM): _____
 VERTICAL CLEARANCE ABOVE STREAMBED: _____
 WATERWAY AREA OF FULL OPENING: _____

ADDITIONAL INFORMATION

TRAFFIC MAINTENANCE NOTES

1. TRAFFIC DETOURED DURING DECK REPLACEMENT ON BRIDGE 62A.
2. TRAFFIC SIGNALS USED DURING RETAINING WALL, WINGWALL, CLEANING AND PAINTING OF STRUCTURE FOR BRIDGE 62A.
3. FLAGGERS AND TRAFFIC SIGNAL TO BE USED FOR BRIDGE 66.

DESIGN VALUES

1. DESIGN LIVE LOAD	HL-93
2. FUTURE PAVEMENT	d_p : 2.5 INCH
3. DESIGN SPAN	L : 0.00 FT
4. MIN. MID-SPAN POS. CAMBER @ RELEASE (PRESTRESSED UNITS)	Δ : ---
5. PRESTRESSING STRAND (0.80 INCH DIAMETER - LOW RELAX)	f_y : ---
6. PRESTRESSED CONCRETE STRENGTH	$f'c$: ---
7. PRESTRESSED CONCRETE RELEASE STRENGTH	$f'ci$: ---
8. CONCRETE, HIGH PERFORMANCE CLASS AA	$f'c$: ---
9. CONCRETE, HIGH PERFORMANCE CLASS A LOW CEMENT	$f'c$: 4.0 KSI
10. CONCRETE, HIGH PERFORMANCE CLASS B	$f'c$: 3.5 KSI
11. CONCRETE, CLASS C	$f'c$: ---
12. REINFORCING STEEL	f_y : 80 KSI
13. STRUCTURAL STEEL AASHTO M270	f_y : ---
14. SOIL UNIT WEIGHT	γ : 0.140 KCF
15. NOMINAL BEARING RESISTANCE OF SOIL	q_n : 4.0 KSF
16. SOIL BEARING RESISTANCE FACTOR (REFER TO AASHTO LRFD)	ϕ : ---
17. NOMINAL BEARING RESISTANCE OF ROCK	q_n : ---
18. ROCK BEARING RESISTANCE FACTOR (REFER TO AASHTO LRFD)	ϕ : ---
19. NOMINAL AXIAL PILE RESISTANCE	q_p : ---
20. PILE YIELD STRENGTH ASTM A572	f_y : ---
21. PILE SIZE	---
22. EST. PILE LENGTH	L_p : _____
23. PILE RESISTANCE FACTOR	ϕ : ---
24. LATERAL PILE DEFLECTION	Δ : ---
25. BASIC WIND SPEED	V_{3s} : ---
26. MINIMUM GROUND SNOW LOAD	P_g : ---
27. SEISMIC DATA	PGA : --- S_s : --- S_1 : ---

PROJECT NAME: **HARTLAND**
 PROJECT NUMBER: **BHF BPNT(12)**

FILE NAME: **z11c260pi.dgn** PLOT DATE: 12/31/2013
 PROJECT LEADER: **M.A. COLGAN** DRAWN BY: **A.J. GOUDREAU**
 DESIGNED BY: **S.G. FARNSWORTH** CHECKED BY: **S.G. FARNSWORTH**
BR 62A PRELIMINARY INFORMATION SHEET SHEET **2** OF **55**

TRAFFIC DATA

YEAR	ADT	DHV	% D	% T	ADTT
2013	2150	240	54	7.0	150
2033	2420	260	54	7.0	170


AS BUILT "REBAR" DETAILS

20 year ESAL for flexible pavement from 2013 to 2033 : 0		
LEVEL I	LEVEL II	LEVEL III
TYPE:	TYPE:	TYPE:
GRADE:	GRADE:	GRADE:

40 year ESAL for flexible pavement from 2013 to 2053 : 0
 Design Speed : 45 mph

Vanasse Hangen Brustlin, Inc.


SEE REVISED SHEET

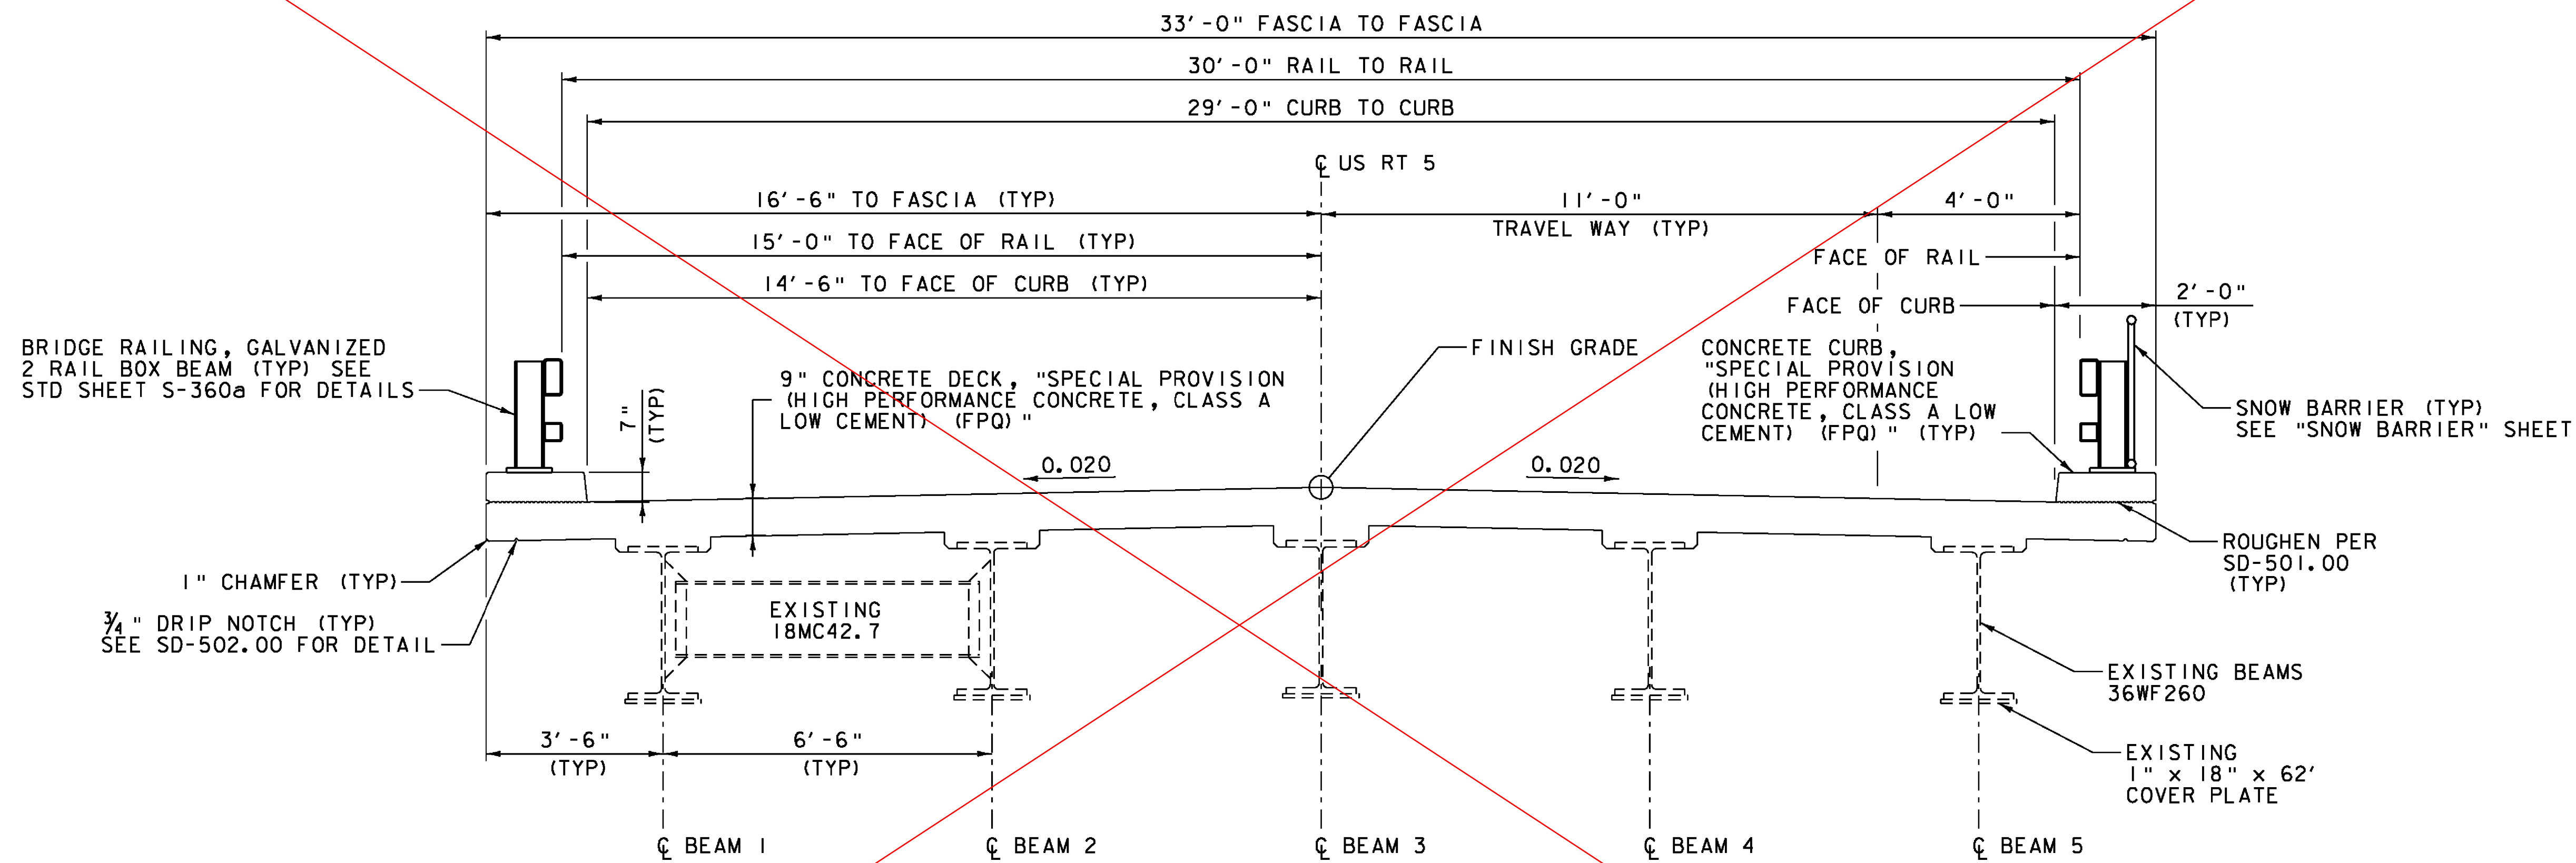

TYPICAL BRIDGE SECTION
 SCALE: 1/2" = 1'-0"

PROJECT NAME: HARTLAND	PLOT DATE: 1/2/2014
PROJECT NUMBER: BHF BPNT(12)	DRAWN BY: A.J. GOUDREAU
FILE NAME: zllc2601yp.dgn	CHECKED BY: S.G. FARNSWORTH
PROJECT LEADER: M.A. COLGAN	SHEET 3 OF 55
DESIGNED BY: A.J. GOUDREAU	
BR 62A TYPICAL BRIDGE SECTION	



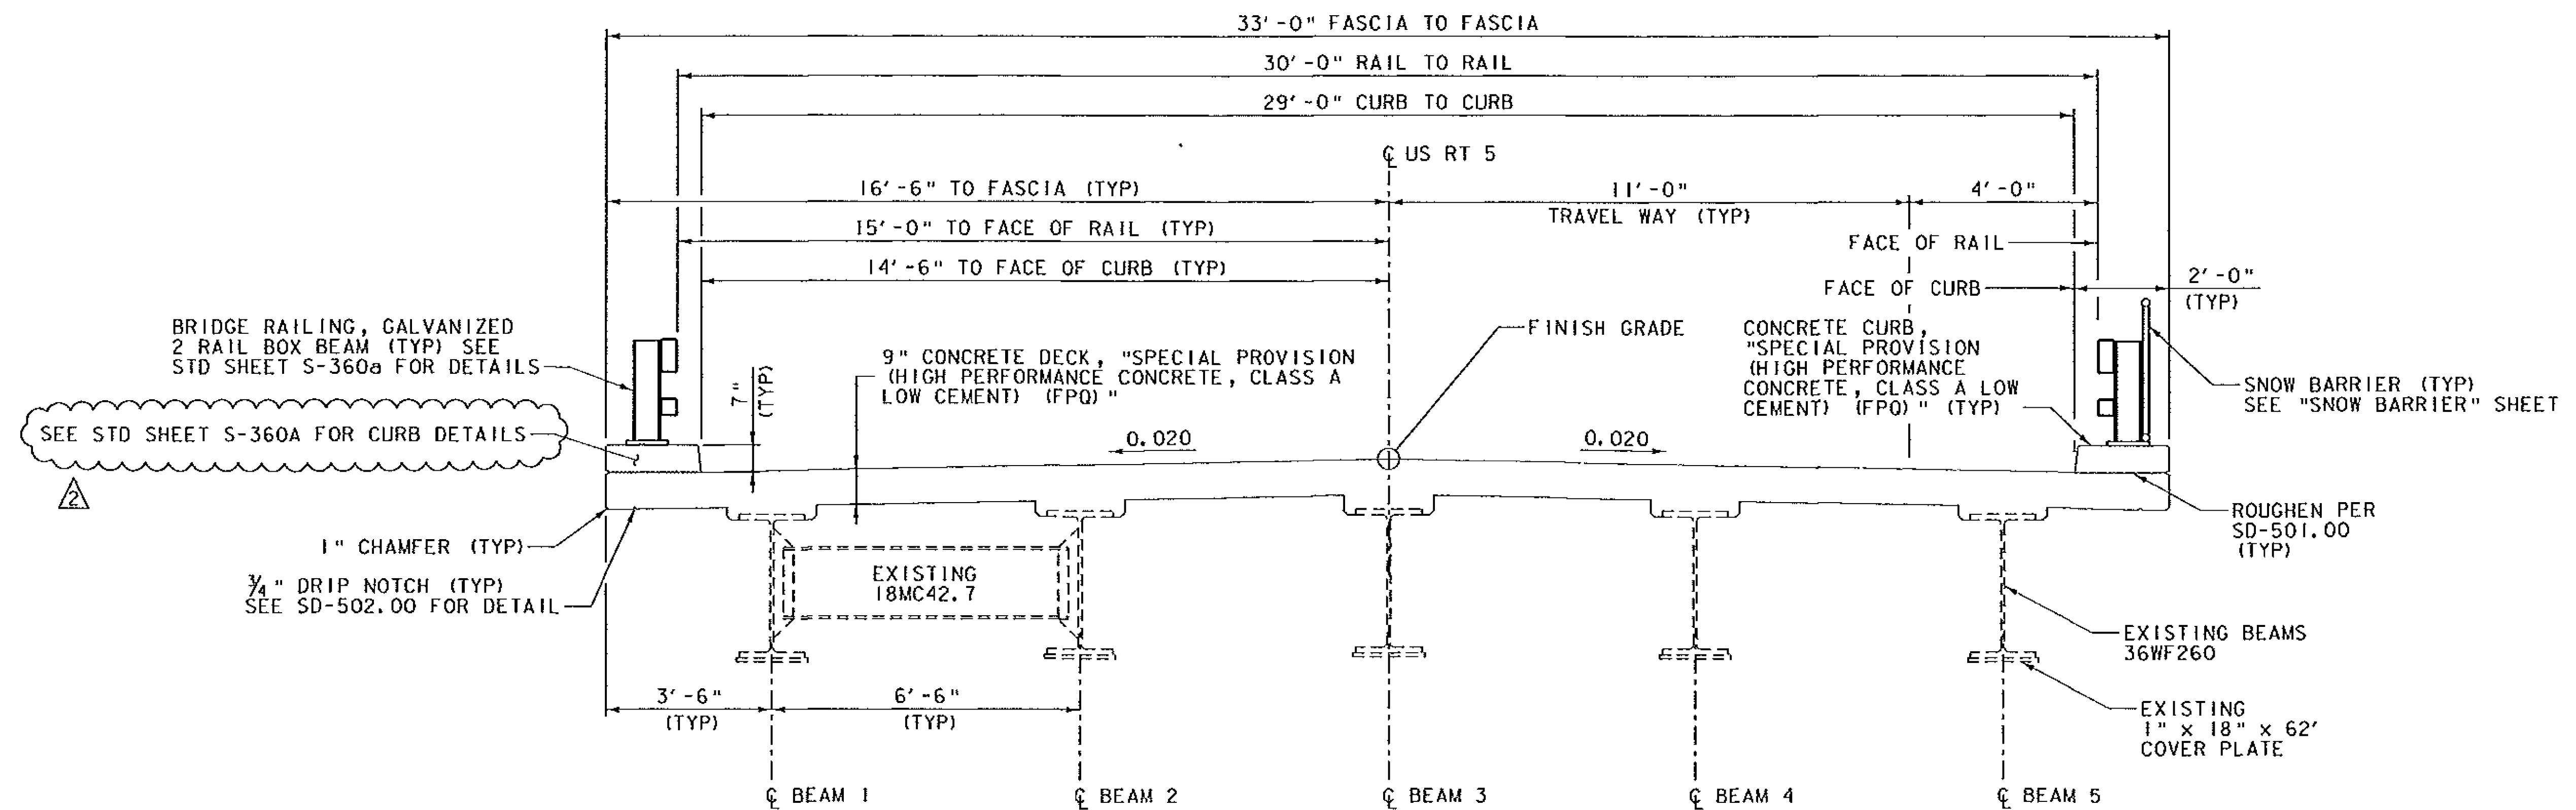



TYPICAL BRIDGE SECTION
 SCALE: 1/2" = 1'-0"

REV.	DESCRIPTION	DATE
△	SEE CURB DETAILS STD SHEET	3/3/2014
PROJECT NAME: HARTLAND		
PROJECT NUMBER: BHF BPNT(12)		
FILE NAME: zllc260typ.dgn		PLOT DATE: 3/3/2014
PROJECT LEADER: M.A. COLGAN		DRAWN BY: A.J. GOUDREAU
DESIGNED BY: A.J. GOUDREAU		CHECKED BY: S.G. FARNSWORTH
BR 62A TYPICAL BRIDGE SECTION		SHEET 3 OF 55




MATERIAL TOLERANCES
(IF USED ON PROJECT)


	TOTAL DEPTH FOR EACH MATERIAL
SURFACE - PAVEMENT	+/- 1/4"
- AGGREGATE SURFACE COURSE	+/- 1/2"
BASE COURSE	+/- 1/2"
SUBBASE	+/- 1"
SAND BORROW	+/- 1"
GRANULAR BORROW	+/- 1"

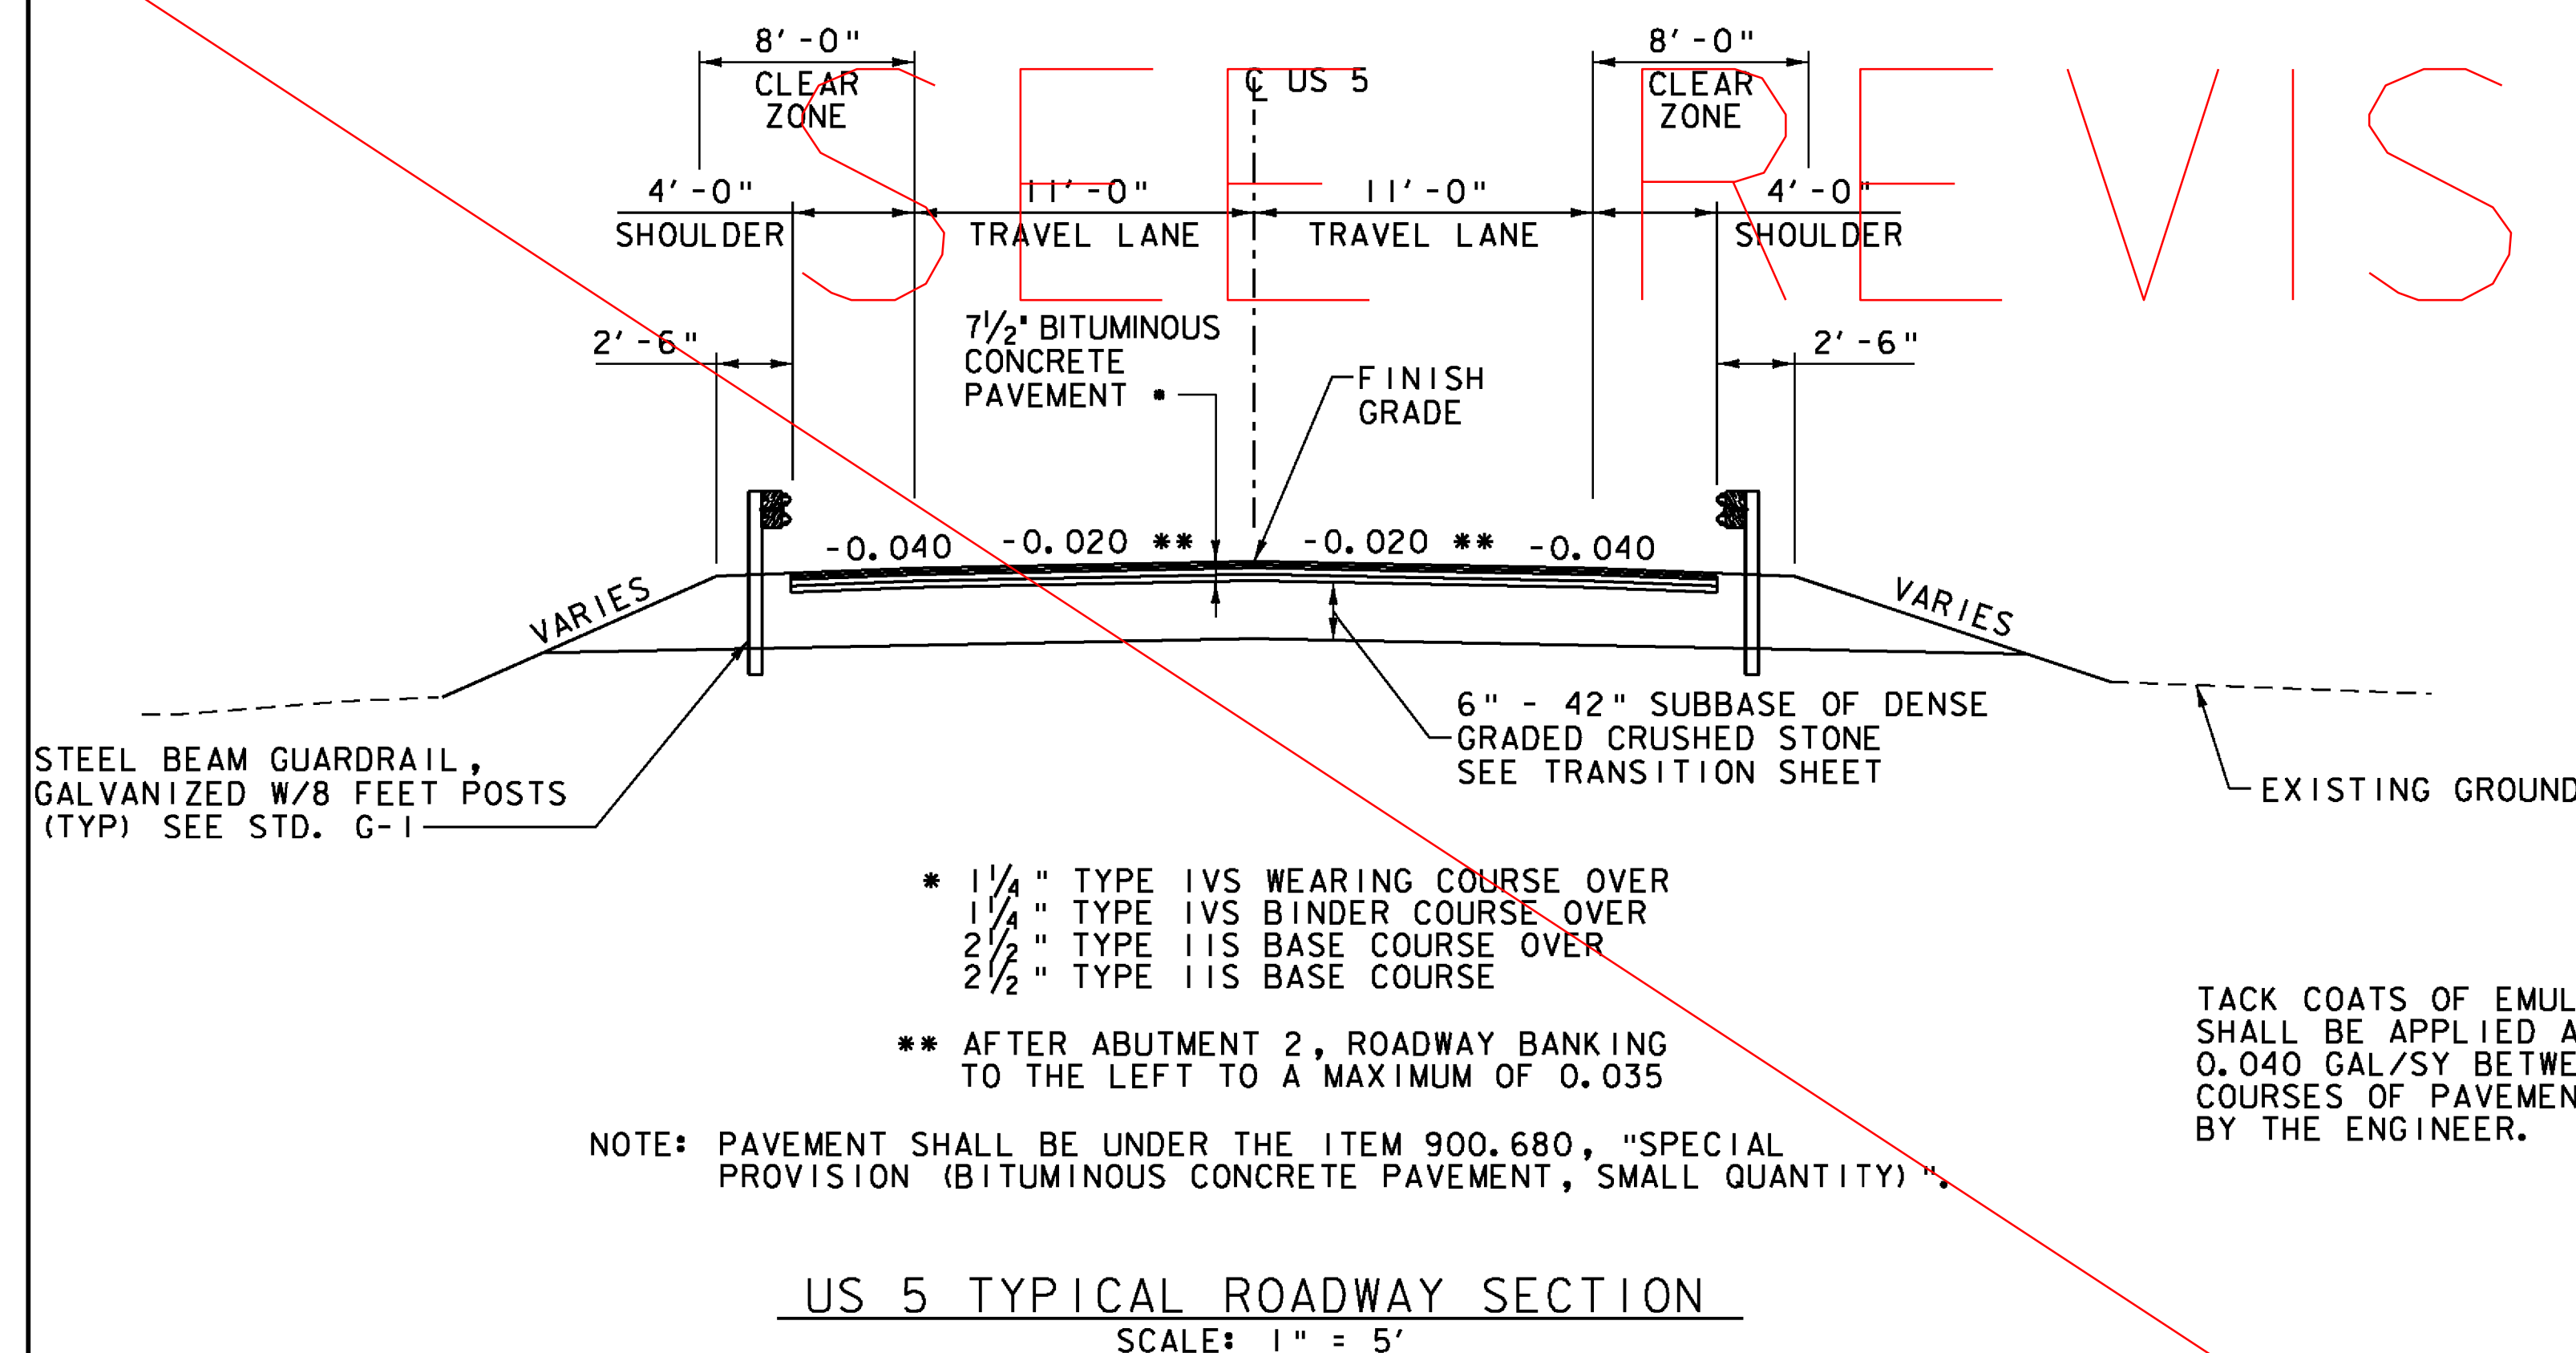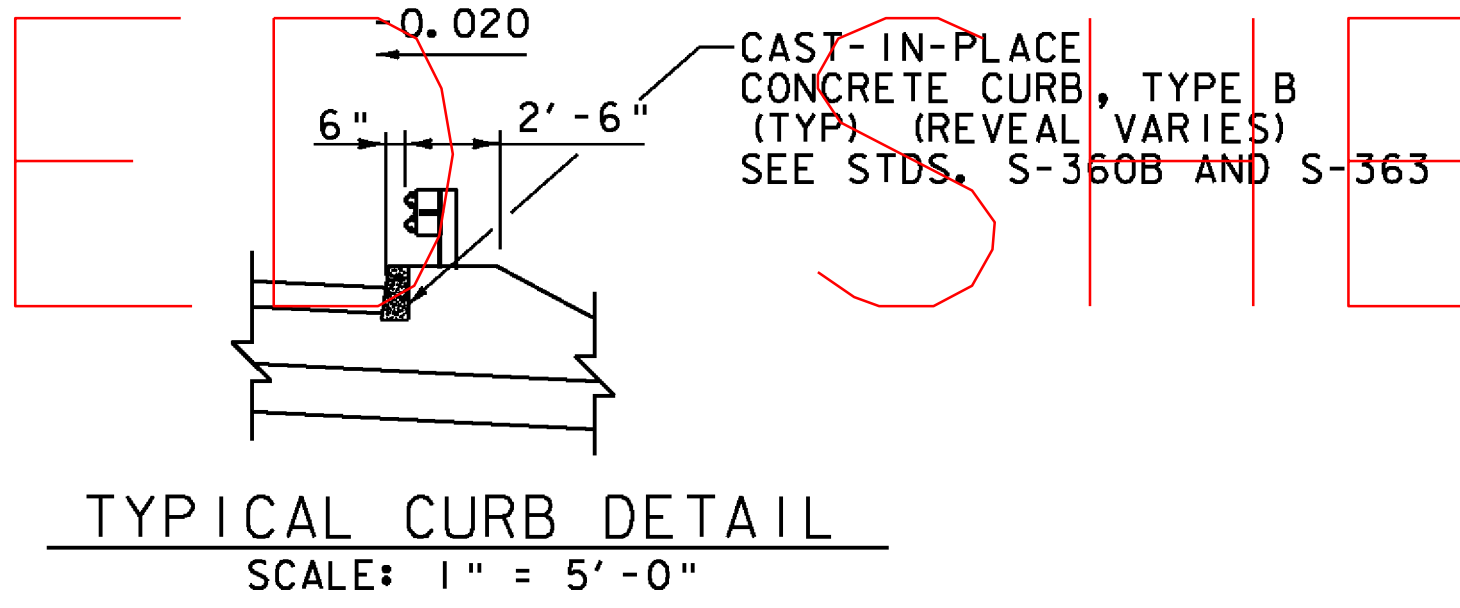


US 5 TYPICAL ROADWAY SECTION
SCALE: 1" = 5'

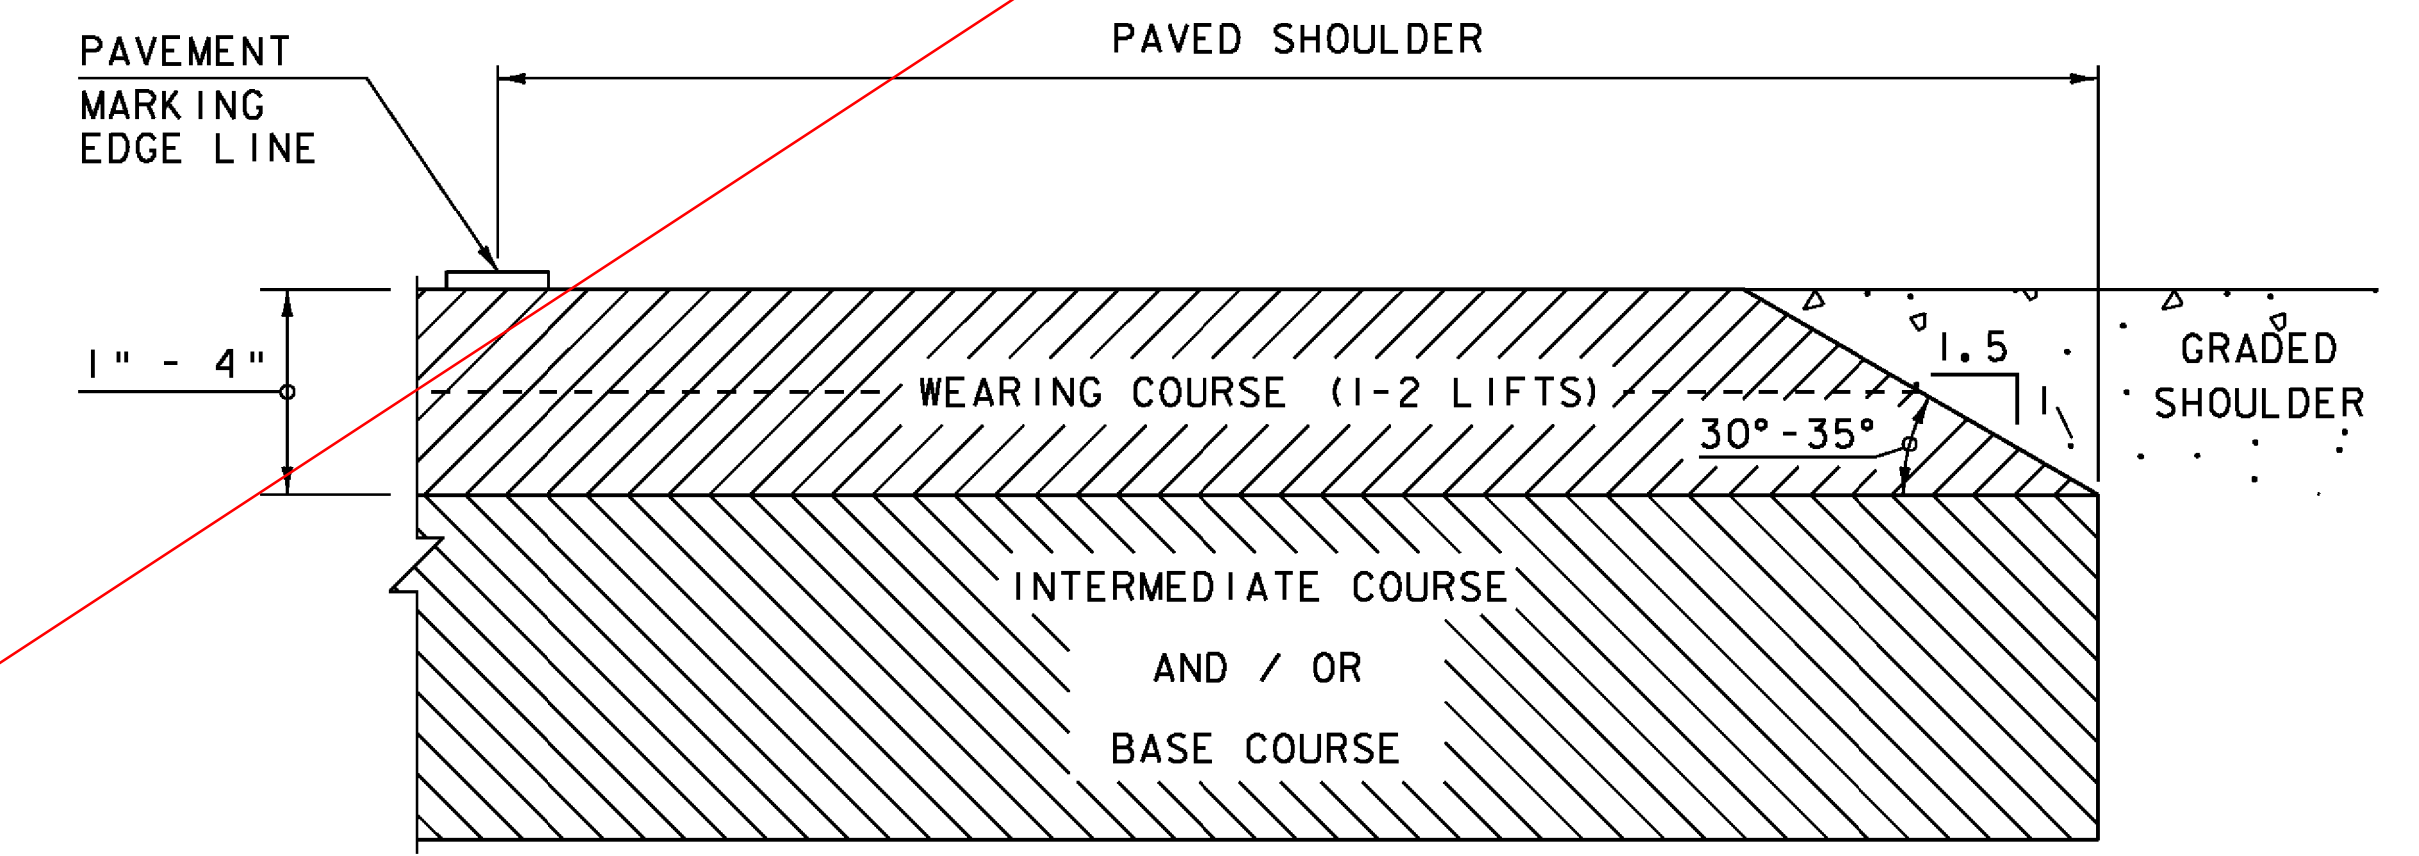

SAFETY EDGE DETAIL
NOT TO SCALE

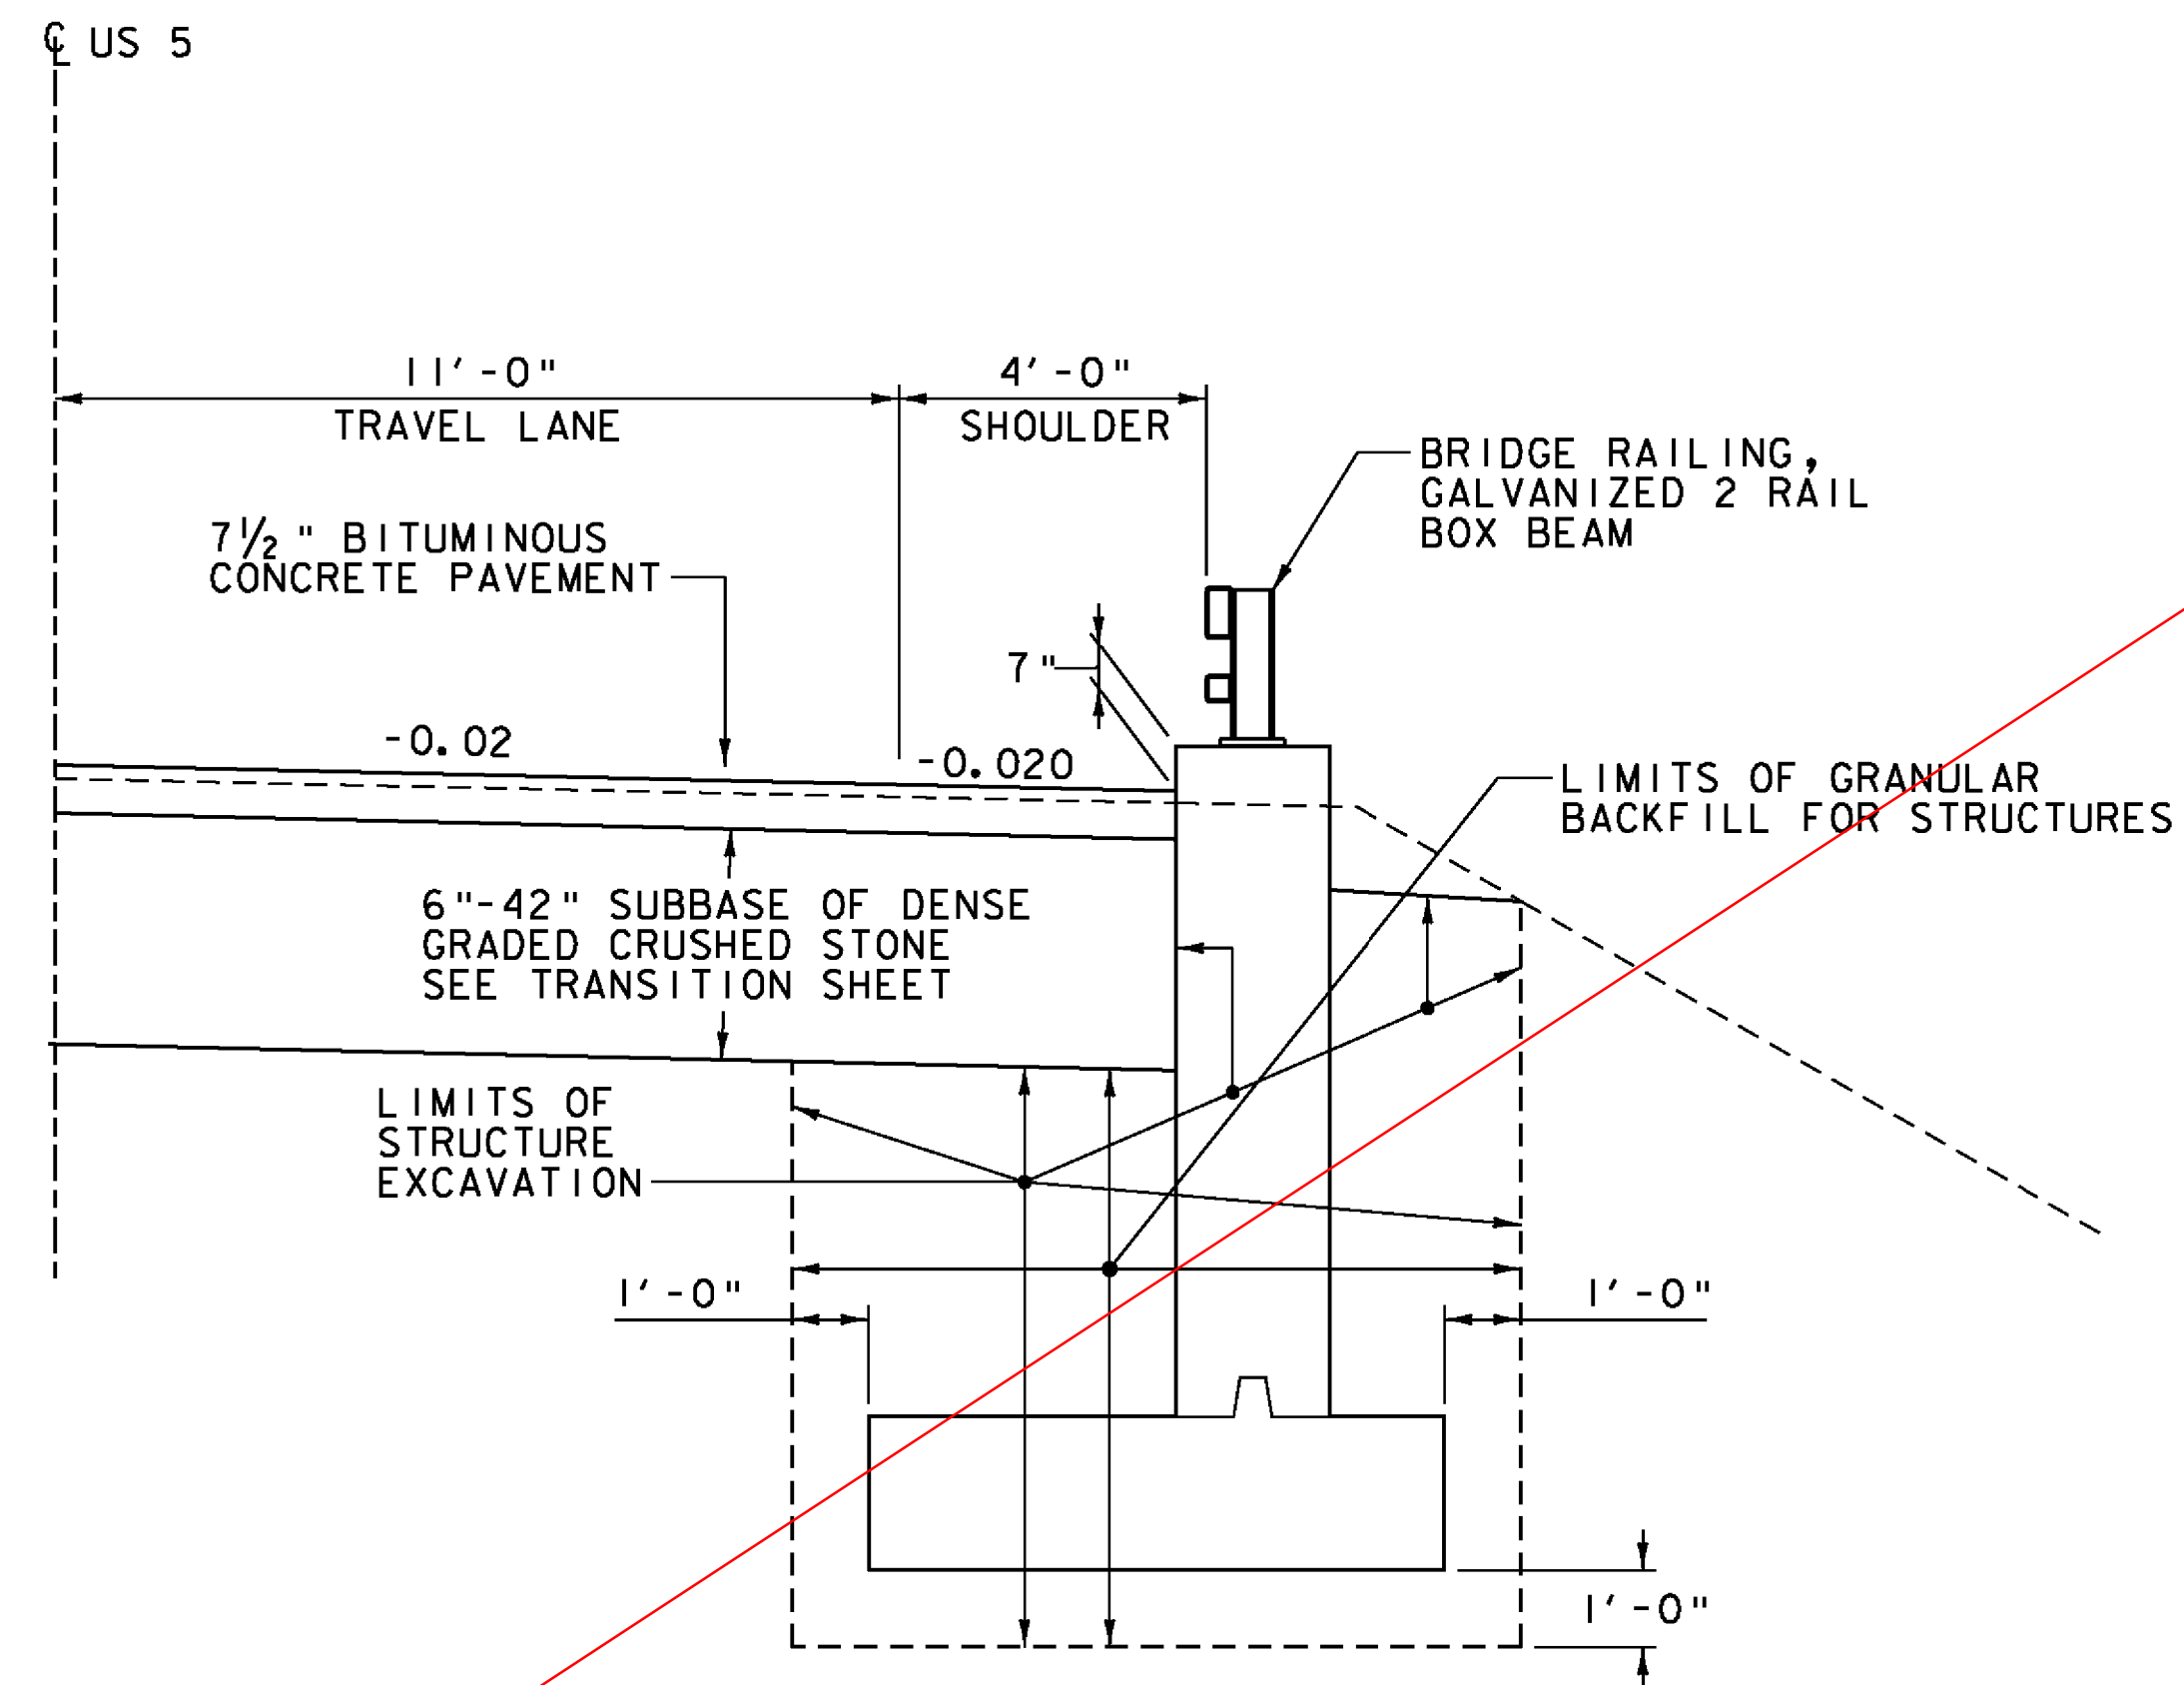


WINGWALL TYPICAL EARTHWORKS SECTION
N. T. S.

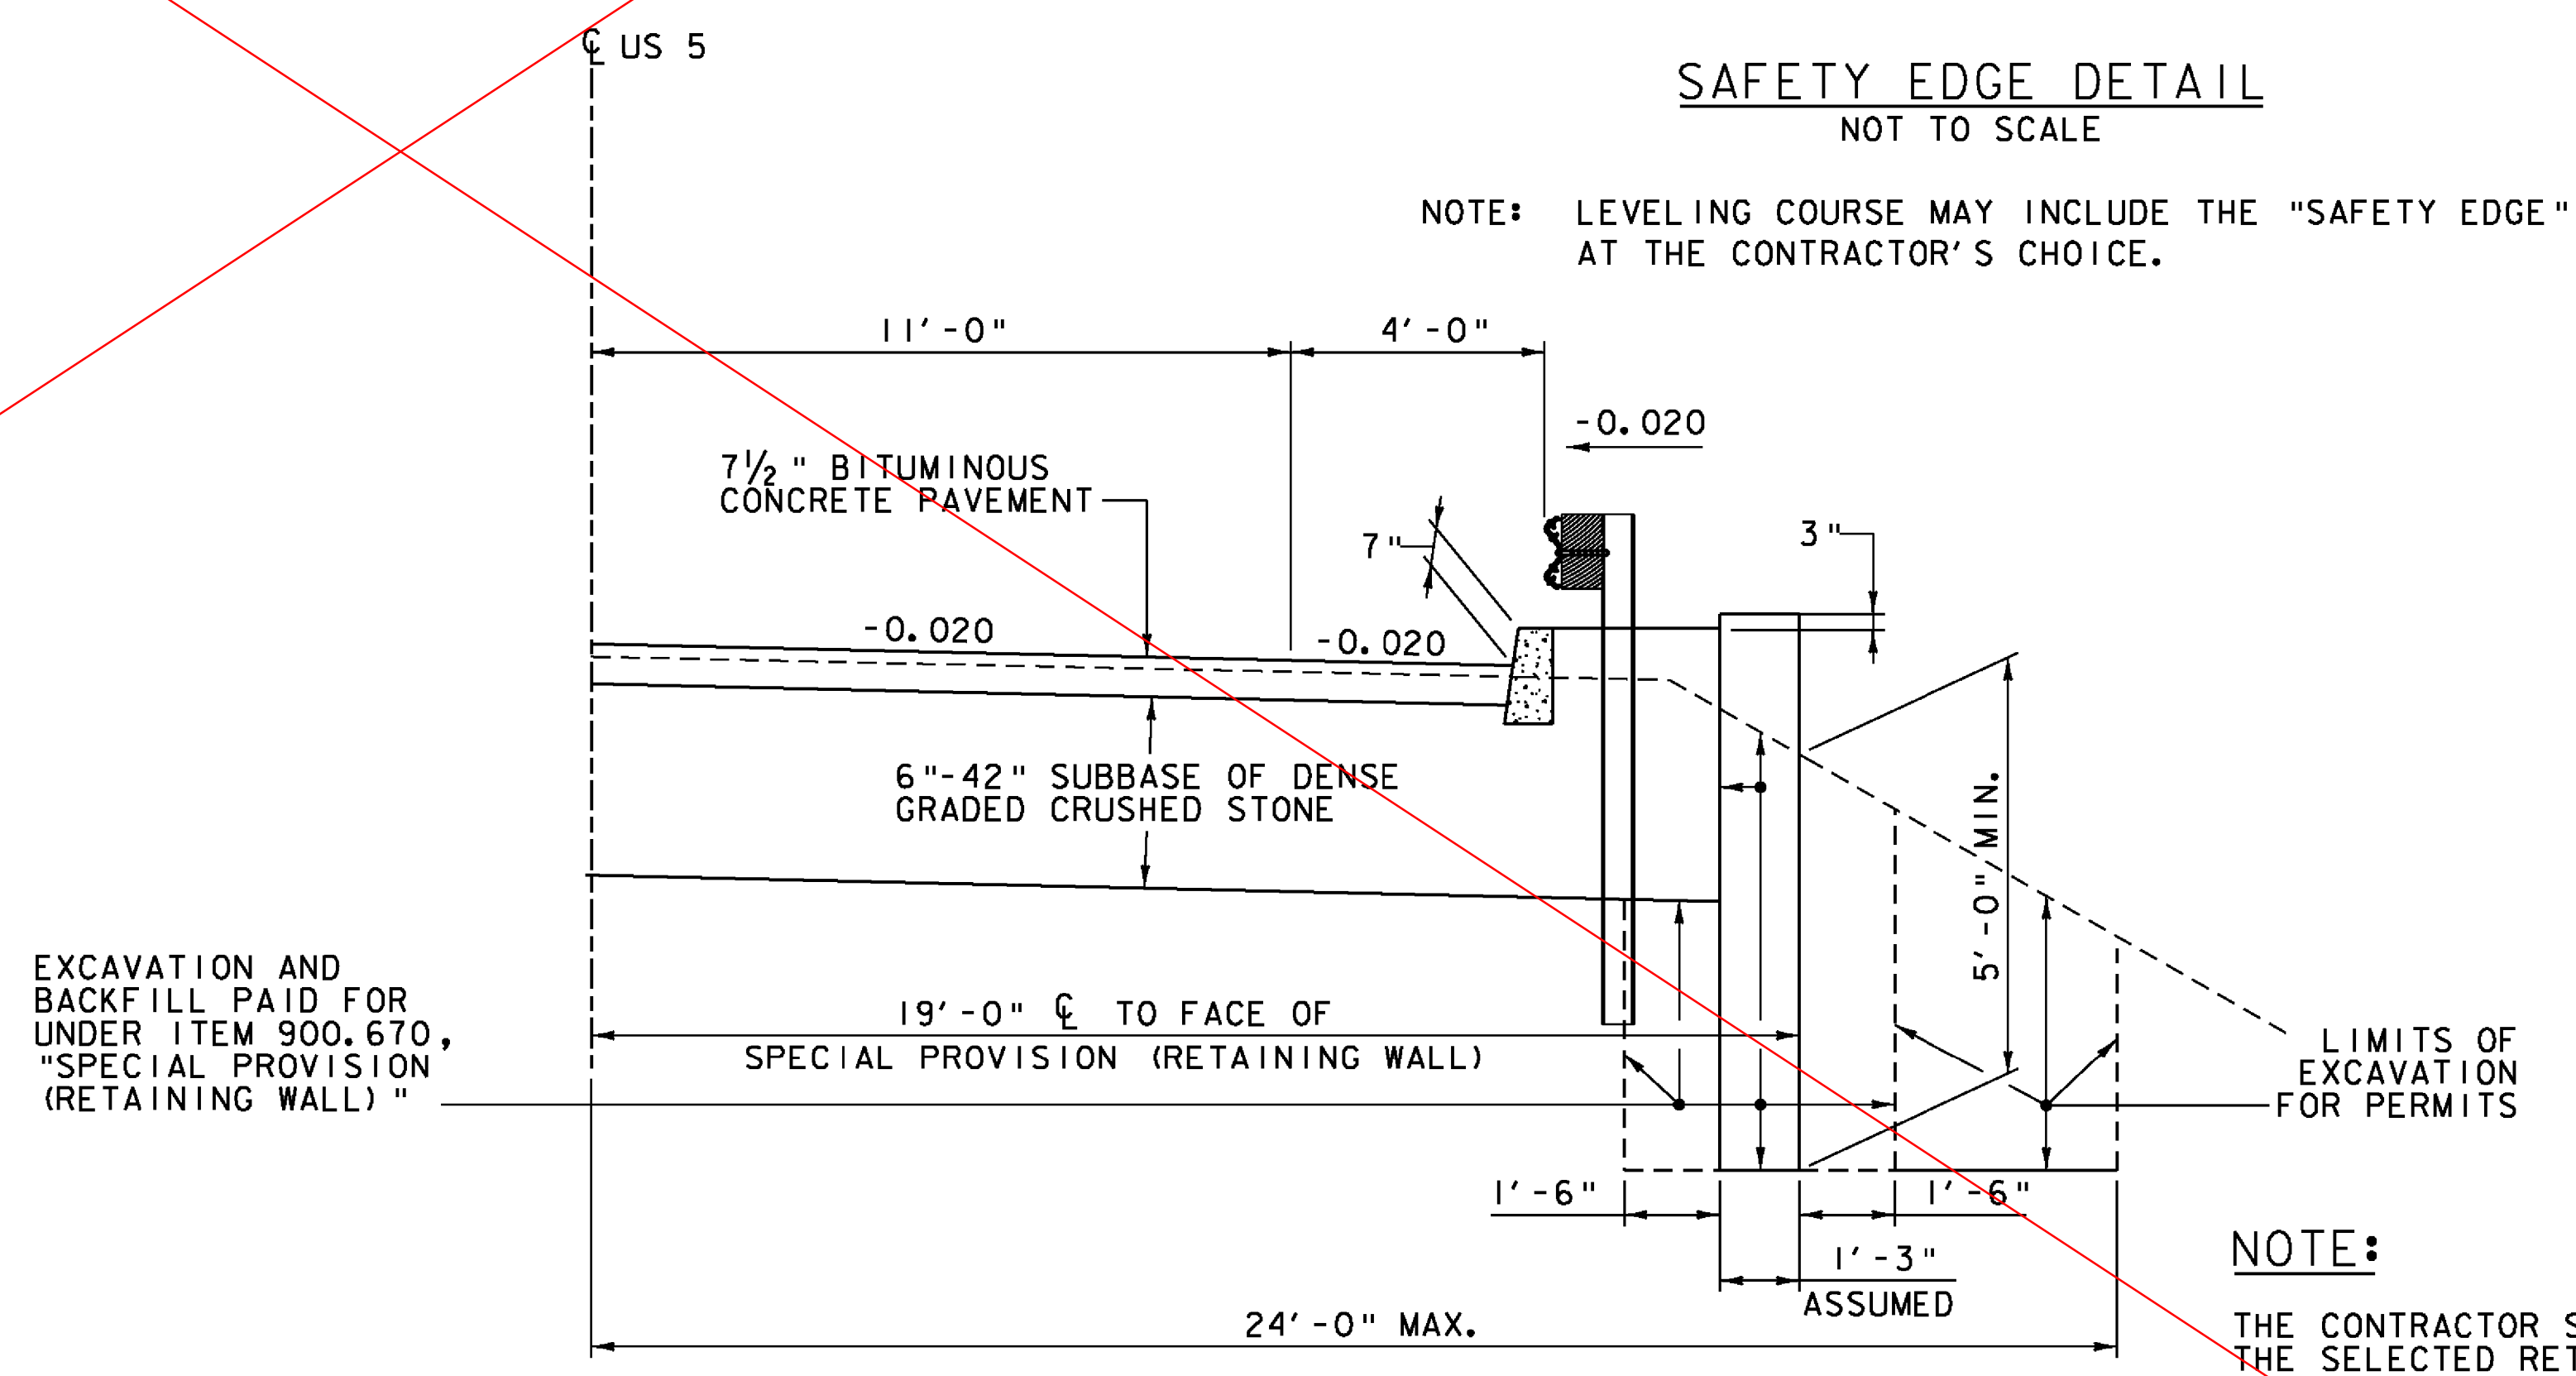


SPECIAL PROVISION (RETAINING WALL)
N. T. S.

PROJECT NAME: HARTLAND	FILE NAME: zllc2601yp.dgn	PLOT DATE: 1/2/2014
PROJECT NUMBER: BHF BPNT(12)	PROJECT LEADER: M.A. COLGAN	DRAWN BY: A.J. GOUDREAU
	DESIGNED BY: S.G. FARNSWORTH	CHECKED BY: S.G. FARNSWORTH
	BR 62A TYPICAL ROADWAY SECTIONS	SHEET 4 OF 55




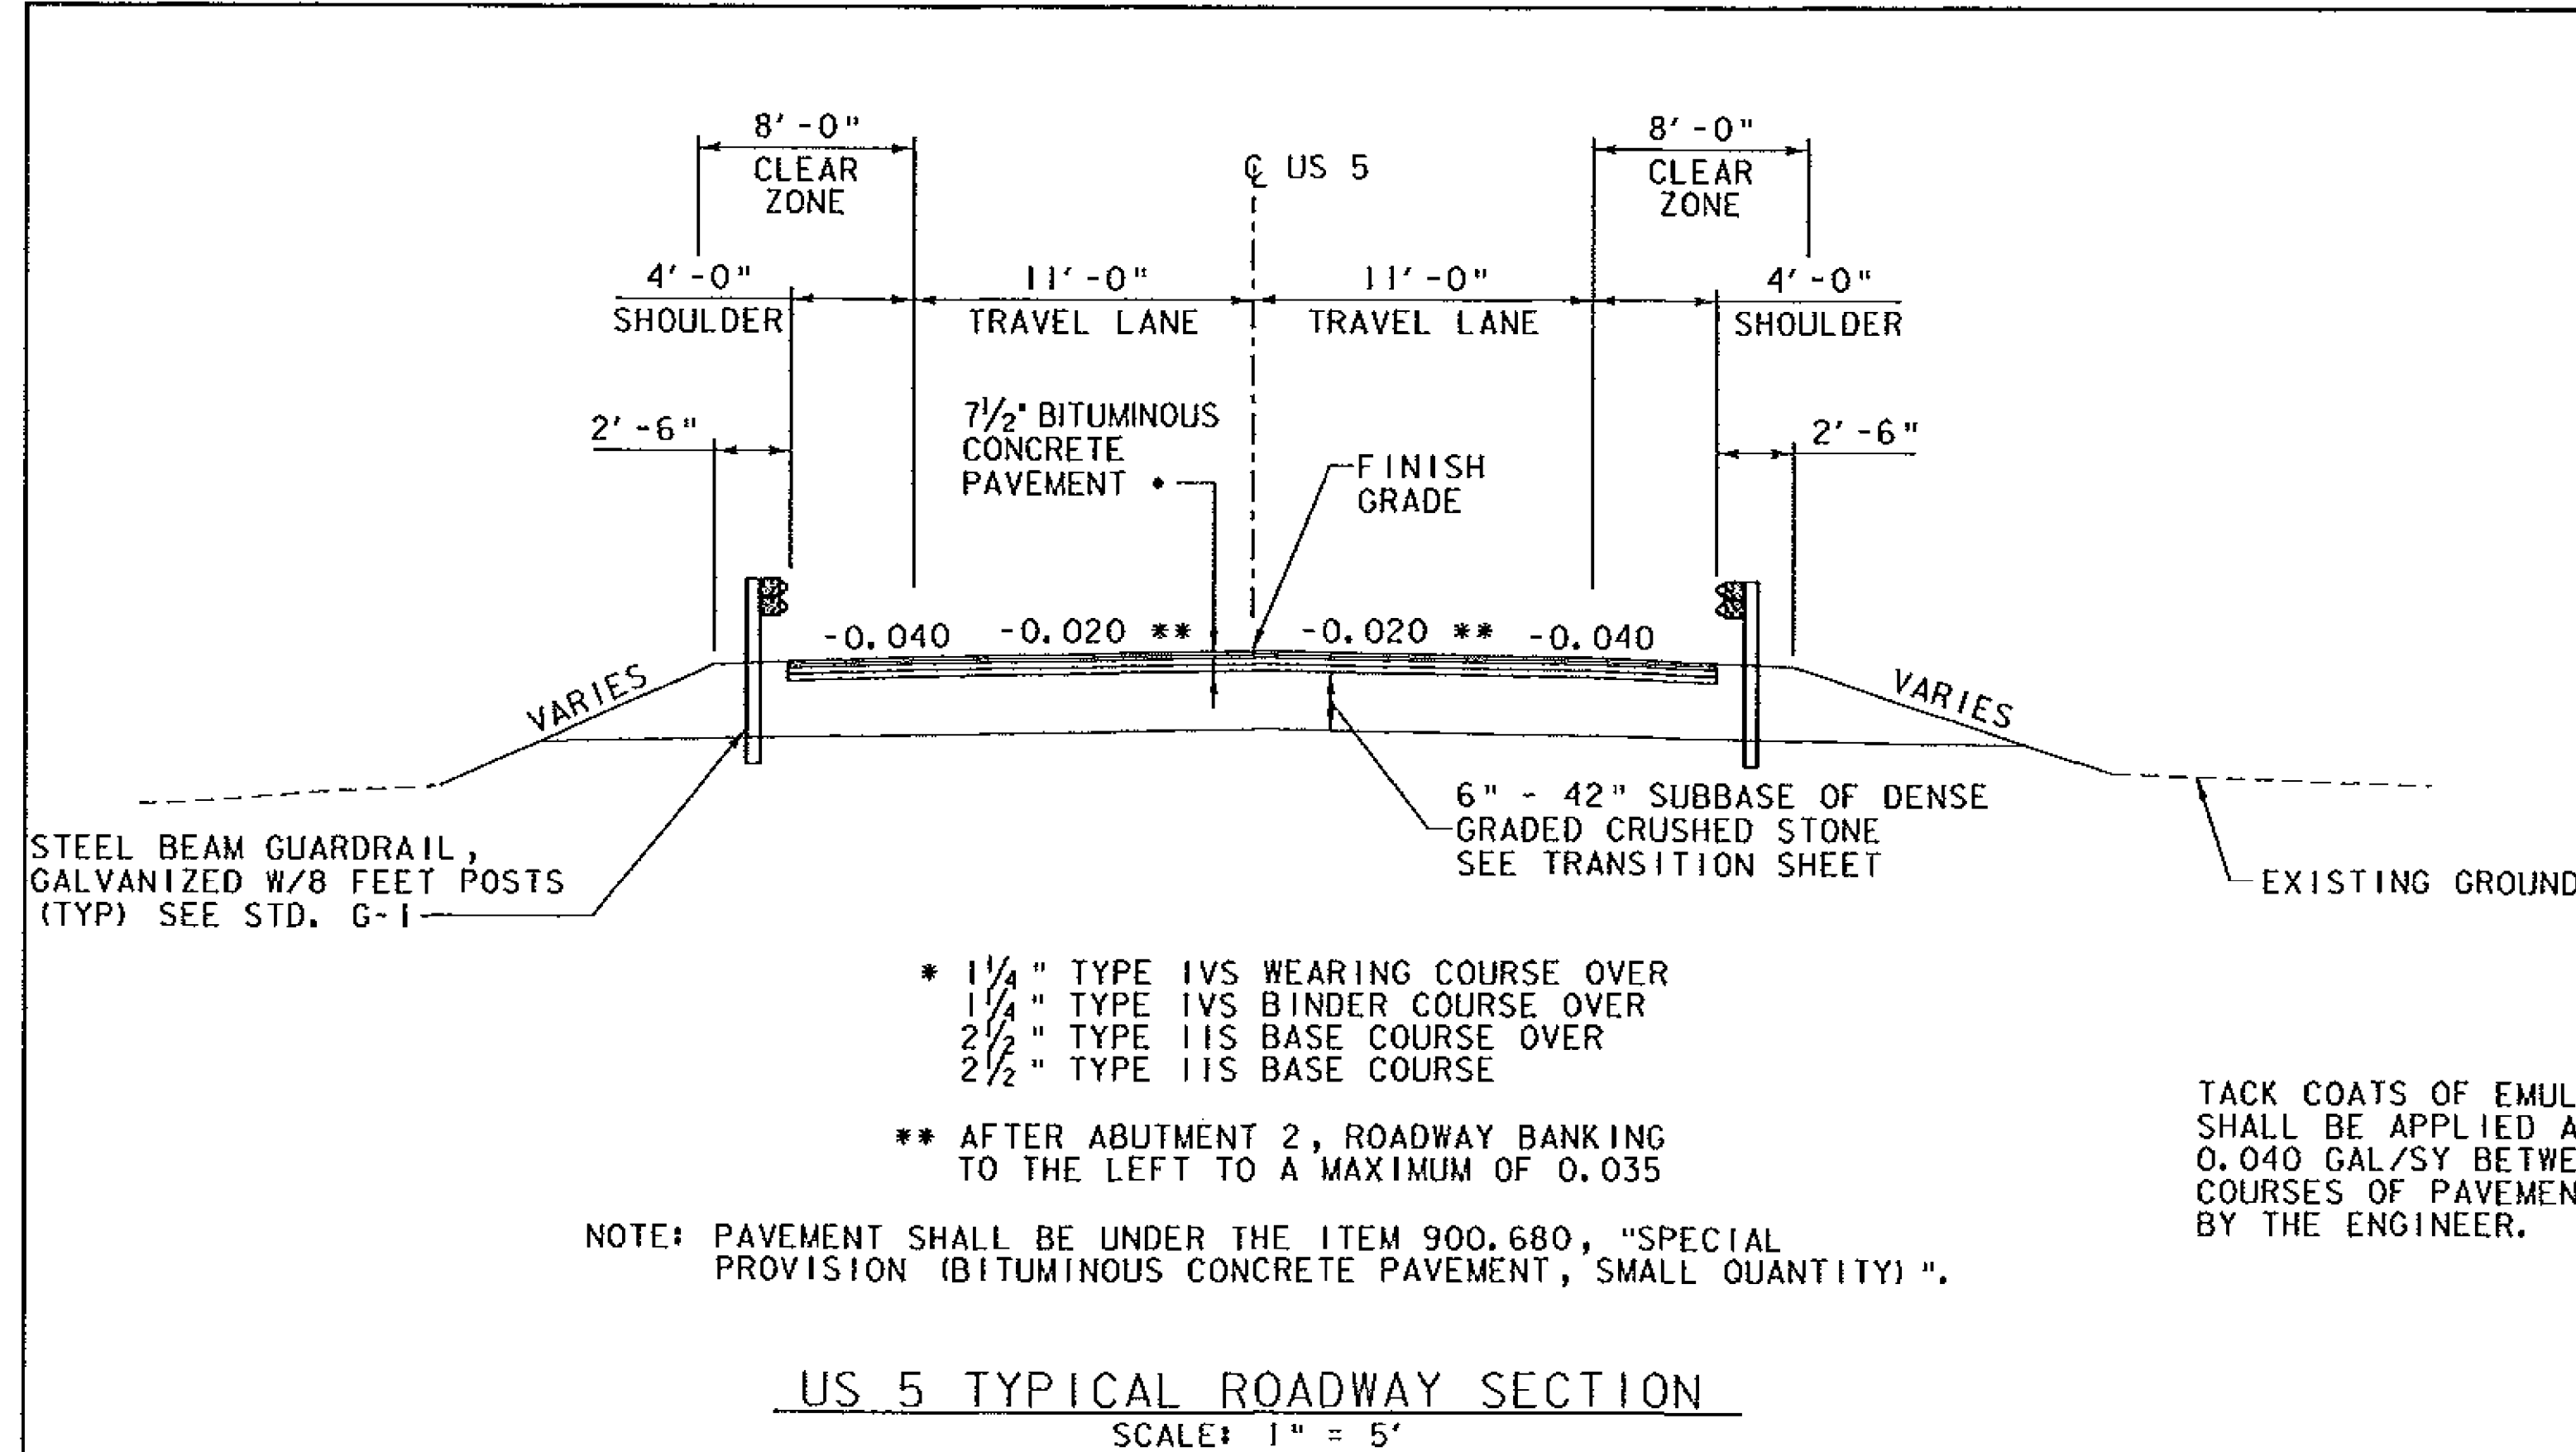

US 5 TYPICAL ROADWAY SECTION
 SCALE: 1" = 5'


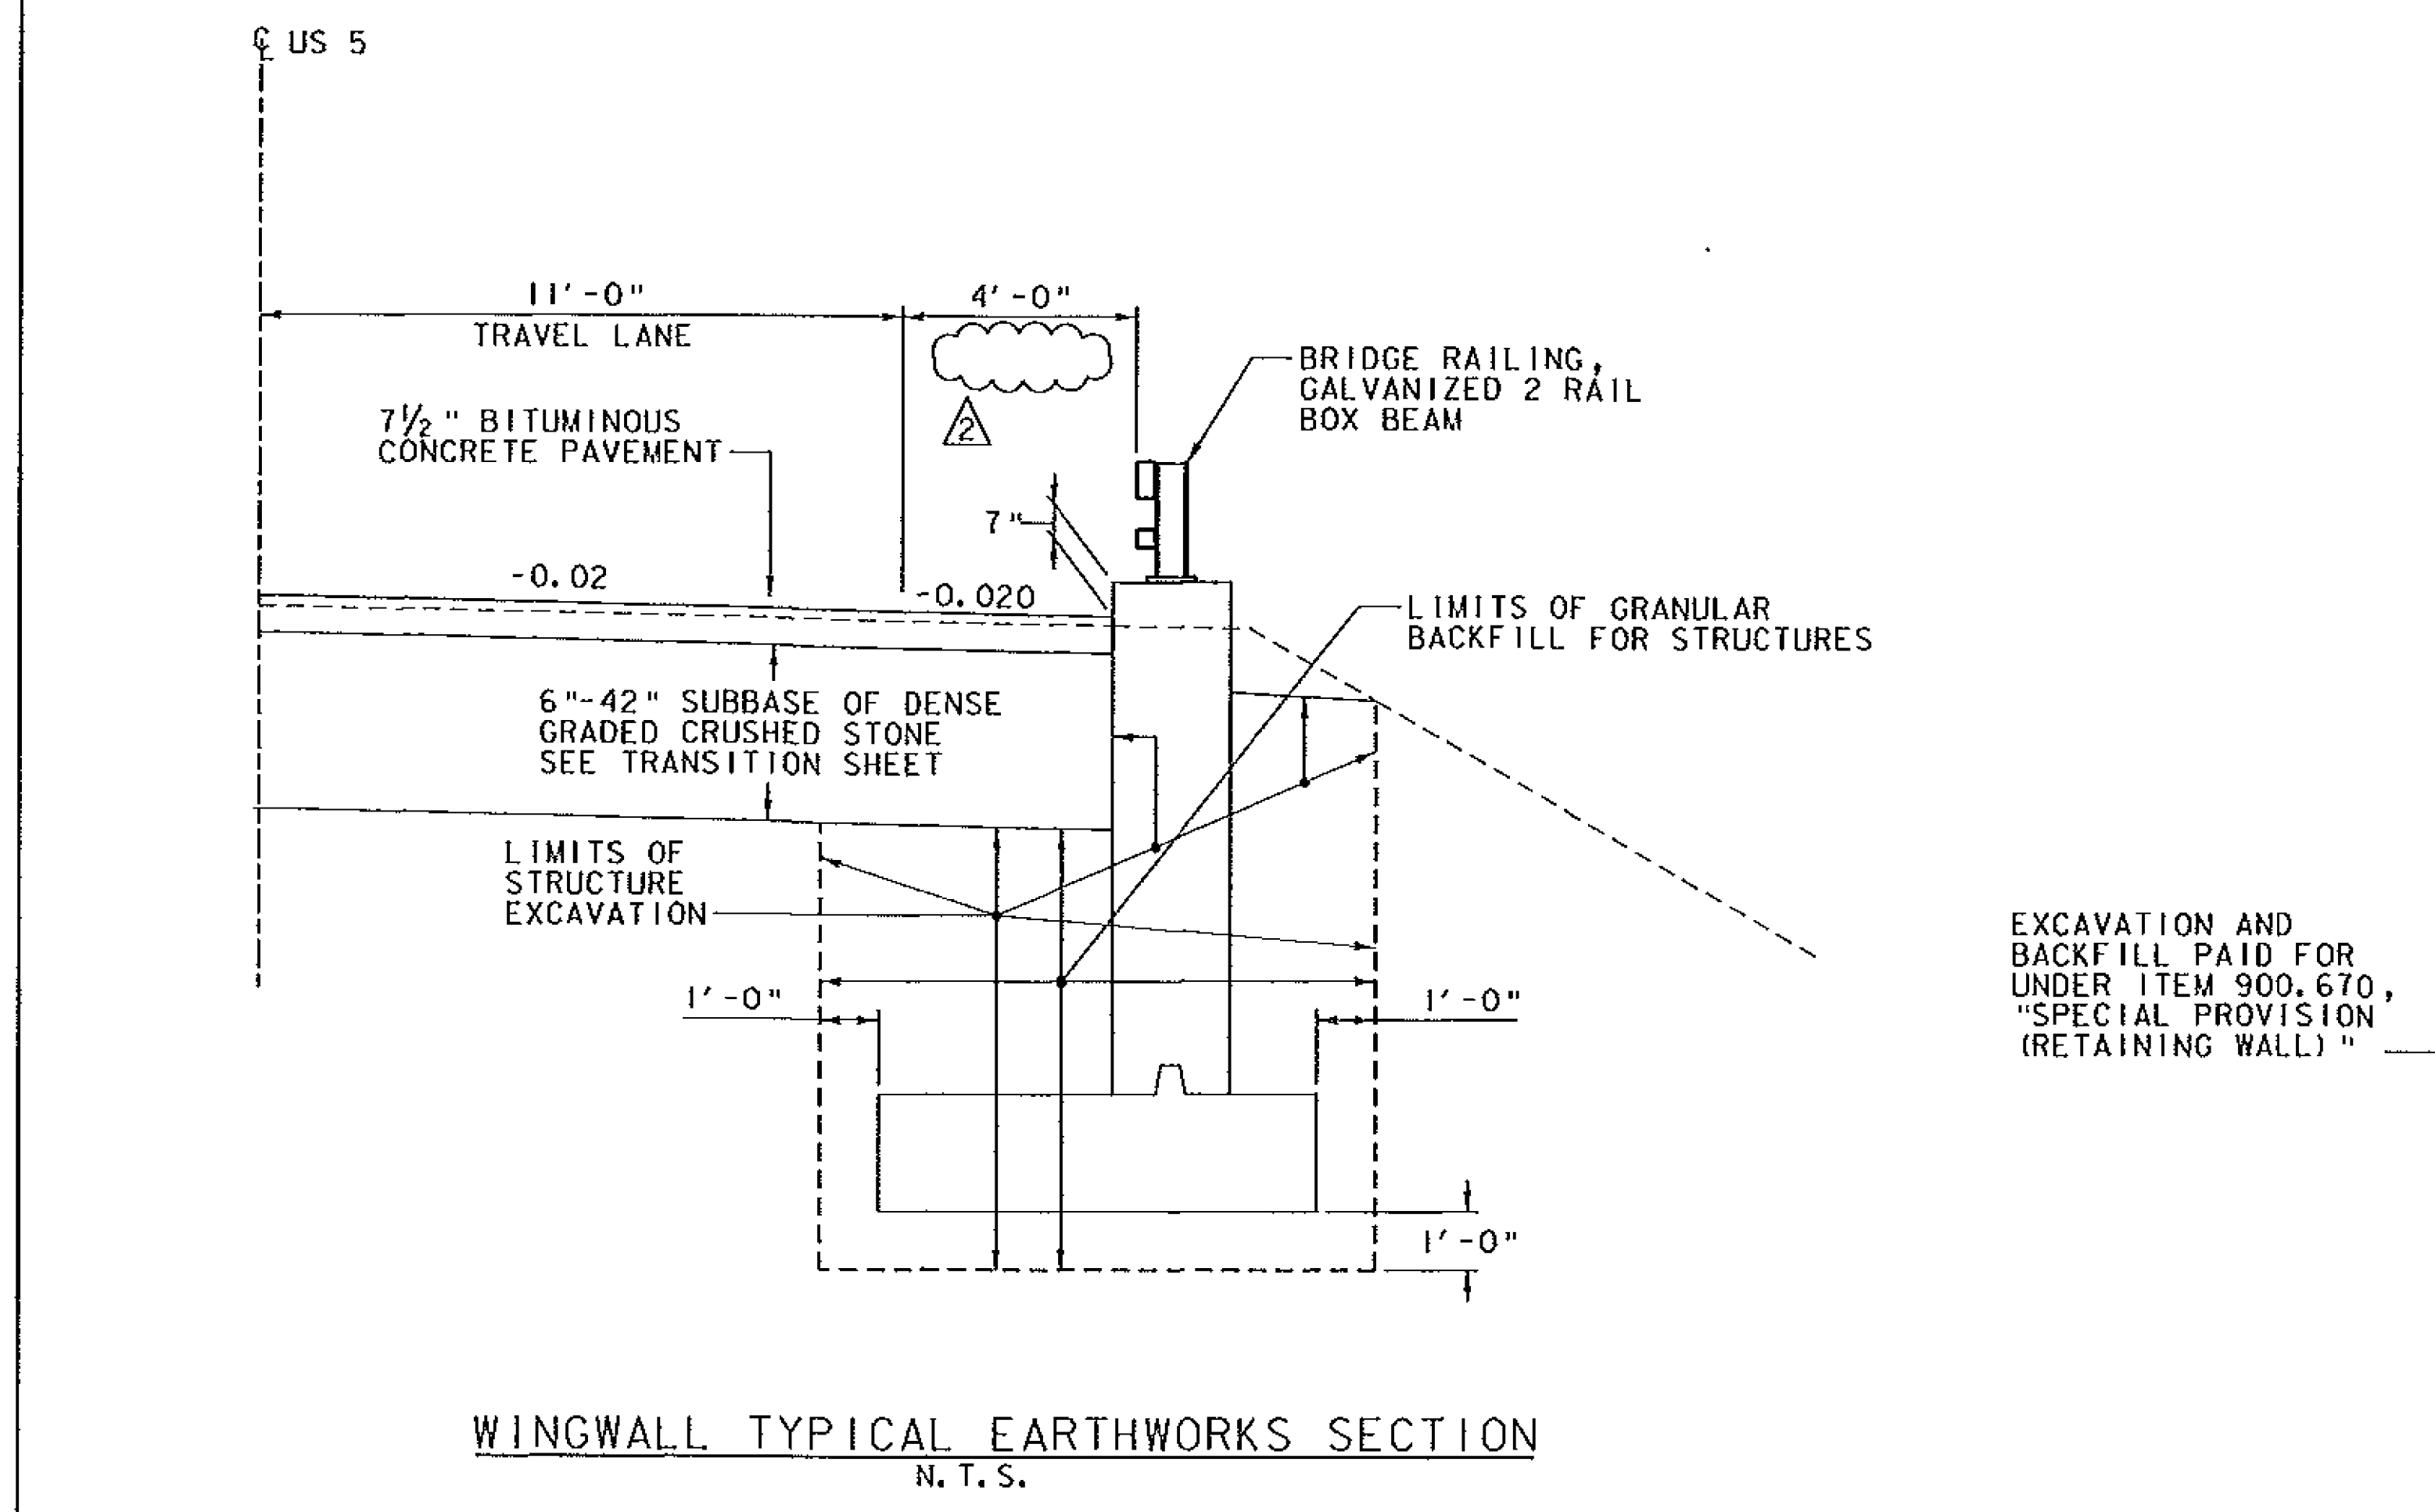


WINGWALL TYPICAL EARTHWORKS SECTION
 N. T. S.

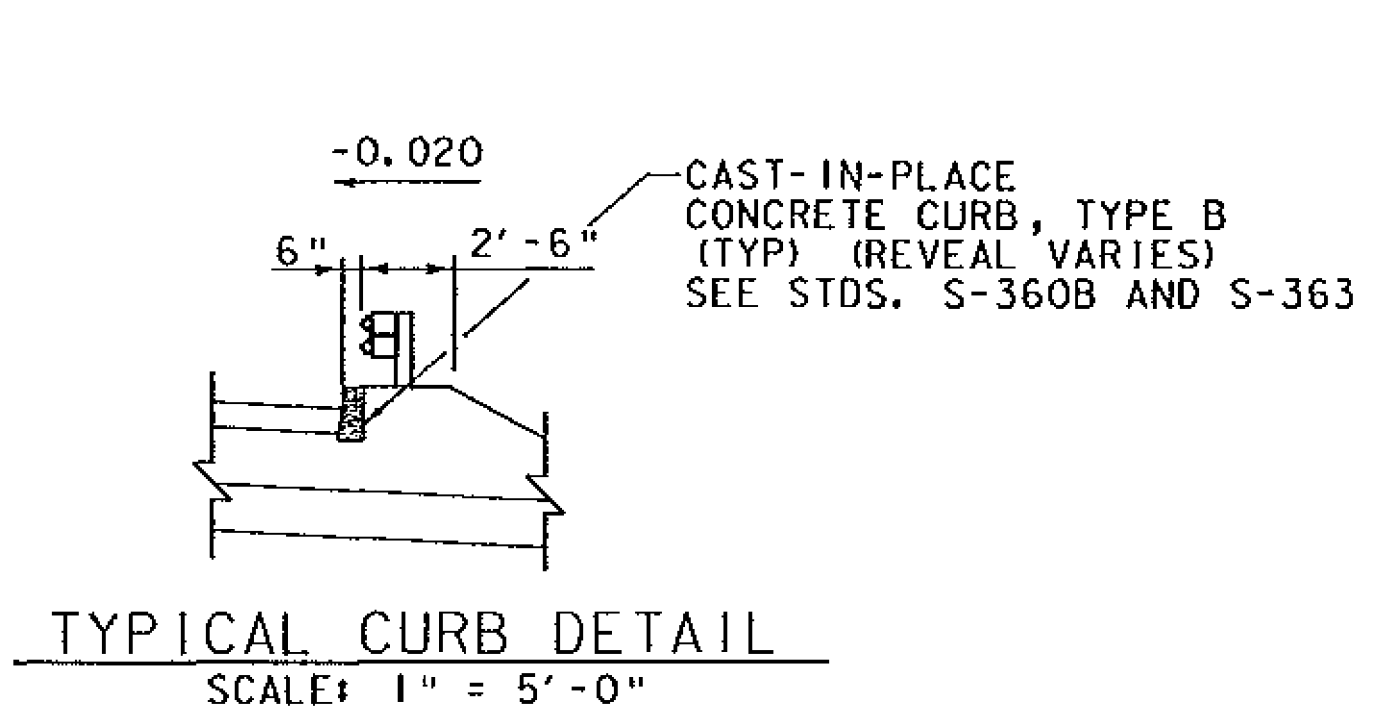

MATERIAL TOLERANCES
 (IF USED ON PROJECT)

	TOTAL DEPTH FOR EACH MATERIAL
SURFACE	
- PAVEMENT	+/- 1/4"
- AGGREGATE SURFACE COURSE	+/- 1/2"
BASE COURSE	+/- 1/2"
SUBBASE	+/- 1"
SAND BORROW	+/- 1"
GRANULAR BORROW	+/- 1"

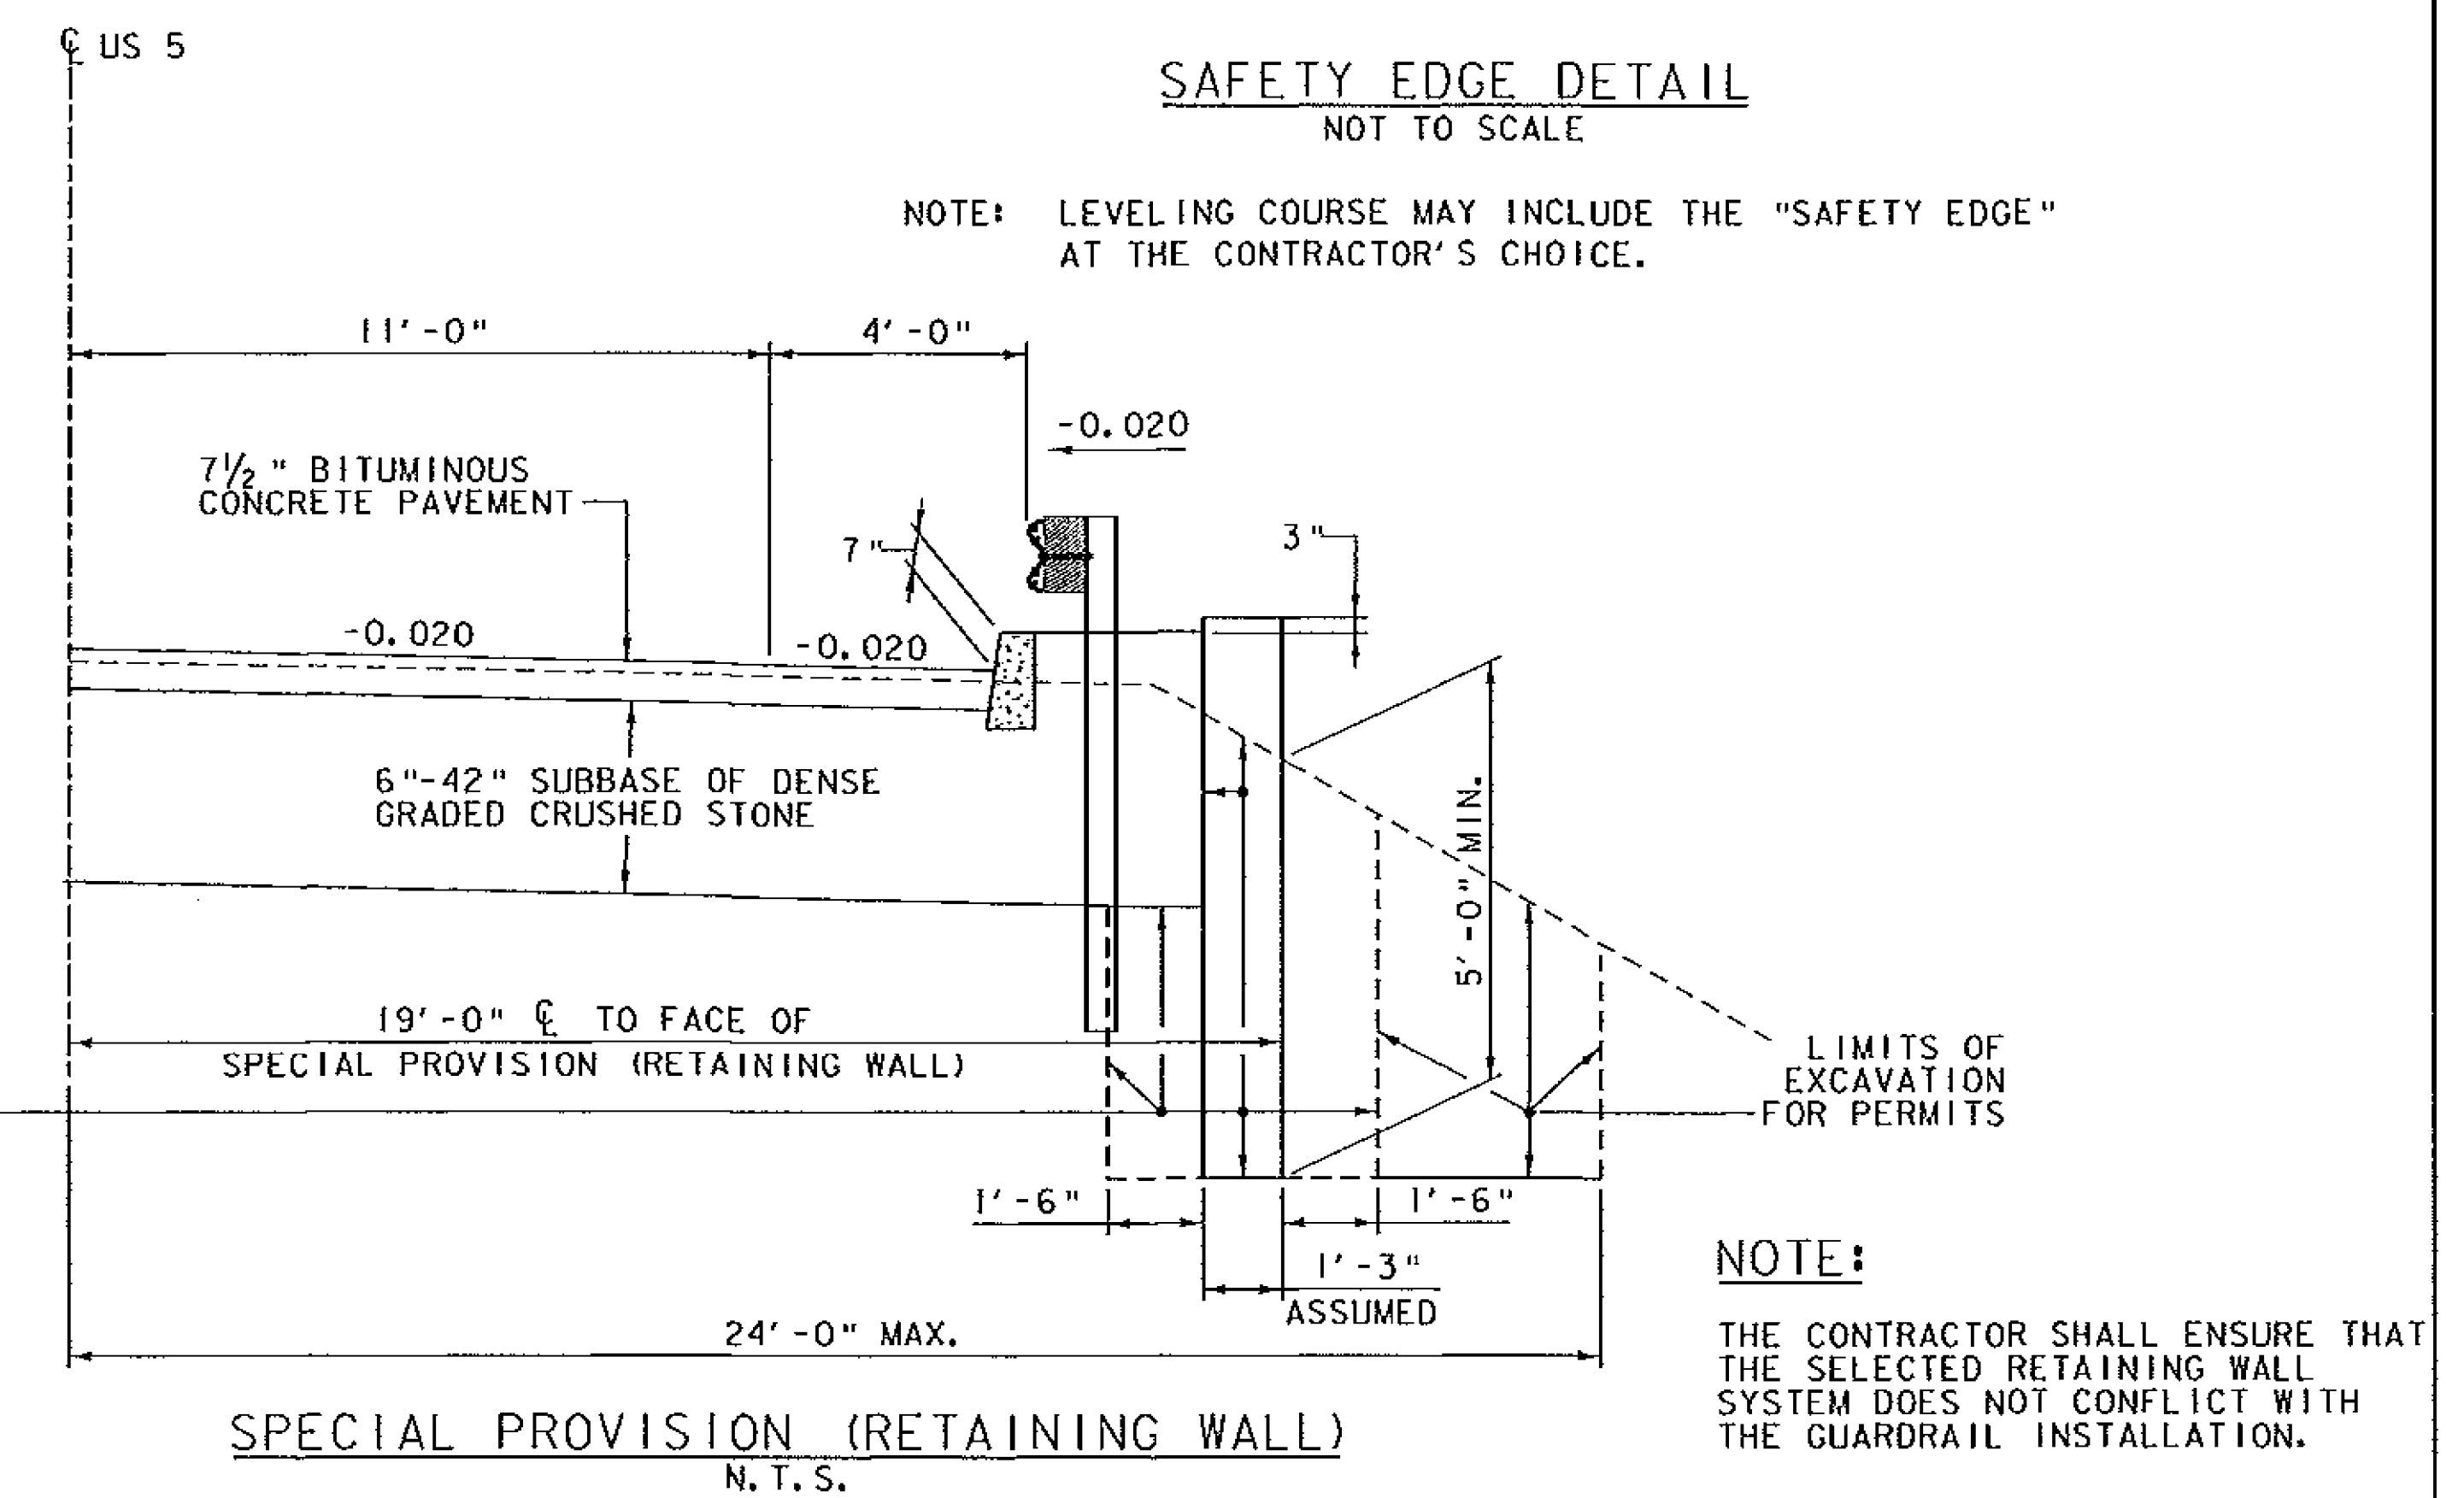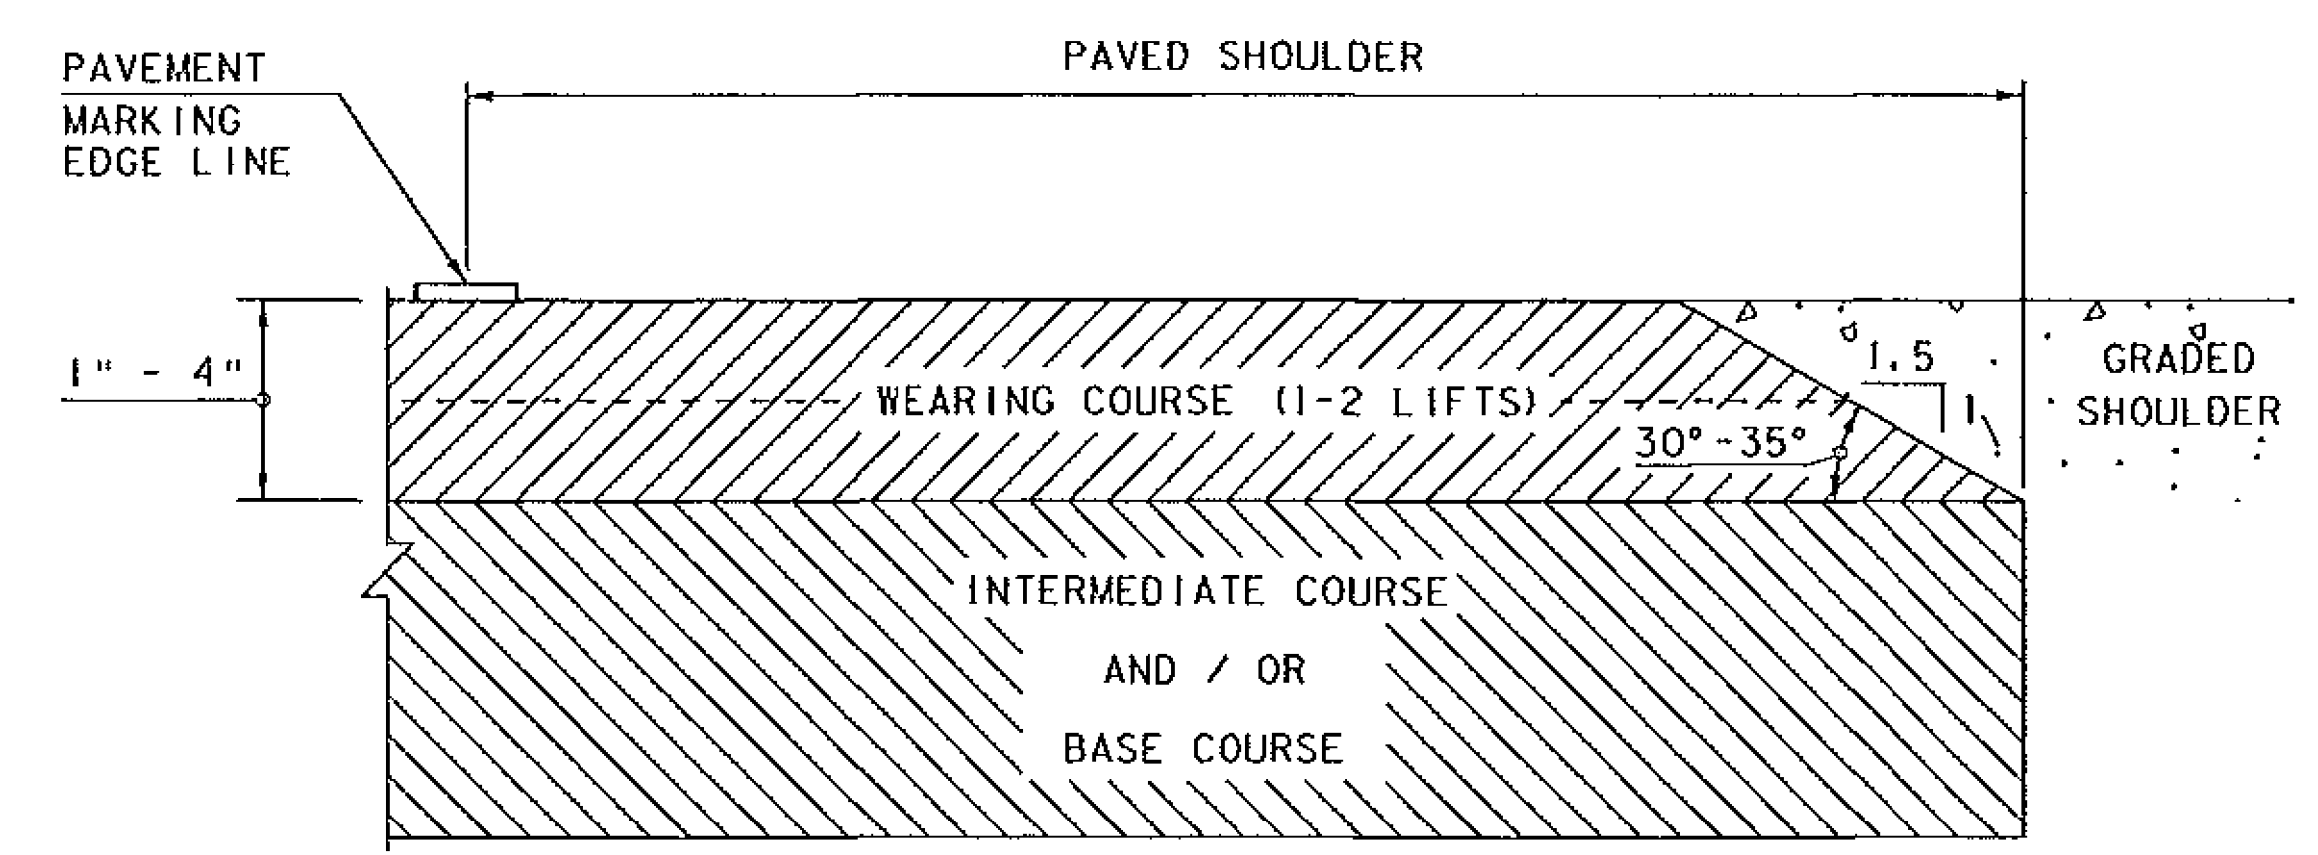

SPECIAL PROVISION (RETAINING WALL)
 N. T. S.

REV.	DESCRIPTION	DATE
△	REMOVED THE WORD "SHOULDER"	3/3/2014



PROJECT NAME: HARTLAND	PLOT DATE: 3/3/2014
PROJECT NUMBER: BHF BPNT(I2)	DRAWN BY: A.J. GOUDREAU
FILE NAME: zllc260+yp.dgn	CHECKED BY: S.G. FARNSWORTH
PROJECT LEADER: M.A. COLGAN	SHEET 4 OF 55
DESIGNED BY: S.G. FARNSWORTH	
BR 62A TYPICAL ROADWAY SECTIONS	

PROJECT NOTES

GENERAL

- ALL MATERIALS AND CONSTRUCTION SHALL CONFORM TO STATE OF VERMONT, AGENCY OF TRANSPORTATION 2011 STANDARD SPECIFICATIONS FOR CONSTRUCTION, DATED 2011, AND ITS LATEST REVISIONS AND THE AASHTO LRFD BRIDGE DESIGN SPECIFICATION, 6TH EDITION AND ITS LATEST REVISIONS.
- ALL DIMENSIONS ARE HORIZONTAL OR VERTICAL, AND ARE GIVEN AT 68 DEGREES FAHRENHEIT, UNLESS NOTED OTHERWISE.
- MAINTAIN EXISTING MINIMUM VERTICAL CLEARANCE.
- IT SHALL BE THE RESPONSIBILITY OF THE CONTRACTOR TO DOCUMENT THE CONDITION OF ALL STRUCTURES THAT HAVE THE POTENTIAL FOR DAMAGE FROM CONSTRUCTION ACTIVITIES. THIS DOCUMENTATION SHALL BE IN THE FORM OF VIDEO OR PICTURES, WITH SUFFICIENT DESCRIPTION, AND SHALL BE SUPPLIED TO THE ENGINEER PRIOR TO ANY EXCAVATION OR DRIVING OF SHEET PILING. THE COST OF PREPARING THIS DOCUMENTATION WILL NOT BE PAID FOR DIRECTLY, BUT SHALL BE CONSIDERED INCIDENTAL TO ALL CONTRACT ITEMS. SEE SPECIAL PROVISIONS.
- THE BRIDGE IS DESIGNED FOR HL-93 LIVE LOAD WITH A 2.5 INCH ALLOWANCE FOR FUTURE PAVEMENT.
- ALL WORK AND ANY ASSOCIATED ACTIVITY ON THIS PROJECT SHALL BE PERFORMED WITHIN THE EXISTING RIGHT-OF-WAY LIMITS. UNLESS SHOWN OTHERWISE ON REFERENCE PLANS, THE RIGHT-OF-WAY LIMIT SHALL BE ASSUMED TO BE 3 RODS.
- STAGING AREAS OFF THE PAVEMENT SHALL UNDERGO VTRANS CONSTRUCTION STAGING REVIEW. ALL DISTURBED STAGING AREAS SHALL BE RESTORED TO THEIR ORIGINAL CONDITION. TEMPORARY STAGING AREAS OFF PAVEMENT, IF APPROVED, SHALL MEET THE REQUIREMENTS OF SECTION 105.
- THE PAYMENT FOR THE REMOVAL AND SALVAGE OF THE EXISTING BRIDGE 62A BRIDGE RAILING, POSTS, AND HARDWARE SHALL BE INCLUDED IN THE CONTRACT ITEM 529.20, "PARTIAL REMOVAL OF STRUCTURE" IN ACCORDANCE WITH THE SPECIAL PROVISIONS.

CONCRETE

- CONCRETE FOR THE DECK, CURBS AND ABUTMENTS ABOVE THE BRIDGE SEAT OR CONSTRUCTION JOINT SHALL BE ITEM 900.608, "SPECIAL PROVISION, (HIGH PERFORMANCE CONCRETE, CLASS A LOW CEMENT) (FPQ)".
- ALL OTHER SUBSTRUCTURE CONCRETE SHALL BE ITEM 501.34, "CONCRETE, HIGH PERFORMANCE CLASS B" UNLESS OTHERWISE NOTED.
- NO CONCRETE IN ABUTMENT WINGWALLS SHALL BE PLACED ABOVE THE BRIDGE SEAT ELEVATIONS UNTIL THE BEAMS HAVE BEEN PROFILED AND THE FINISHED GRADE OF THE DECK HAS BEEN DETERMINED BY THE ENGINEER.
- THE DECK IS TO BE POURED IN ONE CONTINUOUS POUR WITH A MAXIMUM DURATION OF EIGHT HOURS. IF CIRCUMSTANCES BEYOND THE CONTRACTOR'S CONTROL PREVENT THIS FROM BEING ACCOMPLISHED, A TRANSVERSE CONSTRUCTION JOINT SHALL BE USED BETWEEN ADJACENT POURS. A MINIMUM 96 HOUR DELAY BETWEEN ADJACENT POURS SHALL BE OBSERVED.
- RELATIVE TO GRADE, ALL DECK POURS SHALL BEGIN FROM THE LOW ELEVATION END AND PROCEED TOWARDS THE HIGH ELEVATION END.
- STAY-IN-PLACE CORRUGATED METAL FORMS (SIPCMF) MAY BE USED TO FORM THE UNDERSIDE OF THE CONCRETE BRIDGE DECK IN ACCORDANCE WITH SUBSECTION 501.09.
- FLEMING BRACKETS OR SIMILAR FALSE WORK SHALL BE DESIGNED BY THE CONTRACTOR AND PLACED AT A MAXIMUM SPACING OF 4'-0". THE BRACKET SHALL BEAR NEAR THE BOTTOM FLANGE AND IN NO CASE SHALL BEAR ABOVE THE BOTTOM QUARTER OF THE WEB DEPTH.
- ALL EXPOSED EDGES OF CONCRETE SHALL BE CHAMFERED 1 INCH X 1 INCH UNLESS OTHERWISE NOTED.
- ITEM 514.10, "WATER REPELLENT, SILANE", SHALL BE APPLIED TO ALL EXPOSED CONCRETE ON THE BRIDGE SUPERSTRUCTURE AND SUBSTRUCTURE EXCEPT THE UNDERSIDE OF THE DECK BETWEEN DRIP NOTCHES.
- JOINTS AND SCORE MARKS IN CONCRETE SHALL BE CONSTRUCTED AS INDICATED ON THE PLANS OR AS DIRECTED BY THE ENGINEER.

- MINIMUM COVER FOR REINFORCING STEEL SHALL BE 2" ALONG THE BACK FACES OF WALLS AGAINST EARTH, 1 1/2" ALONG THE BOTTOM SURFACE OF THE DECK AND 3" ELSEWHERE, UNLESS OTHERWISE NOTED.
- ALL REINFORCING STEEL SHALL BE DETAILED AND FABRICATED USING PROCEDURES AND TOLERANCES IN ACCORDANCE WITH APPLICABLE PUBLICATIONS OF THE CONCRETE REINFORCING STEEL INSTITUTUE (CRSI).
- ALL REINFORCEMENT IN THE DECK, CURTAIN WALLS, AND CURBS SHALL MEET THE REQUIREMENTS OF SECTION 507 FOR LEVEL II REINFORCING STEEL AND WILL BE PAID FOR UNDER CONTRACT ITEM 507.12. ALL OTHER REINFORCING STEEL SHALL MEET THE REQUIREMENTS OF SECTION 507 FOR LEVEL I EPOXY COATED REINFORCING STEEL AND WILL BE PAID FOR UNDER CONTRACT ITEM 507.11.
- REINFORCING STEEL PLACEMENT TOLERANCES SHALL BE:
SPACING +/- 1"
CLEARANCE +/- 1/4"
- CUTTING AND REPAIRING DAMAGED AREAS OF COATED REINFORCING STEEL SHALL BE PERFORMED IN ACCORDANCE WITH SUBSECTION 507.04.

TRAFFIC CONTROL

- THE CONTRACTOR SHALL NOTIFY THE TOWN A MINIMUM OF TWO (2) WEEKS PRIOR TO CLOSING THE ROAD.
- FULL ACCESS TO ALL SIDE ROADS AND DRIVES WITHIN THE PROJECT LIMITS SHALL BE MAINTAINED AT ALL TIMES. THIS WORK SHALL BE CONSIDERED INCIDENTAL TO ITEM 641.10, "TRAFFIC CONTROL".
- ALL SIGNS SHALL BE IN ACCORDANCE WITH THE CURRENT EDITIONS OF THE "MANUAL ON UNIFORM TRAFFIC CONTROL DEVICES" (MUTCD) AND THE "STANDARD HIGHWAY SIGNS AND MARKINGS" BOOK (SHSM) PUBLISHED BY THE FEDERAL HIGHWAY ADMINISTRATION (FHWA).
- THE CONTRACTOR SHALL SUBMIT SITE SPECIFIC TRAFFIC CONTROL PLANS DEPICTING EACH PHASE OF THE PLANNED WORK FOR ANY WORK ON US ROUTE 5 OR FROM THE ROAD ABOVE OR RAILROAD BELOW THE BRIDGES. THE DESIGN SHALL ENSURE STATE-REGULATED WIDE LOADS CAN BE ACCOMMODATED DURING LANE CLOSURES. A MINIMUM WIDTH OF 14'-6" SHALL BE MAINTAINED BETWEEN THE FACE OF CURB AND THE TEMPORARY TRAFFIC BARRIER. TRAFFIC CONTROL PLANS SHALL BE DEVELOPED IN ACCORDANCE WITH THE 2009 M.U.T.C.D. SITE CONDITIONS MAY WARRANT ADDITIONAL CONSIDERATIONS FOR SAFETY. MINIMUM VERTICAL CLEARANCE OVER THE RAILROAD SHALL BE SHOWN ON TRAFFIC CONTROL PLAN SUBMITTALS. PLANS SHALL BE SUBMITTED IN ACCORDANCE WITH SUBSECTION 105.03 AND SHALL BE STAMPED BY A PROFESSIONAL ENGINEER LICENSED IN AN APPROPRIATE DISCIPLINE IN THE STATE OF VERMONT.
- THE TRAFFIC CONTROL PLANS SHALL SHOW ALL BIKE LANES, SIDEWALKS AND INTERSECTIONS AS APPLICABLE TO EACH BRIDGE SITE. PEDESTRIANS SHALL BE ACCOMMODATED IN ACCORDANCE WITH A.D.A. GUIDELINES.
- NIGHT WORK WILL NOT BE ALLOWED UNLESS APPROVED BY THE ENGINEER.
- UNLESS COVERED UNDER INDIVIDUAL PAY ITEMS, ALL COSTS FOR TEMPORARY TRAFFIC CONTROL DEVICES WILL BE CONSIDERED TO BE INCLUDED IN THE CONTRACT LUMP SUM PRICE FOR TRAFFIC CONTROL, ITEM 641.10.
- THE PORTABLE CHANGEABLE MESSAGE SIGNS (PCMS) SHALL BE USED 2 WEEKS IN ADVANCE OF LANE CLOSURE AS DIRECTED BY THE ENGINEER. PAYMENT SHALL BE MADE UNDER ITEM 641.15, PORTABLE CHANGEABLE MESSAGE SIGN.
- RIGHT-OF-WAY FENCE MAY HAVE TO BE REMOVED AND RESET IN ACCORDANCE WITH SECTION 620 FOR EGRESS AND INGRESS. THIS WORK SHALL BE INCIDENTAL TO TRAFFIC CONTROL, ITEM 641.10.
- ALL EQUIPMENT AND CONTAINMENT FACILITIES SHALL BE PROTECTED BY A CONCRETE BARRIER OVERNIGHT AND DURING NON-WORKING HOURS. PERMANENT LANE CLOSURES SHALL UTILIZE TEMPORARY TRAFFIC BARRIER AND SHALL BE INDICATED IN THE SITE SPECIFIC TRAFFIC CONTROL PLANS. ALSO SEE SUBSECTION 621.07 FOR ADDITIONAL REQUIREMENTS.

RAILROAD – BRIDGES 62A AND 66

- BRIDGE LOCATIONS IN REFERENCE TO THE ROXBURY SUB-DIVISION OF THE NECR.

US 5 BRIDGE NO.	ROXBURY MILE POST
62A	Br 7.16
66	Br 9.29

- SEE THE RAILROAD SPECIAL PROVISIONS FOR ADDITIONAL INFORMATION AND REQUIREMENTS.

UTILITIES

- REFER TO UTILITIES SPECIAL PROVISIONS.

EXISTING STEEL BEAMS AND CONCRETE

- ITEM 529.20 PARTIAL REMOVAL OF STRUCTURE (US 5 BR 62A) SHALL BE USED FOR REMOVAL OF THE EXISTING SUPERSTRUCTURE INCLUDING BRIDGE RAIL COMPONENTS, CONCRETE DECK, CURBS, AND CURTAIN WALLS. THIS WORK SHALL INCLUDE THE REMOVAL OF THE EXISTING CONCRETE WINGWALLS AND THE EXISTING SPIRAL AND/OR STUD SHEAR CONNECTORS TO 1/4" ABOVE THE EXISTING STEEL BEAMS. REMOVAL AND DISPOSAL OF BRIDGE PAVEMENT WILL BE PAID FOR SEPARATELY UNDER CONTRACT ITEM 529.10.
- ITEM 529.20 PARTIAL REMOVAL OF STRUCTURE (US5 BR 66) SHALL BE USED FOR THE REMOVAL OF THE EXISTING BLAST PROTECTION MATERIAL FROM THE INTERIOR BEAMS AND DIAPHRAGMS OF SPAN NO. 2 AND SHALL BE PROPERLY DISPOSED OF. THE CONCRETE TYPE MATERIAL WITH WIRE MESH WHICH ENCASES MORE THAN TWO-THIRDS OF THE INTERIOR BEAMS LENGTH AND DIAPHRAGMS HAS BEEN TESTED AND DOES NOT CONTAIN ASBESTOS.
- THE CONTRACTOR SHALL TAKE CARE AS TO NOT DAMAGE THE EXISTING STEEL BEAMS WHILE REMOVING THE CONCRETE AND SPIRAL AND/OR STUD SHEAR CONNECTORS.
- ITEM 900.645 SPECIAL PROVISION (PUBLIC PROTECTION FOR BRIDGE PROJECTS) SHALL BE USED TO PROVIDE A TEMPORARY PROTECTION SYSTEM TO BRIDGE 62A TO PREVENT CONCRETE AND REINFORCING STEEL FROM FALLING ONTO THE TRACKS AND EMBANKMENTS UNDER THE BRIDGE.

BRIDGE 66 DRAIN TROUGH

- THE CONTRACTOR SHALL PROVIDE AND ERECT STAGING AND/OR LADDERS SO THAT THE ENGINEER CAN INSPECT THE EXISTING DRAIN TROUGHS AT THE PIERS. PAYMENT FOR THIS WORK SHALL BE INCIDENTAL TO ITEM 900.640, "SPECIAL PROVISION (REMOVE AND RESTORE DRAIN TROUGH)".
- ITEM 900.640, "SPECIAL PROVISION (REMOVE AND REPLACE DRAIN TROUGH) SHALL INCLUDE ALL INCIDENTAL WORK AND MATERIALS FOR THE REMOVAL OF EXISTING DRAIN TROUGH AND REPLACING IT AS DETAILED IN THE PLANS.
- ITEM 900.640, "SPECIAL PROVISION (REMOVE AND RESTORE DRAIN TROUGH) SHALL INCLUDE ALL INCIDENTAL WORK FOR THE REMOVAL OF THE EXISTING DRAIN TROUGH, SALVAGING THE MATERIALS AND RESTORING THE DRAINAGE TROUGH. THE COST FOR ANY NEW CRADLES, DRAIN TROUGH SUPPORTS, AND APRON FABRIC AT THE FASCIA AS DETAILED IN THE PLANS SHALL BE INCIDENTAL TO THIS ITEM.

PROJECT NAME: HARTLAND
PROJECT NUMBER: BHF BPNT (I2)

FILE NAME: zllc260pn.dgn PLOT DATE: 1/3/2014
PROJECT LEADER: M.A. COLGAN DRAWN BY: M.C. SCOTT
DESIGNED BY: S. FARNSWORTH CHECKED BY: S. FARNSWORTH
PROJECT NOTES (I OF 2) SHEET 5 OF 55

BRIDGE PAINTING NOTES

GENERAL

1. PRIOR TO PAINTING BRIDGE 66, THE EXISTING BLAST PROTECTION OF THE INTERIOR BEAMS AND DIAPHRAGM OF SPAN NO. 2 SHALL BE REMOVED AND PROPERLY DISPOSED OF. SEE EXISTING STEEL BEAMS AND CONCRETE NOTES ON PREVIOUS SHEET.
2. ALL COSTS ASSOCIATED WITH EXTENDING OR FILLING THE DRAIN TUBES ON BRIDGE 66 SHALL BE INCIDENTAL TO ITEM 900.645, SPECIAL PROVISION (QC/QA CLEAN AND PAINT EXISTING STEEL STRUCTURES, BARE STEEL).
3. THE CONTRACTOR SHALL NOT DRILL OR DOWEL INTO THE PIERS FOR CONTAINMENT SUPPORT OR ANY OTHER WORK.
4. EXISTING GREASE PAINT REMOVAL SHALL BE PAID AS ITEM 900.645, SPECIAL PROVISION (QC/QA CLEAN AND PAINT EXISTING STEEL STRUCTURES, BARE STEEL).
5. EXISTING MINIMUM VERTICAL CLEARANCE UNDER BRIDGES (FROM VTRANS BRIDGE INSPECTION REPORTS DATED MAY 2011):


BRIDGE NO.	CLEARANCE
62A	22'-3"
66	19'-2"

PROTECTIVE COATINGS

1. THE SURFACE PREPARATION OF THE EXISTING STEEL ON BRIDGES 62A AND 66 SHALL INCLUDE 100% REMOVAL OF THE EXISTING PAINT SYSTEM.
2. THE COLOR OF THE FINAL COAT OF PAINT SHALL BE BROWN CONFORMING TO SUBSECTION 708.03.
3. TWO INTERMEDIATE COATS OF PAINT SHALL BE APPLIED TO ALL BEAMS AND DIAPHRAGMS IN ACCORDANCE WITH ITEM 900.645, SPECIAL PROVISION (QC/QA CLEAN AND PAINT EXISTING STEEL STRUCTURES, BARE STEEL), WITHIN 20 FEET OF EACH ABUTMENT (FIXED AND EXPANSION JOINTS); AND AT PIERS FROM BEAM END TO A LENGTH EQUAL TO TWO TIMES THE BEAM DEPTH FROM POINT OF BEARING AND SHALL INCLUDE ALL EXPOSED SURFACE AREAS OF ATTACHMENTS OR MEMBERS WITHIN THIS DISTANCE. COST SHALL BE INCIDENTAL TO ITEM 900.645, SPECIAL PROVISION (QC/QA CLEAN AND PAINT EXISTING STEEL STRUCTURES, BARE STEEL).
4. CLEANING AND PAINTING OF ANY DOWNSPOUTS AND/OR ANY STEEL CONNECTORS FOR DRAIN TROUGHS SHALL BE INCLUDED AS PART OF THE WORK.

NIGHT WORK

1. NIGHT WORK WILL NOT BE ALLOWED AT BRIDGE 66 BETWEEN THE HOURS OF 9:00 PM AND 7:00 AM.

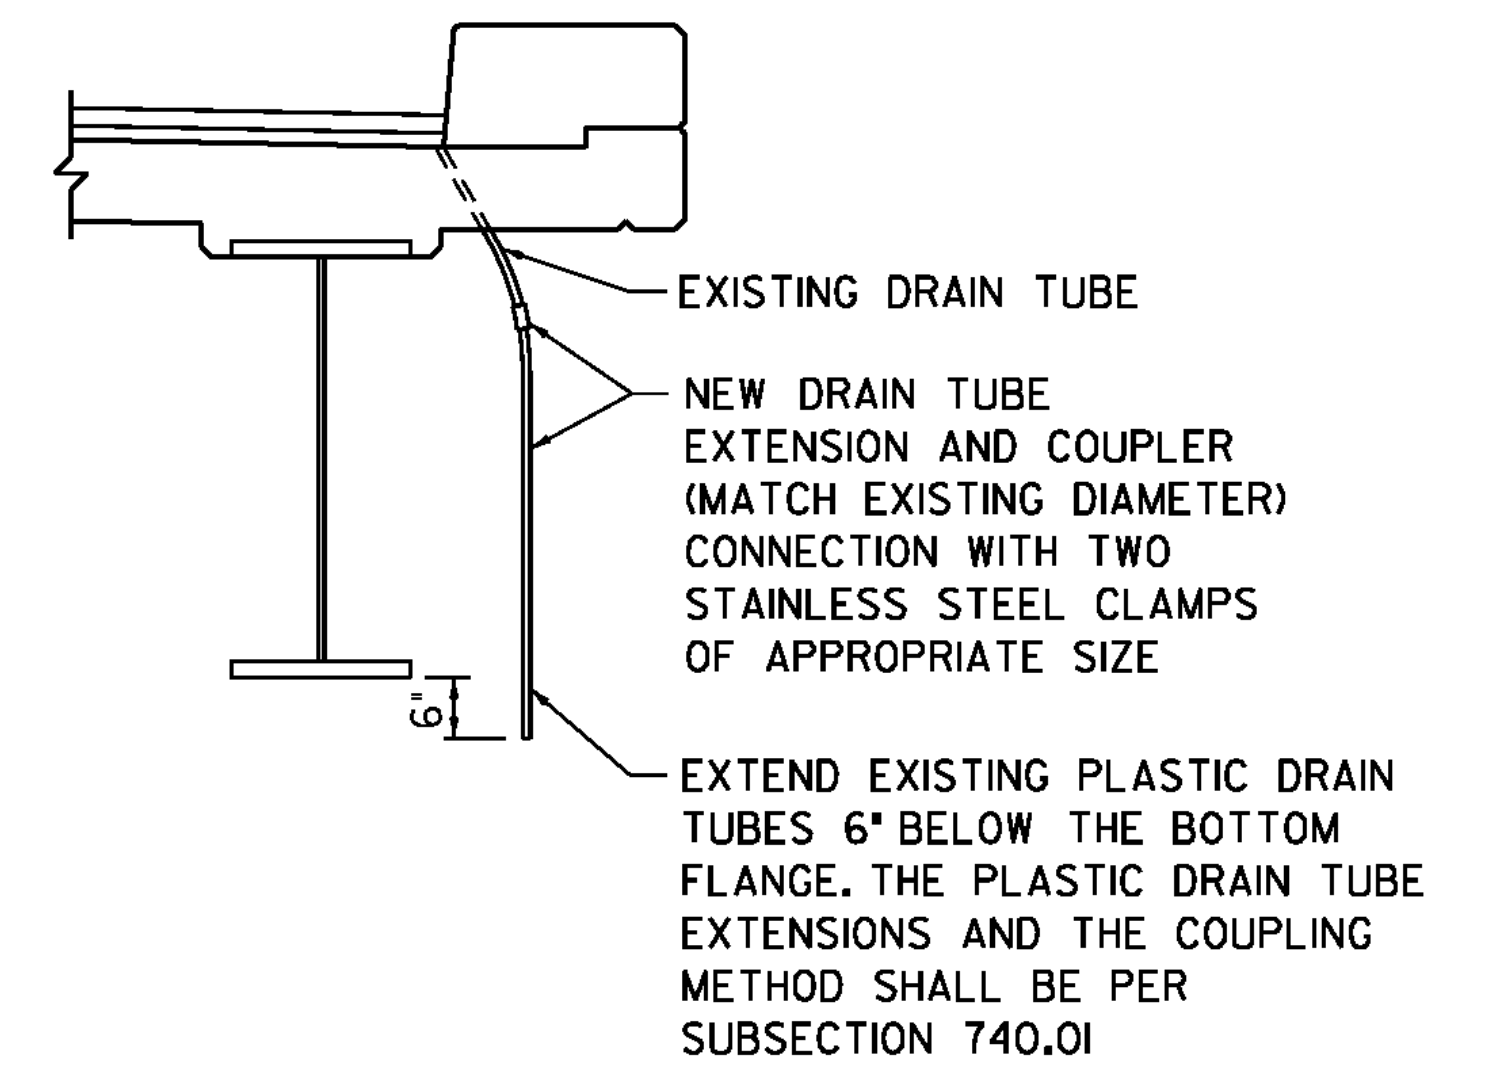

NOTES:

1. DRAIN TUBE EXTENSION DETAIL TO BE USED WHERE THE END OF EXISTING TUBES ARE LESS THAN 6" BELOW ADJACENT BEAM OR AS DIRECTED BY THE ENGINEER.
2. IF EXISTING DRAIN TUBE IS TOO SHORT TO PROVIDE AN ADEQUATE CONNECTION, THE CONTRACTOR SHALL COMPLETELY FILL THE TUBE WITH POLYURETHANE SEALANT CONFORMING TO SUBSECTION 707.05. TUBES TO BE FILLED WITH POLYURETHANE SEALANT SHALL BE APPROVED BY THE ENGINEER PRIOR TO BEING FILLED.

DRAIN TUBE EXTENSION DETAIL

NOT TO SCALE

PROJECT NAME: HARTLAND
PROJECT NUMBER: BHF BPNT (I2)

FILE NAME: zllc260pn.dgn
PROJECT LEADER: M.A. COLGAN
DESIGNED BY: S. FARNSWORTH
PROJECT NOTES (2 OF 2)

PLOT DATE: 1/2/2014
DRAWN BY: M.C. SCOTT
CHECKED BY: S. FARNSWORTH
SHEET 6 OF 55

QUANTITY SHEET 1

SUMMARY OF ESTIMATED QUANTITIES										TOTALS		DESCRIPTIONS			DETAILED SUMMARY OF QUANTITIES		
	ROADWAY (BRIDGE 62A)	TRAINING	EROSION CONTROL (BRIDGE 62A)	BRIDGE (BRIDGE 62A)	FULL C.E. ITEMS	ROADWAY (BRIDGE 66)	BRIDGE (BRIDGE 66)	GRAND TOTAL	FINAL	UNIT	ITEMS	ITEM NUMBER	ROUND	QUANTITIES	UNIT	ITEMS	
	460							460		CY	COMMON EXCAVATION	203.15					
	1							1		CY	TRENCH EXCAVATION OF EARTH, EXPLORATORY (N.A.B.I.)	204.22		460 CY		COMMON EXCAVATION (460 CY*1.00)	
				200				200		CY	STRUCTURE EXCAVATION	204.25		150 CY		STRUCTURE EXCAVATION (200 CY*0.75)	
				120				120		CY	GRANULAR BACKFILL FOR STRUCTURES	204.30		610 CY		SUBTOTAL	
	660							660		SY	COLD PLANING, BITUMINOUS PAVEMENT	210.10		0 CY		ROUNDING	
	420							420		CY	SUBBASE OF DENSE GRADED CRUSHED STONE	301.35		610 CY		TOTAL	
	2							2		CWT	EMULSIFIED ASPHALT	404.65		610 CY		FILL AVAILABLE	
	1							1		LU	PRICE ADJUSTMENT, ASPHALT CEMENT (N.A.B.I.)	406.50		0 CY		FILL REQUIRED	
				90				90		CY	CONCRETE, HIGH PERFORMANCE CLASS B	501.34		0 CY		BORROW	
				6100				6100		LB	REINFORCING STEEL, LEVEL I	507.11		610 CY		WASTE	
				20000				20000		LB	REINFORCING STEEL, LEVEL II	507.12					
				39				39		LF	DRILLING AND GROUTING DOWELS	507.16					
				1				1		LS	SHEAR CONNECTORS (980 - 7/8"x7")	508.15					
				15				15		GAL	WATER REPELLENT, SILANE	514.10					
				82				82		LF	BRIDGE EXPANSION JOINT, ASPHALTIC PLUG	516.10					
				279				279		LF	BRIDGE RAILING, GALVANIZED 2 RAIL BOX BEAM	525.33					
				318				318		SY	REMOVAL OF BRIDGE PAVEMENT	529.10					
				1				1		EACH	PARTIAL REMOVAL OF STRUCTURE (US5-BR. NO. 62A)	529.20					
							1	1		EACH	PARTIAL REMOVAL OF STRUCTURE (US5-BR. NO. 66)	529.20					
	6							6		LF	12" CPEP	601.0905					
	1							1		EACH	PRECAST REINFORCED CONCRETE CURB DI WITH CAST IRON GRATE	604.30					
	2880					720		3600		HR	TRUCK-MOUNTED ATTENUATOR	608.45					
			3					3		CY	STONE FILL, TYPE I	613.10	EST				
	200							200		LF	CAST-IN-PLACE CONCRETE CURB, TYPE B	616.28					
	40							40		LF	REMOVING AND RESETTING FENCE	620.50					
				112				112		LF	SNOW BARRIER	620.75					
	125							125		LF	STEEL BEAM GUARDRAIL, GALVANIZED W/8 FEET POSTS	621.205					
	1							1		EACH	MANUFACTURED TERMINAL SECTION, FLARED	621.50					
	1							1		EACH	ANCHOR FOR STEEL BEAM RAIL	621.60					
	4							4		EACH	GUARDRAIL APPROACH SECTION, GALVANIZED 2 RAIL BOX BEAM	621.72					
	350							350		LF	REMOVAL AND DISPOSAL OF GUARDRAIL	621.80					
				950			320	1270		LF	TEMPORARY TRAFFIC BARRIER	621.90					
				430				430		LF	REMOVE AND RESET TEMPORARY TRAFFIC BARRIER	621.95					
	150					150		300		HR	UNIFORMED TRAFFIC OFFICERS	630.10					
	800					400		1200		HR	FLAGGERS	630.15					
					1			1		LS	FIELD OFFICE, ENGINEERS	631.10					
					1			1		LS	TESTING EQUIPMENT, CONCRETE	631.16					
					1			1		LS	TESTING EQUIPMENT, BITUMINOUS	631.17					
					3000			3000		DL	FIELD OFFICE TELEPHONE (N.A.B.I.)	631.26					
		520						520		HR	EMPLOYEE TRAINEESHIP	634.10					

PROJECT NAME:	HARTLAND
PROJECT NUMBER:	BHF BPNT (12)
FILE NAME:	z11c260qs.dgn
PROJECT LEADER:	MA. COLGAN
DESIGNED BY:	S.G. FARNSWORTH
QUANTITY SHEET #1	
PLOT DATE:	01/06/2014
DRAWN BY:	E.A. KIALA
CHECKED BY:	S.G. FARNSWORTH
SHEET	7 OF 55



QUANTITY SHEET 1

SUMMARY OF ESTIMATED QUANTITIES										TOTALS		DESCRIPTIONS				DETAILED SUMMARY OF QUANTITIES		
			ROADWAY (BRIDGE 62A)	TRAINING	EROSION CONTROL (BRIDGE 62A)	BRIDGE (BRIDGE 62A)	FULL C.E. ITEMS	ROADWAY (BRIDGE 66)	BRIDGE (BRIDGE 66)	GRAND TOTAL	FNAL	UNIT	ITEMS	ITEM NUMBER	ROUND	QUANTITIES	UNIT	ITEMS
			460							460		CY	COMMON EXCAVATION	203.15				
			1							1		CY	TRENCH EXCAVATION OF EARTH, EXPLORATORY (N.A.B.I.)	204.22		460	CY	COMMON EXCAVATION (460 CY*1.00)
						200				200		CY	STRUCTURE EXCAVATION	204.25		150	CY	STRUCTURE EXCAVATION (200 CY*0.75)
						120				120		CY	GRANULAR BACKFILL FOR STRUCTURES	204.30		610	CY	SUBTOTAL
			660							660		SY	COLD PLANING, BITUMINOUS PAVEMENT	210.10		0	CY	ROUNDING
			420							420		CY	SUBBASE OF DENSE GRADED CRUSHED STONE	301.35		610	CY	TOTAL
			2							2		CWT	EMULSIFIED ASPHALT	404.65		610	CY	FILL AVAILABLE
			1							1		LU	PRICE ADJUSTMENT, ASPHALT CEMENT (N.A.B.I.)	406.50		0	CY	FILL REQUIRED
						90				90		CY	CONCRETE, HIGH PERFORMANCE CLASS B	501.34		0	CY	BORROW
						6320				6320		LB	REINFORCING STEEL, LEVEL I	507.11		610	CY	WASTE
						25400				25400		LB	REINFORCING STEEL, LEVEL II	507.12				
						39				39		LF	DRILLING AND GROUTING DOVELS	507.16				
						1				1		LS	SHEAR CONNECTORS (880 - 7/8"x7")	508.15				
						15				15		GAL	WATER REPELLENT, SILANE	514.10				
						82				82		LF	BRIDGE EXPANSION JOINT, ASPHALTIC PLUG	518.10				
						279				279		LF	BRIDGE RAILING, GALVANIZED 2 RAIL BOX BEAM	525.33				
						318				318		SY	REMOVAL OF BRIDGE PAVEMENT	529.10				
						1				1		EACH	PARTIAL REMOVAL OF STRUCTURE (US5-BR. NO. 62A)	529.20				
									1	1		EACH	PARTIAL REMOVAL OF STRUCTURE (US5-BR. NO. 66)	529.20				
			6							6		LF	12" CPEP	601.0905				
			1							1		EACH	PRECAST REINFORCED CONCRETE CURB DI WITH CAST IRON GRATE	604.30				
			2880					720		3600		HR	TRUCK-MOUNTED ATTENUATOR	608.45				
					3					3		CY	STONE FILL, TYPE I	613.10	EST			
			200							200		LF	CAST-IN-PLACE CONCRETE CURB, TYPE B	616.28				
			40							40		LF	REMOVING AND RESETTING FENCE	620.50				
						112				112		LF	SNOWBARRIER	620.75				
			125							125		LF	STEEL BEAM GUARDRAIL, GALVANIZED W/8 FEET POSTS	621.205				
			1							1		EACH	MANUFACTURED TERMINAL SECTION, FLARED	621.50				
			1							1		EACH	ANCHOR FOR STEEL BEAM RAIL	621.60				
			4							4		EACH	GUARDRAIL APPROACH SECTION, GALVANIZED 2 RAIL BOX BEAM	621.72				
			350							350		LF	REMOVAL AND DISPOSAL OF GUARDRAIL	621.80				
						950			320	1270		LF	TEMPORARY TRAFFIC BARRIER	621.90				
						430				430		LF	REMOVE AND RESET TEMPORARY TRAFFIC BARRIER	621.95				
			150					150		300		HR	UNIFORMED TRAFFIC OFFICERS	630.10				
			800					400		1200		HR	FLAGGERS	630.15				
							1			1		LS	FIELD OFFICE, ENGINEERS	631.10				
							1			1		LS	TESTING EQUIPMENT, CONCRETE	631.16				
							1			1		LS	TESTING EQUIPMENT, BITUMINOUS	631.17				
							3000			3000		DL	FIELD OFFICE TELEPHONE (N.A.B.I.)	631.26				
			520							520		HR	EMPLOYEE TRAINESHIP	634.10				

DELETE ITEM 621.60 FROM CONTRACT.

REV	DESCRIPTION	DATE
Δ	DELETED ITEM OR INCREASED QUANTITY	3-3-2014

PROJECT NAME: HARTLAND
 PROJECT NUMBER: BHF BPNT (12)
 FILE NAME: z11c260qs.dgn
 PROJECT LEADER: W.A. COLGAN
 DESIGNED BY: S.G. FARNSWORTH
 QUANTITY SHEET 41
 PLOT DATE: 02/28/2014
 DRAWN BY: E.A. FIALA
 CHECKED BY: S.G. FARNSWORTH
 SHEET 7 OF 55



QUANTITY SHEET 2

SUMMARY OF ESTIMATED QUANTITIES										TOTALS		DESCRIPTIONS				DETAILED SUMMARY OF QUANTITIES		
			ROADWAY (BRIDGE 62A)	TRAINING	EROSION CONTROL (BRIDGE 62A)	BRIDGE (BRIDGE 62A)	FULL C.E. ITEMS	ROADWAY (BRIDGE 66)	BRIDGE (BRIDGE 66)	GRAND TOTAL	FINAL	UNIT	ITEMS	ITEM NUMBER	ROUND	QUANTITIES	UNIT	ITEMS
			0.5					0.5		1		LS	MOBILIZATION/DEMOBILIZATION	635.11				SPECIAL PROVISION (BITUMINOUS CONCRETE PAVEMENT, SMALL QUANTITY)
			1							1		LS	TRAFFIC CONTROL (US5-BR. NO. 62A)	641.10		197	TON	TYPE IIS
								1		1		LS	TRAFFIC CONTROL (US5-BR. NO. 66)	641.10		98	TON	TYPE IVS
			3					3		6		EACH	PORTABLE CHANGEABLE MESSAGE SIGN	641.15		295	TON	SUBTOTAL
			650							650		LF	4 INCH WHITE LINE	646.20		5	TON	ROUND
			650							650		LF	4 INCH YELLOW LINE	646.21		300	TON	TOTAL
			800					500		1300		LF	TEMPORARY 4 INCH WHITE LINE, TYPE II TAPE	646.601				
			800					500		1300		LF	TEMPORARY 4 INCH YELLOW LINE, TYPE II TAPE	646.611				
			433							433		SF	PAVEMENT MARKING MASK	646.86				
					310					310		SY	GEOTEXTILE FOR SILT FENCE	649.51				
					10					10		LB	SEED	651.15				
					70					70		LB	FERTILIZER	651.18				
					0.3					0.3		TON	AGRICULTURAL LIMESTONE	651.20				
					0.3					0.3		TON	HAY MULCH	651.25				
					1					1		LS	EPSC PLAN	652.10				
					30					30		HR	MONITORING EPSC PLAN	652.20				
					1					1		LU	MAINTENANCE OF EPSC PLAN (N.A.B.I.)	652.30				
					175					175		SY	TEMPORARY EROSION MATTING	653.20				
					15					15		CY	VEHICLE TRACKING PAD	653.35				
					460					460		LF	PROJECT DEMARCATION FENCE	653.55				
			1							1		SF	TRAFFIC SIGNS, TYPE A	675.20				
			14							14		LF	SQUARE TUBE SIGN POST AND ANCHOR	675.341				
						115				115		CY	SPECIAL PROVISION (HIGH PERFORMANCE CONCRETE, CLASS A LOWCEMENT) (FPQ)	900.608				
			1					1		2		EACH	SPECIAL PROVISION (TEMPORARY TRAFFIC SIGNAL SYSTEM, PORTABLE)	900.620				
									82	82		LF	SPECIAL PROVISION (REMOVE AND REPLACE DRAIN TROUGH)	900.640				
									82	82		LF	SPECIAL PROVISION (REMOVE AND RESTORE DRAIN TROUGH)	900.640				
									1	1		LS	SPECIAL PROVISION (CONTAINMENT AND DISPOSAL OF LEAD PAINT CLEANING RESIDUES) (US5-BR. NO. 66)	900.645				
						1				1		LS	SPECIAL PROVISION (CONTAINMENT AND DISPOSAL OF LEAD PAINT CLEANING RESIDUES) (US5-BR. NO. 62A)	900.645				
			1							1		LS	SPECIAL PROVISION (PUBLIC PROTECTION FOR BRIDGE PROJECTS)	900.645				
						1				1		LS	SPECIAL PROVISION (QC/QA CLEAN AND PAINT EXISTING STEEL STRUCTURES, BARE STEEL) (US5-BR. NO. 62A)	900.645				
									1	1		LS	SPECIAL PROVISION (QC/QA CLEAN AND PAINT EXISTING STEEL STRUCTURES, BARE STEEL) (US5-BR. NO. 66)	900.645				
						1				1		LU	SPECIAL PROVISION (INCENTIVE/DISINCENTIVE) (N.A.B.I.)	900.650				
						1			1	2		LU	SPECIAL PROVISION (MAINTENANCE OF RAILROAD TRAFFIC) (N.A.B.I.)	900.650				
			1							1		LU	SPECIAL PROVISION (MAT DENSITY PAY ADJUSTMENT, SMALL QUANTITY) (N.A.B.I.)	900.650				
			1							1		LU	SPECIAL PROVISION (MIXTURE PAY ADJUSTMENT) (N.A.B.I.)	900.650				
			215							215		SF	SPECIAL PROVISION (RETAINING WALL)	900.670				
			300							300		TON	SPECIAL PROVISION (BITUMINOUS CONCRETE PAVEMENT, SMALL QUANTITY)	900.680				

PROJECT NAME: **HARTLAND**
 PROJECT NUMBER: **BHF BPNT (12)**
 FILE NAME: z11c260qs.dgn
 PROJECT LEADER: MA. COLGAN
 DESIGNED BY: S.G. FARNSWORTH
 QUANTITY SHEET #2

PLOT DATE: 01/03/2014
 DRAWN BY: E.A. FIALA
 CHECKED BY: S.G. FARNSWORTH
 SHEET 8 OF 55



GENERAL INFORMATION

SYMBOLGY LEGEND NOTE

THE SYMBOLGY ON THIS SHEET IS INTENDED TO COVER STANDARD CONVENTIONAL SYMBOLGY. THE SYMBOLGY IS USED FOR EXISTING & PROPOSED FEATURES WITH HEAVIER LINEWEIGHT, IN COMBINATION WITH PROJECT ANNOTATION, AS NOTED ON PROJECT PLAN SHEETS. THIS LEGEND SHEET COVERS THE BASICS. SYMBOLGY ON PLANS MAY VARY, PLAN ANNOTATIONS AND NOTES SHOULD BE USED TO CLARIFY AS NEEDED.

COMMON TOPOGRAPHIC POINT SYMBOLS

POINT CODE	DESCRIPTION
⊕	APL BOUND APPARENT LOCATION
◻	BM BENCH MARK
◻	BND BOUND
◻	CB CATCH BASIN
⊕	COMB COMBINATION POLE
◻	DITHR DROP INLET THROATED DNC
⊕	EL ELECTRIC POWER POLE
◦	FPOLE FLAGPOLE
⊕	GASFIL GAS FILLER
⊕	GP GUIDE POST
⊕	GSO GAS SHUT OFF
◦	GUY GUY POLE
◦	GUYW GUY WIRE
◦	GV GATE VALUE
⊕	H TREE HARDWOOD
△	HCTRL CONTROL HORIZONTAL
△	HVCTRL CONTROL HORIZ. & VERTICAL
⊕	HYD HYDRANT
◦	IP IRON PIN
◦	IPIPE IRON PIPE
⊕	LI LIGHT - STREET OR YARD
⊕	MB MAILBOX
◦	MH MANHOLE (MH)
◻	MM MILE MARKER
◦	PM PARKING METER
◻	PMK PROJECT MARKER
◦	POST POST STONE/WOOD
⊕	RRSIG RAILROAD SIGNAL
⊕	RRSL RAILROAD SWITCH LEVER
⊕	S TREE SOFTWOOD
⊕	SAT SATELLITE DISH
⊕	SHRUB SHRUB
⊕	SIGN SIGN
⊕	STUMP STUMP
⊕	TEL TELEPHONE POLE
◦	TIE TIE
⊕	TSIGN SIGN W/DOUBLE POST
⊕	VCTRL CONTROL VERTICAL
◦	WELL WELL
⊕	WSO WATER SHUT OFF

THESE ARE COMMON VAOT SURVEY POINT SYMBOLS FOR EXISTING FEATURES, ALSO USED FOR PROPOSED FEATURES WITH HEAVIER LINEWEIGHT, IN COMBINATION WITH PROPOSED ANNOTATION.

PROPOSED GEOMETRY CODES

CODE	DESCRIPTION
PC	POINT OF CURVATURE
PI	POINT OF INTERSECTION
CC	CENTER OF CURVE
PT	POINT OF TANGENCY
PCC	POINT OF COMPOUND CURVE
PRC	POINT OF REVERSE CURVE
POB	POINT OF BEGINNING
POE	POINT OF ENDING
STA	STATION PREFIX
AH	AHEAD STATION SUFFIX
BK	BACK STATION SUFFIX
D	CURVE DEGREE OF (100FT)
R	CURVE RADIUS OF
T	CURVE TANGENT LENGTH
L	CURVE LENGTH OF
E	CURVE EXTERNAL DISTANCE

R.O.W. ABBREVIATIONS (CODES) & SYMBOLS

POINT CODE	DESCRIPTION
CH	CHANNEL EASEMENT
CONST	CONSTRUCTION EASEMENT
CUL	CULVERT EASEMENT
D&C	DISCONNECT & CONNECT
DIT	DITCH EASEMENT
DR	DRAINAGE EASEMENT
DRIVE	DRIVEWAY EASEMENT
EC	EROSION CONTROL
I&M	INSTALL & MAINTAIN EASEMENT
LAND	LANDSCAPE EASEMENT
SR	SLOPE RIGHT
UE	UTILITY EASEMENT
(P)	PERMANENT EASEMENT
(T)	TEMPORARY EASEMENT
■	BNDNS BOUND SET
◻	BNDNS BOUND TO BE SET
●	IPNS IRON PIN SET
⊕	IPNS IRON PIN TO BE SET
⊕	CALC CALCULATED ROW POINT
[DISTANCE]	DISTANCE CARRIED ON NEXT SHEET

UTILITY SYMBOLGY

UNDERGROUND UTILITIES

— UT —	TELEPHONE
— UE —	ELECTRIC
— UC —	CABLE (TV)
— UEC —	ELECTRIC+CABLE
— UET —	ELECTRIC+TELEPHONE
— UCT —	CABLE+TELEPHONE
— UECT —	ELECTRIC+CABLE+TELEP.
— G —	GAS LINE
— W —	WATER LINE
— S —	SANITARY SEWER (SEPTIC)

ABOVE GROUND UTILITIES (AERIAL)

— T —	TELEPHONE
— E —	ELECTRIC
— C —	CABLE (TV)
— EC —	ELECTRIC+CABLE
— ET —	ELECTRIC+TELEPHONE
— AER E&T —	ELECTRIC+TELEPHONE
— CT —	CABLE+TELEPHONE
— ECT —	ELECTRIC+CABLE+TELEP.
—	UTILITY POLE GUY WIRE

PROJECT CONSTRUCTION SYMBOLGY

PROJECT DESIGN & LAYOUT SYMBOLGY

— — — CZ — — —	CLEAR ZONE
— — — — —	PLAN LAYOUT MATCHLINE

PROJECT CONSTRUCTION FEATURES

— — — — —	TOP OF CUT SLOPE
— — — — —	TOE OF FILL SLOPE
⊕ ⊕ ⊕ ⊕ ⊕	STONE FILL
— — — — —	BOTTOM OF DITCH
— — — — —	CULVERT PROPOSED
— — — — —	STRUCTURE SUBSURFACE
PDF — — — PDF	PROJECT DEMARCATION FENCE
BF — — — BF	BARRIER FENCE
XXXXXXXXXXXXXXXXXXXX	TREE PROTECTION ZONE (TPZ)
//// //// //// ////	STRIPING LINE REMOVAL
~~~~ ~~~~ ~~~~ ~~~~	SHEET PILES

**CONVENTIONAL BOUNDARY SYMBOLGY**

**BOUNDARY LINES**

— — — — —	TOWN BOUNDARY LINE
— — — — —	COUNTY BOUNDARY LINE
— — — — —	STATE BOUNDARY LINE
— — — — —	PROPOSED STATE R.O.W. (LIMITED ACCESS)
— — — — —	PROPOSED STATE R.O.W.
— — — — —	STATE ROW (LIMITED ACCESS)
— — — — —	STATE ROW
— — — — —	TOWN ROW
— — — — —	PERMANENT EASEMENT LINE (P)
— — — — —	TEMPORARY EASEMENT LINE (T)
— — — — —	SURVEY LINE
— — — — —	PROPERTY LINE (P/L)
SR — — — SR	SLOPE RIGHTS
6f — — — 6f	6F PROPERTY BOUNDARY
4f — — — 4f	4F PROPERTY BOUNDARY
HAZ — — — HAZ	HAZARDOUS WASTE

**EPSC LAYOUT PLAN SYMBOLGY**

**EPSC MEASURES**

ONNOONNOONNO	FILTER CURTAIN
— — — — —	SILT FENCE
— — — — —	SILT FENCE WOVEN WIRE
— — — — —	CHECK DAM
— — — — —	DISTURBED AREAS REQUIRING RE-VEGETATION
— — — — —	EROSION MATTING

**ENVIRONMENTAL RESOURCES**

— — — — —	WETLAND BOUNDARY
— — — — —	RIPARIAN BUFFER ZONE
— — — — —	WETLAND BUFFER ZONE
— — — — —	SOIL TYPE BOUNDARY
— — — — —	THREATENED & ENDANGERED SPECIES
HAZ — — — HAZ	HAZARDOUS WASTE AREA
— — — — —	AGRICULTURAL LAND
HABITAT — — —	FISH & WILDLIFE HABITAT
— — — — —	FLOOD PLAIN
— — — — —	ORDINARY HIGH WATER (OHW)
— — — — —	STORM WATER
— — — — —	USDA FOREST SERVICE LANDS
— — — — —	WILDLIFE HABITAT SUIT/CONN

**ARCHEOLOGICAL & HISTORIC**

— — — — —	ARCHEOLOGICAL BOUNDARY
— — — — —	HISTORIC DISTRICT BOUNDARY
— — — — —	HISTORIC AREA
(H)	HISTORIC STRUCTURE

**CONVENTIONAL TOPOGRAPHIC SYMBOLGY**

**EXISTING FEATURES**

— — — — —	ROAD EDGE PAVEMENT
— — — — —	ROAD EDGE GRAVEL
— — — — —	DRIVEWAY EDGE
— — — — —	DITCH
— — — — —	FOUNDATION
— — — — —	FENCE (EXISTING)
— — — — —	FENCE WOOD POST
— — — — —	FENCE STEEL POST
— — — — —	GARDEN
— — — — —	ROAD GUARDRAIL
— — — — —	RAILROAD TRACKS
— — — — —	CULVERT (EXISTING)
— — — — —	STONE WALL
— — — — —	WALL
— — — — —	WOOD LINE
— — — — —	BRUSH LINE
— — — — —	HEDGE
— — — — —	BODY OF WATER EDGE
— — — — —	LEDGE EXPOSED

PROJECT NAME: HARTLAND  
PROJECT NUMBER: BHF BPNT(12)

FILE NAME: zllc260LegendSheet.dgn PLOT DATE: 12/17/2013  
PROJECT LEADER: M.A. COLGAN DRAWN BY: A.J. GOUDREAU  
DESIGNED BY: VTRANS CHECKED BY: S.E. BURBANK  
CONVENTIONAL SYMBOLGY LEGEND SHEET 9 OF 55

GPS CONTROL POINTS

HVCTRL #1

NORTH = 20000.00  
 EAST = 10000.00  
 ELEV. = 100.00




HVCTRL #2

NORTH = 19825.030  
 EAST = 9863.306  
 ELEV. = 114.457

HVCTRL #3

NORTH = 19930.980  
 EAST = 9856.446  
 ELEV. = 76.262

TRAVERSE TIES

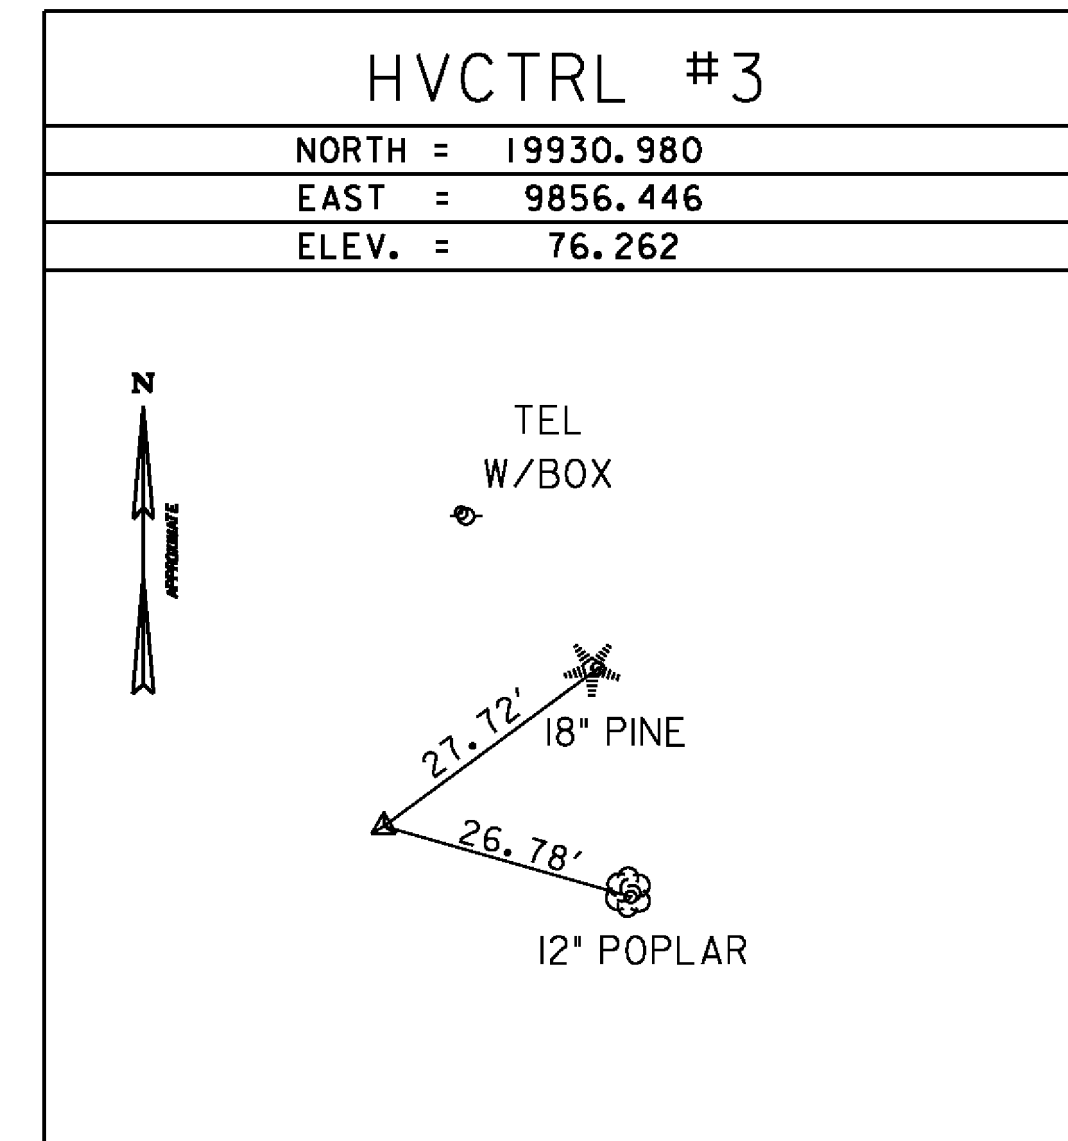
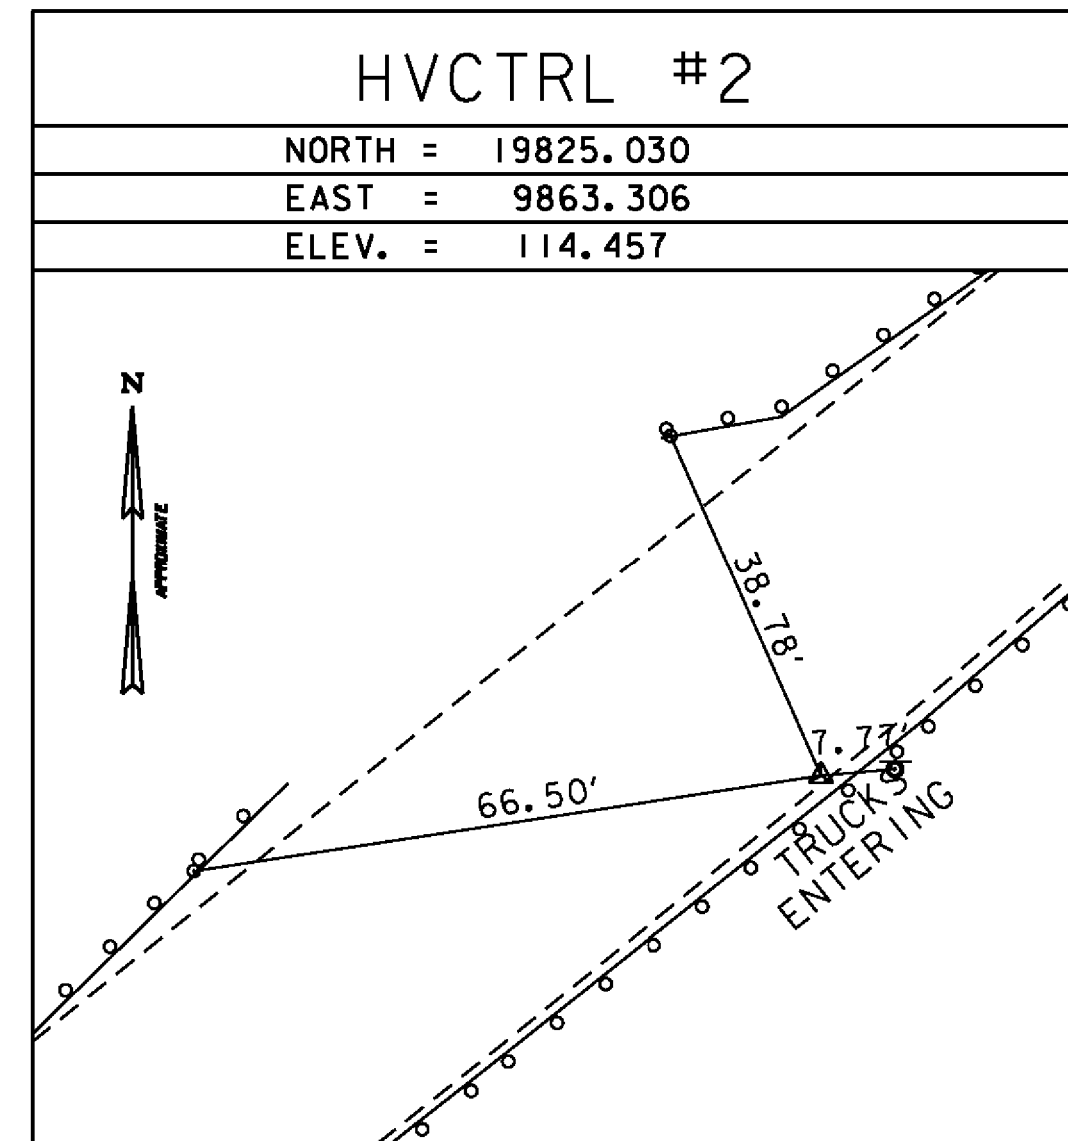
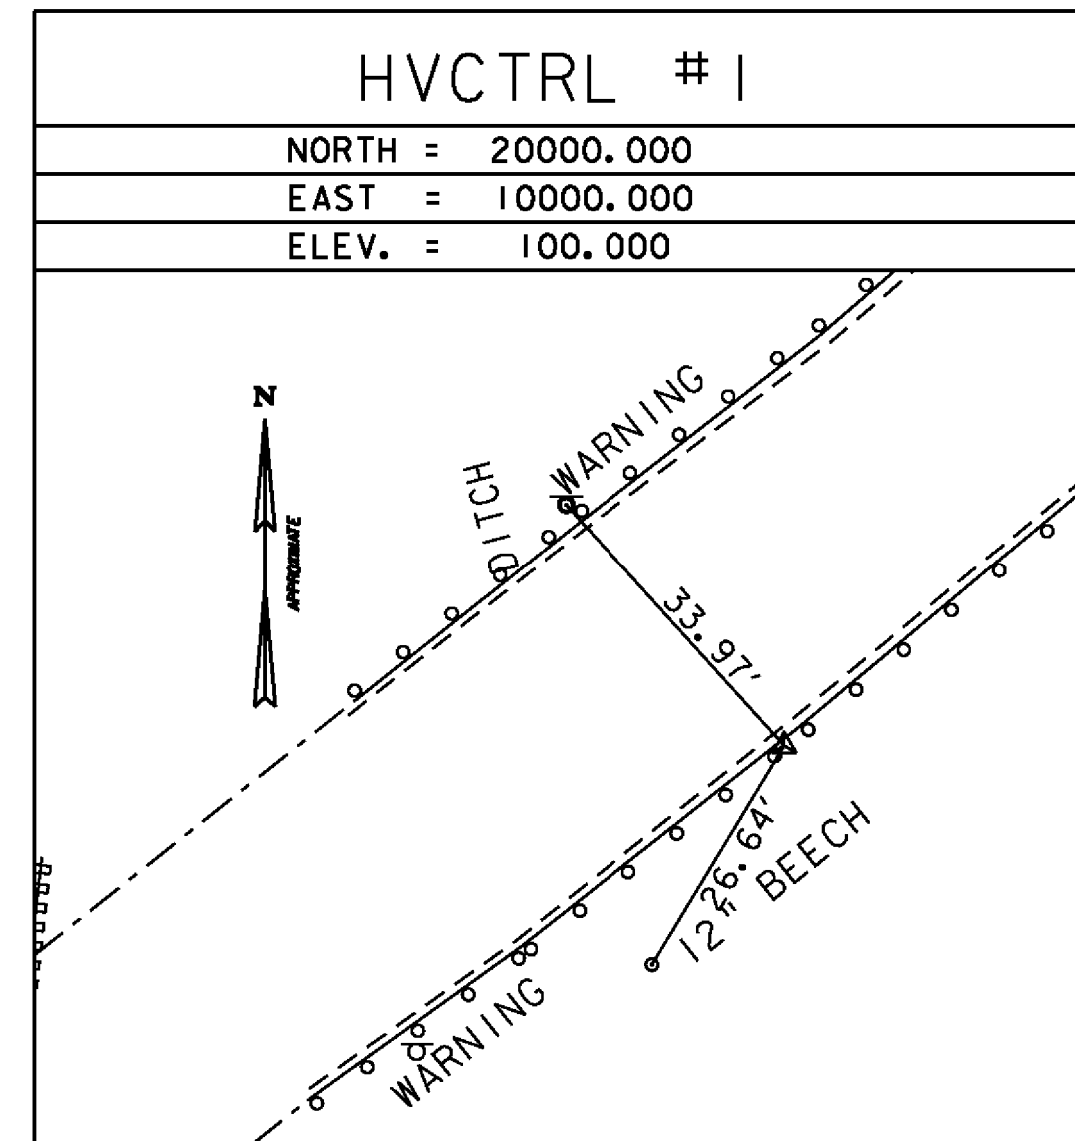


DATUM	
VERTICAL	ASSUMED
HORIZONTAL	ASSUMED
ADJUSTMENT	COMPASS




PROJECT NAME: HARTLAND	PLOT DATE: 12/17/2013
PROJECT NUMBER: BHF BPNT(12)	DRAWN BY: A.J. GOUDREAU
FILE NAME: z1lc260+1.dgn	CHECKED BY: S. FARNSWORTH
PROJECT LEADER: M.A. COLGAN	SHEET 10 OF 55
DESIGNED BY: VHB	
BR 62A TIE SHEET	



GPS CONTROL POINTS

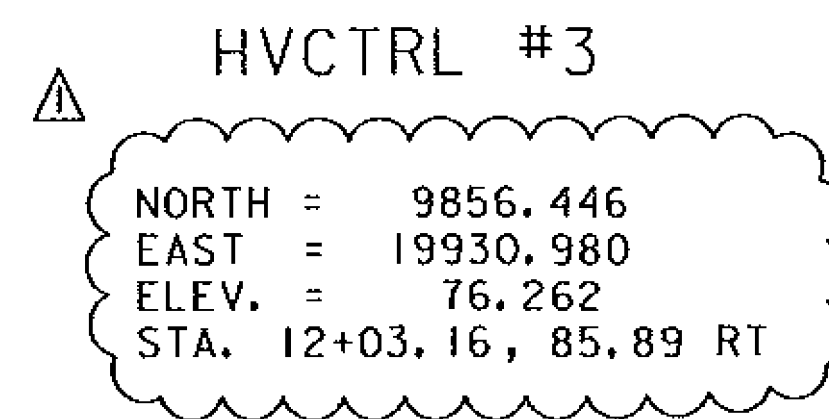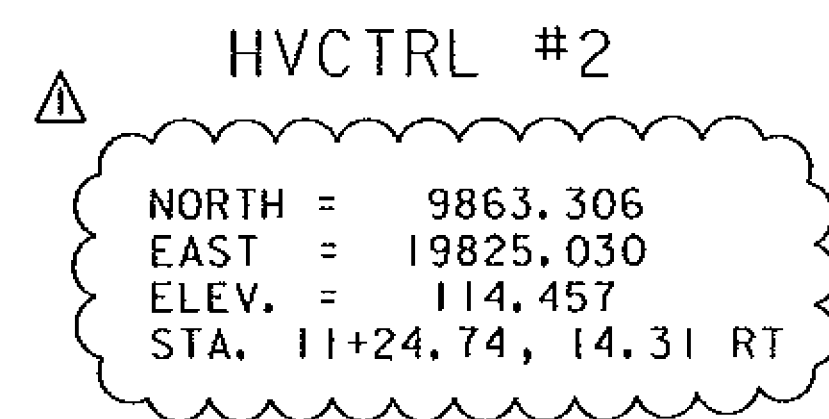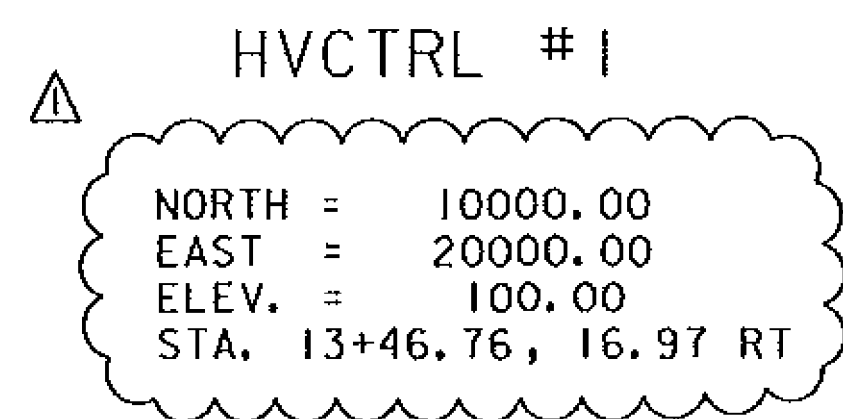

TRAVERSE TIES

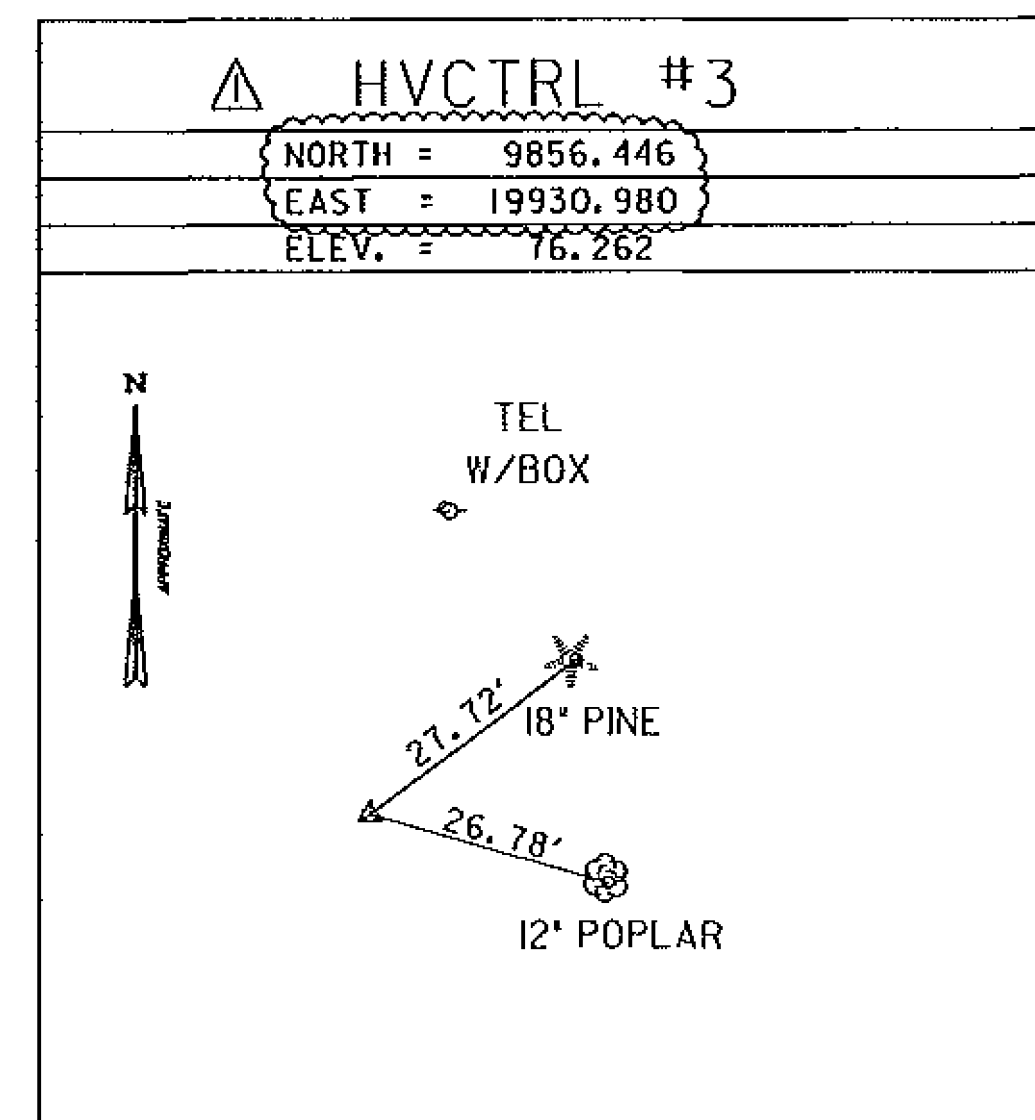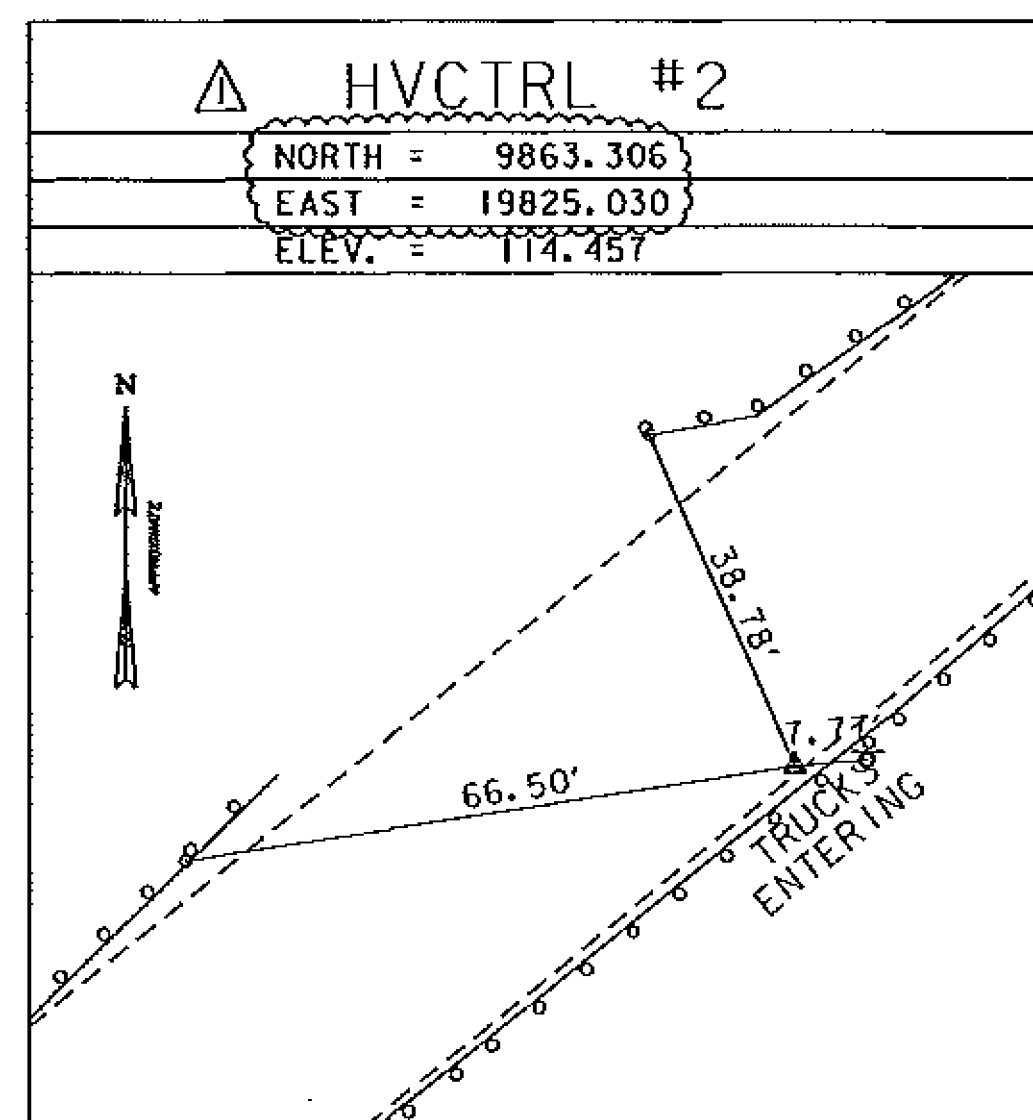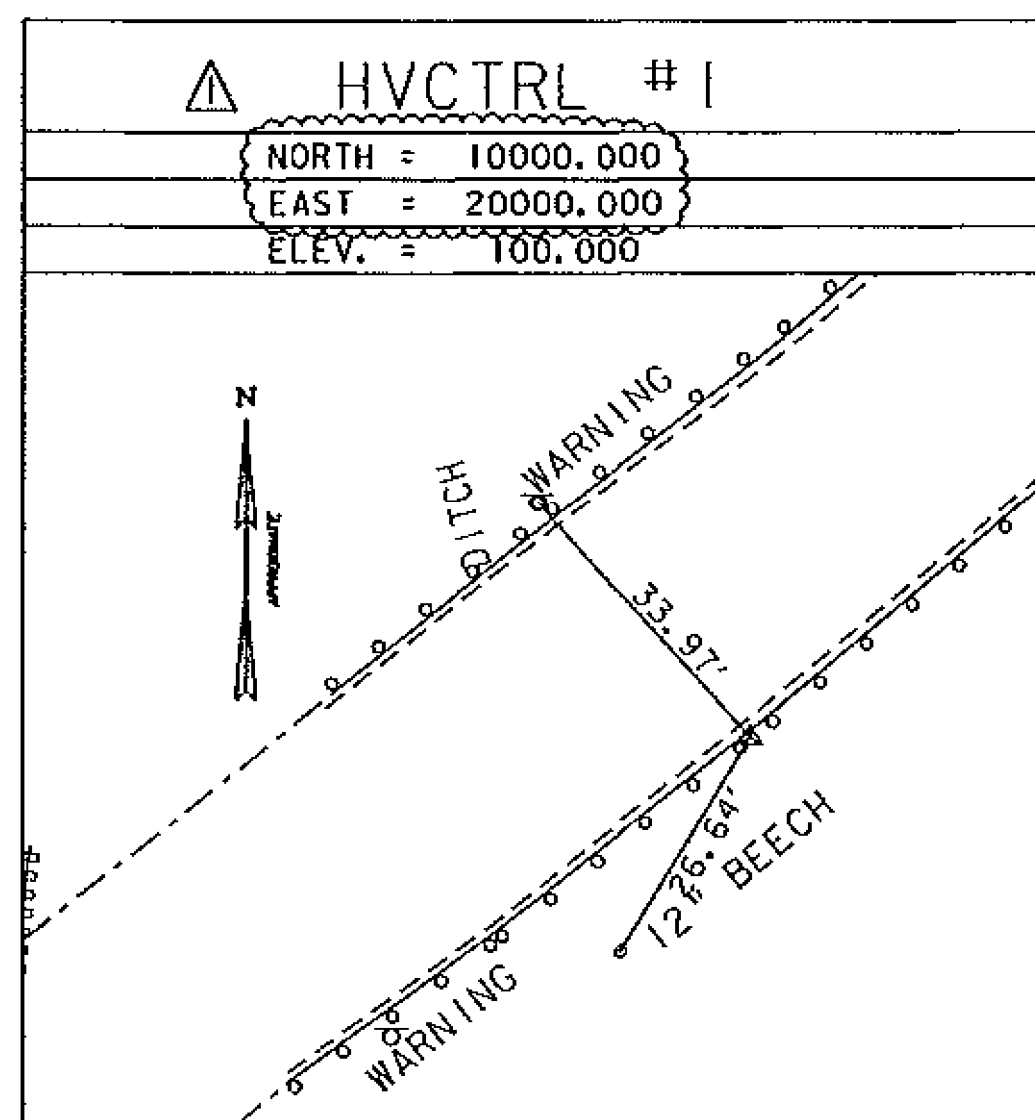


DATUM	
VERTICAL	ASSUMED
HORIZONTAL	ASSUMED
ADJUSTMENT	COMPASS

REV.	DESCRIPTION	DATE
△	CORRECTED COORDINATES & ADDED STATIONS WITH OFFSETS	2/12/2014
PROJECT NAME: HARTLAND		
PROJECT NUMBER: BHF BPNT(12)		
FILE NAME: zllc2601.dgn	PLOT DATE: 2/12/2014	
PROJECT LEADER: M.A. COLGAN	DRAWN BY: A.J. GOUDREAU	
DESIGNED BY: VHB	CHECKED BY: S. FARNSWORTH	
BR 62A TIE SHEET	SHEET 10 OF 55	



# SEE REVISED SHEET

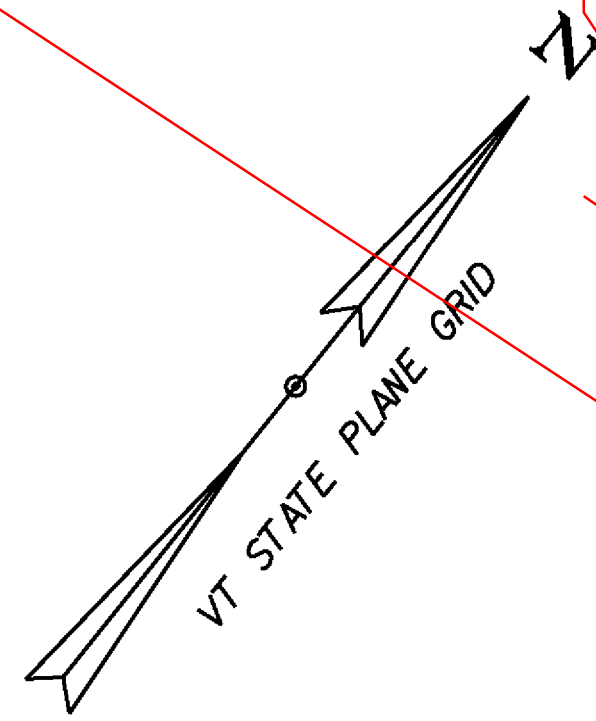


COORDINATE TABLE WITH NORTHINGS AND EASTINGS

	STATION	NORTHING	EASTING
POB	10+00.00	9796.51	19718.71
BEGIN PROJECT	11+25.00	9874.64	19816.28
PC	13+73.76	10030.12	20010.47
END PROJECT	13+82.00	10035.27	20016.90
BEGIN BRIDGE	12+00.34	9921.73	19875.09
ABUT #1 CL BRG	12+01.75	9922.61	19875.20
ABUT #2 CL BRG	12+98.25	9982.92	19951.52
END BRIDGE	12+99.66	9983.81	19952.62
WW #1 WP	12+18.25	9945.80	19878.76
WW #2 WP	11+85.25	9899.42	19873.63
WW #3 WP	13+14.75	10006.12	19954.09
WW #4 WP	12+81.75	9959.73	19948.95

SEE NOTE 1

HORIZONTAL ALIGNMENT NAME: US 5 PROPOSED

	STATION	NORTHING	EASTING
ELEMENT: LINEAR			
POB	10+00.00	9796.5098	19718.7069
POE	14+50.00	10077.7727	20069.9776
TANGENT DIRECTION:		N 51° 18' 56.51" E	
TANGENT LENGTH:		450.00	

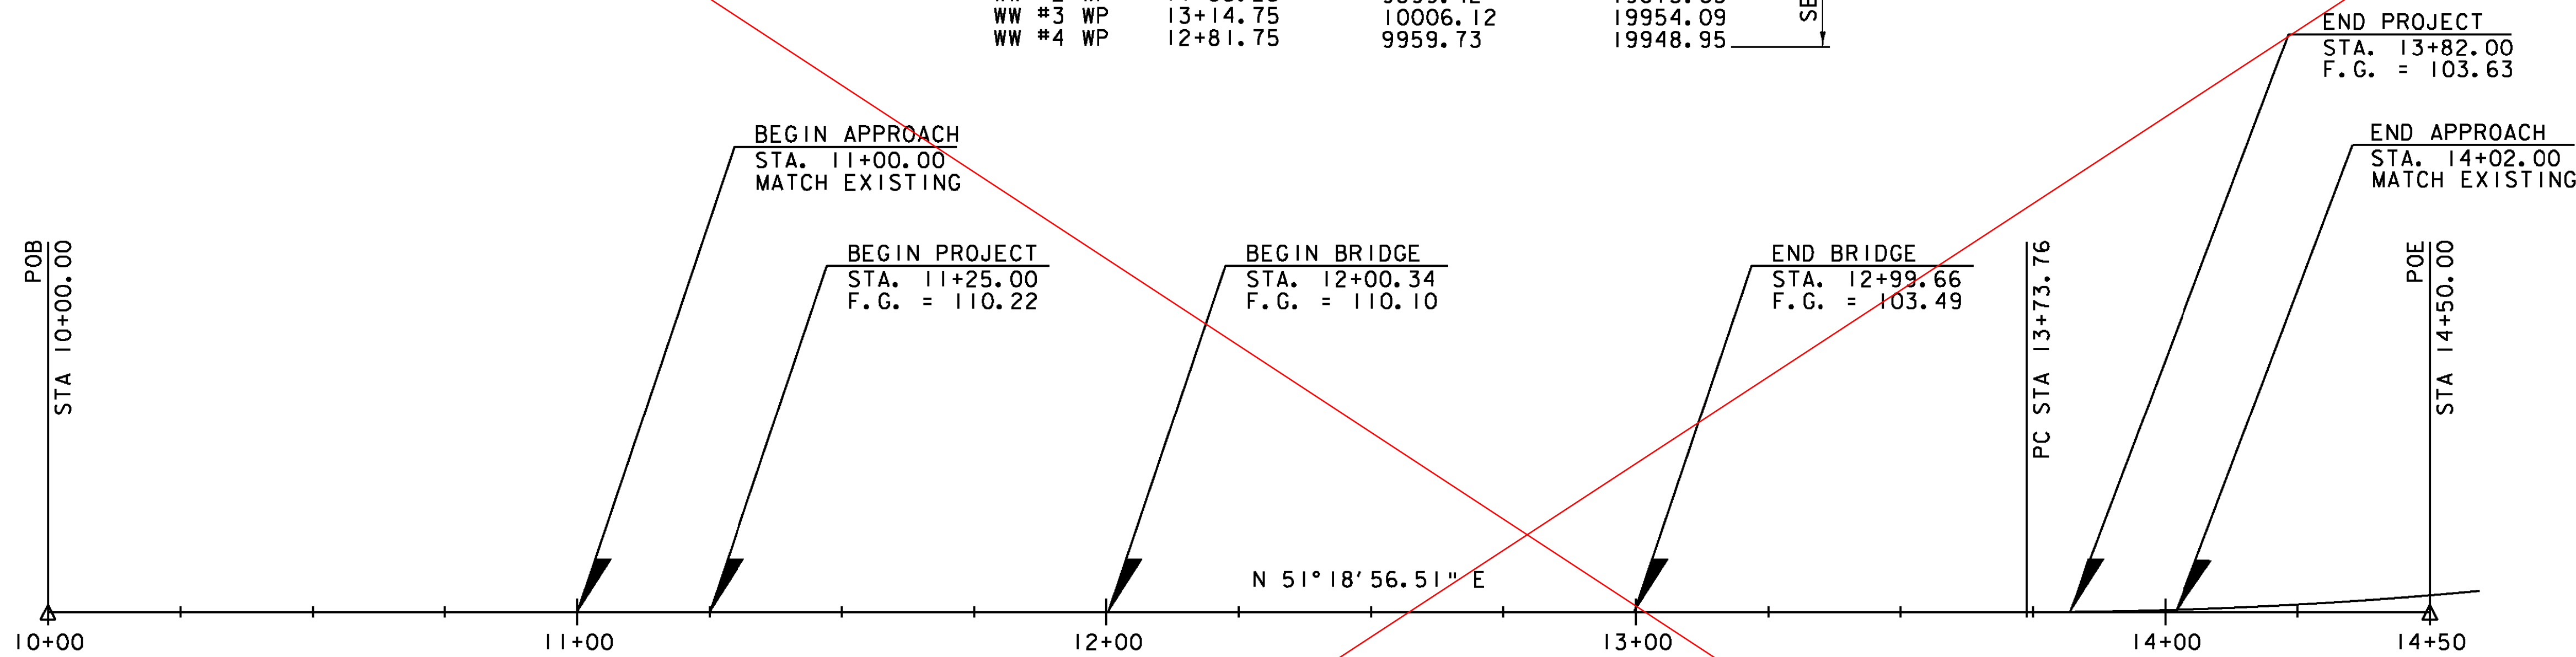

HORIZONTAL CURVE DATA

PI = 16+19.40  
 DELTA = 30° 0' 0"  
 D = 6° 15' 0"  
 R = 916.73  
 T = 245.64  
 L = 480  
 E = 32.34

NOTE:


- ENGINEER TO VERIFY THAT ROADWAY CL PASSES DIRECTLY OVER THE CL OF BEAM 3 PRIOR TO SETTING THE WORKING POINTS

SCALE 1" = 20'-0"

DATUM	
VERTICAL	ASSUMED
HORIZONTAL	ASSUMED
ADJUSTMENT	COMPASS



PROJECT NAME:	HARTLAND
PROJECT NUMBER:	BHF BPNT(12)
FILE NAME:	zllc260allgn.dgn
PROJECT LEADER:	M.A. COLGAN
DESIGNED BY:	M.C. SCOTT
BR 62A ALIGNMENT LAYOUT PLAN	
PLOT DATE:	1/2/2014
DRAWN BY:	M.C. SCOTT
CHECKED BY:	S.E. BURBANK
SHEET	II OF 55

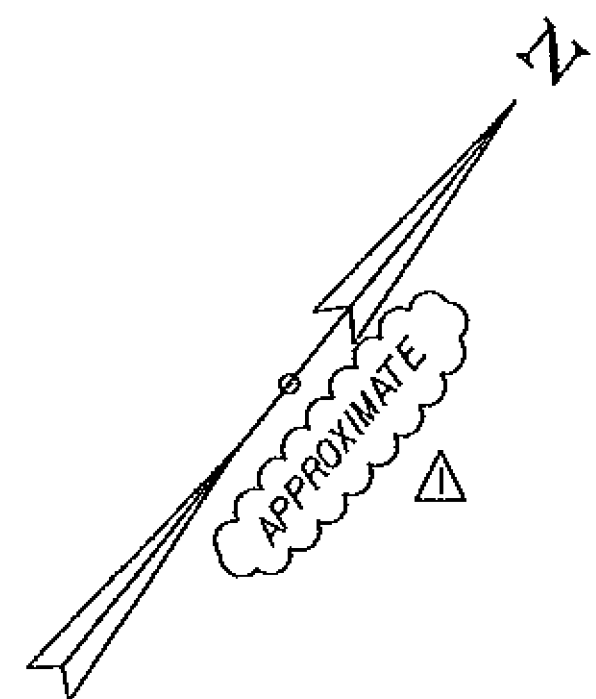


HORIZONTAL ALIGNMENT NAME: US 5 PROPOSED

STATION	NORTHING	EASTING
POB 10+00.00	9796.5098	19718.7069
POE 14+50.00	10077.7727	20069.9776
TANGENT DIRECTION:	N 51° 18' 56.51" E	
TANGENT LENGTH:	450.00	

COORDINATE TABLE WITH NORTHINGS AND EASTINGS

	STATION	NORTHING	EASTING
POB	10+00.00	9796.51	19718.71
BEGIN PROJECT	11+25.00	9874.64	19816.28
PC	13+73.76	10030.12	20010.47
END PROJECT	13+82.00	10035.27	20016.90
BEGIN BRIDGE	12+00.34	9921.73	19875.09
ABUT #1 CL BRG	12+01.75	9922.61	19876.20
ABUT #2 CL BRG	12+98.25	9982.92	19951.52
END BRIDGE	12+99.66	9983.81	19952.62
WW #1 WP	12+18.25	9945.80	19878.76
WW #2 WP	11+85.25	9899.42	19873.63
WW #3 WP	13+14.75	10006.12	19954.09
WW #4 WP	12+81.75	9959.73	19948.95

SEE NOTE 1

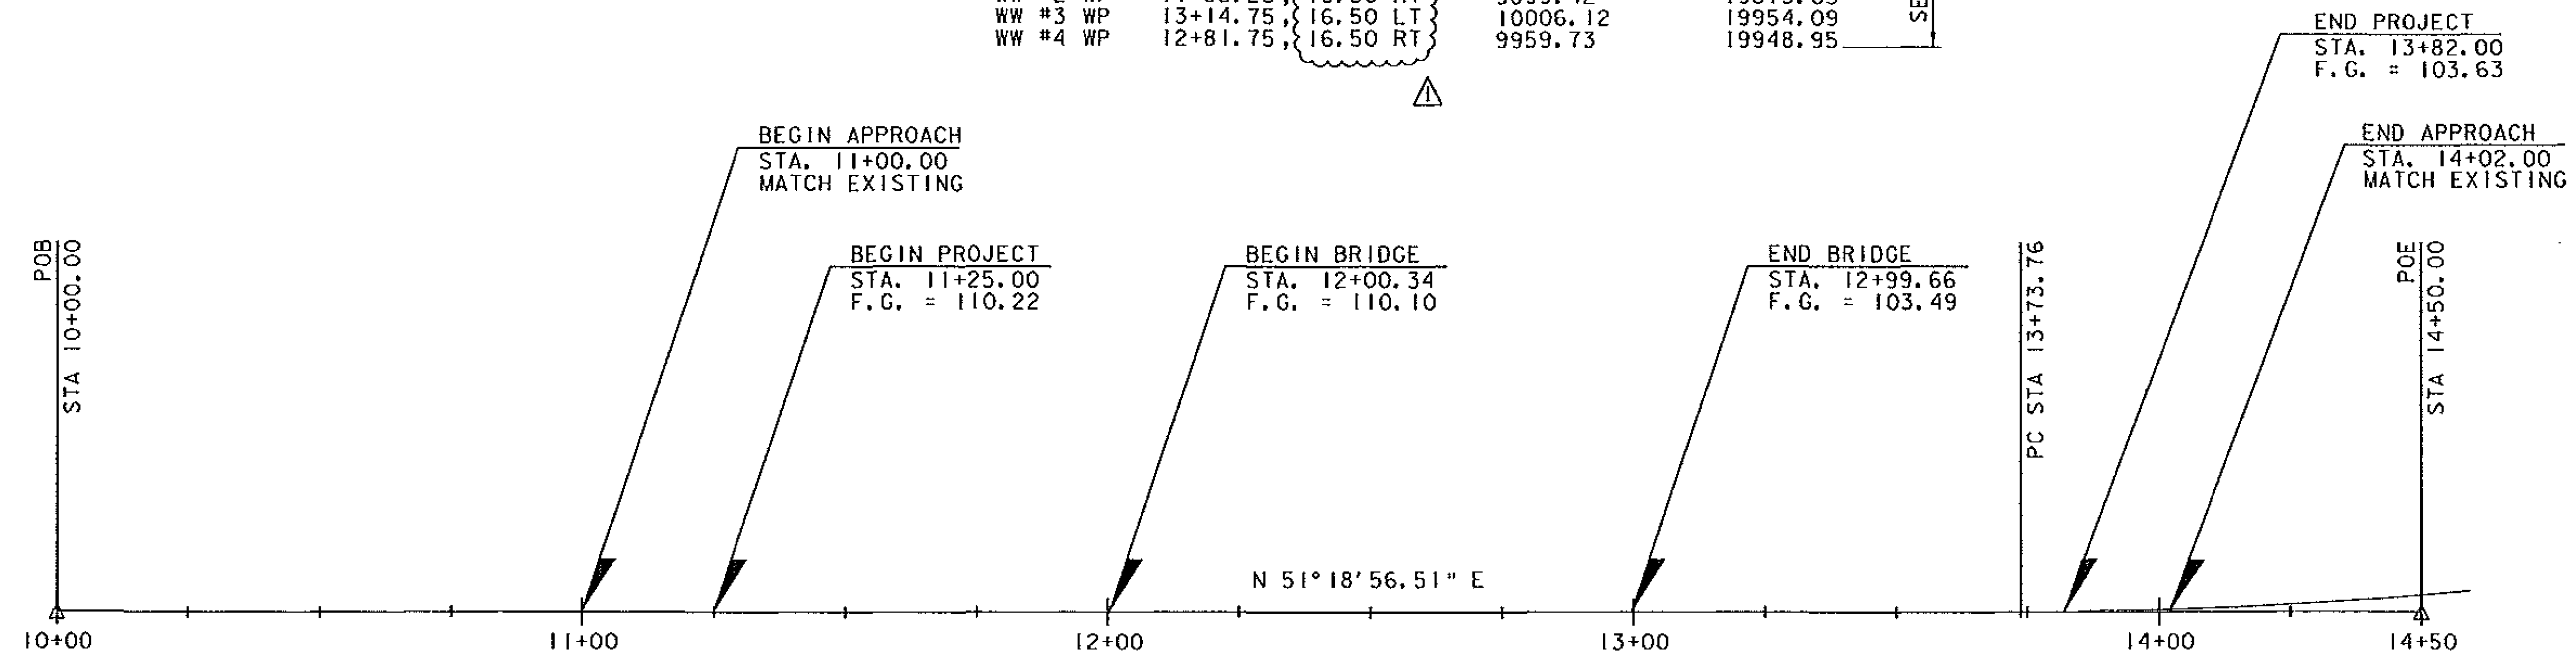

HORIZONTAL CURVE DATA

PI = 16+19.40  
 DELTA = 30° 0' 0"  
 D = 6° 15' 0"  
 R = 916.73  
 T = 245.64  
 L = 480  
 E = 32.34

NOTE:

- ENGINEER TO VERIFY THAT ROADWAY CL PASSES DIRECTLY OVER THE CL OF BEAM 3 PRIOR TO SETTING THE WORKING POINTS

REV.	DESCRIPTION	DATE
△	CORRECTED COORDINATE & ADDED WP OFFSETS	2/12/2014

PROJECT NAME: HARTLAND  
 PROJECT NUMBER: BHF BPNT(12)

FILE NAME: zllc260dallgn.dgn	PLOT DATE: 2/12/2014
PROJECT LEADER: M.A. COLGAN	DRAWN BY: M.C. SCOTT
DESIGNED BY: M.C. SCOTT	CHECKED BY: S.E. BURBANK
BR 62A ALIGNMENT LAYOUT PLAN	SHEET 11 OF 55

DATUM	
VERTICAL	ASSUMED
HORIZONTAL	ASSUMED
ADJUSTMENT	COMPASS

SCALE 1" = 20' - 0"  
 20 0 20



**MANUFACTURED TERMINAL SECTION, FLARED**

STA. 11+24.76 - 11+62.26, LT  
 STA. 10+37.50 - 10+75.00, LT

**CAST-IN-PLACE CONCRETE CURB, TYPE B**

STA. 11+29.84 - 11+69.84, LT  
 STA. 13+01.16 - 13+41.06, LT  
 STA. 11+63.84 - 12+03.84, RT  
 STA. 13+41.91 - 13+81.91, RT

**GUARDRAIL APPROACH SECTION, GALVANIZED 2 RAIL BOX BEAM**

STA. 11+74.76 - 12+03.84, LT  
 STA. 13+41.91 - 13+70.99, LT  
 STA. 11+40.76 - 11+69.84, RT  
 STA. 13+01.16 - 13+30.24, RT

**REMOVAL AND DISPOSAL OF GUARDRAIL**

STA. 11+03.26 - 11+83.80, RT  
 STA. 11+34.00 - 12+12.80, LT  
 STA. 12+88.70 - 13+93.99, RT  
 STA. 13+14.73 - 13+95.99, LT

**STEEL BEAM GUARDRAIL, GALVANIZED W/ 8 FEET POSTS**


STA. 11+03.26 - 11+40.76, RT  
 STA. 13+30.24 - 13+80.24, RT  
 STA. 11+62.26 - 11+74.76, LT  
 STA. 13+70.99 - 13+95.99, LT

**BRIDGE RAILING, GALVANIZED 2 RAIL BOX BEAM**

STA. 12+03.84 - 13+41.91, LT  
 STA. 11+69.84 - 13+01.16, RT

**SNOW BARRIER**

STA. 11+91.79 - 12+47.44, RT  
 STA. 12+52.59 - 13+08.24, LT

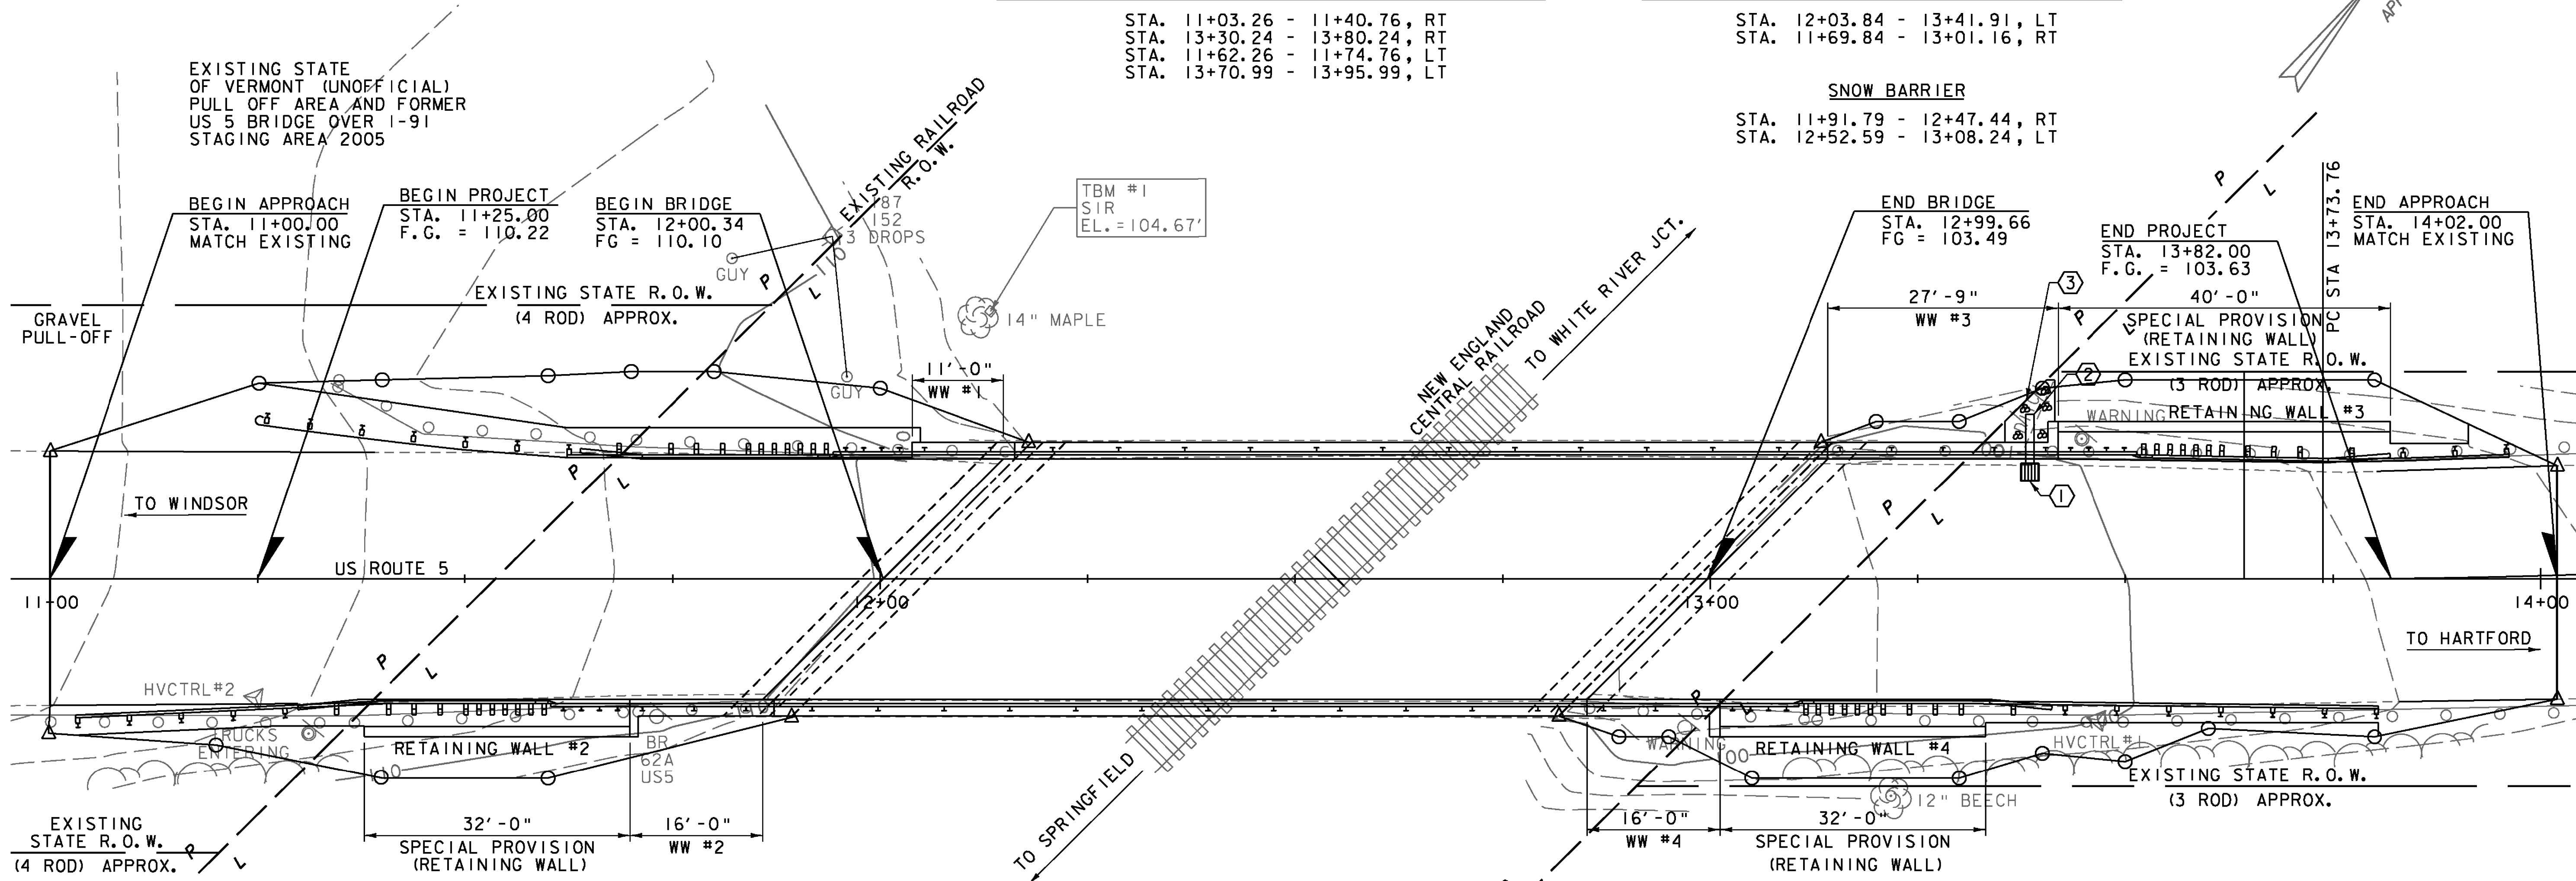

**EXISTING BRIDGE 62A**

SINGLE SPAN  
 ROLLED BEAM  
 CONCRETE DECK  
 99'-4" LENGTH  
 29'-6" ROADWAY WIDTH  
 22'-2" VERTICAL CLEARANCE TO RAILROAD RAIL  
 BUILT 1955


**DRAINAGE**

- ① STA. 13+38.5, LT 14.0'  
 CONSTRUCT PRECAST REINFORCED CONCRETE  
 DROP INLET WITH CAST IRON GRATE  
 INV. @ INLET (14.0' LT) = 96.75'
- ② STA 13+38.50, LT 19.86'  
 CONSTRUCT 6 LF x 12" CPEP  
 12" INV. @ INLET (15.5' LT) = 96.34'  
 12" INV. @ OUTLET (21.3' LT) = 94.69'
- ③ STA 13+38.50, LT 16.5' TO LT 24.0'  
 STONE FILL, TYPE 1, 1.5' x 6'

TELEGRAPH POLE  
 W/BOX

HVCTRL#3


18" PINE

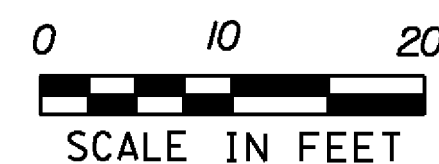

**NOTE:**

- 1. NEW STEEL BEAM GUARDRAIL IS TO BE ATTACHED TO EXISTING STEEL BEAM GUARDRAIL AT STATIONS 11+03.26 RT, 13+80.24 RT AND 13+95.99 LT.


PROJECT NAME: HARTLAND	PLOT DATE: 1/2/2014
PROJECT NUMBER: BHF BPNT(12)	DRAWN BY: M.C. SCOTT
FILE NAME: zllc260bdr_nul.dgn	CHECKED BY: S.E. BURBANK
PROJECT LEADER: M.A. COLGAN	SHEET 12 OF 55
DESIGNED BY: S.G. FARNSWORTH	

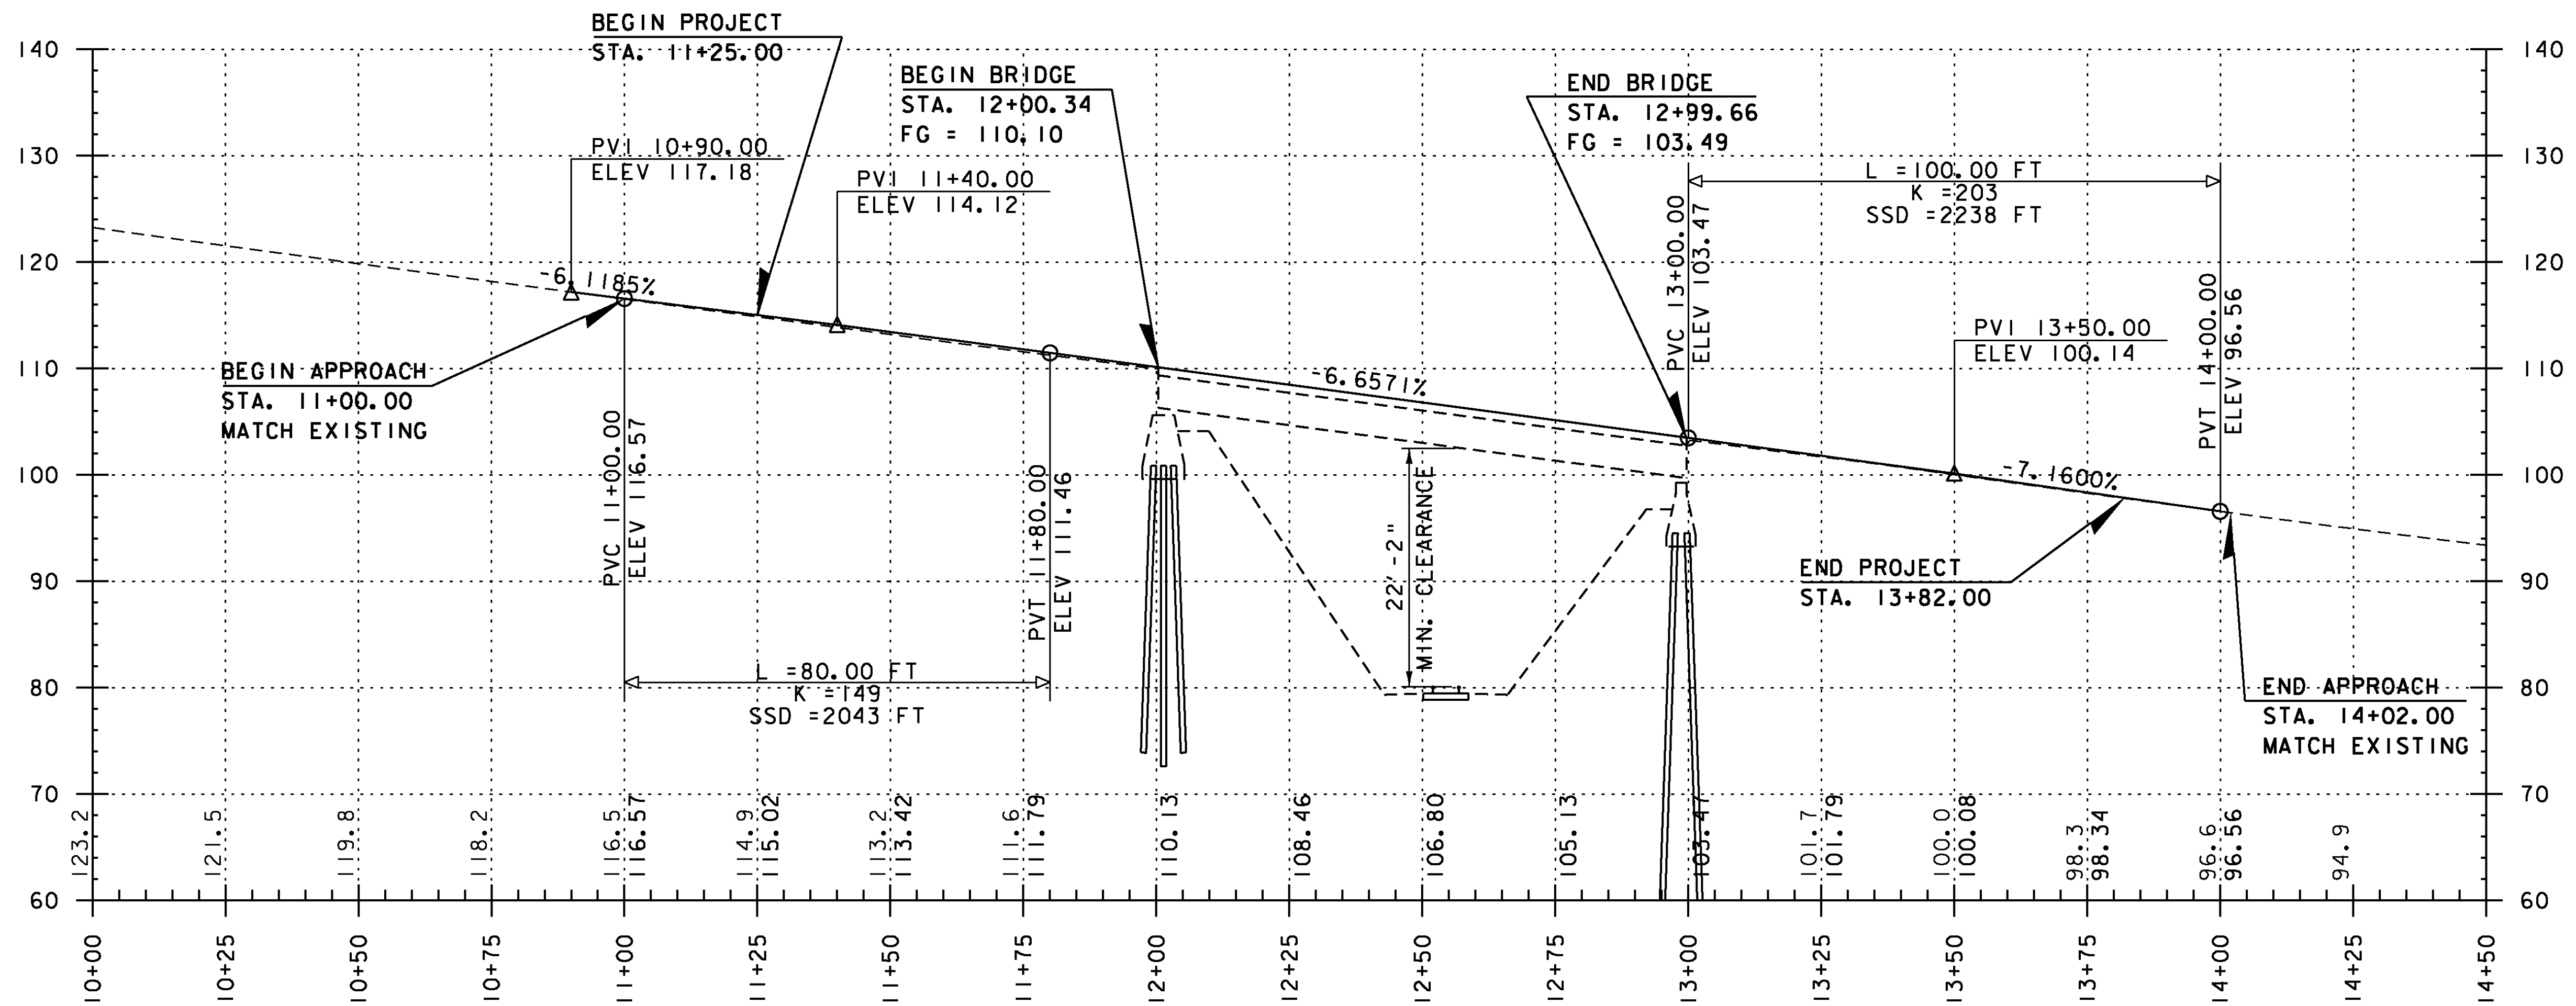

US ROUTE 5 PROFILE

SCALE  
 HORIZONTAL: 1" = 20'  
 VERTICAL: 1" = 10'

THE GRADES SHOWN TO THE NEAREST TENTH ARE THE ORIGINAL GROUND ELEVATIONS ALONG THE PROPOSED ALIGNMENT.  
 THE GRADES SHOWN TO THE NEAREST HUNDREDTH ARE THE FINISH GRADES ALONG THE PROPOSED ALIGNMENT.

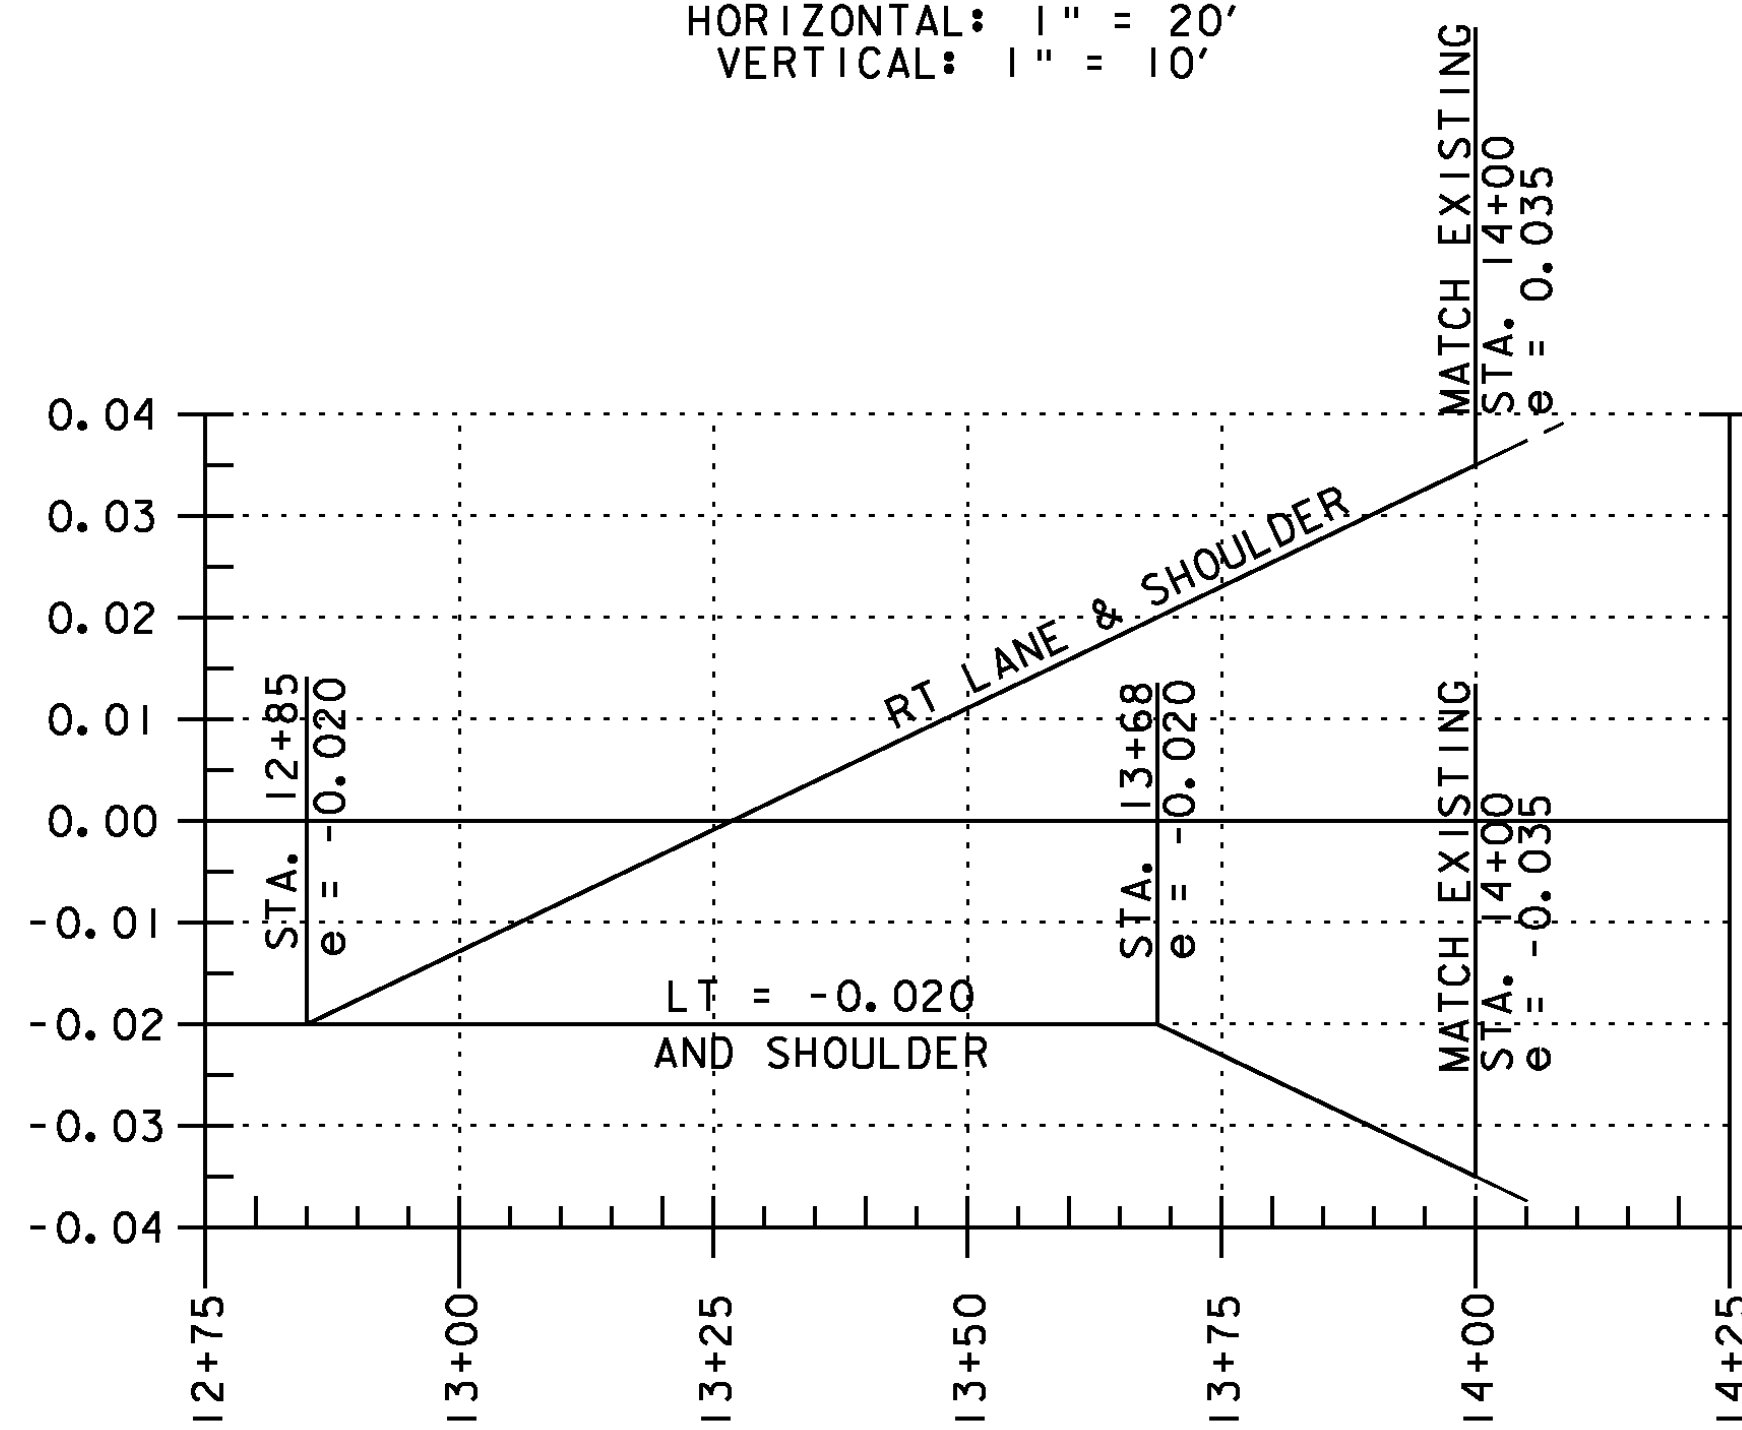

BANK TRANSITION


SCALE  
 HORIZONTAL: 1" = 20'  
 VERTICAL: 1" = 0.02 FT/FT



PROJECT NAME: HARTLAND  
 PROJECT NUMBER: BHF BPNT(12)

FILE NAME: zllc260pro.dgn  
 PROJECT LEADER: M.A. COLGAN  
 DESIGNED BY: S.G. FARNSWORTH  
 BR 62A PROFILE SHEET

PLOT DATE: 12/17/2013  
 DRAWN BY: A.J. GOUDREAU  
 CHECKED BY: S.E. BURBANK  
 SHEET 13 OF 55

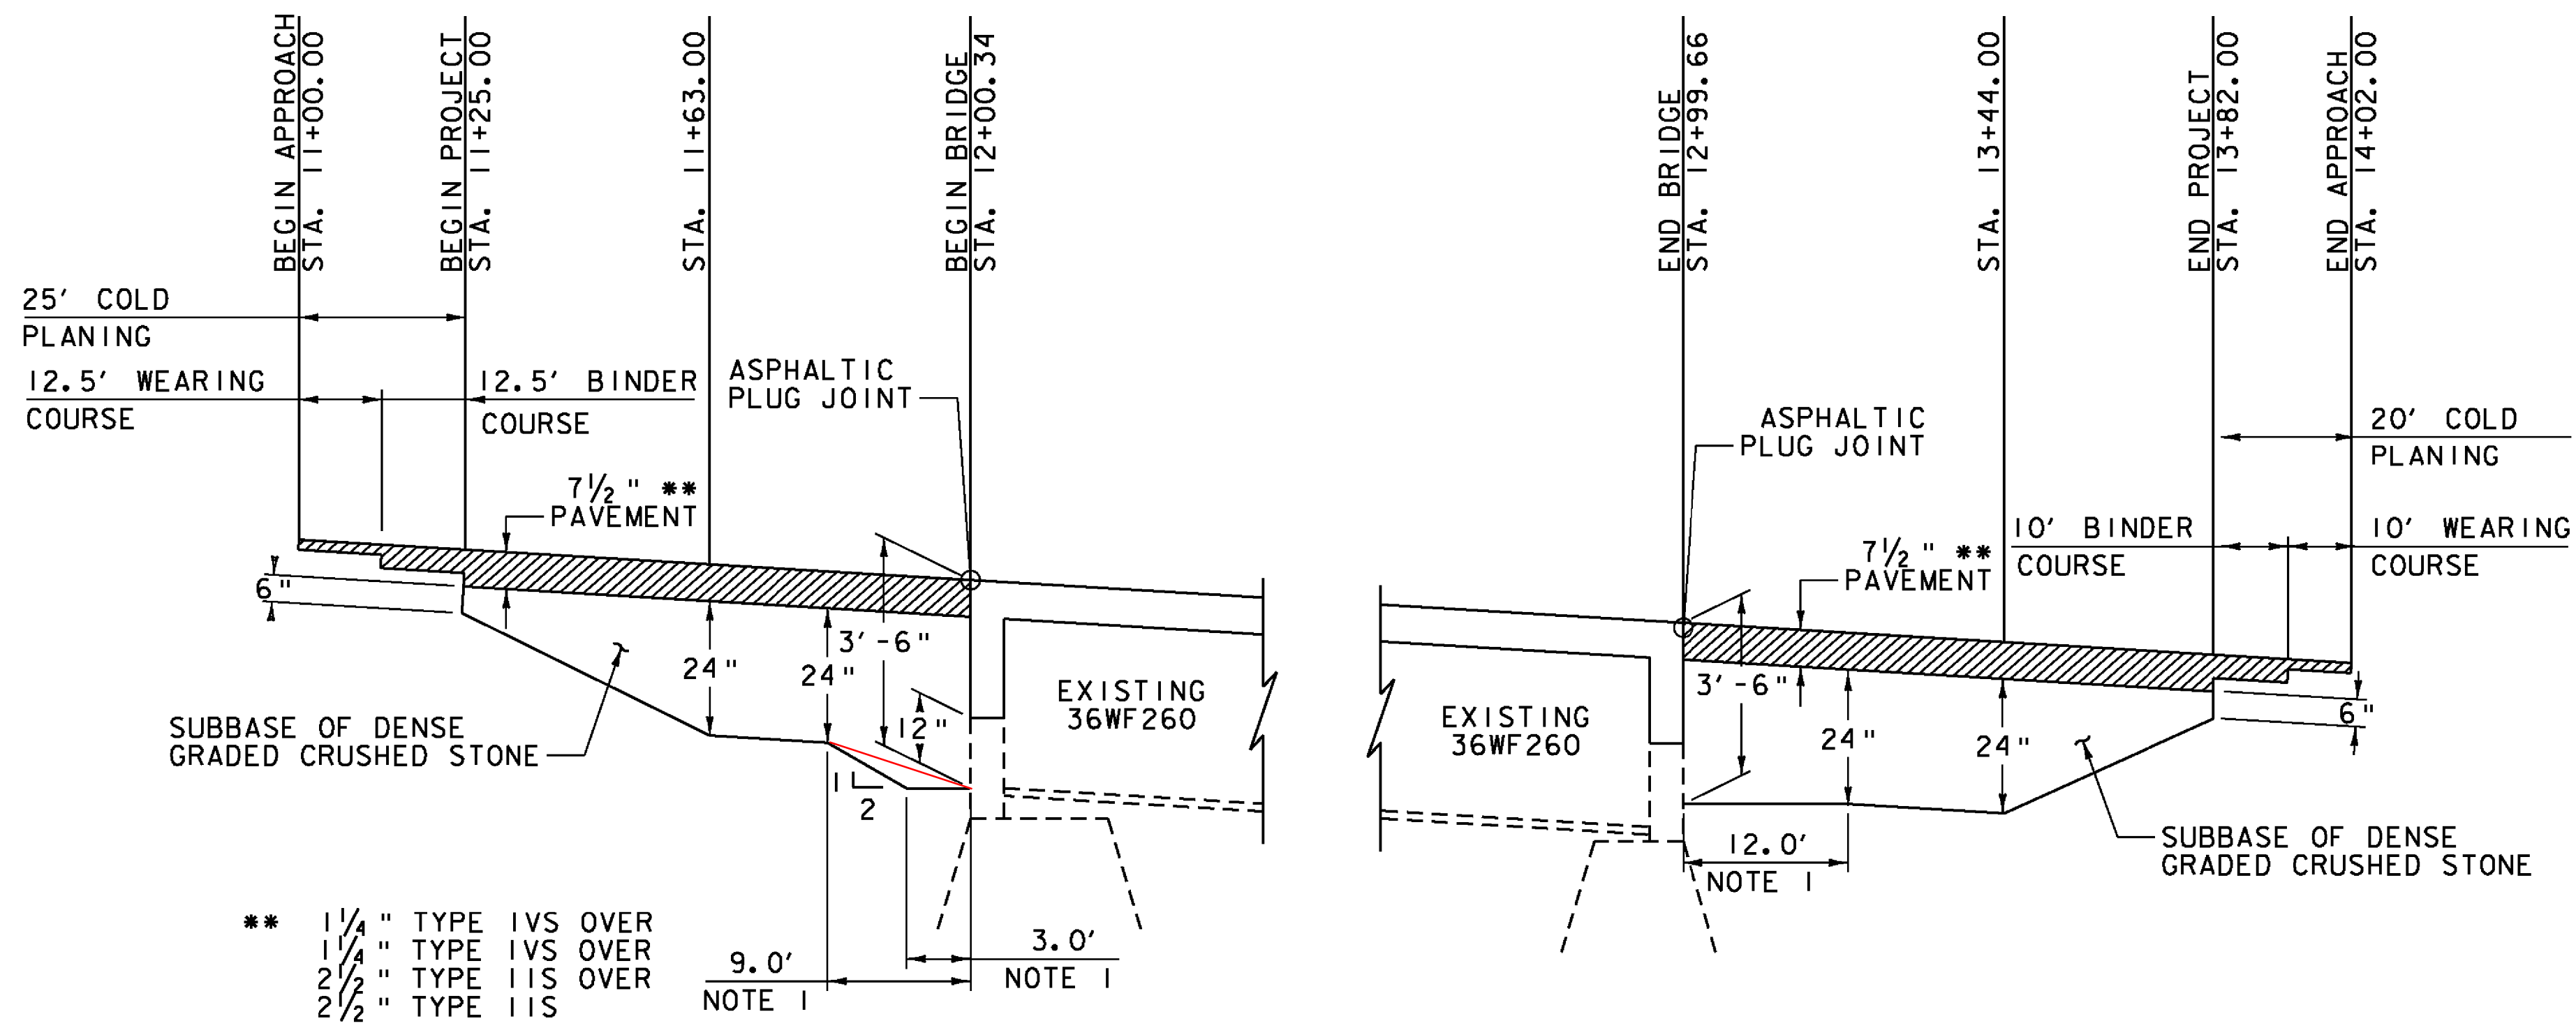

NOTE:  
1. MEASURED PERPENDICULAR TO BACK OF ABUTMENT


US RT 5 MATERIAL TRANSITION DIAGRAM  
N. T. S.



PROJECT NAME: HARTLAND	PLOT DATE: 12/17/2013
PROJECT NUMBER: BHF BPNT(12)	DRAWN BY: A.J. GOUDREAU
FILE NAME: zllc260pro.dgn	CHECKED BY: S.E. BURBANK
PROJECT LEADER: M.A. COLGAN	SHEET 14 OF 55
DESIGNED BY: S.G. FARNSWORTH	BR 62A MATERIAL TRANSITION DIAGRAM

**TRAFFIC CONTROL NOTES OTHER HIGHWAYS:**

1. THE TRAFFIC CONTROL PLAN SHOWN IS A SCHEMATIC AND SHOULD BE USED AS AN EXAMPLE ONLY. THE CONTRACTOR SHALL SUBMIT A SITE SPECIFIC TRAFFIC CONTROL PLAN FOR BRIDGES 62A & 66 TO VTRANS FOR APPROVAL. PAYMENT FOR PREPARING AND SUBMITTING THE TRAFFIC CONTROL PLAN, AND MAKING ANY NECESSARY REVISIONS TO THE PLAN, WILL BE INCLUDED IN THE UNIT PRICE BID FOR CONTRACT ITEM 64110. THE CONTRACTOR SHALL ALLOW TWO WEEKS FOR APPROVAL OF THE TRAFFIC CONTROL PLAN. NO WORK SHALL COMMENCE UNTIL THE CONTRACTOR HAS AN APPROVED TRAFFIC CONTROL PLAN.
2. ANY PARKING AREAS OR DRIVES WITH AN ENTRANCE/EXIT BETWEEN THE FLAGGER AND THE WORK ZONE SHALL HAVE THAT ENTRANCE/EXIT CLOSED WITH CONES OR DRUMS, PROVIDED ADDITIONAL ENTRANCES/EXITS EXIST IN THE AREA APPROACHING THE FLAGGER.
3. ANY PUBLIC HIGHWAYS BETWEEN THE FLAGGER AND THE WORK ZONE WILL REQUIRE AN ADDITIONAL FLAGGER TO MAINTAIN TRAFFIC CONTROL FOR THE PUBLIC HIGHWAY.
4. SIGNS SHALL BE INSTALLED SO AS NOT TO OBSTRUCT EXISTING SIGNS OR CORNER SIGHT DISTANCE FROM TOWN HIGHWAYS OR DRIVES.
5. ALL SIGNS SHALL BE IN ACCORDANCE WITH THE CURRENT EDITIONS OF THE "MANUAL ON UNIFORM TRAFFIC CONTROL DEVICES" (MUTCD) AND THE "STANDARD HIGHWAY SIGNS" BOOK (SHS) PUBLISHED BY THE FEDERAL HIGHWAY ADMINISTRATION (FHWA).
6. SOLID SUBSTRATE CONSTRUCTION SIGNS SHALL HAVE RETROREFLECTIVE SHEETING EQUAL TO OR EXCEEDING "AMERICAN SOCIETY FOR TESTING AND MATERIALS" (ASTM) D 4956 TYPE VII, VIII OR IX REQUIREMENTS, UNLESS OTHERWISE NOTED.
7. ROLL UP SIGNS SHALL HAVE RETROREFLECTIVE SHEETING EQUAL TO OR EXCEEDING ASTM D 4956 TYPE VI.
8. SIGNS SHALL BE ERECTED BEFORE THE START OF ANY WORK AND SHALL BE COVERED UNTIL WORK COMMENCES, DURING PERIODS OF INACTIVITY OR UPON COMPLETION OF THE WORK. EACH SIGN SHALL BE ERECTED IN A NEAT AND WORKMANLIKE MANNER. SIGNS SHALL BE REMOVED UPON COMPLETION OF THE WORK AT THE DISCRETION OF THE ENGINEER.
9. FIXED SIGNS SHALL BE SET SECURELY IN THE GROUND. THE BOTTOM OF A SIGN SHALL BE AT LEAST SEVEN FEET ABOVE THE EDGE OF PAVEMENT. THE NEAREST EDGE OF A SIGN SHALL BE AT LEAST SIX FEET OUTSIDE THE SHOULDER POINT OR FOUR FEET OUTSIDE GUARDRAIL.
10. PORTABLE SIGNS SHALL BE PLACED ON THE EDGE OF ROADWAY AND AT ONE FOOT MINIMUM ABOVE TRAVELED WAY. ALL VEGETATION THAT INTERFERES WITH VISIBILITY OF THE SIGNS SHALL BE REMOVED. WHEN PLACED BEHIND GUARDRAIL, THE BOTTOM OF THE SIGN FACE SHALL BE ABOVE THE TOP OF THE GUARDRAIL.
11. WHERE SIGN INSTALLATIONS ARE NOT PROTECTED BY GUARDRAIL OR OTHER APPROVED TRAFFIC BARRIERS, ALL SIGN STANDS AND POST INSTALLATIONS SHALL BE "NATIONAL COOPERATIVE HIGHWAY RESEARCH PROGRAM" (NCHRP) REPORT 350 COMPLIANT. NO SIGN POSTS SHALL EXTEND OVER THE TOP OF THE SIGN INSTALLED ON SAID POST(S). WHEN ANCHORS ARE INSTALLED STUB SHALL NOT BE GREATER THAN FOUR INCHES ABOVE EXISTING GROUND.
12. THE NUMBER OF CHANNELIZING DEVICES SHOWN ARE FOR ILLUSTRATIVE PURPOSES ONLY. THE ACTUAL NUMBER REQUIRED ARE TO BE DETERMINED BY THE CONTRACTOR AND SHOWN ON THE TRAFFIC CONTROL PLAN SUBMITTED BY THE CONTRACTOR. WARNING LIGHTS SHALL NOT BE USED ON CHANNELIZING DEVICES.
13. THE PORTABLE CHANGEABLE MESSAGE SIGN (PCMS) SHALL BE USED AT THE DISCRETION OF THE ENGINEER, THE PCMS SHALL BE USED IN ACCORDANCE WITH SECTION 6F.55 OF THE MUTCD.

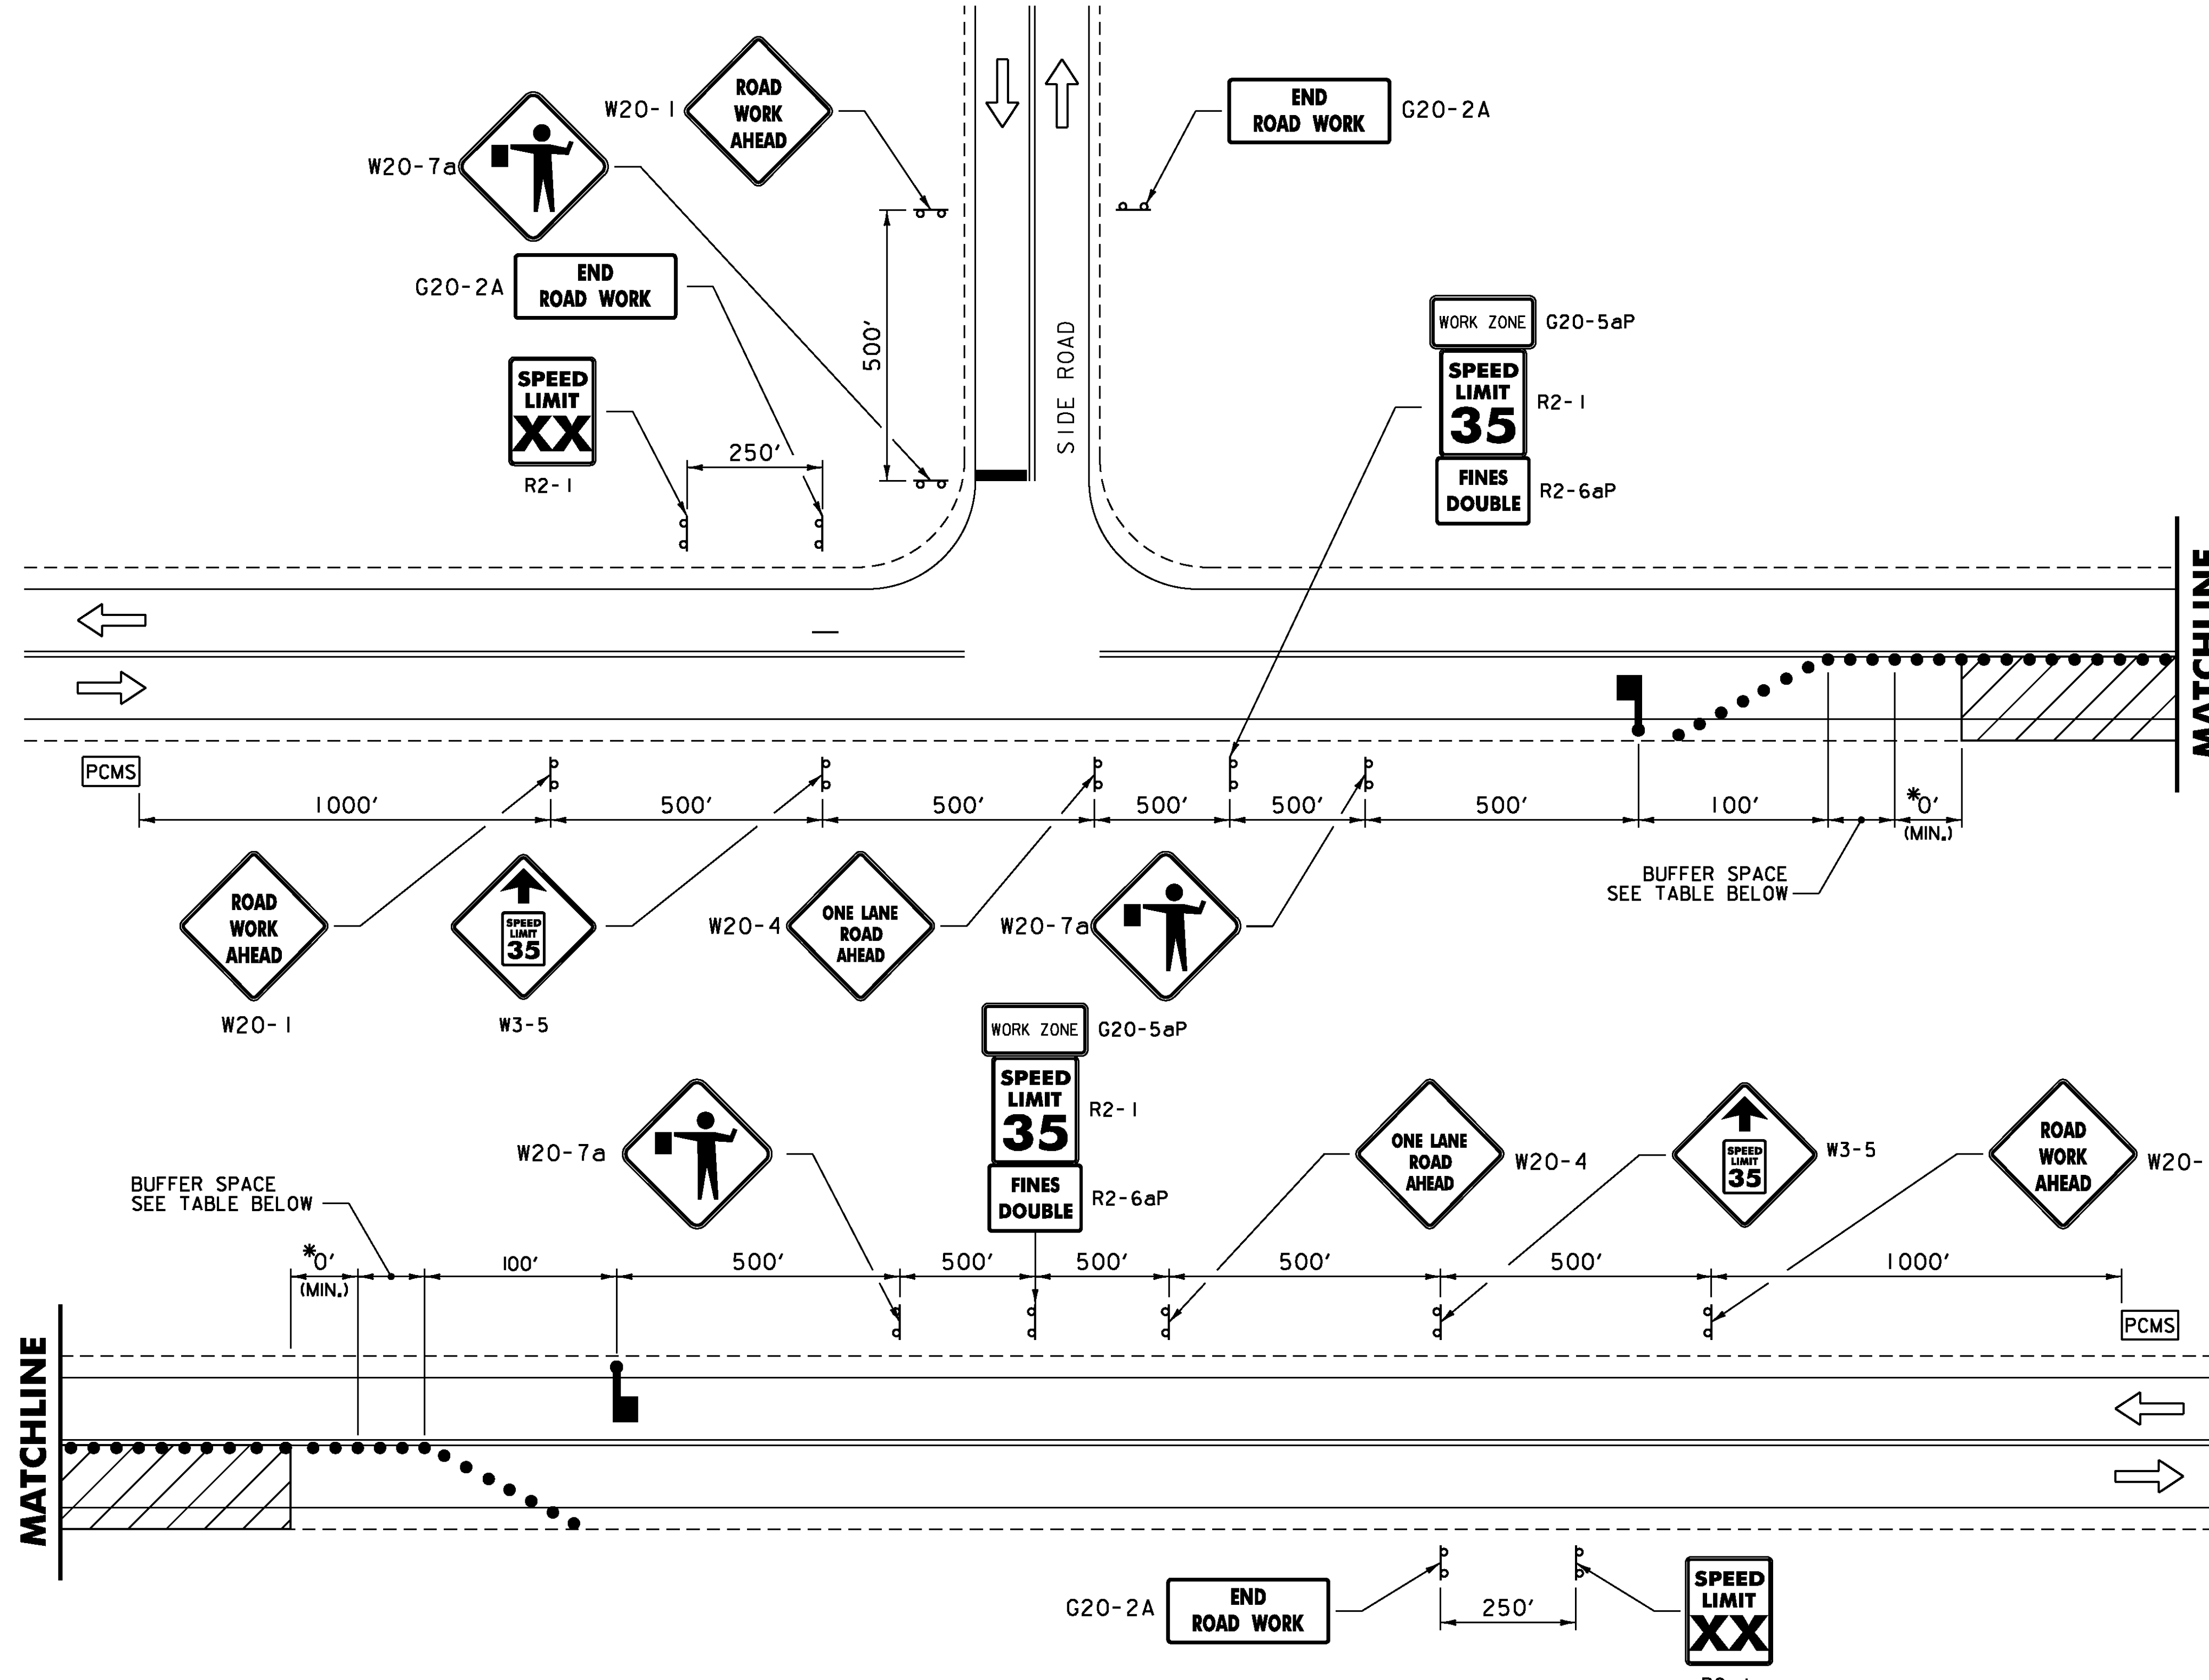

XX = PRESENT POSTED SPEED LIMIT

* - ACTUAL DIMENSION TO BE DETERMINED BY INDIVIDUAL BRIDGE SITE CONDITIONS AND TO BE SHOWN ON TRAFFIC CONTROL PLANS SUBMITTED BY THE CONTRACTOR.

**TRAFFIC CONTROL PLAN ON NON-INTERSTATE ROADWAYS**

NOT TO SCALE

**LEGEND**

- FLOW OF TRAFFIC
- RETROREFLECTIVE PLASTIC DRUM OR CONCRETE BARRIER
- ▨ WORK AREA
- FLAGGER
- PCMS PORTABLE CHANGEABLE MESSAGE SIGN (SEE NOTE 13)

**BUFFER SPACE TABLE**

POSTED SPEED (MPH)	MINIMUM BUFFER SPACE LENGTH (F T)
35	250
40	305
45	360
50	425

PROJECT NAME:	HARTLAND
PROJECT NUMBER:	BHF BPNT(12)
FILE NAME:	zllc260+c.dgn
PROJECT LEADER:	M.A. COLGAN
DESIGNED BY:	E.A. FIALA
TRAFFIC CONTROL WITH FLAGGERS	
PLOT DATE:	12/17/2013
DRAWN BY:	E.A. FIALA
CHECKED BY:	S.E. BURBANK
SHEET	15 OF 55



BUFFER SPACE TABLE


POSTED SPEED (MPH)	MINIMUM BUFFER SPACE LENGTH (FT)
25	155
30	200
35	250
40	305
45	360
50	425

LEGEND

- ➔ FLOW OF TRAFFIC
- RETROREFLECTIVE PLASTIC DRUM
- ▨ WORK AREA
- PCMS PORTABLE CHANGEABLE MESSAGE SIGN (SEE NOTE 16)
- ⊠ TRUCK-MOUNTED ATTENUATOR
- ↔ PORTABLE TRAFFIC SIGNAL
- ☛ PORTABLE LUMINAIRE (LIGHT TOWER)

TRAFFIC CONTROL NOTES:

1. CONSTRUCTION APPROACH SIGNS SHALL BE PROVIDED ON EACH APPROACH AS SHOWN. PAYMENT FOR THESE SIGNS, THE RETROREFLECTIVE PLASTIC DRUMS, ETC., SHALL BE INCLUDED IN ITEM 641.10, "TRAFFIC CONTROL". SEE SHEET 17 FOR ADDITIONAL NOTES.
2. ALL WORK DESCRIBED HEREIN FOR THE TEMPORARY TRAFFIC SIGNAL SYSTEM, AND NOT SPECIFIED FOR PAYMENT UNDER A SEPARATE CONTRACT ITEM, SHALL BE INCLUDED IN THE UNIT PRICE BID FOR CONTRACT ITEM 900.620, "SPECIAL PROVISION (TEMPORARY TRAFFIC SIGNAL SYSTEM, PORTABLE)".
3. SIGNAL TIMING/TIMING ADJUSTMENTS REQUESTED BY THE ENGINEER SHALL BE ACCOMPLISHED WITHIN 24 HOURS AFTER BEING REQUESTED. PAYMENT SHALL BE INCIDENTAL TO ITEM 900.620, "SPECIAL PROVISION (TEMPORARY TRAFFIC SIGNAL SYSTEM, PORTABLE)". THE CONTRACTOR, AT THE DIRECTION OF THE ENGINEER, SHALL MAKE SEVERAL TRIAL RUNS TO DETERMINE THE PROPER ALL-RED CLEARANCE INTERVAL.
4. SIGNAL FACES SHALL BE L.E.D. AND CONSIST OF 12" LENSES. (RED, AMBER, AND GREEN).
5. THE BOTTOM OF THE HOUSING OF A SIGNAL FACE SUSPENDED OVER A ROADWAY SHALL NOT BE LESS THAN 16.5 FEET NOR MORE THAN 19 FEET ABOVE THE PAVEMENT GRADE AT THE CENTER OF THE ROADWAY. THE BOTTOM OF A SIGNAL FACE NOT MOUNTED OVER A ROADWAY SHALL NOT BE LESS THAN 8 FEET NOR MORE THAN 15 FEET ABOVE THE GROUND. CAUTION SHOULD BE USED TO INSURE COMPLIANCE WITH THE HEIGHT REQUIREMENTS IN THE EVENT THE NEW APPROACH GRADES DIFFER SIGNIFICANTLY FROM THE OLD ROAD GRADE.
6. SIGNAL FACES FOR ANY ONE APPROACH SHALL NOT BE LESS THAN 8 FEET APART MEASURED HORIZONTALLY BETWEEN CENTER FACES.
7. ONE SIGNAL HEAD SHALL BE SUPPORTED FROM A CANTILEVER MAST ARM, WHICH SHALL BE IN THE CONE OF VISION OF APPROACHING TRAFFIC AT ALL TIMES. THE SECOND SIGNAL HEAD SHALL BE MOUNTED TO THE POST OF THE CANTILEVER MAST ARM. THE PORTABLE TRAFFIC SIGNAL SHALL BE LOCATED SO AS TO PLACE THE POST MOUNTED SIGNAL HEAD AT A HORIZONTAL DISTANCE OF NO GREATER THAN 14.5 FEET FROM THE CENTER OF THE APPROACH LANE WHEN THE STOP BAR IS 40 FEET FROM THE SIGNAL HEAD. CONSULT THE M.U.T.C.D. 2009 EDITION FOR ADDITIONAL INFORMATION CONCERNING SIGNAL PLACEMENT.
8. SIGNAL HEAD LOCATION SHALL BE ADJUSTED TO REFLECT LANE LOCATION CHANGES.
9. THE TEMPORARY TRAFFIC SIGNAL SYSTEM SHALL CONSIST OF A MINIMUM OF TWO (2) PORTABLE TRAFFIC SIGNALS, LUMINARIES, AND ASSOCIATED PAVEMENT MARKINGS.
10. ALL PORTABLE TRAFFIC SIGNALS, SIGNS, ETC., SHALL BELONG TO THE CONTRACTOR AT THE END OF THE PROJECT AND THE CONTRACTOR SHALL BE RESPONSIBLE FOR THEIR REMOVAL INCLUDING ANY TEMPORARY PAVEMENT MARKINGS, ETC.
11. A PORTABLE LIGHT TOWER WITH A MINIMUM OF A 250 WATT MER/150 WATT HPS LUMINAIRE MOUNTED ON A MAST AT A HEIGHT OF 30 FEET ABOVE THE ROADWAY CENTERLINE SHALL BE PROVIDED AS SHOWN ON THE TRAFFIC CONTROL PLANS OR AT THE DISCRETION OF THE ENGINEER. THE INTENT IS TO LIGHT UP THE AREA AROUND THE SIGNAL HEADS AND STOP BAR FOR INCREASED VISIBILITY. THE ENGINEER SHALL DETERMINE THE ADEQUACY OF THE LIGHTING AND DIRECT CHANGES IF THE LIGHTING IS INSUFFICIENT. LIGHTING SHALL BE INCIDENTAL TO ITEM 900.620, "SPECIAL PROVISION (TEMPORARY TRAFFIC SIGNAL SYSTEM, PORTABLE)".
12. TEMPORARY STOP BARS SHALL BE LOCATED A MINIMUM OF 40' AND A MAXIMUM OF 120' FROM THE NEAREST SIGNAL HEAD.
13. IF WORK ZONE IS BEHIND TEMPORARY TRAFFIC BARRIER THEN THE TRUCK-MOUNTED ATTENUATOR IS NOT NEEDED UNLESS THE END OF THE TEMPORARY TRAFFIC BARRIER IS WITHIN THE CLEAR ZONE.
14. ALL STOP SIGNS AND ANY OTHER TRAFFIC SIGNS MADE IRRELEVANT DUE TO THE TEMPORARY SIGNAL SHALL BE COVERED DURING OPERATION OF THE TEMPORARY SIGNAL OR AT THE DISCRETION OF THE ENGINEER. THE COSTS OF COVERING AND UNCOVERING THESE SIGNS SHALL BE PAID INCIDENTAL TO ITEM 641.10, "TRAFFIC CONTROL".
15. THE CONTRACTOR SHALL BE RESPONSIBLE FOR DETERMINING SIGNAL PHASING. THE CONTRACTOR SHALL SUBMIT A PHASING DIAGRAM TO THE ENGINEER FOR APPROVAL. THE CONTRACTOR SHALL MAKE SIGNALS OPERATIONAL ONLY AFTER RECEIVING APPROVAL OF THE PHASING DIAGRAM BY THE ENGINEER.
16. THE PORTABLE CHANGEABLE MESSAGE SIGNS (PCMS) SHALL BE USED IN ACCORDANCE WITH SECTION 6F.60 OF THE MUTCD. THE PCMS SHALL READ "ONE LANE BRIDGE AHEAD, BE PREPARED TO STOP" OR AS DIRECTED BY THE ENGINEER.

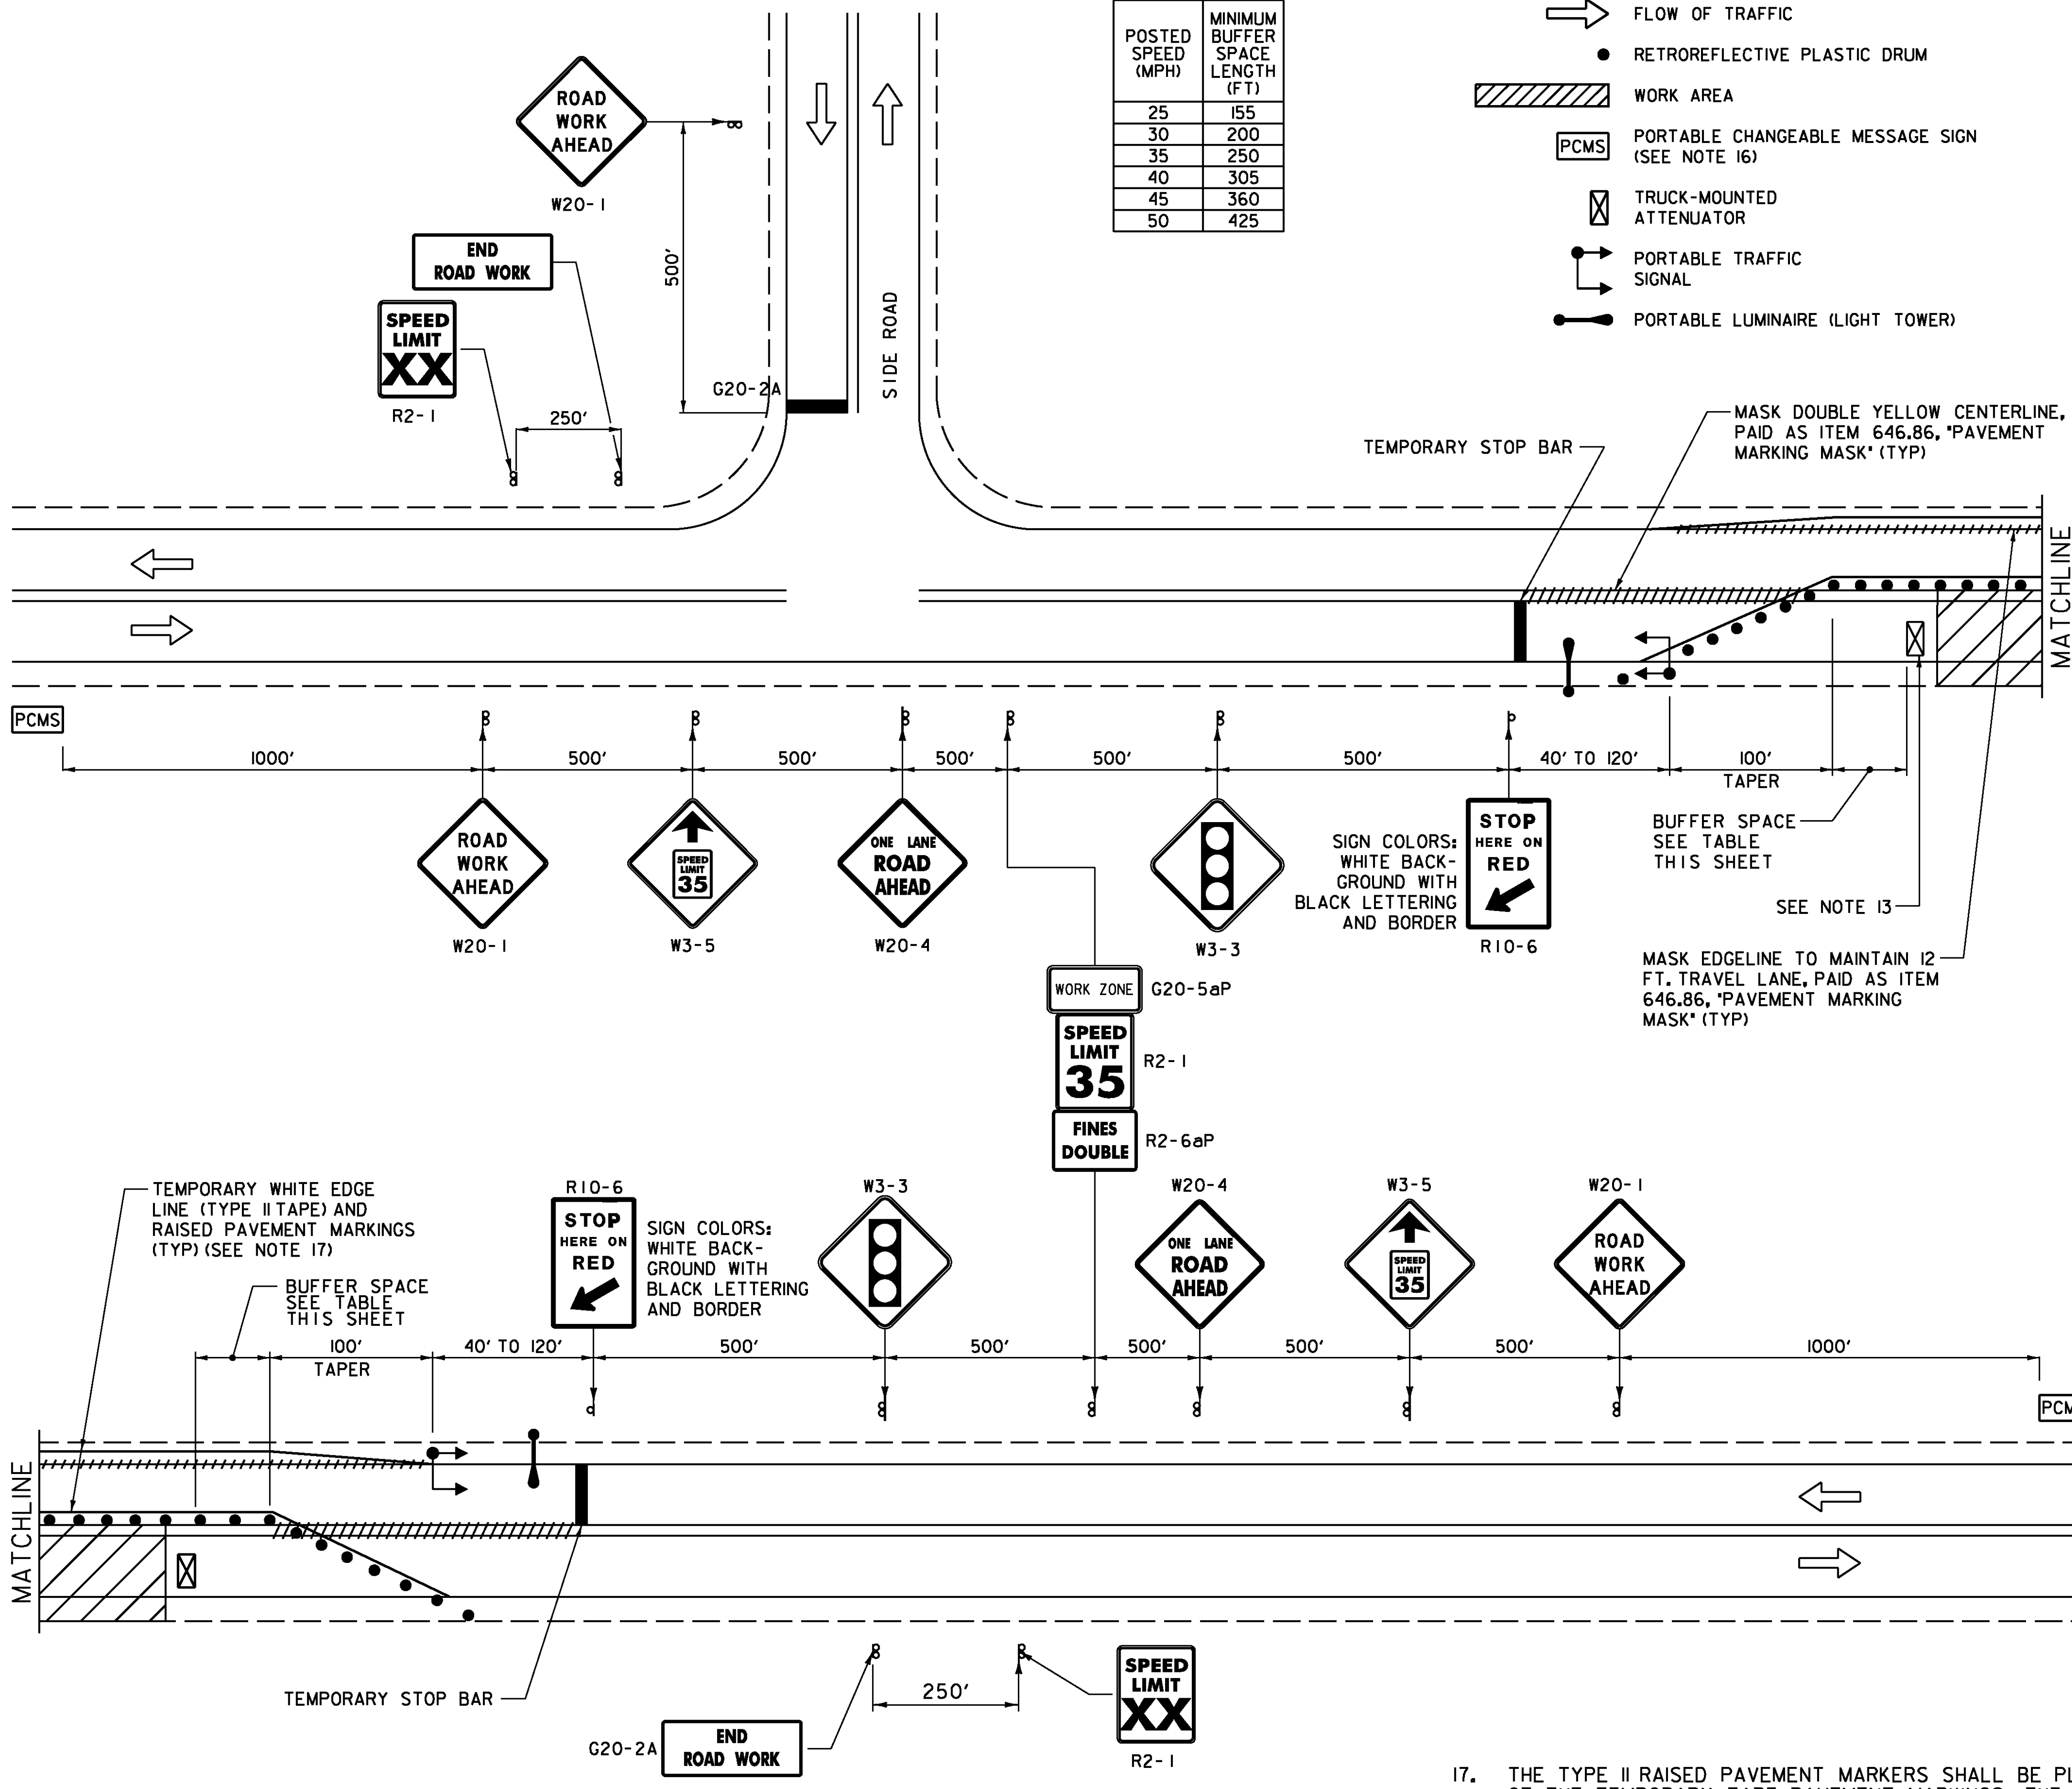

XX = PRESENT POSTED SPEED LIMIT

17. THE TYPE II RAISED PAVEMENT MARKERS SHALL BE PLACED TO THE OUTSIDE OF THE TEMPORARY TAPE PAVEMENT MARKINGS. THE TYPE II RAISED PAVEMENT MARKERS SHALL BE PLACED AT A SPACING OF 20 FEET.



TRAFFIC CONTROL FOR BRIDGES 62A AND 66 RIGHT SIDE CLOSED  
(LEFT SIDE CLOSURE SIMILAR)  
NOT TO SCALE

PROJECT NAME: HARTLAND  
PROJECT NUMBER: BHF BPNT(12)

FILE NAME: zllc260+cdgn  
PROJECT LEADER: M.A. COLGAN  
DESIGNED BY: E.A. FIALA  
TRAFFIC CONTROL WITH TEMP. SIGNALS

PLOT DATE: 12/17/2013  
DRAWN BY: E.A. FIALA  
CHECKED BY: S.E. BURBANK  
SHEET 16 OF 55



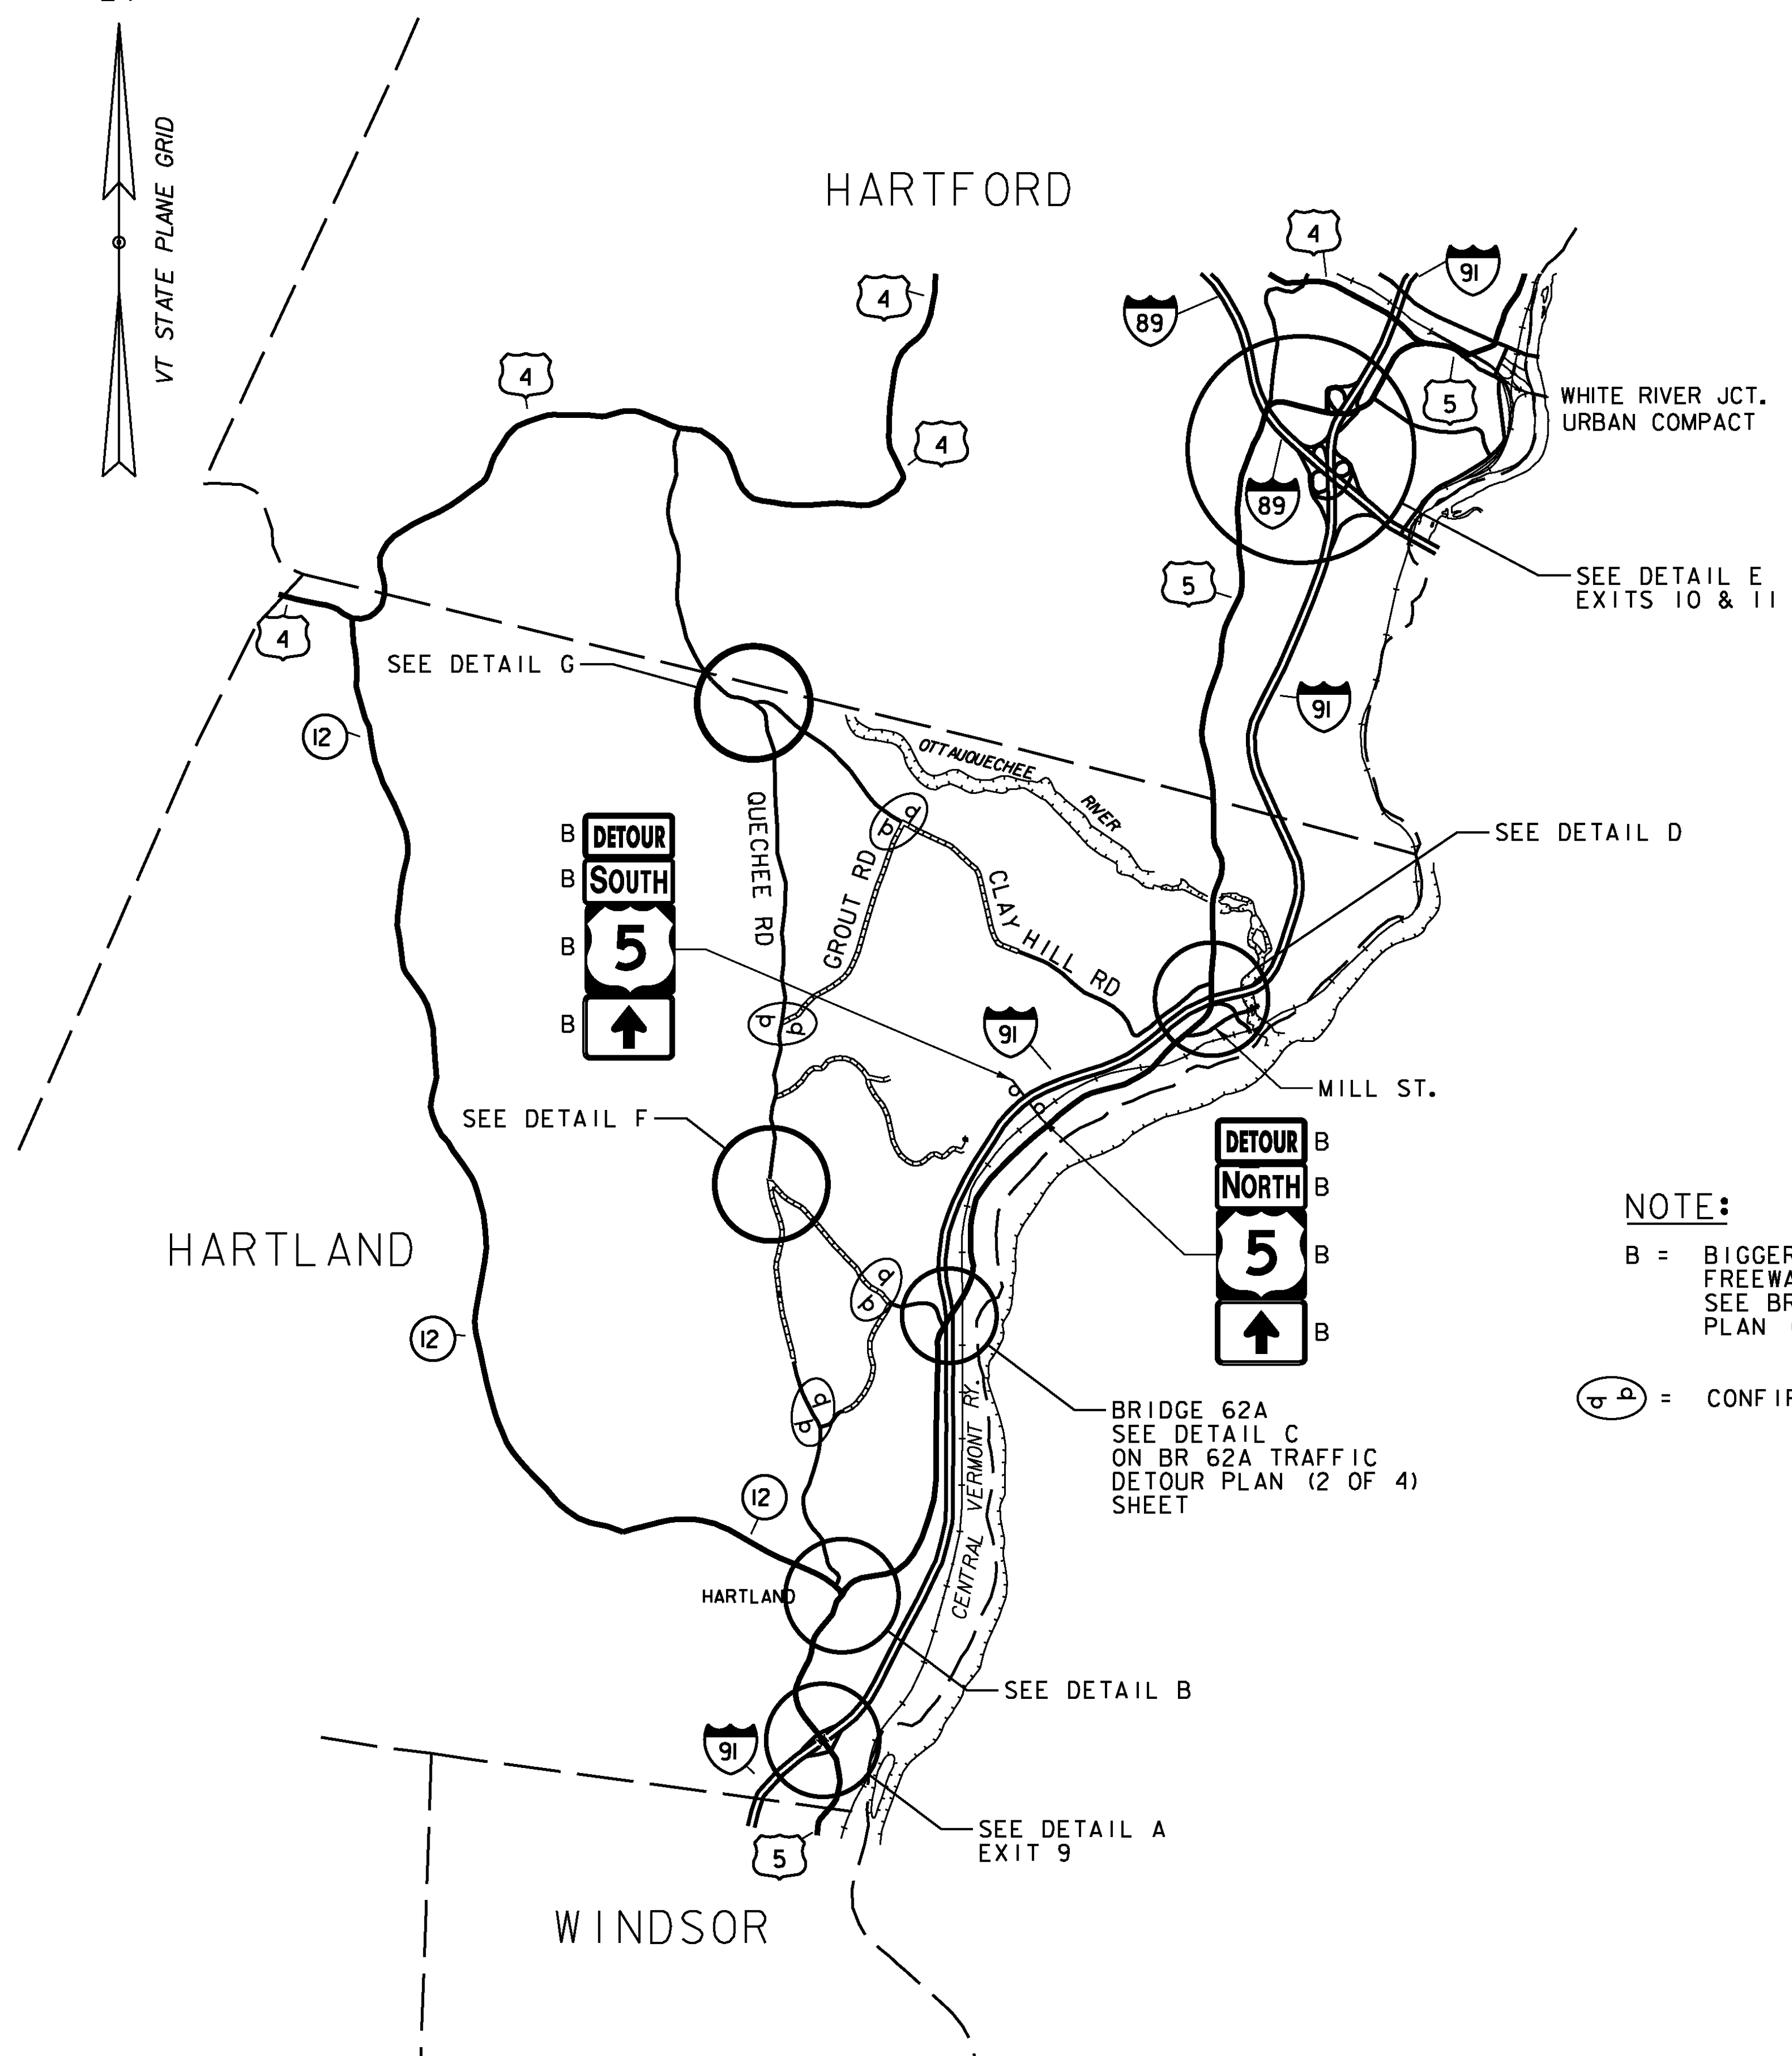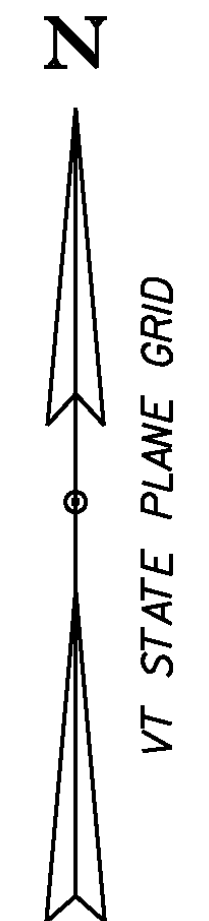


**NOTE:**

B = BIGGER SIGNS FOR FREEWAY SIGN STANDARD. SEE BR 62A TRAFFIC DETOUR PLAN (4 OF 4) SHEET.

= CONFIRMATORY BIKE DETOUR SIGNS

**TRAFFIC CONTROL NOTES:**

1. ALL SIGNS SHALL BE LOCATED SO THEY ARE VISIBLE AND ABLE TO BE READ BY THE TRAVELING PUBLIC. SIGNS SHALL BE INSTALLED SO AS NOT TO OBSTRUCT EXISTING SIGNS.
2. ALL SIGNS SHALL BE IN ACCORDANCE WITH THE CURRENT EDITIONS OF THE "MANUAL ON UNIFORM TRAFFIC CONTROL DEVICES" (MUTCD) AND THE "STANDARD HIGHWAY SIGNS" BOOK (SHS) PUBLISHED BY THE FEDERAL HIGHWAY ADMINISTRATION (FHWA).
3. SOLID SUBSTRATE CONSTRUCTION SIGNS SHALL HAVE RETROREFLECTIVE SHEETING EQUAL TO OR EXCEEDING "AMERICAN SOCIETY FOR TESTING MATERIALS" (ASTM D 4956) TYPE VII, VIII, IX REQUIREMENTS, UNLESS OTHERWISE NOTED. SOLID SUBSTRATE REGULATORY SIGNS (WHITE BACKGROUND) SHALL HAVE A RETROREFLECTIVE SHEETING EQUAL TO OR EXCEEDING ASTM D 4956 TYPE III.
4. SIGNS SHALL BE ERECTED BEFORE THE START OF ANY WORK AND SHALL BE COVERED UNTIL WORK COMMENCES, AND UPON COMPLETION OF THE WORK. EACH SIGN SHALL BE ERECTED IN A NEAT AND WORKMANLIKE MANNER. SIGNS SHALL BE REMOVED UPON COMPLETION OF THE WORK AT THE DISCRETION OF THE ENGINEER.
5. FIXED SIGNS SHALL BE SET SECURELY IN THE GROUND. THE BOTTOM OF A SIGN SHALL BE AT LEAST SEVEN FEET ABOVE THE EDGE OF PAVEMENT. THE NEAREST EDGE OF A SIGN SHALL BE AT LEAST SIX FEET OUTSIDE THE SHOULDER POINT OR FOUR FEET OUTSIDE GUARDRAIL. ALL SIGNS SHALL BE INSTALLED WITHIN VTRANS OR TOWN'S RIGHT-OF-WAY (ROW). IF THE SIGN CANNOT BE INSTALLED IN THE ROW, THE CONTRACTOR SHALL GET PERMISSION FROM THE LANDOWNER.
6. WHERE SIGN INSTALLATIONS ARE NOT PROTECTED BY GUARDRAIL OR OTHER APPROVED TRAFFIC BARRIERS, ALL SIGN STANDS AND POST INSTALLATIONS SHALL BE "NATIONAL COOPERATIVE HIGHWAY RESEARCH PROGRAM" (NCHRP) REPORT 350 COMPLIANT. NO SIGN POSTS SHALL EXTEND OVER THE TOP OF THE SIGN INSTALLED ON SAID POST(S). WHEN ANCHORS ARE INSTALLED, STUB SHALL NOT BE GREATER THAN FOUR INCHES ABOVE EXISTING GROUND.
7. WHEN EXISTING ROUTE MARKER ASSEMBLIES ARE LOCATED AT THE INTERSECTIONS OR ALONG THE DETOUR ROUTE, THE DETOUR ROUTE MARKER ASSEMBLIES SHALL BE INSTALLED ADJACENT TO THE EXISTING ROUTE MARKER ASSEMBLIES.
8. THE PORTABLE CHANGEABLE MESSAGE SIGNS (PCMS) SHALL BE USED IN ACCORDANCE WITH SECTION 6F.60 OF THE MUTCD. PORTABLE CHANGEABLE MESSAGE SIGNS (PCMS) SHALL BE PLACED OFF THE EDGE OF THE ROADWAY, OUTSIDE THE CLEAR ZONE, BUT SHALL BE VISIBLE FROM THE ROADWAY. ANY VEGETATION THAT INTERFERES WITH VISIBILITY OF THE PCMS SHALL BE REMOVED. THE MESSAGE SIGN SHALL BE A MINIMUM OF 7 FEET ABOVE THE ROADWAY IN URBAN AREAS AND 5 FEET ABOVE THE ROADWAY IN RURAL AREAS WHEN IT IS IN THE OPERATING MODE. REMOVAL OF THE VEGETATION SHALL BE INCIDENTAL TO ITEM 641.15, "PORTABLE CHANGEABLE MESSAGE SIGN". WHEN PLACED BEHIND GUARDRAIL, THE BOTTOM OF THE SIGN FACE SHALL BE ABOVE THE TOP OF THE GUARDRAIL.
9. SEE BR 62A TRAFFIC DETOUR PLAN (2 AND 3) FOR DETAILS A-G.
10. THE COSTS OF ALL DETOUR SIGNS AND REQUIRED SIGN POSTS & INSTALLATION SHALL BE INCLUDED IN ITEM 641.10, "TRAFFIC CONTROL".


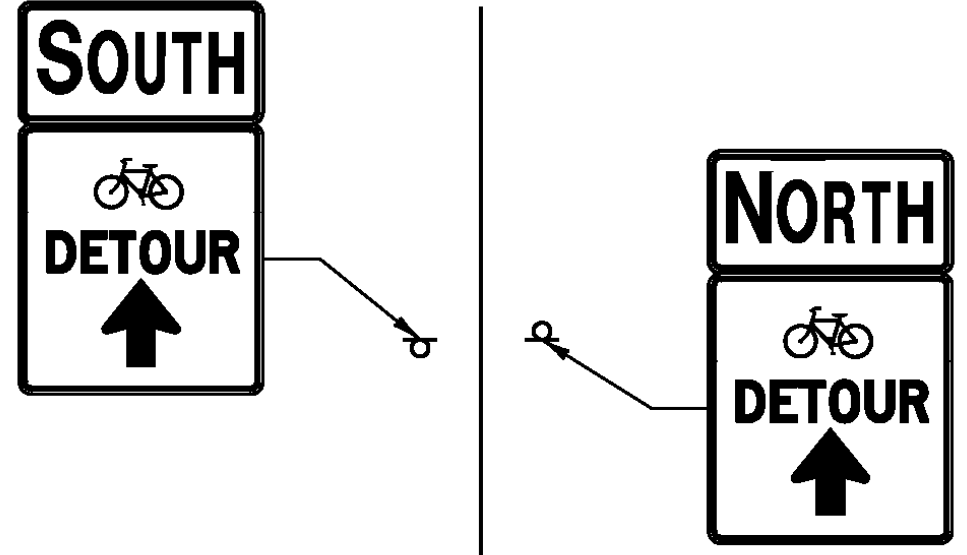


CONFIRMATORY BIKE DETOUR SIGNS  
NOT TO SCALE

TRAFFIC CONTROL PLAN






PROJECT NAME: HARTLAND	PLOT DATE: 12/17/2013
PROJECT NUMBER: BHF BPNT(12)	DRAWN BY: M.C. SCOTT
FILE NAME: zllc260detour.dgn	CHECKED BY: S.G. FARNSWORTH
PROJECT LEADER: M.A. COLGAN	SHEET 17 OF 55
DESIGNED BY: S.G. FARNSWORTH	
BR 62A TRAFFIC DETOUR PLAN (1 OF 4)	

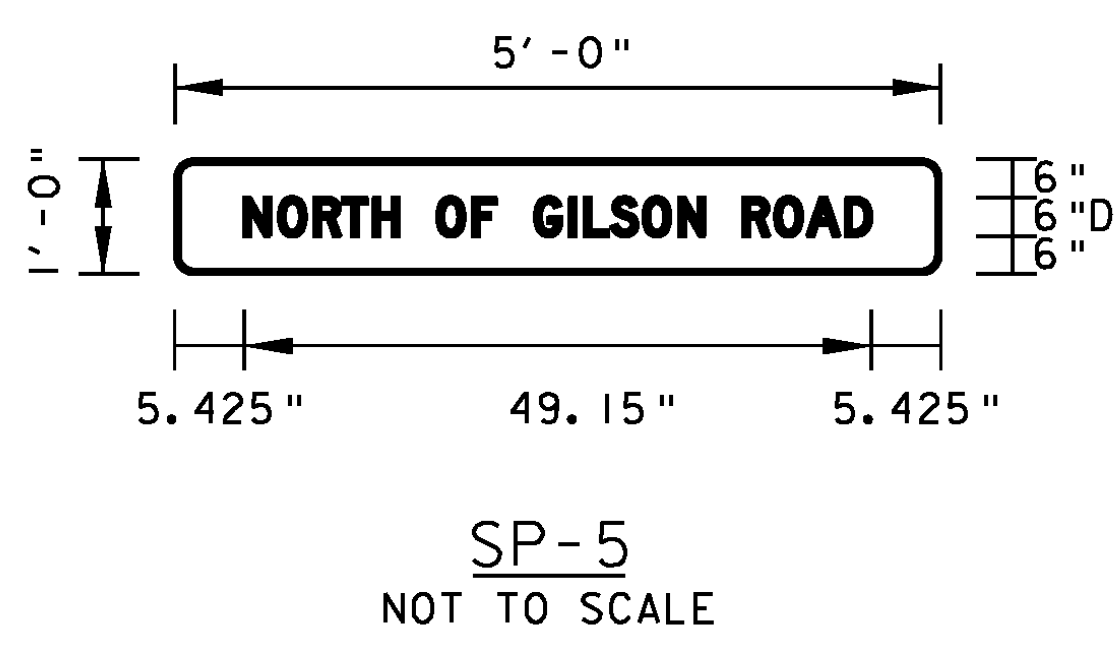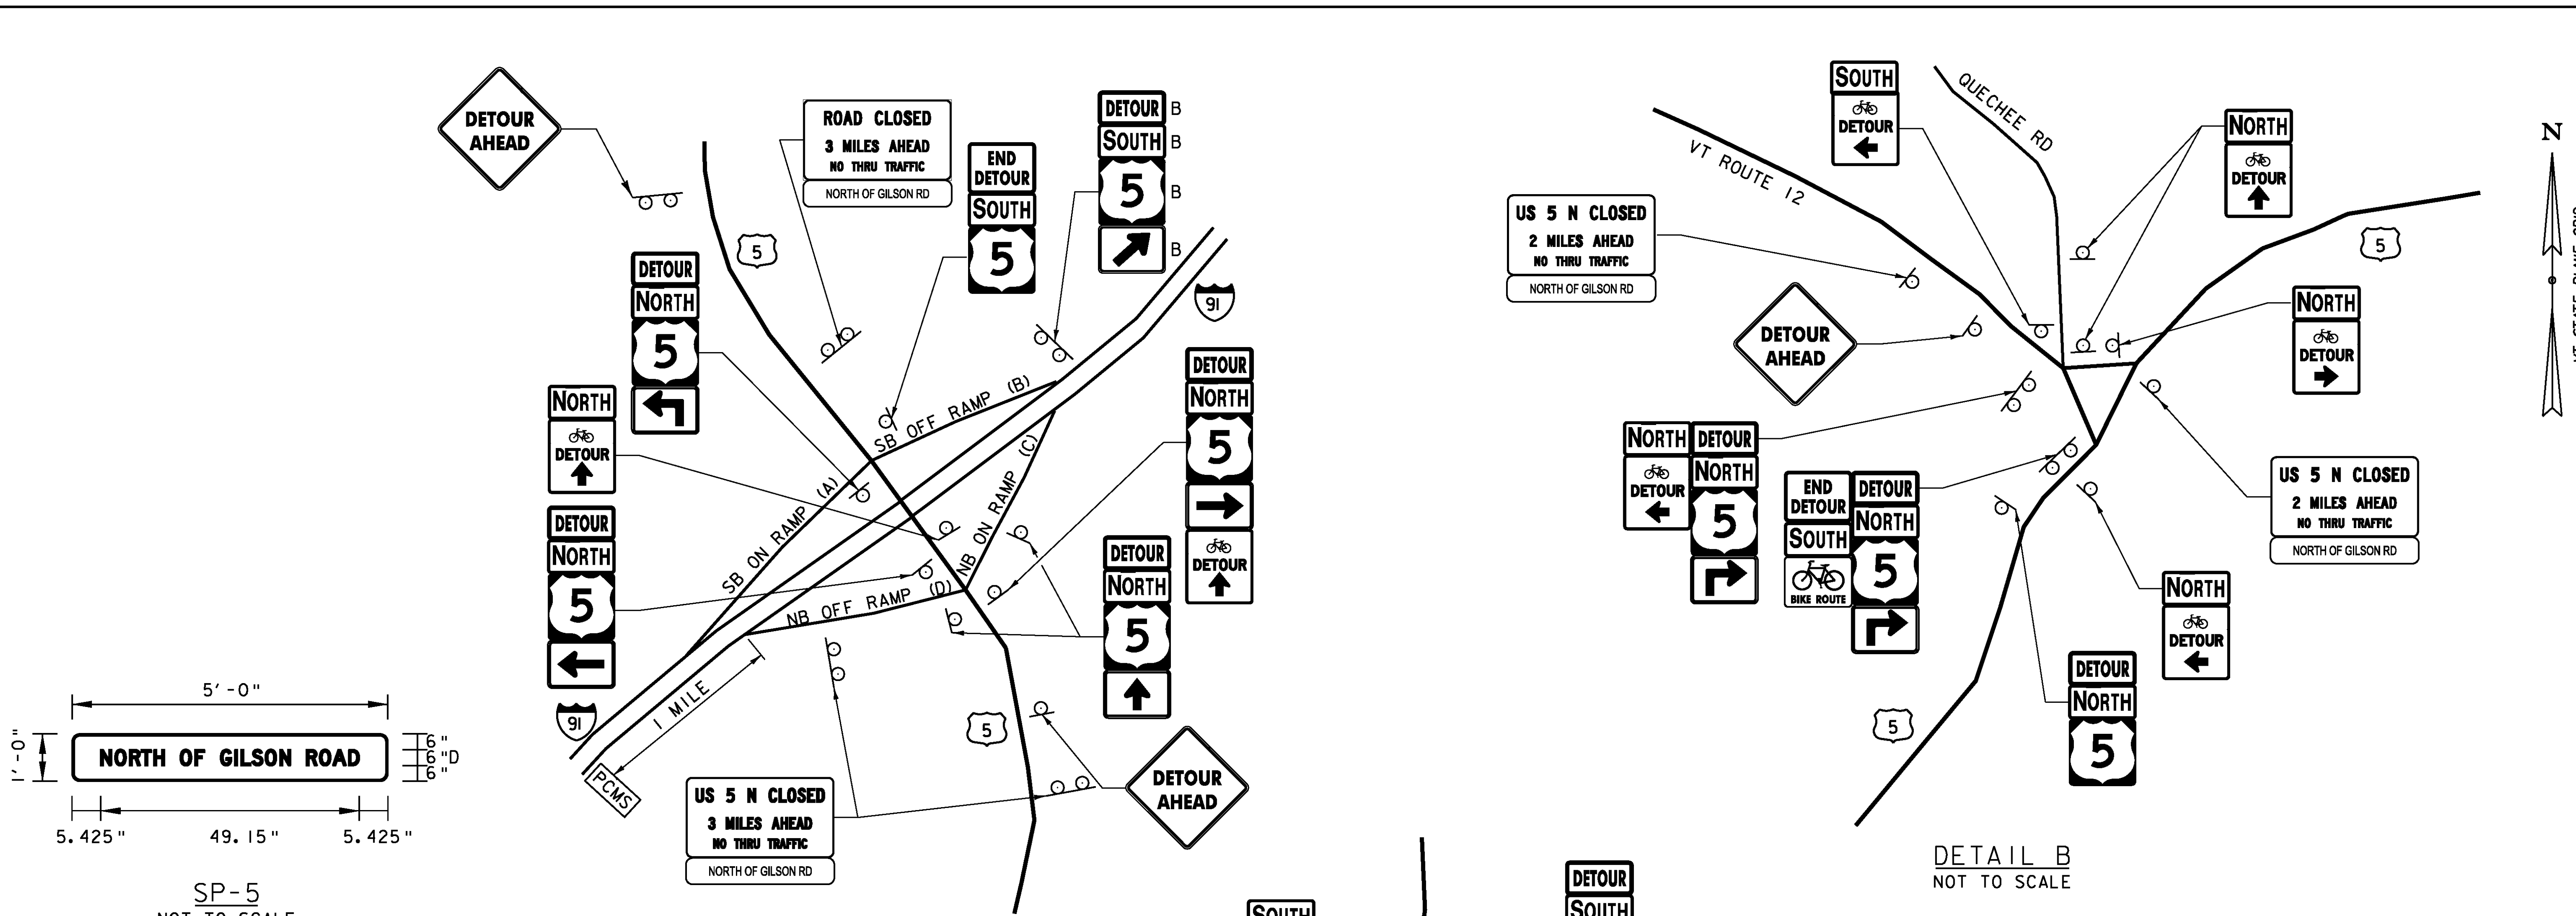

DETAIL A - EXIT 9  
NOT TO SCALE




DETAIL B  
NOT TO SCALE

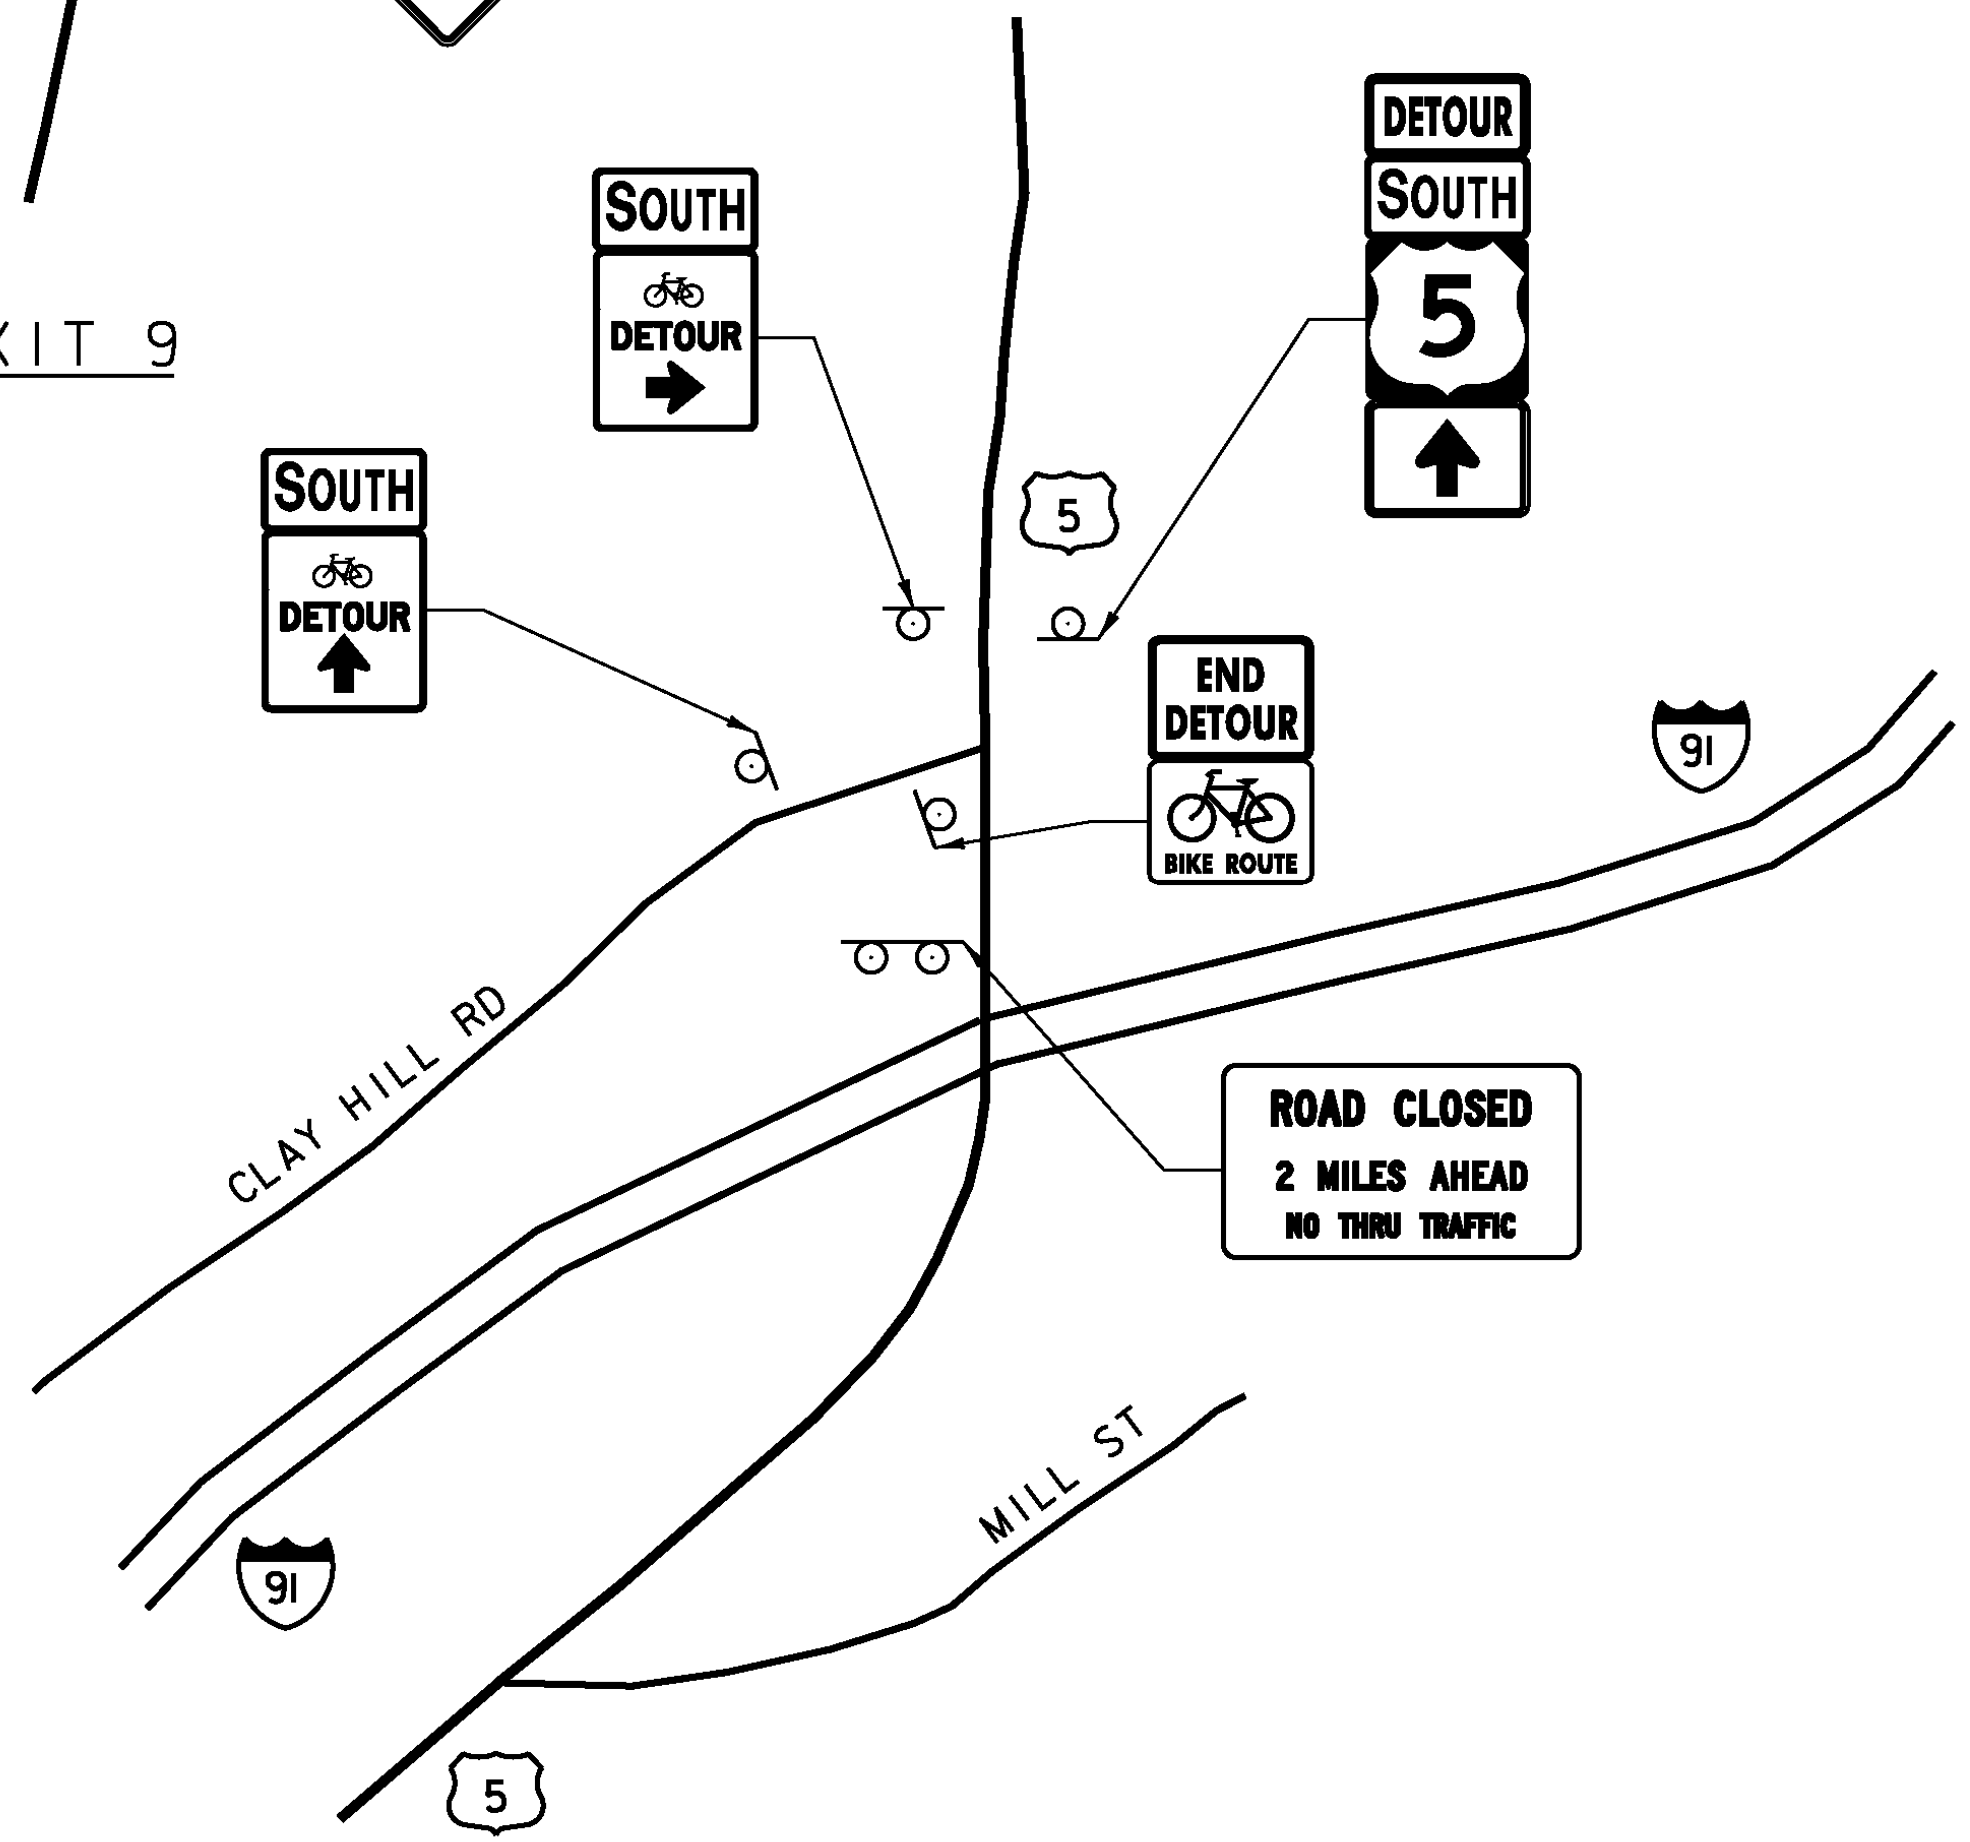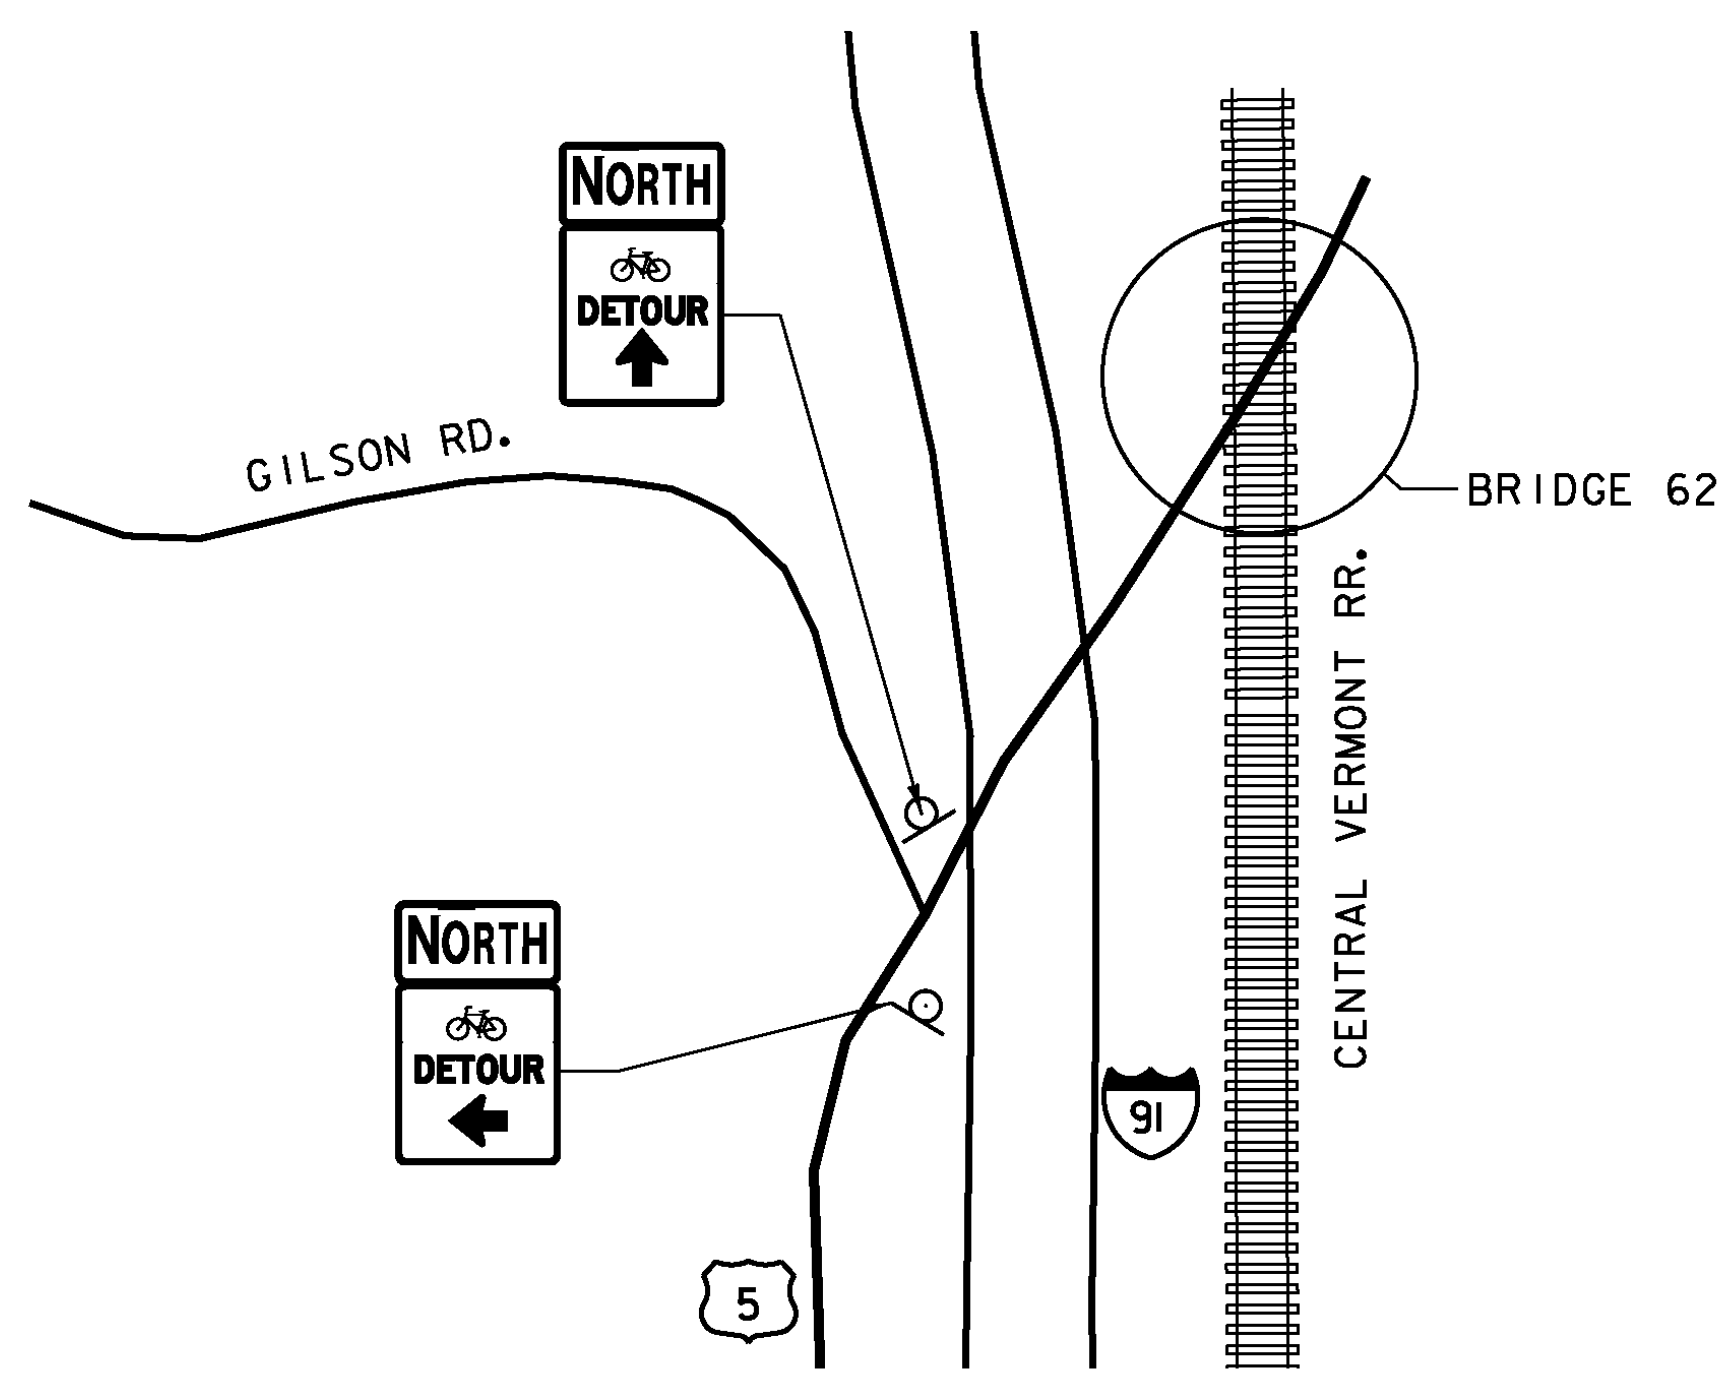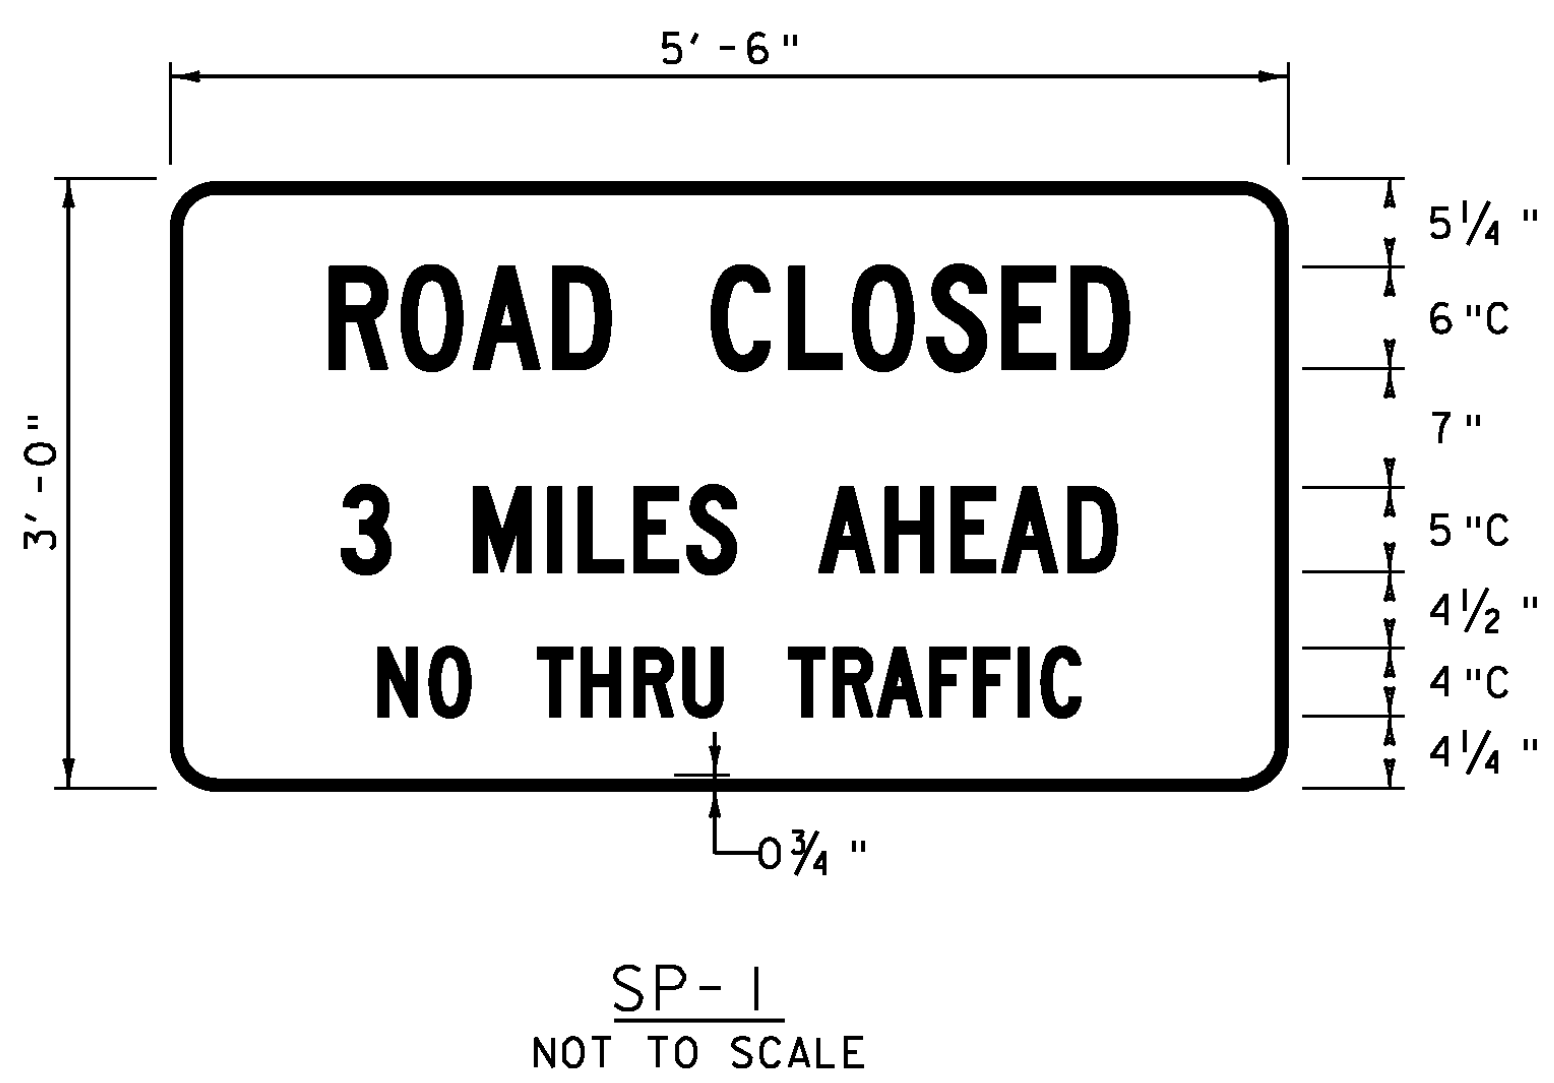

NOTE:  
1. SEE BR 62A TRAFFIC DETOUR PLAN (4 OF 4) FOR PCMS MESSAGES.

PROJECT NAME:	HARTLAND	PLOT DATE:	12/17/2013
PROJECT NUMBER:	BHF BPNT(12)	DRAWN BY:	M.C. SCOTT
FILE NAME:	z1lc260detour_details.dgn	CHECKED BY:	S.G. FARNSWORTH
PROJECT LEADER:	M.A. COLGAN	SHEET	18 OF 55
DESIGNED BY:	S.G. FARNSWORTH		
BR 62A TRAFFIC DETOUR PLAN (2 OF 4)			



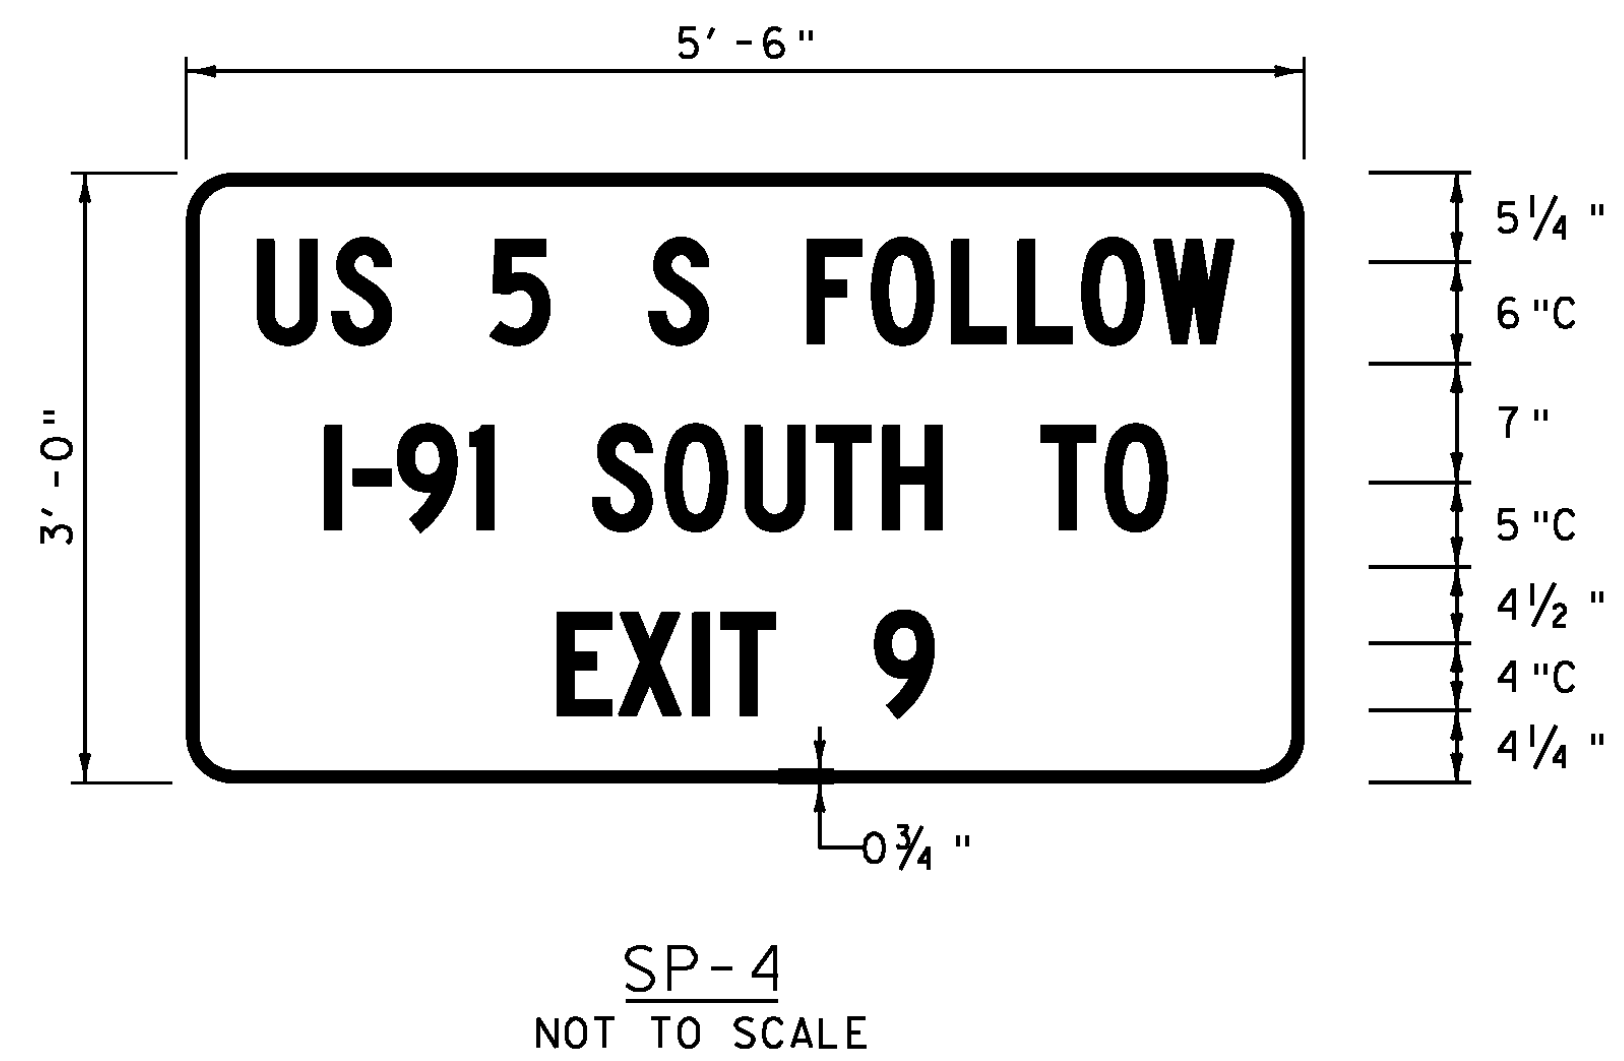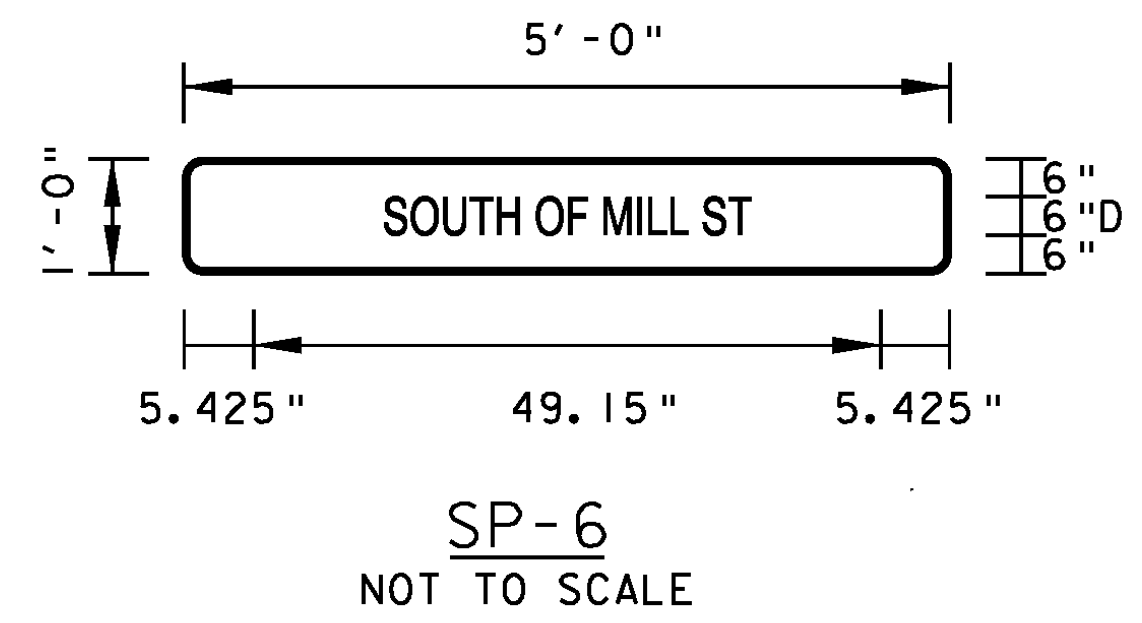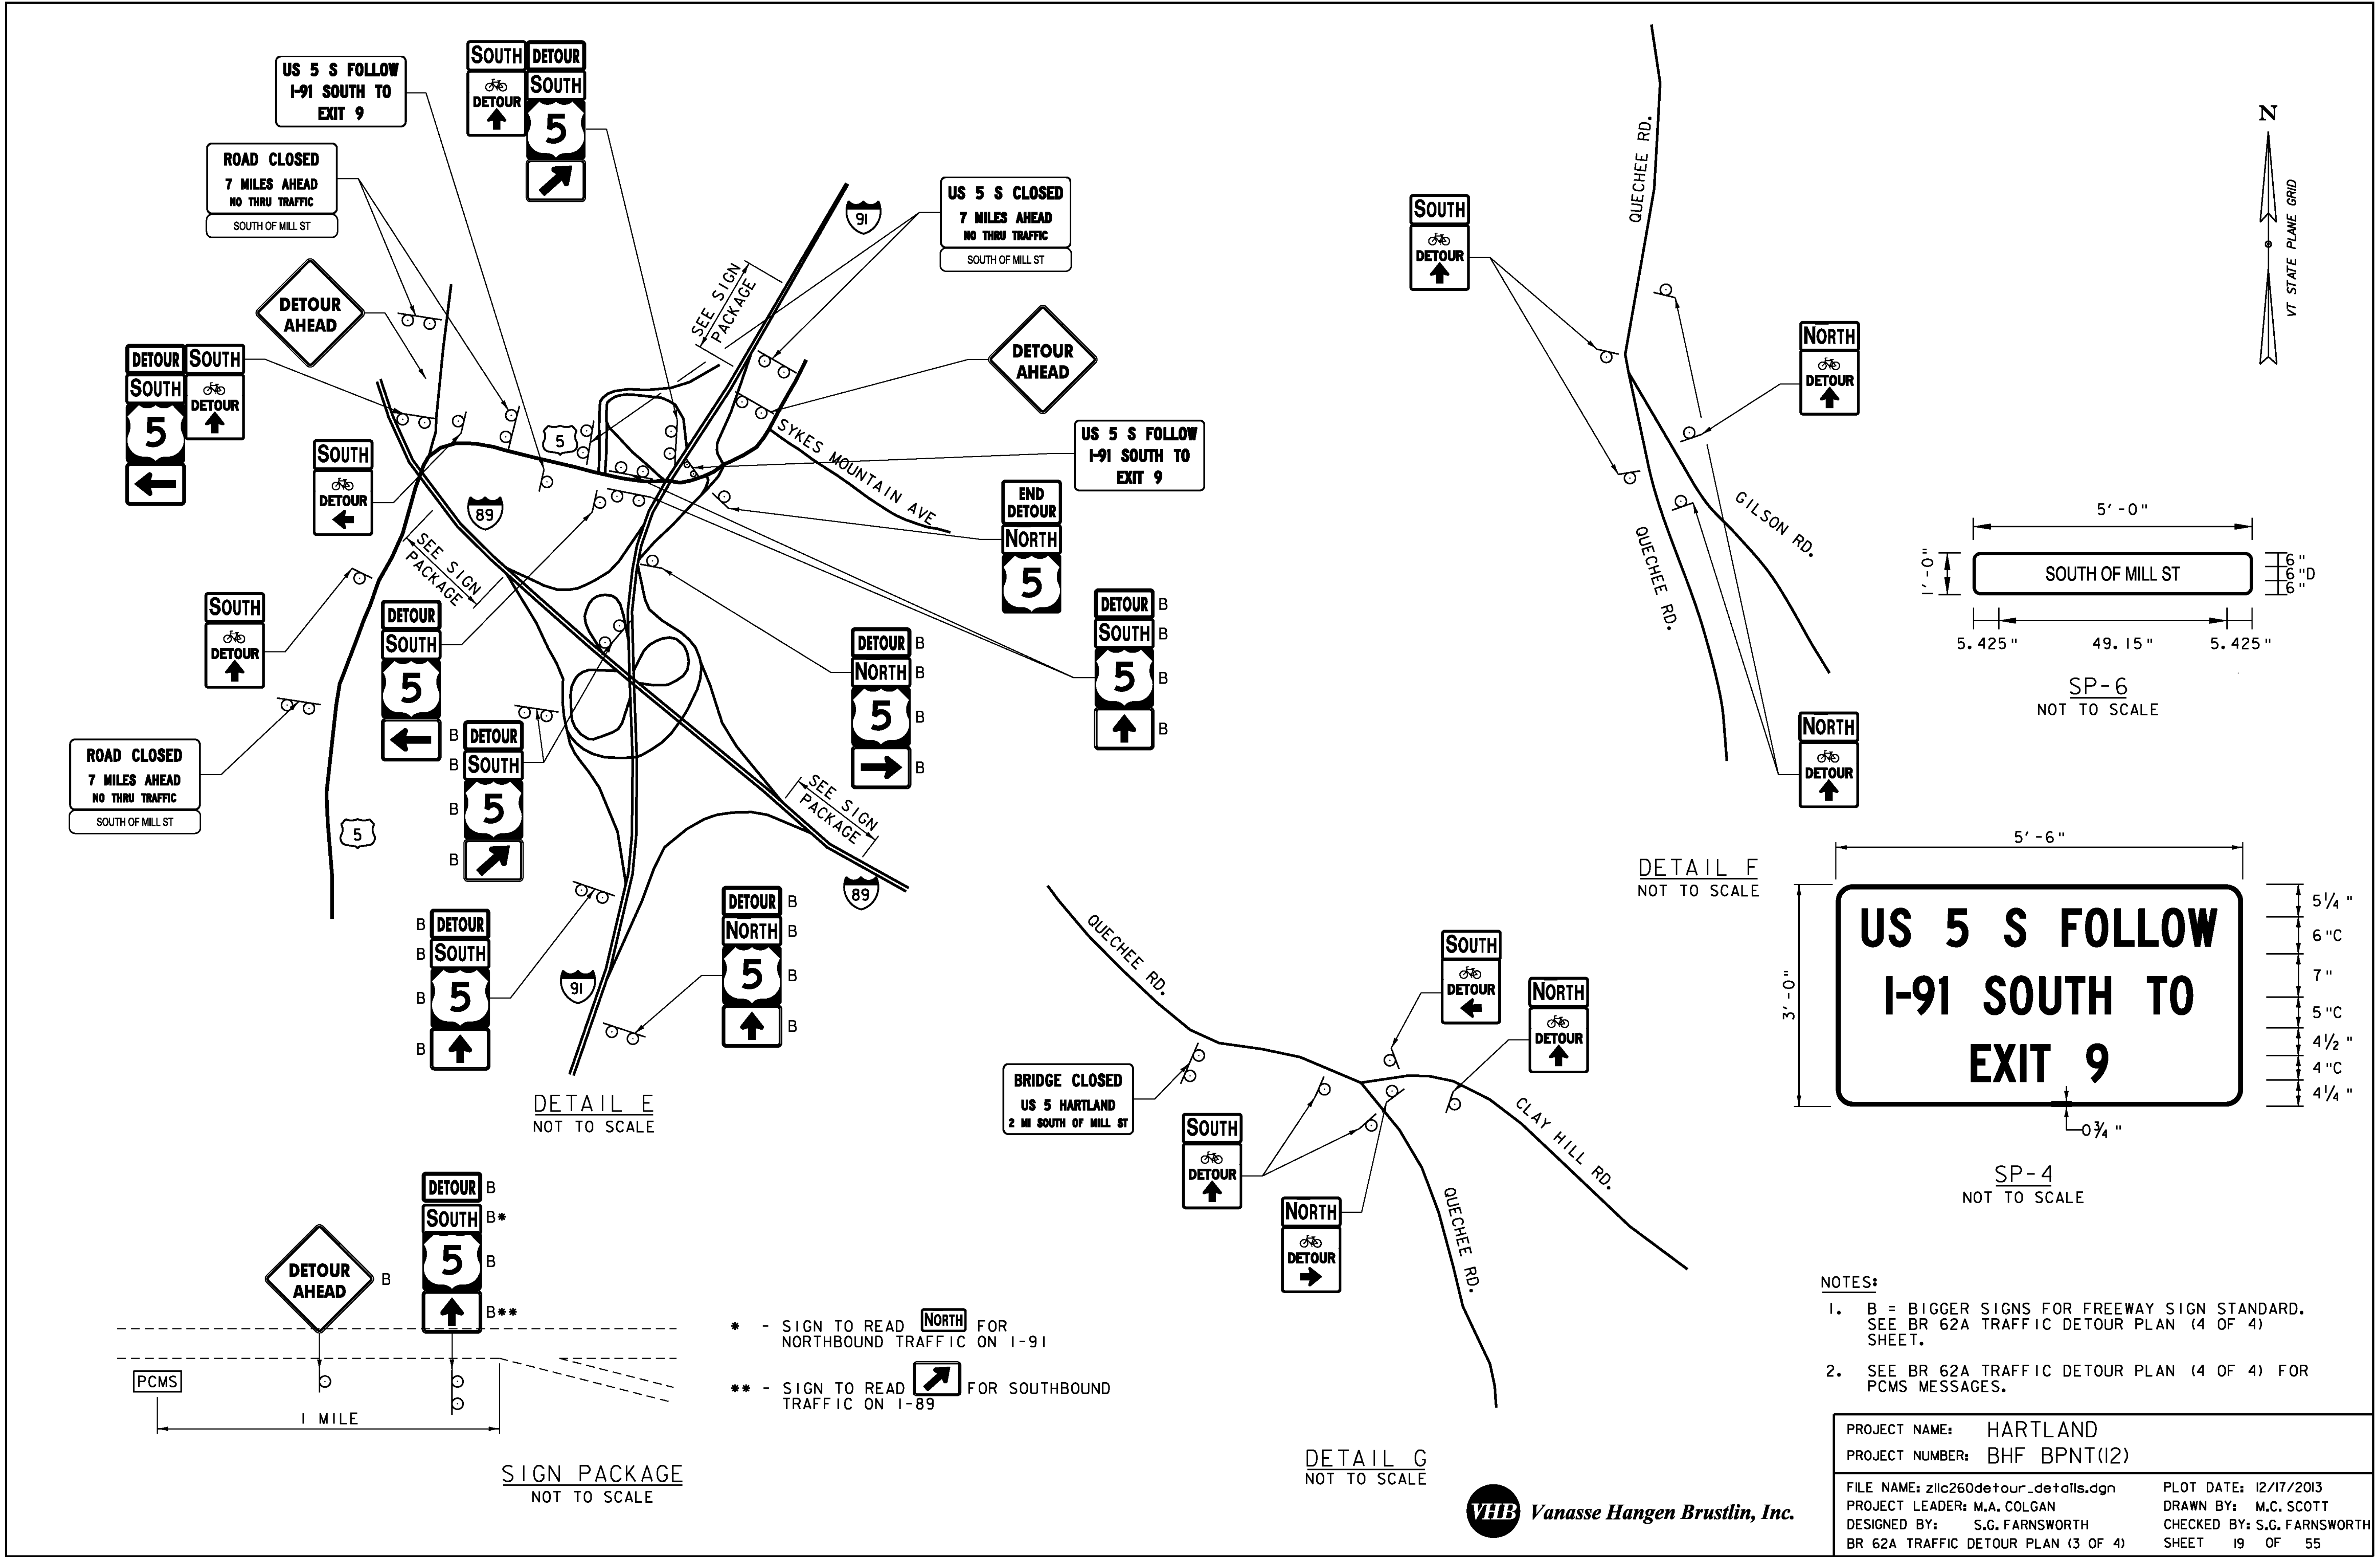

DETAIL E  
NOT TO SCALE

DETAIL F  
NOT TO SCALE

DETAIL G  
NOT TO SCALE

ROAD CLOSED  
7 MILES AHEAD  
NO THRU TRAFFIC  
SOUTH OF MILL ST

ROAD CLOSED  
7 MILES AHEAD  
NO THRU TRAFFIC  
SOUTH OF MILL ST

US 5 S CLOSED  
7 MILES AHEAD  
NO THRU TRAFFIC  
SOUTH OF MILL ST

US 5 S FOLLOW  
I-91 SOUTH TO  
EXIT 9

BRIDGE CLOSED  
US 5 HARTLAND  
2 MI SOUTH OF MILL ST

DETOUR AHEAD

DETOUR AHEAD

DETOUR AHEAD

DETOUR SOUTH 5

DETOUR SOUTH 5

DETOUR SOUTH 5

DETOUR NORTH 5

DETOUR NORTH 5

DETOUR SOUTH 5

SOUTH  
DETOUR

NORTH  
DETOUR

NORTH  
DETOUR

NORTH  
DETOUR

DETOUR SOUTH 5

DETOUR SOUTH 5

* - SIGN TO READ NORTH FOR NORTHBOUND TRAFFIC ON I-91

** - SIGN TO READ [arrow] FOR SOUTHBOUND TRAFFIC ON I-89

SIGN PACKAGE  
NOT TO SCALE

- NOTES:
- B = BIGGER SIGNS FOR FREEWAY SIGN STANDARD. SEE BR 62A TRAFFIC DETOUR PLAN (4 OF 4) SHEET.
  - SEE BR 62A TRAFFIC DETOUR PLAN (4 OF 4) FOR PCMS MESSAGES.

PROJECT NAME:	HARTLAND	PLOT DATE:	12/17/2013
PROJECT NUMBER:	BHF BPNT(12)	DRAWN BY:	M.C. SCOTT
FILE NAME:	z1lc260detour_details.dgn	CHECKED BY:	S.G. FARNSWORTH
PROJECT LEADER:	M.A. COLGAN	SHEET	19 OF 55
DESIGNED BY:	S.G. FARNSWORTH		

IDENTIFICATION NUMBER	SIZE OF SIGN		TEXT	NUMBER OF SIGNS REQ'D	REMARKS
	WIDTH (IN)	HEIGHT (IN)			
D11-1	24	18		2	MOUNT BELOW THE M4-8A
M1-4	24	24		16	---
M1-4-B	36	36		11	---
M3-1	24	12		25*	---
M3-1-B	36	18		4	---
M3-3	24	12		25*	---
M3-3-B	36	18		8	---
M4-8	24	12		14	MOUNT ABOVE THE M3-1 OR M3-3
M4-8-B	36	18		12	MOUNT ABOVE THE M3-1-B OR M3-3-B
M4-8A	24	18		4	MOUNT ABOVE THE M3-1 OR M3-3 OR W11-1
M4-9CR	30	24		3	---
M4-9CL	30	24		6	---
M4-9CT	30	24		25	---
M5-1L	21	15		1	MOUNT BELOW THE MI-4
M5-1R	21	15		2	MOUNT BELOW THE MI-4
M6-1L	21	15		3	MOUNT BELOW THE MI-4
M6-1R	21	15		1	MOUNT BELOW THE MI-4
M6-1R-B	30	21		1	MOUNT BELOW THE MI-4



IDENTIFICATION NUMBER	SIZE OF SIGN		TEXT	NUMBER OF SIGNS REQ'D	REMARKS
	WIDTH (IN)	HEIGHT (IN)			
M6-2R	21	15		1	MOUNT BELOW THE MI-4-B
M6-2R-B	30	21		4	MOUNT BELOW THE MI-4-B
M6-3	21	15		3	MOUNT BELOW THE MI-4
M6-3-B	30	21		7	MOUNT BELOW THE MI-6A
SP-1A	66	36		1	MOUNT ON TWO POSTS
SP-1B	66	36		3	MOUNT ON TWO POSTS
SP-1C	66	36		1	MOUNT ON TWO POSTS
SP-2	66	36		1	MOUNT ON TWO POSTS
SP-3	66	36		2	MOUNT ON TWO POSTS
SP-4	66	36		2	MOUNT ON TWO POSTS
SP-5	60	12		5	MOUNT BELOW THE SP-1 OR SP-3
SP-6	60	12		5	MOUNT BELOW THE SP-1
SP-7	66	36		2	MOUNT ON TWO POSTS
SP-8	66	36		2	MOUNT ON TWO POSTS
W20-2	36	36		5	MOUNT ON TWO POSTS
W20-2-B	48	48		4	MOUNT ON TWO POSTS

* - NUMBER OF SIGNS REQ'D ASSUMING APPROXIMATELY 4 LOCATIONS OF CONFIRMATORY BIKE DETOUR SIGNS

NOTES:

- ONLY THE TEMPORARY DETOUR SIGNS ARE SHOWN ON THIS SHEET. THE TRAFFIC CONTROL SIGNS WITH SIGNALS AND FLAGGERS ARE NOT SHOWN.
- COLORS FOR THE M1-4, M3-1, AND M3-3 SIGNS SHALL MATCH THE COLORS SHOWN ON VTRANS STD. E-136A.
- COLORS FOR M5-1L, M5-1R, M6-1L, M6-1R, M6-1L AND SP-3 SIGNS SHALL BE A BLACK ARROW AND BORDER ON A RETROREFLECTIVE ORANGE BACKGROUND.
- COLORS FOR THE SP-1, SP-2, SP-3, SP-4, SP-5 AND SP-6 SIGNS SHALL BE BLACK TEXT AND BORDER ON RETROREFLECTIVE WHITE BACKGROUND.
- TWO ORANGE FLAGS (ONE EACH SIDE) SHALL BE PLACED AT THE TOP OF THE SP-1, SP-2, SP-3 AND SP-4 SIGN.
- M1-4, M1-4-B, M3-1, M3-1-B, M3-3, AND M3-3-B SIGNS SHALL BECOME THE PROPERTY OF THE STATE OF VERMONT AFTER THEY ARE REMOVED FROM THE DETOUR. THE CONTRACTOR SHALL DELIVER THE SIGNS TO THE STATE AT THE STATE GARAGE LOCATED AT 226 BESWICK DR, WHITE RIVER JUNCTION, VT. CONTACT THE STATE FOREMAN, TREVOR STARR AT (802) 295-8888. ALL COSTS ASSOCIATED WITH PROVIDING THE SIGNS TO THE STATE SHALL BE INCIDENTAL TO ITEM 641.10 "TRAFFIC CONTROL".
- COLORS FOR D11-1, M4-8, M4-8-B, M4-8A, M4-9CR, M4-9CL AND M4-9CT SHALL BE BLACK TEXT AND BORDER ON RETROREFLECTIVE ORANGE BACKGROUND.
- SEE TRAFFIC DETOUR PLAN BR 62A (2 & 3 OF 4) FOR SP-4, SP-5, AND SP-6 LAYOUT MEASUREMENTS.
- SP-7 SIGN SAME AS SP-3 BUT WITH "3 MILES AHEAD".

NORTHBOUND SIGN		SOUTHBOUND SIGN	
PHASE 1	PHASE 2	PHASE 1	PHASE 2
<b>US 5</b>	<b>NORTH OF</b>	<b>US 5</b>	<b>2 MILES</b>
<b>NORTH</b>	<b>N. GILSON</b>	<b>SOUTH</b>	<b>SOUTH OF</b>
<b>CLOSED</b>	<b>ROAD</b>	<b>CLOSED</b>	<b>MILL ST</b>

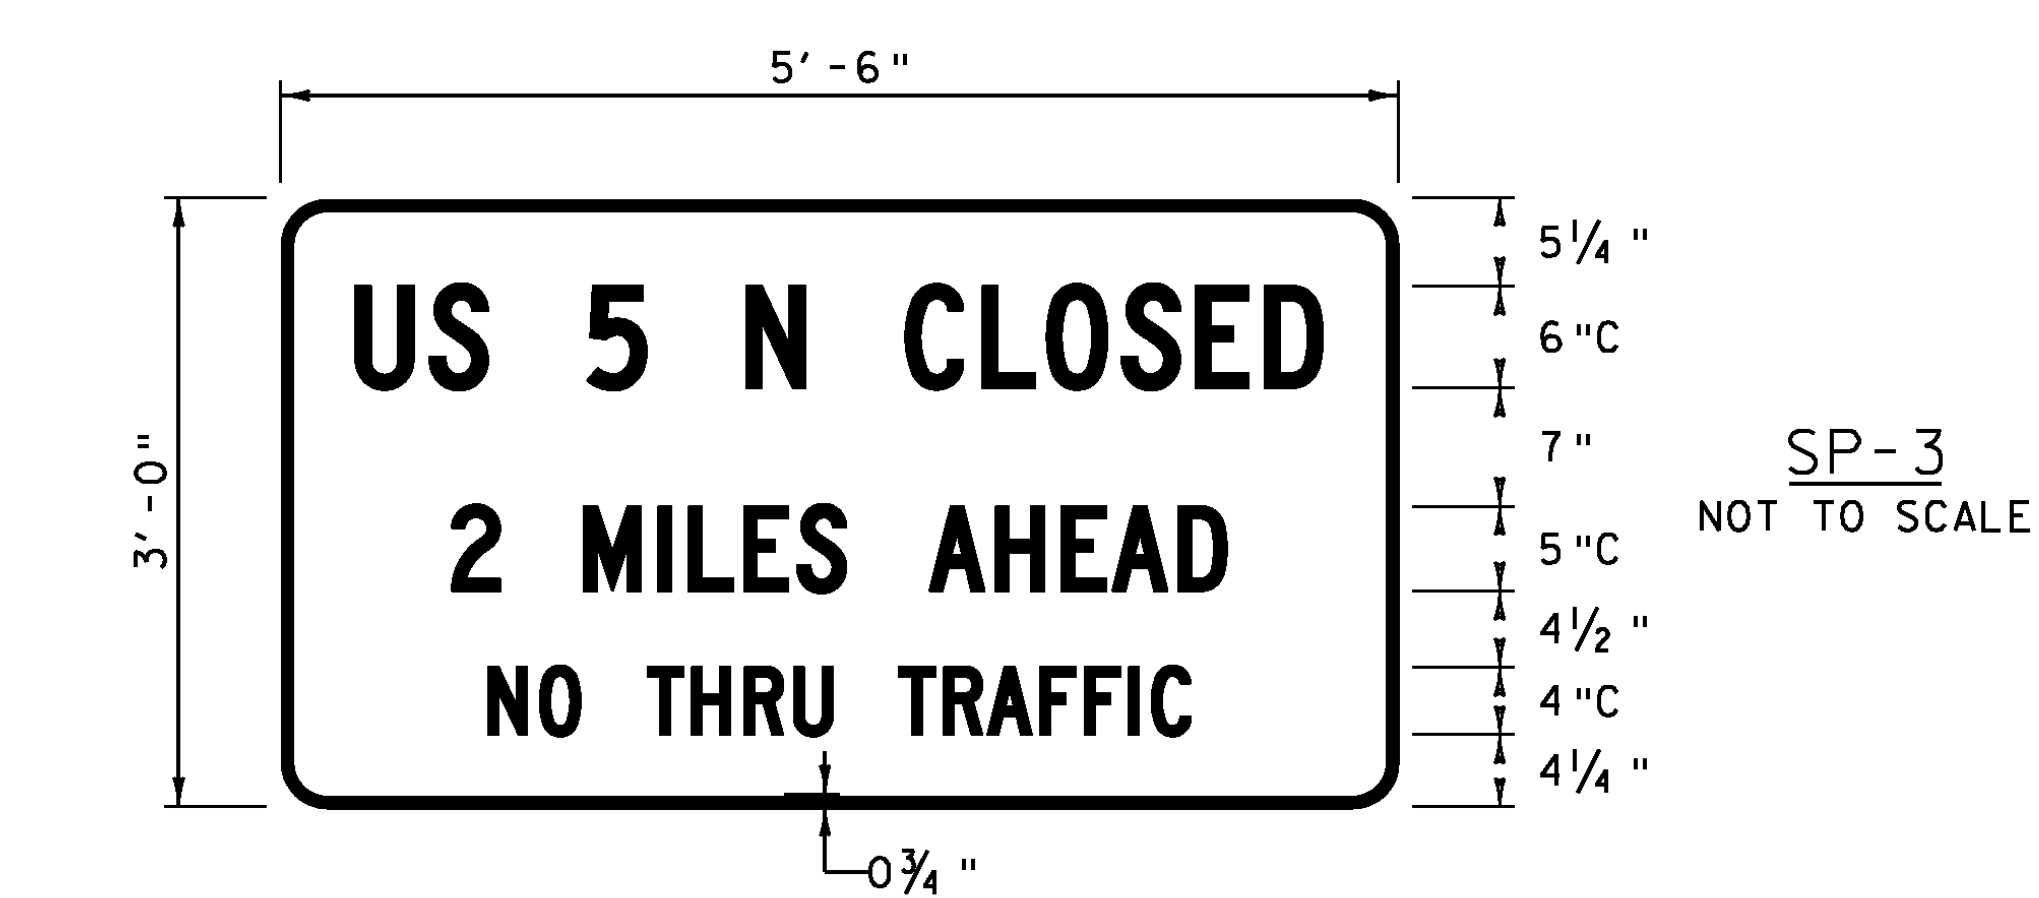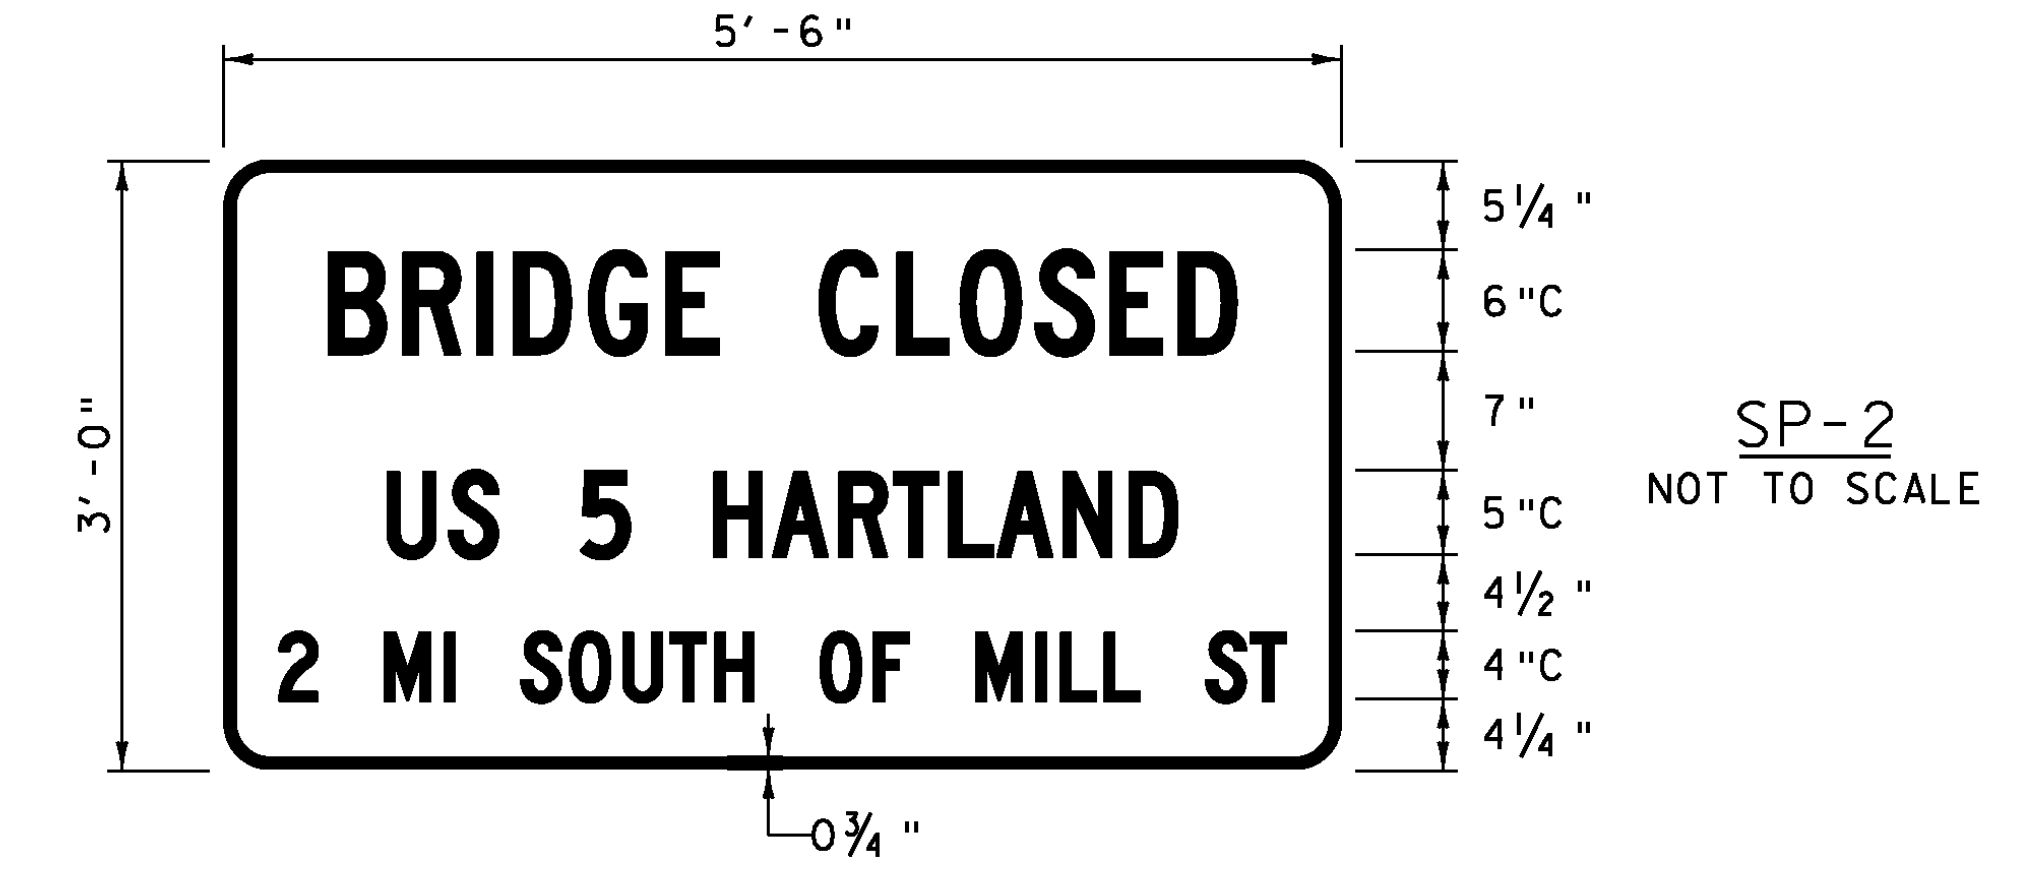


PROJECT NAME: HARTLAND	PLOT DATE: 12/17/2013
PROJECT NUMBER: BHF BPNT(12)	DRAWN BY: M.C. SCOTT
FILE NAME: z1lc260detour_details.dgn	CHECKED BY: S.G. FARNSWORTH
PROJECT LEADER: M.A. COLGAN	BR 62A TRAFFIC DETOUR PLAN (4 OF 4)
DESIGNED BY: S.G. FARNSWORTH	SHEET 20 OF 55





TRAFFIC SIGNS, TYPE A  
 STA. 11+69, RT  
 STA. 13+42, LT

4 INCH YELLOW LINE  
 STA. 11+00 - STA 14+02, LT & RT

4 INCH WHITE LINE  
 STA. 11+00 - 14+02, LT & RT

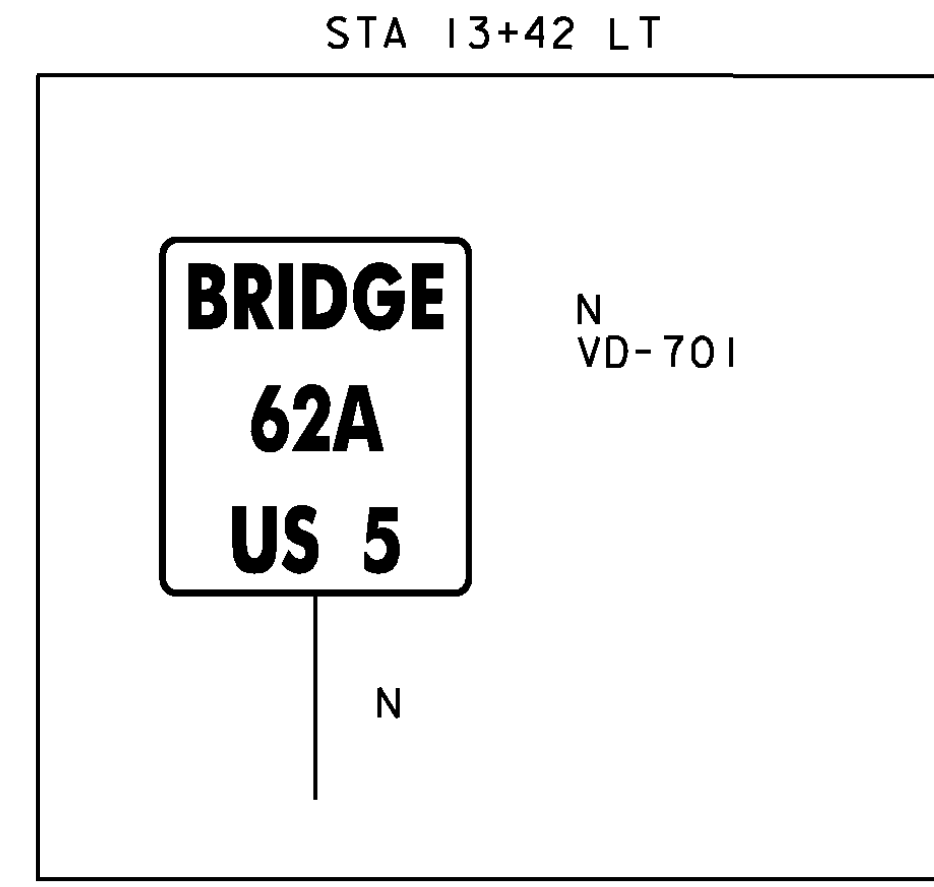


EXISTING STATE (UNOFFICIAL)  
 PULL OFF AREA AND FORMER  
 US 5 BRIDGE OVER I-91  
 STAGING AREA 2005

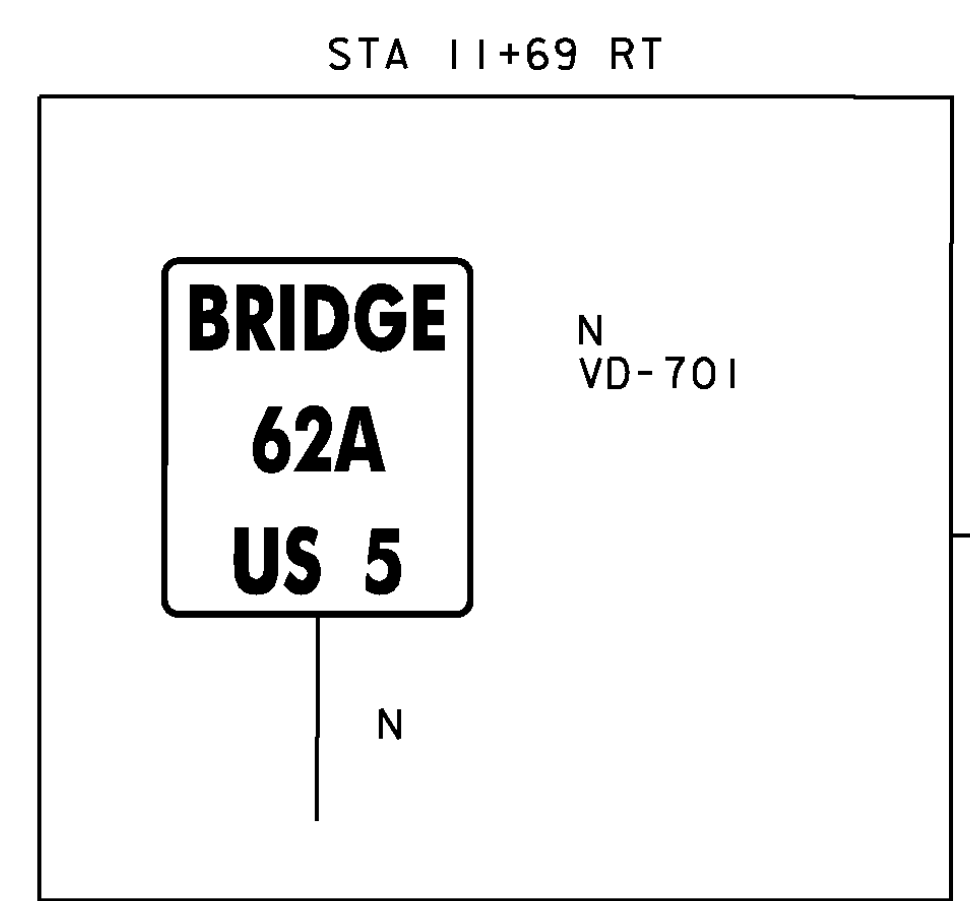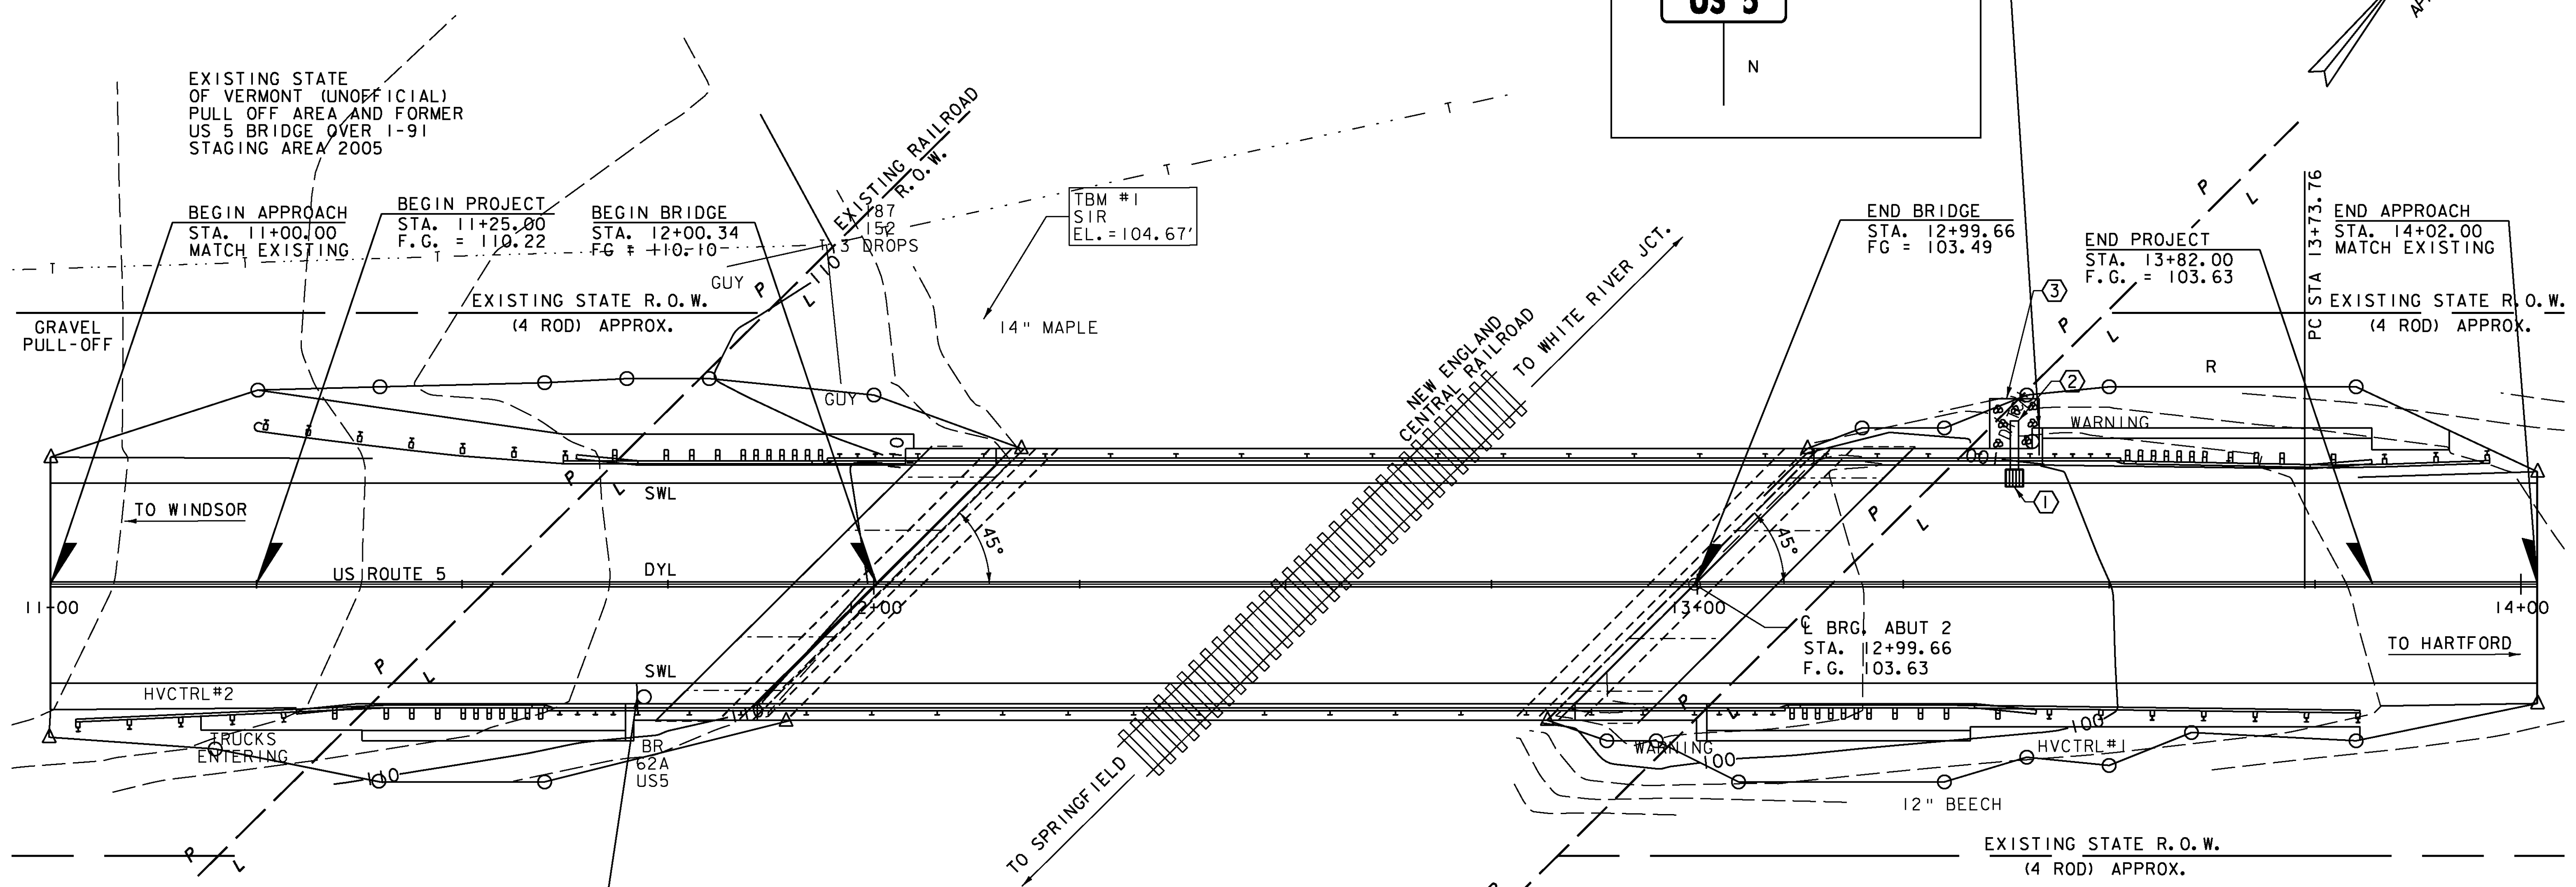

**SIGN LEGEND**  
 N = NEW  
 RET = RETAIN  
 R = REMOVAL  
 S = SALVAGE


**STRIPING LEGEND**  
 DYL = DOUBLE YELLOW LINE  
 SWL = SINGLE WHITE LINE

PROJECT NAME: HARTLAND	PLOT DATE: 12/17/2013
PROJECT NUMBER: BHF BPNT(12)	DRAWN BY: M.C. SCOTT
FILE NAME: zllc260+sl.dgn	CHECKED BY: S.G. FARNSWORTH
PROJECT LEADER: M.A. COLGAN	SHEET 21 OF 55
DESIGNED BY: M.C. SCOTT	

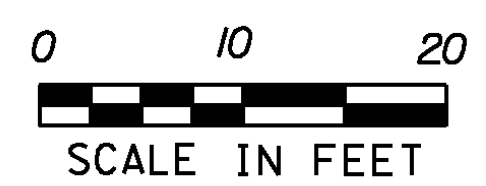




SEE REVISED SHEET

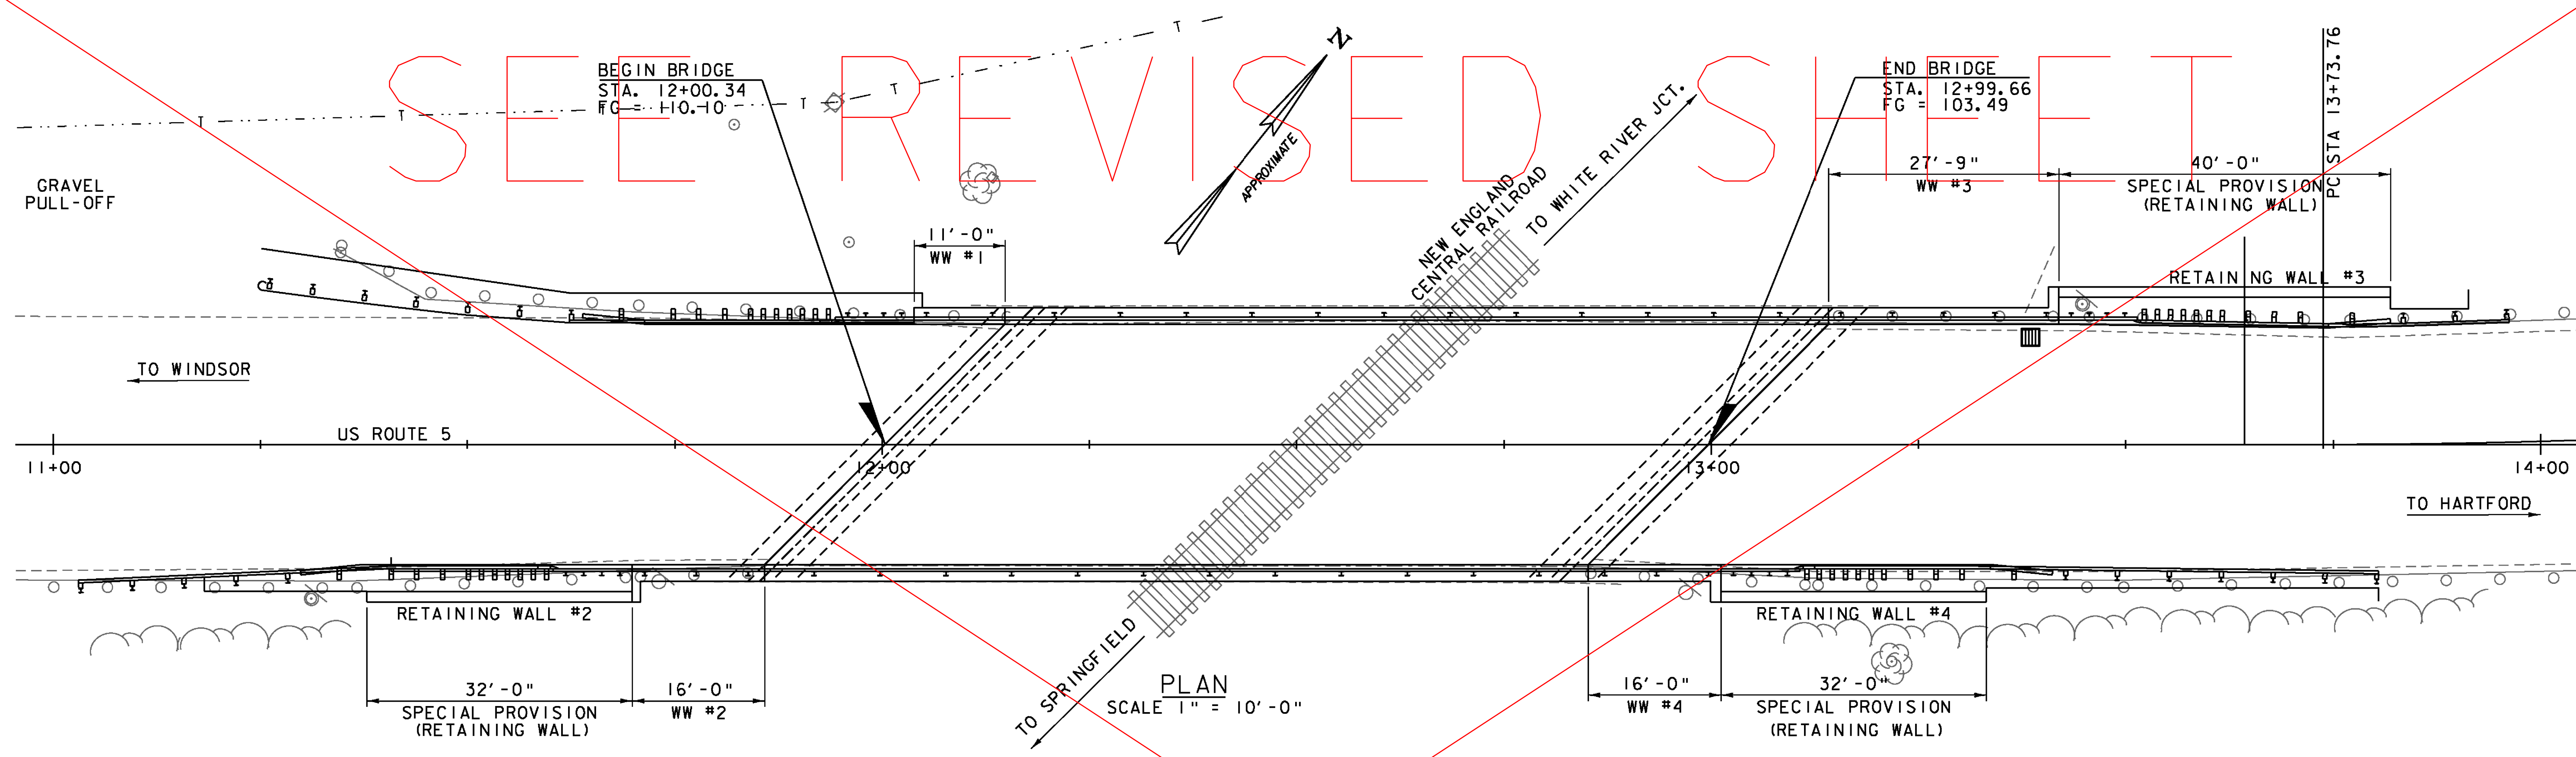

PLAN  
SCALE 1" = 10'-0"

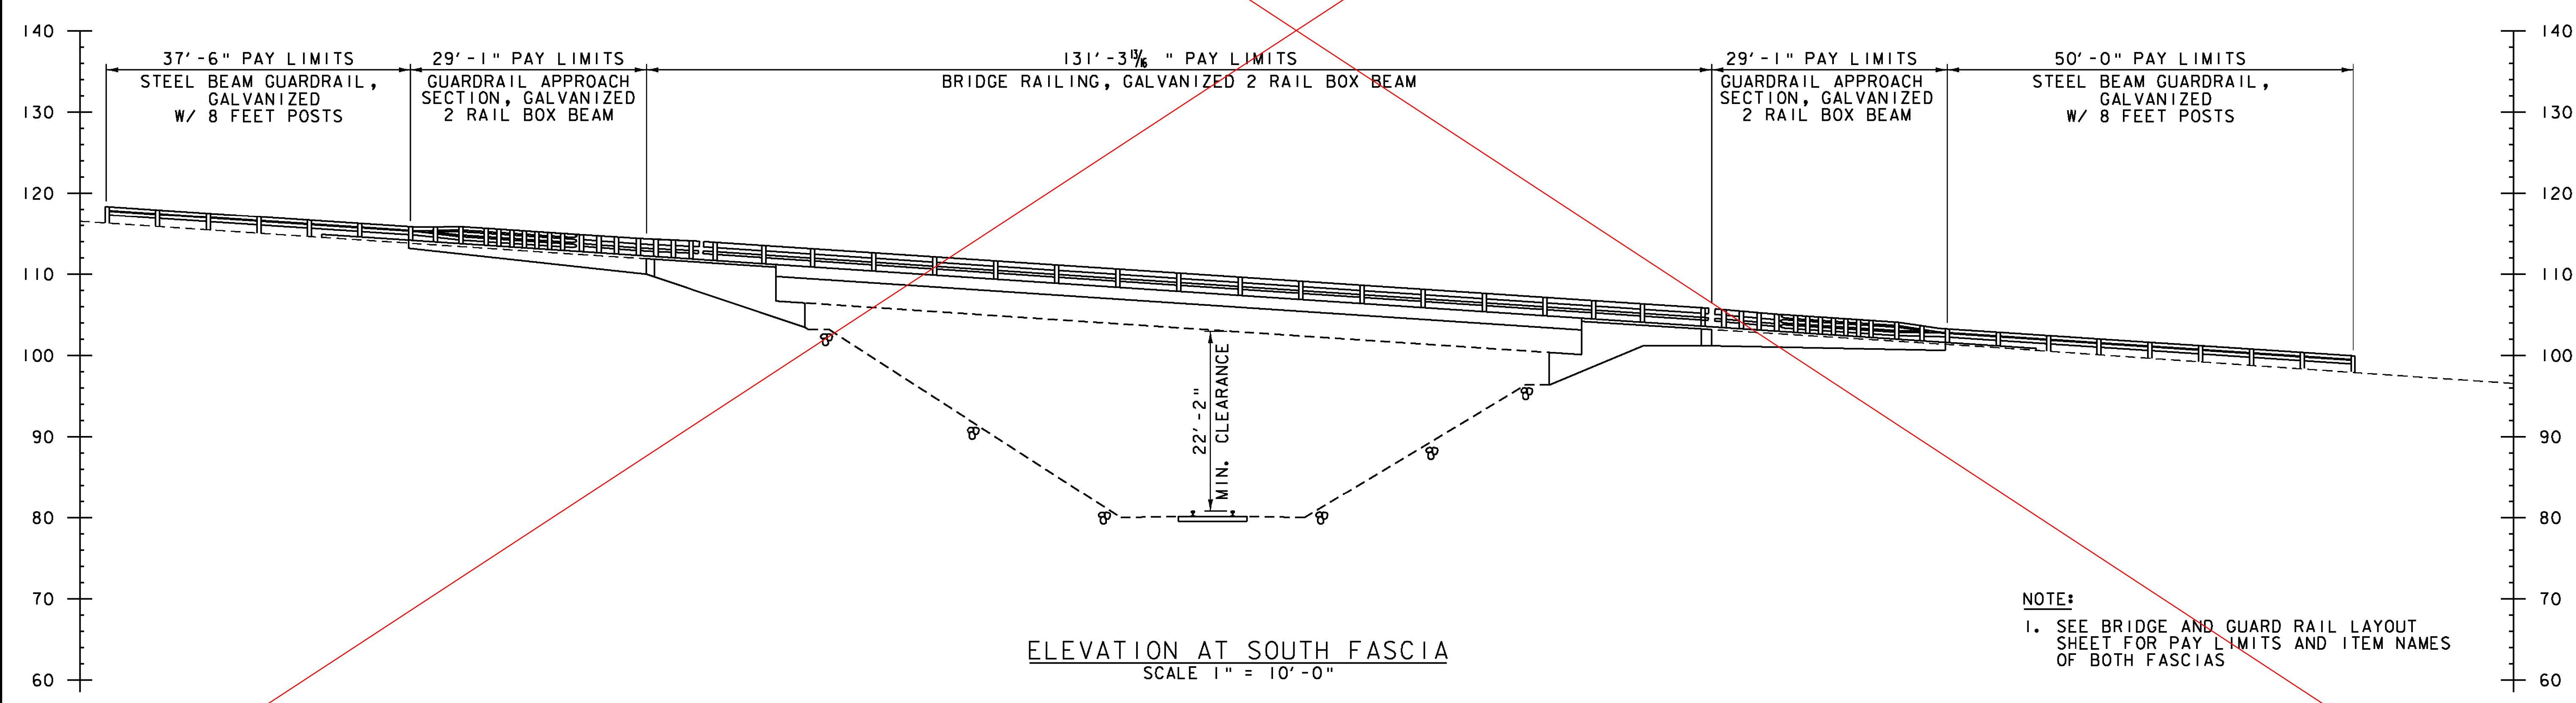


ELEVATION AT SOUTH FASCIA  
SCALE 1" = 10'-0"

**NOTE:**  
1. SEE BRIDGE AND GUARD RAIL LAYOUT SHEET FOR PAY LIMITS AND ITEM NAMES OF BOTH FASCIAS


DATUM	
VERTICAL	ASSUMED
HORIZONTAL	ASSUMED



PROJECT NAME: HARTLAND	FILE NAME: zllc260pe.dgn	PLOT DATE: 12/17/2013
PROJECT NUMBER: BHF BPNT(12)	PROJECT LEADER: M.A. COLGAN	DRAWN BY: A.J. GOUDREAU
	DESIGNED BY: S.G. FARNSWORTH	CHECKED BY: S.G. FARNSWORTH
	BR 62A PLAN AND ELEVATION	SHEET 23 OF 55

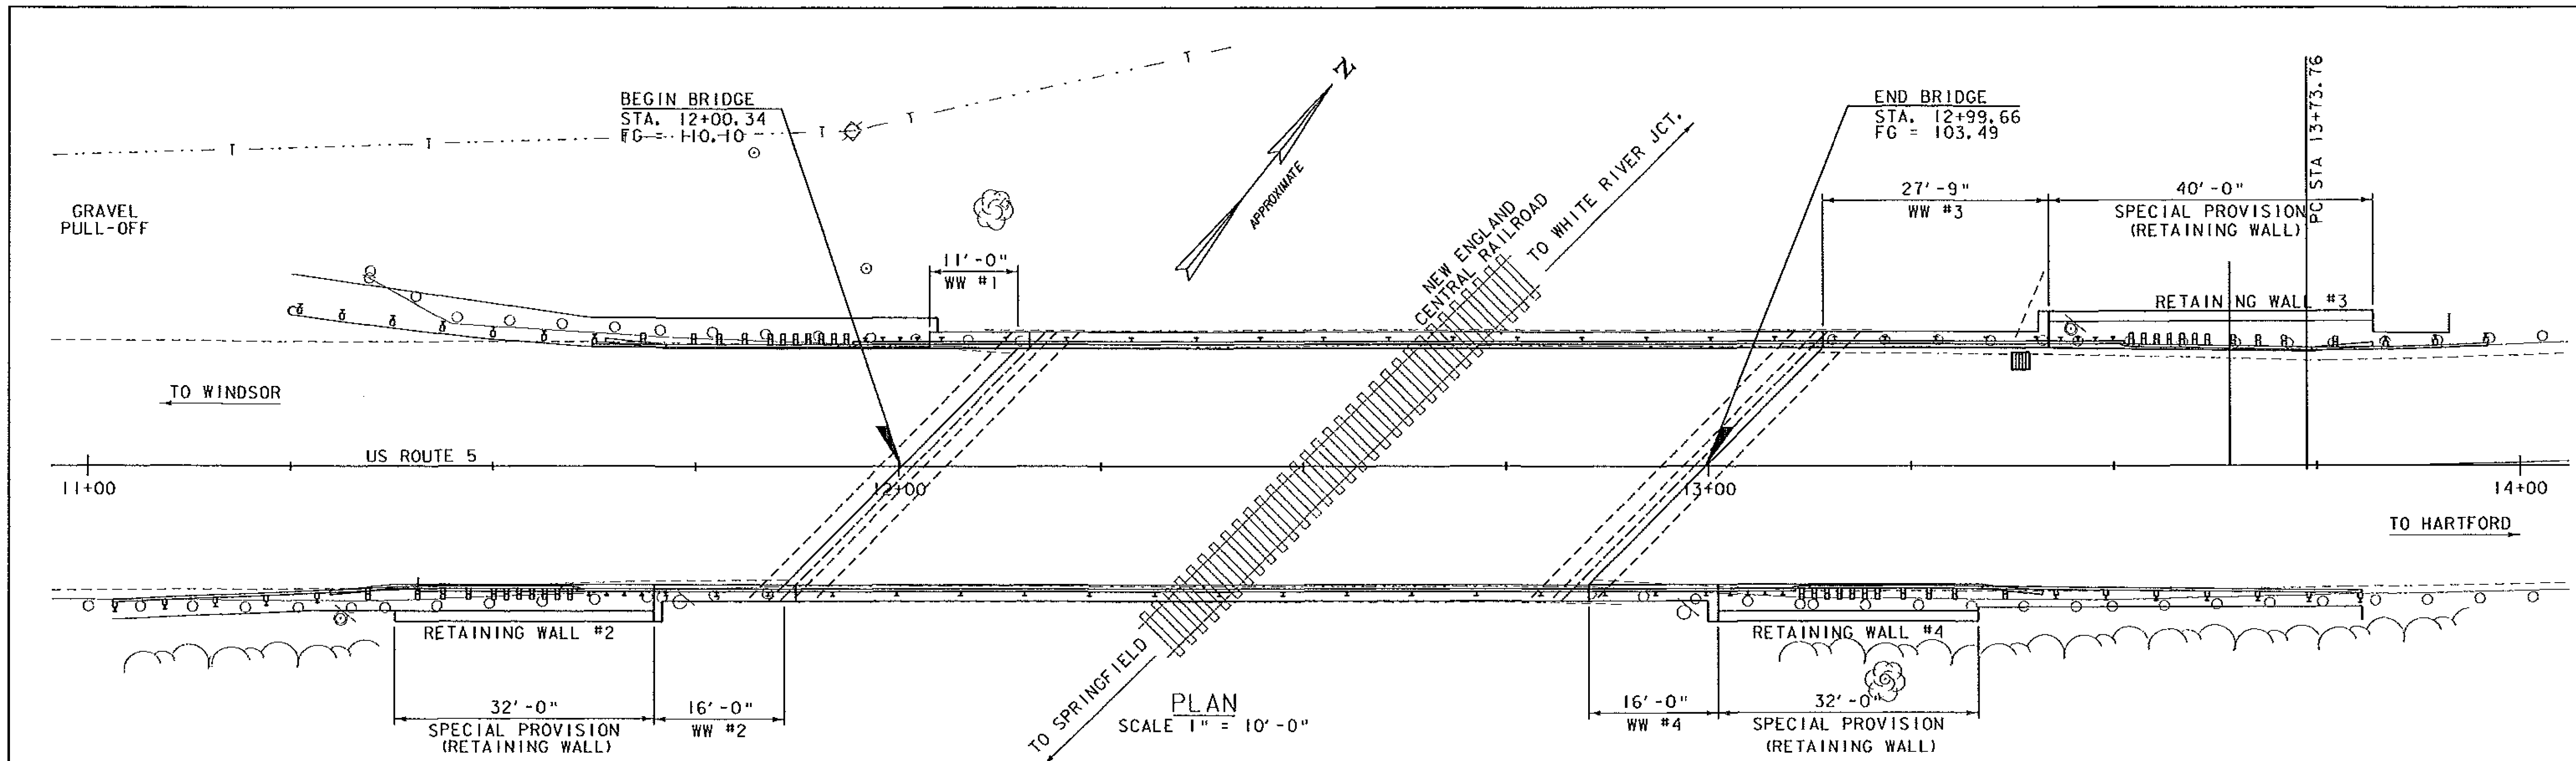

PLAN  
SCALE 1" = 10'-0"

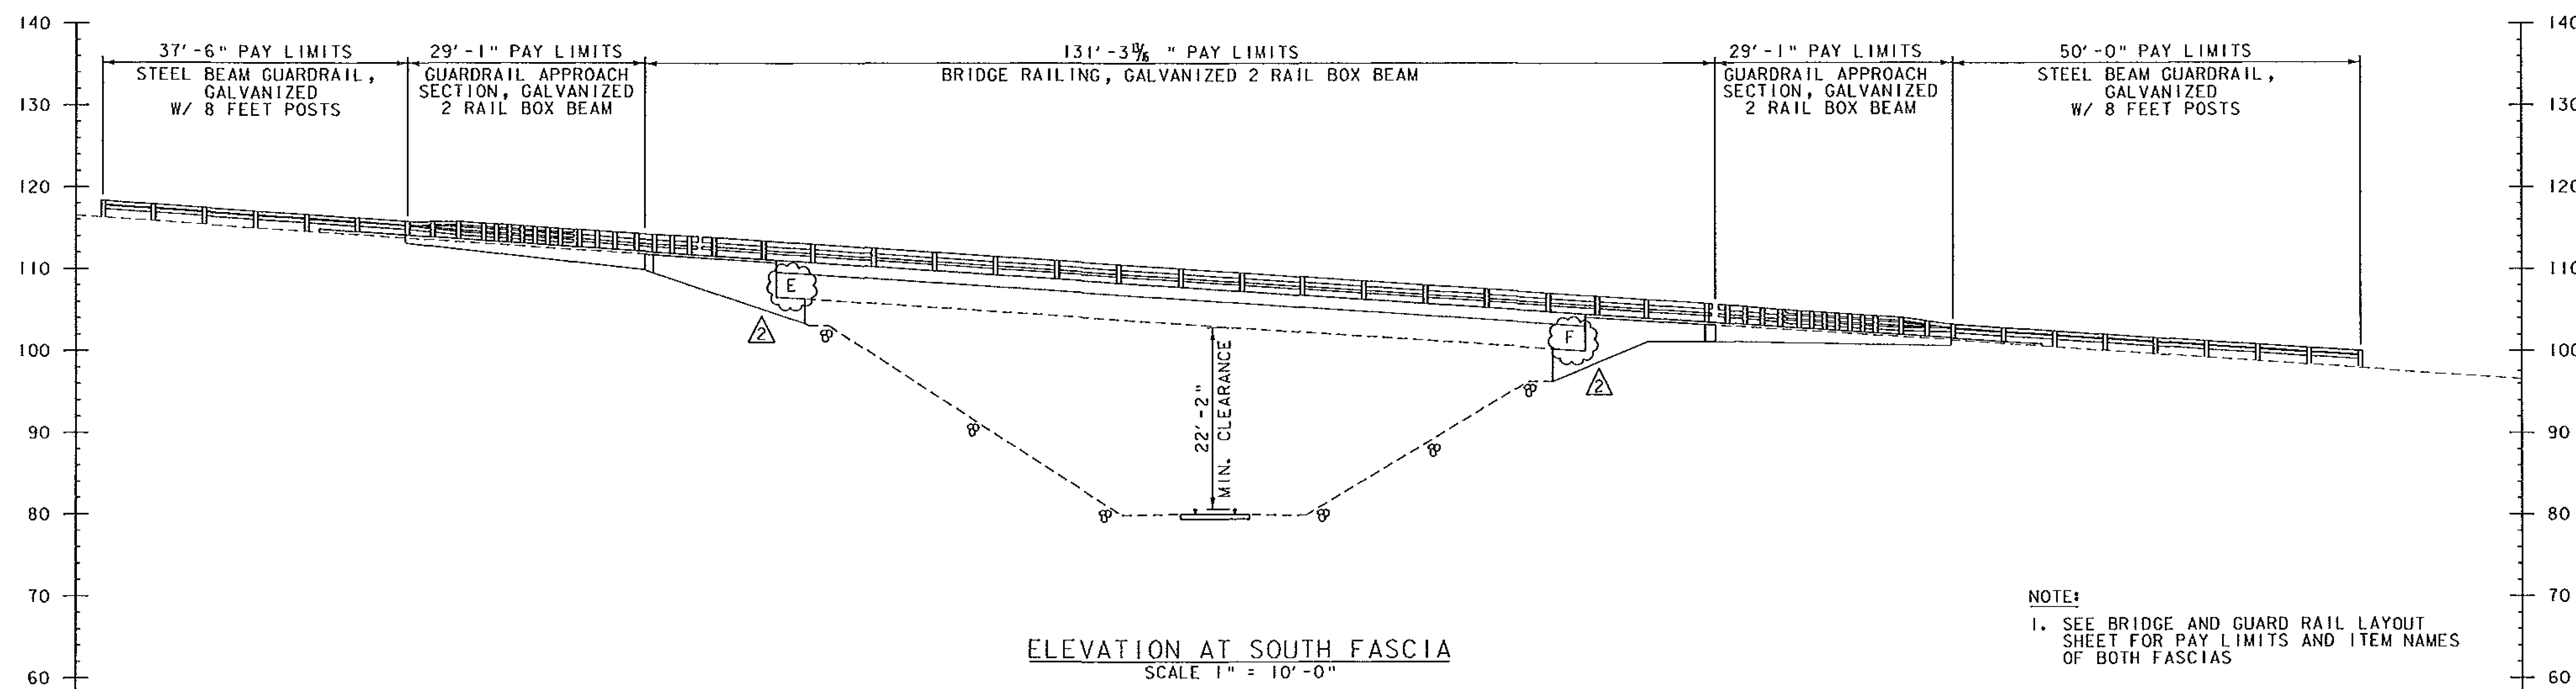

ELEVATION AT SOUTH FASCIA  
SCALE 1" = 10'-0"

NOTE:  
1. SEE BRIDGE AND GUARD RAIL LAYOUT SHEET FOR PAY LIMITS AND ITEM NAMES OF BOTH FASCIAS


DATUM	
VERTICAL	ASSUMED
HORIZONTAL	ASSUMED

REV.	DESCRIPTION	DATE
2	FIXED AND EXPANSION NOTATION	3/3/2014




PROJECT NAME:	HARTLAND
PROJECT NUMBER:	BHF BPNT(12)
FILE NAME:	zllc260pe.dgn
PROJECT LEADER:	M.A. COLGAN
DESIGNED BY:	S.G. FARNSWORTH
BR 62A PLAN AND ELEVATION	
PLOT DATE:	3/3/2014
DRAWN BY:	A.J. GOUDREAU
CHECKED BY:	S.G. FARNSWORTH
SHEET	23 OF 55

SEE REVISION SHEET

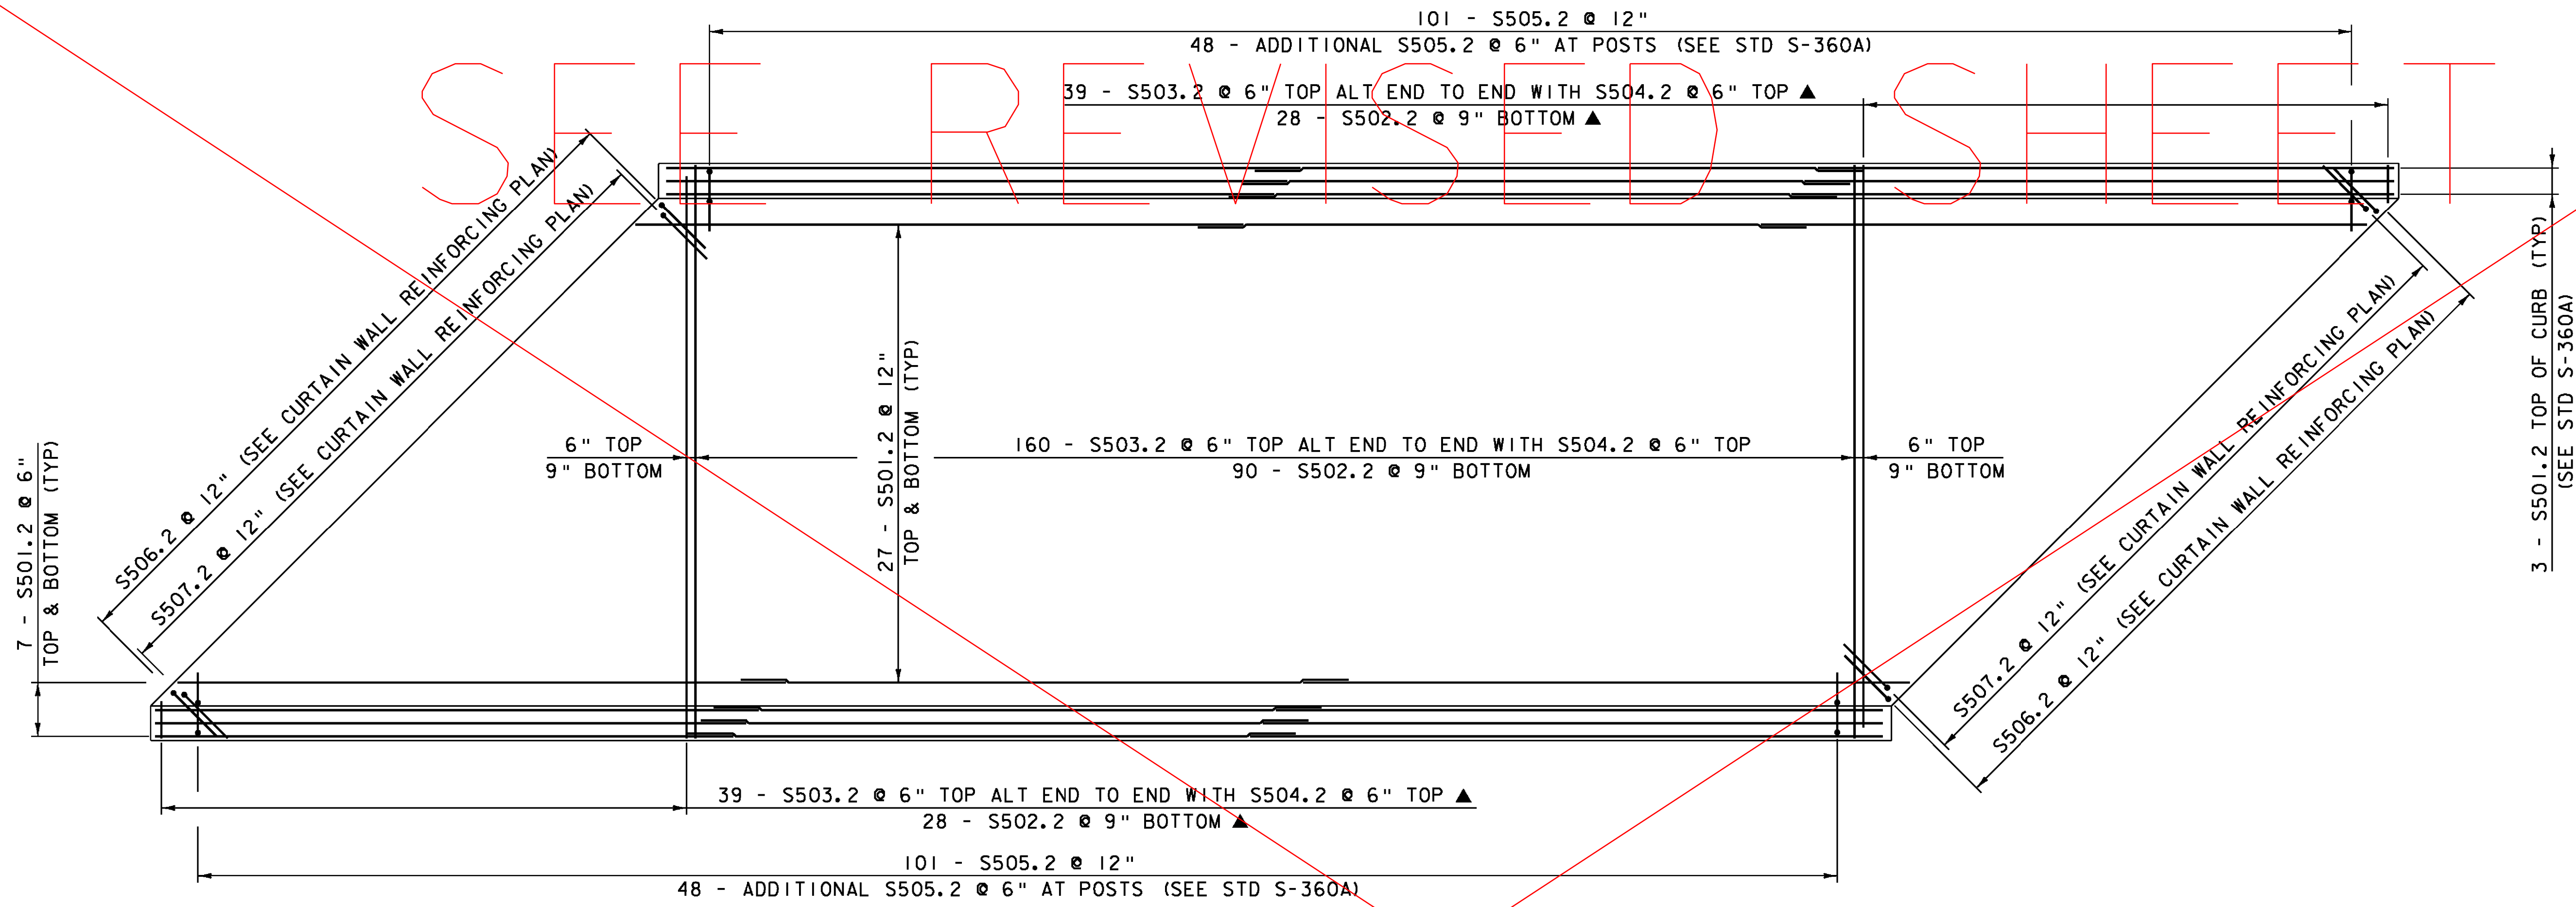

**DECK REINFORCING PLAN**  
SCALE: 3/16" = 1'-0"

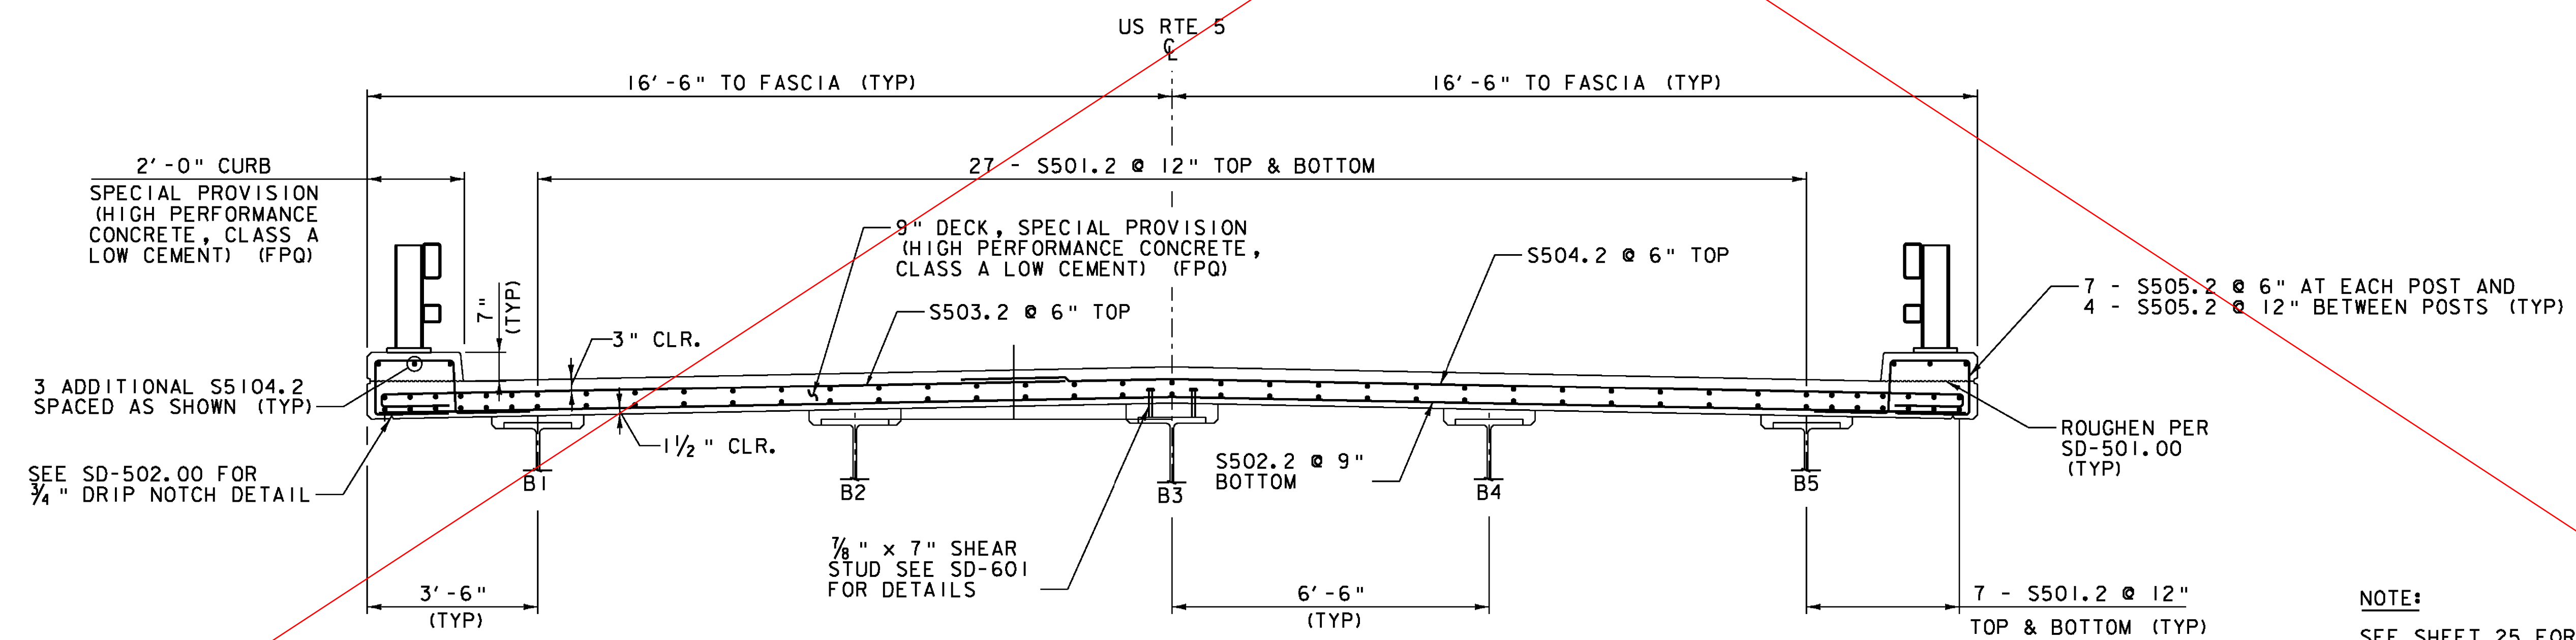


**TYPICAL DECK REINFORCEMENT**  
SCALE: 1/2" = 1'-0"

**NOTE:**  
 NF = NEAR FACE  
 FF = FAR FACE  
 EF = EACH FACE  
 ▲ = CUT TO FIT IN FIELD  
 3" CLEAR, UNLESS OTHERWISE SPECIFIED ON THE PLANS.  
 2'-2" BAR LAP UNLESS OTHERWISE SPECIFIED ON THE PLANS.

**NOTE:**  
 SEE SHEET 25 FOR CURTAIN WALL REINFORCING PLAN


PROJECT NAME: HARTLAND	PLOT DATE: 12/17/2013
PROJECT NUMBER: BHF BPNT (12)	DRAWN BY: A.J. GOUDREAU
FILE NAME: zllc260deck.dgn	CHECKED BY: E.A. FIALA
PROJECT LEADER: M.A. COLGAN	SHEET 24 OF 55
DESIGNED BY: A.J. GOUDREAU	
BR 62A DECK REINFORCING	



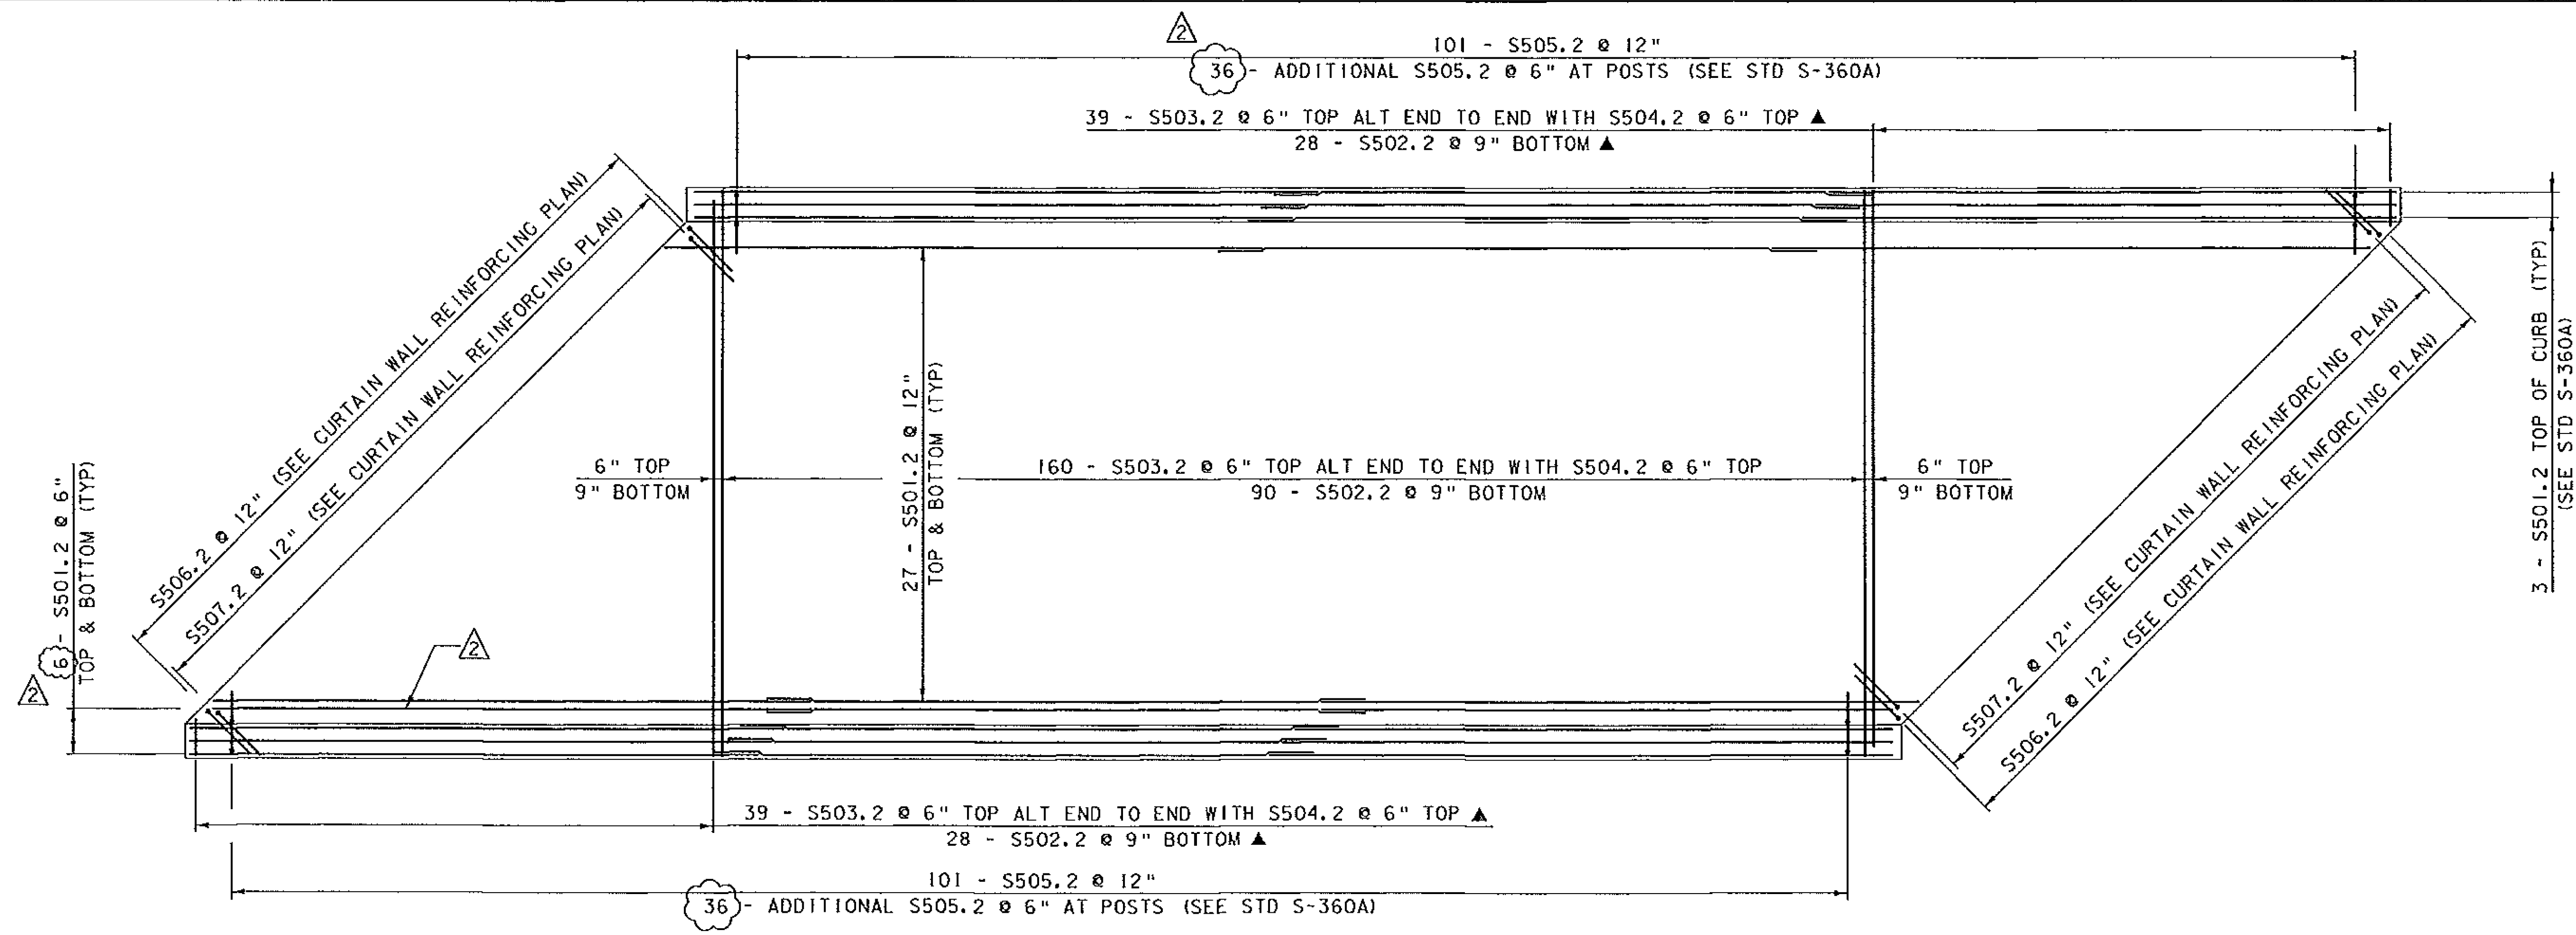

**DECK REINFORCING PLAN**

SCALE 3/16" = 1'-0"

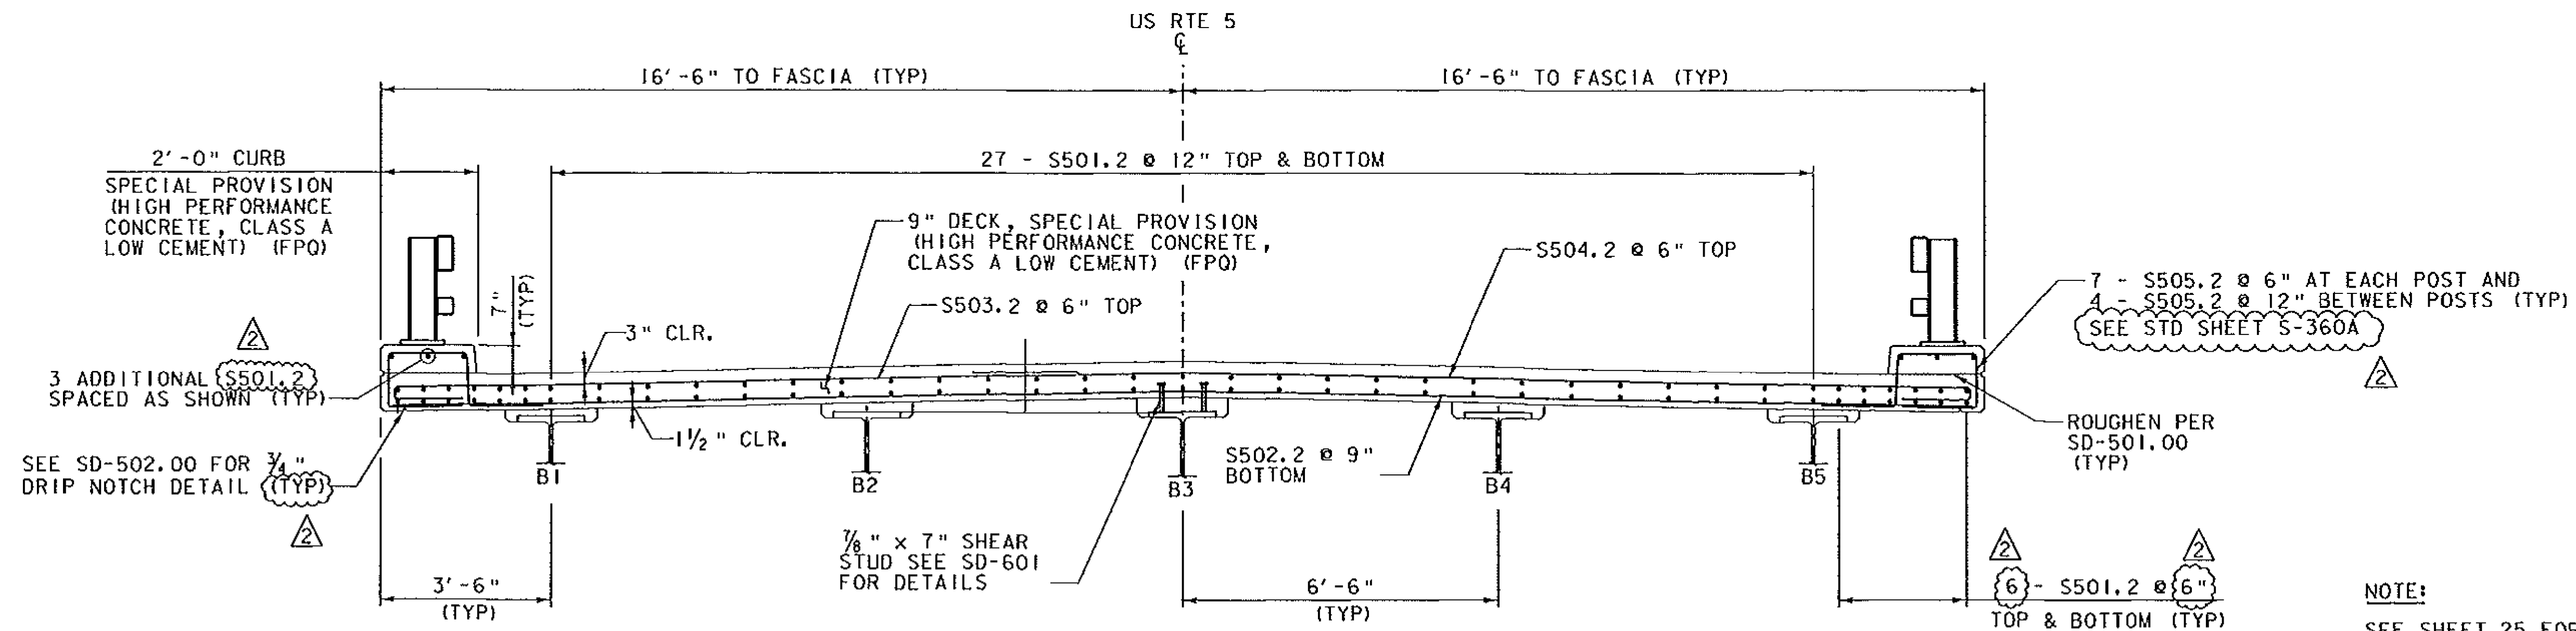

**TYPICAL DECK REINFORCEMENT**

SCALE: 1/2" = 1'-0"

**NOTE:**  
 NF = NEAR FACE  
 FF = FAR FACE  
 EF = EACH FACE  
 ▲ = CUT TO FIT IN FIELD  
 3" CLEAR, UNLESS OTHERWISE SPECIFIED ON THE PLANS.  
 2'-2" BAR LAP UNLESS OTHERWISE SPECIFIED ON THE PLANS.


**NOTE:**  
 SEE SHEET 25 FOR CURTAIN WALL REINFORCING PLAN

REV.	DESCRIPTION	DATE
2	REBAR QUANTITY, SIZE, AND SPACING	3/3/2014




PROJECT NAME: HARTLAND	PLOT DATE: 3/3/2014
PROJECT NUMBER: BHF BPNT (12)	DRAWN BY: A.J. GOUDREAU
FILE NAME: zllc260deck.dgn	CHECKED BY: E.A. FIALA
PROJECT LEADER: M.A. COLGAN	SHEET 24 OF 55
DESIGNED BY: A.J. GOUDREAU	
BR 62A DECK REINFORCING	

SEE REVISED

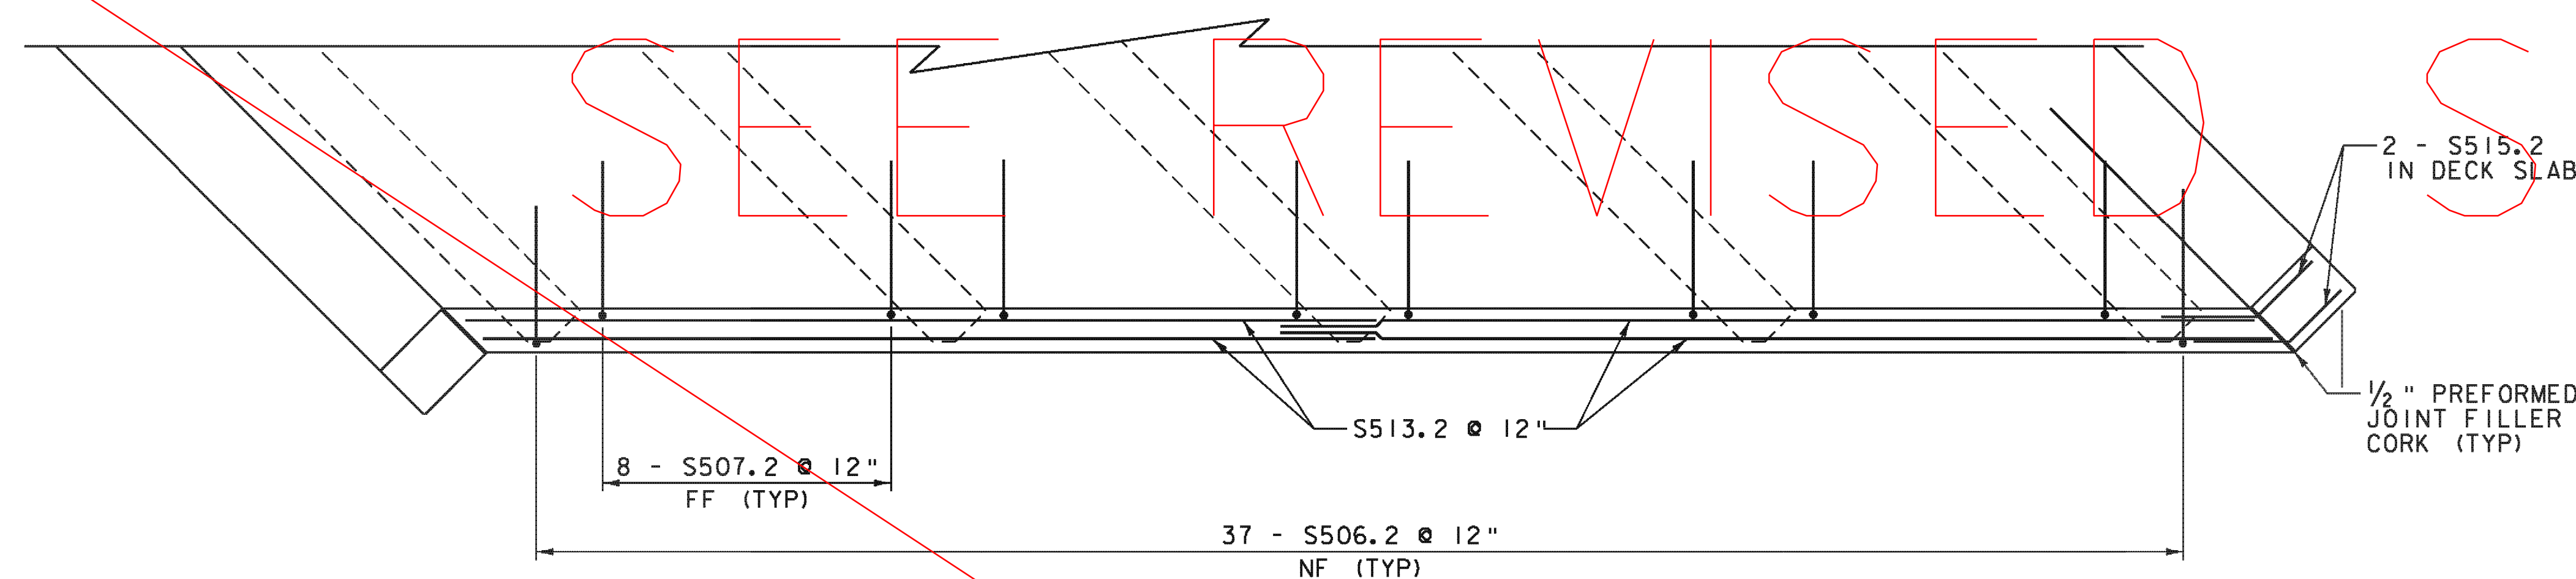


**ABUTMENT 1 CURTAIN WALL REINFORCING PLAN**  
SCALE: 3/8" = 1'-0"

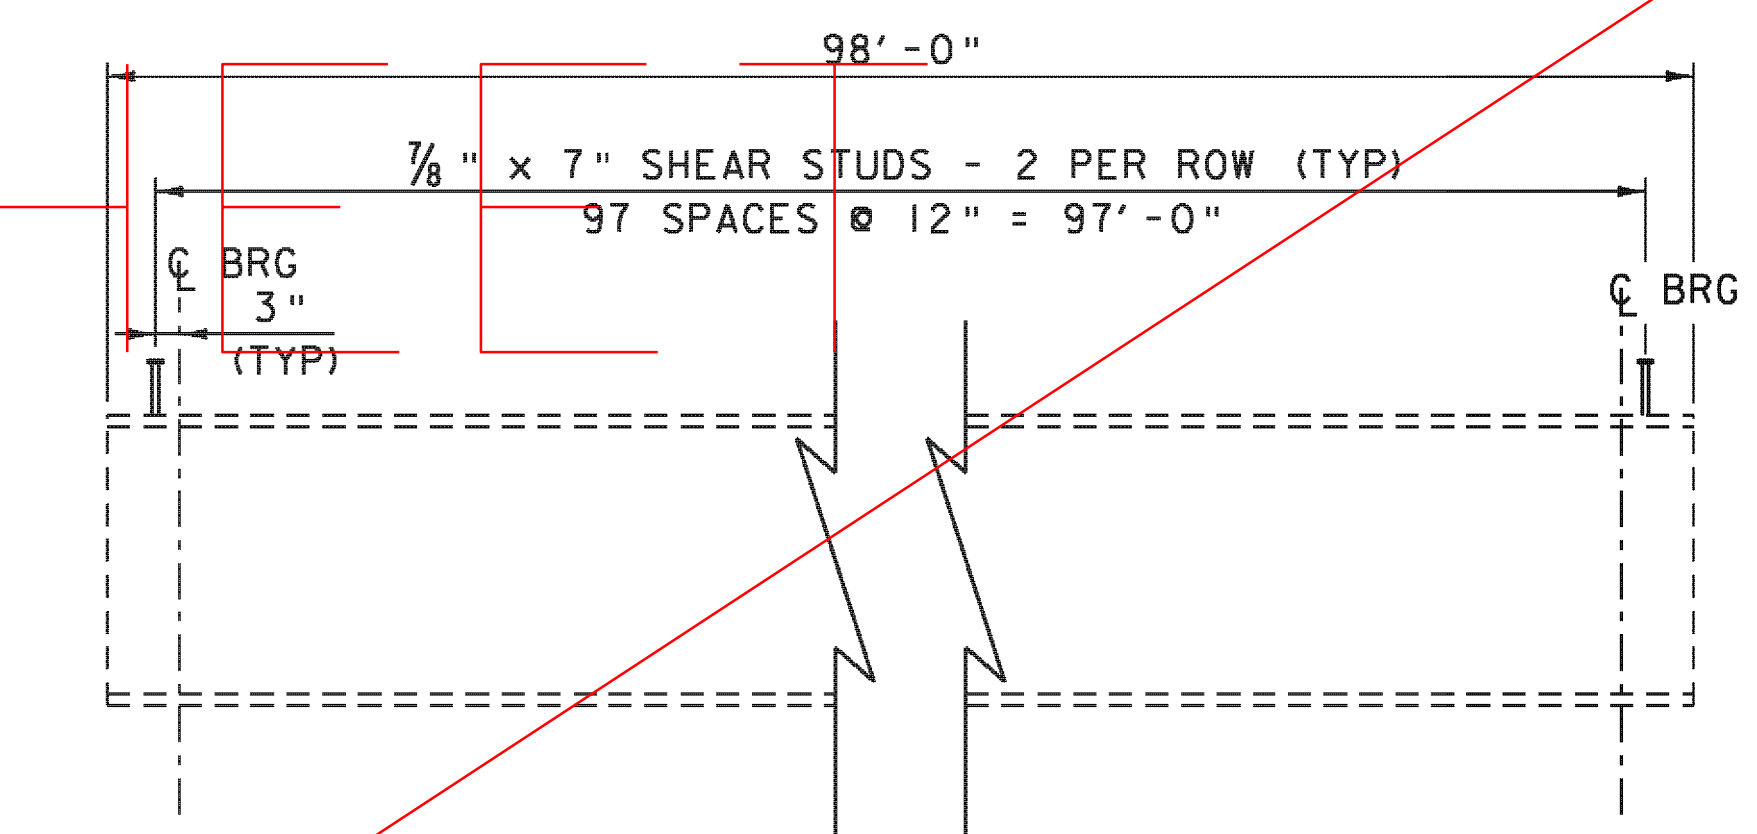


**SHEAR STUD LAYOUT**  
SCALE: 1/2" = 1'-0"


**NOTE:**  
 NF = NEAR FACE  
 FF = FAR FACE  
 EF = EACH FACE  
 ▲ = CUT TO FIT IN FIELD  
 3" CLEAR, UNLESS OTHERWISE SPECIFIED ON THE PLANS.  
 2'-2" BAR LAP UNLESS OTHERWISE SPECIFIED ON THE PLANS.

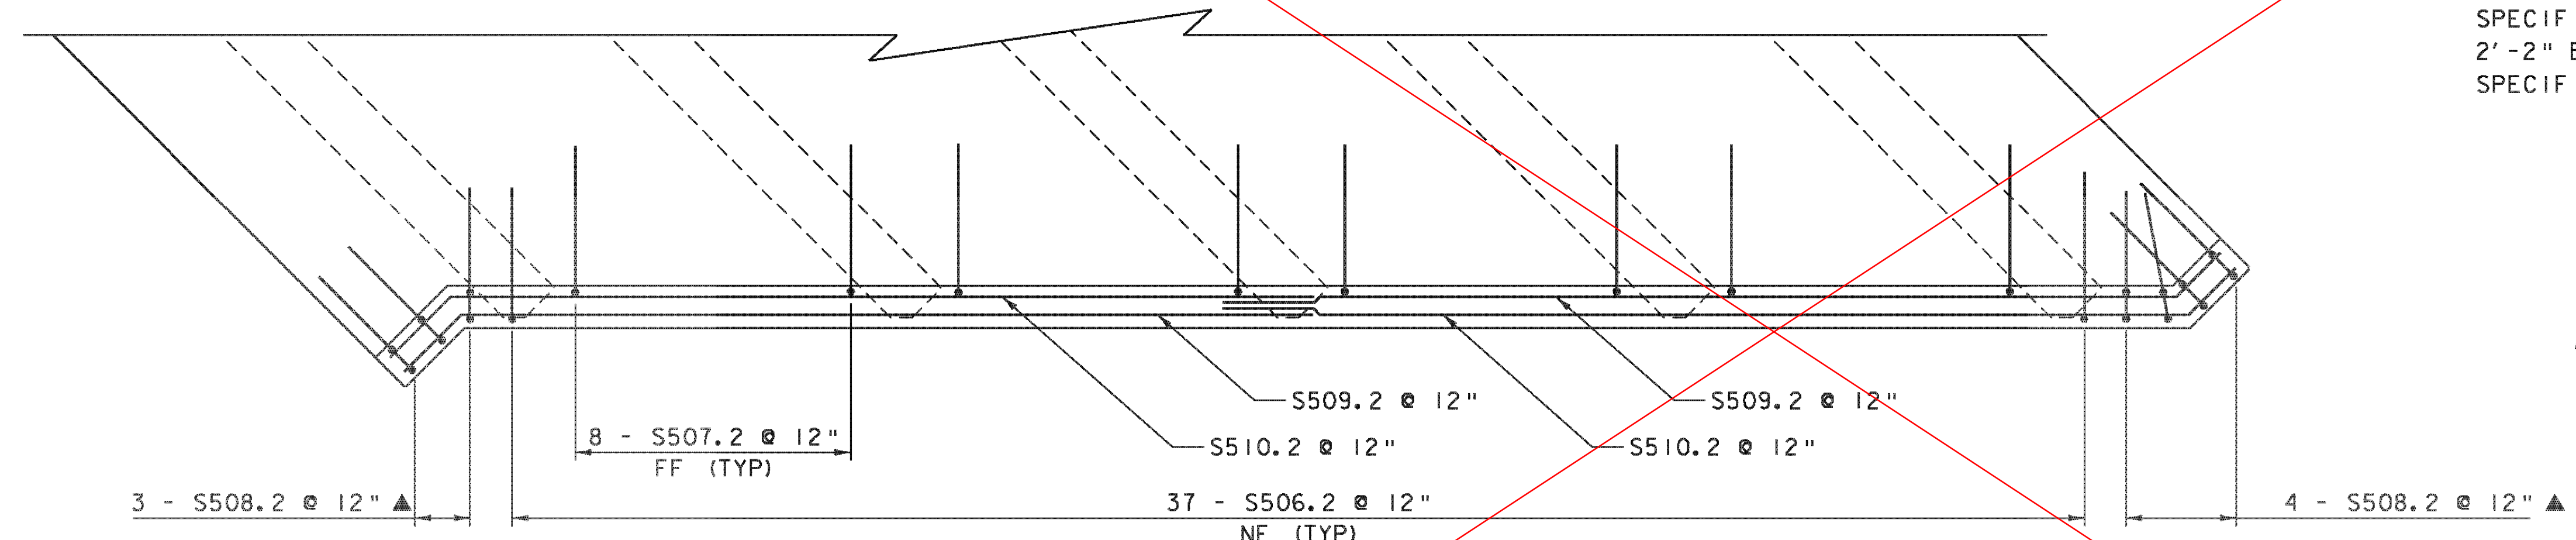

**ABUTMENT 2 CURTAIN WALL REINFORCING PLAN**  
SCALE: 3/8" = 1'-0"

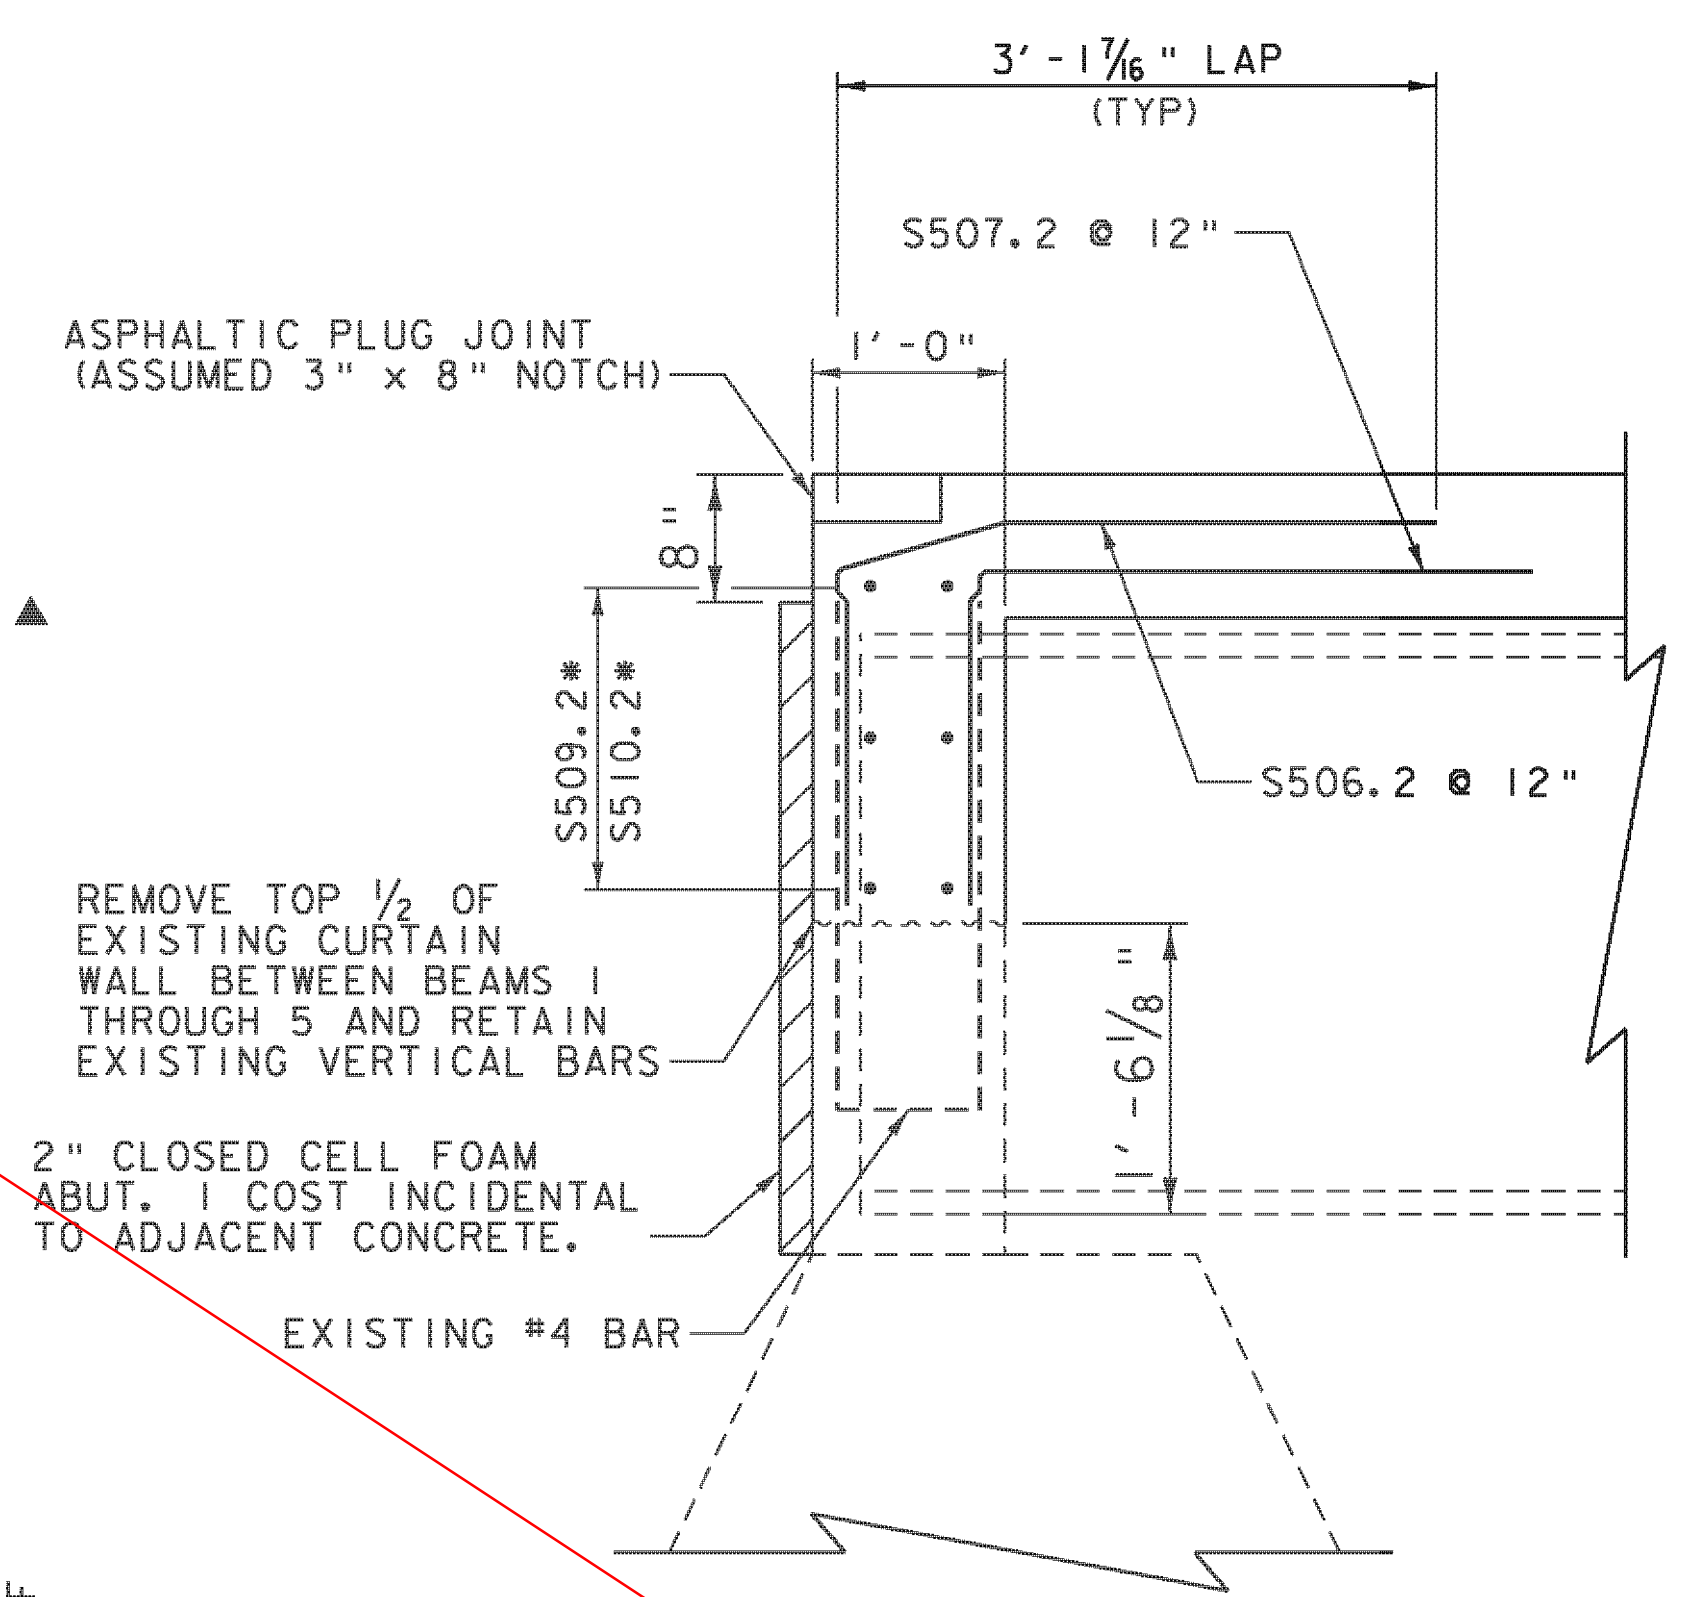


**CURTAIN WALL TYPICAL SECTION**  
SCALE: 3/4" = 1'-0"

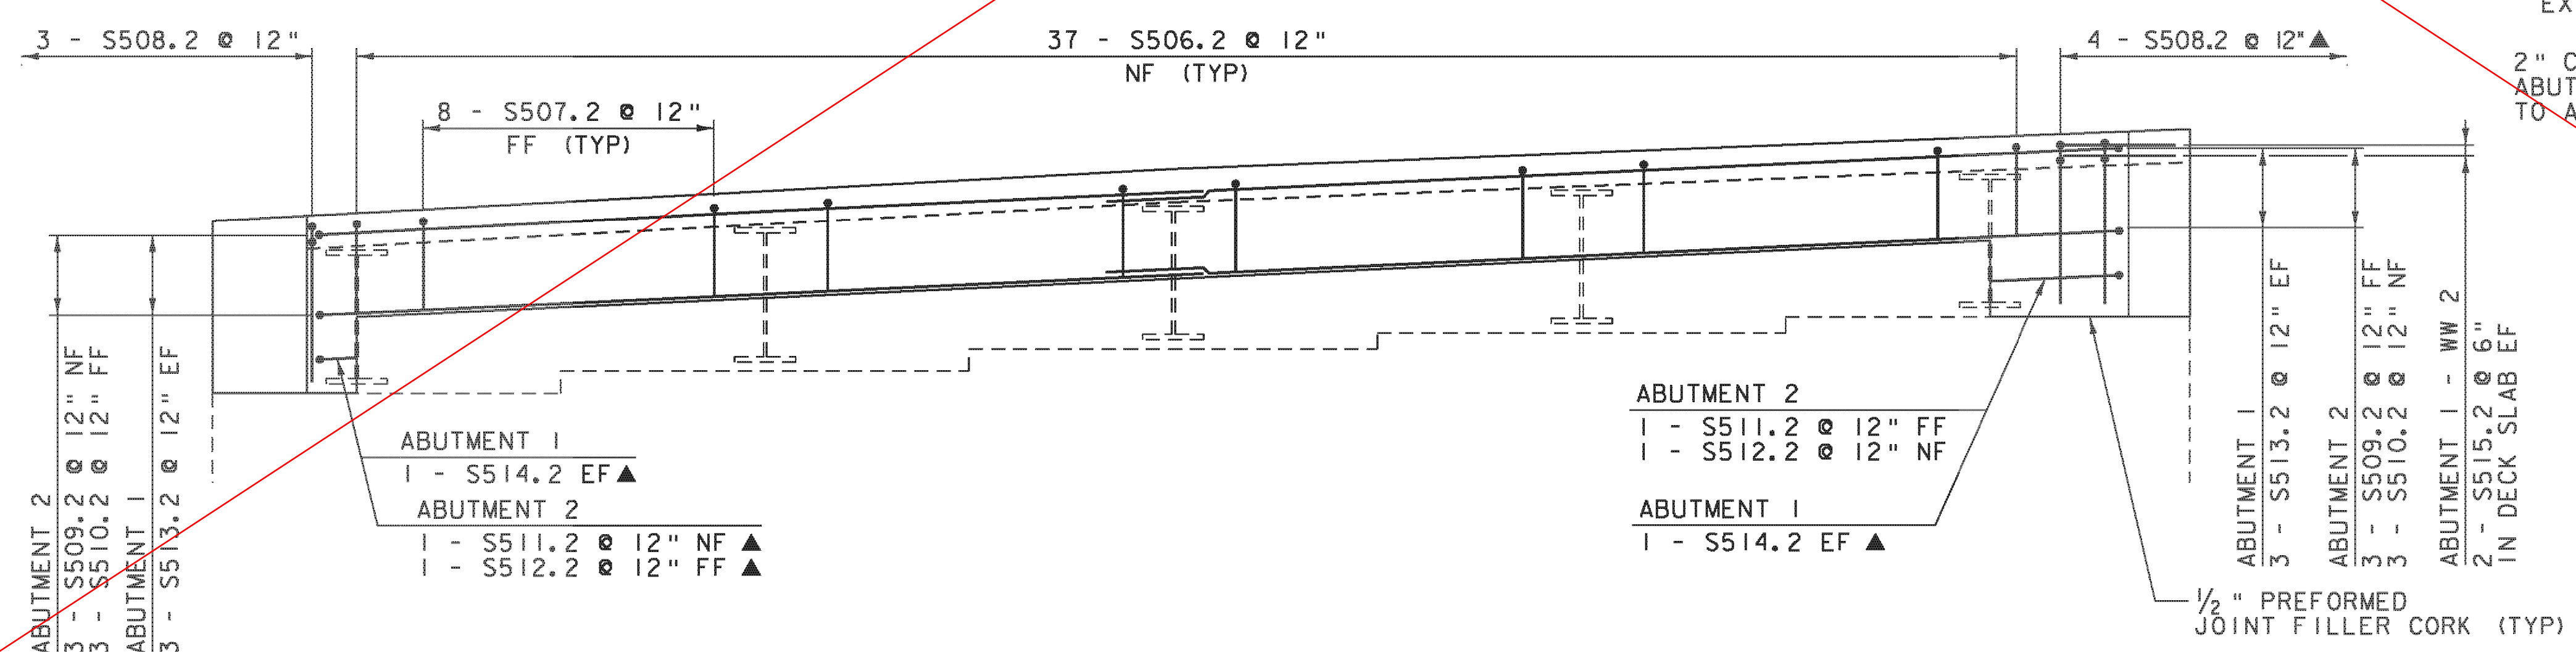


**CURTAIN WALL REINFORCING ELEVATION**  
SCALE: 3/8" = 1'-0"

PROJECT NAME:	HARTLAND	FILE NAME:	zllc260deck.dgn	PLOT DATE:	1/2/2014
PROJECT NUMBER:	BHF BPNT (I2)	PROJECT LEADER:	M.A. COLGAN	DRAWN BY:	A.J. GOUDREAU
		DESIGNED BY:	A.J. GOUDREAU	CHECKED BY:	S.G. FARNSWORTH
					BR 62A CURTAIN WALL/SHEAR STUD LAYOUT SHEET 25 OF 55



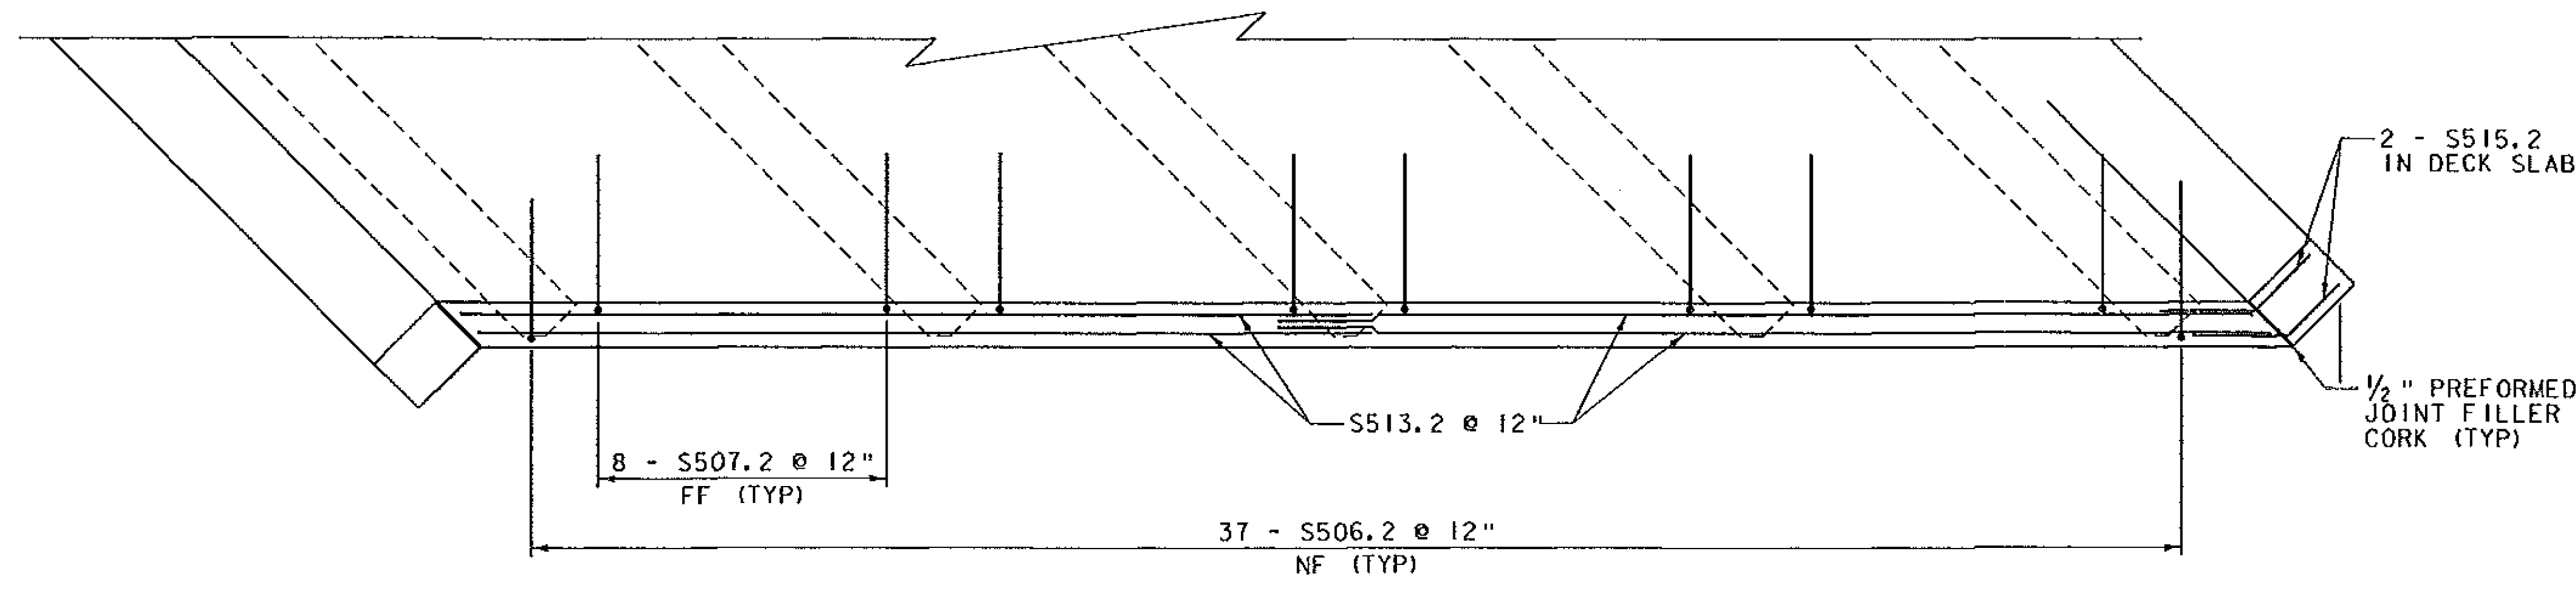


ABUTMENT 1 CURTAIN WALL REINFORCING PLAN  
SCALE: 3/8" = 1'-0"

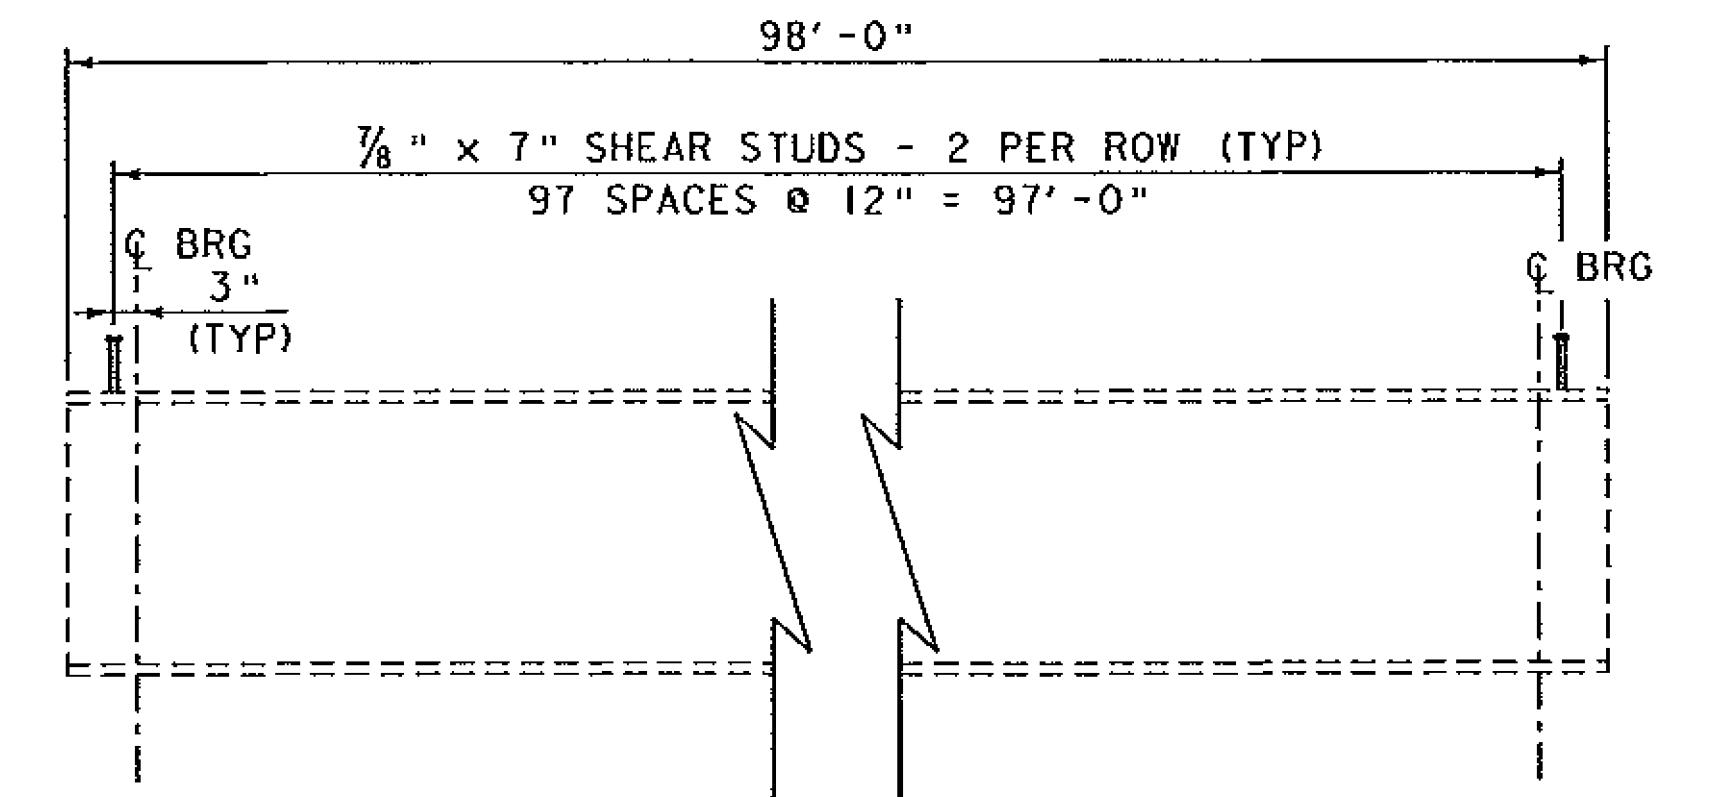


SHEAR STUD LAYOUT  
SCALE: 1/2" = 1'-0"


NOTE:  
 NF = NEAR FACE  
 FF = FAR FACE  
 EF = EACH FACE  
 ▲ = CUT TO FIT IN FIELD  
 3" CLEAR, UNLESS OTHERWISE SPECIFIED ON THE PLANS.  
 2'-2" BAR LAP UNLESS OTHERWISE SPECIFIED ON THE PLANS.

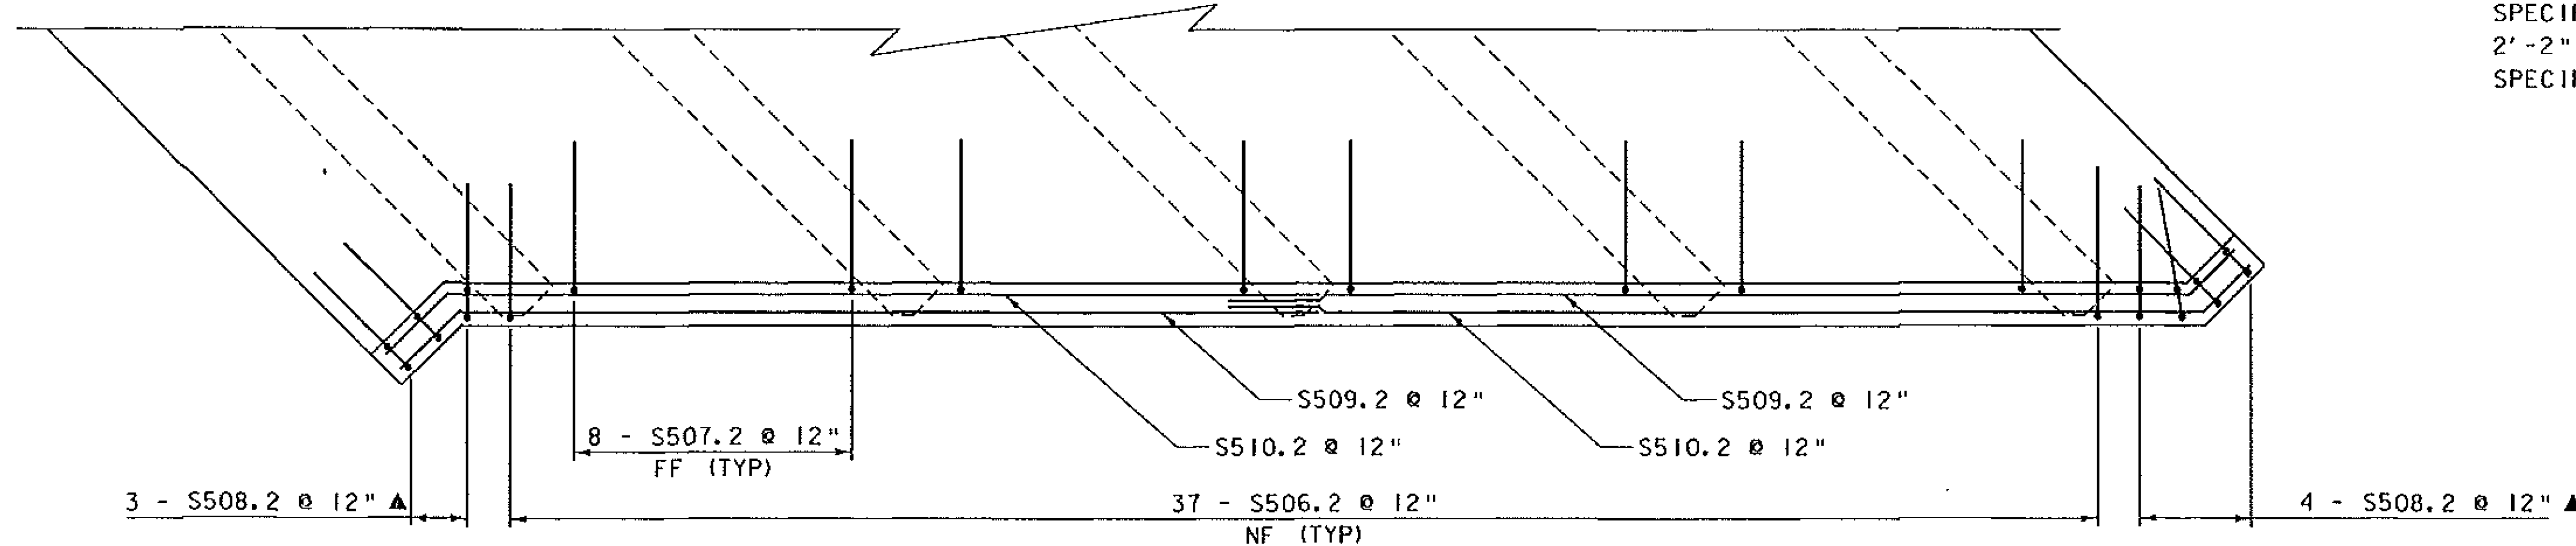

ABUTMENT 2 CURTAIN WALL REINFORCING PLAN  
SCALE: 3/8" = 1'-0"

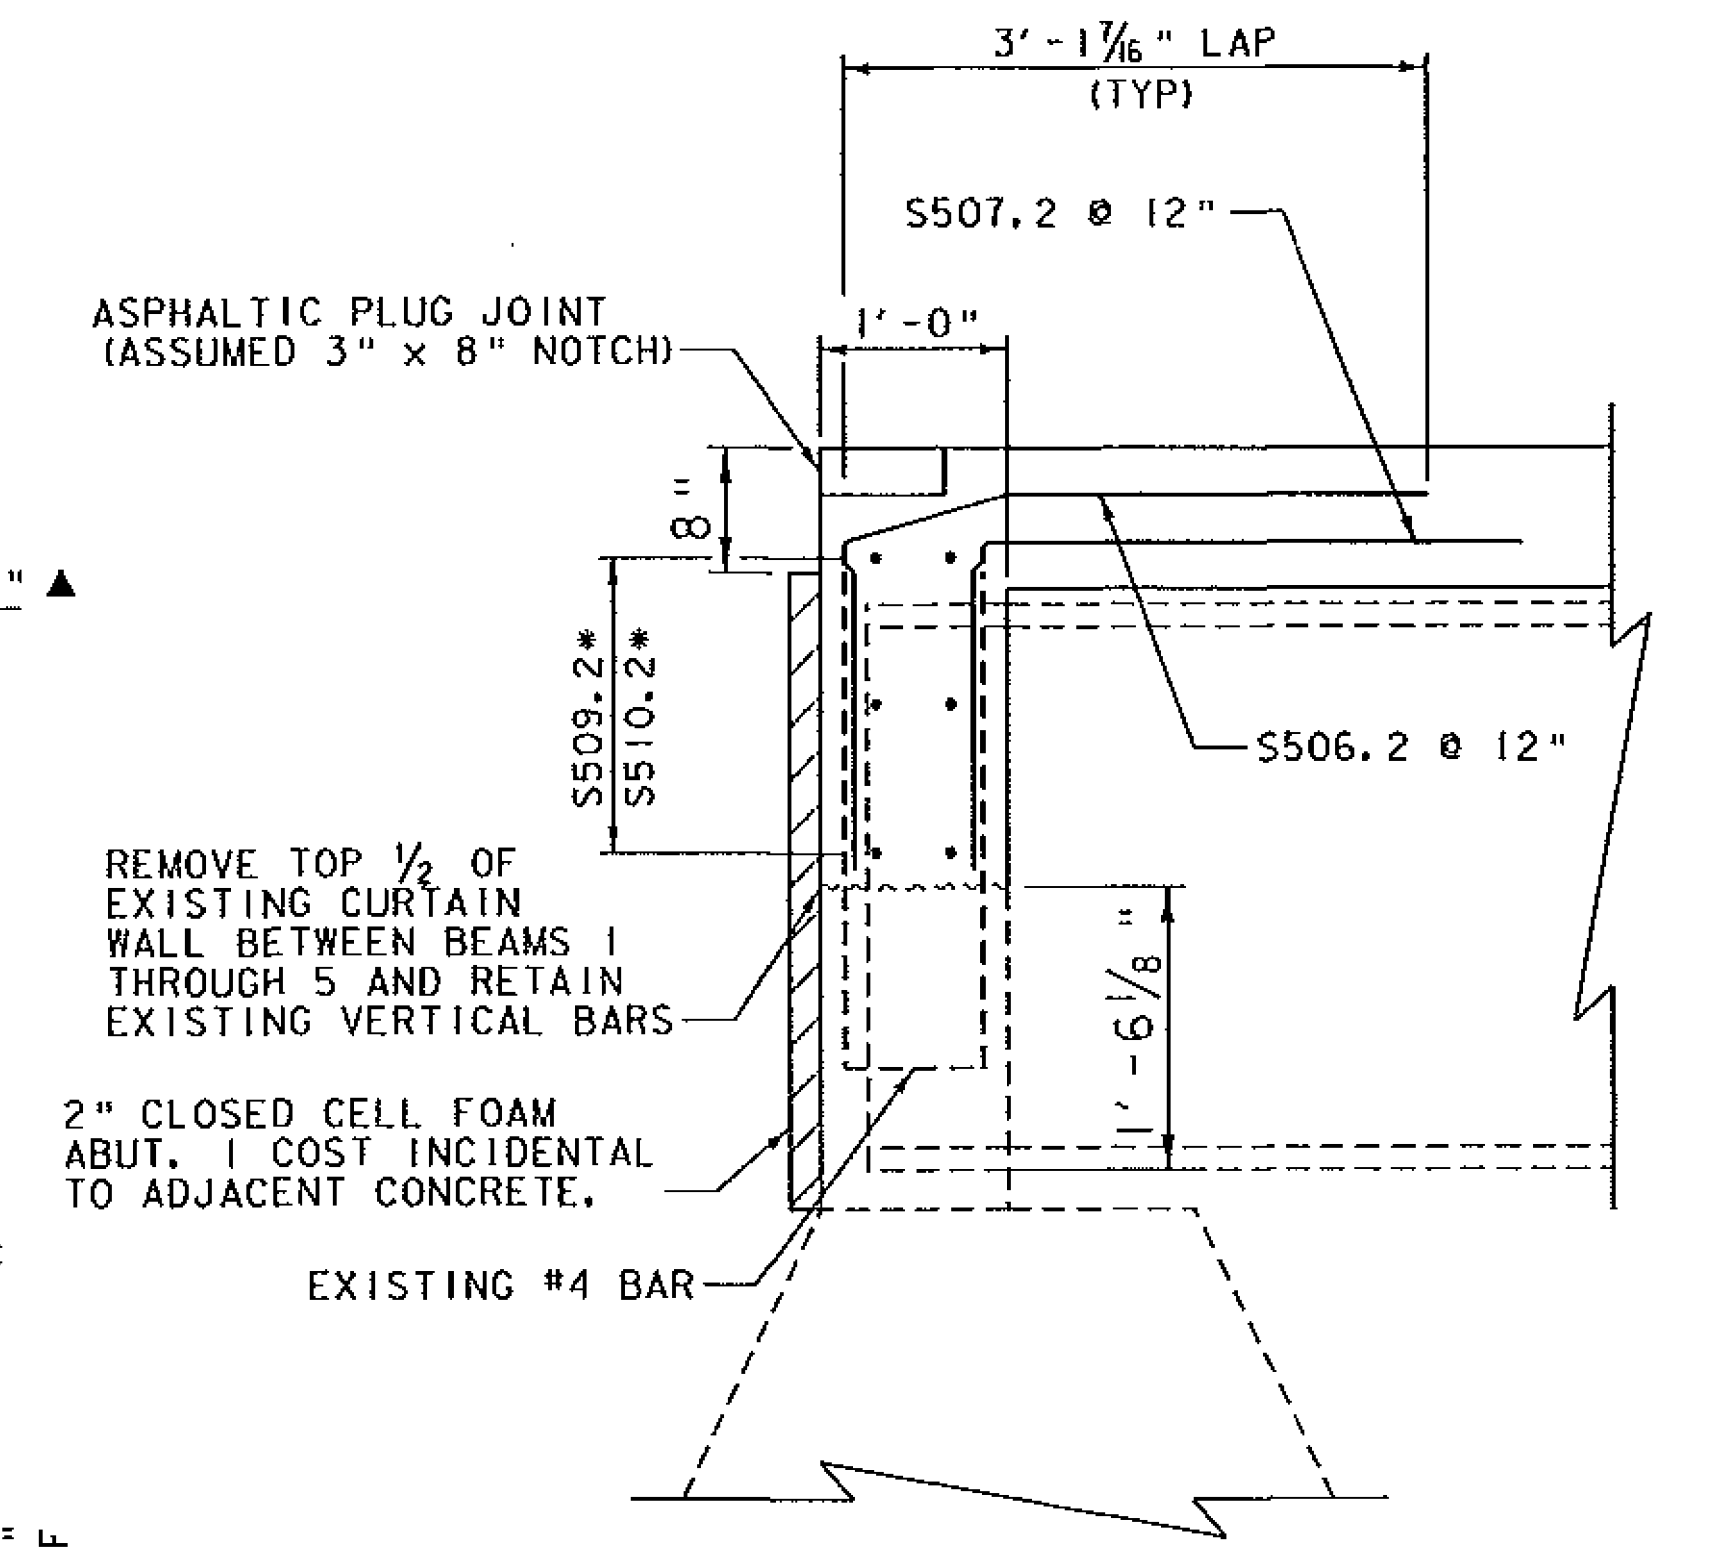

* REFER TO PLAN AND ELEVATION VIEWS FOR SPACING AND LAYOUT  
 CURTAIN WALL TYPICAL SECTION  
 SCALE: 3/4" = 1'-0"

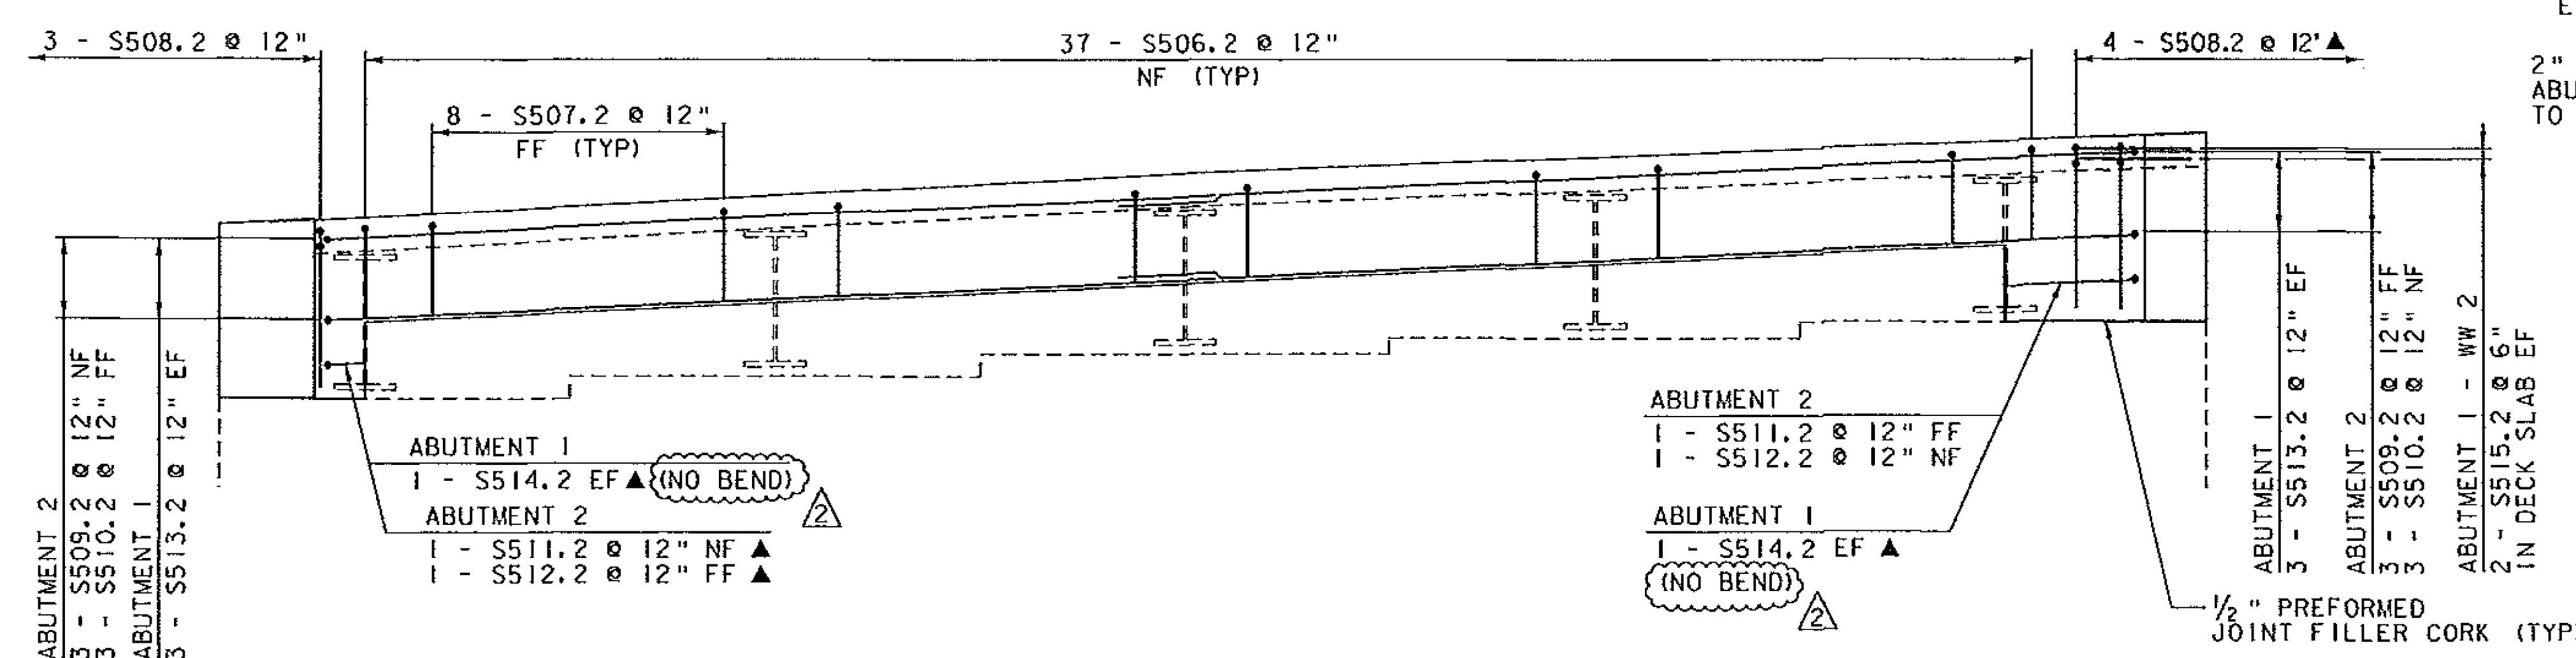


CURTAIN WALL REINFORCING ELEVATION  
SCALE: 3/8" = 1'-0"

REV.	DESCRIPTION	DATE
△	REBAR S514.2 IS A STRAIGHT BAR	3/3/2014



PROJECT NAME: HARTLAND	PLOT DATE: 3/3/2014
PROJECT NUMBER: BHF BPNT (12)	DRAWN BY: A.J. GOUDREAU
FILE NAME: z10c260deck.dgn	CHECKED BY: S.G. FARNSWORTH
PROJECT LEADER: M.A. COLGAN	BR 62A CURTAIN WALL/SHEAR STUD LAYOUT SHEET 25 OF 55
DESIGNED BY: A.J. GOUDREAU	

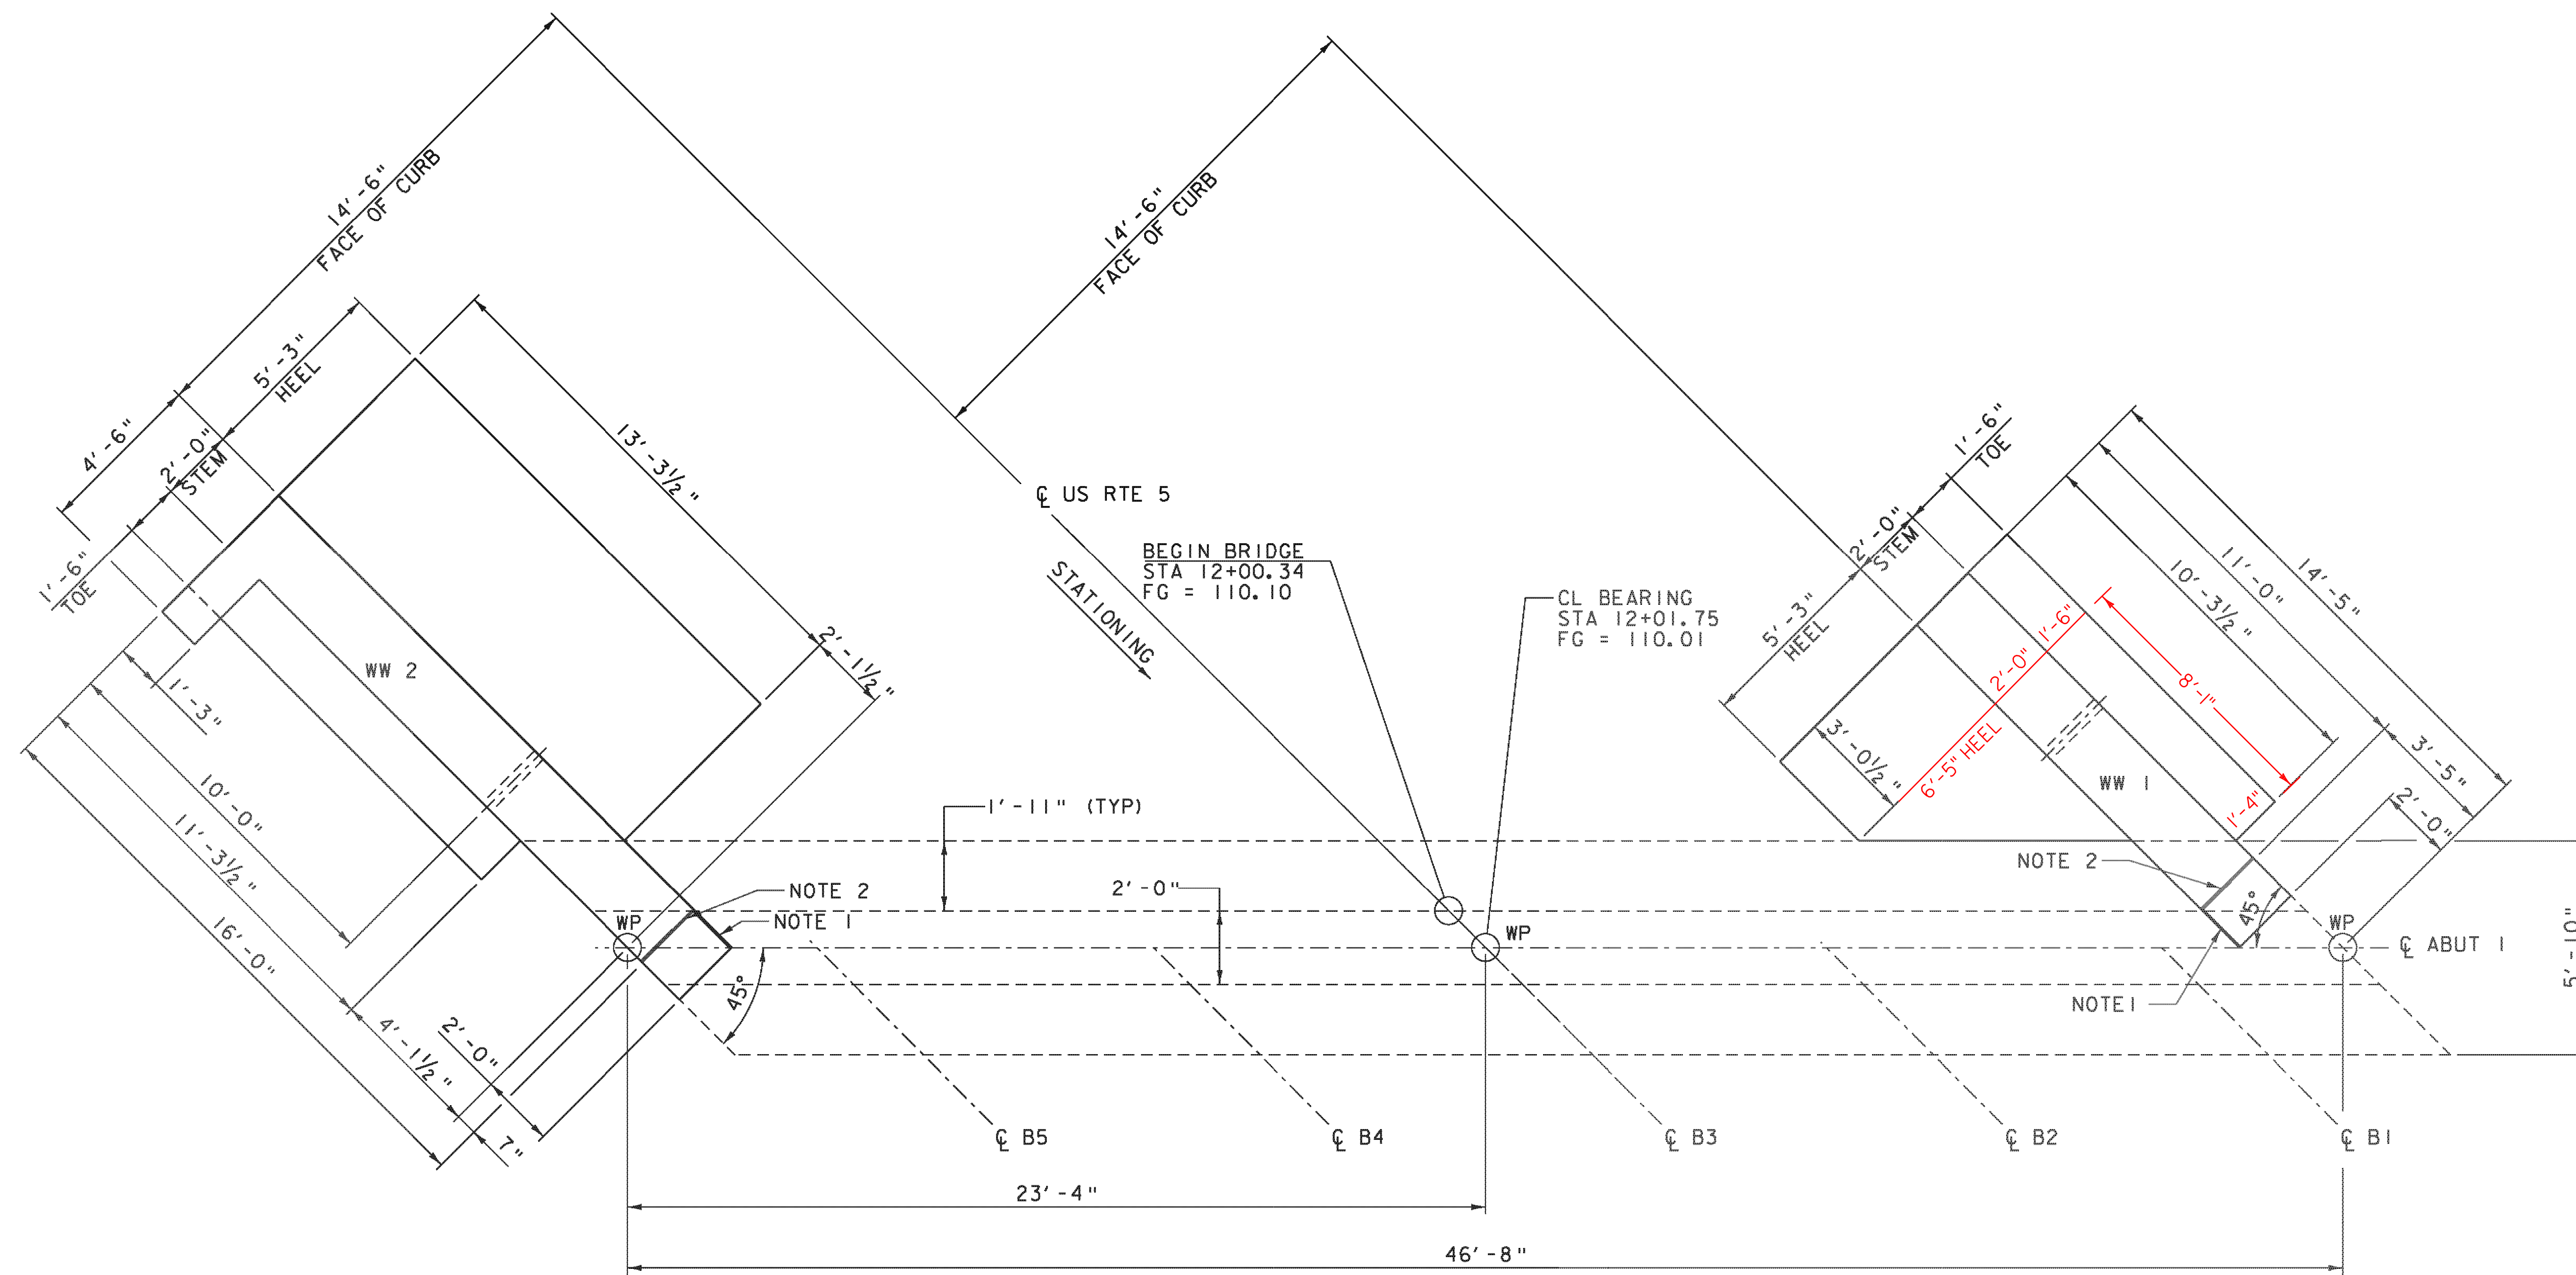


ABUTMENT I PLAN  
SCALE 3/8" = 1'-0"

- NOTE:
- 1/2" PREFORMED JOINT FILLER CORK BETWEEN WINGWALL AND CURTAINWALL.
  - ONE INCH OF CLOSED CELL FOAM WITH ONE INCH POLYURETHANE JOINT SEALER BETWEEN WINGWALL AND CONCRETE SLAB. COST INCIDENTAL TO UNIT BID PRICE FOR ADJACENT CONCRETE.

PROJECT NAME:	HARTLAND
PROJECT NUMBER:	BHF BPNT(12)
FILE NAME:	zllc260sub.dgn
PROJECT LEADER:	M.A. COLGAN
DESIGNED BY:	S.G. FARNSWORTH
BR 62A ABUTMENT I PLAN	
PLOT DATE:	1/2/2014
DRAWN BY:	A.J. GOUDREAU
CHECKED BY:	S.E. BURBANK
SHEET	26 OF 55



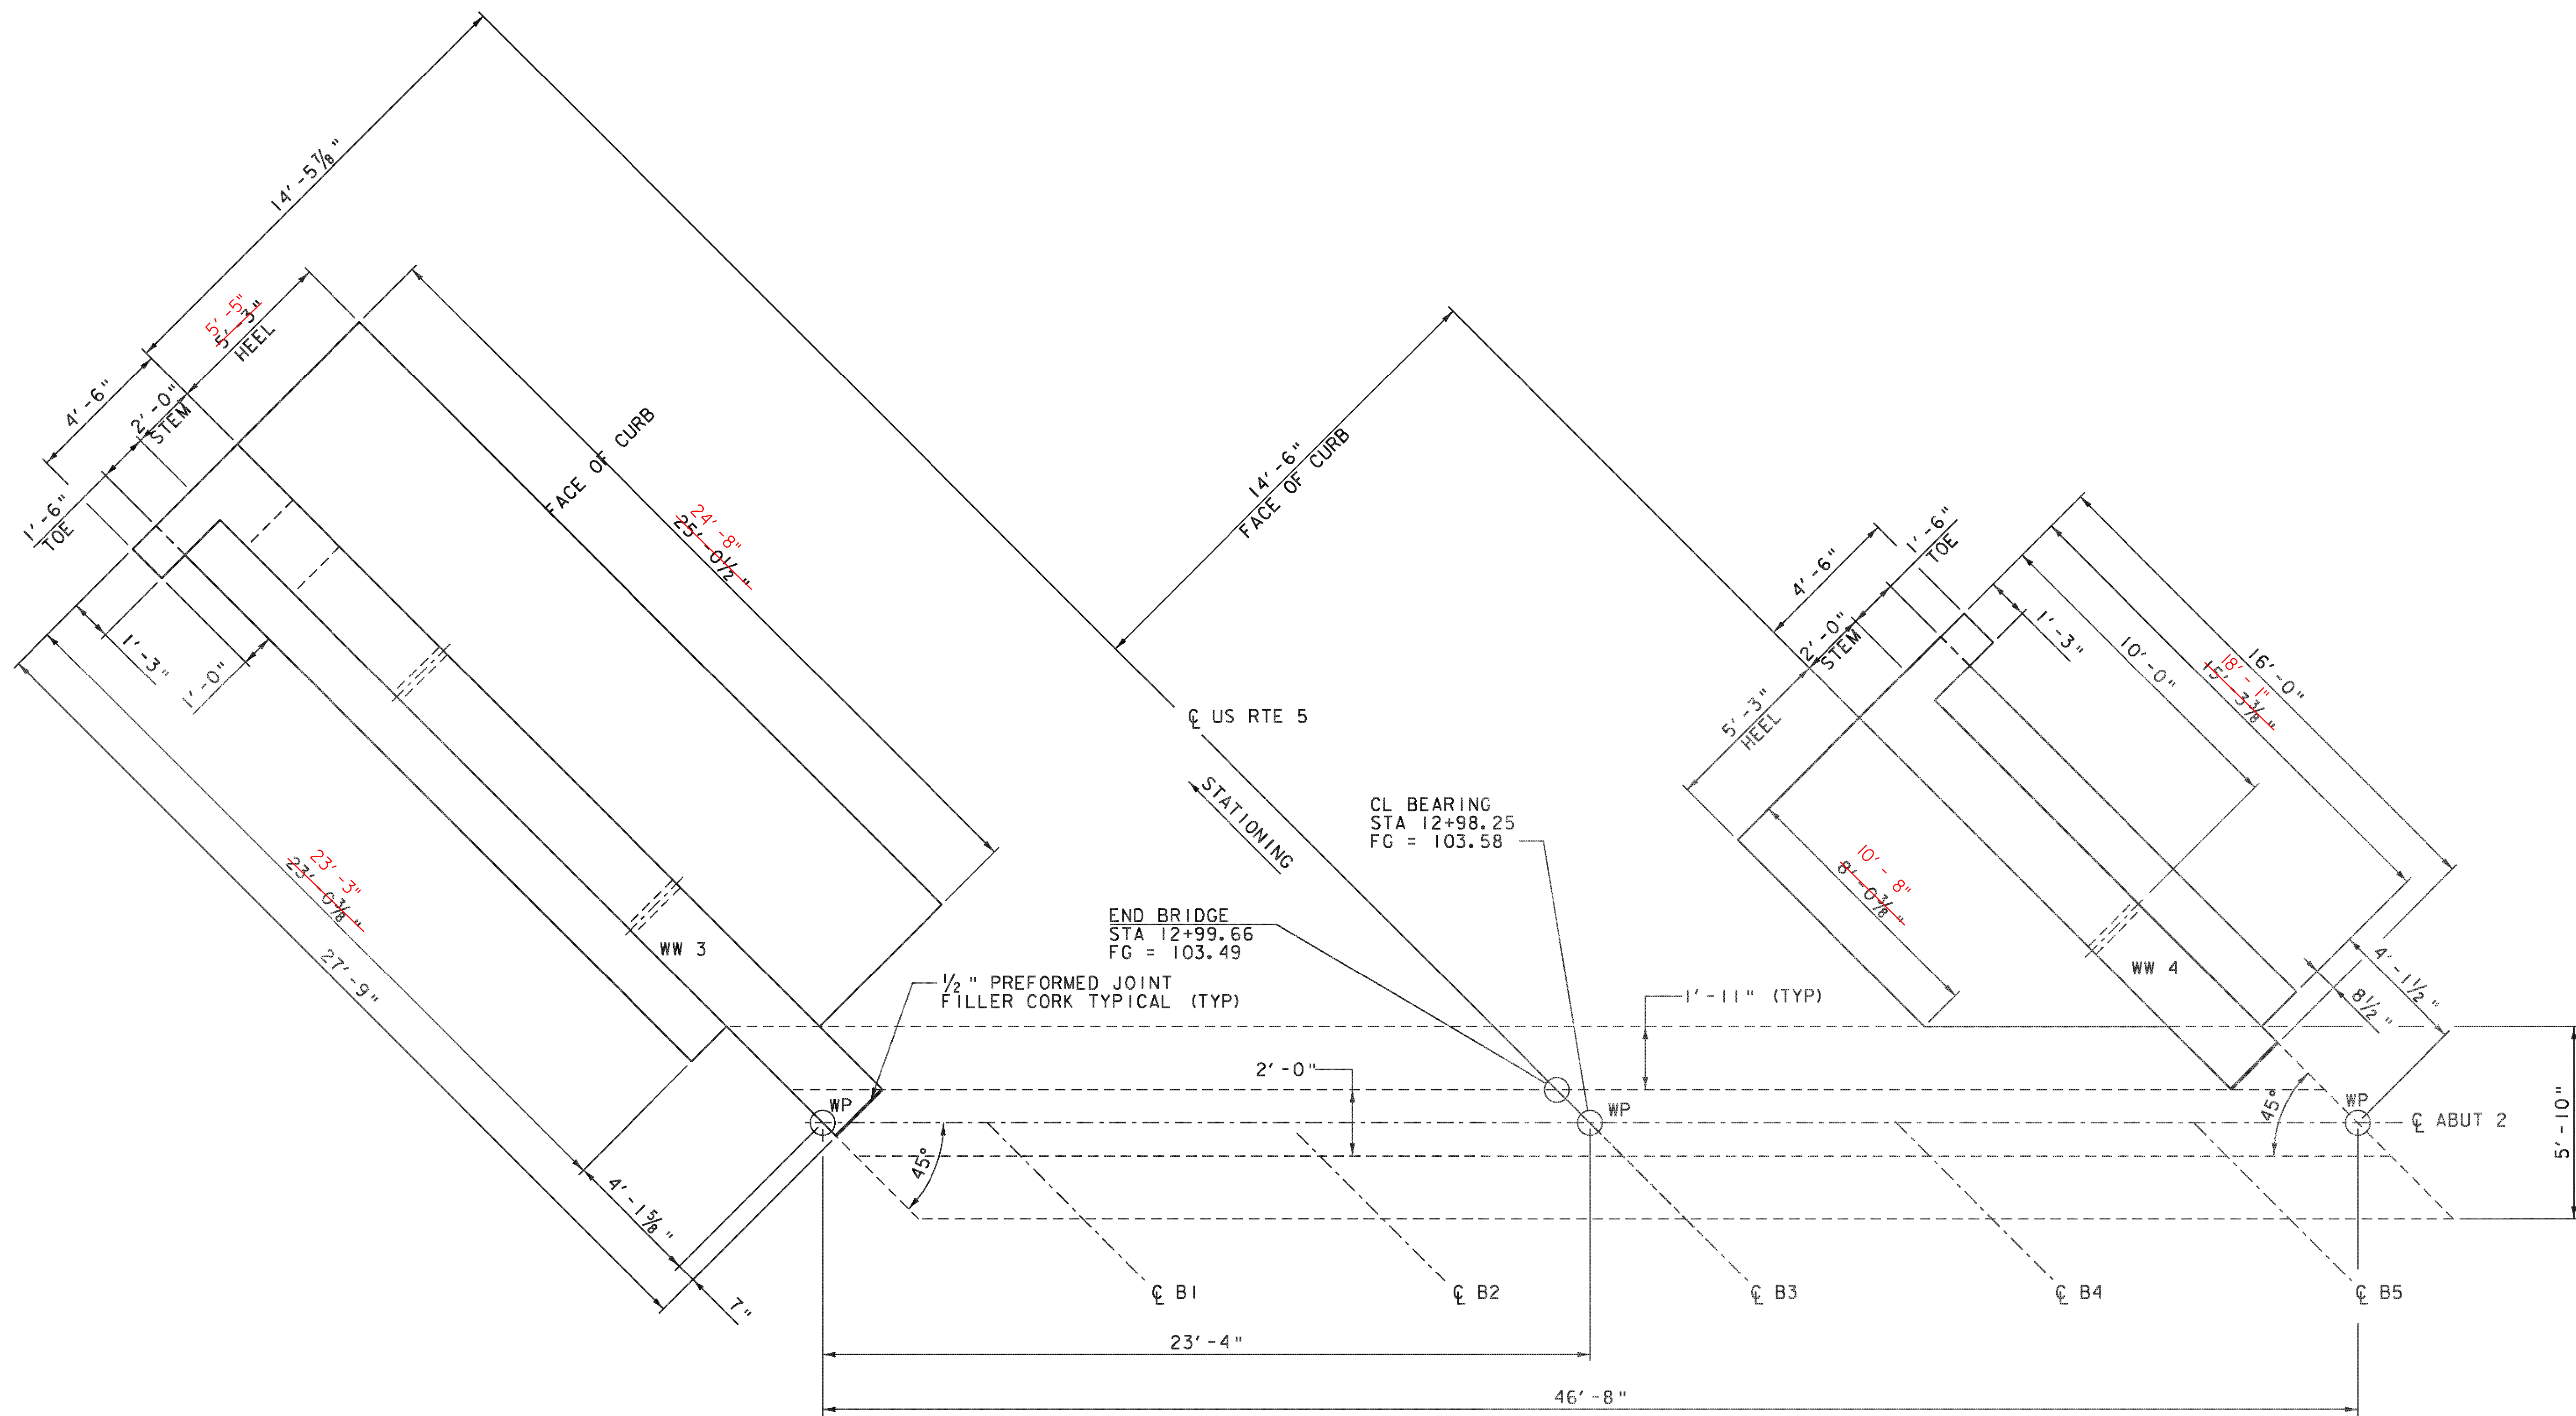


ABUTMENT 2 PLAN  
SCALE 3/8" = 1'-0"




PROJECT NAME:	HARTLAND	PLOT DATE:	1/2/2014
PROJECT NUMBER:	BHF BPNT(12)	DRAWN BY:	A.J. GOUDREAU
FILE NAME:	zllc260sub.dgn	DESIGNED BY:	S.G. FARNSWORTH
PROJECT LEADER:	M.A. COLGAN	BR 62A ABUTMENT 2 PLAN	CHECKED BY: S.E. BURBANK
			SHEET 27 OF 55


REVISED SHEET

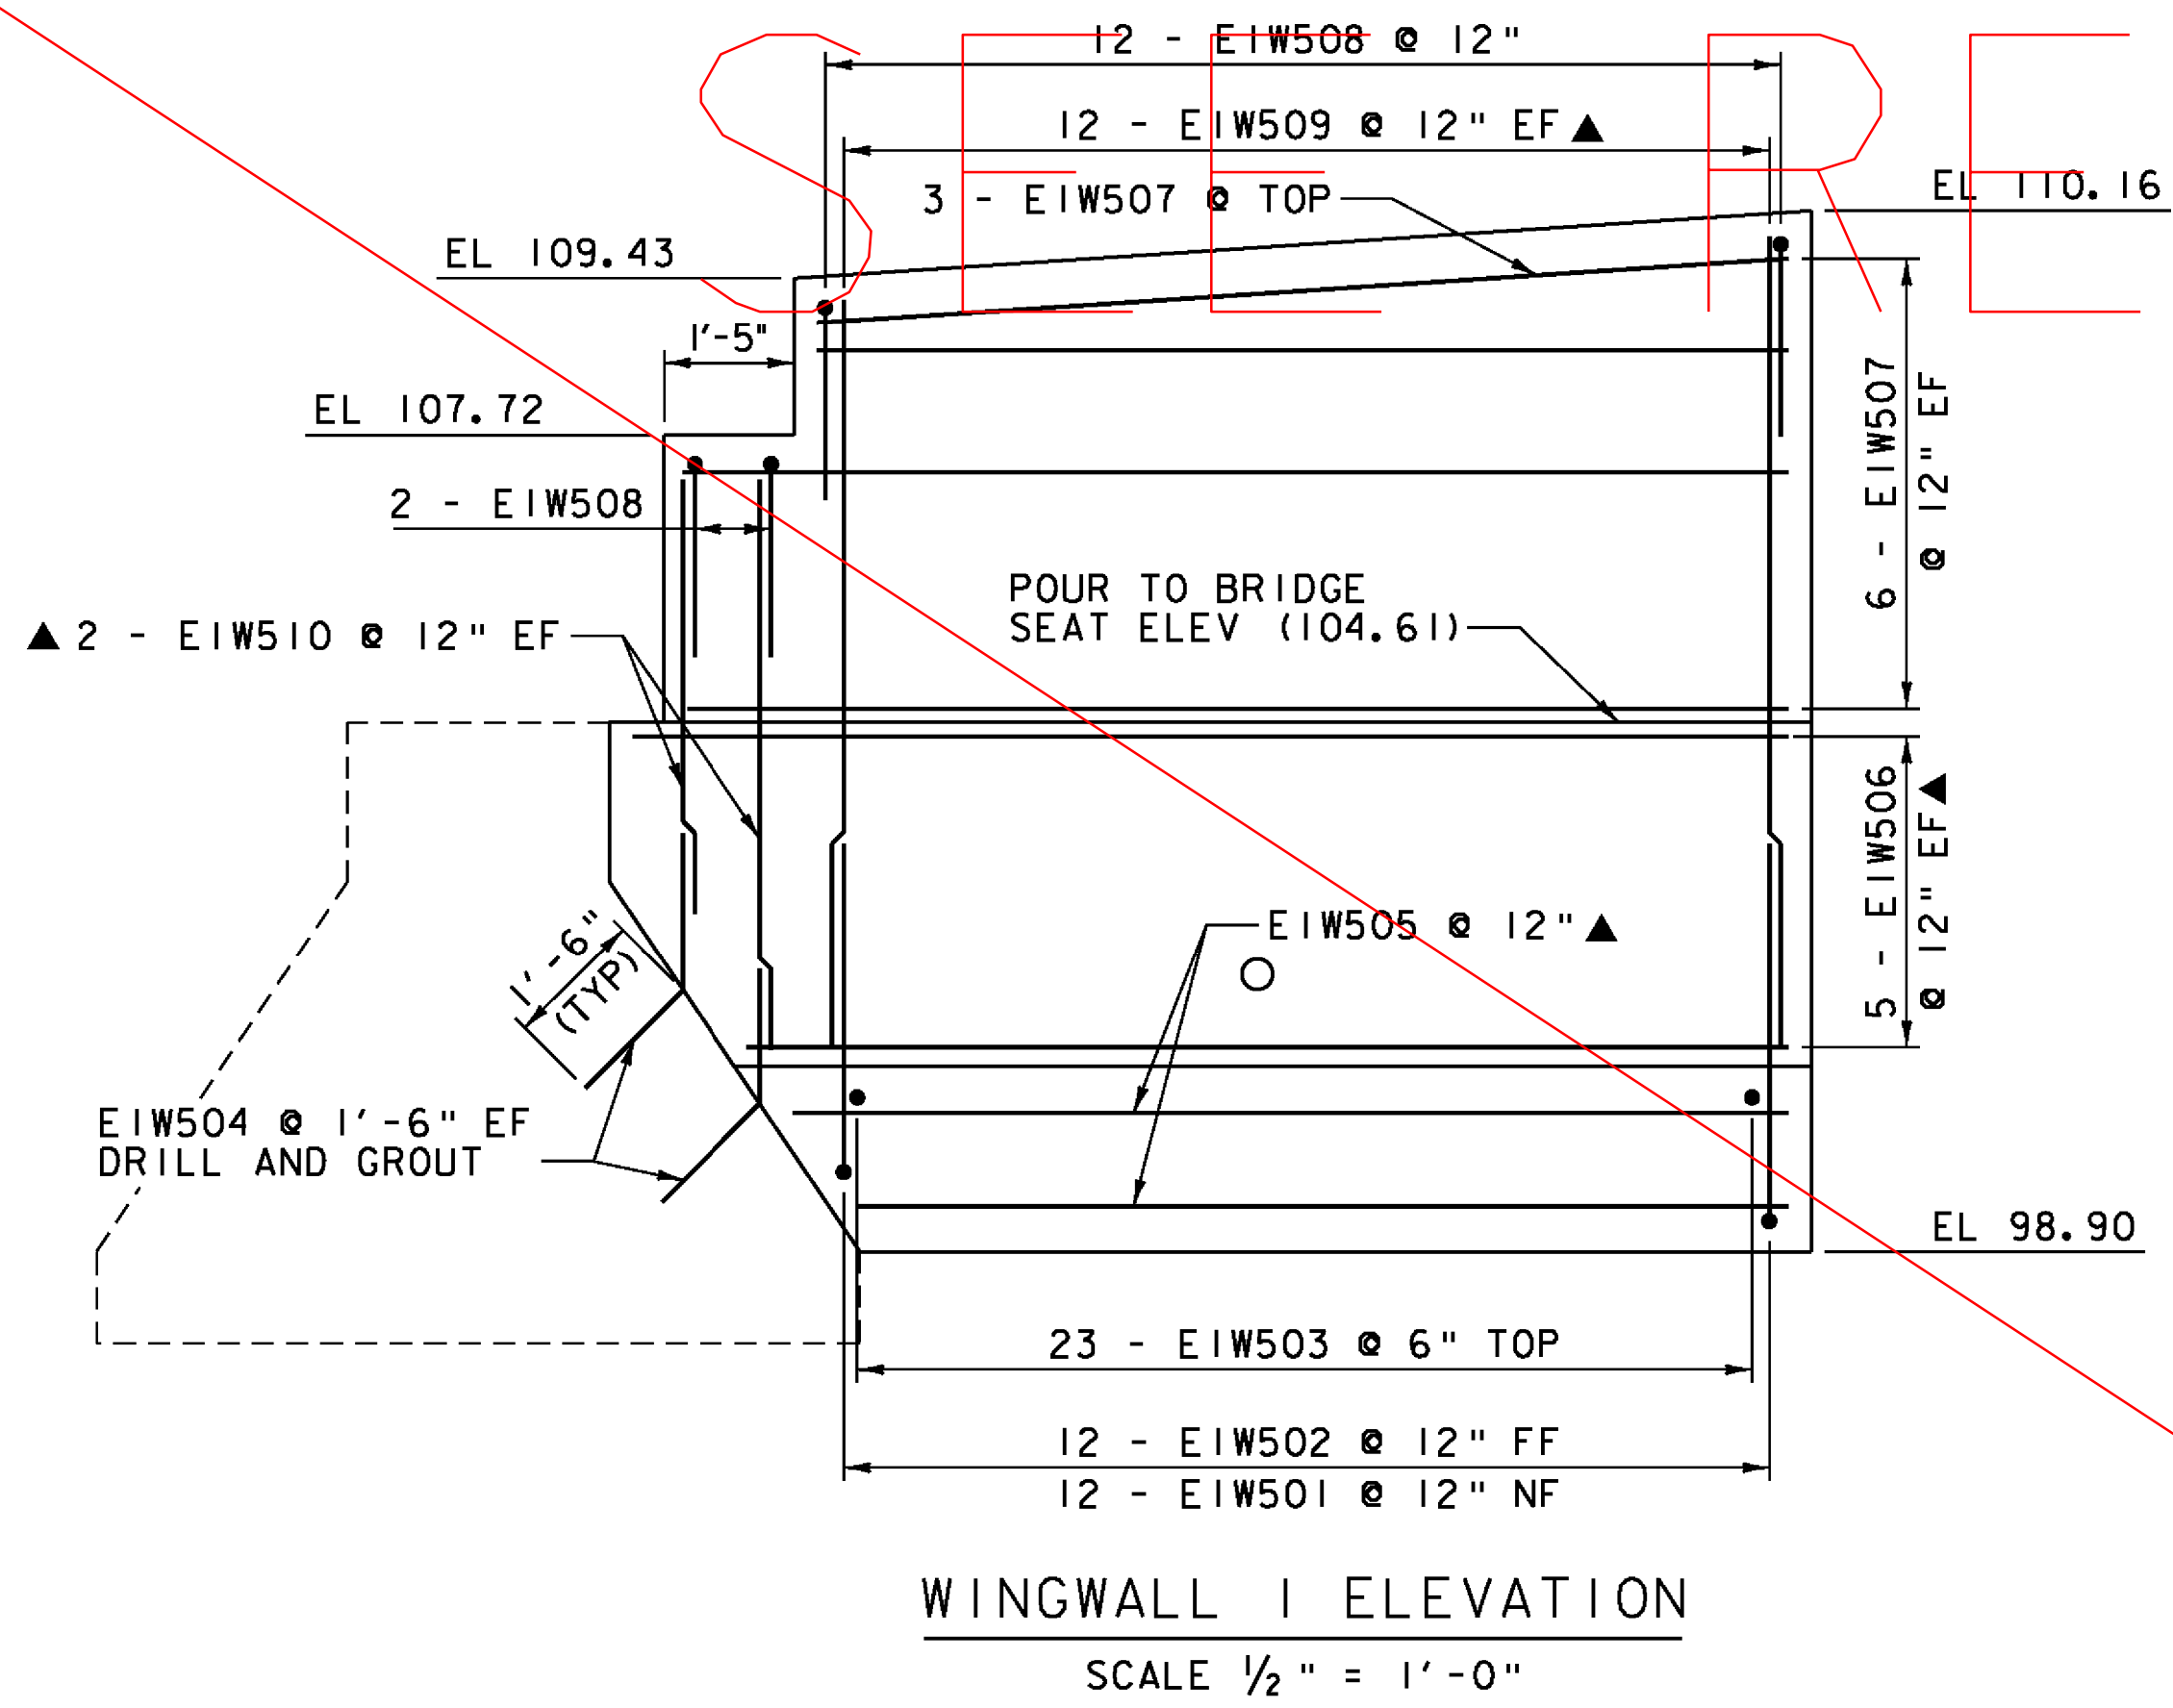

**WINGWALL 1 ELEVATION**  
SCALE 1/2" = 1'-0"

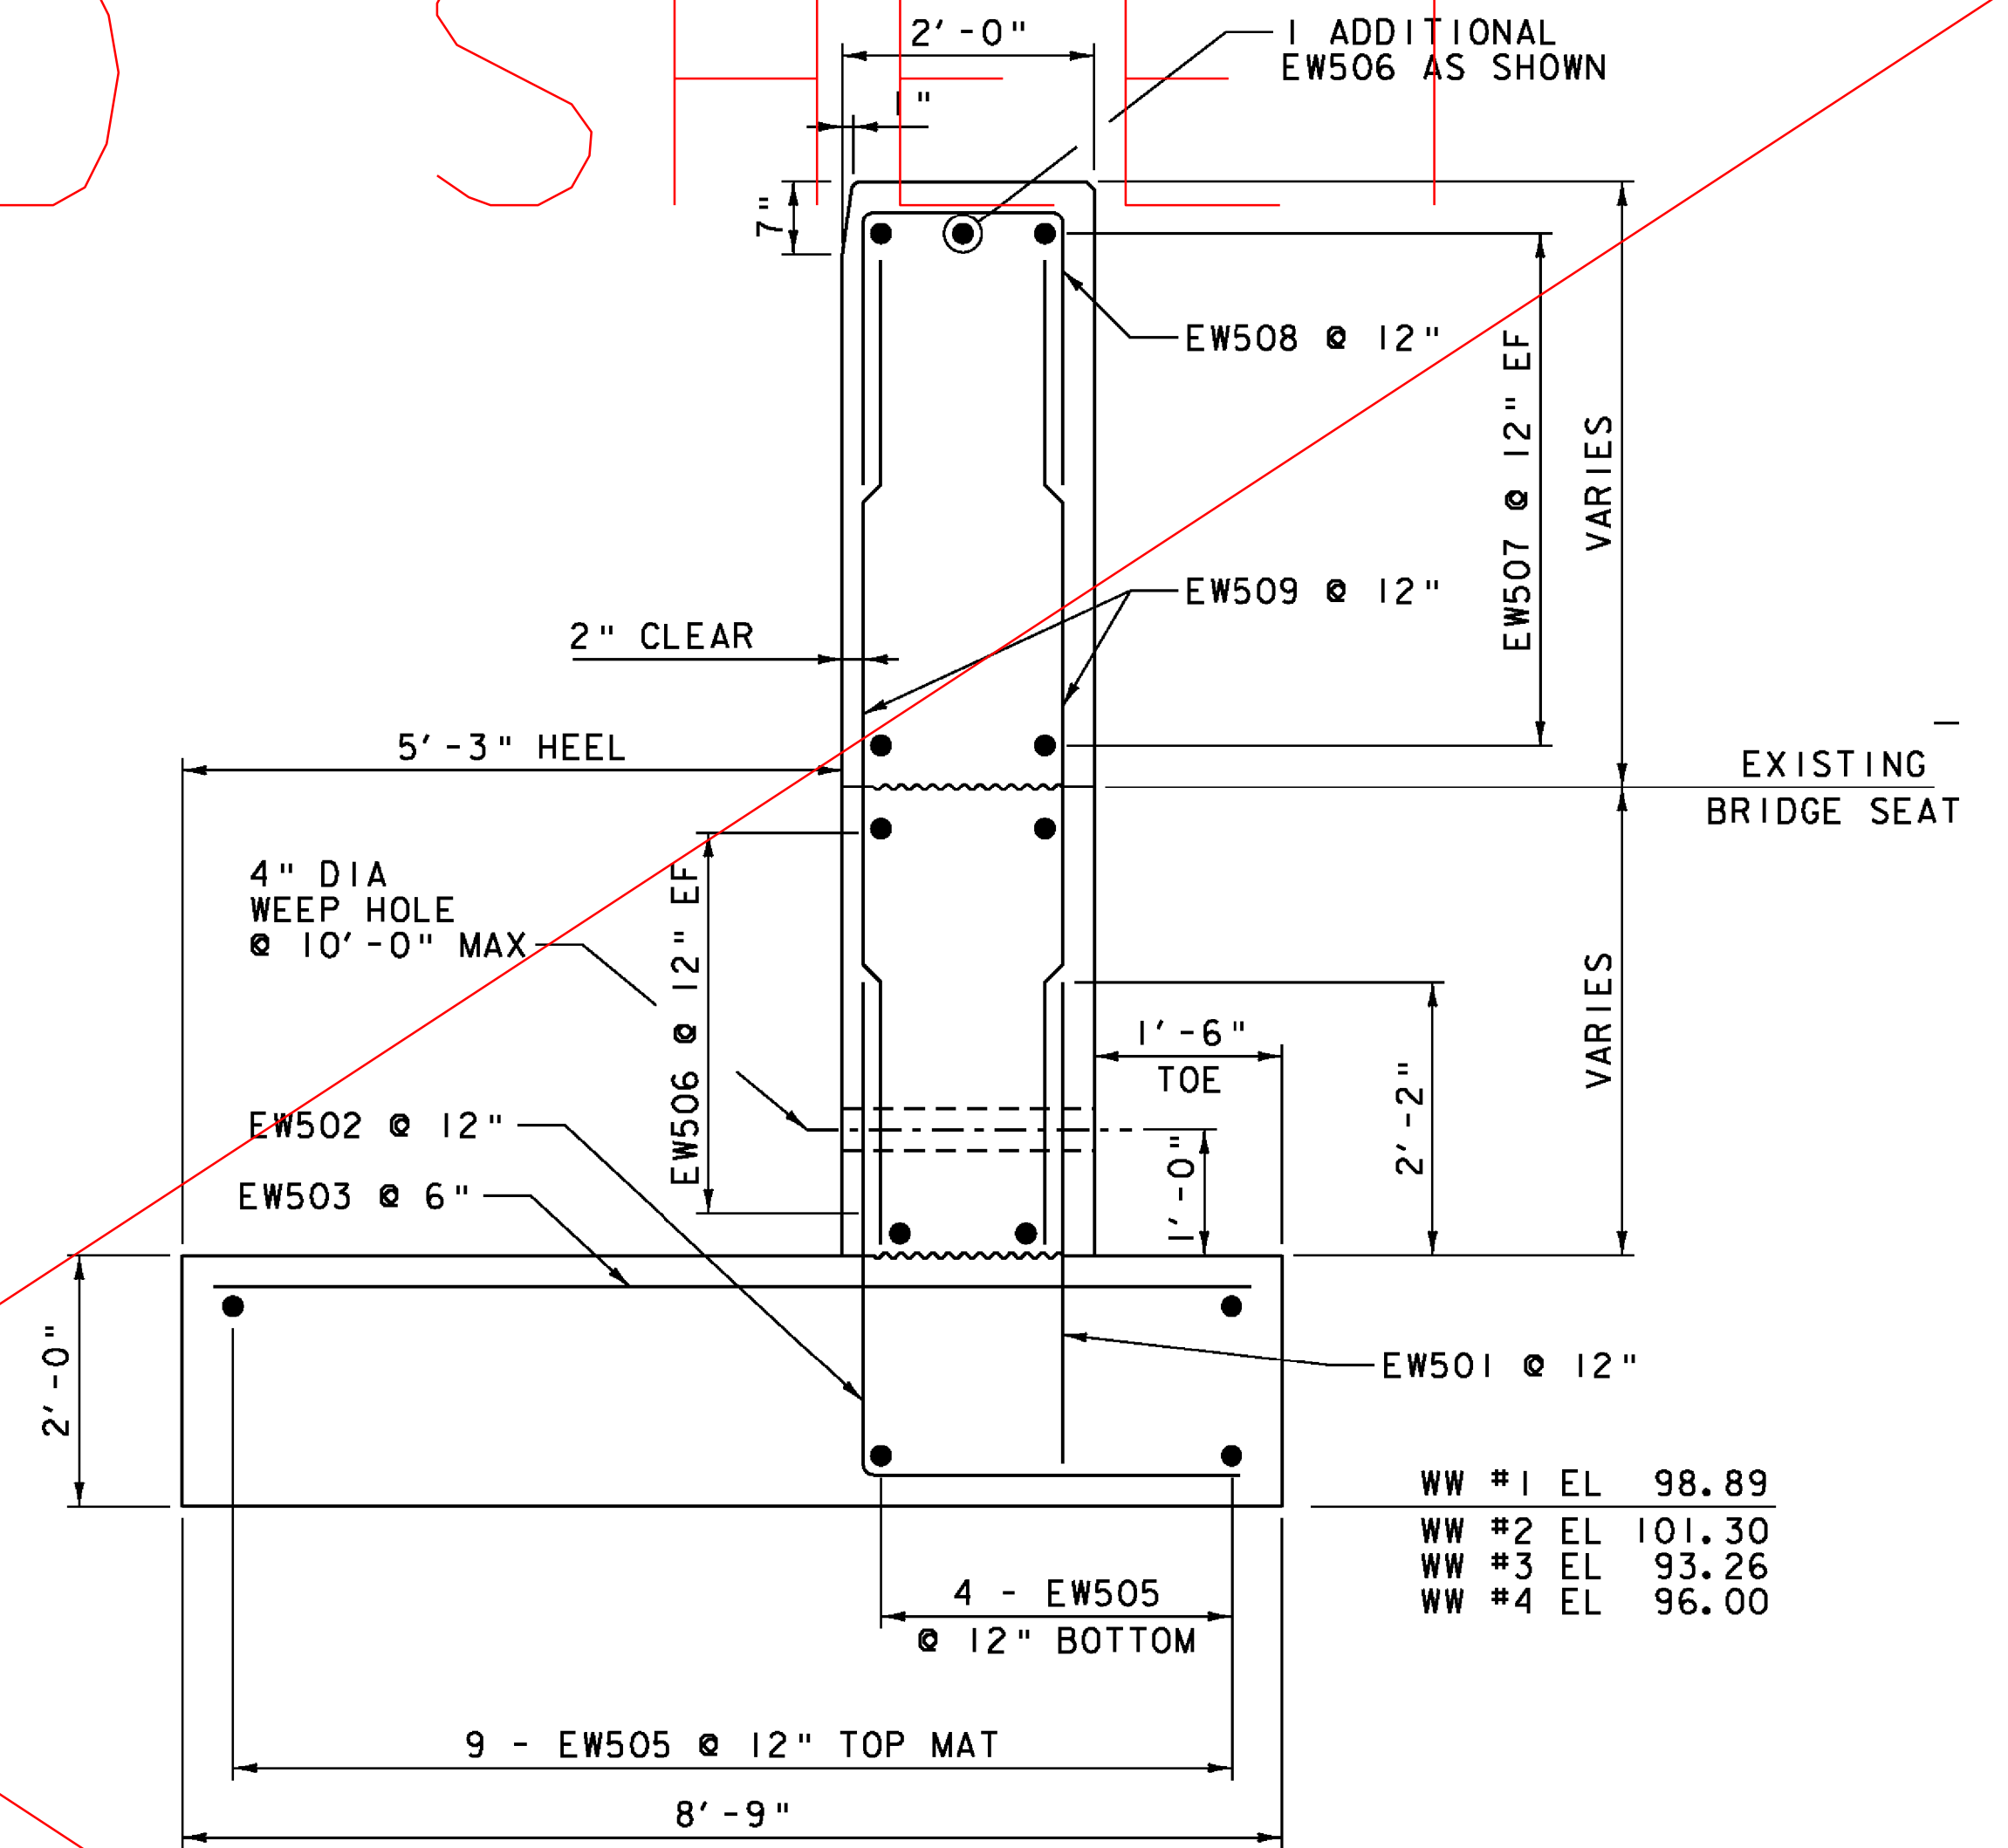

**WINGWALL TYPICAL SECTION**  
SCALE 3/4" = 1'-0"

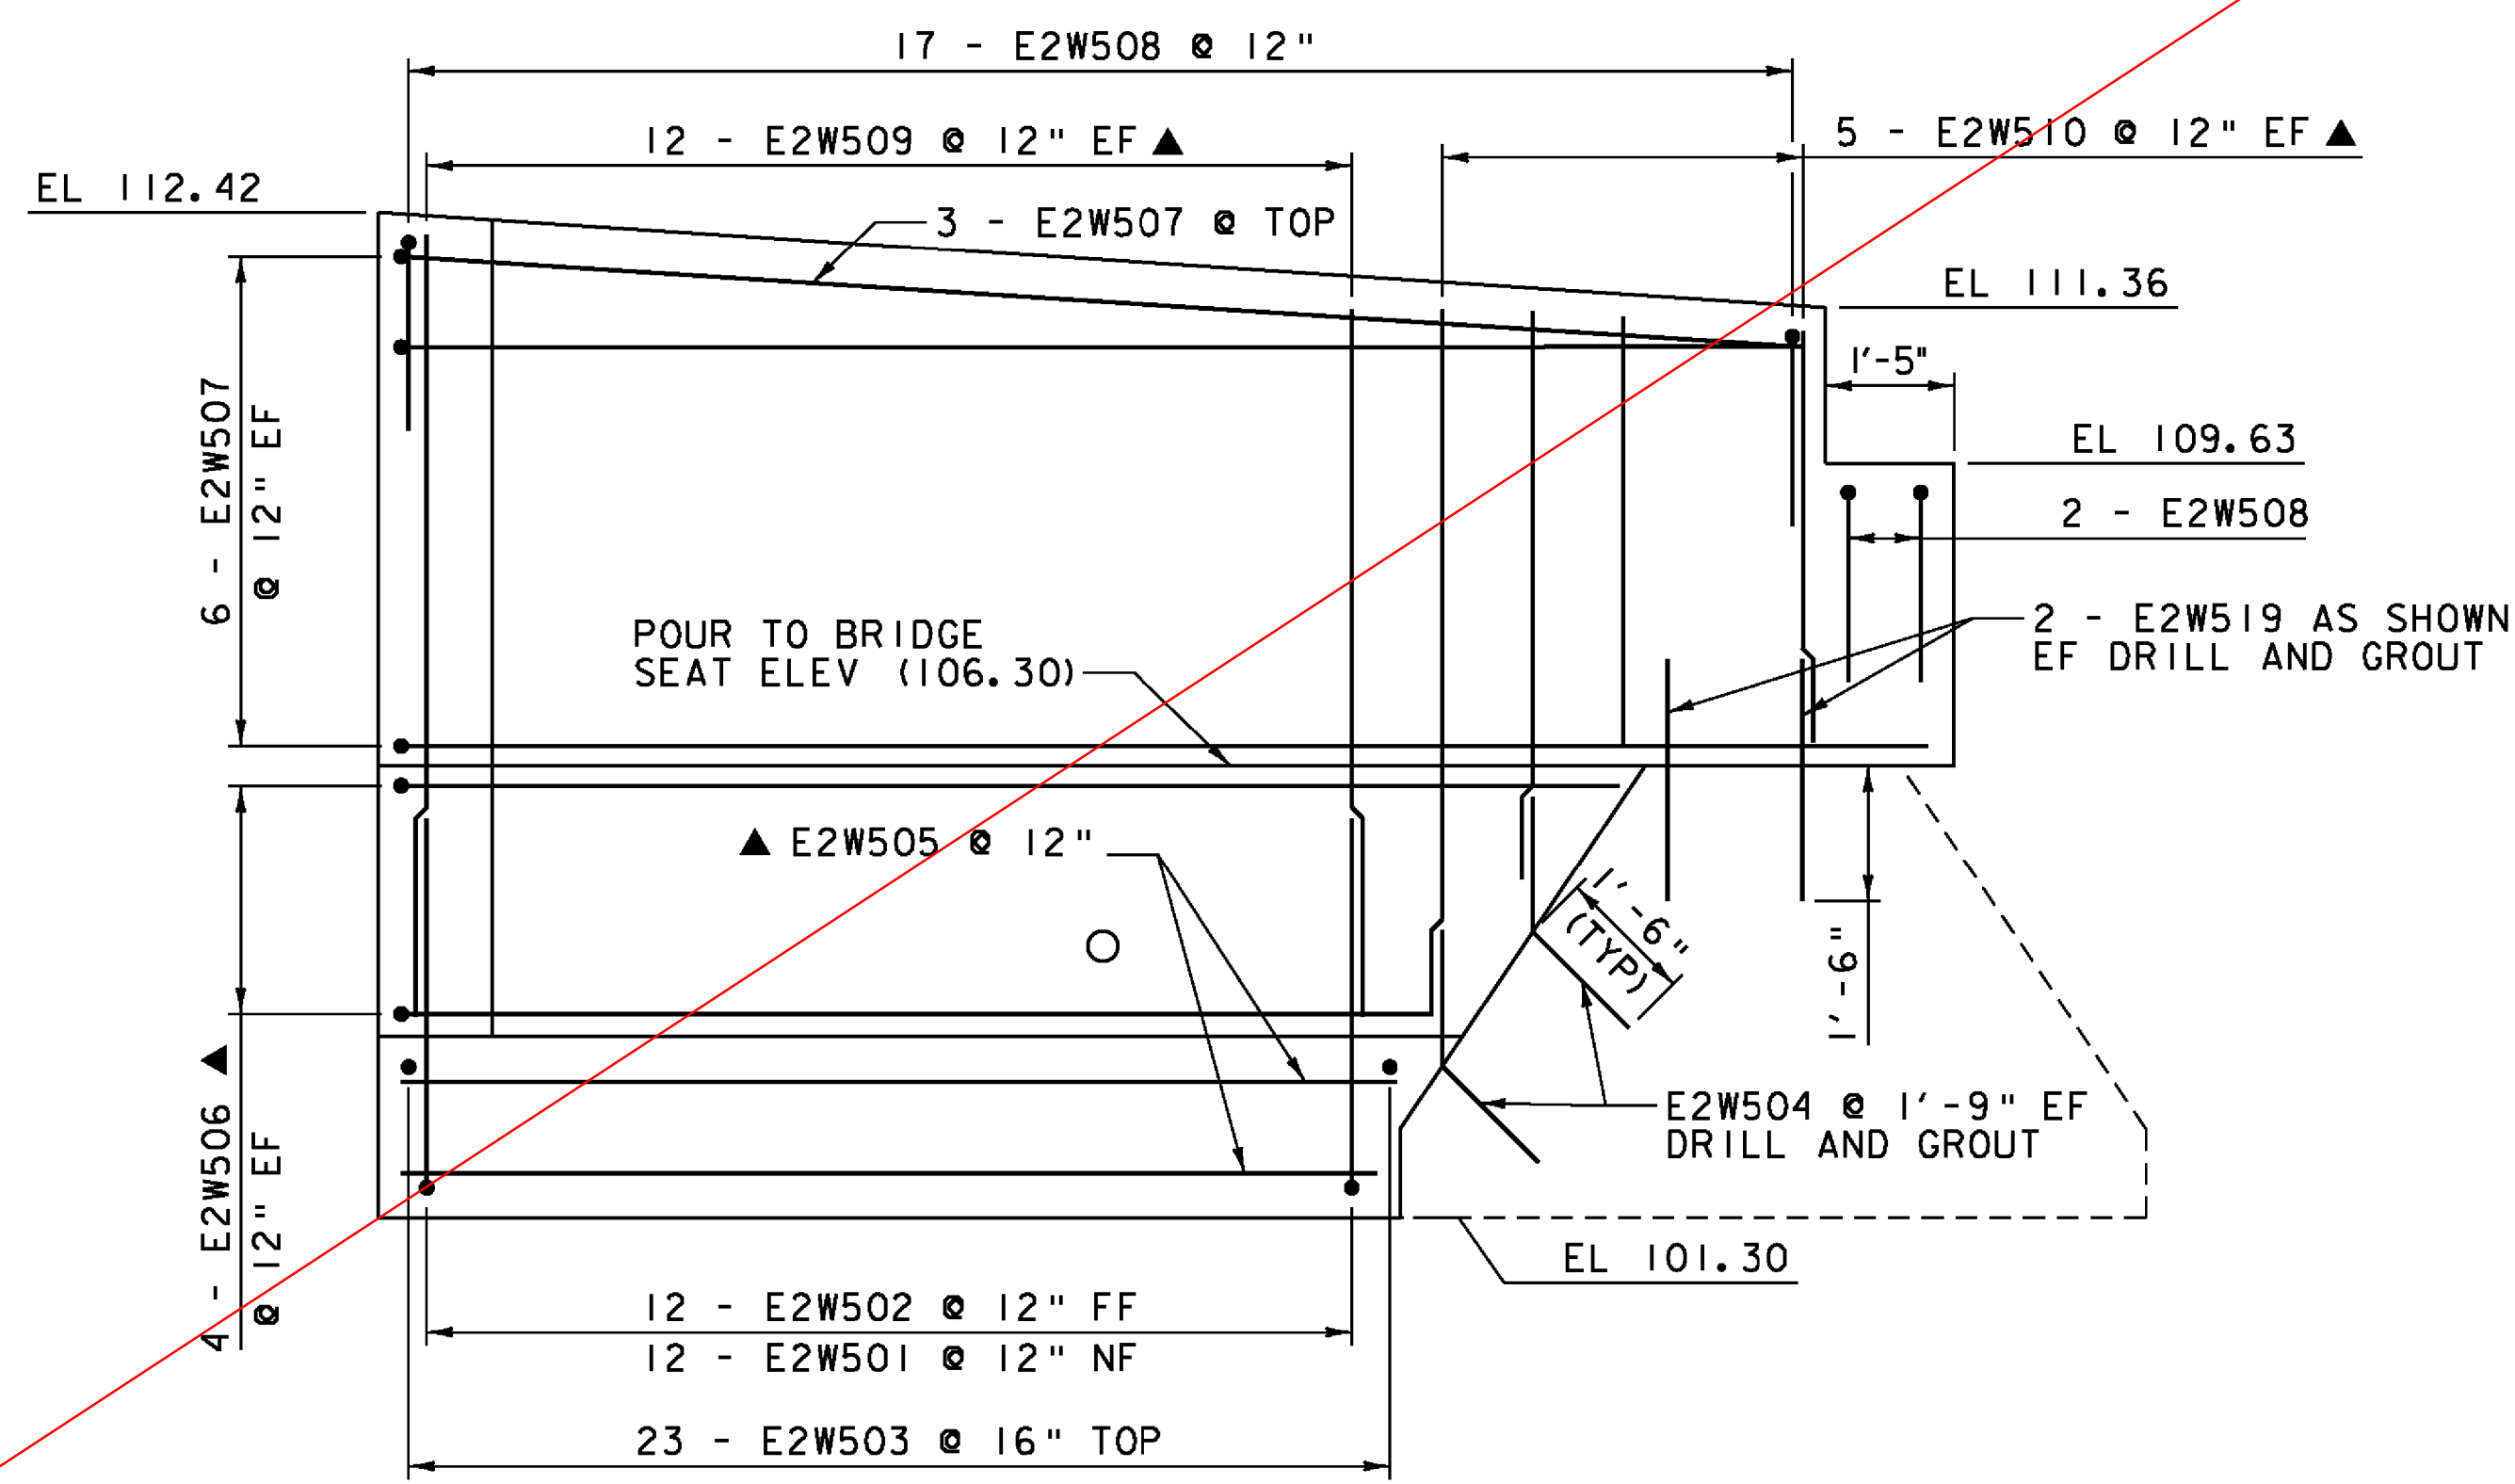


**WINGWALL 2 ELEVATION**  
SCALE 1/2" = 1'-0"


**NOTE:**  
 NF = NEAR FACE  
 FF = FAR FACE  
 EF = EACH FACE  
 ▲ = CUT TO FIT IN FIELD  
 3" CLEAR, UNLESS OTHERWISE SPECIFIED ON THE PLANS.  
 2'-2" BAR LAP UNLESS OTHERWISE SPECIFIED ON THE PLANS.  
 DRILL & GROUT IN 2" DIA HOLES

PROJECT NAME: HARTLAND	
PROJECT NUMBER: BHF BPNT(12)	
FILE NAME: zllc260sub.dgn	PLOT DATE: 1/2/2014
PROJECT LEADER: M.A. COLGAN	DRAWN BY: A.J. GOUDREAU
DESIGNED BY: A.J. GOUDREAU	CHECKED BY: S.G. FARNSWORTH
BR 62A WINGWALL DETAILS (1 OF 2)	SHEET 28 OF 55




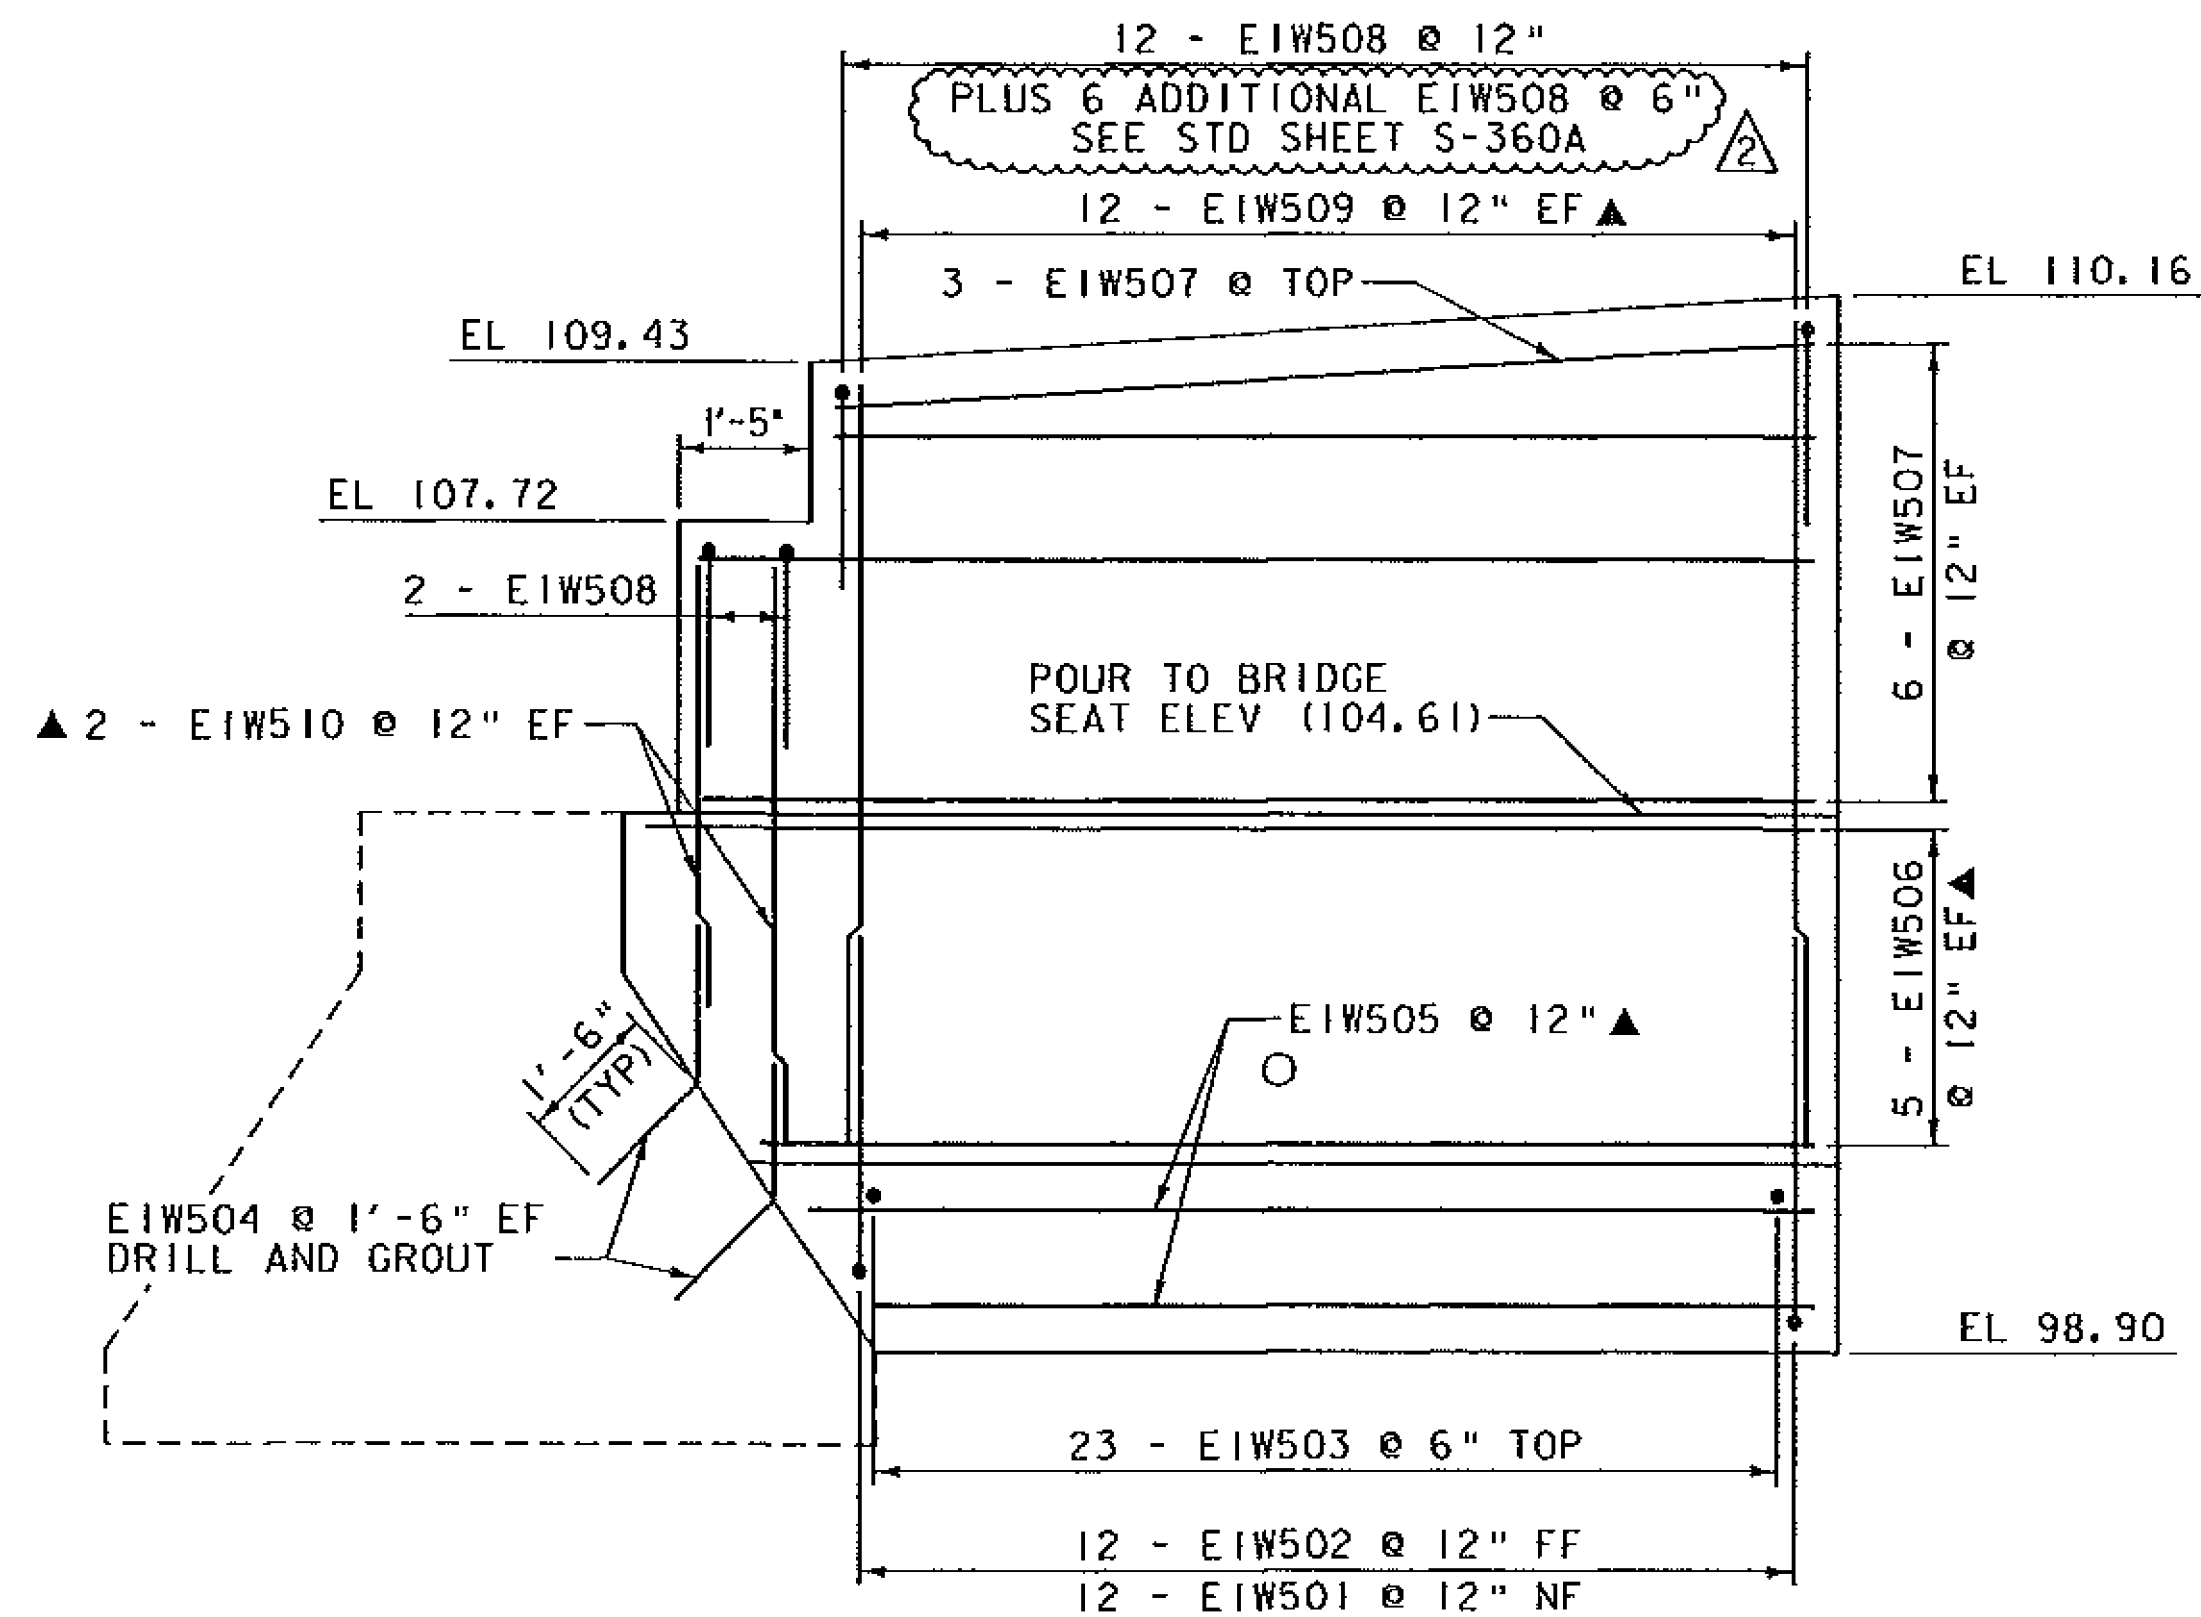

**WINGWALL 1 ELEVATION**  
SCALE 1/2" = 1'-0"

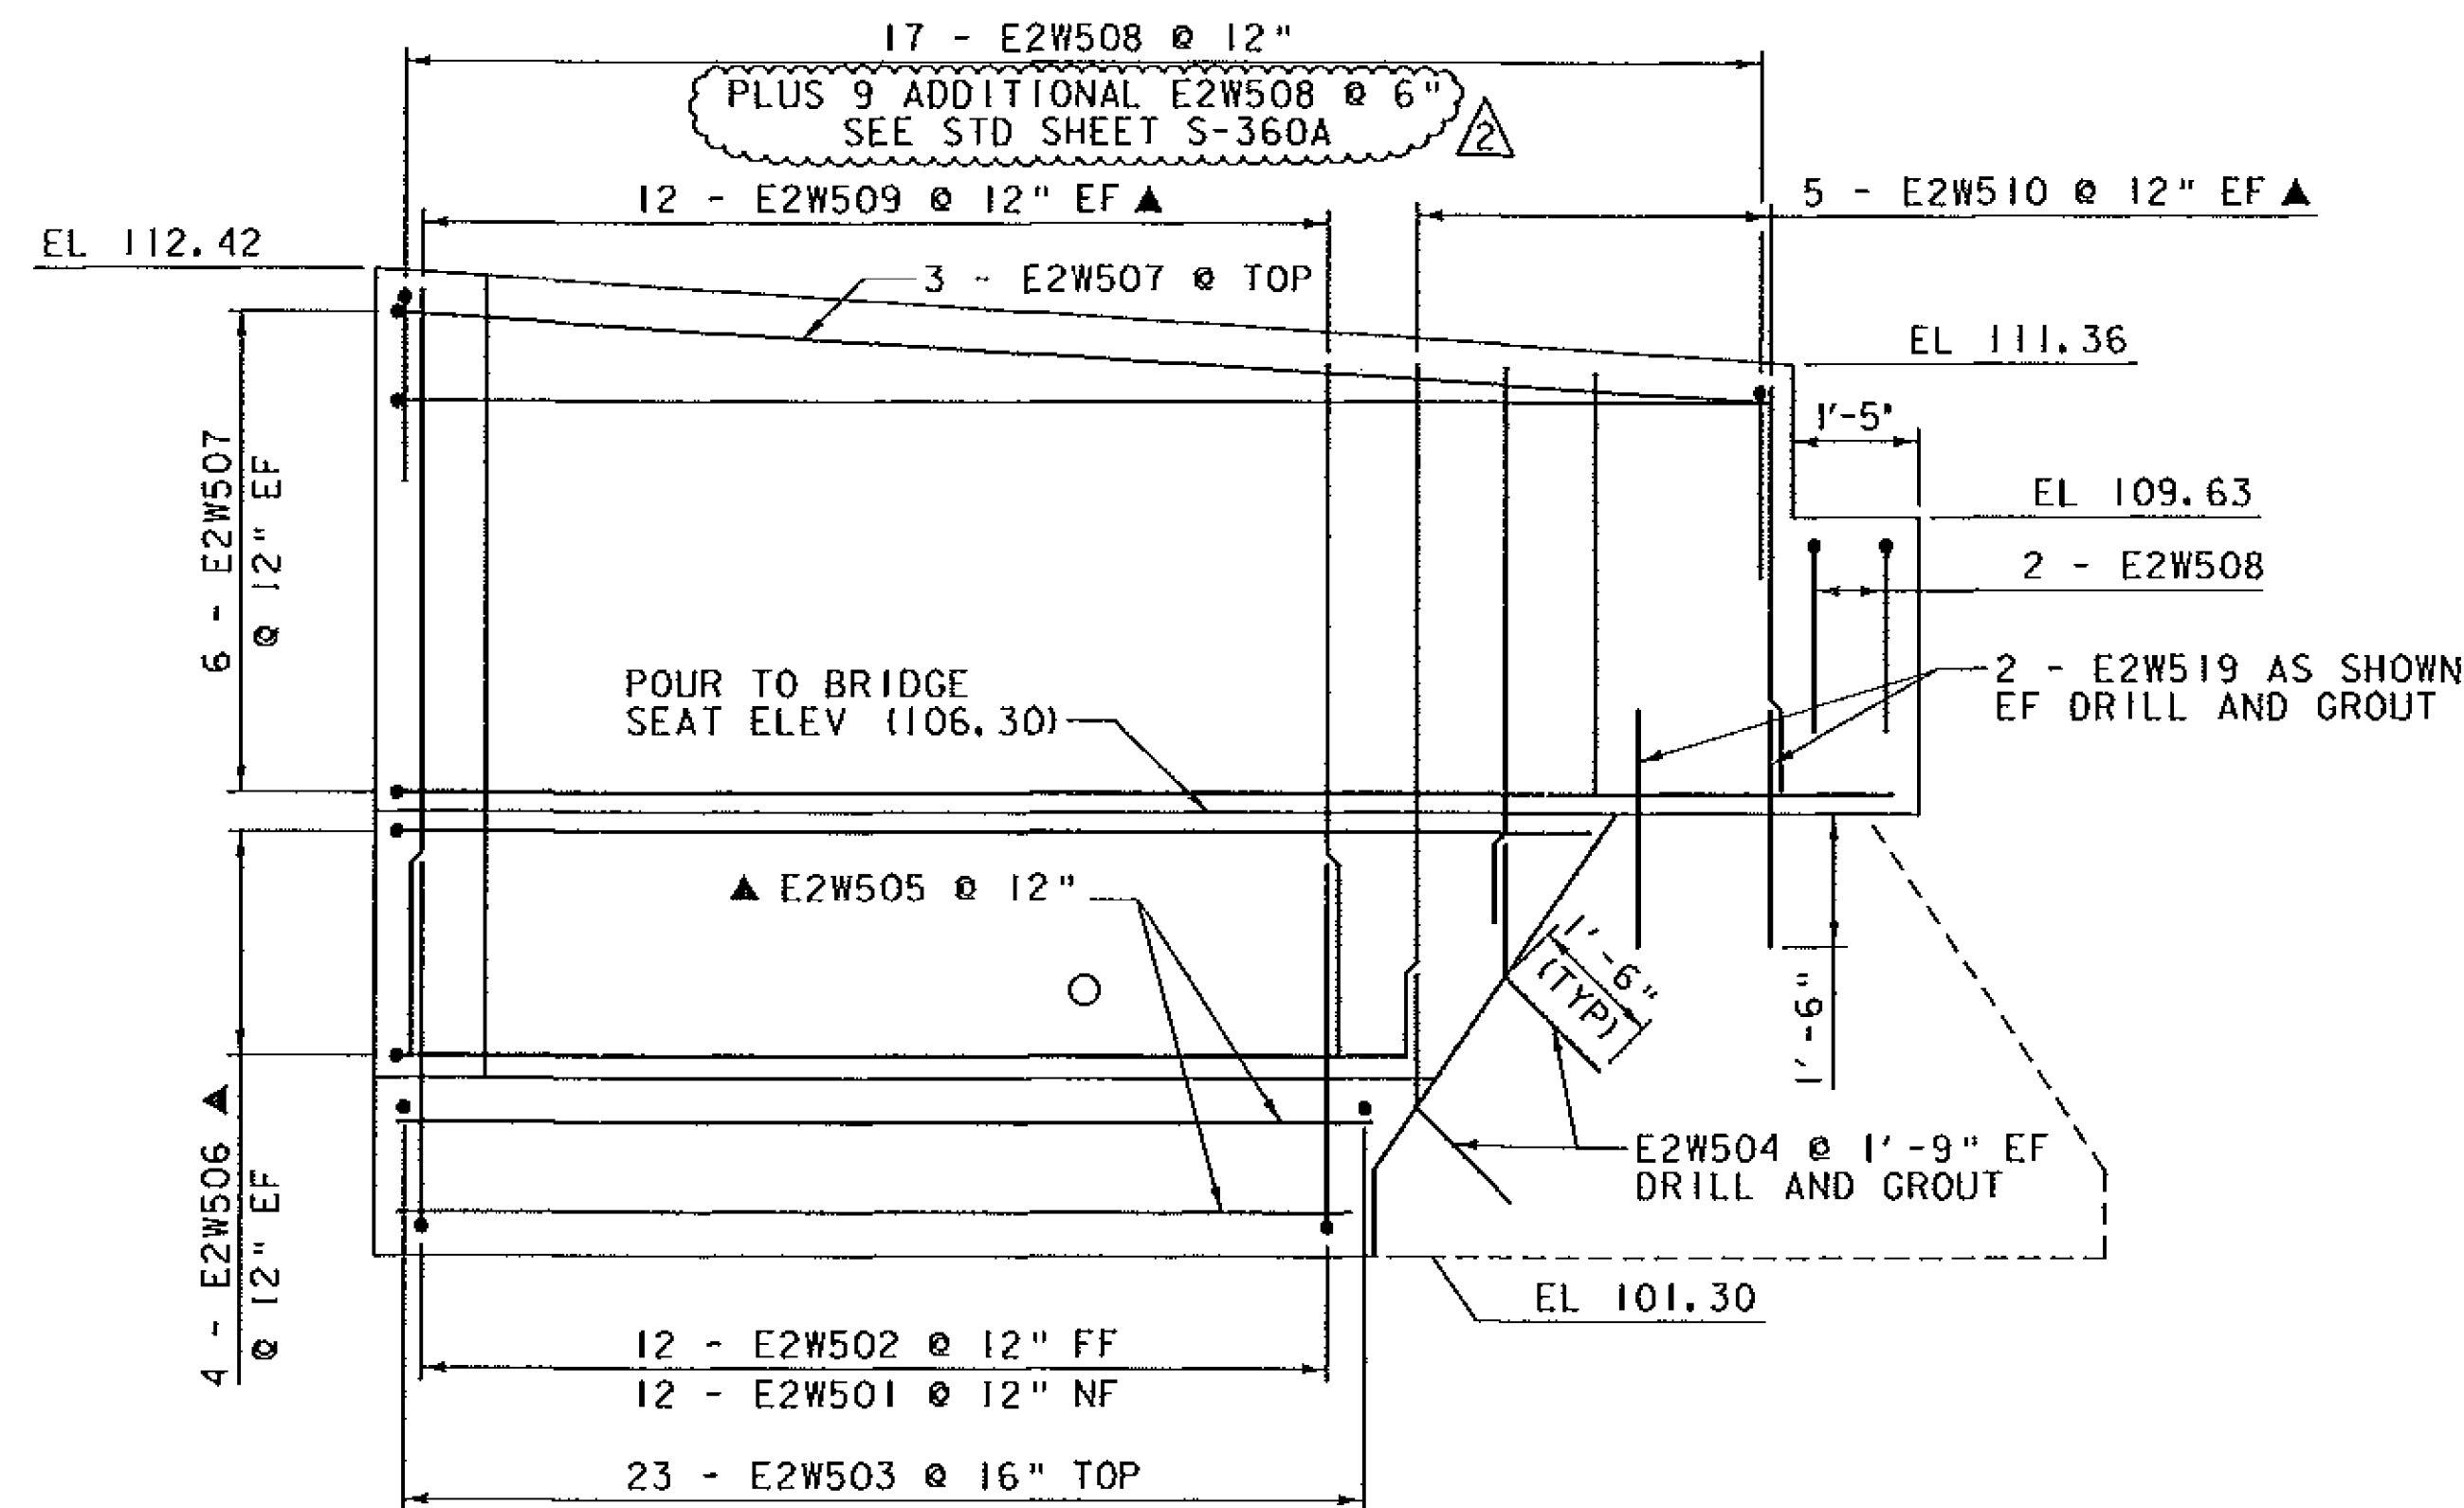

**WINGWALL 2 ELEVATION**  
SCALE 1/2" = 1'-0"

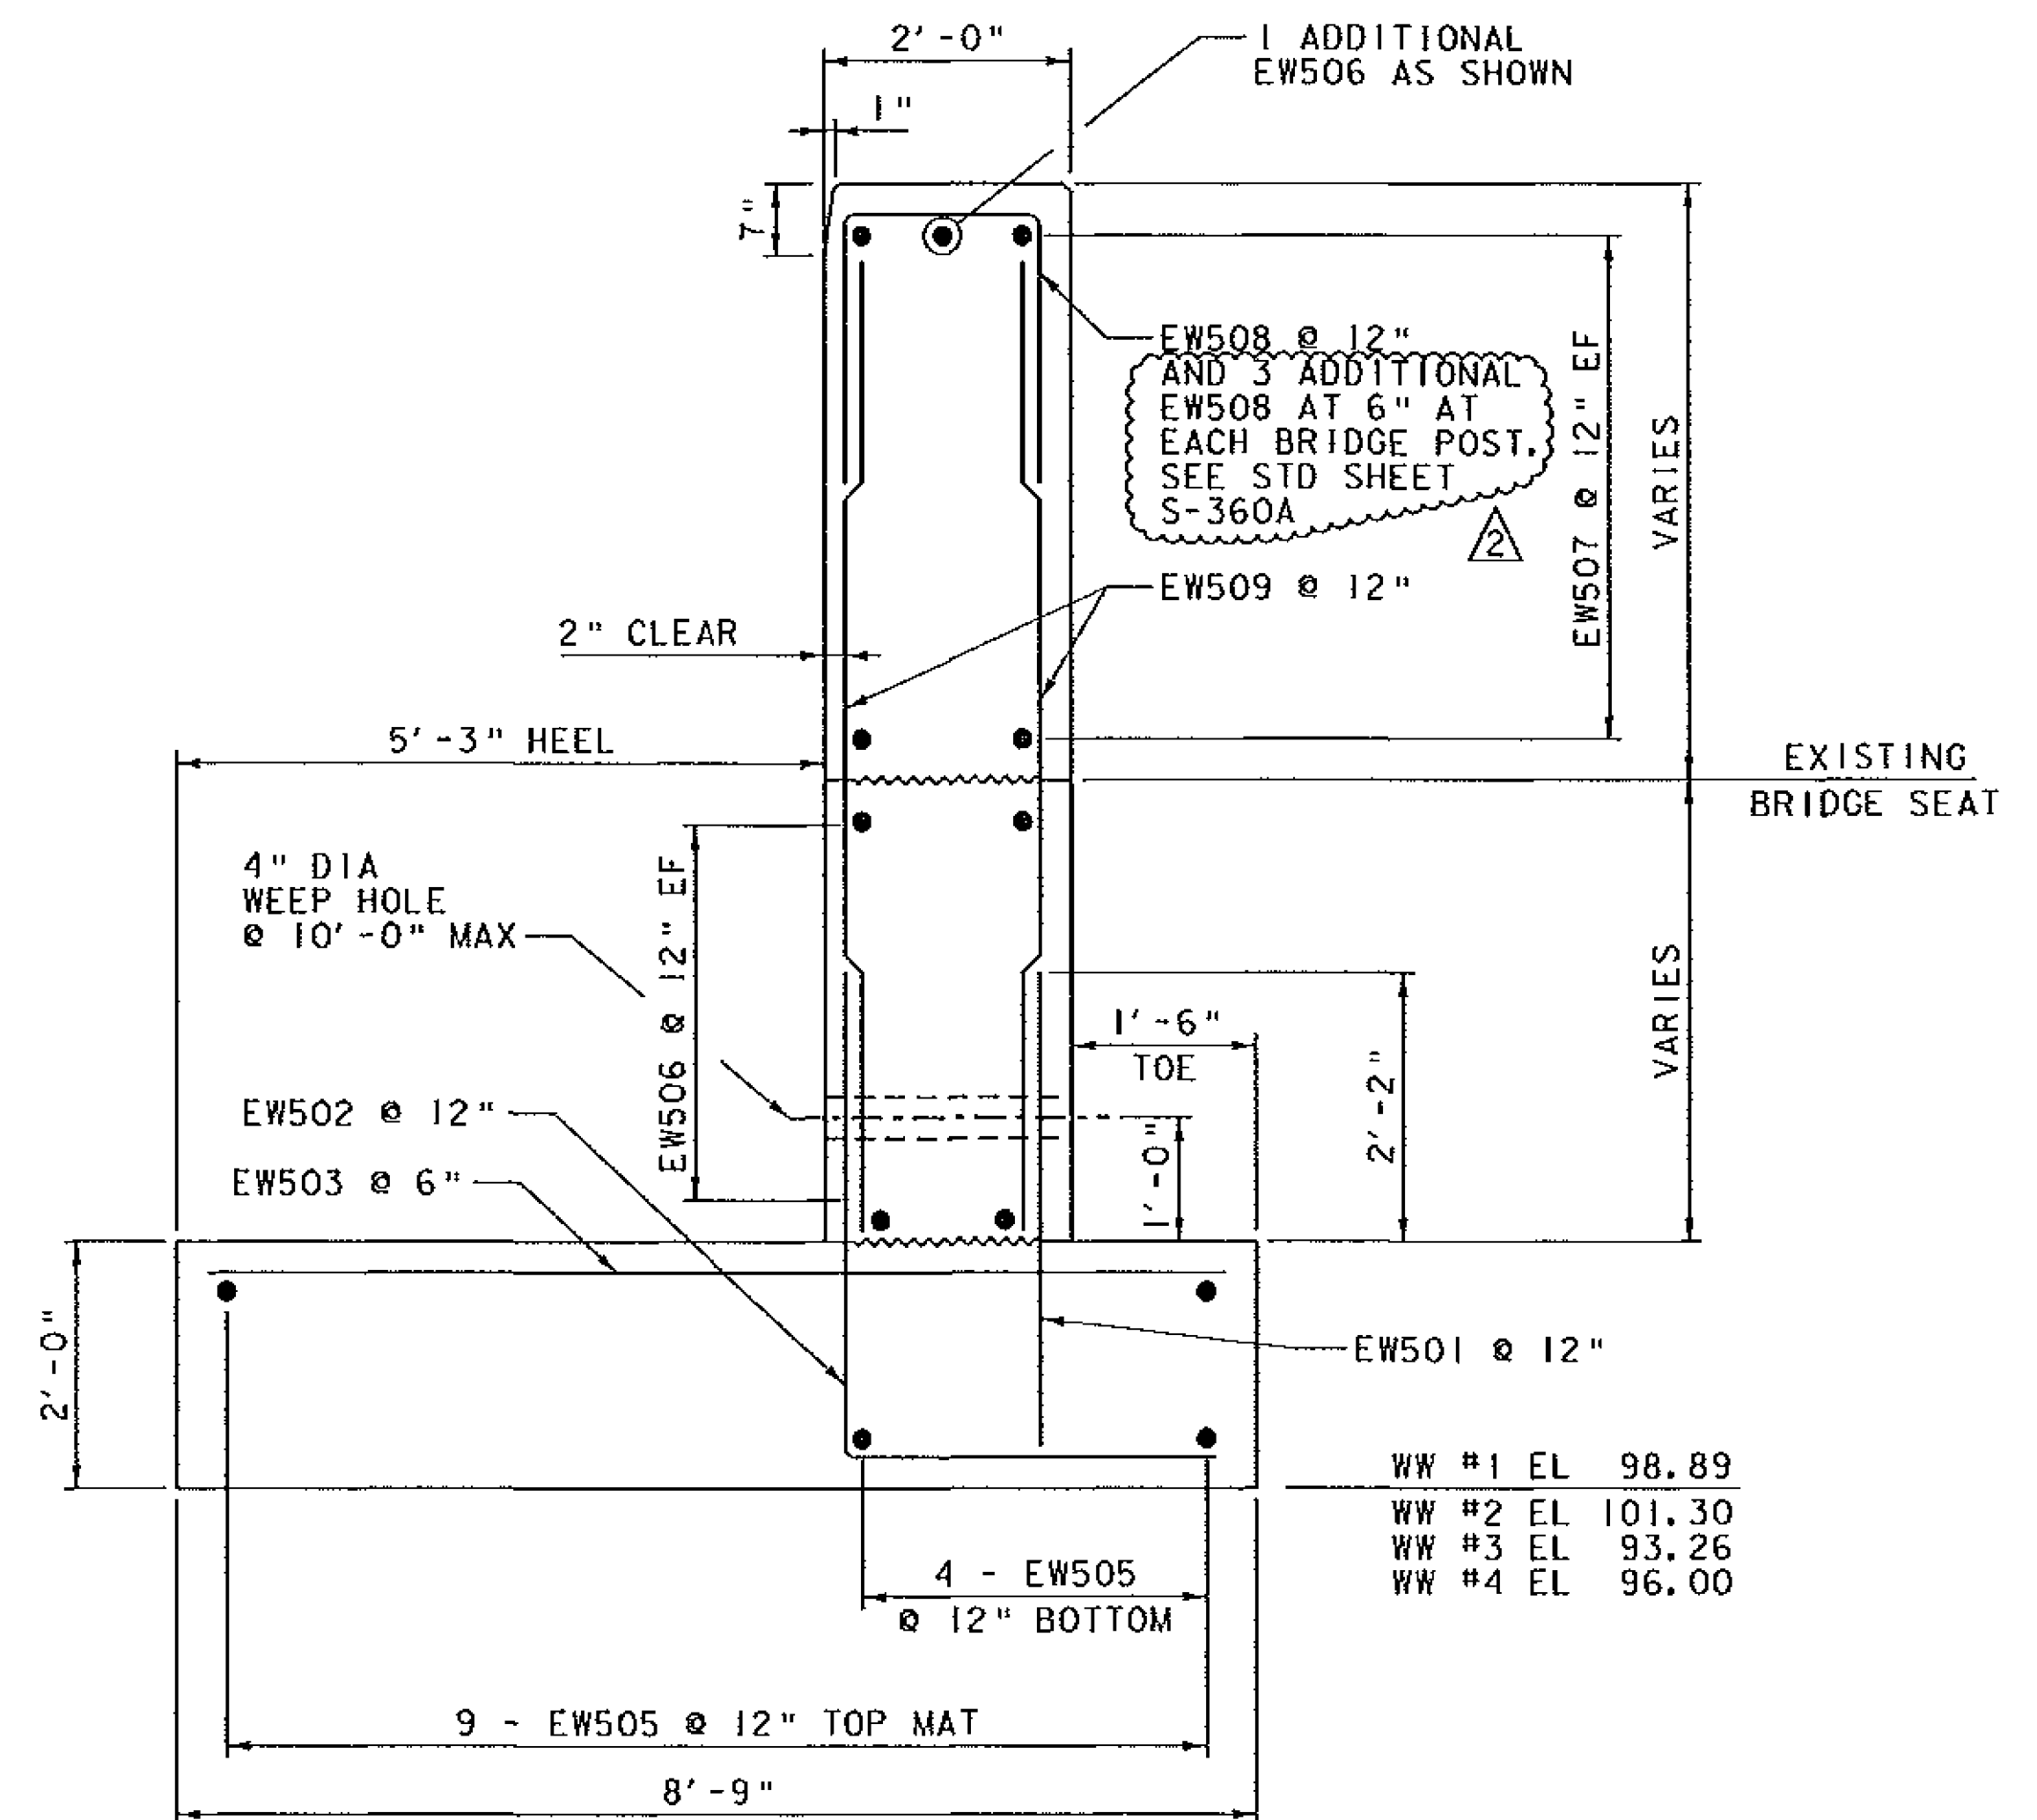


**WINGWALL TYPICAL SECTION**  
SCALE 3/4" = 1'-0"

**NOTE:**  
 NF = NEAR FACE  
 FF = FAR FACE  
 EF = EACH FACE  
 ▲ = CUT TO FIT IN FIELD  
 3" CLEAR, UNLESS OTHERWISE SPECIFIED ON THE PLANS.  
 2'-2" BAR LAP UNLESS OTHERWISE SPECIFIED ON THE PLANS.  
 DRILL & GROUT IN 2" DIA HOLES


REV.	DESCRIPTION	DATE
△	ADDITIONAL EW508 AT POSTS	3/3/2014
PROJECT NAME: HARTLAND		
PROJECT NUMBER: BHF BPNT(12)		
FILE NAME: z:\c260sub.dgn		PLOT DATE: 3/3/2014
PROJECT LEADER: M.A. COLGAN		DRAWN BY: A.J. GOUDREAU
DESIGNED BY: A.J. GOUDREAU		CHECKED BY: S.G. FARNSWORTH
BR 62A WINGWALL DETAILS (1 OF 2)		SHEET 28 OF 55




SEE REVISED SHEET

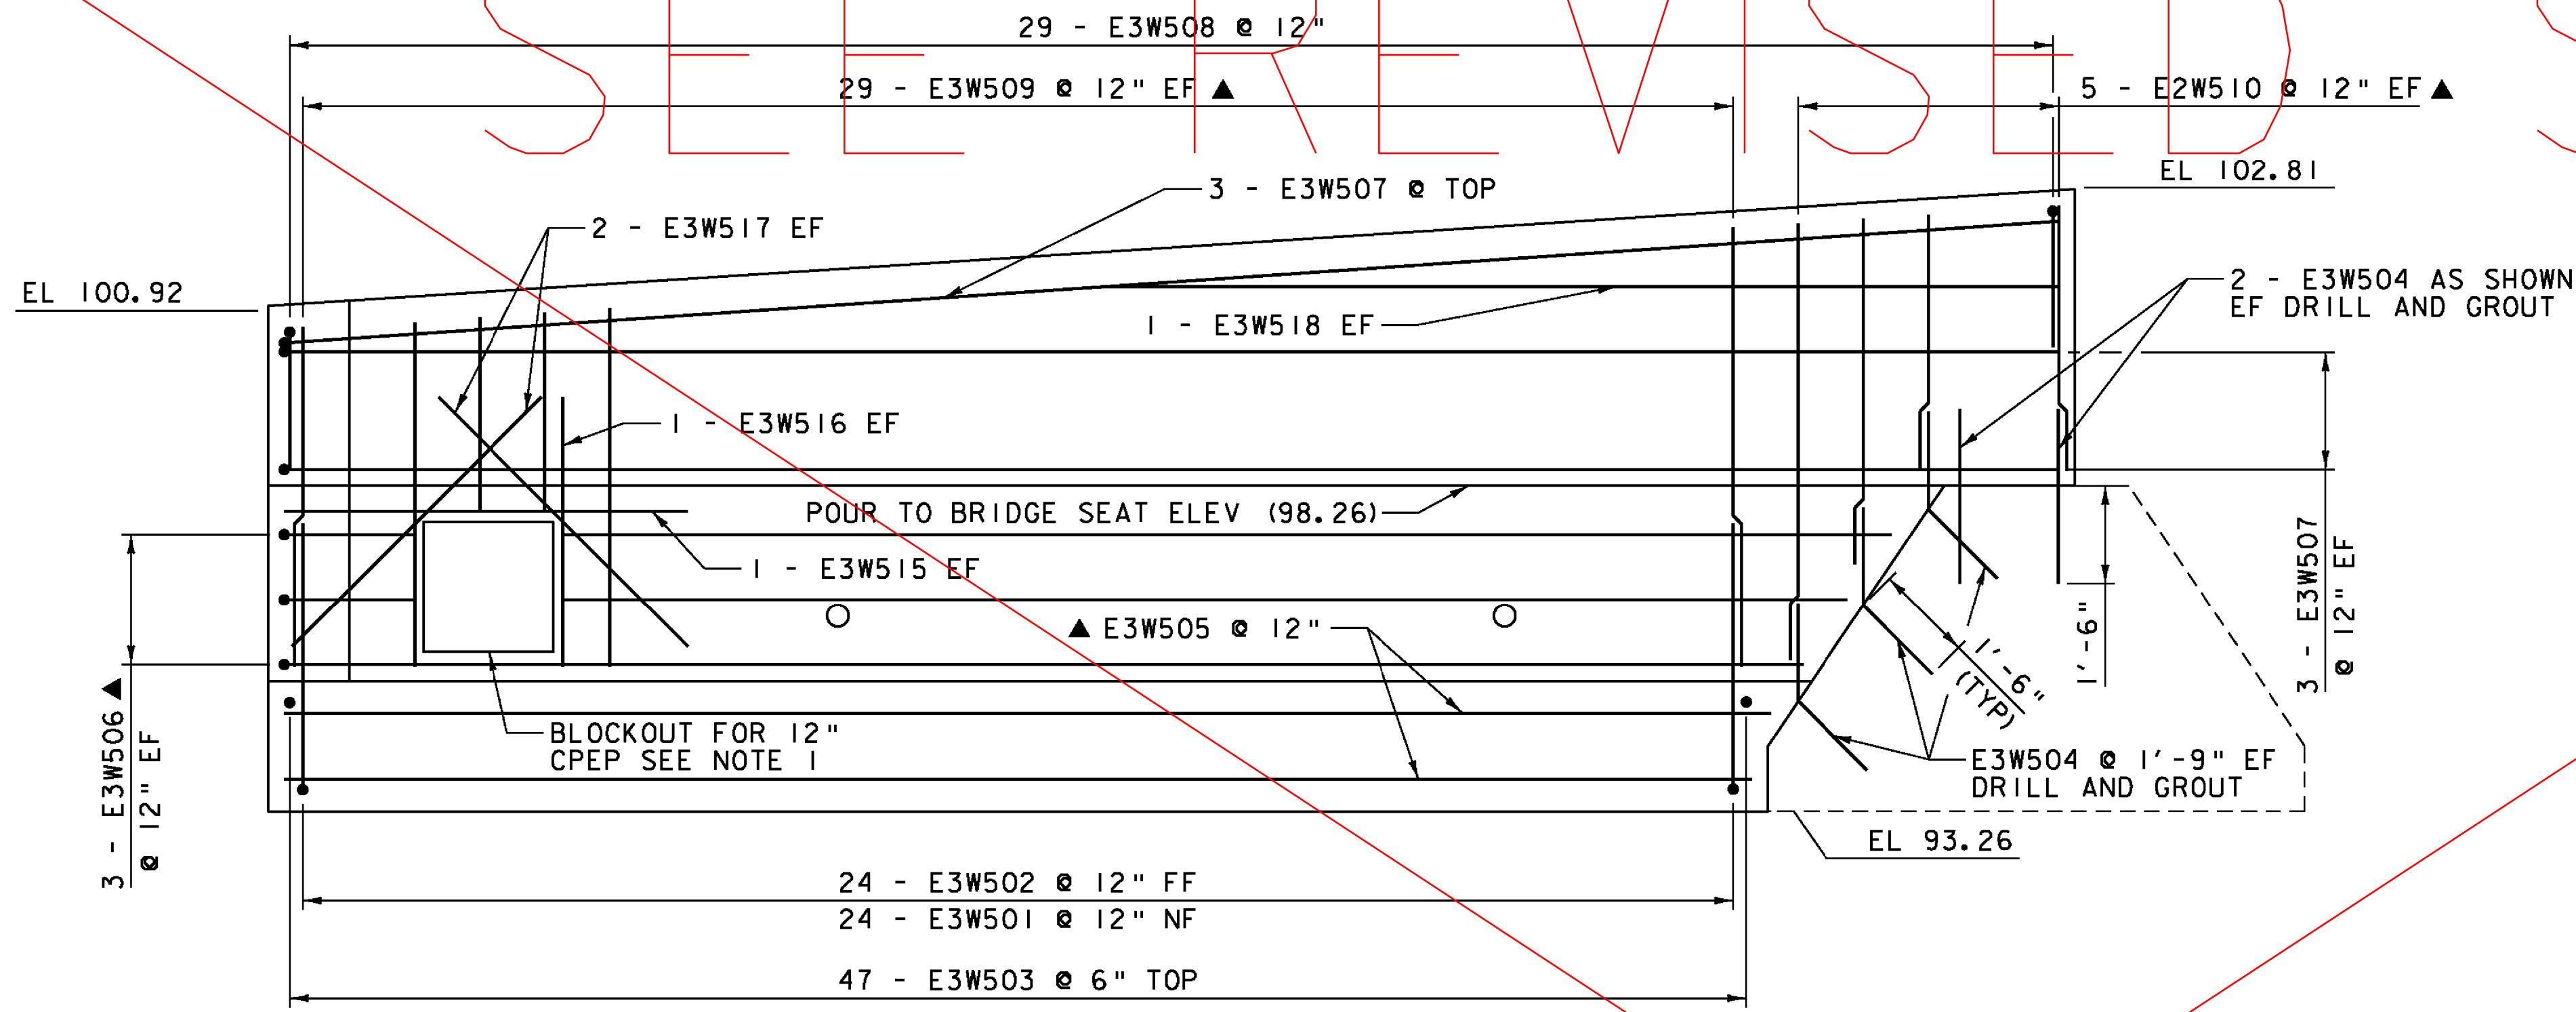


WINGWALL 3 ELEVATION  
 SCALE 1/2" = 1'-0"

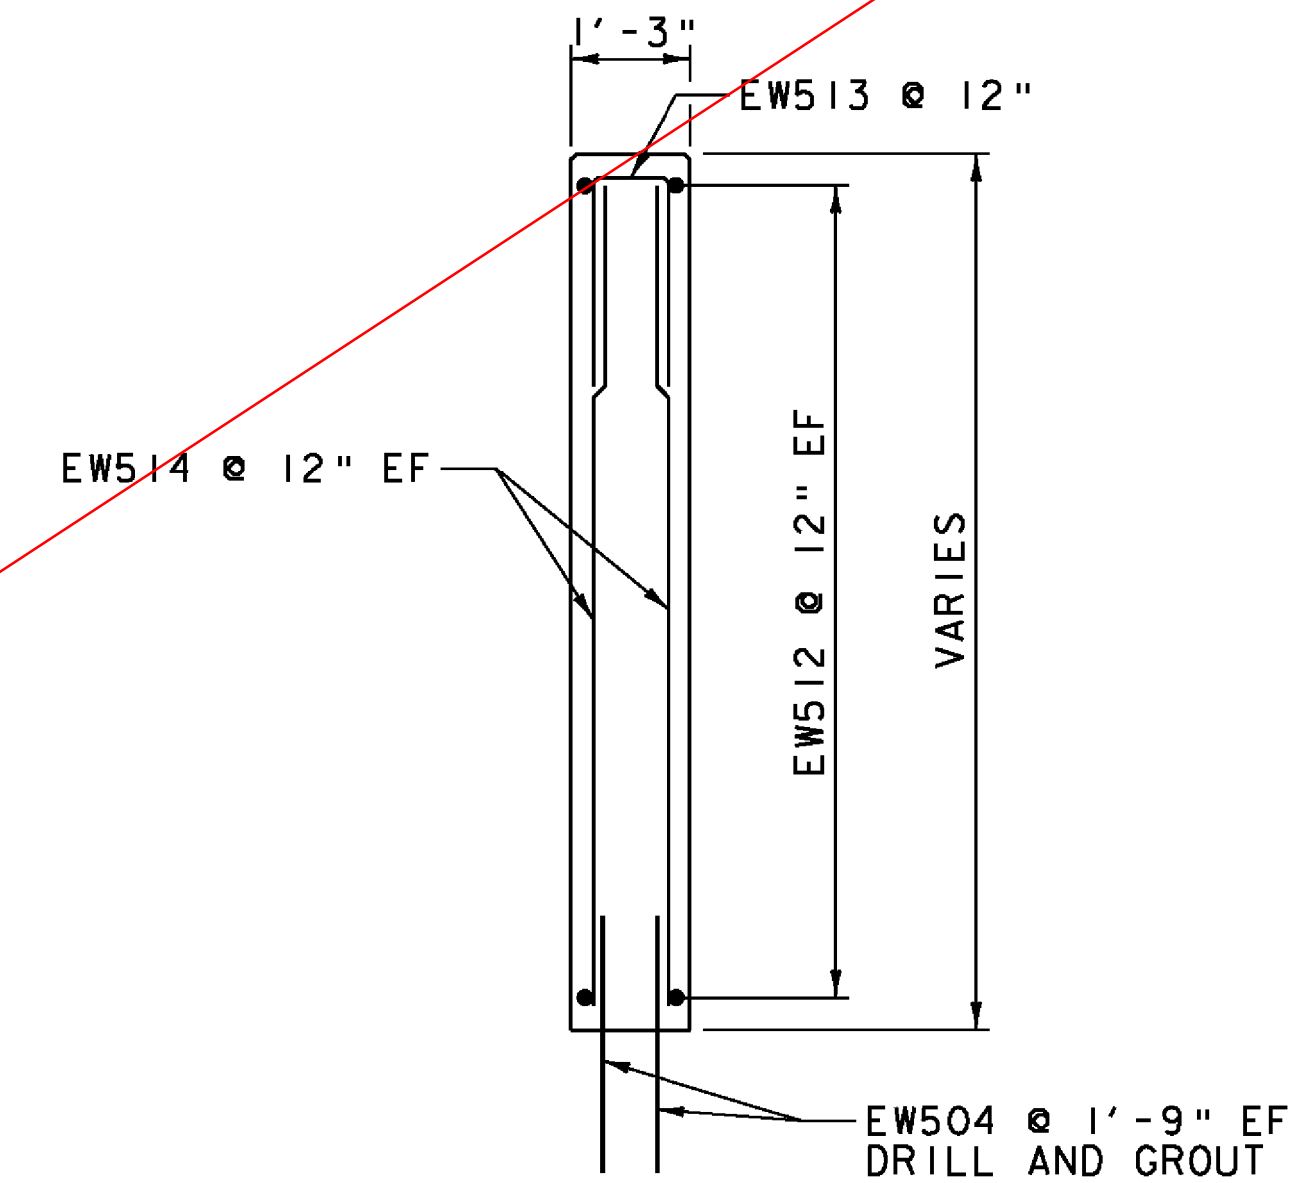

TYPICAL CANTILEVERED WINGWALL SECTION  
 SCALE 1/2" = 1'-0"

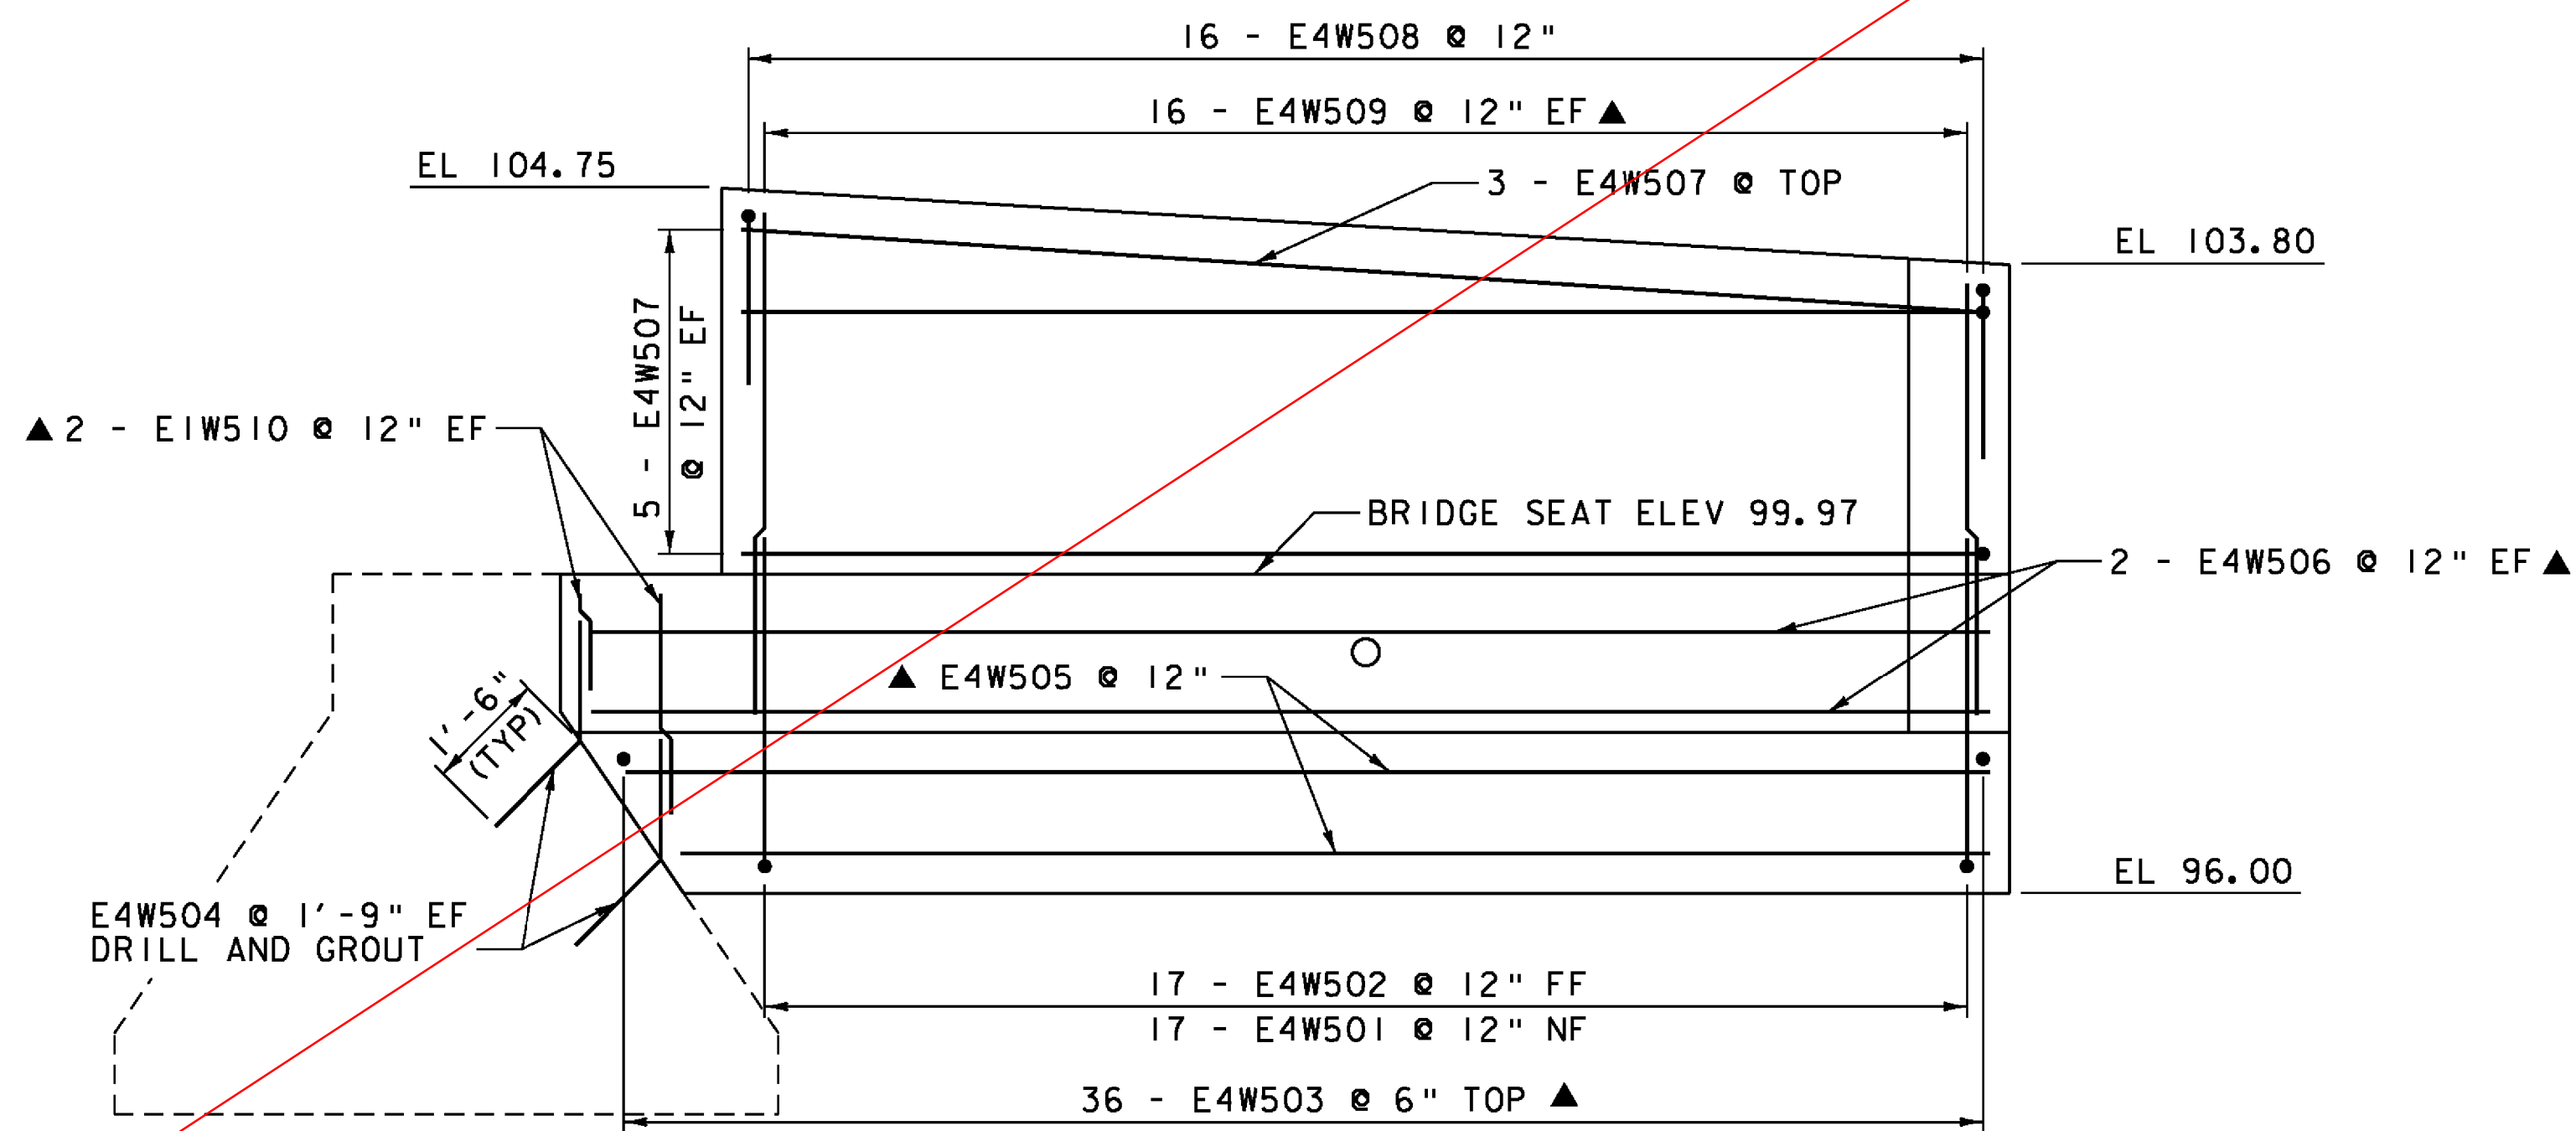

WINGWALL 4 ELEVATION  
 SCALE 1/2" = 1'-0"

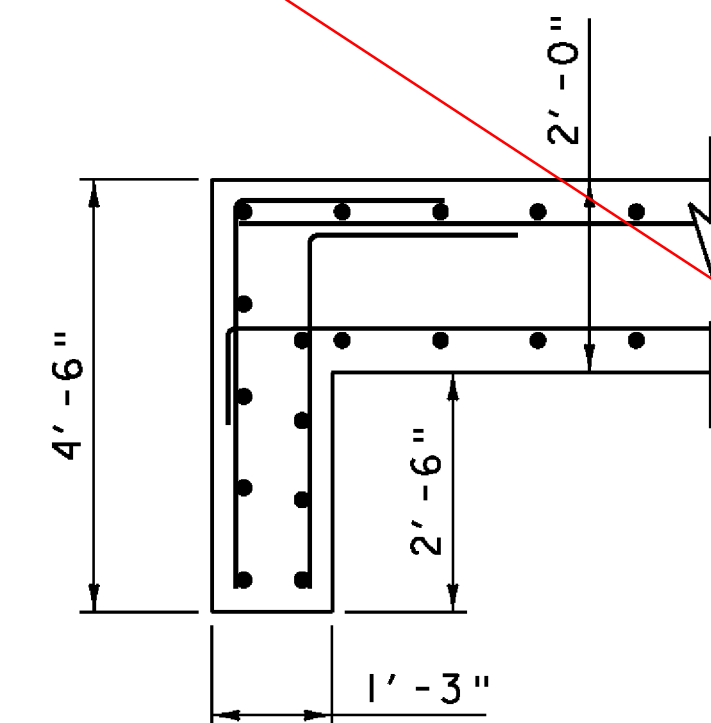

TYPICAL WINGWALL CORNER DETAIL  
 SCALE 1/2" = 1'-0"

**NOTE:**


NF = NEAR FACE  
 FF = FAR FACE  
 EF = EACH FACE  
 ▲ = CUT TO FIT IN FIELD  
 3" CLEAR, UNLESS OTHERWISE SPECIFIED ON THE PLANS.  
 2'-2" BAR LAP UNLESS OTHERWISE SPECIFIED ON THE PLANS.  
 DRILL & GROUT IN 2" DIA HOLES

**NOTES:**


1. A BLOCKOUT IS TO BE CONSTRUCTED FOR THE 12" CPEP, AND GROUTED AFTER INSTALLATION OF DROP INLET AND CPEP. COST FOR BLOCKOUT AND GROUT TO BE INCLUDED IN ITEM 501.34, "CONCRETE, HIGH PERFORMANCE CLASS B".

PROJECT NAME: HARTLAND	PLOT DATE: 12/17/2013
PROJECT NUMBER: BHF BPNT(12)	DRAWN BY: A.J. GOUDREAU
FILE NAME: zllc260sub.dgn	CHECKED BY: S.G. FARNSWORTH
PROJECT LEADER: M.A. COLGAN	SHEET 29 OF 55
DESIGNED BY: A.J. GOUDREAU	BR 62A WINGWALL DETAILS (2 OF 2)




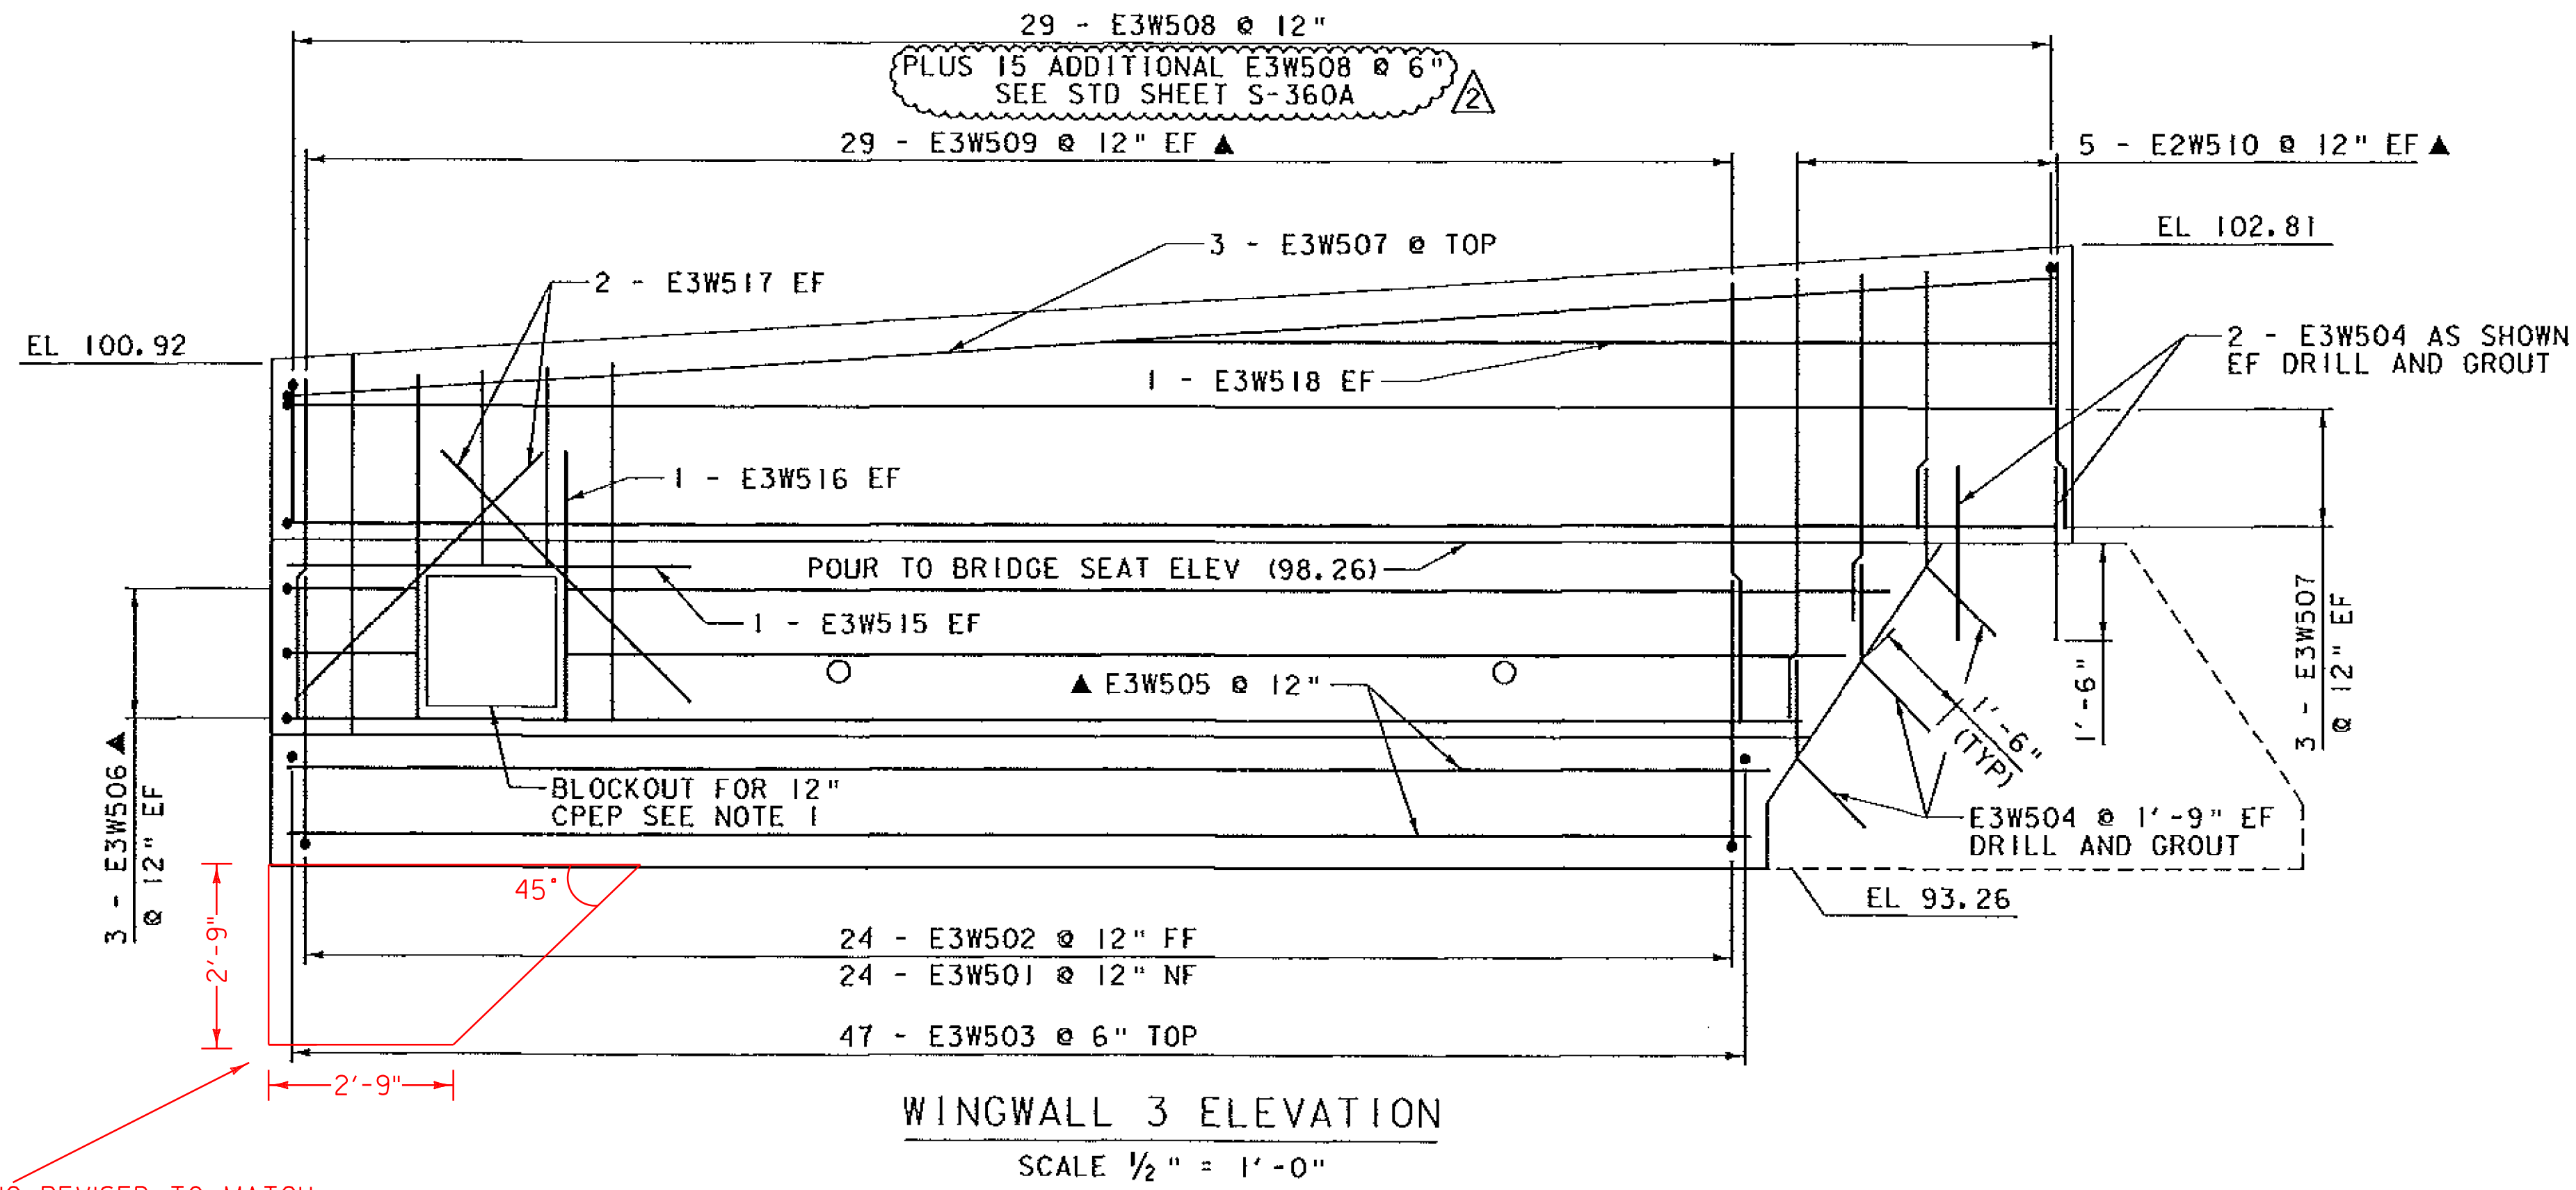


WINGWALL 3 ELEVATION  
SCALE 1/2" = 1'-0"

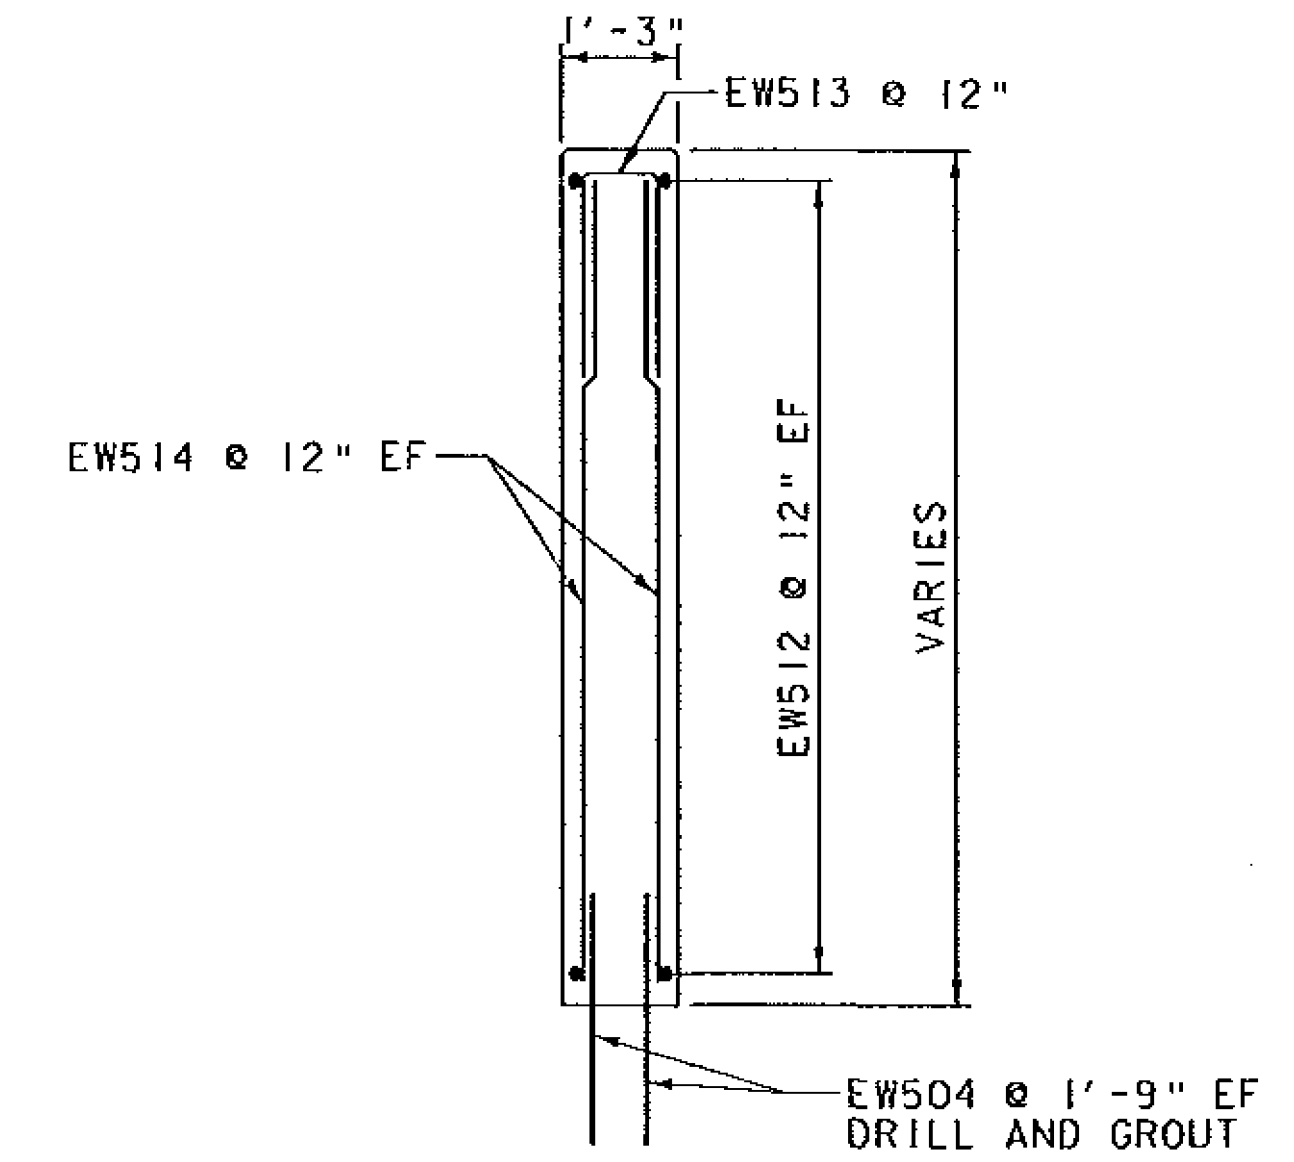

TYPICAL CANTILEVERED WINGWALL SECTION  
SCALE 1/2" = 1'-0"

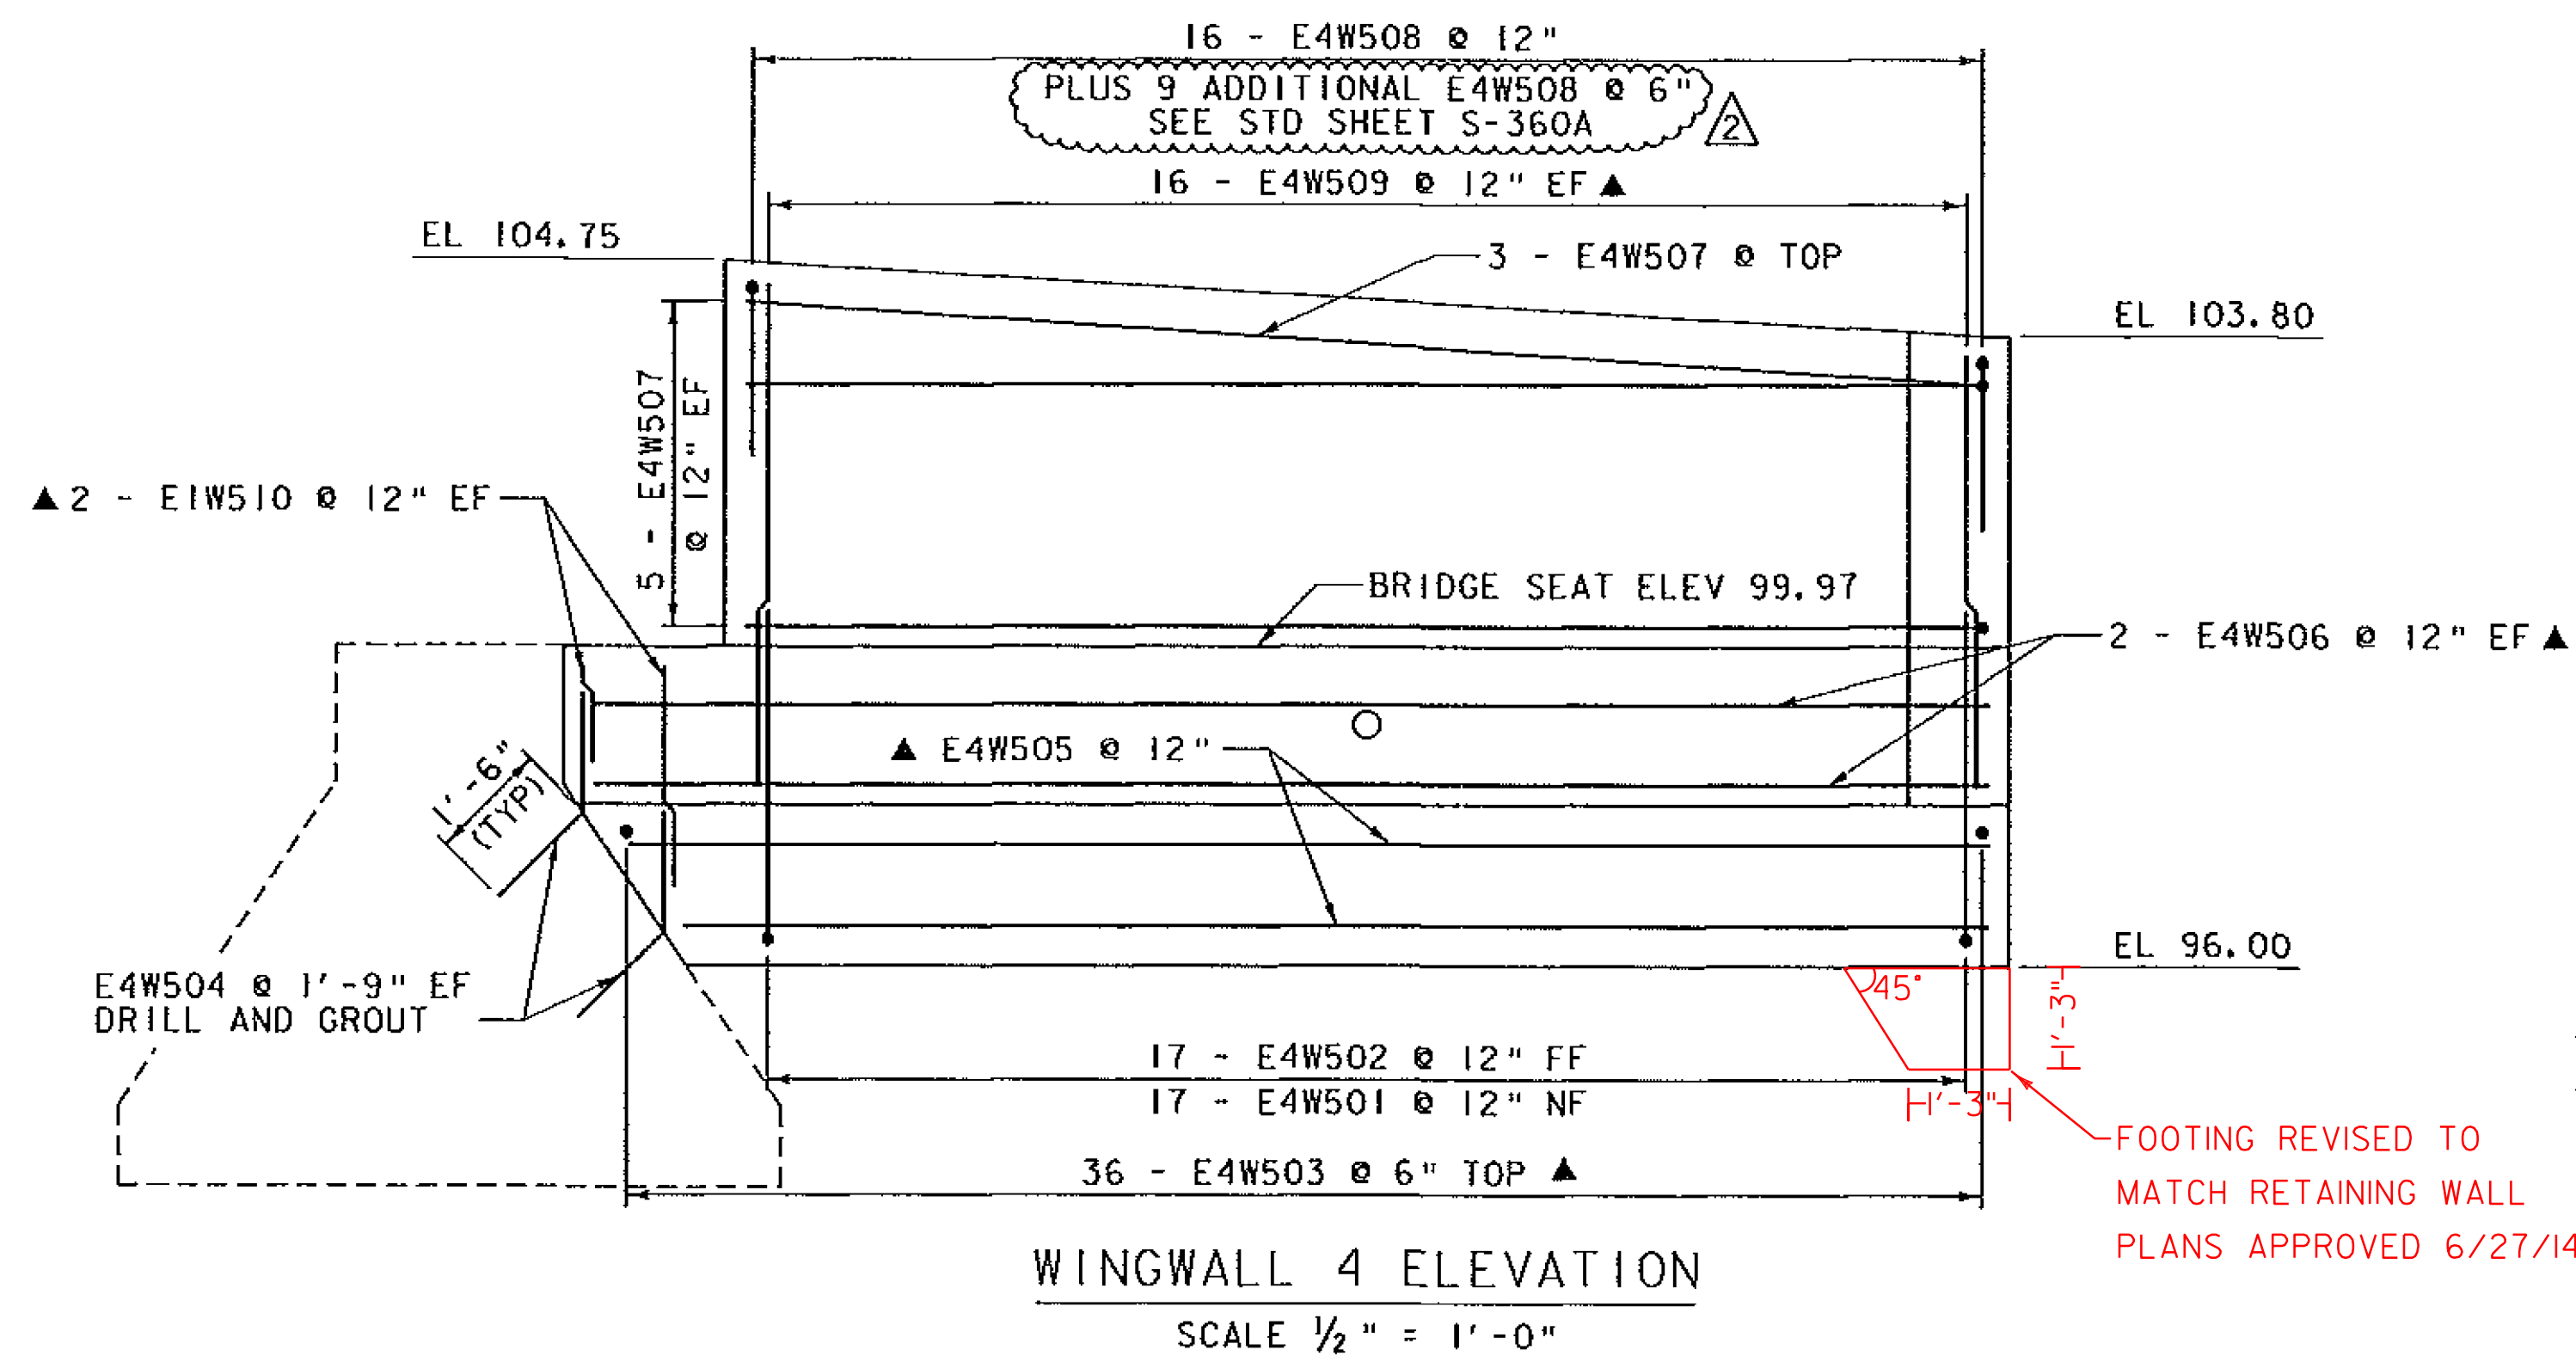

WINGWALL 4 ELEVATION  
SCALE 1/2" = 1'-0"

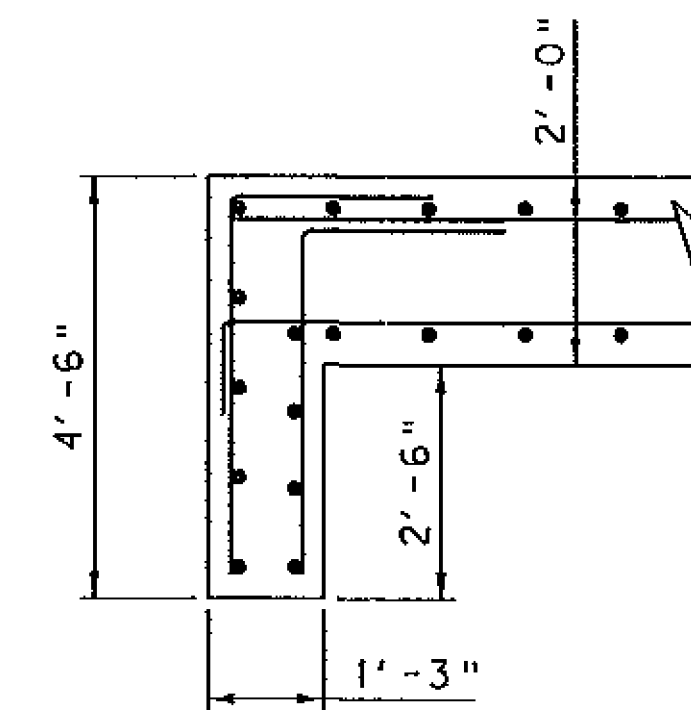

TYPICAL WINGWALL CORNER DETAIL  
SCALE 1/2" = 1'-0"

NOTE:




- NF = NEAR FACE
- FF = FAR FACE
- EF = EACH FACE
- ▲ = CUT TO FIT IN FIELD
- 3" CLEAR, UNLESS OTHERWISE SPECIFIED ON THE PLANS.
- 2'-2" BAR LAP UNLESS OTHERWISE SPECIFIED ON THE PLANS.
- DRILL & GROUT IN 2" DIA HOLES

NOTES:

1. A BLOCKOUT IS TO BE CONSTRUCTED FOR THE 12" CPEP, AND GROUTED AFTER INSTALLATION OF DROP INLET AND CPEP. COST FOR BLOCKOUT AND GROUT TO BE INCLUDED IN ITEM 501.34, "CONCRETE, HIGH PERFORMANCE CLASS B".




REV.	DESCRIPTION	DATE
△	ADDITIONAL EW508 AT POSTS	3/3/2014
PROJECT NAME: HARTLAND		
PROJECT NUMBER: BHF BPNT(12)		
FILE NAME: zllc260sub.dgn		PLOT DATE: 3/3/2014
PROJECT LEADER: M.A. COLGAN		DRAWN BY: A.J. GOUDREAU
DESIGNED BY: A.J. GOUDREAU		CHECKED BY: S.G. FARNSWORTH
BR 62A WINGWALL DETAILS (2 OF 2)		SHEET 29 OF 55



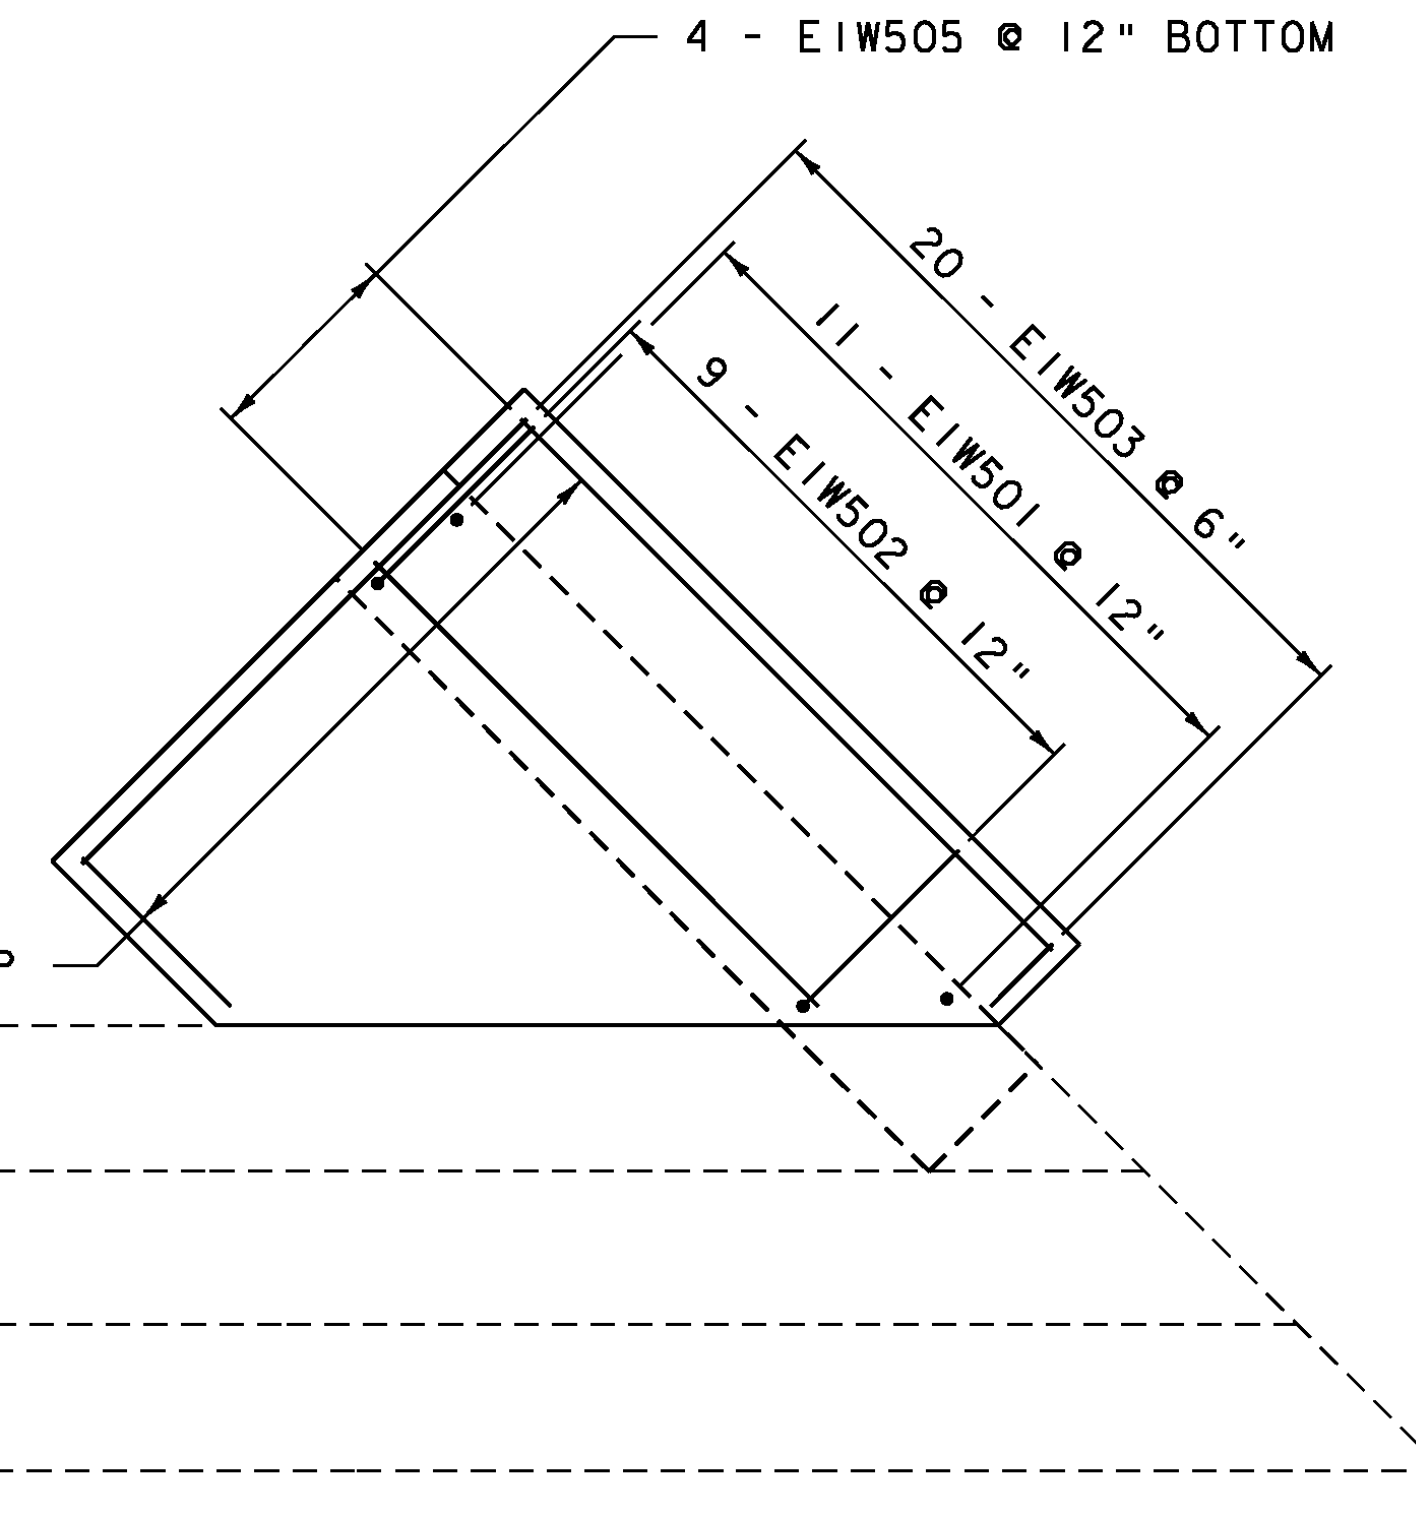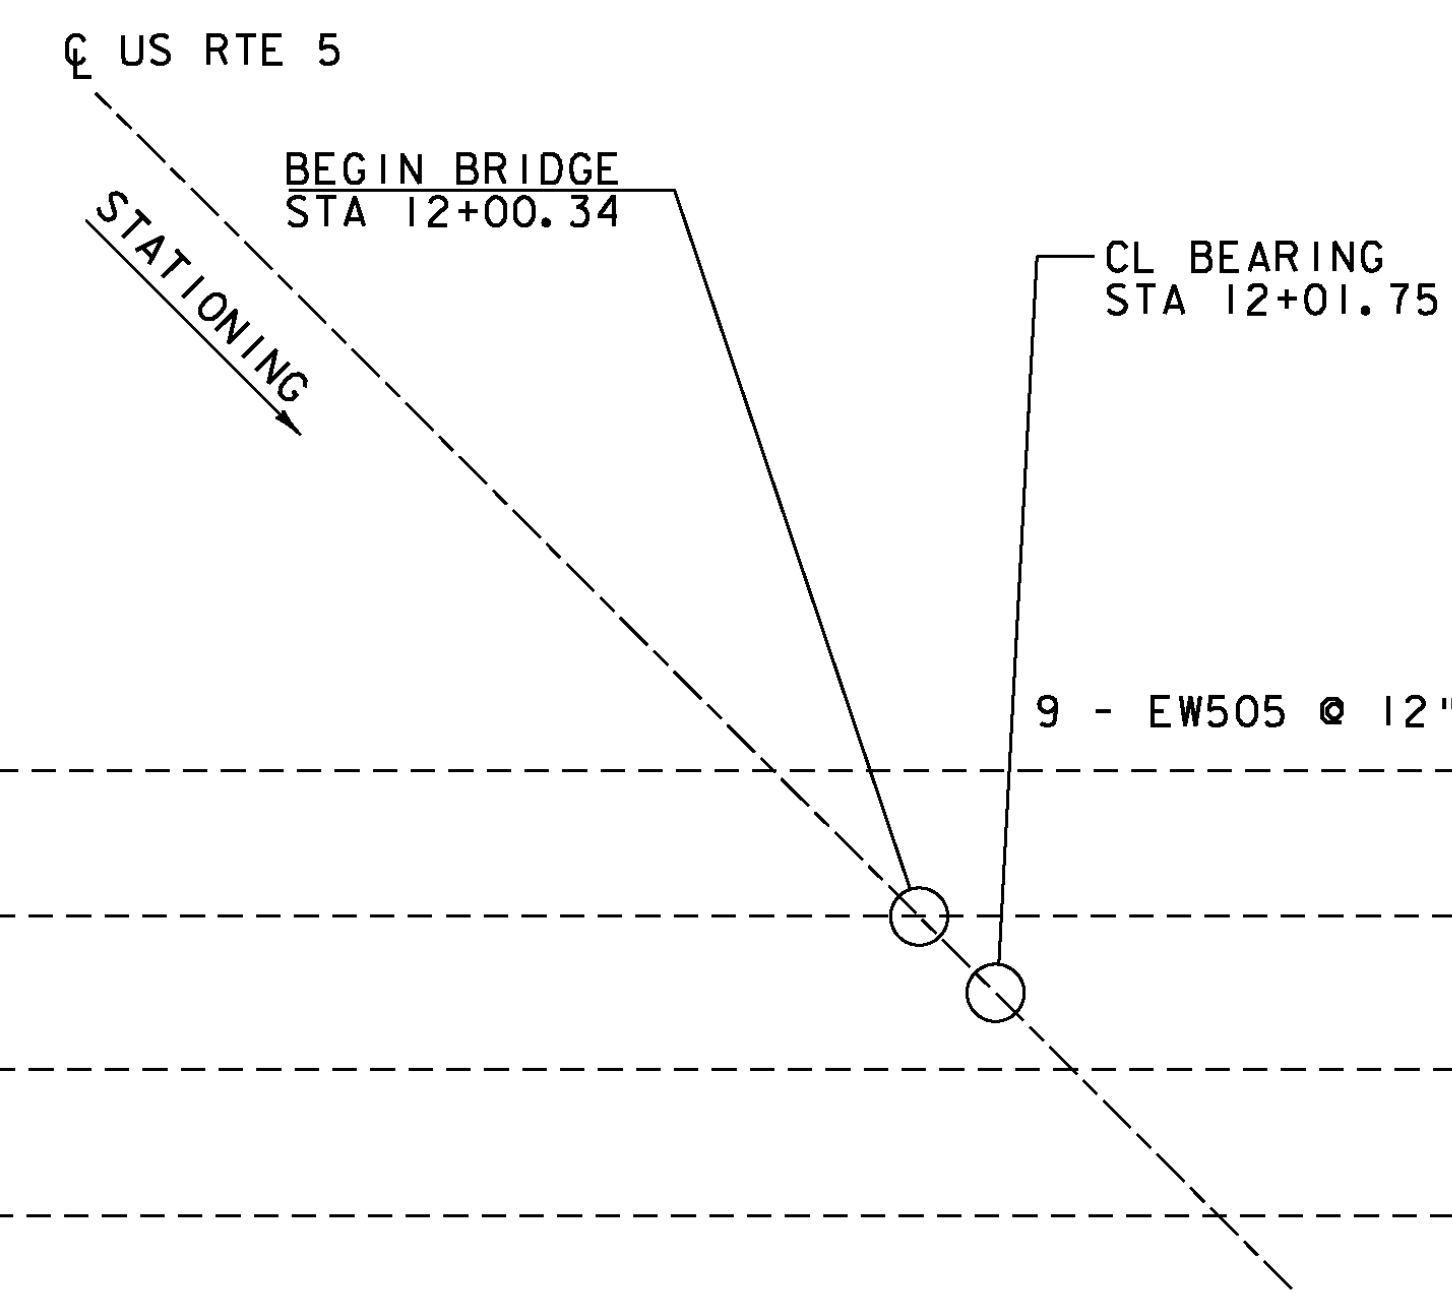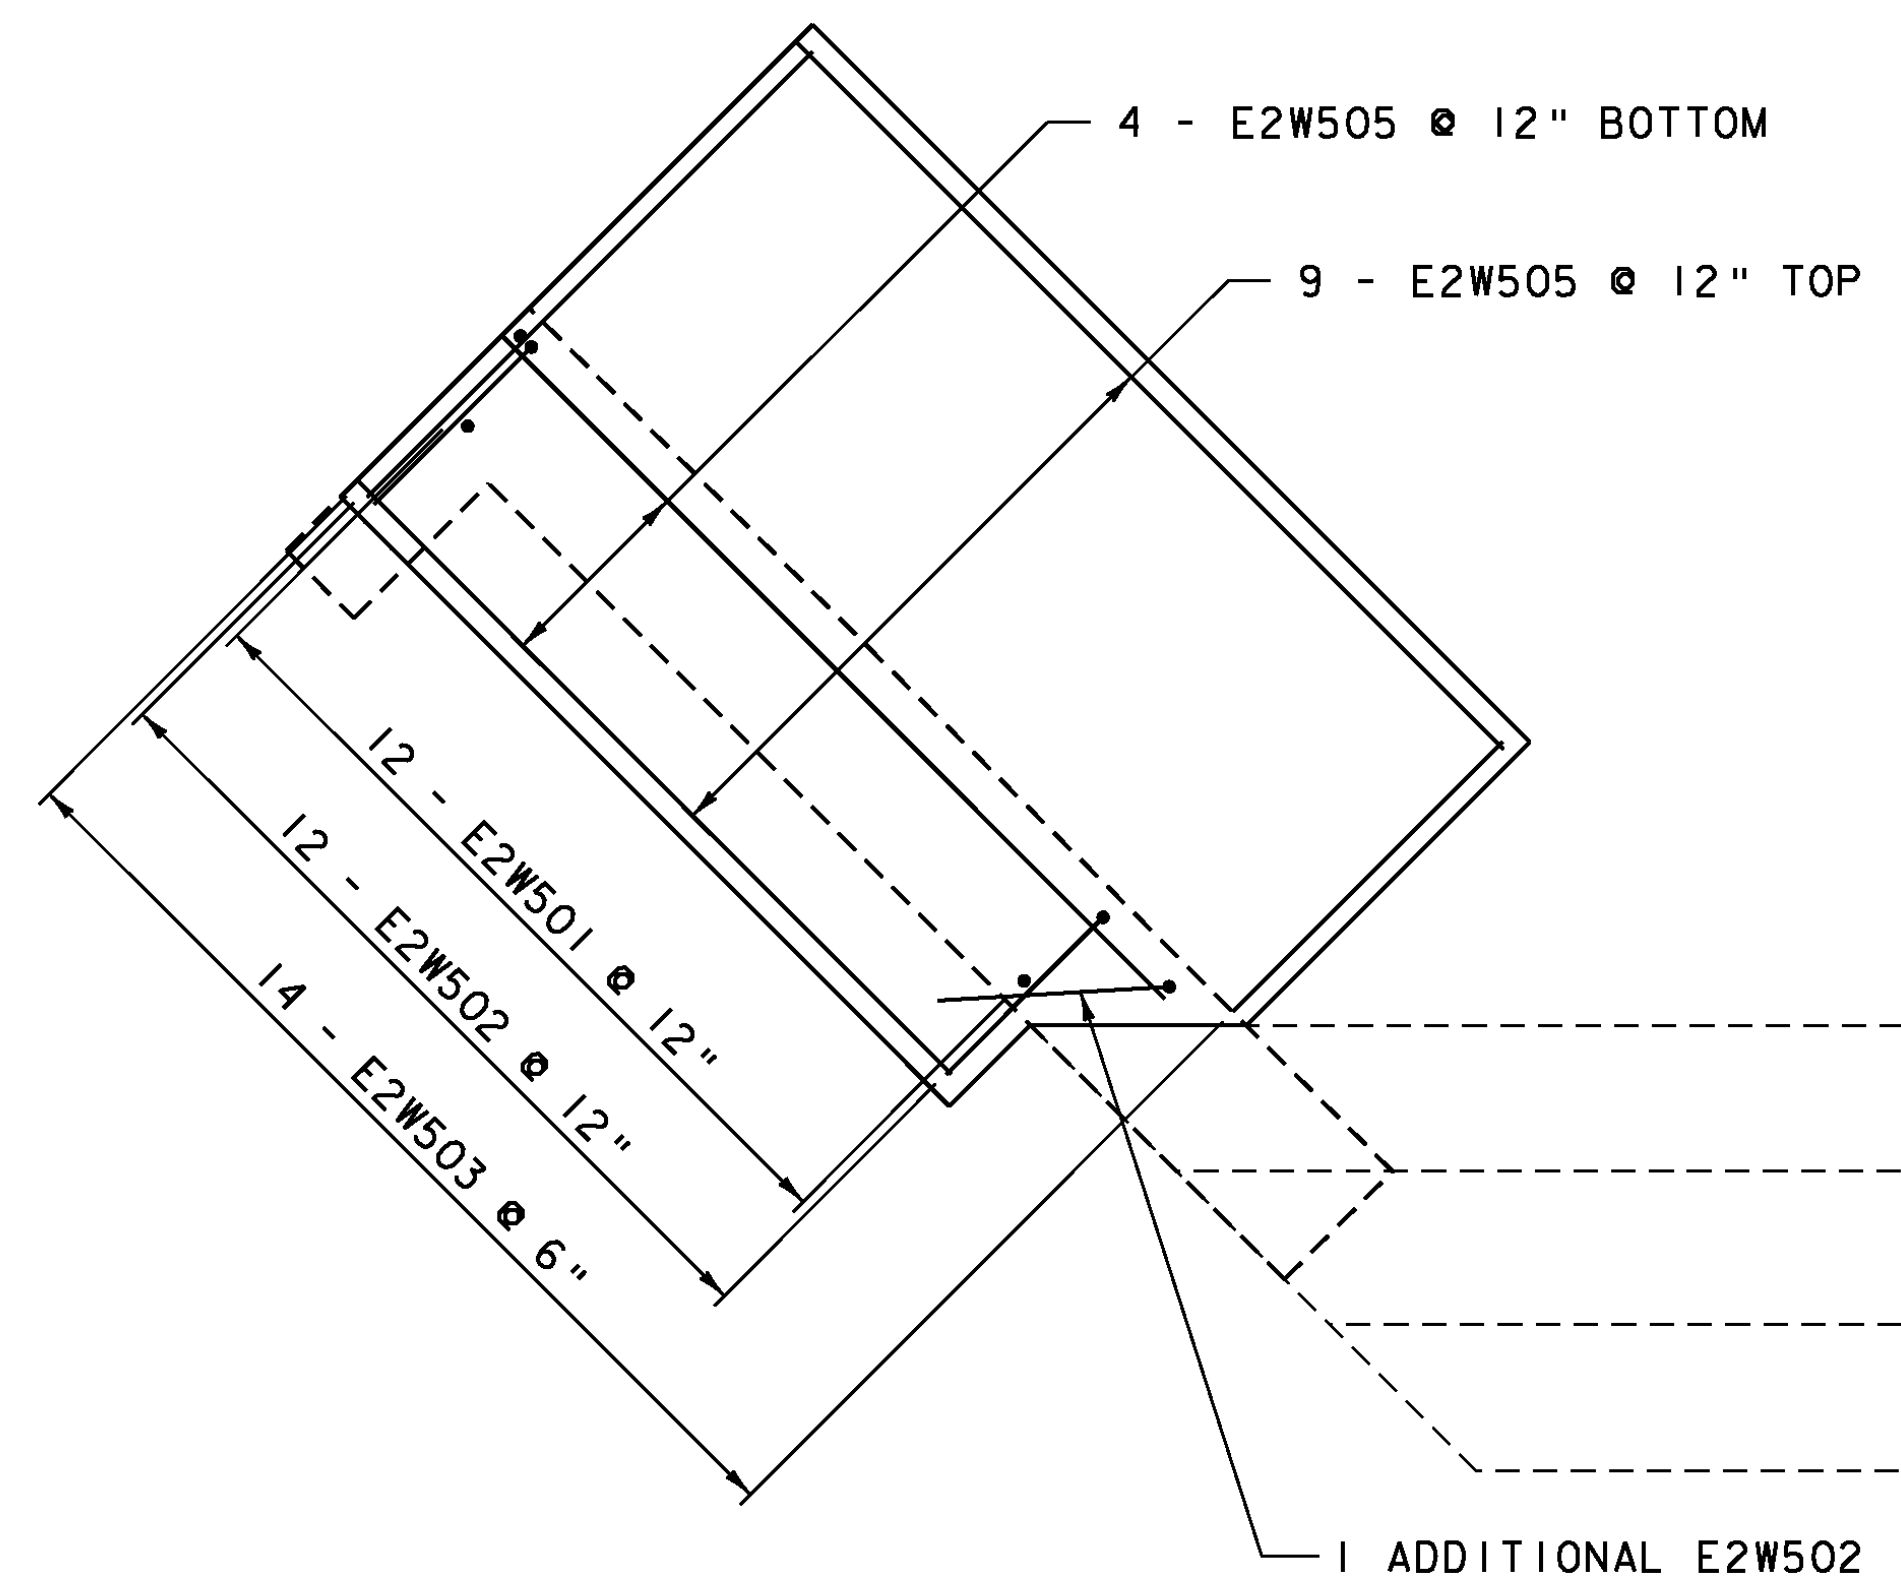

ABUTMENT 1 FOOTING REINFORCING PLAN  
SCALE 3/8" = 1'-0"


**NOTE:**  
 NF = NEAR FACE  
 FF = FAR FACE  
 EF = EACH FACE  
 ▲ = CUT TO FIT IN FIELD  
 3" CLEAR, UNLESS OTHERWISE SPECIFIED ON THE PLANS.  
 2'-2" BAR LAP UNLESS OTHERWISE SPECIFIED ON THE PLANS.  
 DRILL & GROUT IN 2" DIA HOLES

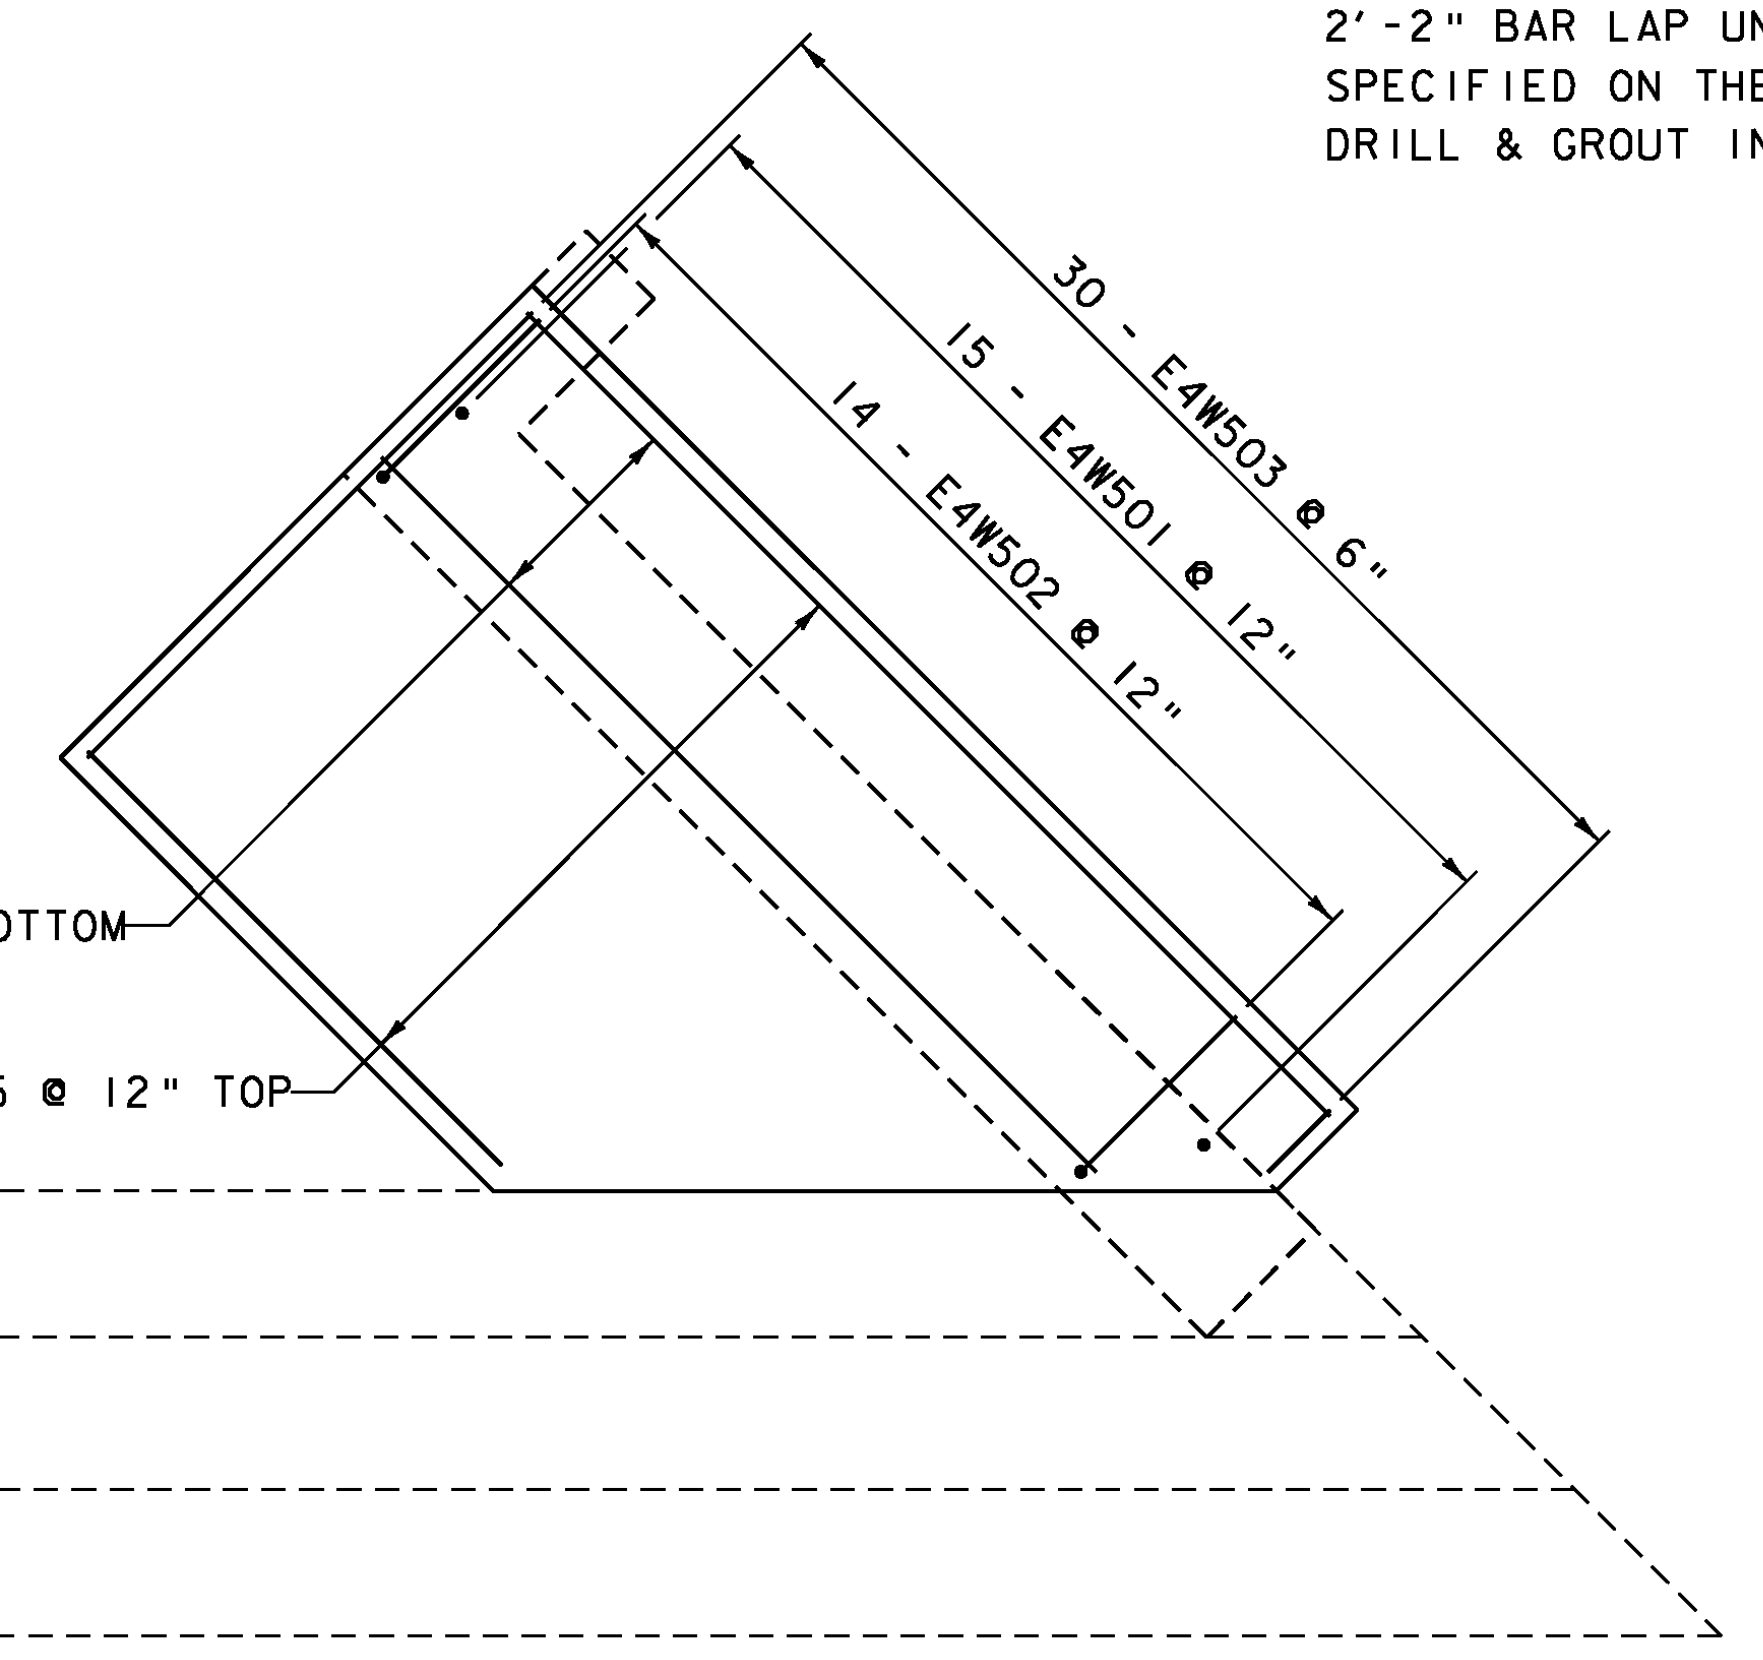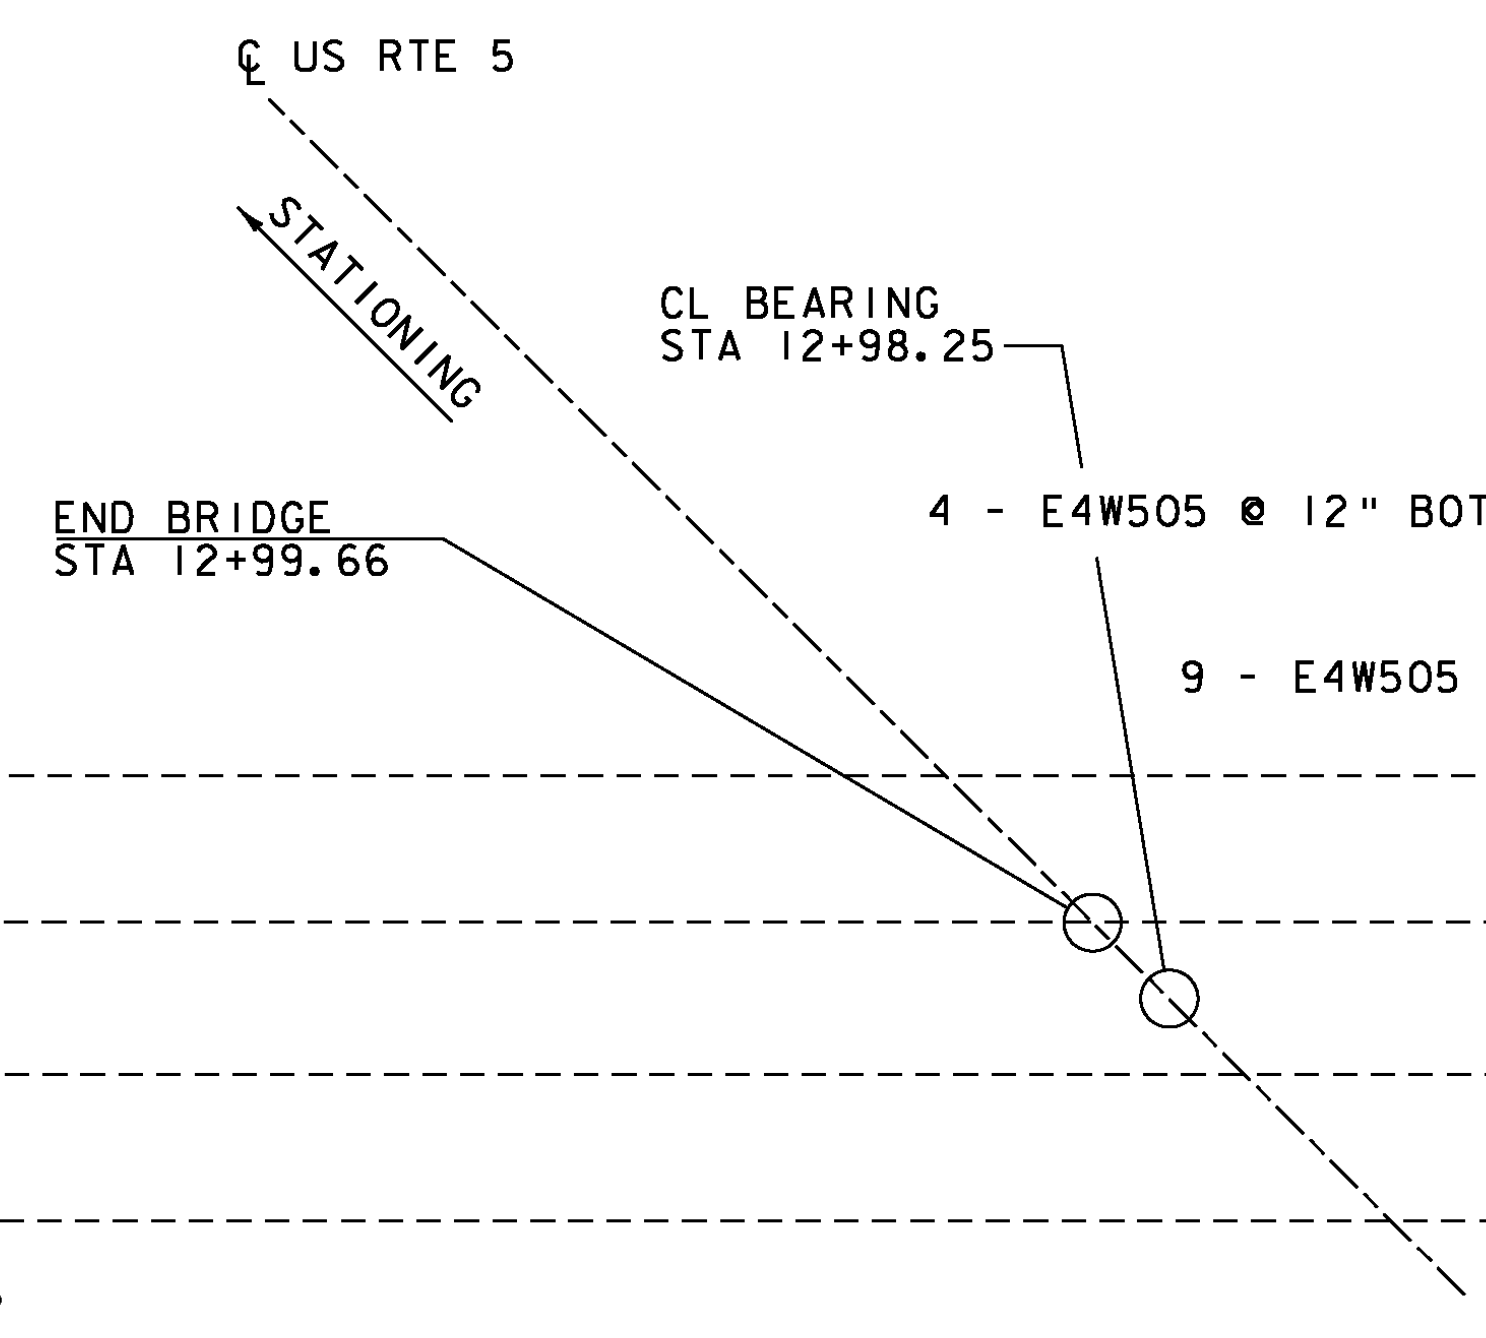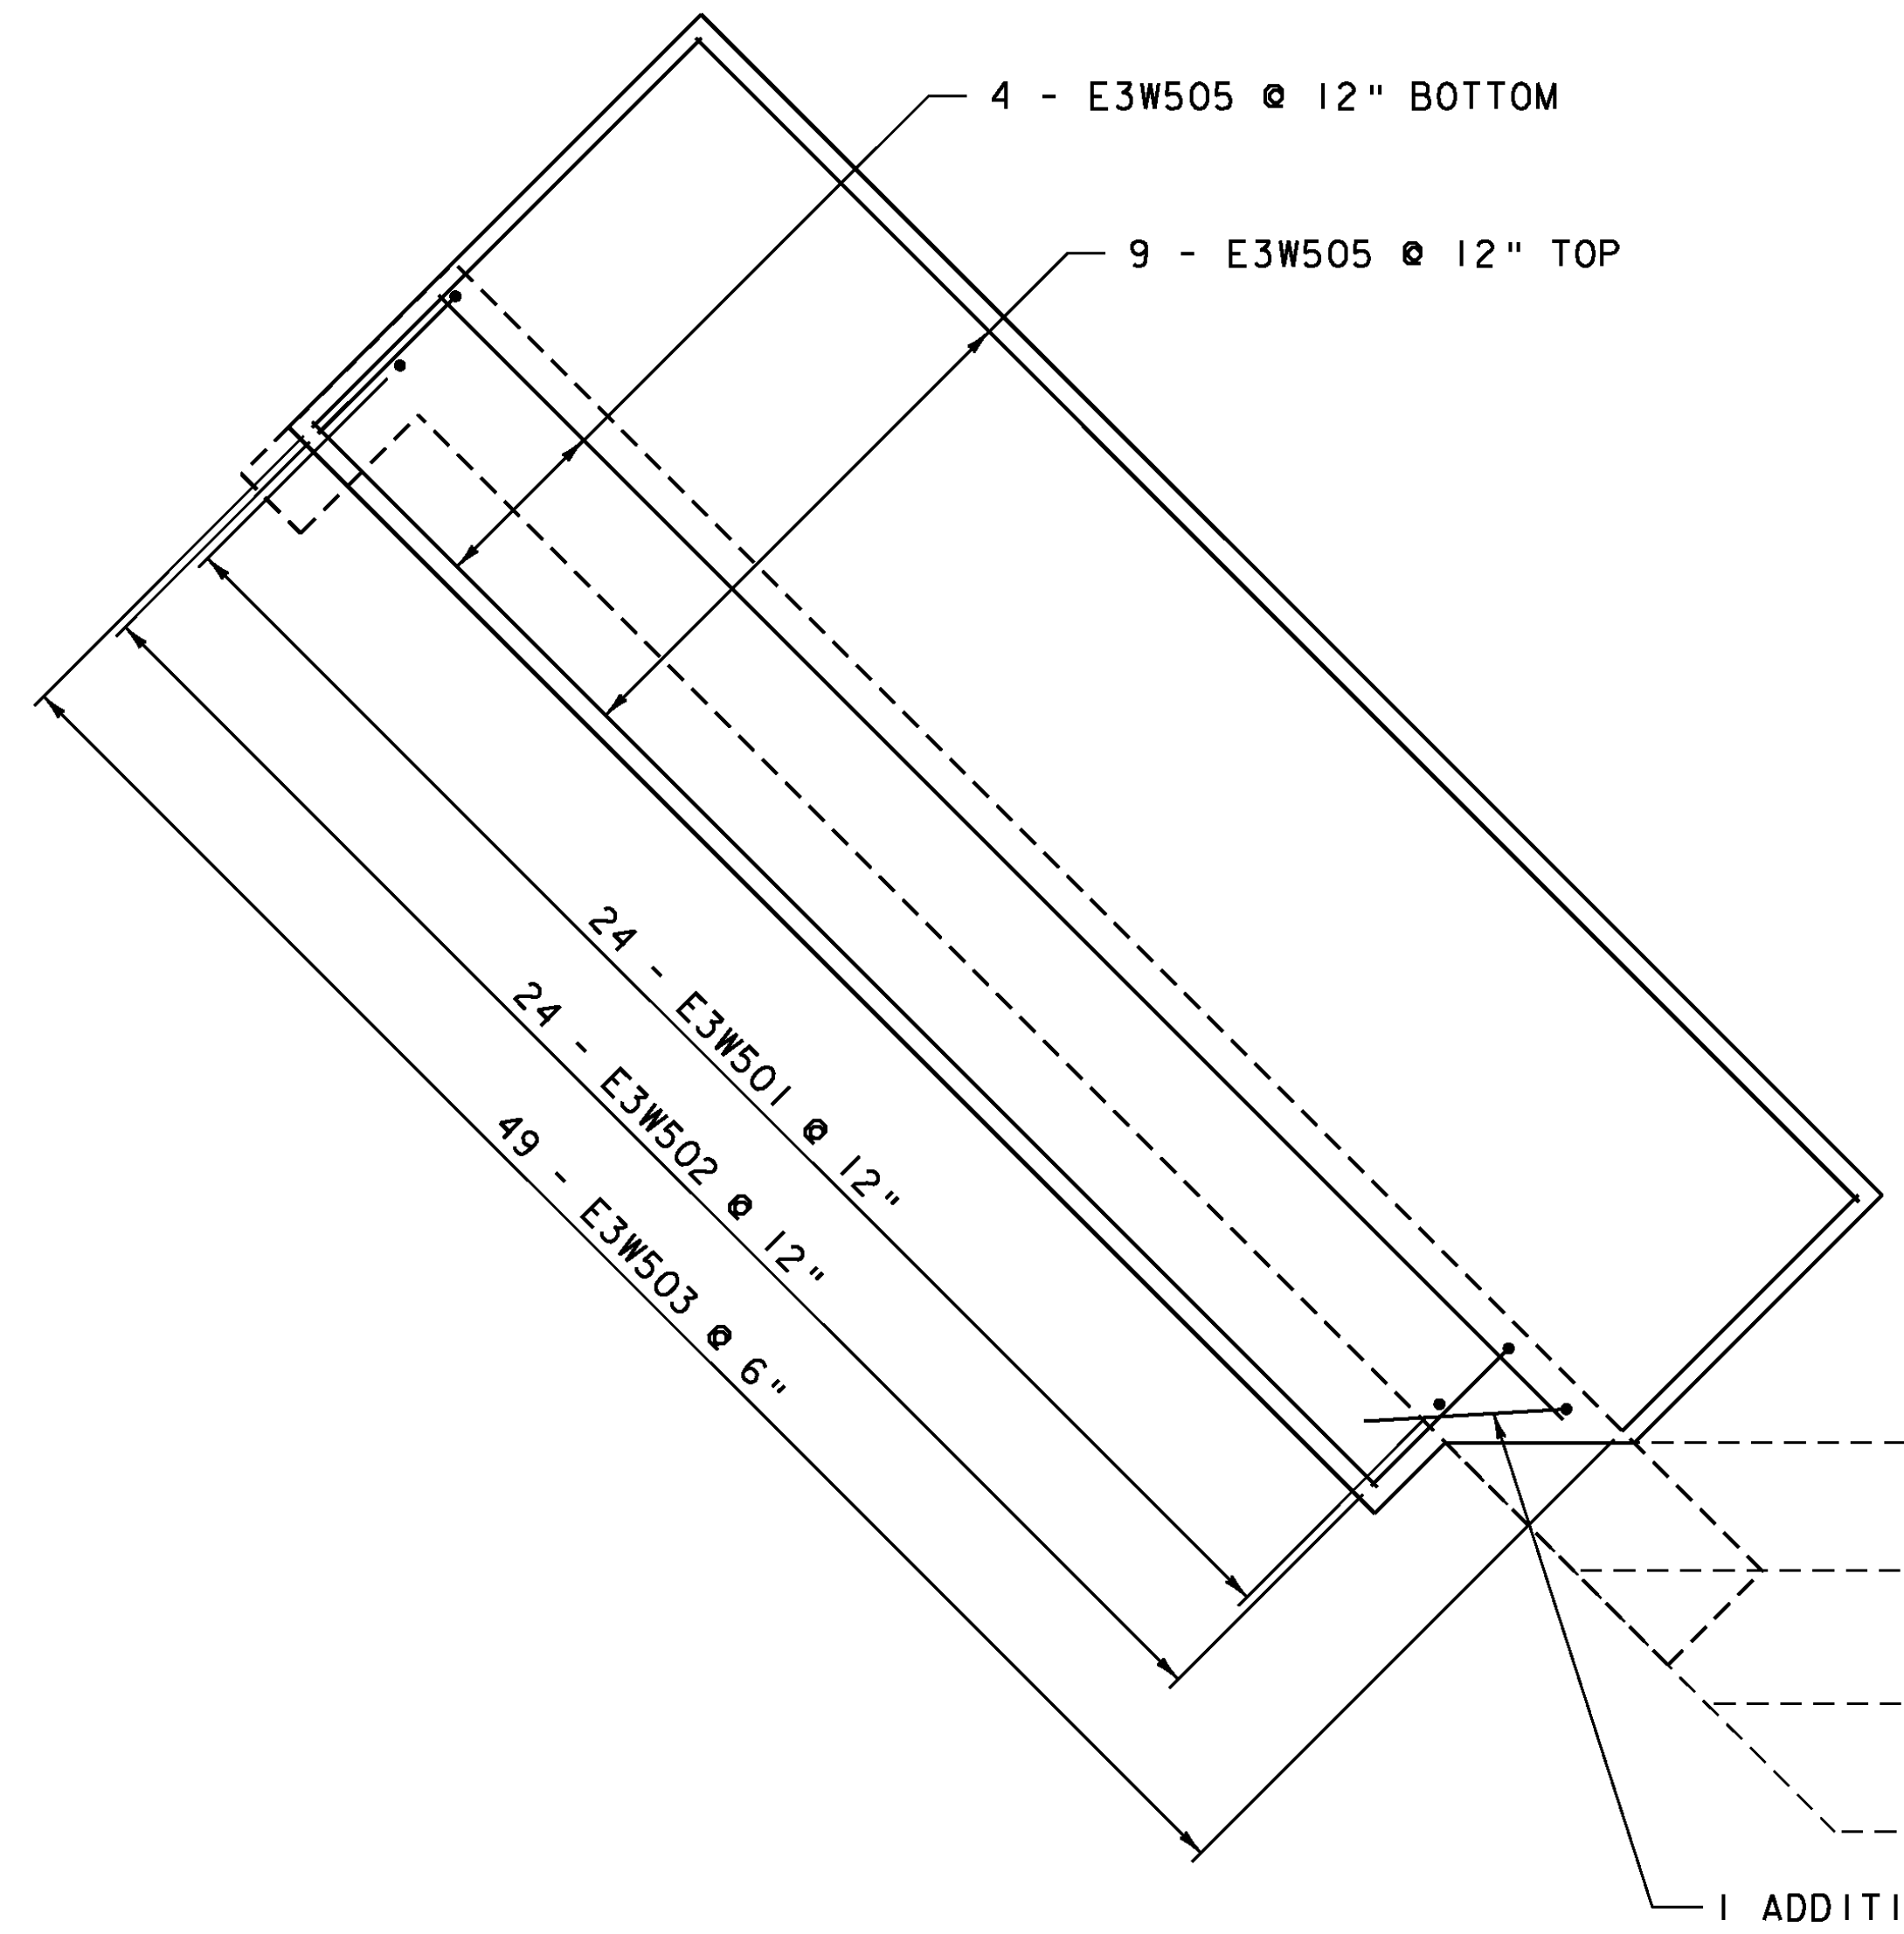


ABUTMENT 2 FOOTING REINFORCING PLAN  
SCALE 3/8" = 1'-0"

PROJECT NAME:	HARTLAND	PLOT DATE:	12/17/2013
PROJECT NUMBER:	BHF BPNT(12)	DRAWN BY:	A.J. GOUDREAU
FILE NAME:	zllc260sub.dgn	CHECKED BY:	S.E. BURBANK
PROJECT LEADER:	M.A. COLGAN	SHEET	30 OF 55
DESIGNED BY:	S.G. FARNSWORTH		
BR 62A FOOTING REINFORCING PLAN			



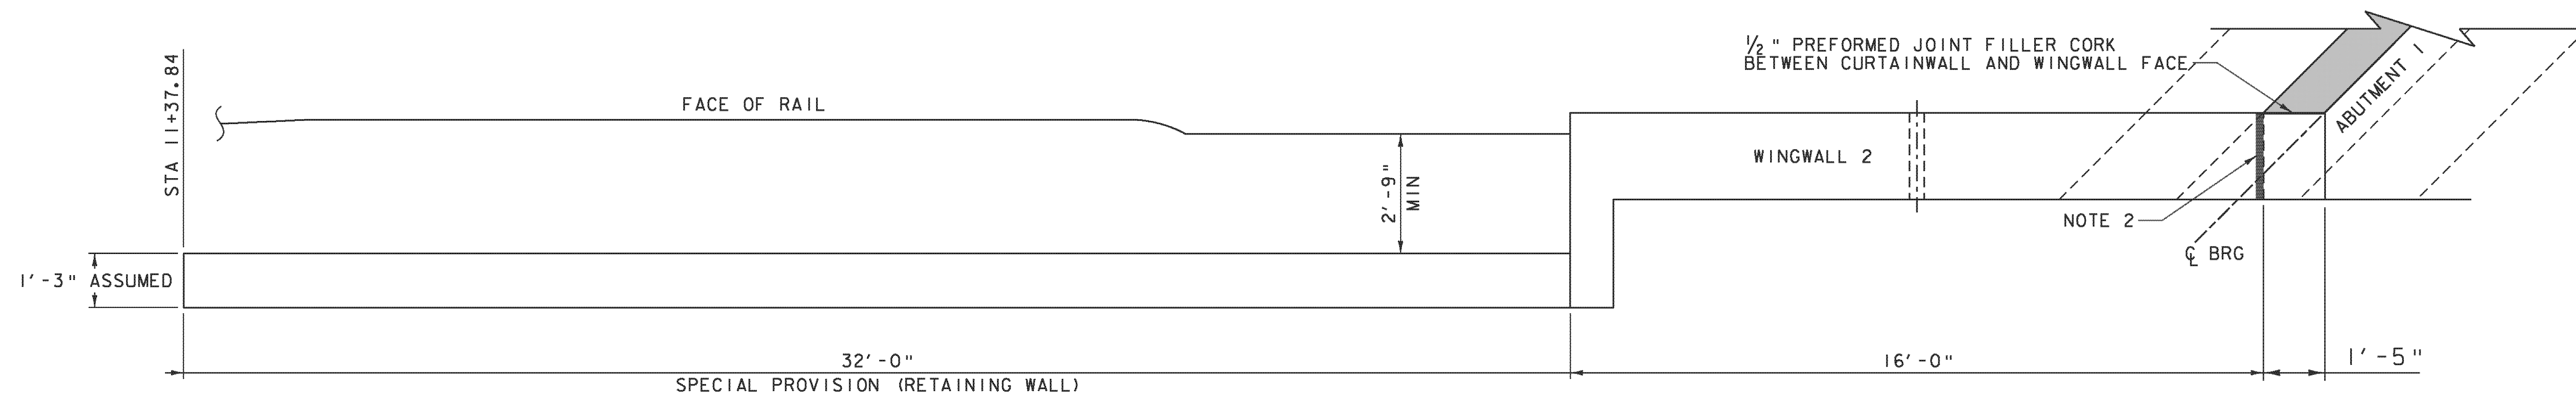

RETAINING WALL 2 PLAN  
SCALE 1/2" = 1'-0"

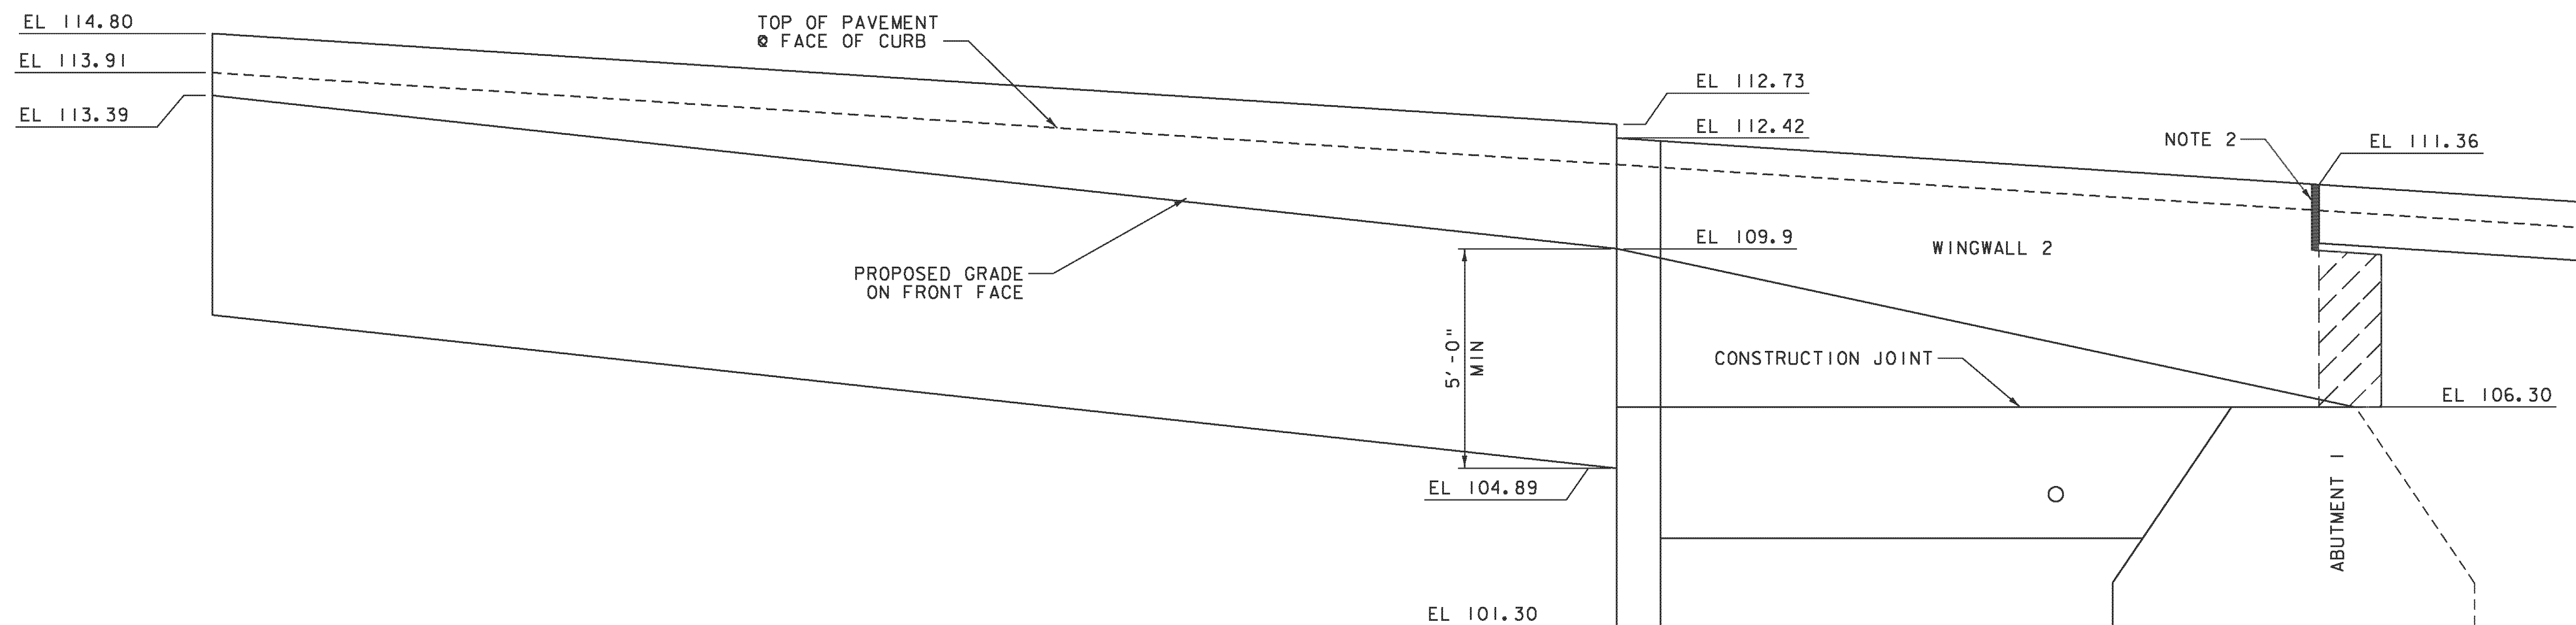

RETAINING WALL 2 ELEVATION  
SCALE 1/2" = 1'-0"

KEY

 CURTAIN WALL


NOTE:

1. SEE SHEET 4 FOR SPECIAL PROVISION (RETAINING WALL) EXCAVATION DETAIL.
2. ONE INCH OF CLOSED CELL FOAM WITH ONE INCH POLYURETHANE JOINT SEALER BETWEEN WINGWALL AND CONCRETE SLAB. COST INCIDENTAL TO UNIT BID PRICE FOR ADJACENT CONCRETE.


PROJECT NAME: HARTLAND  
PROJECT NUMBER: BHF BPNT(12)

FILE NAME: zllc260sub.dgn  
PROJECT LEADER: M.A. COLGAN  
DESIGNED BY: S.G. FARNSWORTH  
BR 62A RETAINING WALL DETAILS (1 OF 3)

PLOT DATE: 1/2/2014  
DRAWN BY: A. J. GOUDREAU  
CHECKED BY: S.E. BURBANK  
SHEET 31 OF 55

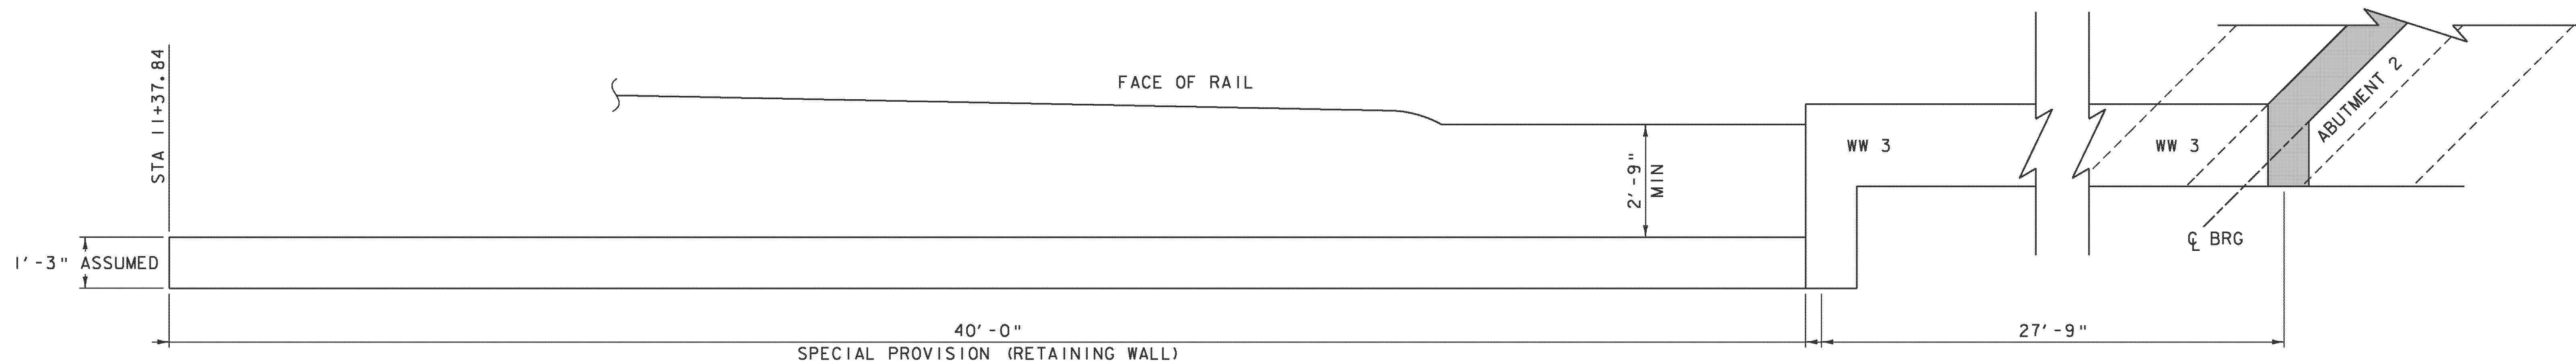

RETAINING WALL 3 PLAN  
SCALE 1/2" = 1'-0"

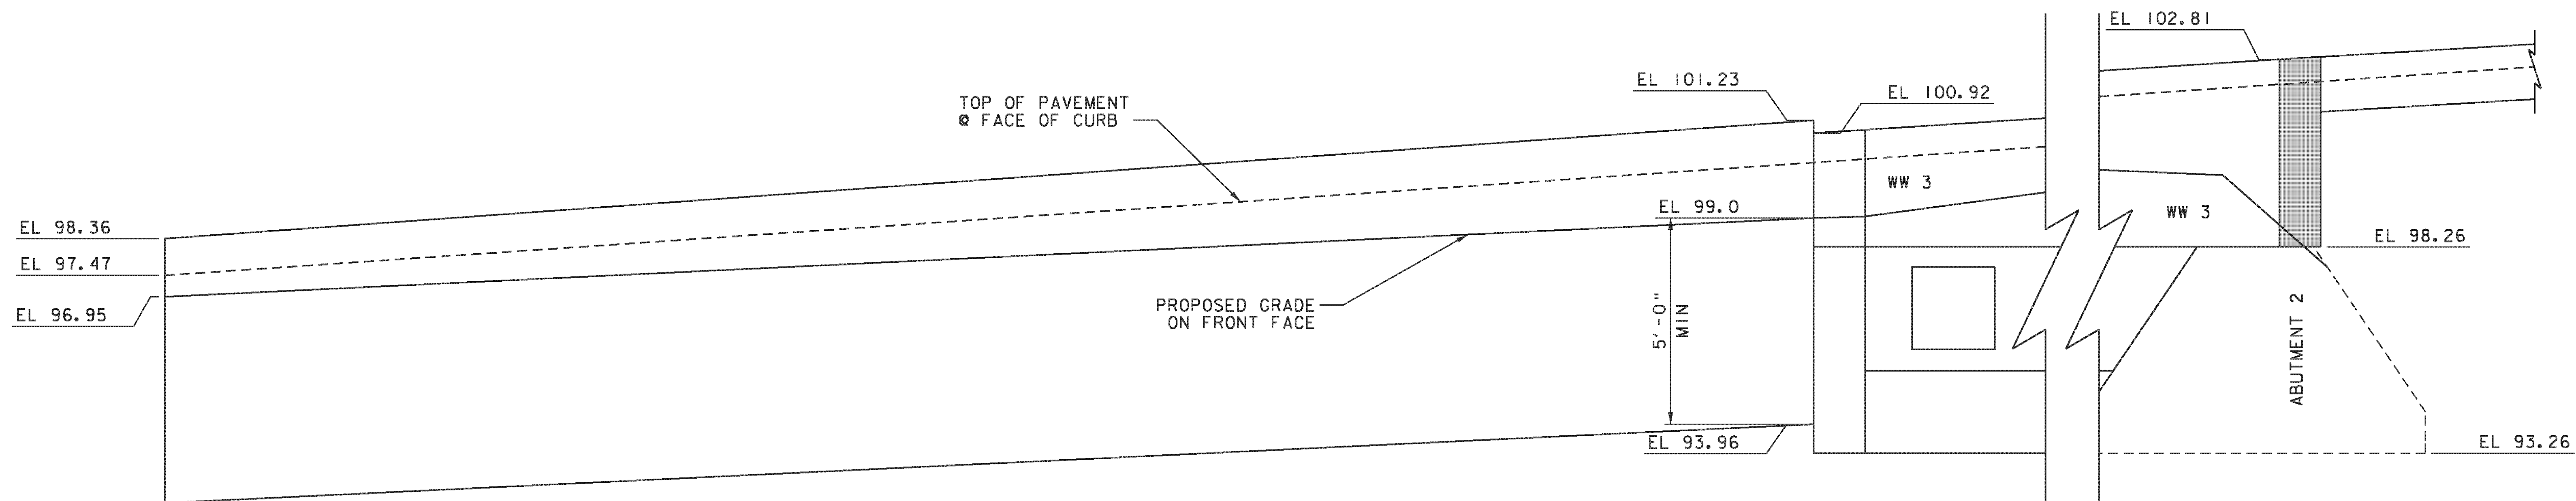

RETAINING WALL 3 ELEVATION  
SCALE 1/2" = 1'-0"

KEY

 CURTAIN WALL

NOTE:


SEE SHEET 4 FOR SPECIAL PROVISION (RETAINING WALL) EXCAVATION DETAIL.

PROJECT NAME: HARTLAND  
PROJECT NUMBER: BHF BPNT(12)


FILE NAME: zllc260sub.dgn  
PROJECT LEADER: M.A. COLGAN  
DESIGNED BY: S.G. FARNSWORTH  
BR 62A RETAINING WALL DETAILS (2 OF 3)

PLOT DATE: 12/17/2013  
DRAWN BY: A.J. GOUDREAU  
CHECKED BY: S.E. BURBANK  
SHEET 32 OF 55



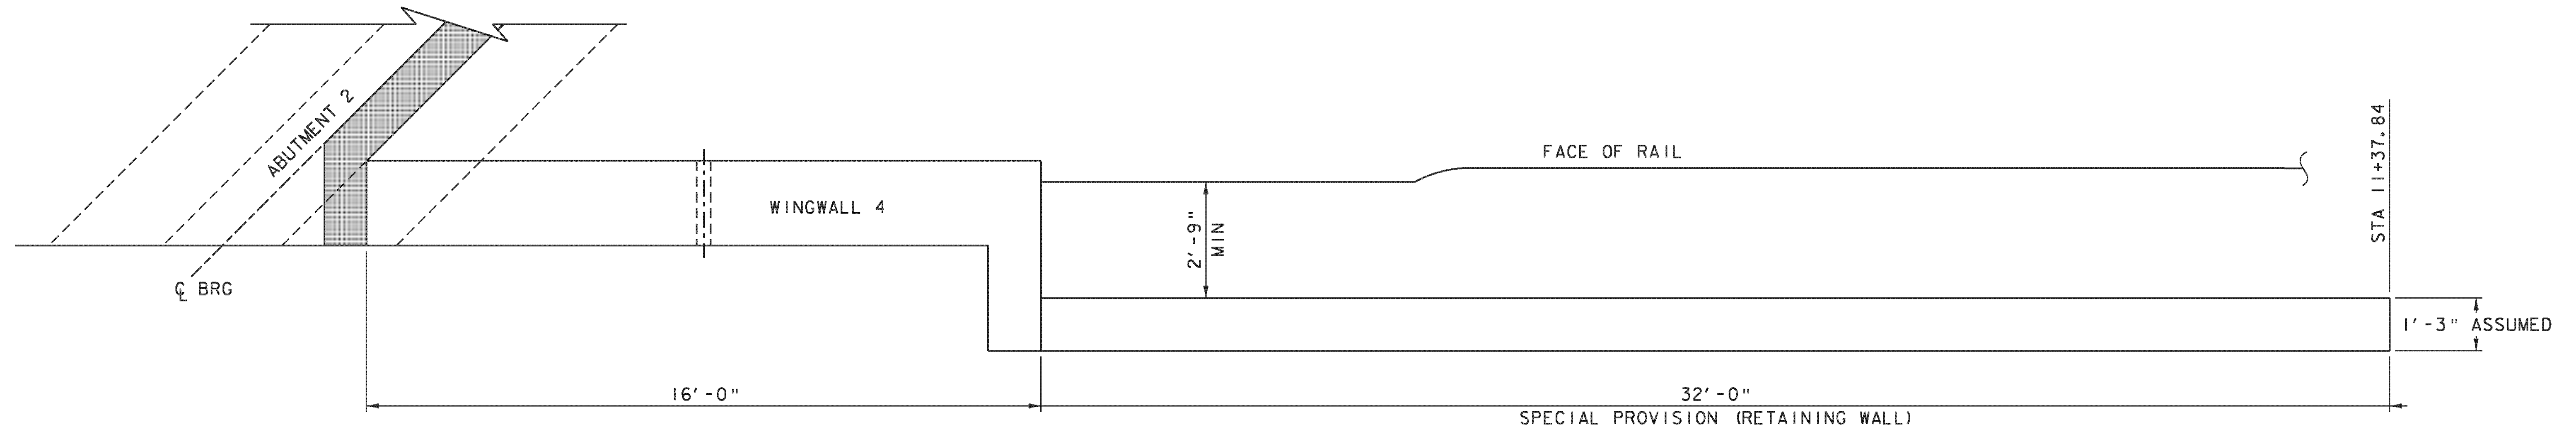

RETAINING WALL 4 PLAN  
SCALE 1/2" = 1'-0"

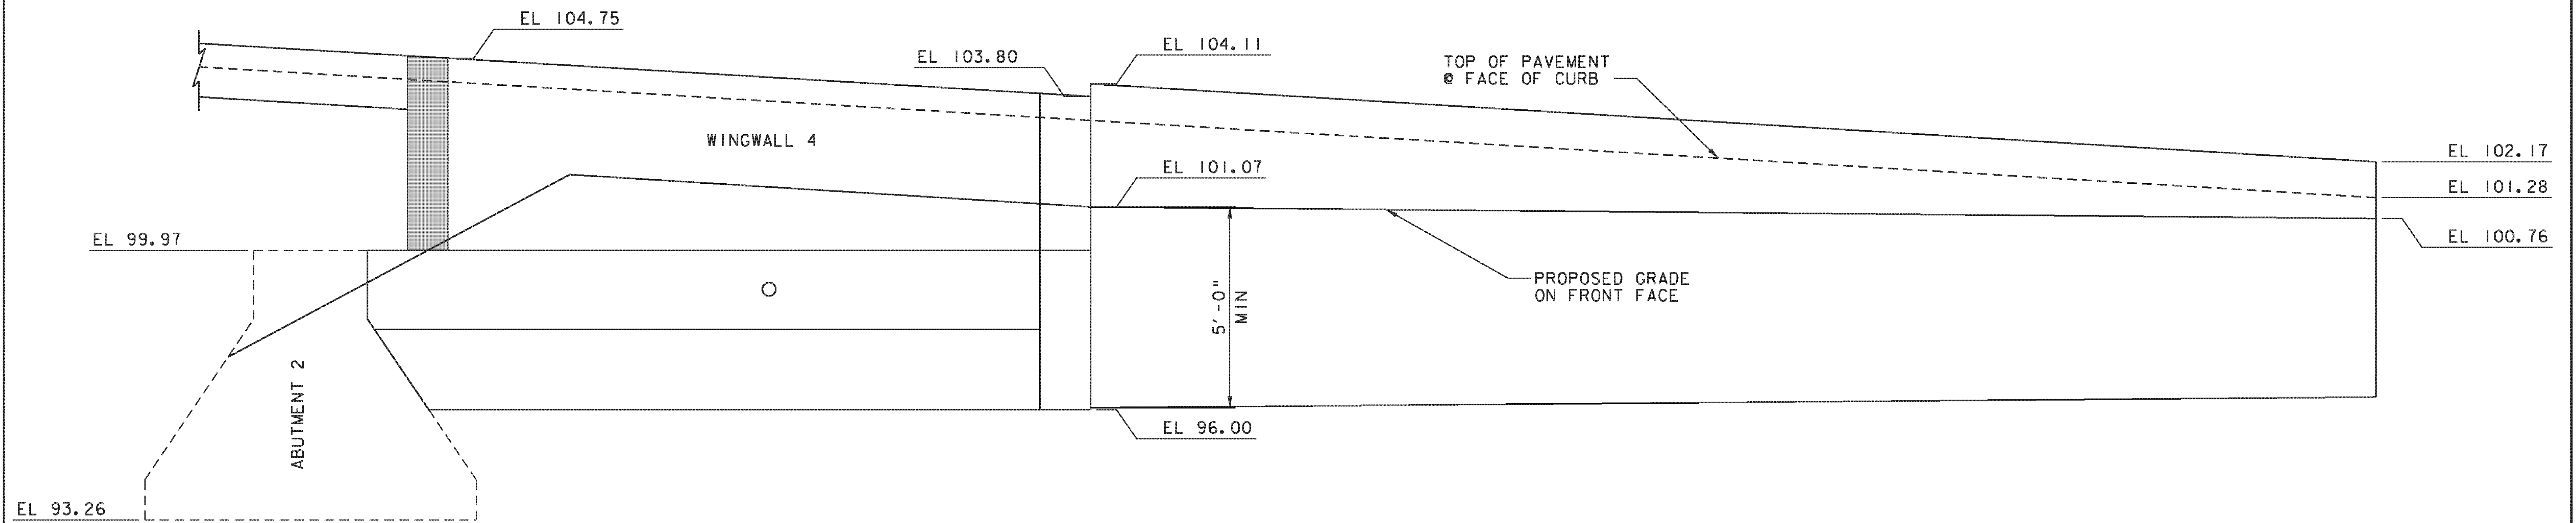

RETAINING WALL 4 ELEVATION  
SCALE 1/2" = 1'-0"

KEY

 CURTAIN WALL

NOTE:

SEE SHEET 4 FOR SPECIAL PROVISION (RETAINING WALL) EXCAVATION DETAIL.

PROJECT NAME: HARTLAND  
PROJECT NUMBER: BHF BPNT(12)

FILE NAME: zllc260sub.dgn PLOT DATE: 12/17/2013  
PROJECT LEADER: M.A. COLGAN DRAWN BY: A.J. GOUDREAU  
DESIGNED BY: S.G. FARNSWORTH CHECKED BY: S.E. BURBANK  
BR 62A RETAINING WALL DETAILS (3 OF 3) SHEET 33 OF 55




# REINFORCING STEEL SCHEDULE

ITEM	EACH	SIZE	LENGTH	MARK	TYPE	A	B	C	D	E	F	G	H	J	K	R	O	ITEM	EACH	SIZE	LENGTH	MARK	TYPE	A	B	C	D	E	F	G	H	J	K	R	O
<b>DECK &amp; CURB</b>																																			
252	5	34	6"	S501.2	STR																														
146	5	32	6"	S502.2	STR																														
238	5	14	8"	S503.2	1	0'-7"	14'-1"																												
238	5	21	2"	S504.2	1		20'-7"					0'-7"																							
274	5	4	5"	S505.2	S5	0'-6"	1'-0"	1'-5"	1'-0"			0'-6"																							
74	5	4	8"	S506.2	S5	1'-8"	1'-0"	2'-0"				0'-3"			1'-0"																				
64	5	4	8"	S507.2	S5	3'-0"	1'-8"	0'-8"	1'-8"			3'-0"																							
14	5	9	10"	S508.2	S5	3'-0"	1'-8"	0'-8"	1'-8"			3'-0"																							
3	5	23	5"	S509.2	S5	1'-10"	21'-7"					1'-4"			1'-4"		22'-11"																		
4	5	23	8"	S510.2	S5	2'-1"	21'-7"					1'-6"			1'-6"		23'-1"																		
2	5	4	7"	S511.2	S5	1'-10"	2'-0"					1'-4"			1'-4"		4'-1"																		
2	5	4	10"	S512.2	S5	2'-1"	2'-9"					1'-8"			1'-8"		4'-3"																		
6	5	21	8"	S513.2	STR																														
4	5	4	0"	S514.2	STR																														
4	5	4	2"	S515.2	STR		2'-3"	1'-9"				1'-9"			1'-9"		3'-6"																		
<b>WINGWALL NO. 1</b>																																			
13	5	3	11"	E1W501	STR																														
12	5	7	2"	E1W502	STR		3'-11"	3'-3"																											
23	5	8	3"	E1W503	STR																														
4	5	3	8"	E1W504	STR		1'-6"	2'-2"				1'-1"			1'-1"																				
13	5	11	0"	E1W505	STR																														
10	5	12	6"	E1W506	STR																														
12	5	11	0"	E1W507	STR																														
20	5	5	9"	E1W508	S10	2'-2"	1'-5"	2'-2"																											
24	5	9	0"	E1W509	STR																														
4	5	6	6"	E1W510	STR																														
<b>WINGWALL NO. 2</b>																																			
12	5	3	11"	E2W501	STR																														
12	5	7	2"	E2W502	STR		3'-11"	3'-3"																											
23	5	8	3"	E2W503	STR																														
4	5	3	8"	E2W504	STR		1'-6"	2'-2"				1'-1"			1'-1"																				
13	5	12	9"	E2W505	STR																														
8	5	15	8"	E2W506	STR		2'-2"	13'-6"																											
13	5	19	1"	E2W507	STR		2'-2"	15'-6"																											
28	5	5	9"	E2W508	S10	2'-2"	1'-5"	2'-2"																											
24	5	5	9"	E2W509	STR																														
14	5	8	4"	E2W510	STR																														
20	5	5	1"	E2W512	S10	2'-2"	0'-9"	2'-2"																											
4	5	6	2"	E2W513	S5	4'-0"	2'-2"																												
6	5	8	0"	E2W514	STR																														
6	5	3	8"	E2W519	STR																														
<b>WINGWALL NO. 3</b>																																			
24	5	3	11"	E3W501	STR																														
24	5	7	2"	E3W502	STR		3'-11"	3'-3"																											
47	5	8	3"	E3W503	STR																														
4	5	3	8"	E3W504	STR		1'-6"	2'-2"				1'-1"			1'-1"																				
13	5	22	10"	E3W505	STR																														
6	5	2	2"	E3W506	STR		2'-2"																												
9	5	2	2"	E3W507	STR		2'-2"																												
44	5	5	9"	E3W508	S10	2'-2"	1'-5"	2'-2"																											
58	5	6	10"	E3W509	STR																														
10	5	7	3"	E3W510	STR																														
20	5	5	1"	E3W512	S10	2'-2"	0'-9"	2'-2"																											
4	5	6	2"	E3W513	S5	4'-0"	2'-2"																												
6	5	5	5"	E3W514	STR																														
2	5	6	3"	E3W515	STR																														
2	5	4	2"	E3W516	STR																														
4	5	5	5"	E3W517	STR																														
2	5	19	0"	E3W518	STR																														
4	5	3	8"	E3W519	STR																														
<b>WINGWALL NO. 4</b>																																			
17	5	3	11"	E4W501	STR																														
17	5	7	2"	E4W502	STR		3'-11"	3'-3"																											
36	5	8	3"	E4W503	STR																														
4	5	3	8"	E4W504	STR		1'-6"	2'-2"				1'-1"			1'-1"																				
13	5	17	0"	E4W505	STR																														
4	5	19	8"	E4W506	STR		2'-2"	17'-6"																											
11	5	17	8"	E4W507	STR		2'-2"	15'-6"																											
25	5	5	9"	E4W508	S10	2'-2"	1'-5"	2'-2"																											
32	5	6	5"	E4W509	STR																														
4	5	3	3"	E4W510	STR																														
14	5	5	1"	E4W512	S10	2'-2"	0'-9"	2'-2"																											
4	5	6	2"	E4W513	S5	4'-0"	2'-2"																												
6	5	5	6"	E4W514	STR																														



~ NOTES ~

- UNLESS OTHERWISE DESIGNATED, ALL BAR REINFORCEMENT FOR CONCRETE IN SIZES UP TO AND INCLUDING NO. 18 SHALL CONFORM TO THE REQUIREMENTS OF THE "SPECIFICATIONS FOR DEFORMED BILLET-STEEL BARS FOR CONCRETE REINFORCEMENT", AASHTO M31 (ASTM A 615-S). ALL BARS SHALL BE GRADE 60, UNLESS OTHERWISE DESIGNATED.
- FOR TYPICAL BENDING DETAILS, RECOMMENDED P/D RATIO OF BENDS AND HOOKS, AND OTHER STANDARD PRACTICE, SEE CURRENT CONCRETE REINFORCING STEEL INSTITUTE "MANUAL OF STANDARD PRACTICE".
- BARS WHICH REQUIRE MORE ACCURATE BENDING THAN STANDARD PRACTICES SHOULD HAVE LIMITS INDICATED.
- ALL DIMENSIONS ARE OUT TO OUT OF BAR EXCEPT "A" AND "G" ON STANDARD 180 DEGREE AND 135 DEGREE HOOKS.
- "J" DIMENSION ON 180 DEGREE HOOKS TO BE SHOWN ONLY WHERE NECESSARY TO RESTRICT HOOK SIZE. OTHERWISE, STANDARD HOOKS ARE TO BE USED.
- "H" DIMENSION ON STIRRUPS TO BE SHOWN ONLY WHEN NECESSARY TO MAINTAIN CLEARANCES.
- WHERE SLOPE DIFFERS FROM 45 DEGREES, DIMENSIONS "H" AND "K" MUST BE SHOWN.
- ▲ DENOTES BARS TO BE CUT IN FIELD.
- * DENOTES ONE EXTRA BAR ADDED FOR TESTING PURPOSES.
- △ DENOTES TWO EXTRA BARS ADDED FOR TESTING PURPOSES.
- E IN BAR MARK PREFIX DENOTES EPOXY COATED REINFORCING STEEL.

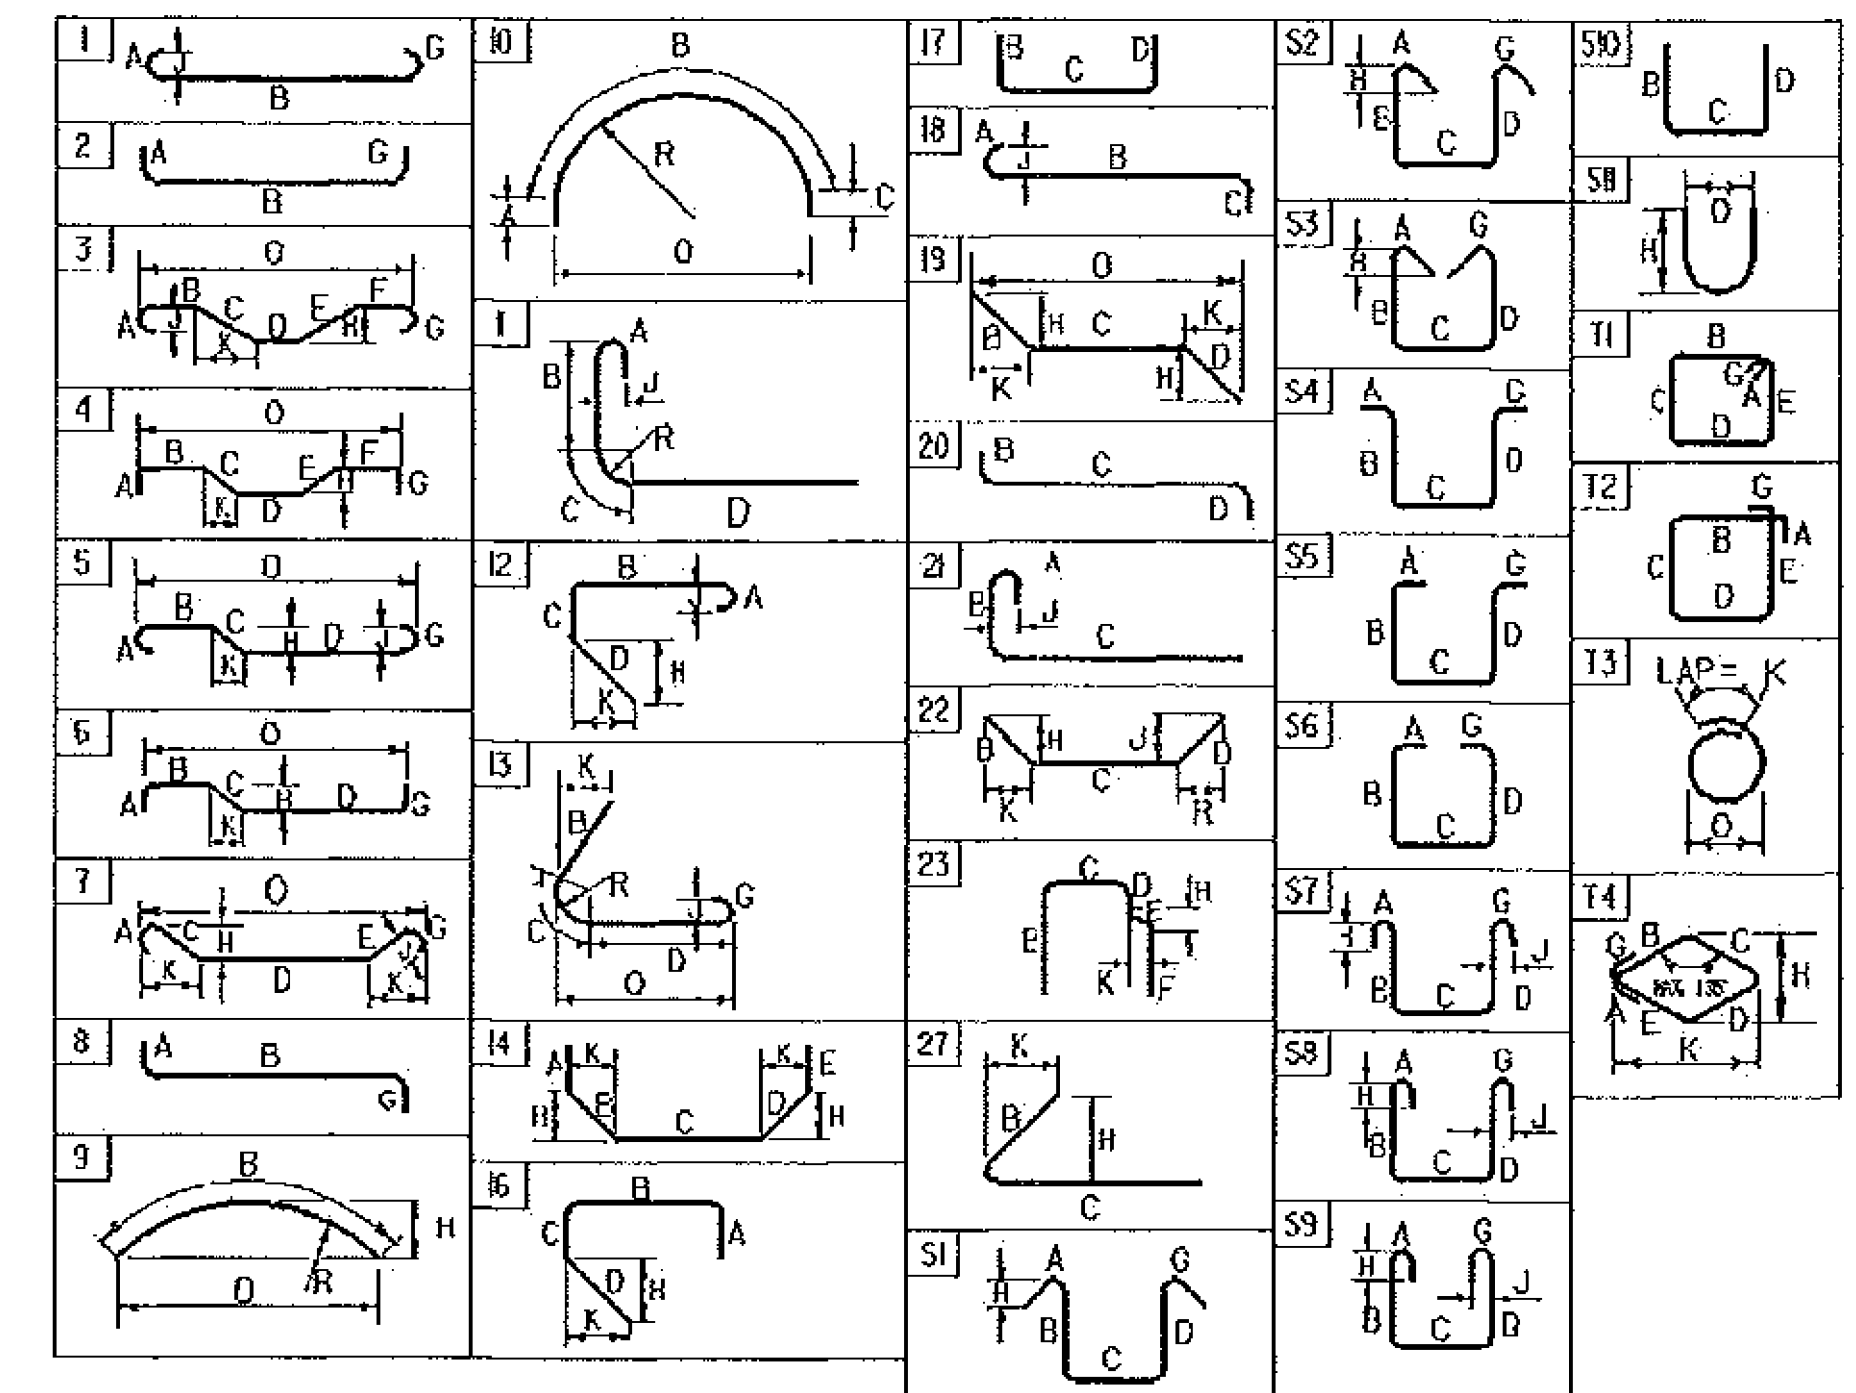


ASTM STANDARD REINFORCING BARS				
BAR SIZE DESIGNATION	WEIGHT POUNDS PER FOOT	NOMINAL DIAMENSIONS ROUND SECTION INCHES	AREA INCHES ²	PERIMETER INCHES
#3	0.376	0.375	0.11	1.178
#4	0.668	0.500	0.20	1.571
#5	1.043	0.625	0.31	1.963
#6	1.502	0.750	0.44	2.356
#7	2.044	0.875	0.60	2.749
#8	2.670	1.000	0.79	3.142
#9	3.400	1.128	1.00	3.544
#10	4.303	1.270	1.27	3.990
#11	5.313	1.410	1.56	4.430
#14				

# SEE REVISED SHEET

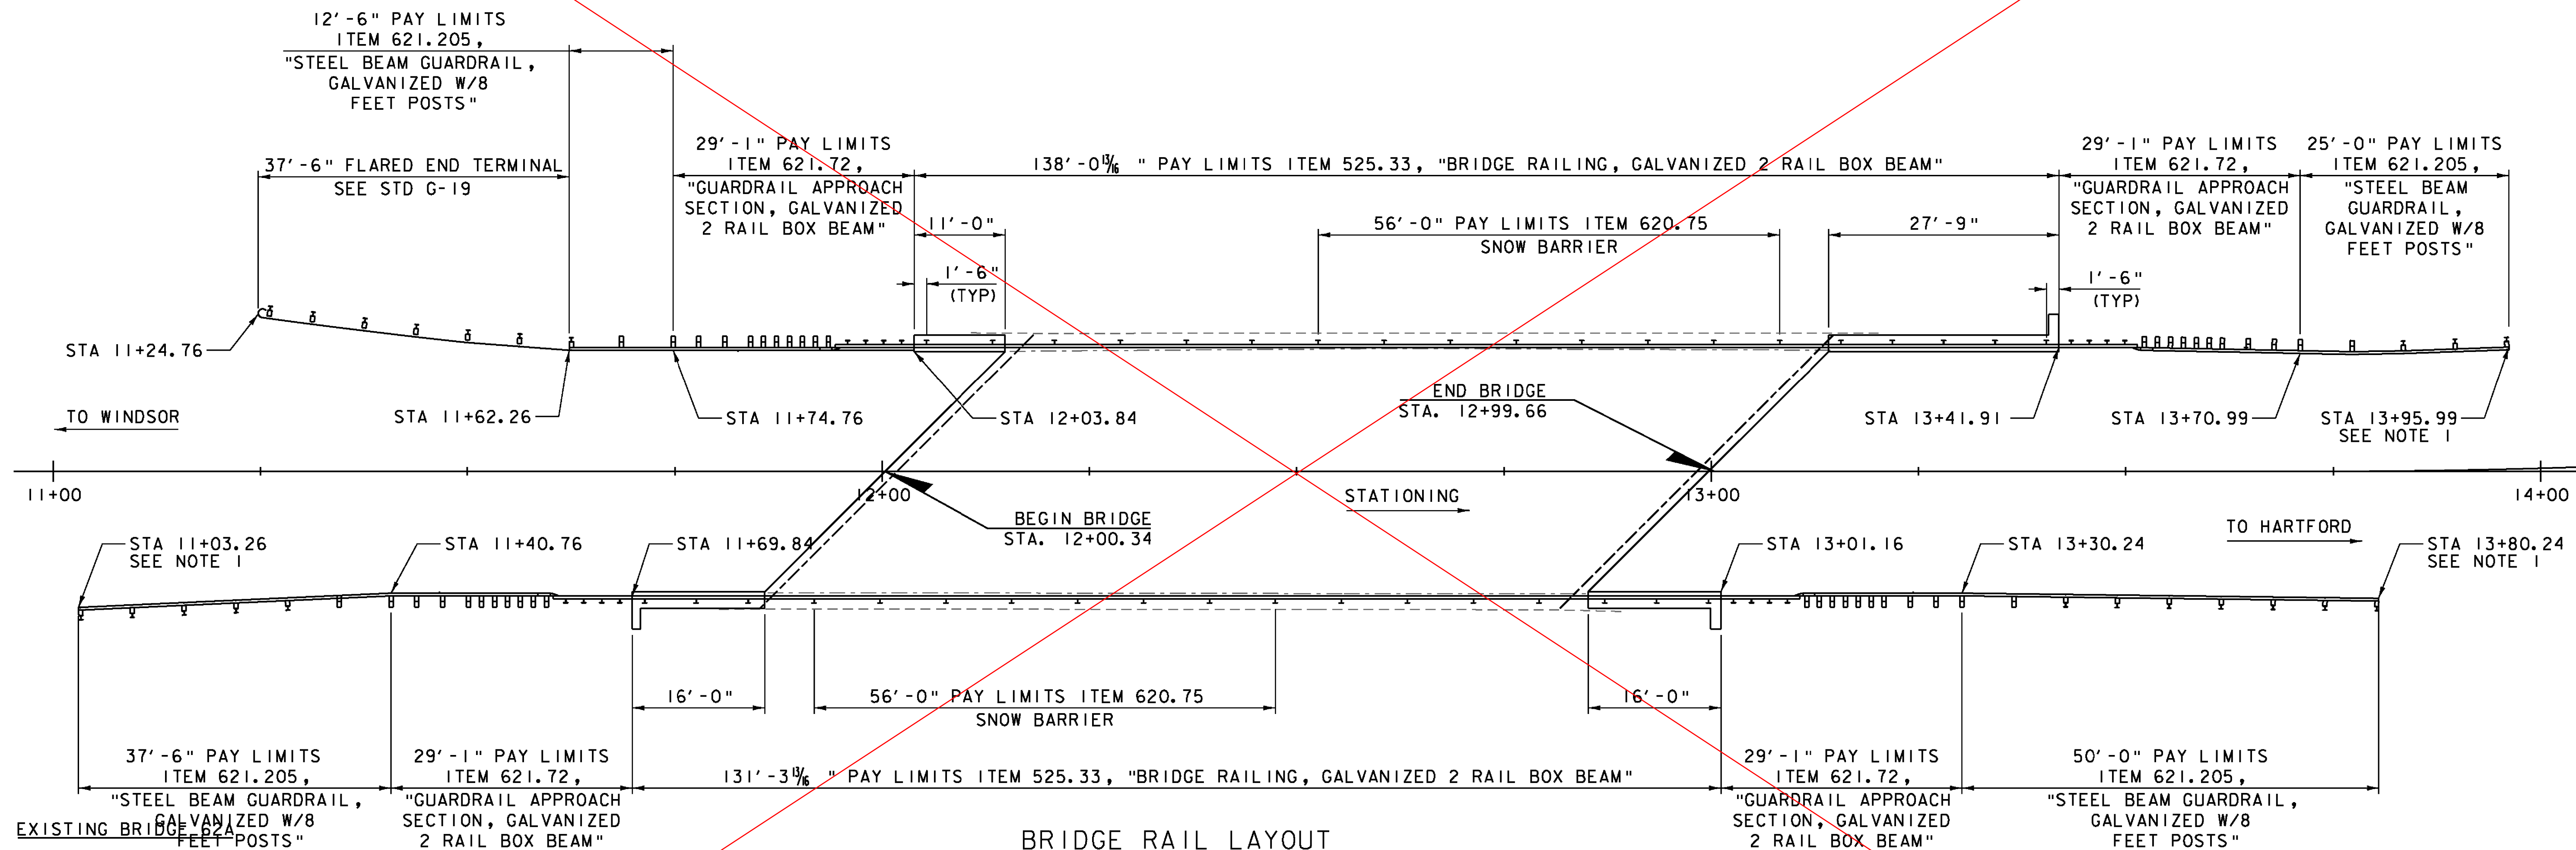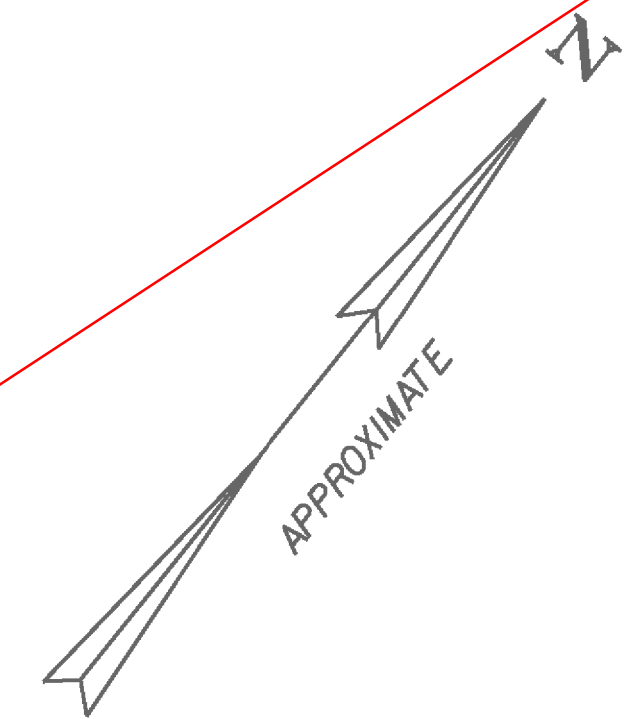

BRIDGE RAIL LAYOUT

SCALE: 1" = 10'-0"


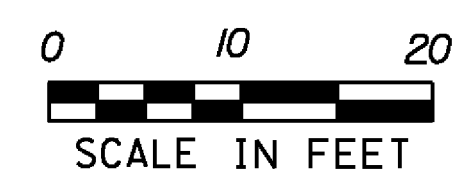


EXISTING BRIDGE  
 SINGLE SPAN  
 ROLLED BEAM  
 CONCRETE DECK  
 99'-4" LENGTH  
 29'-6" ROADWAY WIDTH  
 22'-2" VERTICAL CLEARANCE TO RAILROAD RAIL  
 BUILT 1955


- NOTES:**
- MATCH INTO EXISTING STEEL BEAM GUARDRAIL

PROJECT NAME: HARTLAND	PLOT DATE: 12/17/2013
PROJECT NUMBER: BHF BPNT(12)	DRAWN BY: A.J. GOUDREAU
FILE NAME: zllc260br.dgn	CHECKED BY: S.E. BURBANK
PROJECT LEADER: M.A. COLGAN	SHEET 35 OF 55
DESIGNED BY: S.G. FARNSWORTH	BR 62A BRIDGE AND GUARD RAIL LAYOUT



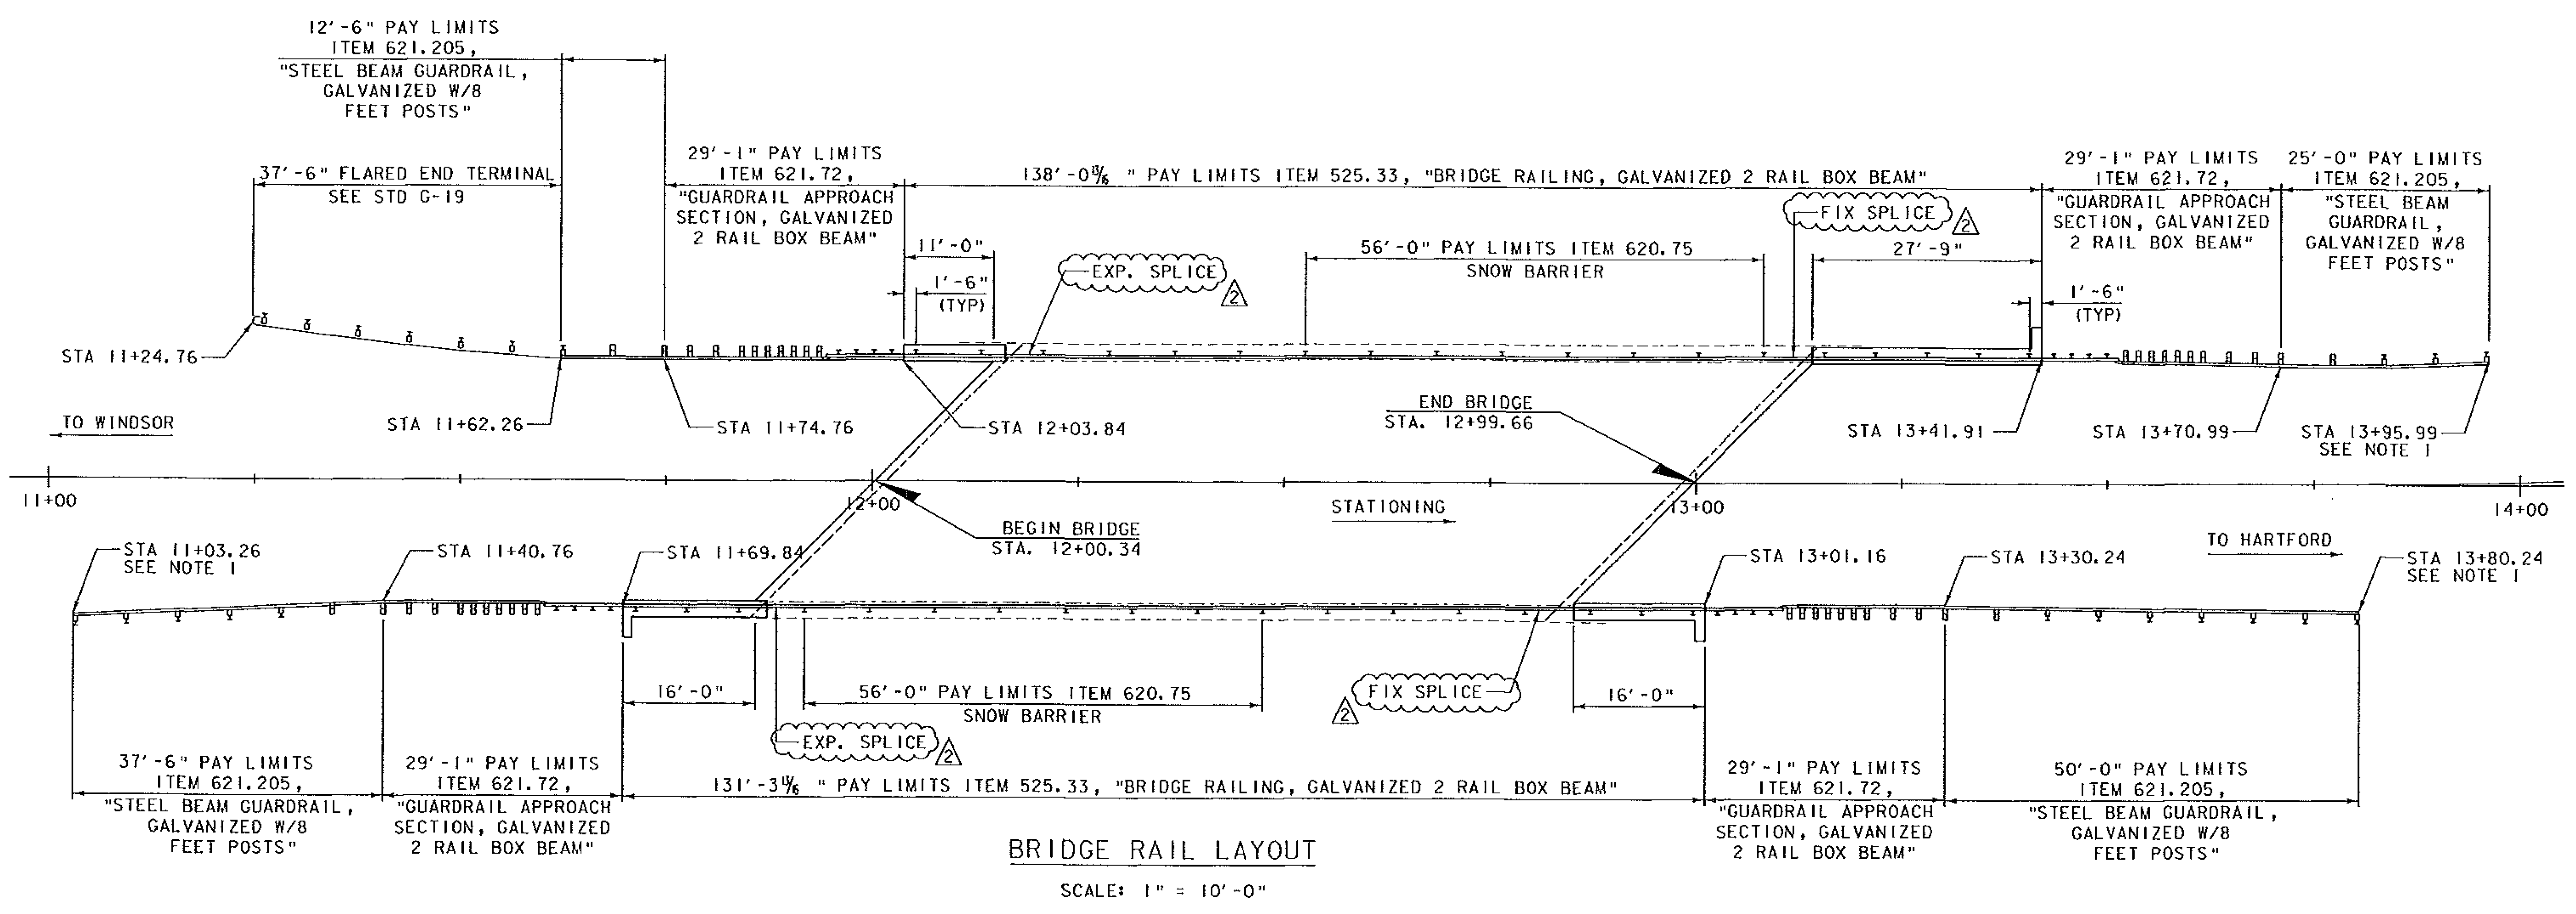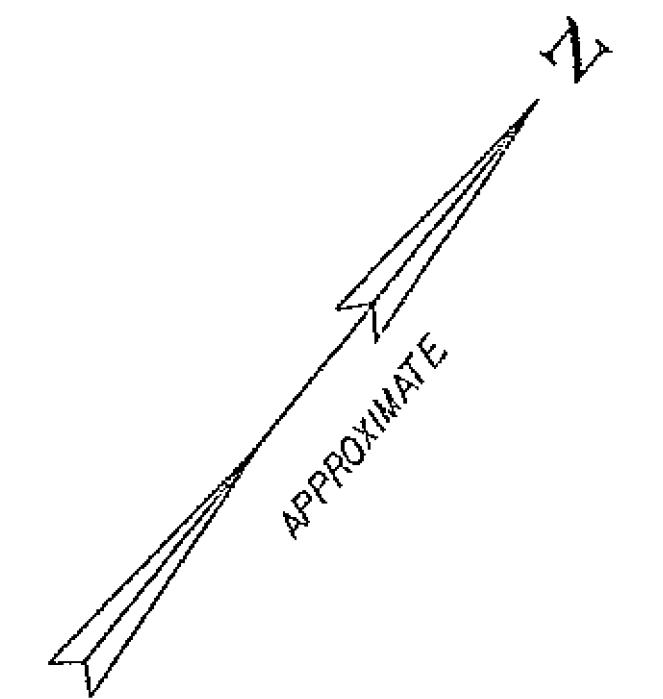

BRIDGE RAIL LAYOUT  
SCALE: 1" = 10'-0"

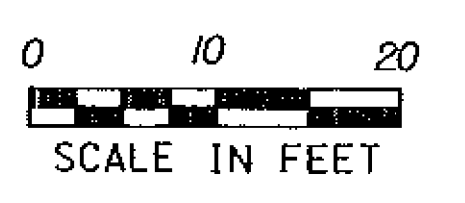

EXISTING BRIDGE 62A  
SINGLE SPAN  
ROLLED BEAM  
CONCRETE DECK  
99'-4" LENGTH  
29'-6" ROADWAY WIDTH  
22'-2" VERTICAL CLEARANCE TO RAILROAD RAIL  
BUILT 1955


NOTES:

- MATCH INTO EXISTING STEEL BEAM GUARDRAIL


REV.	DESCRIPTION	DATE
△	NOTED EXPANSION AND FIXED SPLICE LOCATION	3/3/2014

PROJECT NAME:	HARTLAND
PROJECT NUMBER:	BHF BPNT(12)
FILE NAME:	z1lc260brall.dgn
PROJECT LEADER:	M.A. COLGAN
DESIGNED BY:	S.G. FARNSWORTH
PLOT DATE:	3/3/2014
DRAWN BY:	A.J. GOUDREAU
CHECKED BY:	S.E. BURBANK
BR 62A BRIDGE AND GUARD RAIL LAYOUT	SHEET 35 OF 55




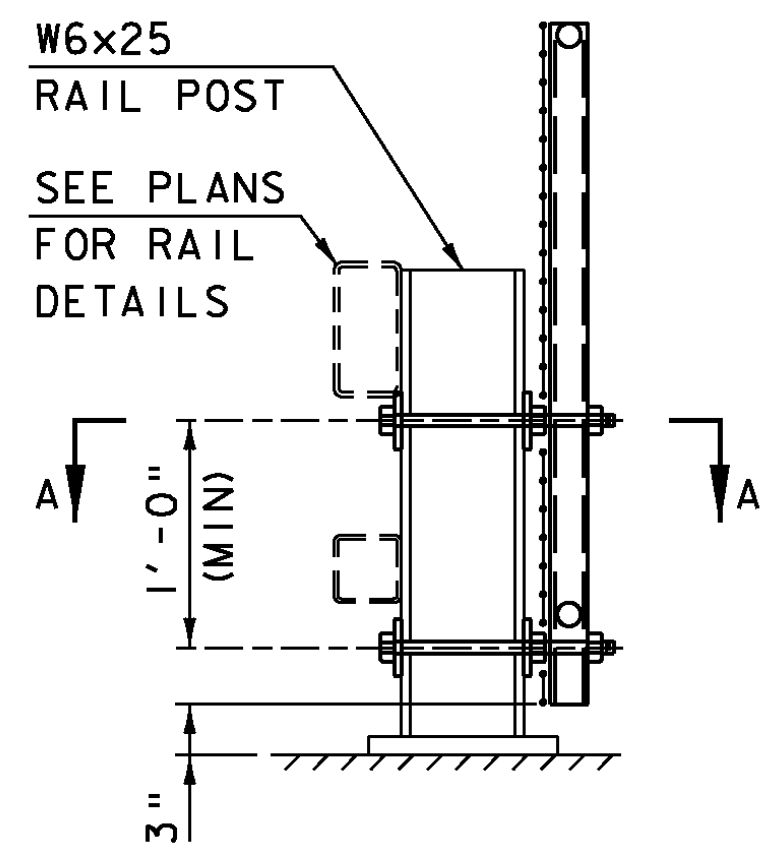


**TYPICAL SECTION**  
FOR SPECIFIC RAIL CONFIGURATION  
AND SIZES SEE PLAN SET

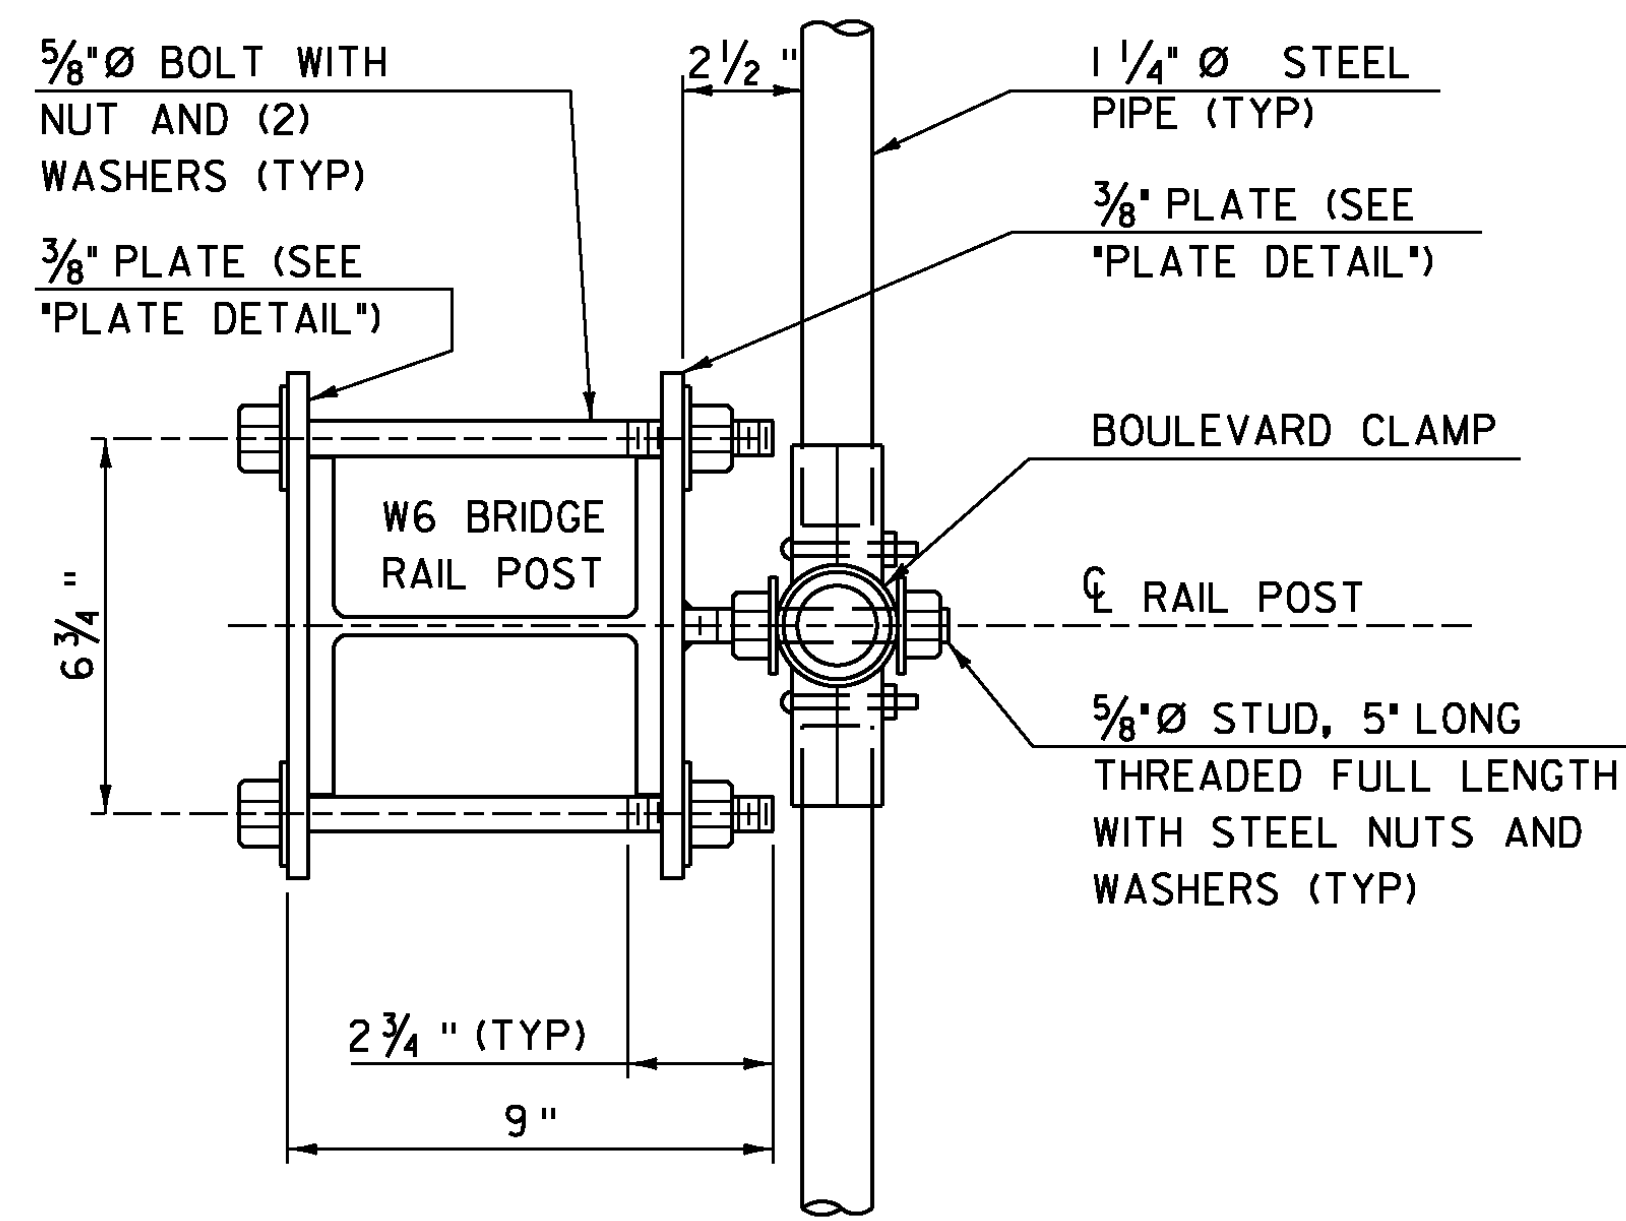


**SECTION A-A**

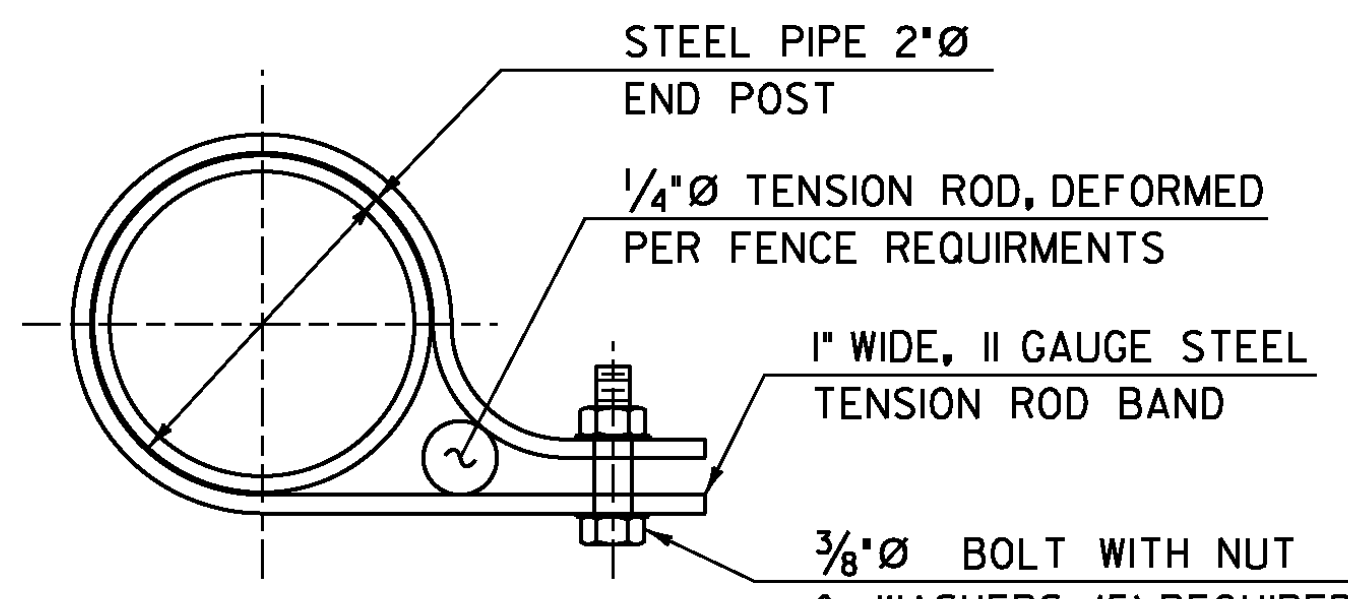


**TENSION ROD BAND**

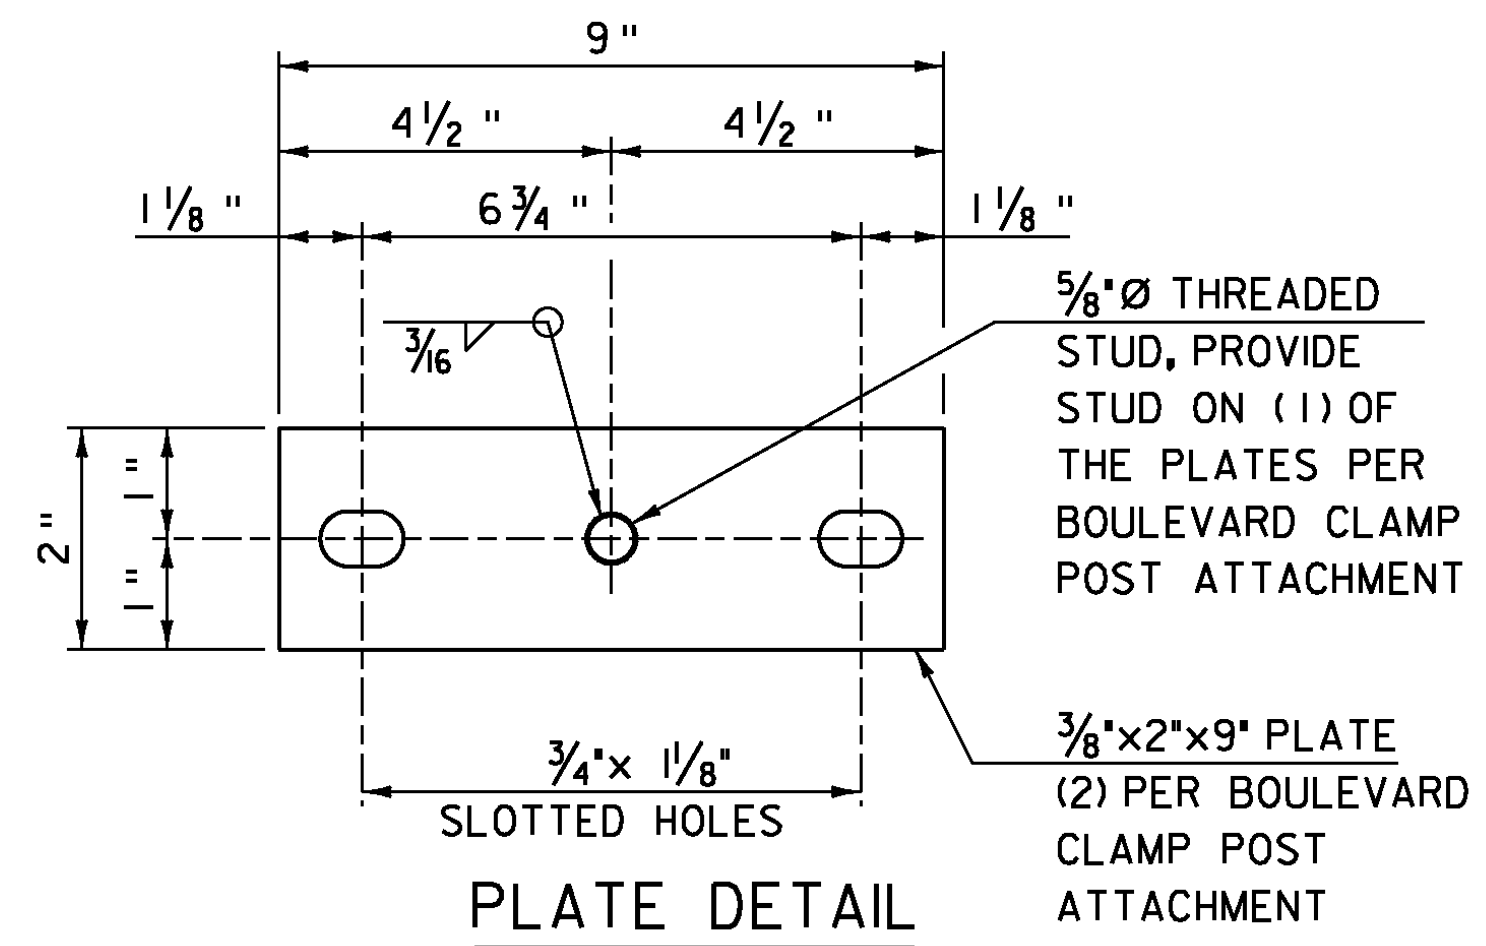

**PLATE DETAIL**

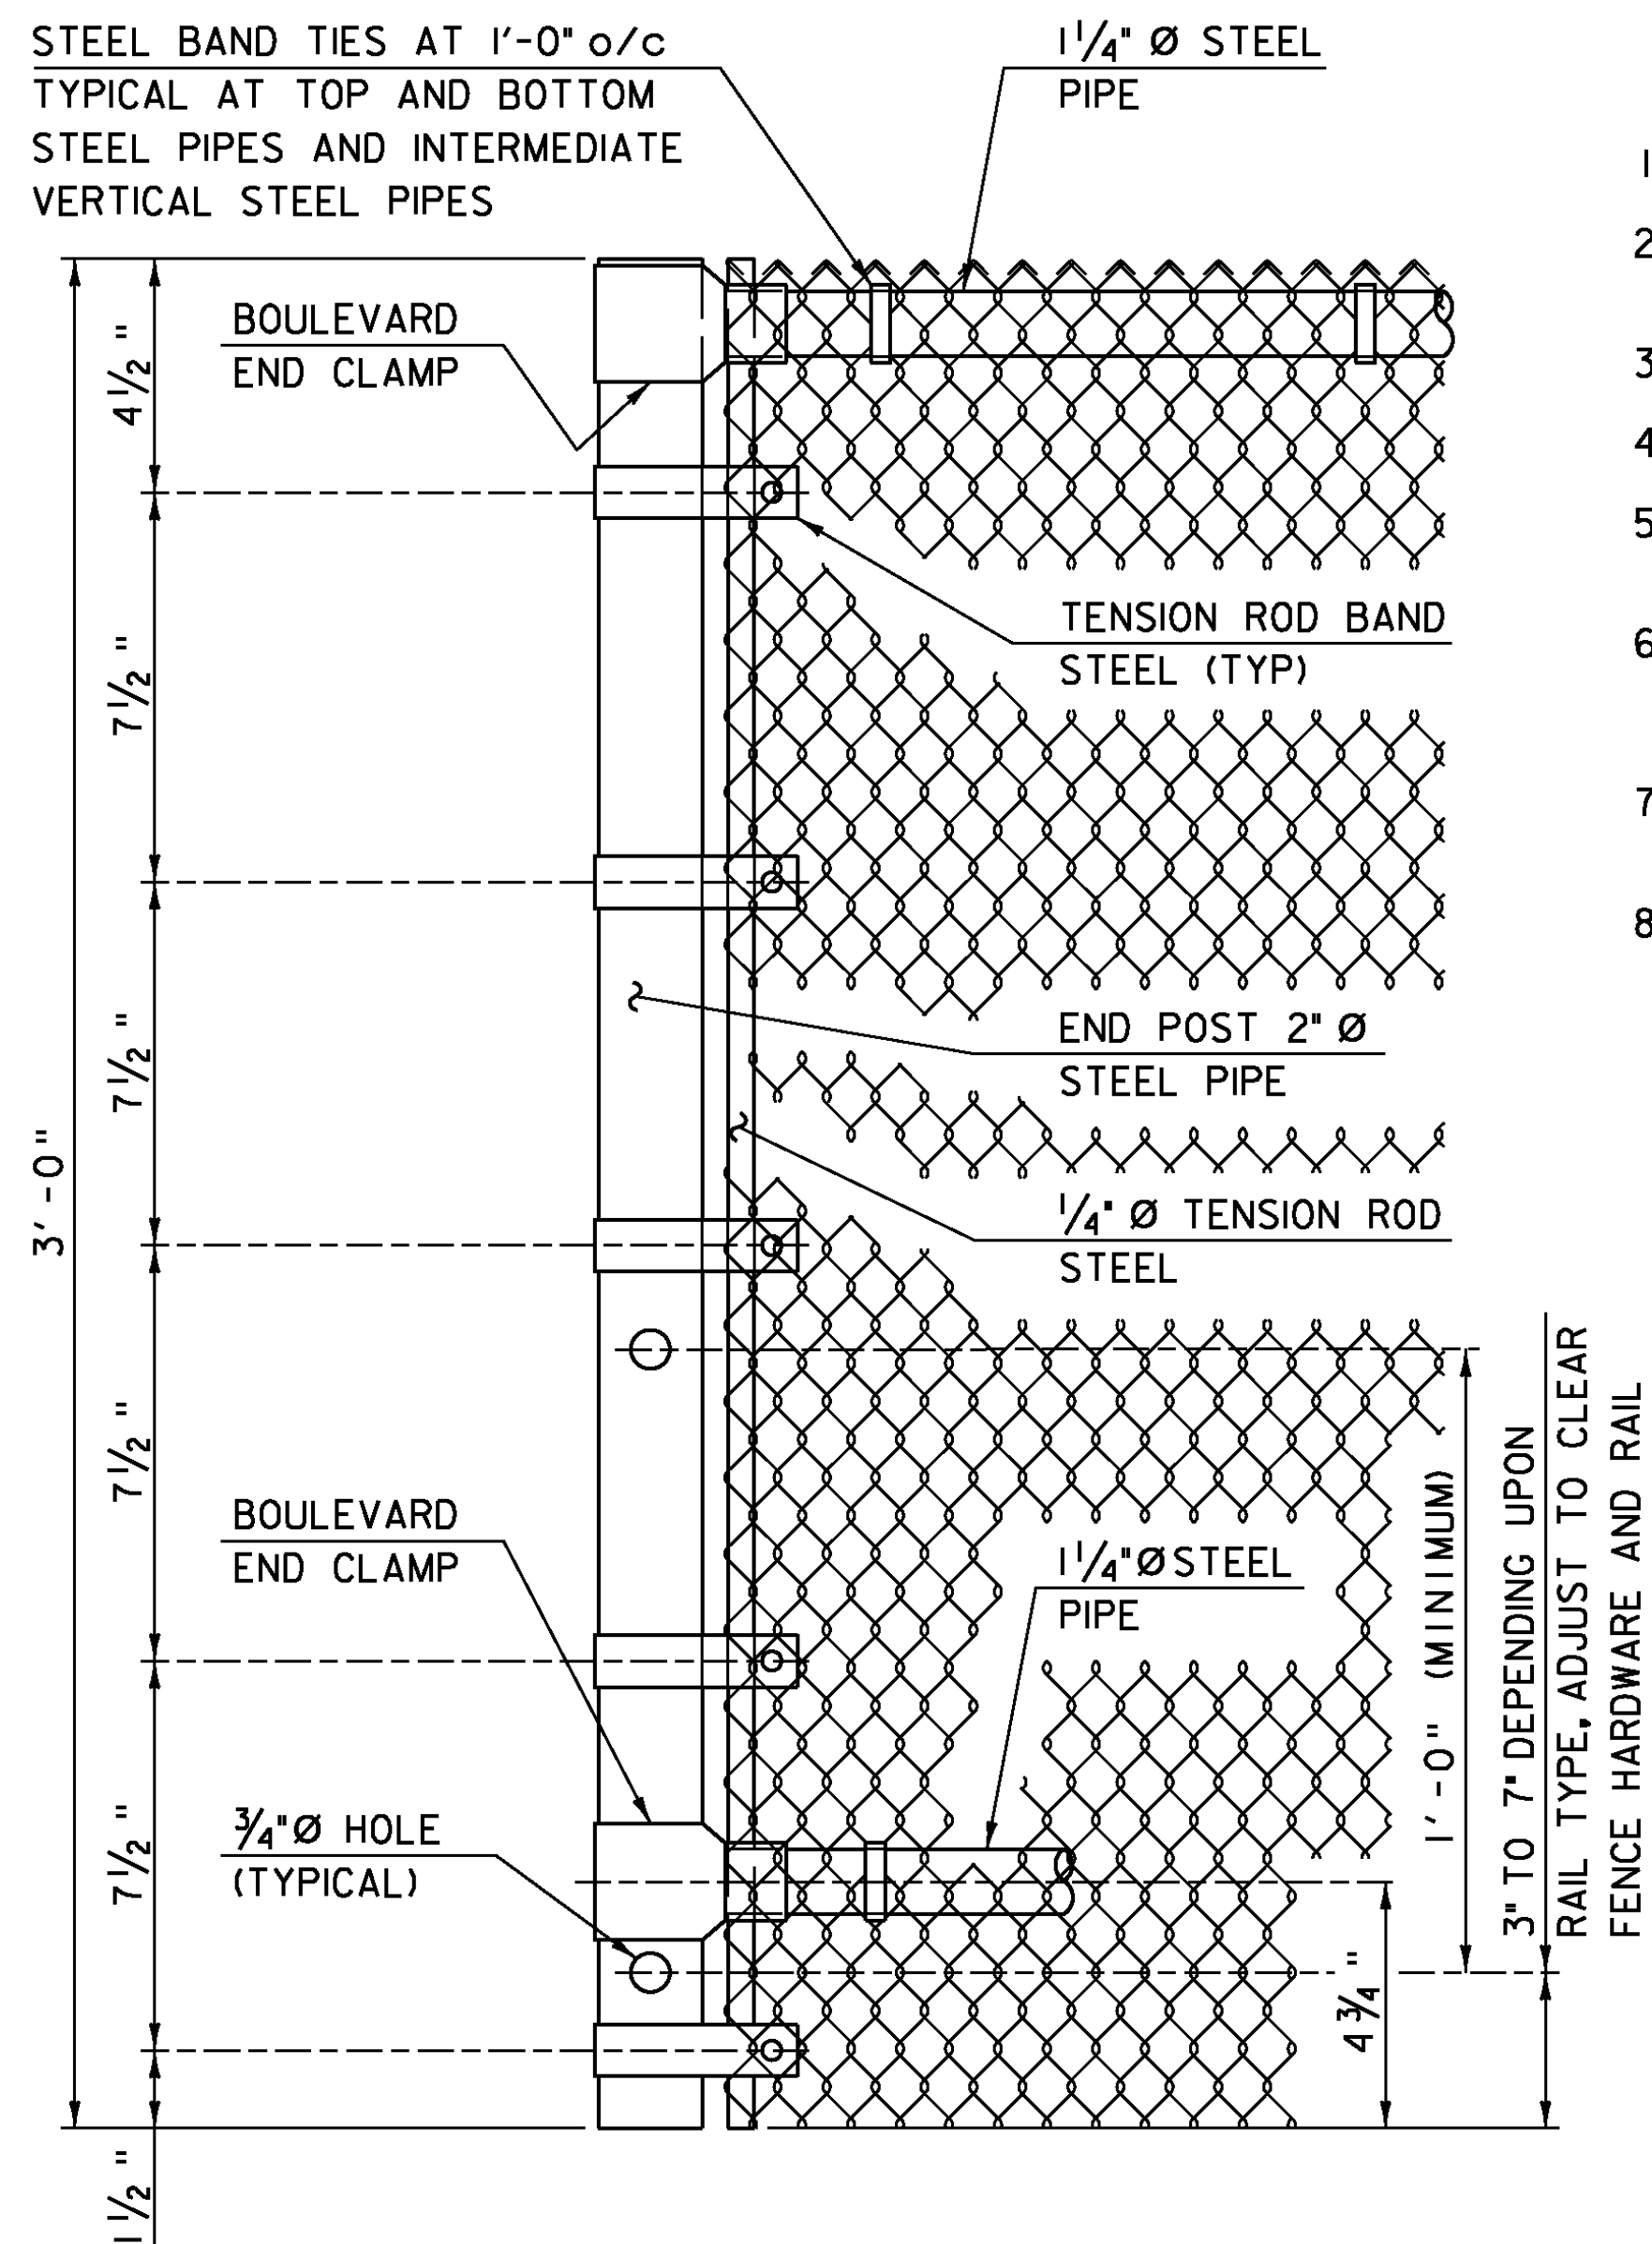


**END POST DETAILS**

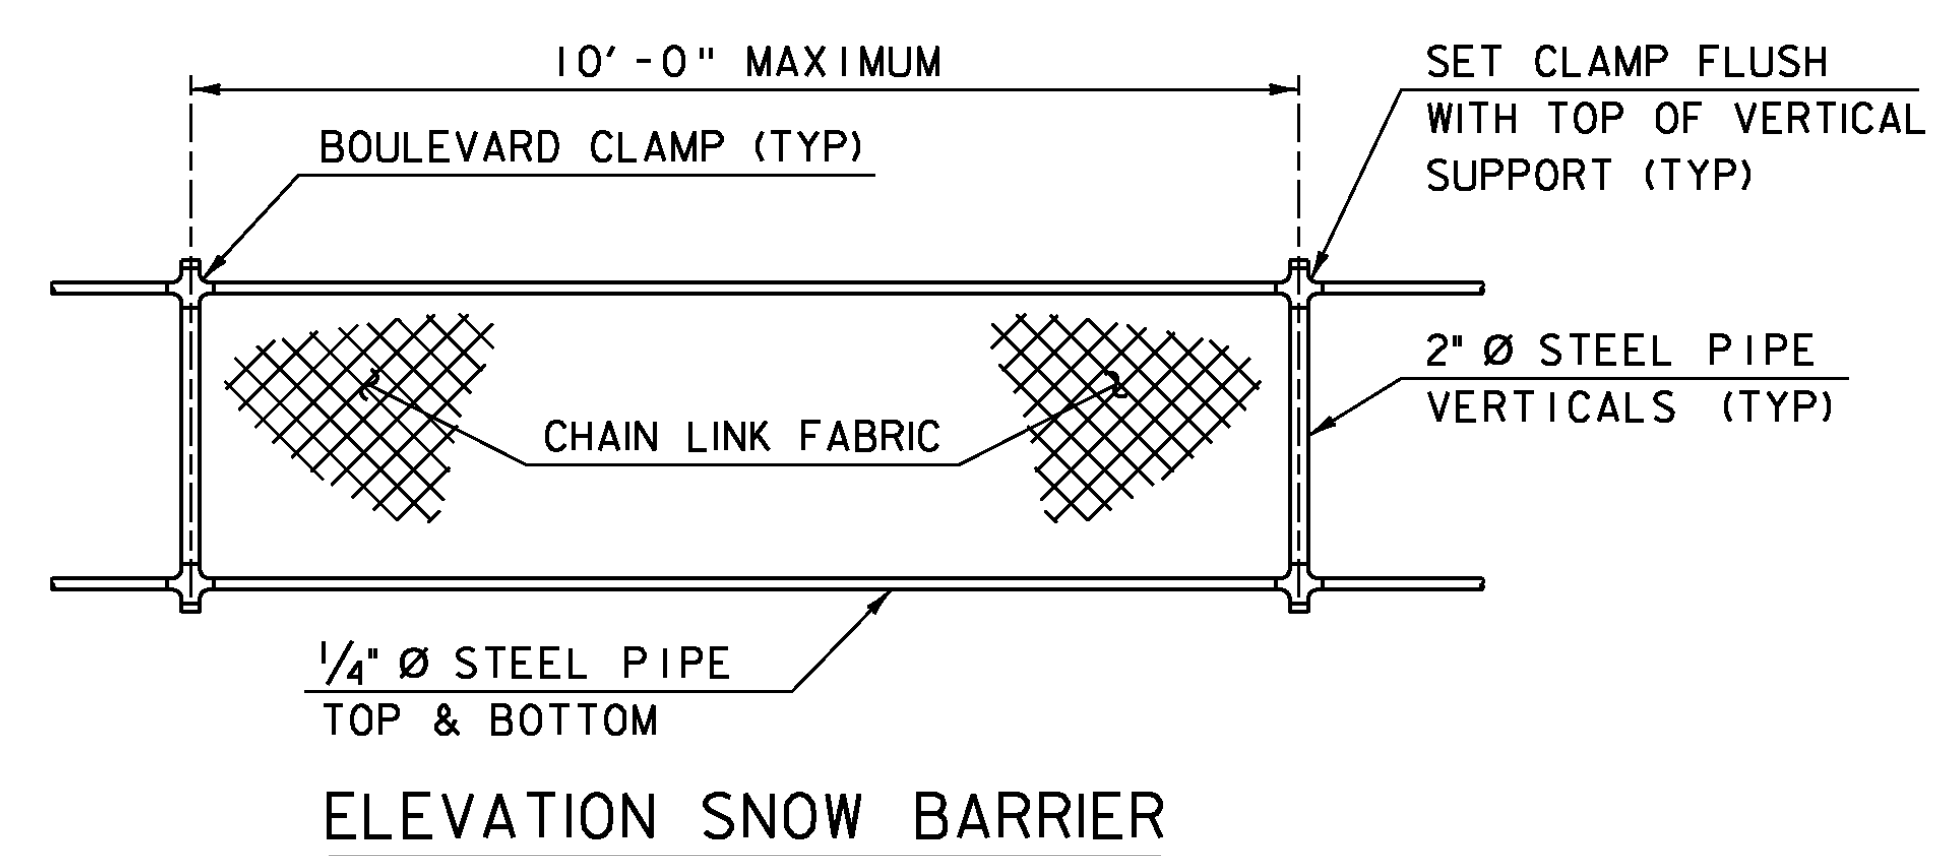

**ELEVATION SNOW BARRIER**


**NOTES**

1. ALL WORK AND MATERIAL SHALL CONFORM TO SECTION 620.
2. SNOW BARRIER CAN BE USED WITH GALVANIZED 2,3, AND 4 RAIL BOX BEAM BRIDGE RAIL.
3. 1 1/4" PIPE LENGTH SHALL BE FIELD CUT TO FIT POST SPACING.
4. CHAIN LINK FABRIC TO BE KNUCKLED TOP AND BOTTOM.
5. ALL STEEL PLATES SHALL CONFORM TO AASHTO M270/M270M GRADE 36.
6. SNOW BARRIER SHALL BEGIN AT THE BRIDGE RAIL POST WHICH WILL PROVIDE A MINIMUM DISTANCE OF 20' (AS SHOWN) OR AS DIRECTED BY THE ENGINEER.
7. ALL REFERENCES TO THE DIAMETERS OF GALVANIZED STEEL PIPE SHALL REFER TO THE OUTSIDE DIAMETER (O.D.).
8. HARDWARE FOR THE CONNECTION OF THE SNOW BARRIER SHALL BE HOT-DIP GALVANIZED OR MECHANICALLY GALVANIZED USING A MECHANICALLY DEPOSITED PROCESS CONFORMING TO THE REQUIREMENTS OF AASHTO M 298, CLASS 10.

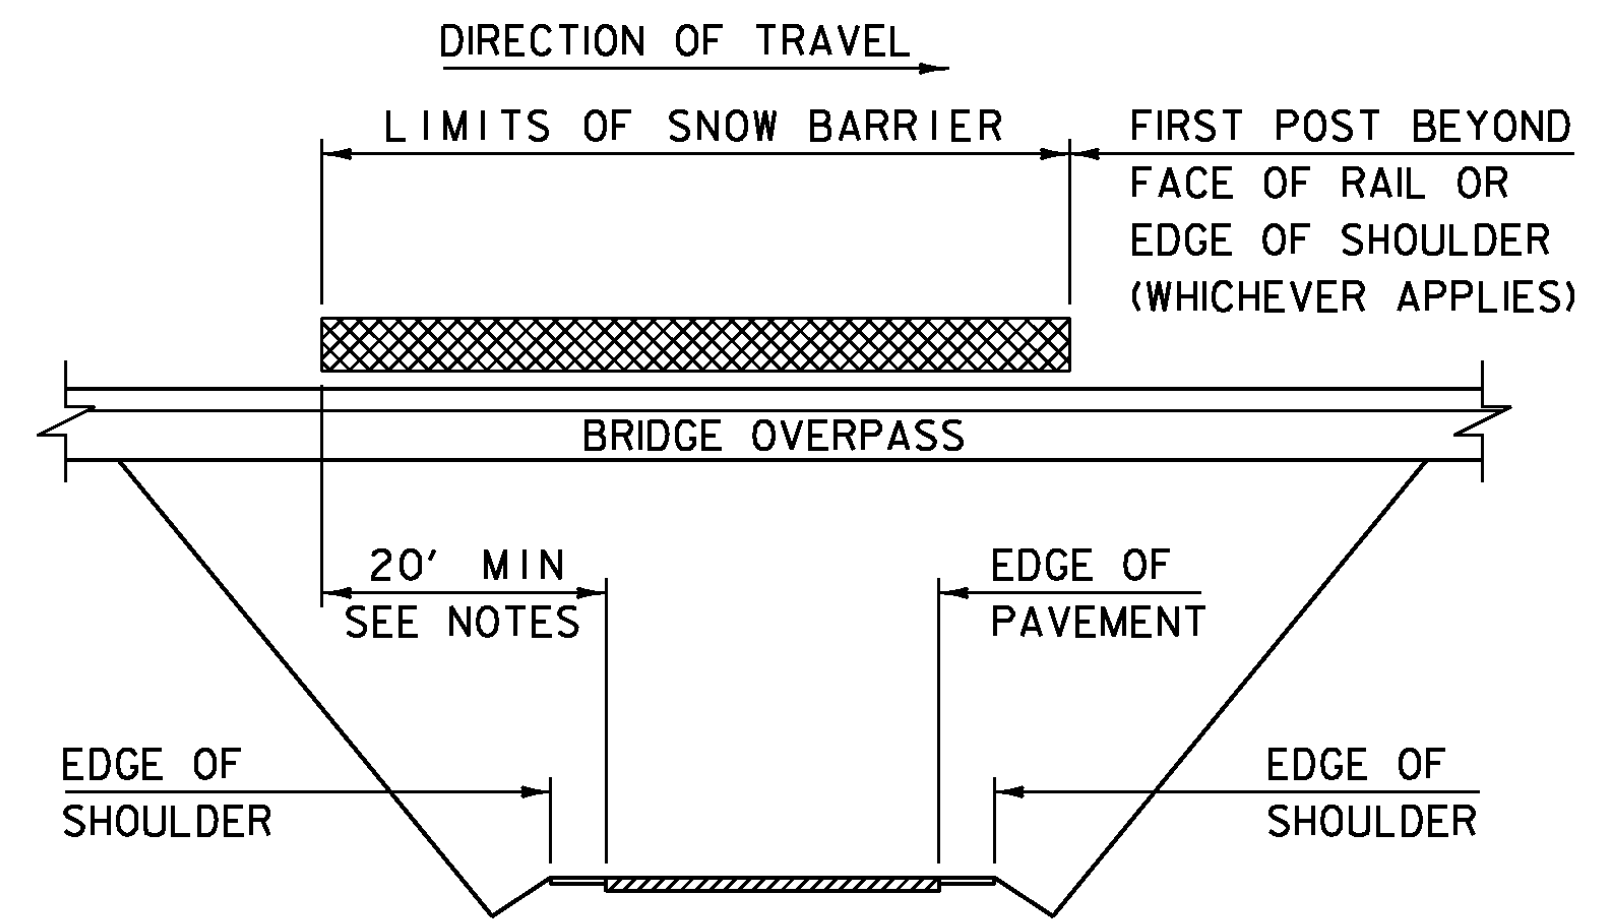


**SCHEMATIC SNOW BARRIER LIMITS**

PROJECT NAME: HARLTAND	PLOT DATE: 1/3/2014
PROJECT NUMBER: BHF BPNT(12)	DRAWN BY: VTRANS
FILE NAME: zllc260snowbarrier.dgn	CHECKED BY: VTRANS
PROJECT LEADER: VTRANS	SHEET 36 OF 55
DESIGNED BY: VTRANS	
BR 62A SNOW BARRIER	

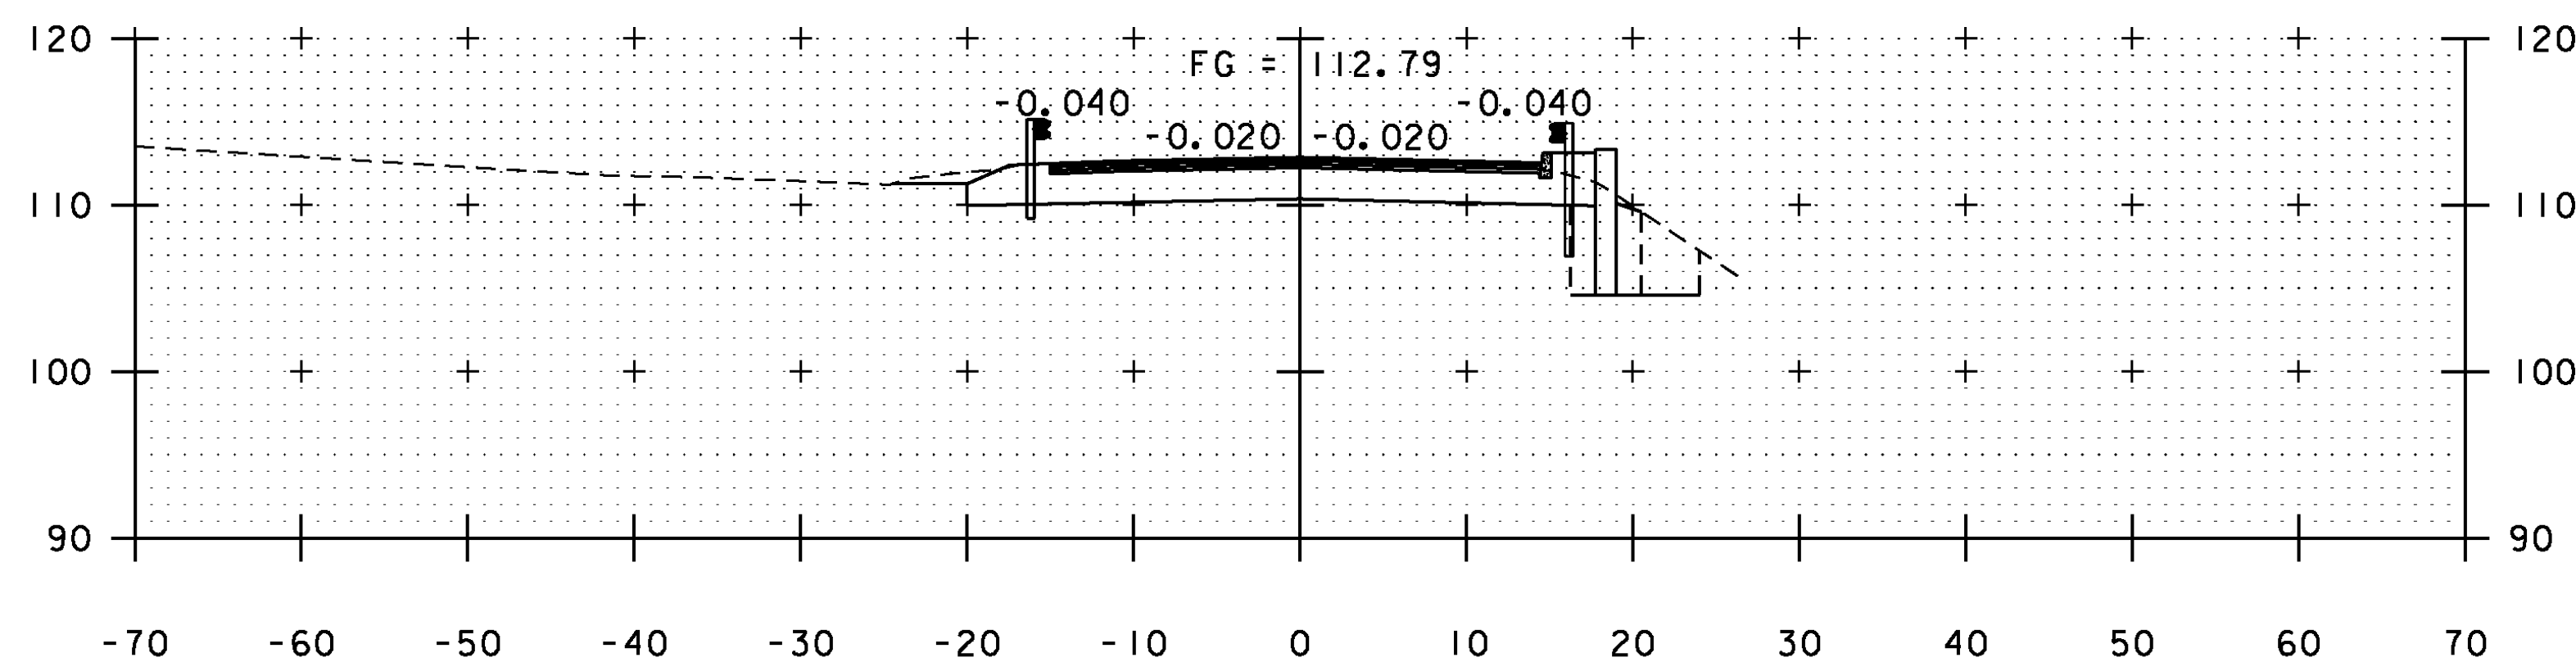


11+60

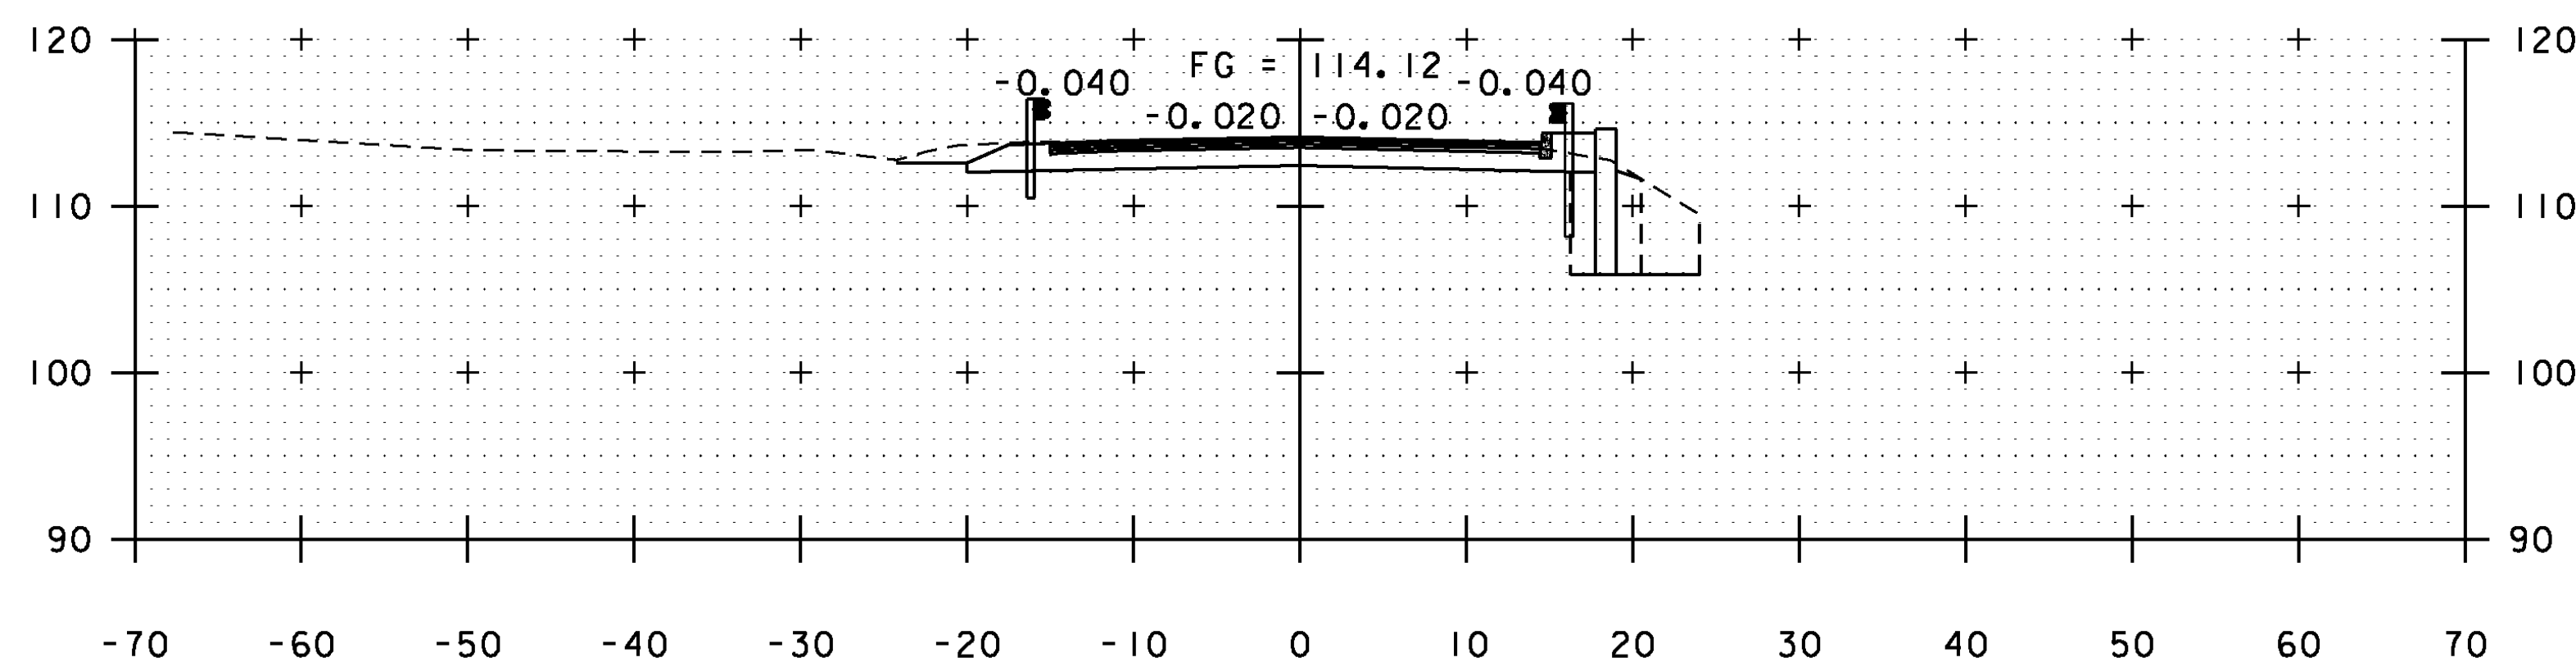


11+40

BEGIN PROJECT  
STA. 11+25.00

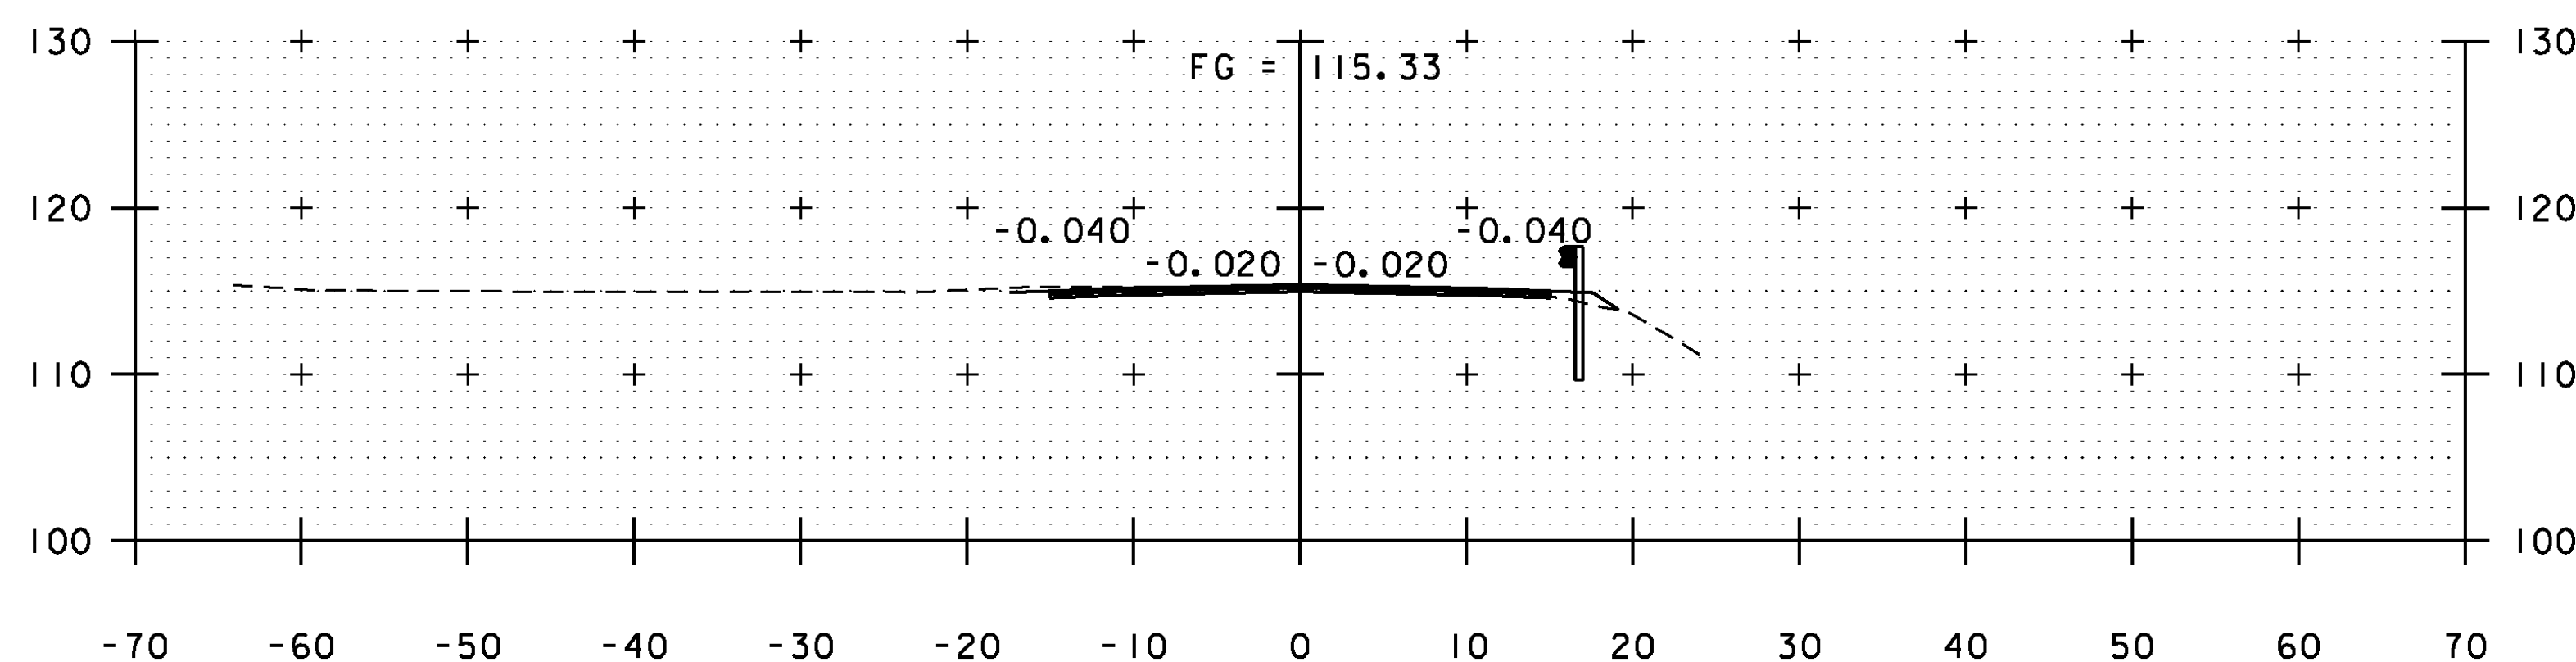


11+20

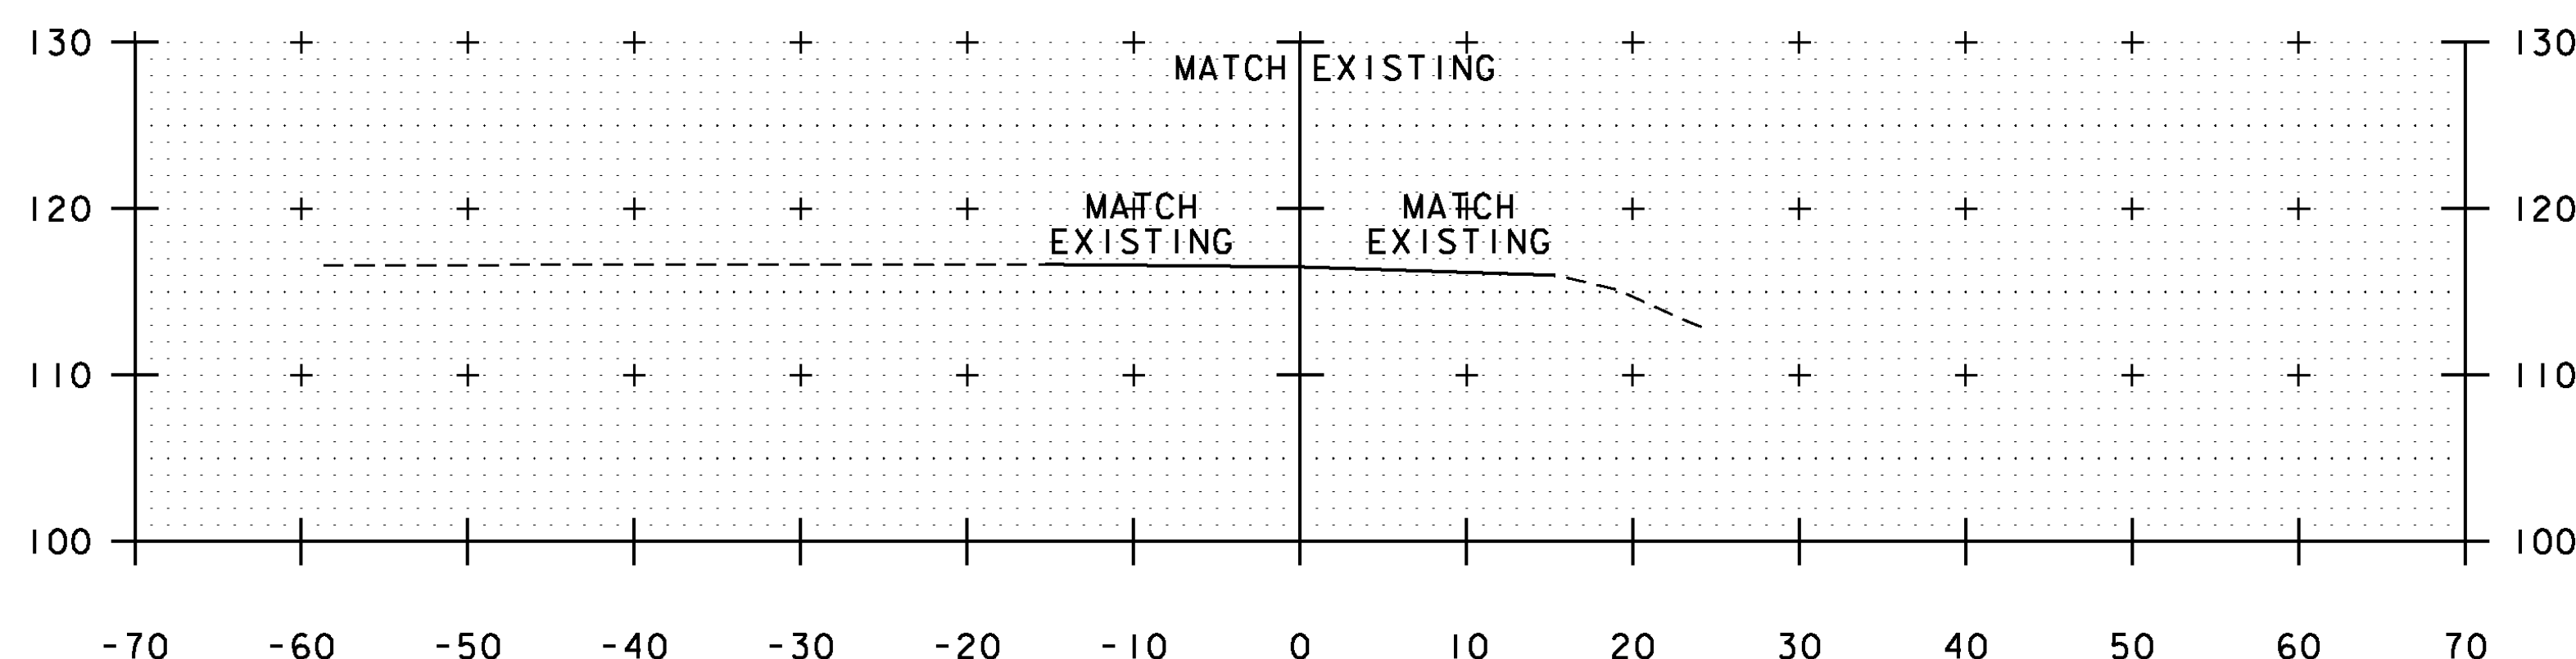


11+00

BEING APPROACH  
STA. 11+00.00

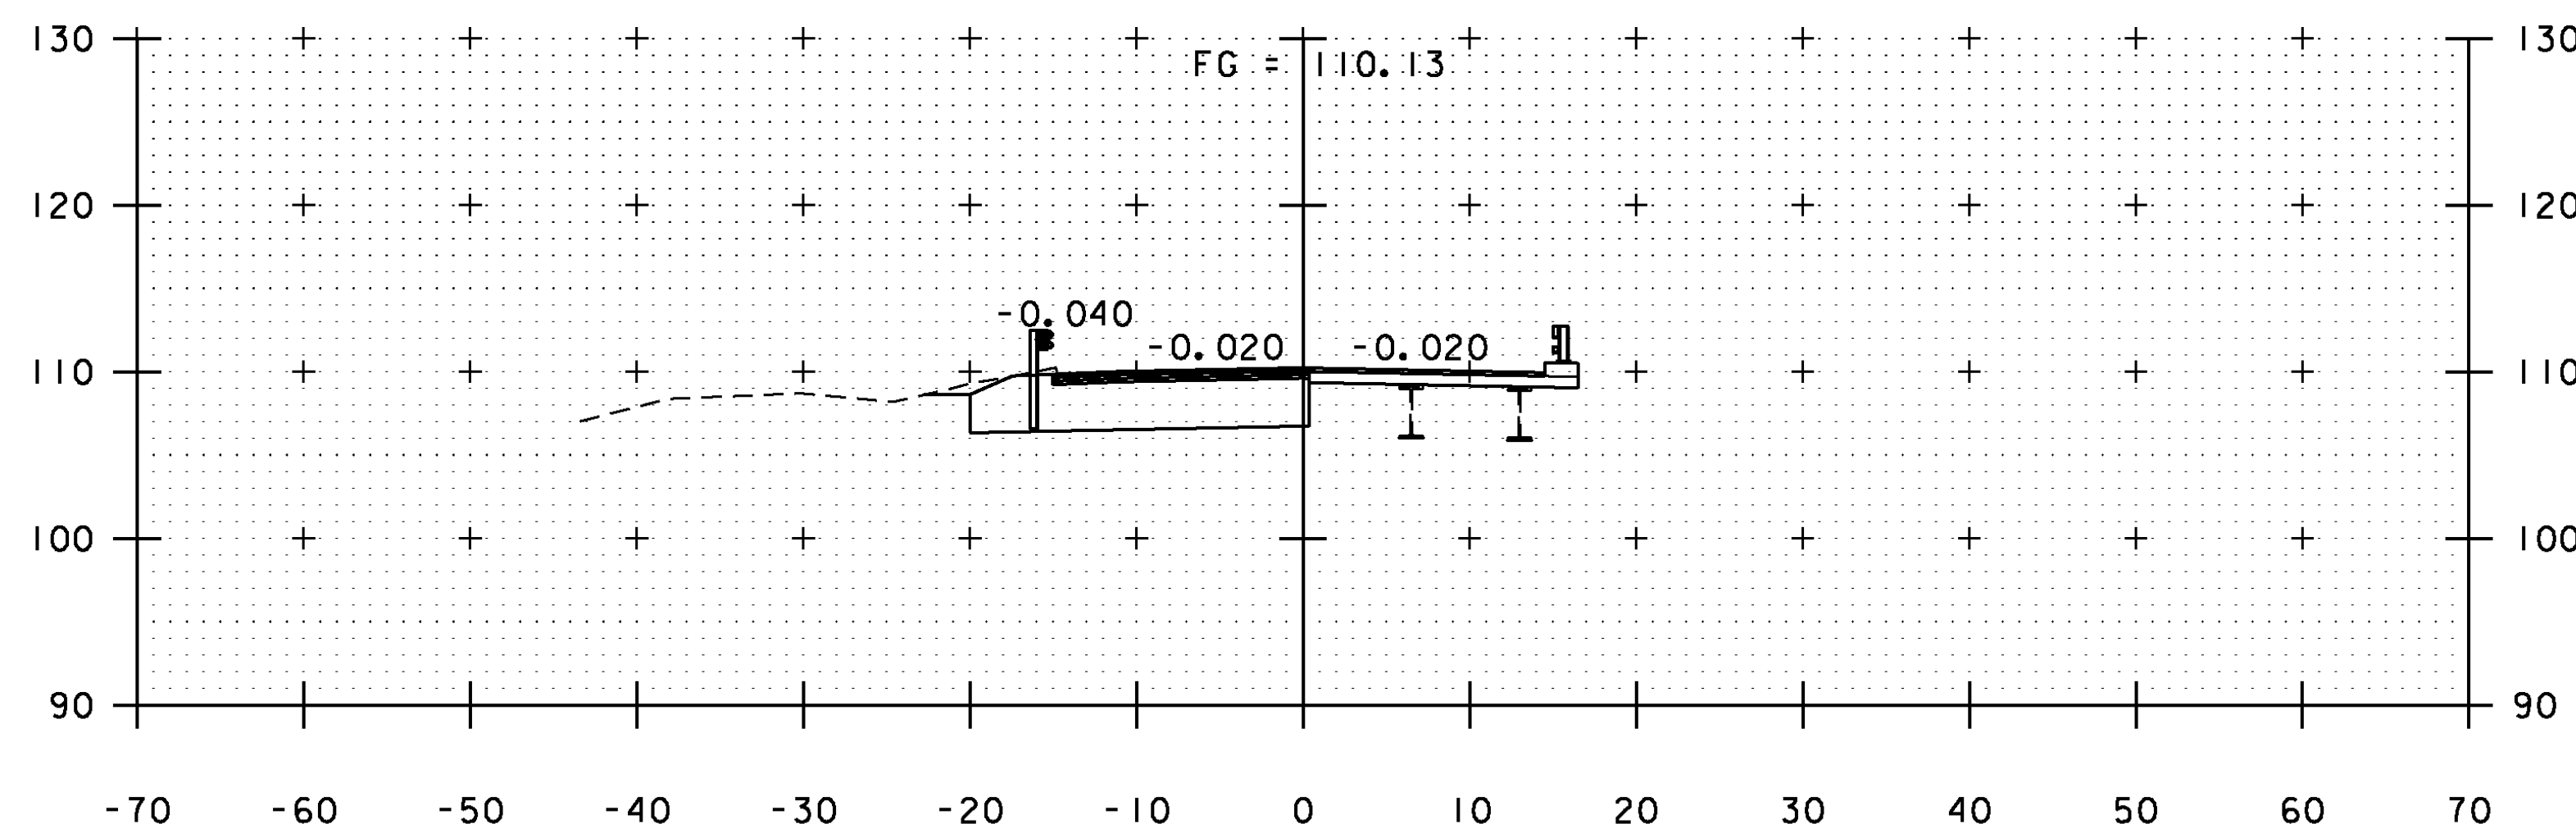


12+00

BEGIN BRIDGE  
STA. 12+00.34

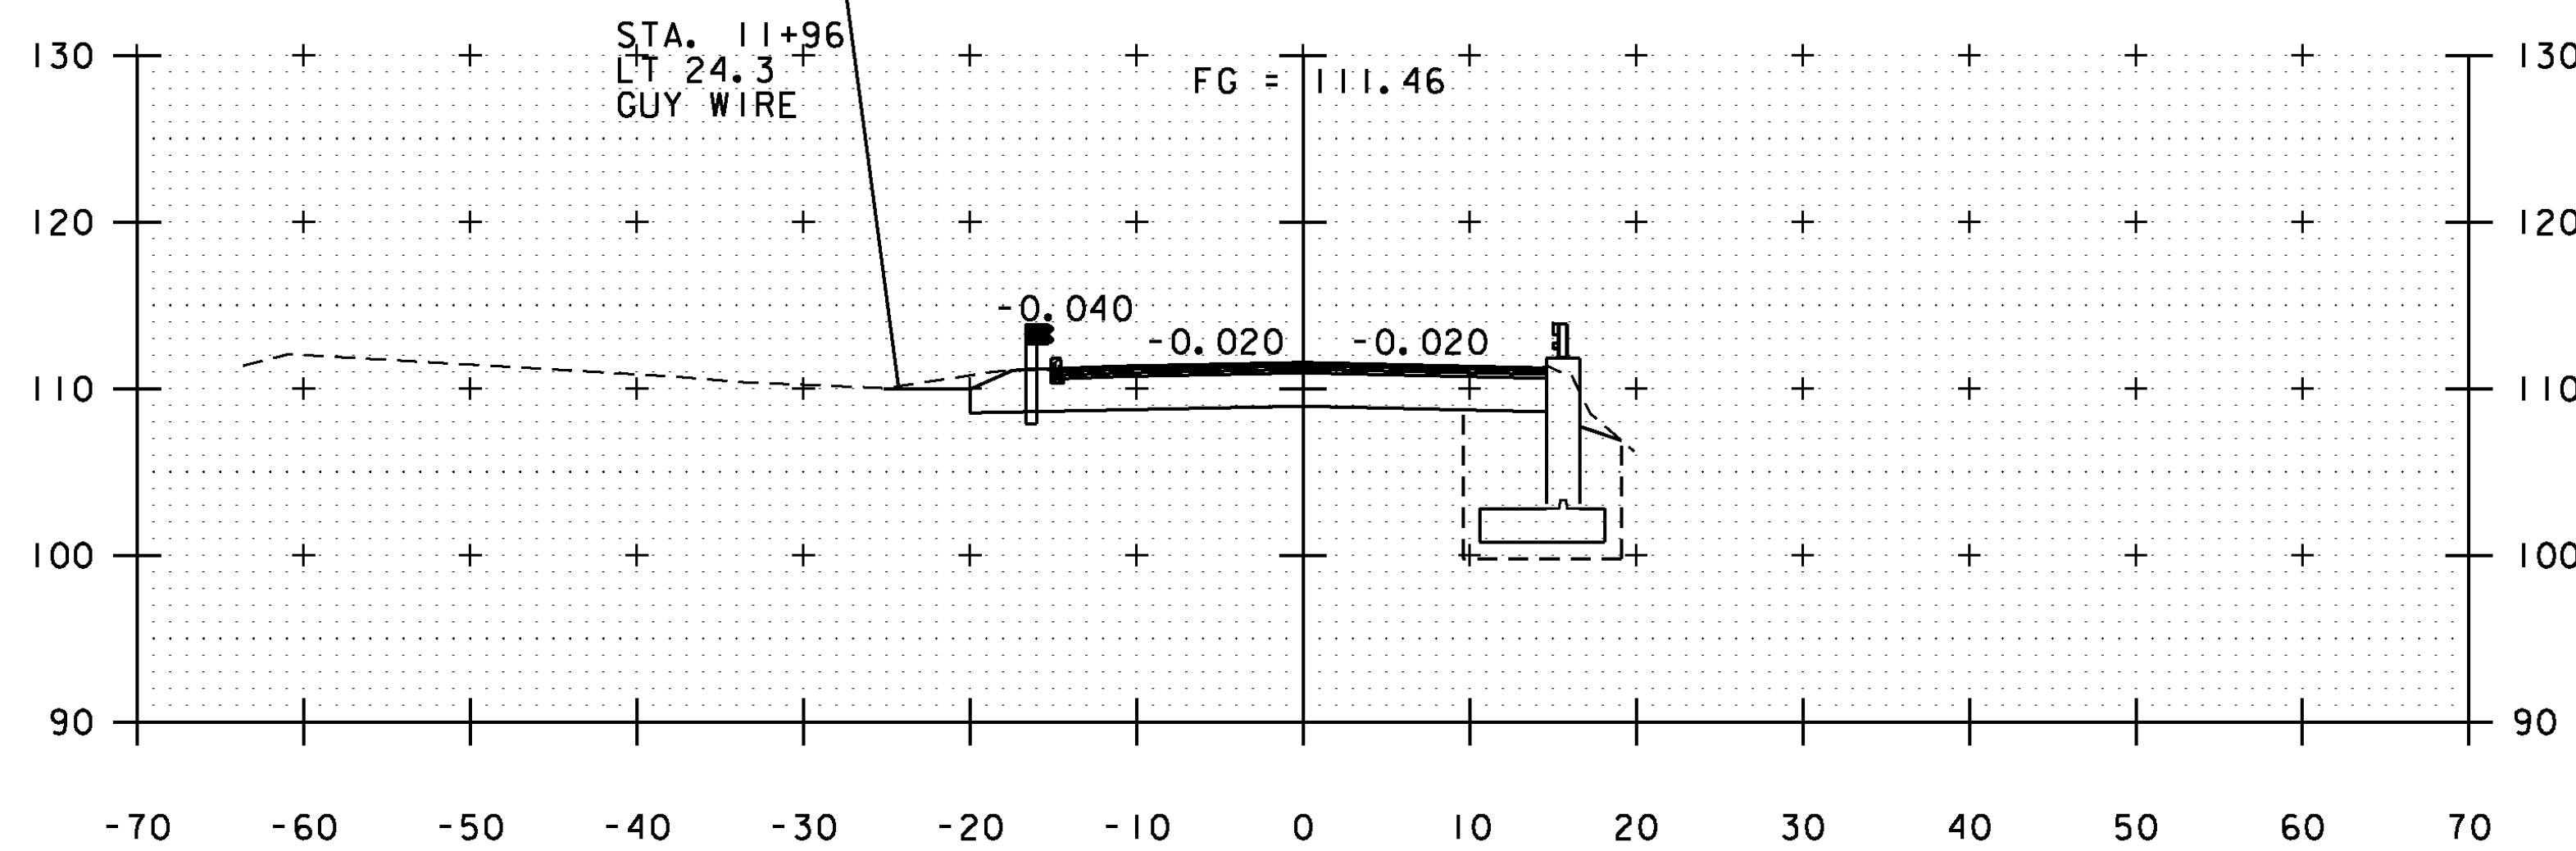


11+80

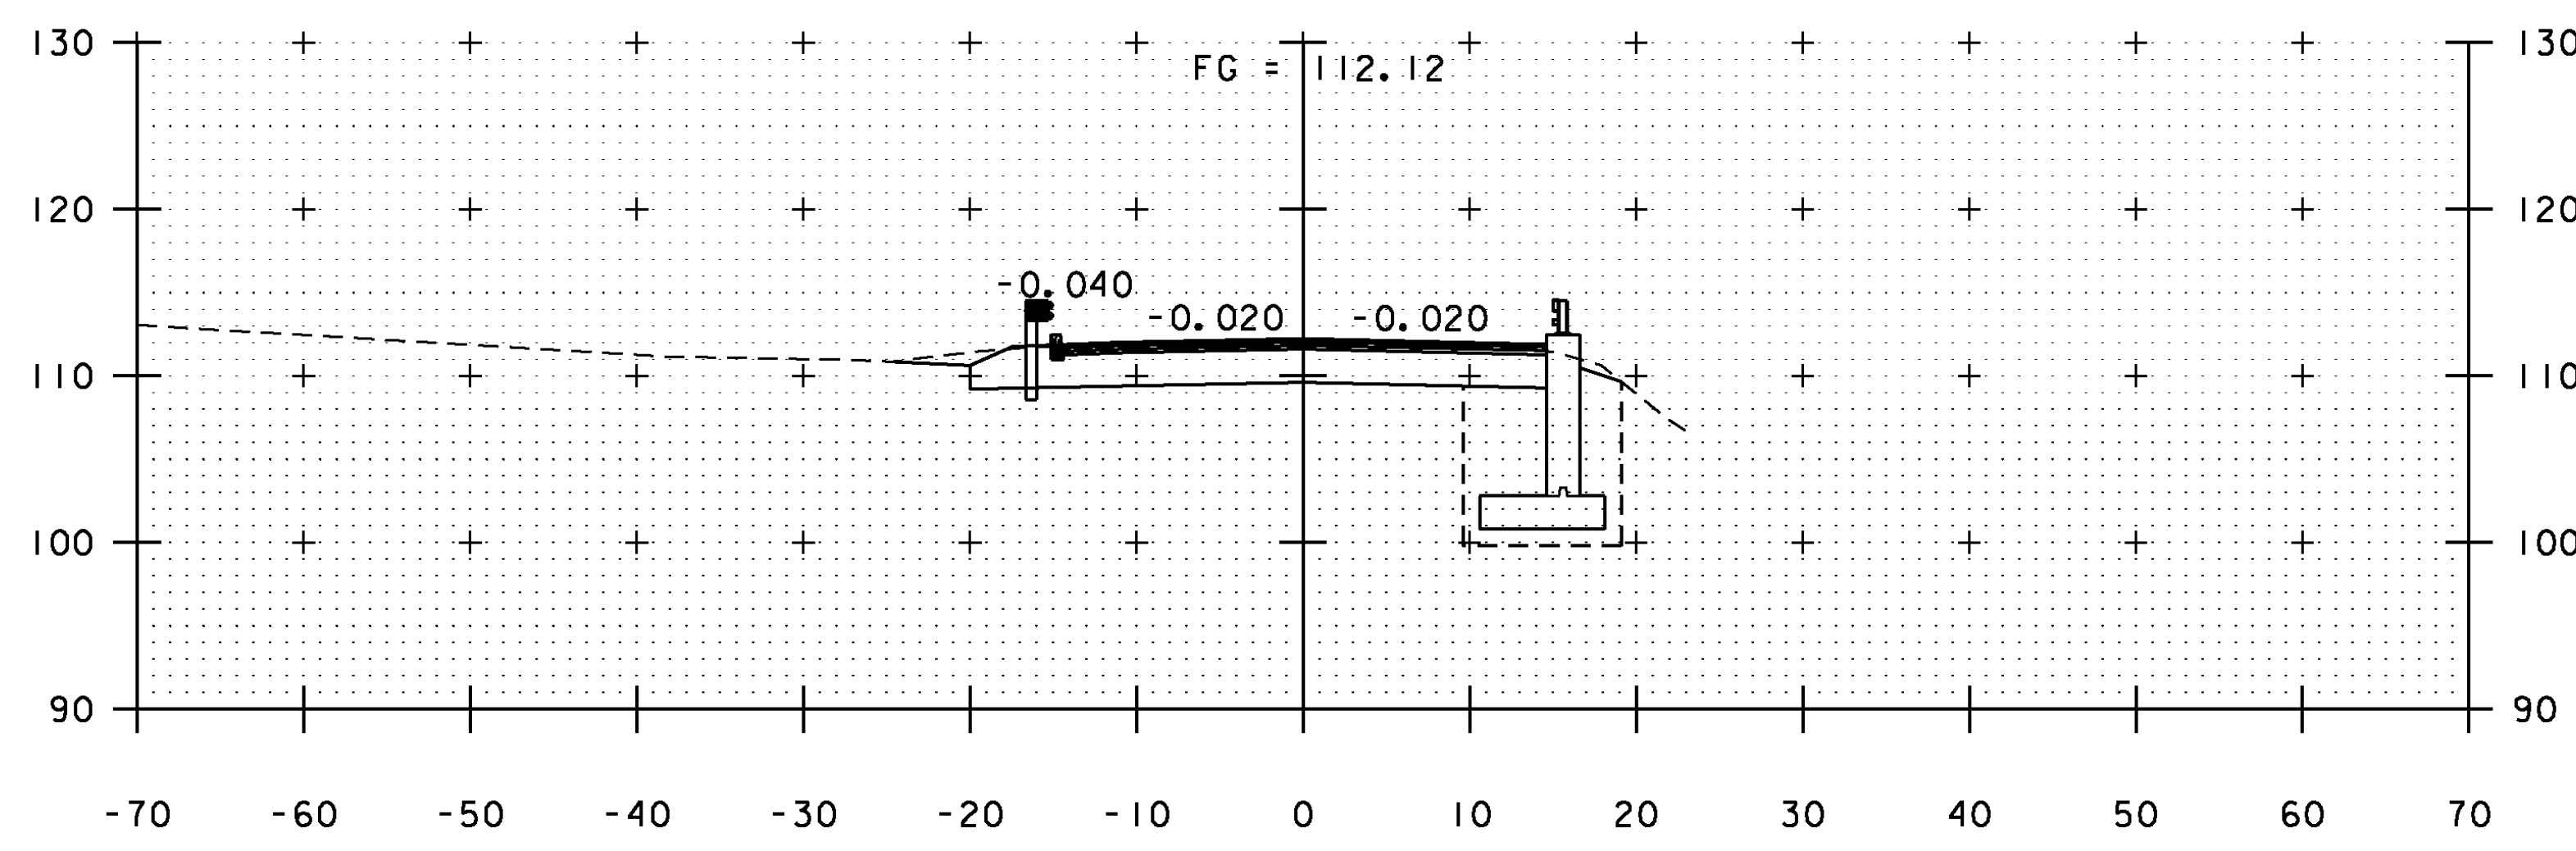


11+70


US RT 5 ROADWAY CROSS SECTIONS  
STA. 11+00 THRU STA. 12+00

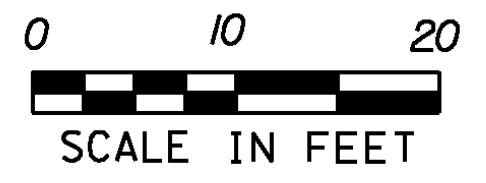

PROJECT NAME: HARTLAND	PLOT DATE: 12/17/2013
PROJECT NUMBER: BHF BPNT(12)	DRAWN BY: A.J. GOUDREAU
FILE NAME: zllc260xs.dgn	CHECKED BY: S.E. BURBANK
PROJECT LEADER: M.A. COLGAN	SHEET 37 OF 55
DESIGNED BY: S.G. FARNSWORTH	
BR 62A US 5 CROSS SECTIONS (10F 3)	

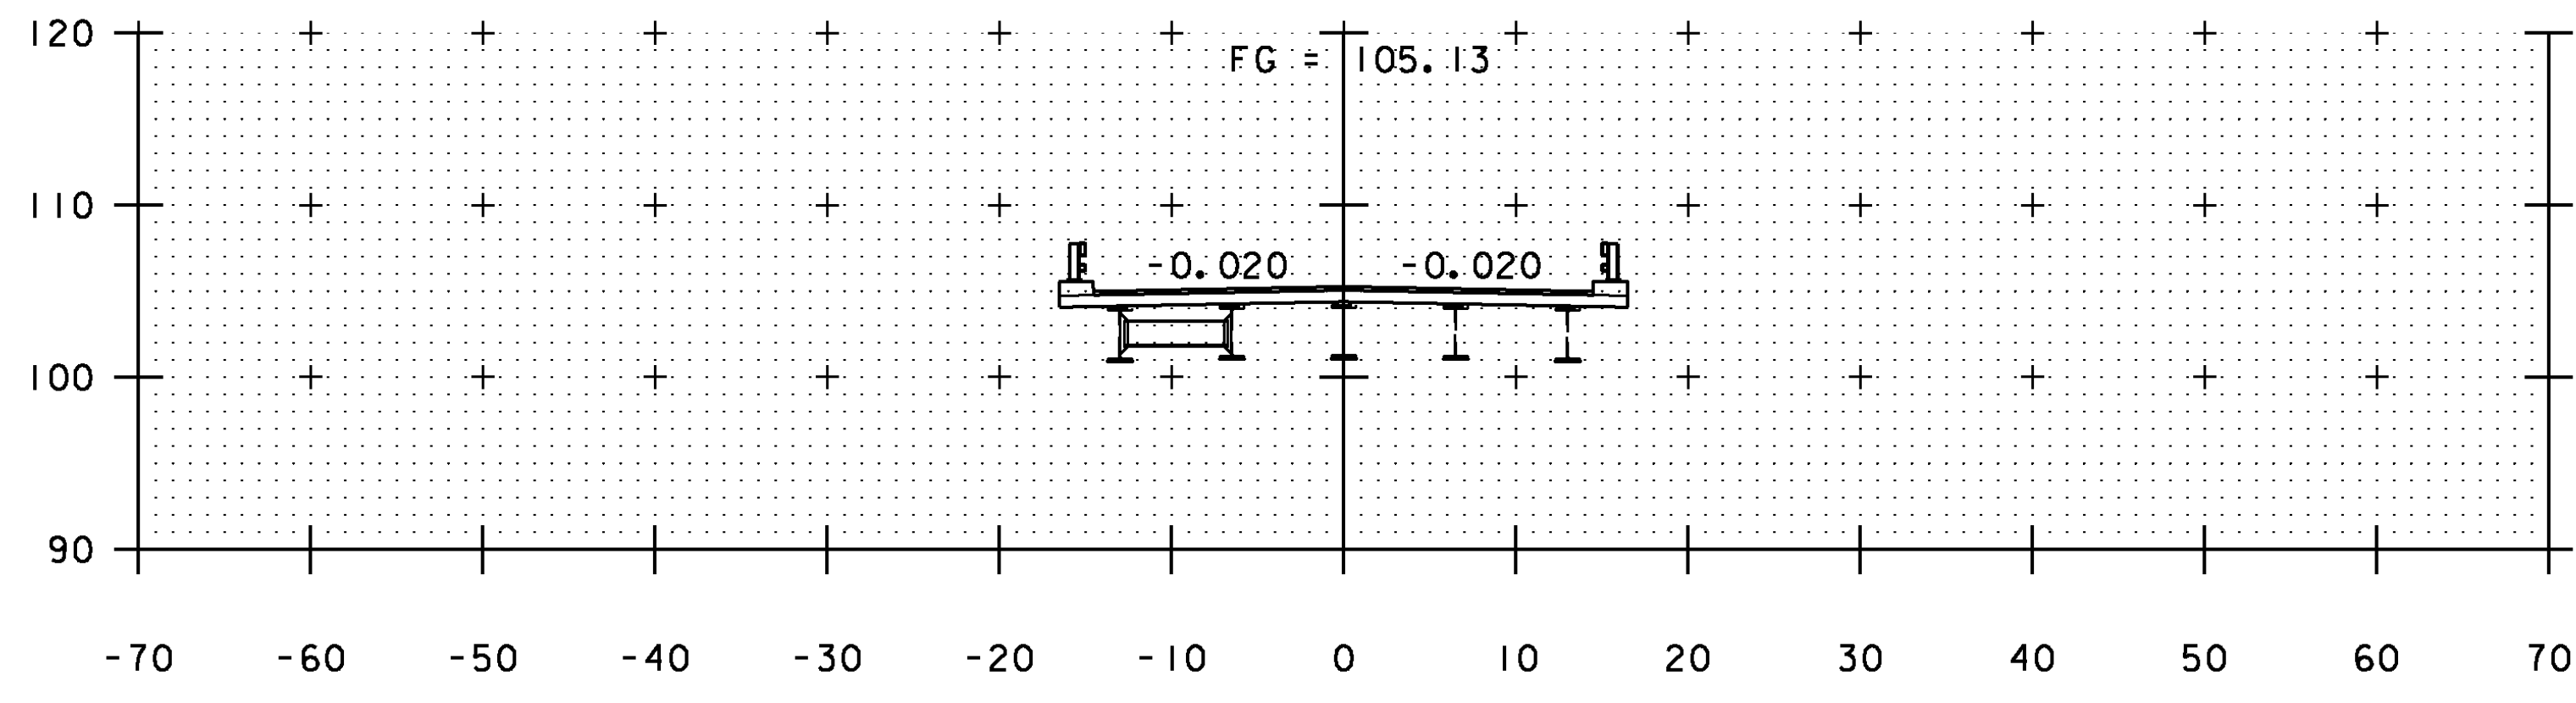


12+75

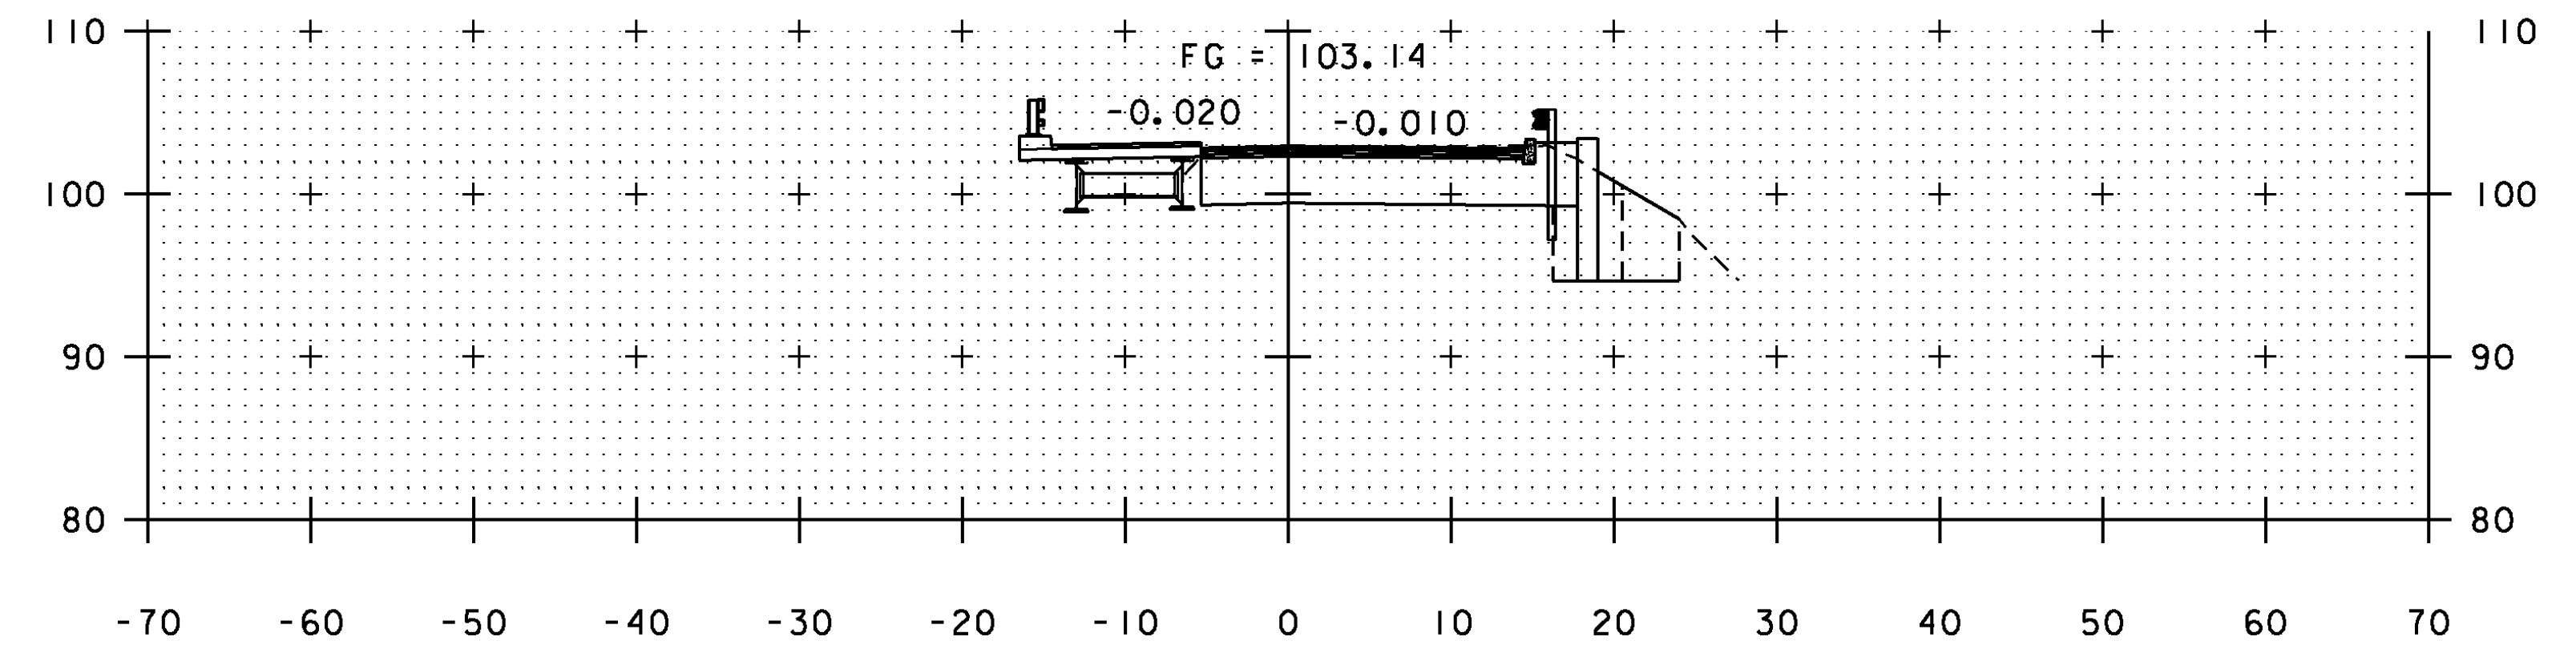


13+05


END BRIDGE  
STA. 12+99.66

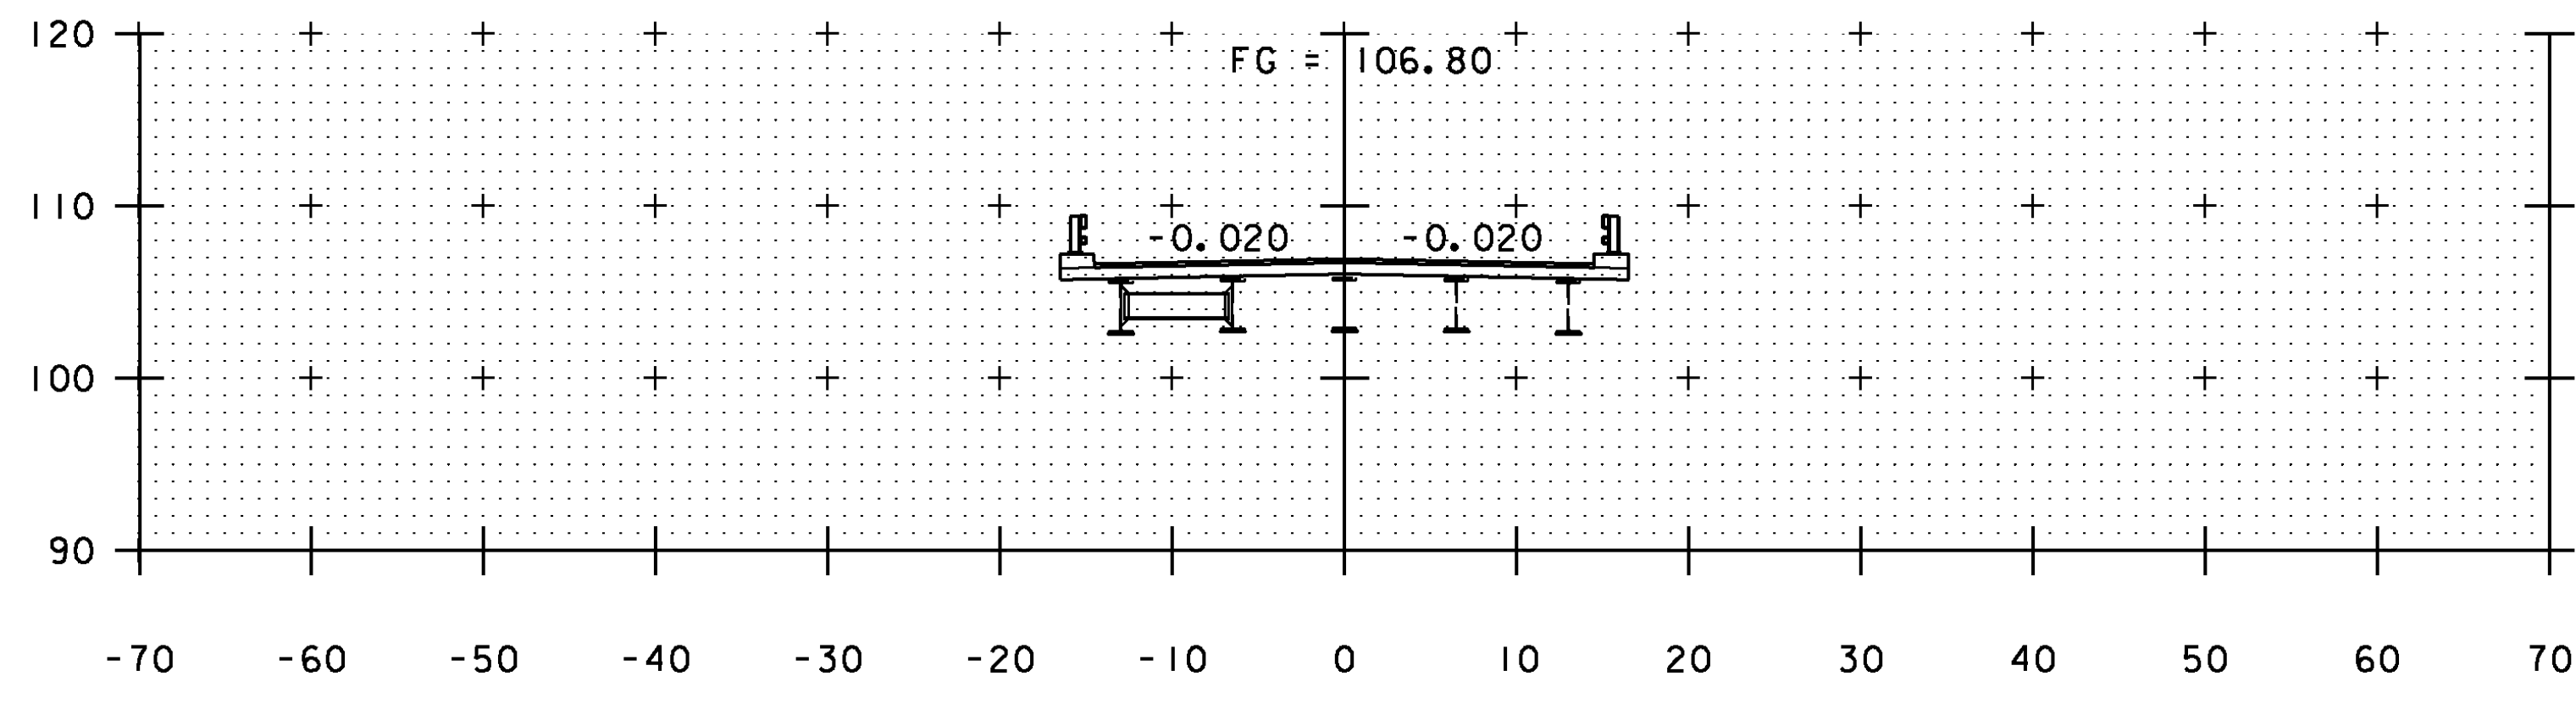


12+50

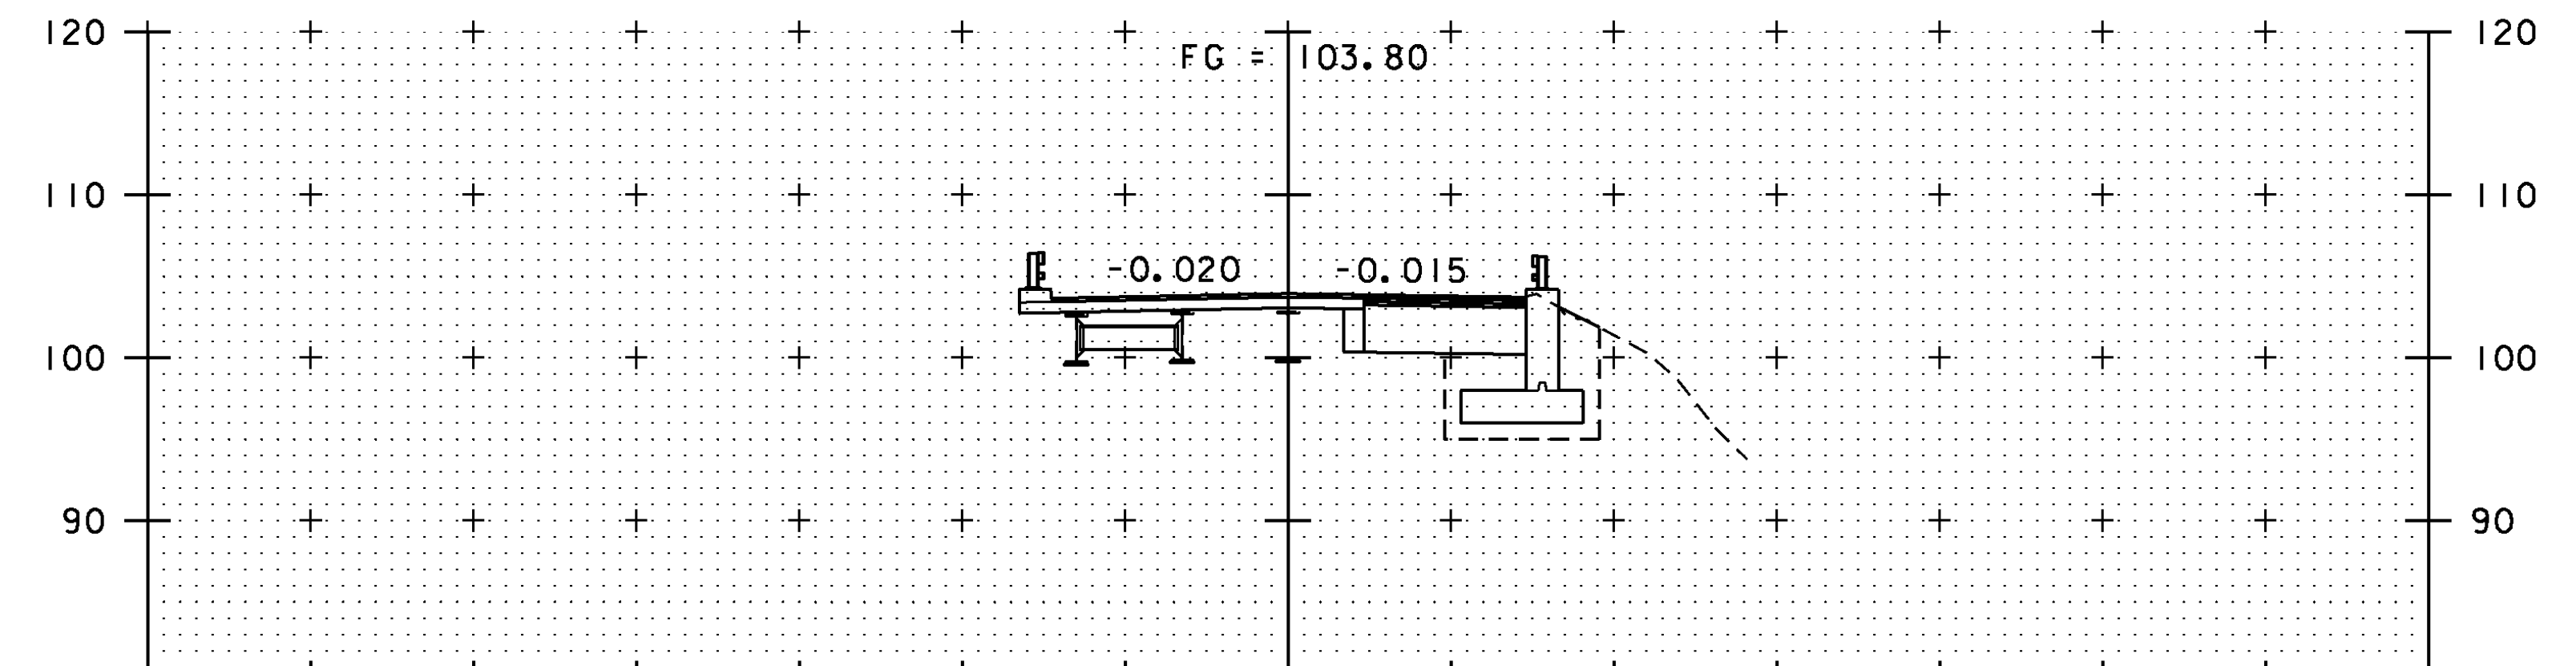


12+95

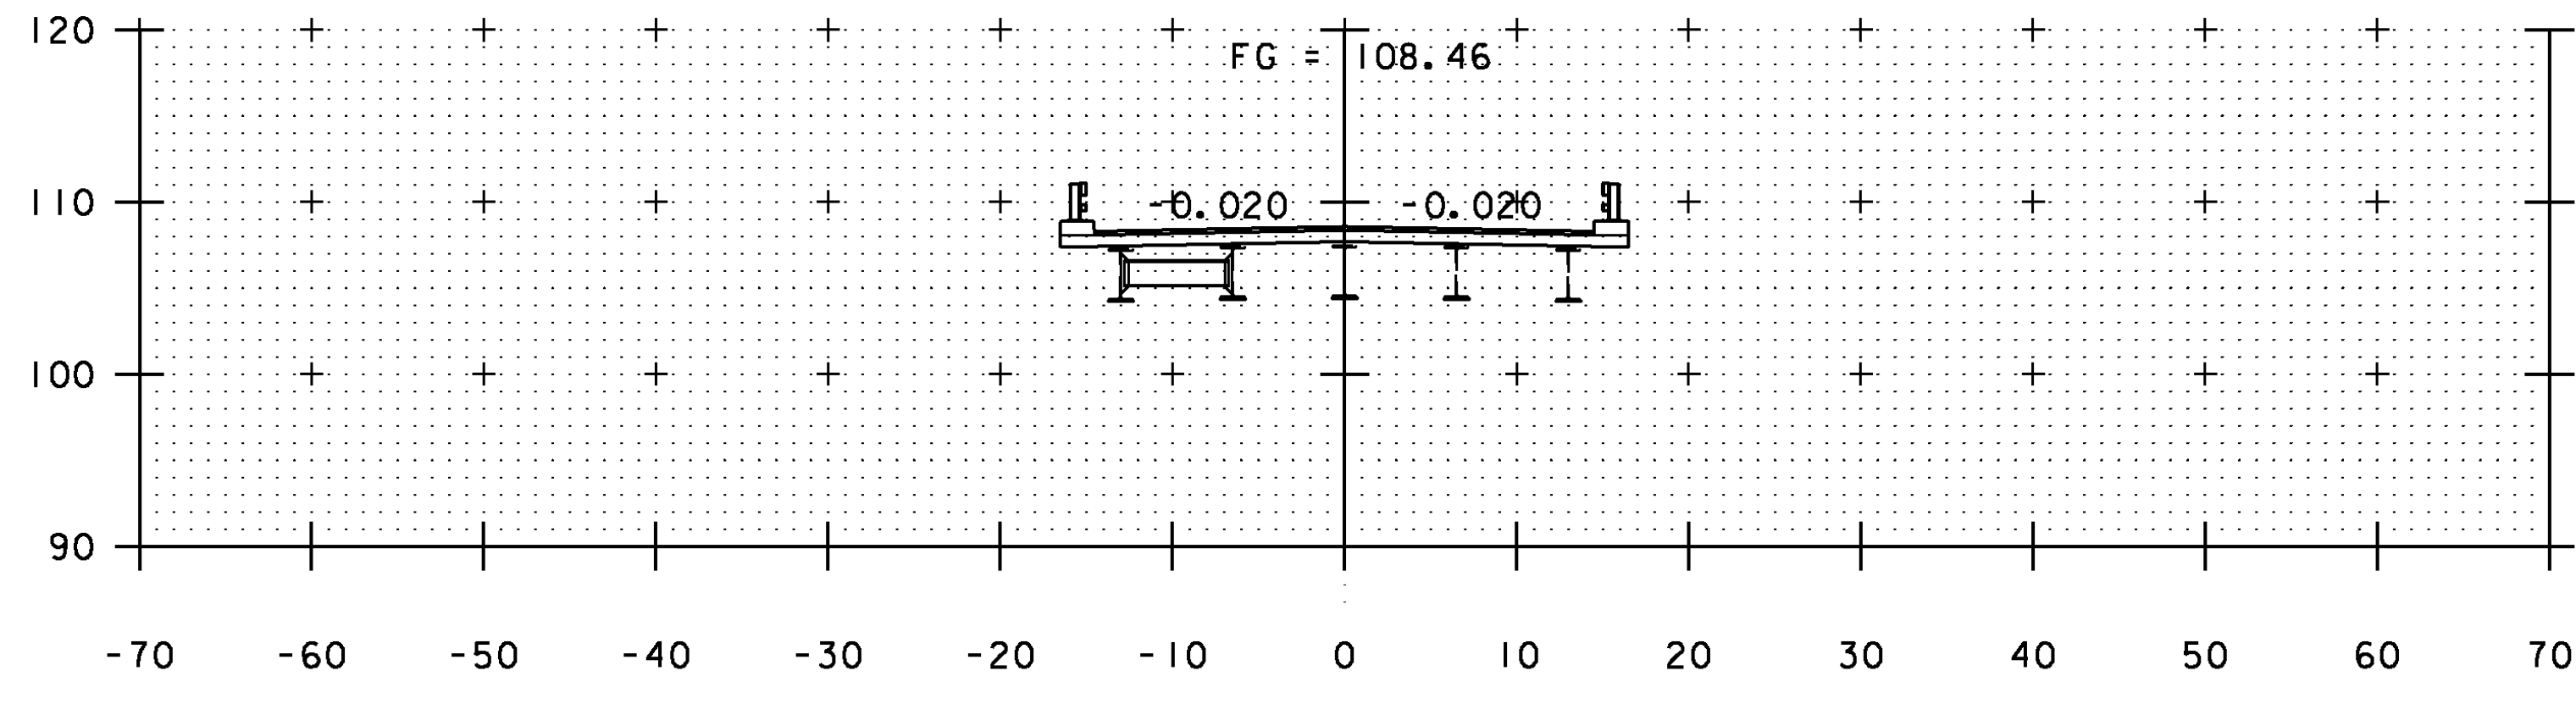

12+25

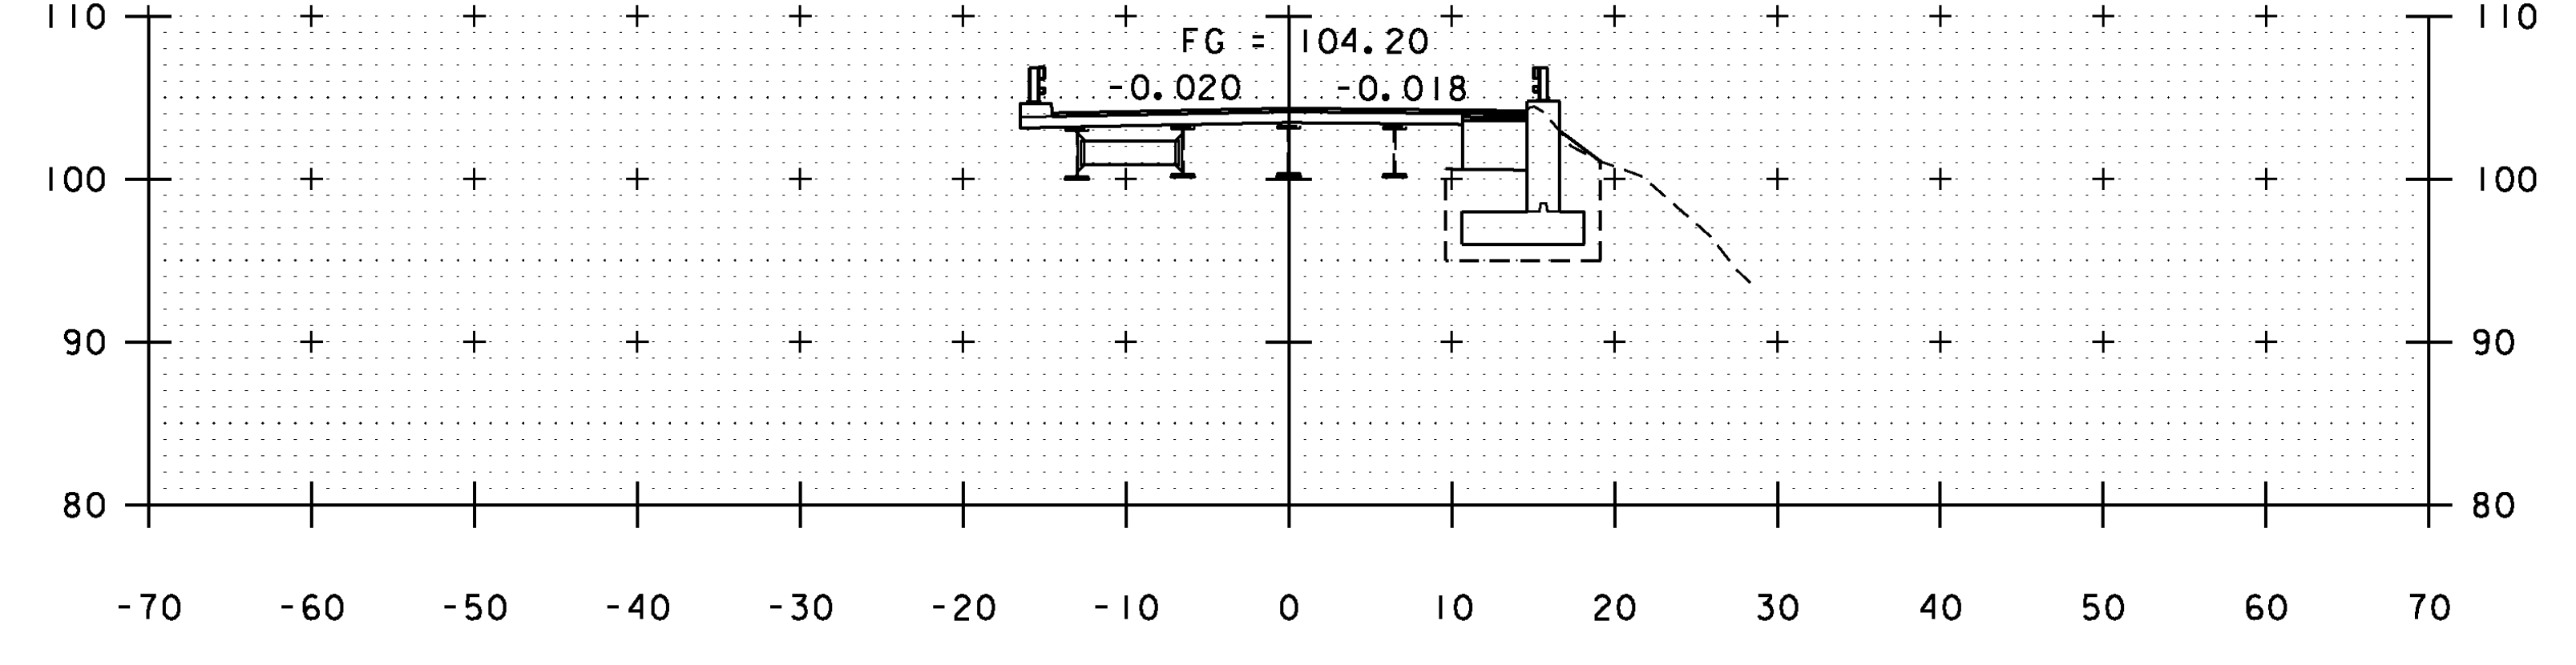


12+89

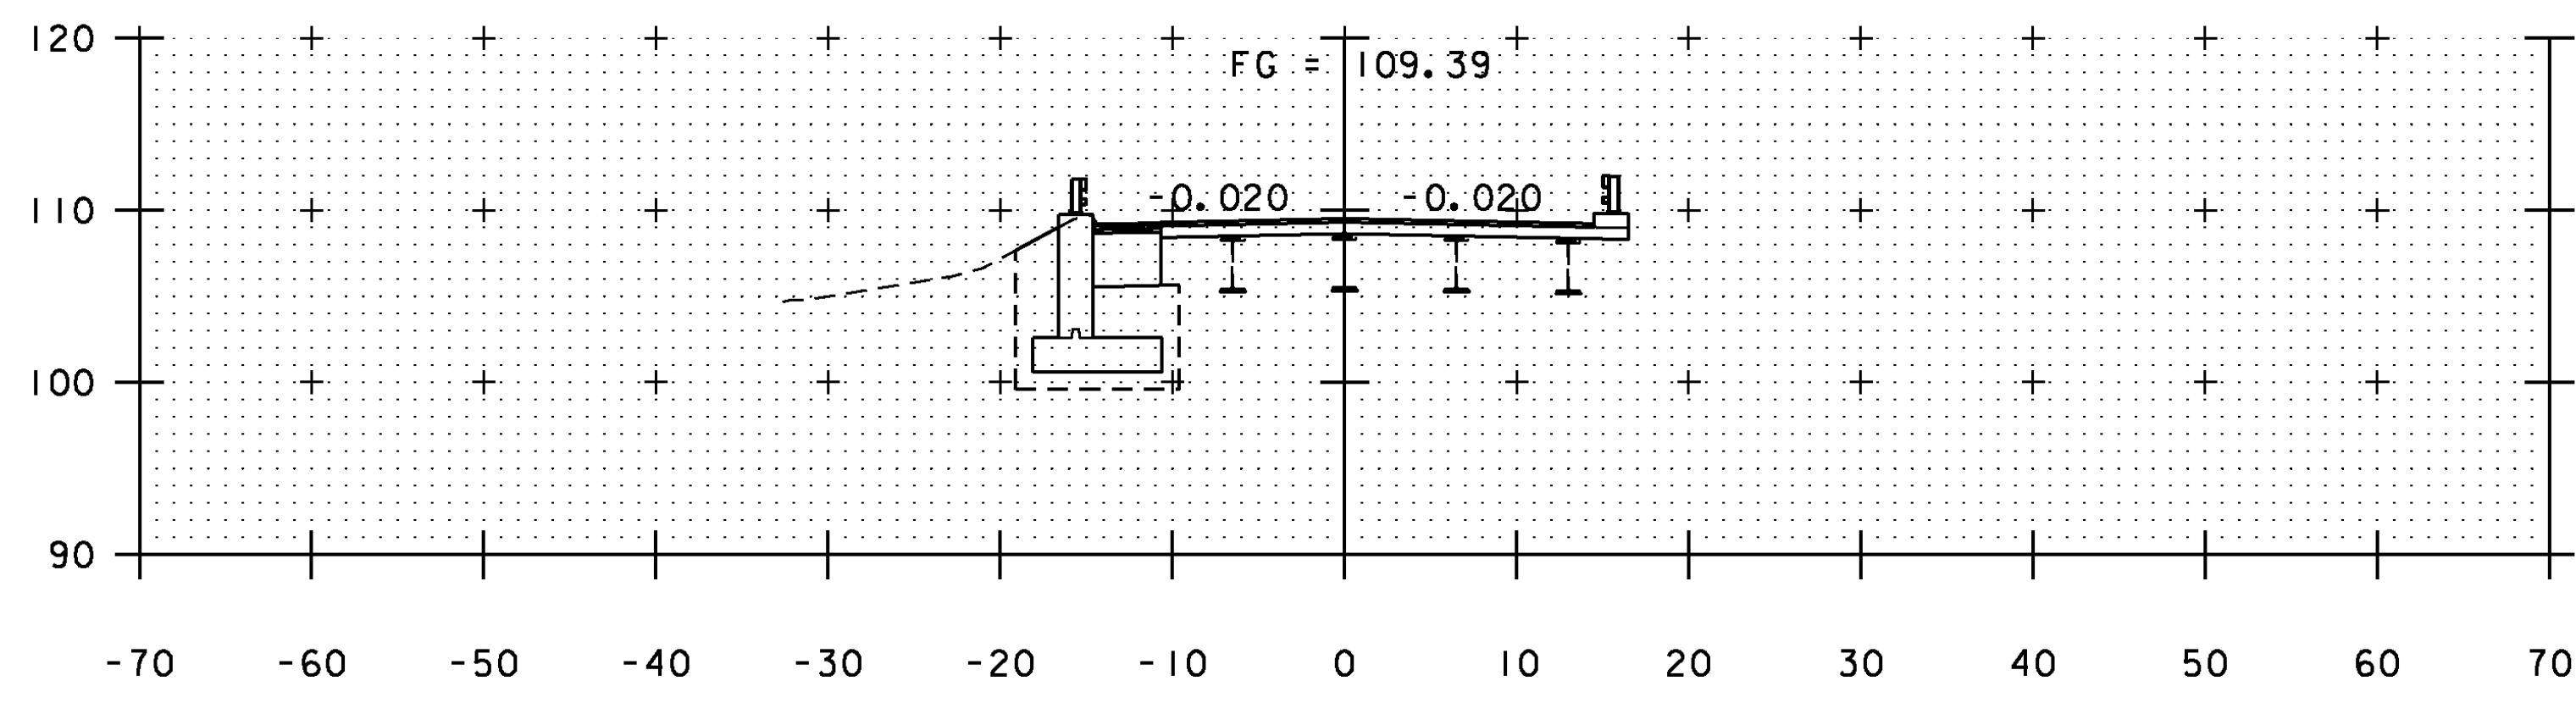


12+11


US RT 5 ROADWAY CROSS SECTIONS  
STA. 12+11 THRU STA. 13+05

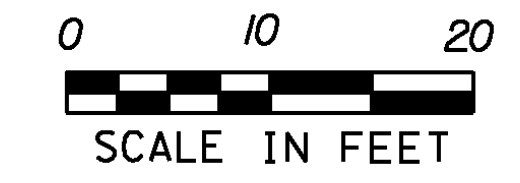

PROJECT NAME: HARTLAND	PLOT DATE: 12/17/2013
PROJECT NUMBER: BHF BPNT(12)	DRAWN BY: A.J. GOUDREAU
FILE NAME: zllc260xs.dgn	CHECKED BY: S.E. BURBANK
PROJECT LEADER: M.A. COLGAN	SHEET 38 OF 55
DESIGNED BY: S.G. FARNSWORTH	
BR 62A US 5 CROSS SECTIONS (2 OF 3)	

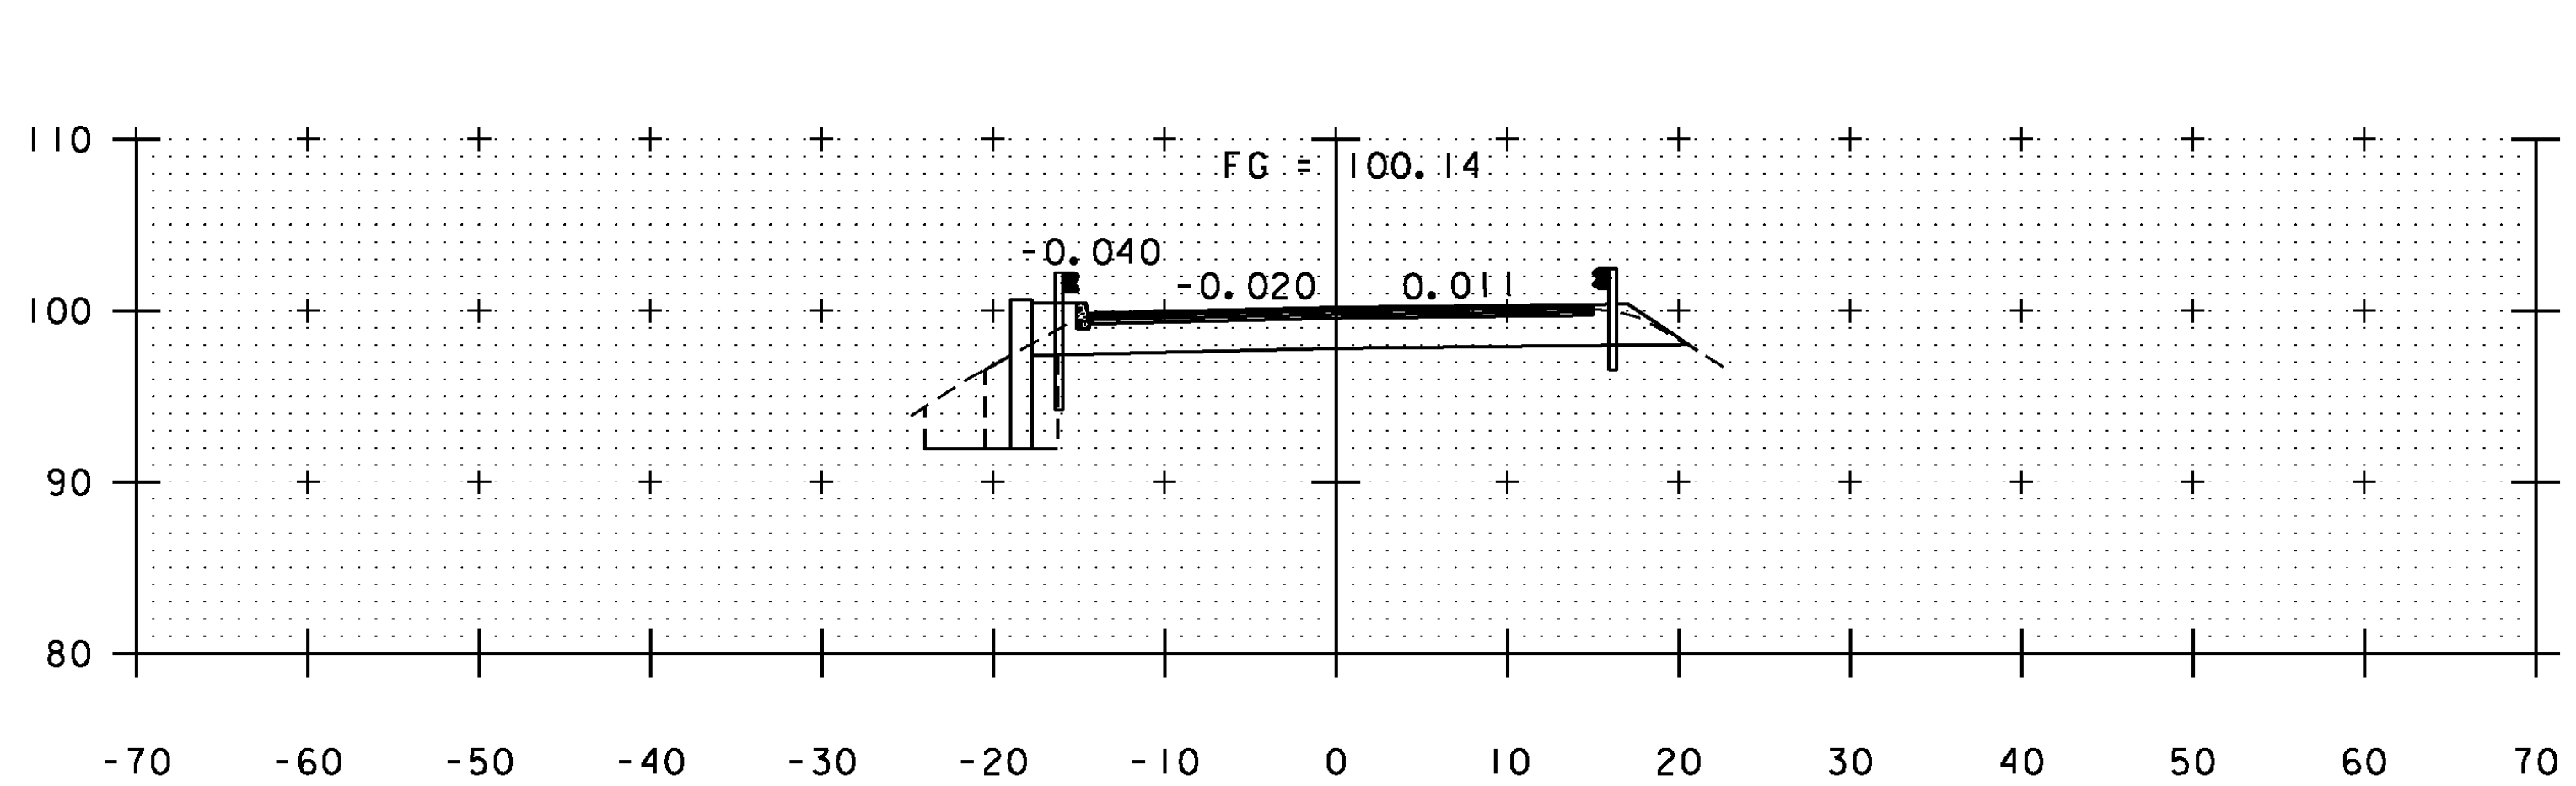


13+50

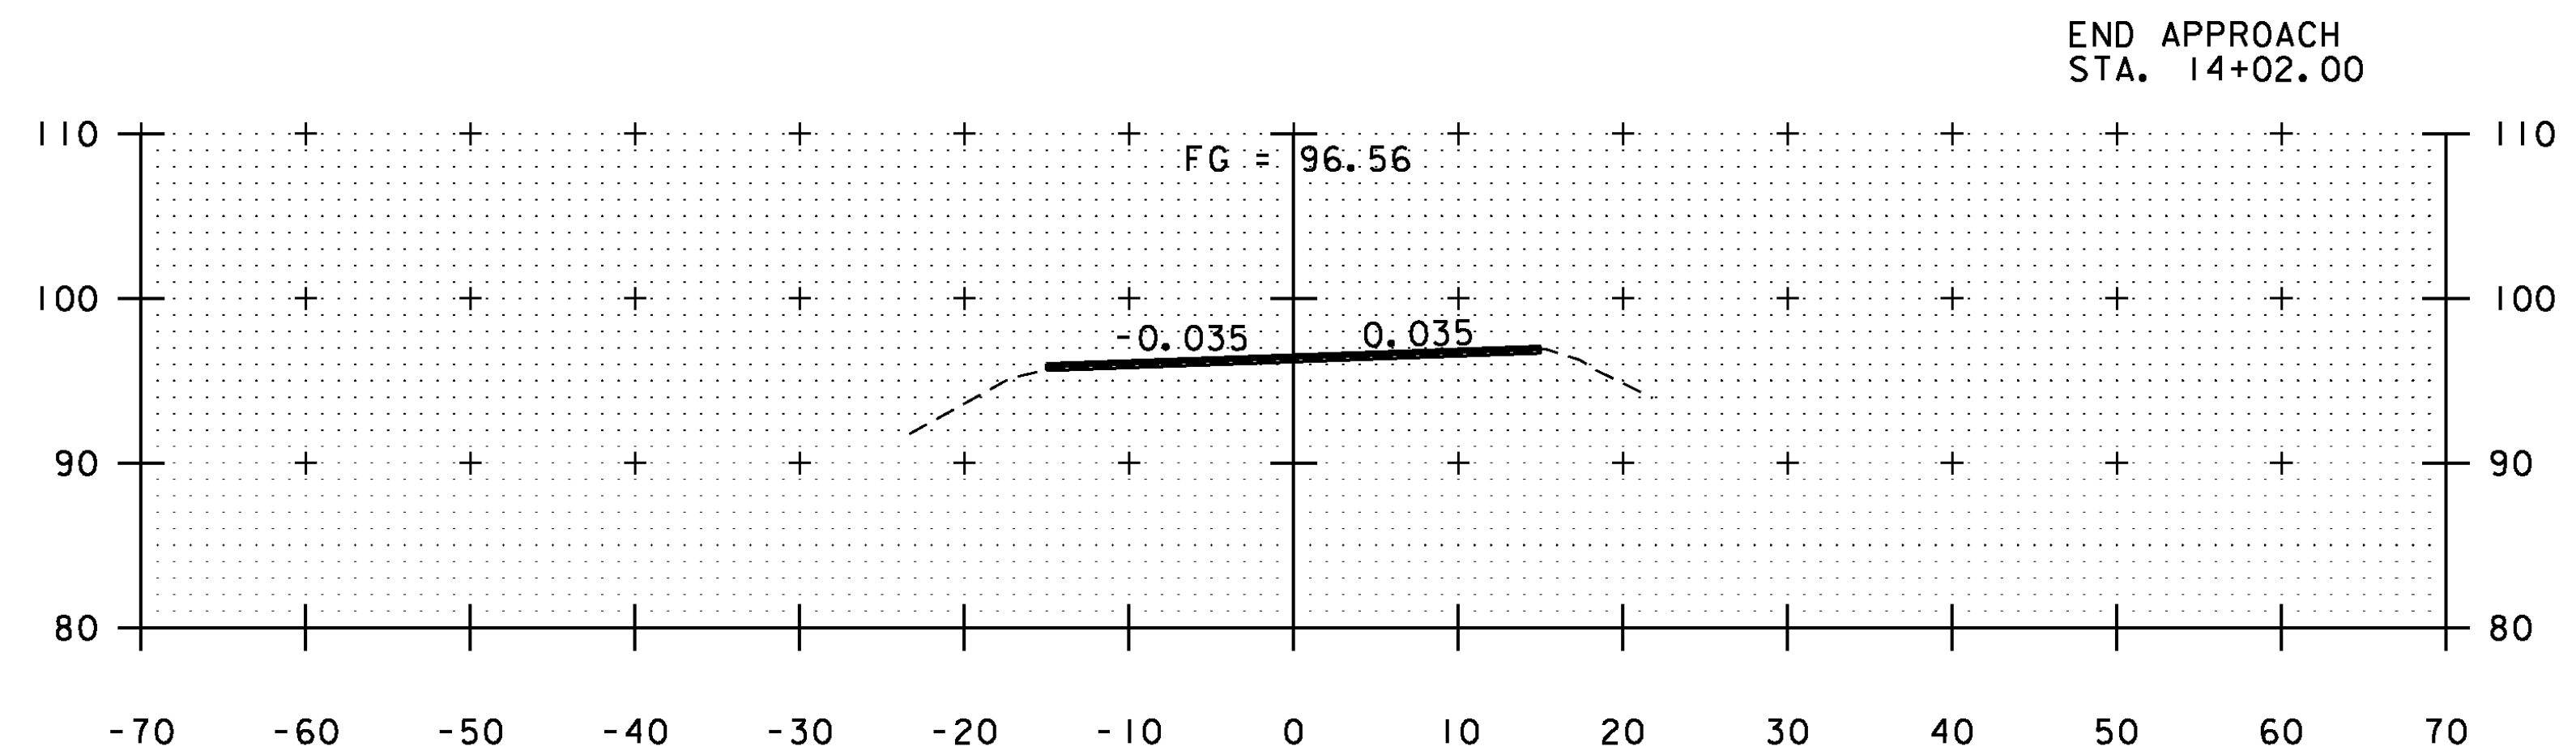


14+00

END APPROACH  
STA. 14+02.00

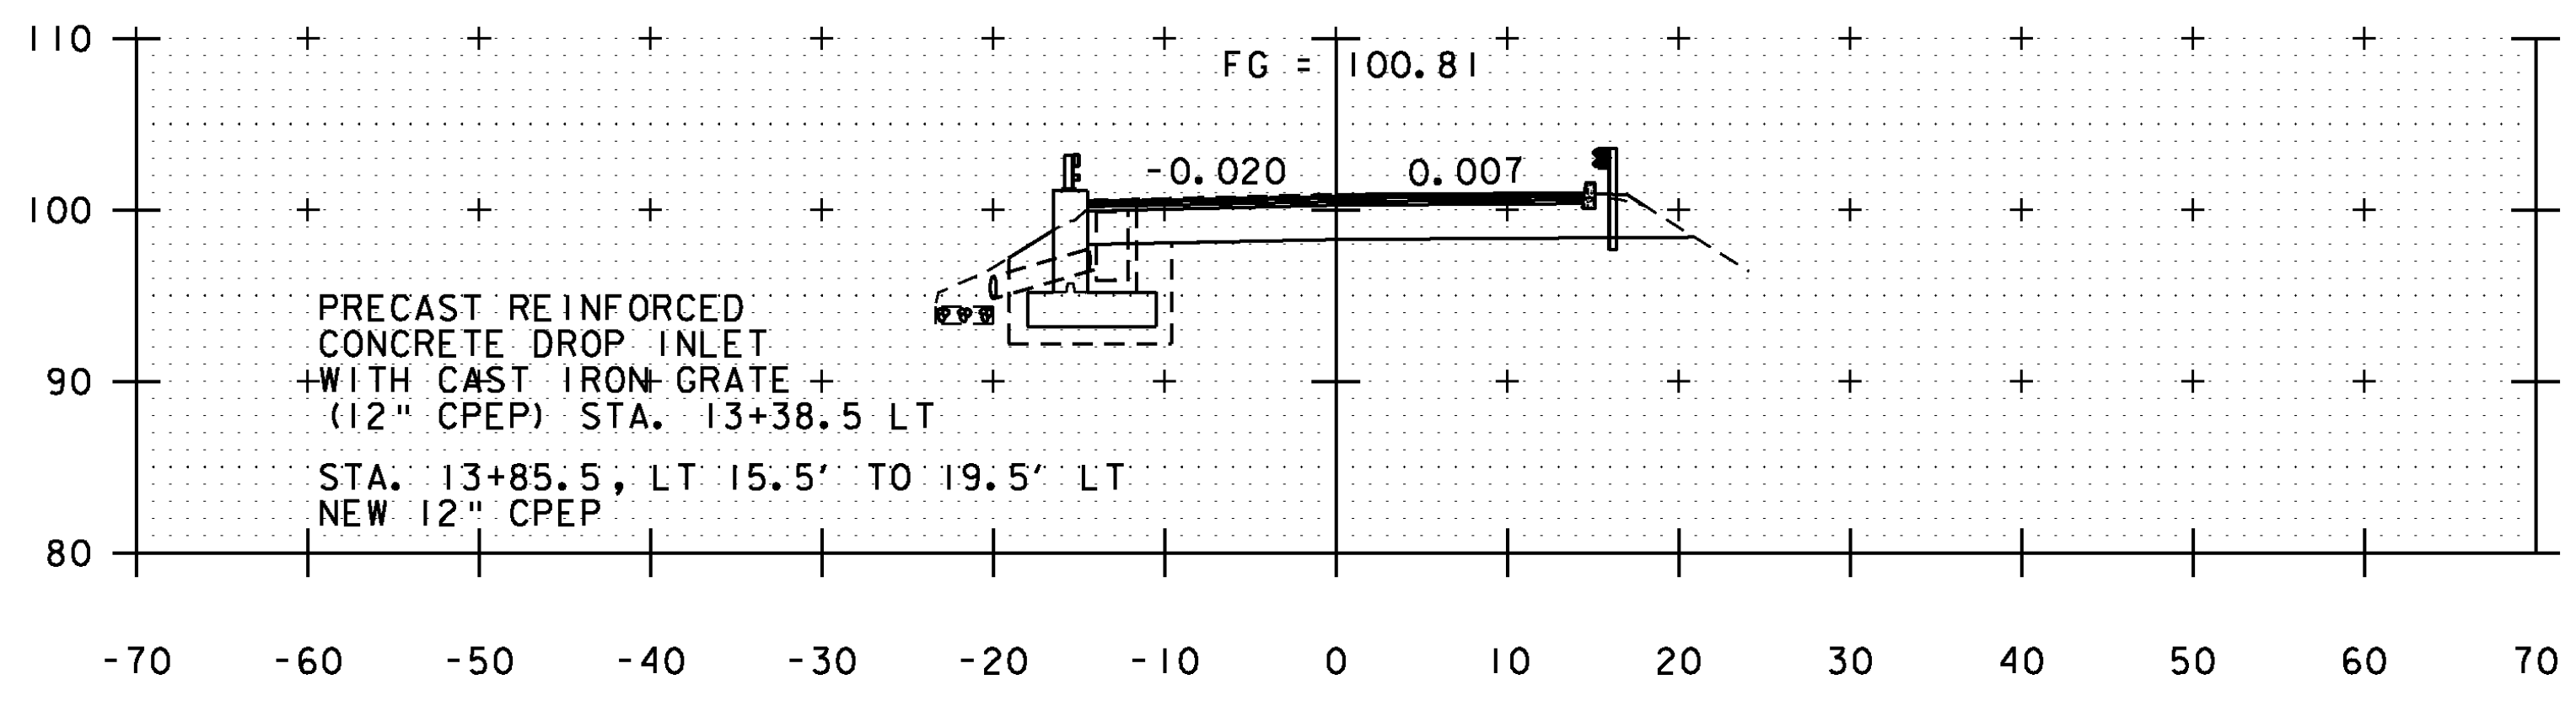


PRECAST REINFORCED  
CONCRETE DROP INLET  
WITH CAST IRON GRATE  
(12" CPEP) STA. 13+38.5 LT  
STA. 13+85.5, LT 15.5' TO 19.5' LT  
NEW 12" CPEP

13+40

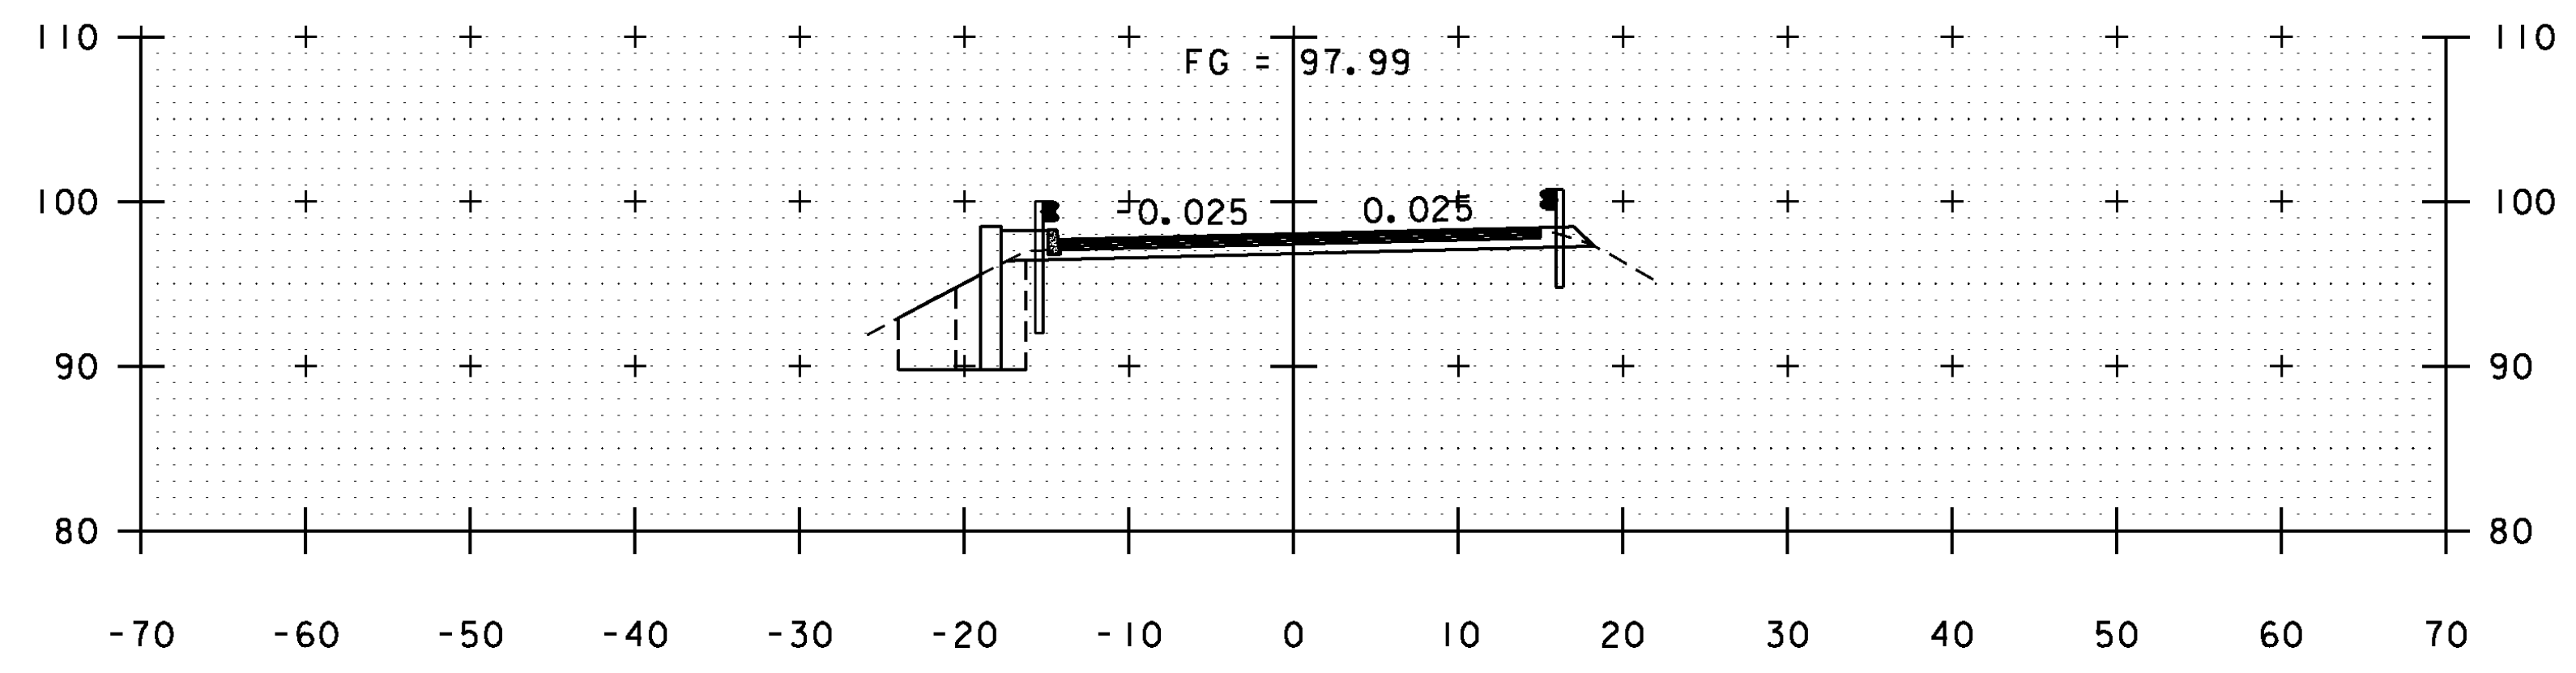


13+80


END PROJECT  
STA. 13+82.00

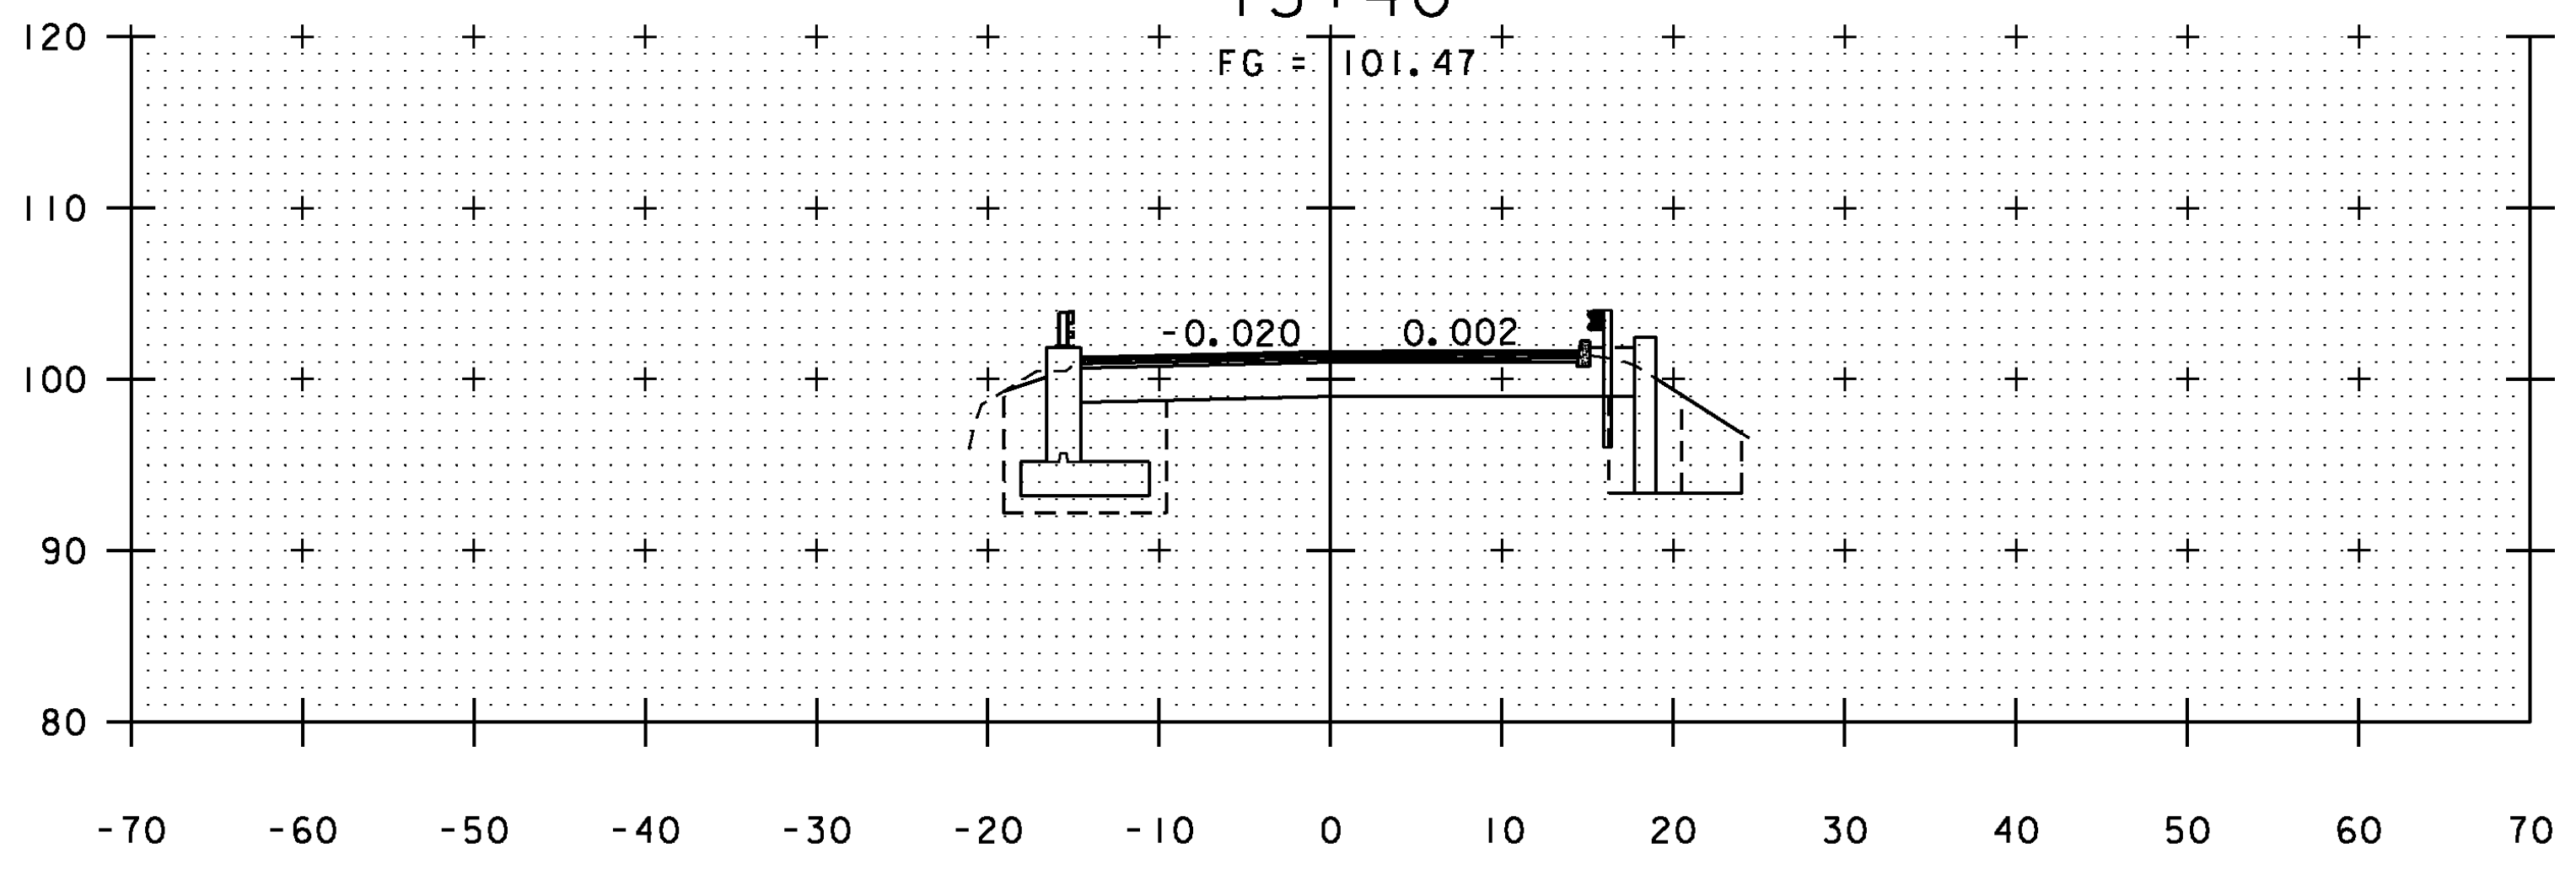

13+30

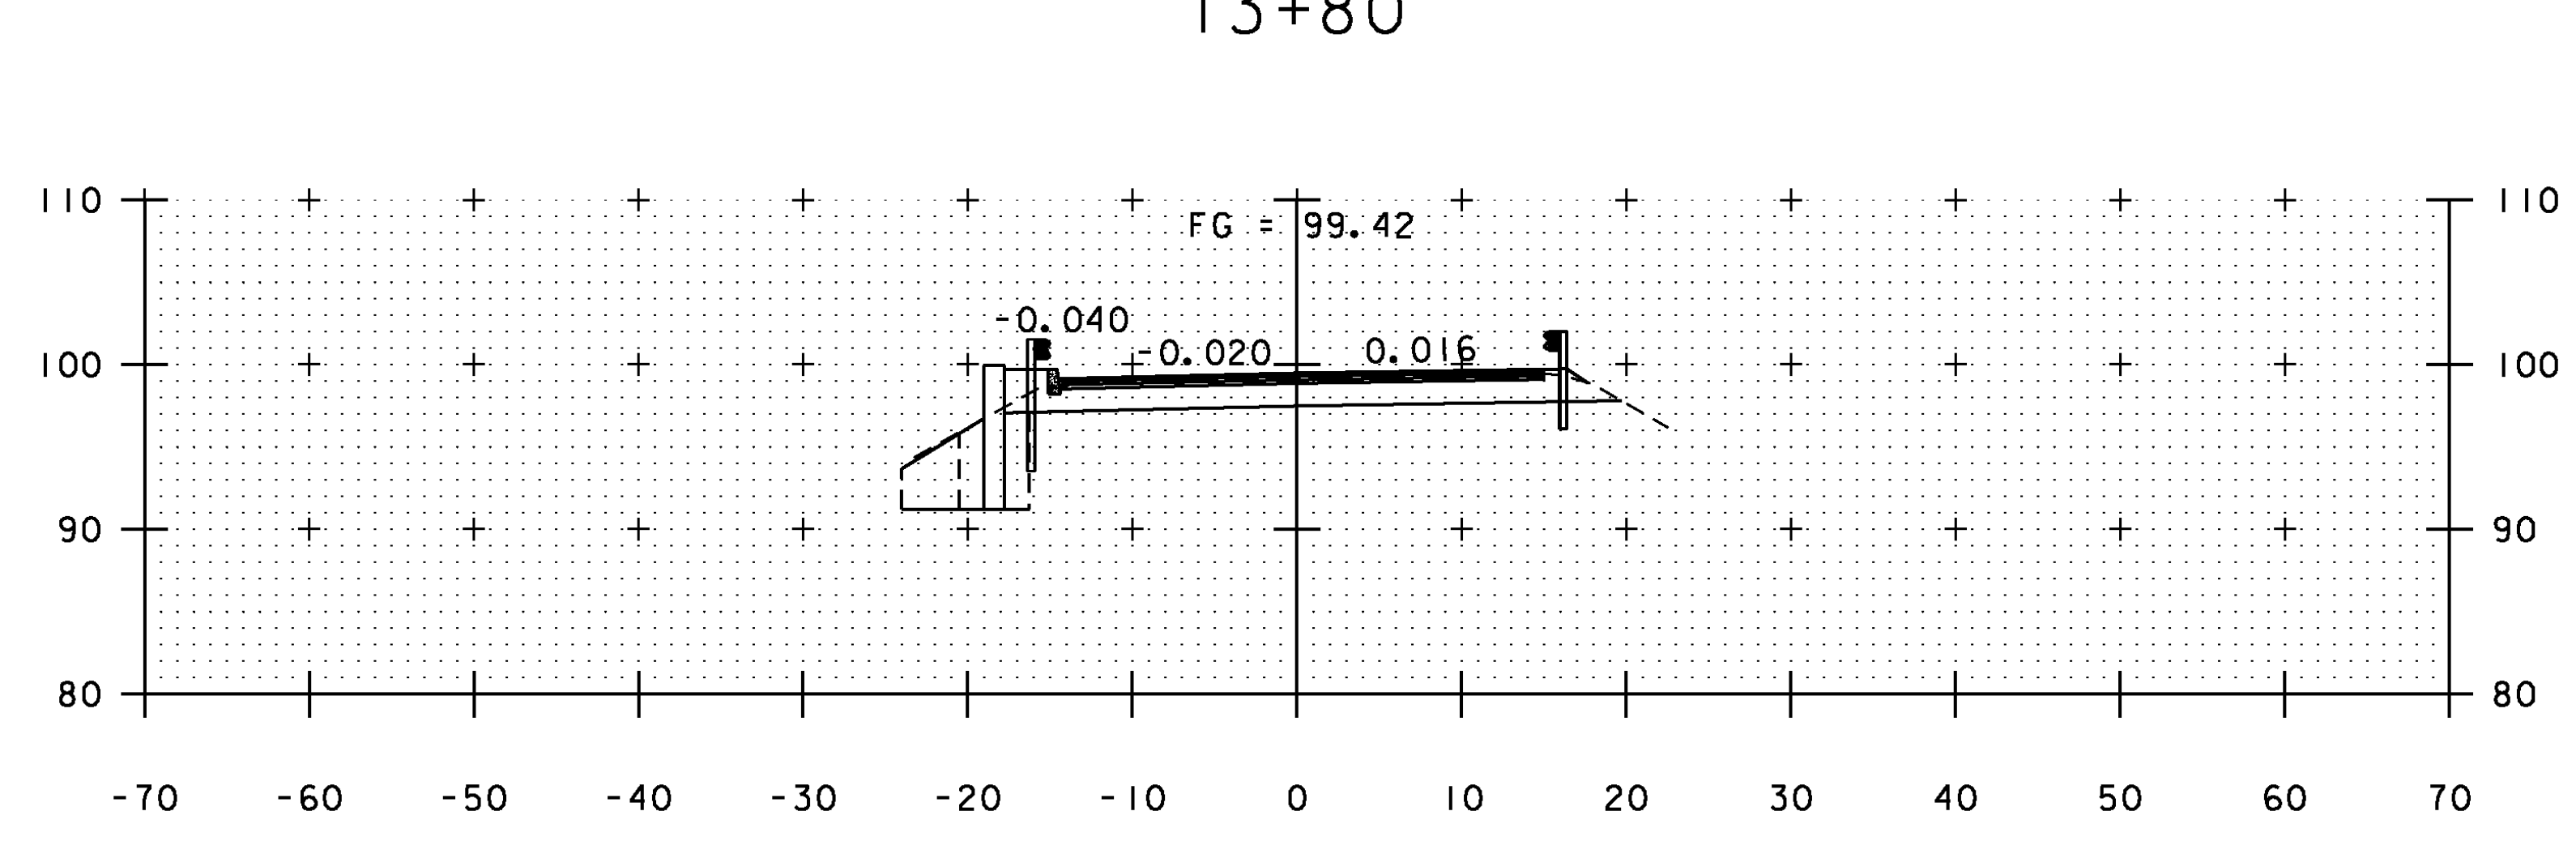


13+60

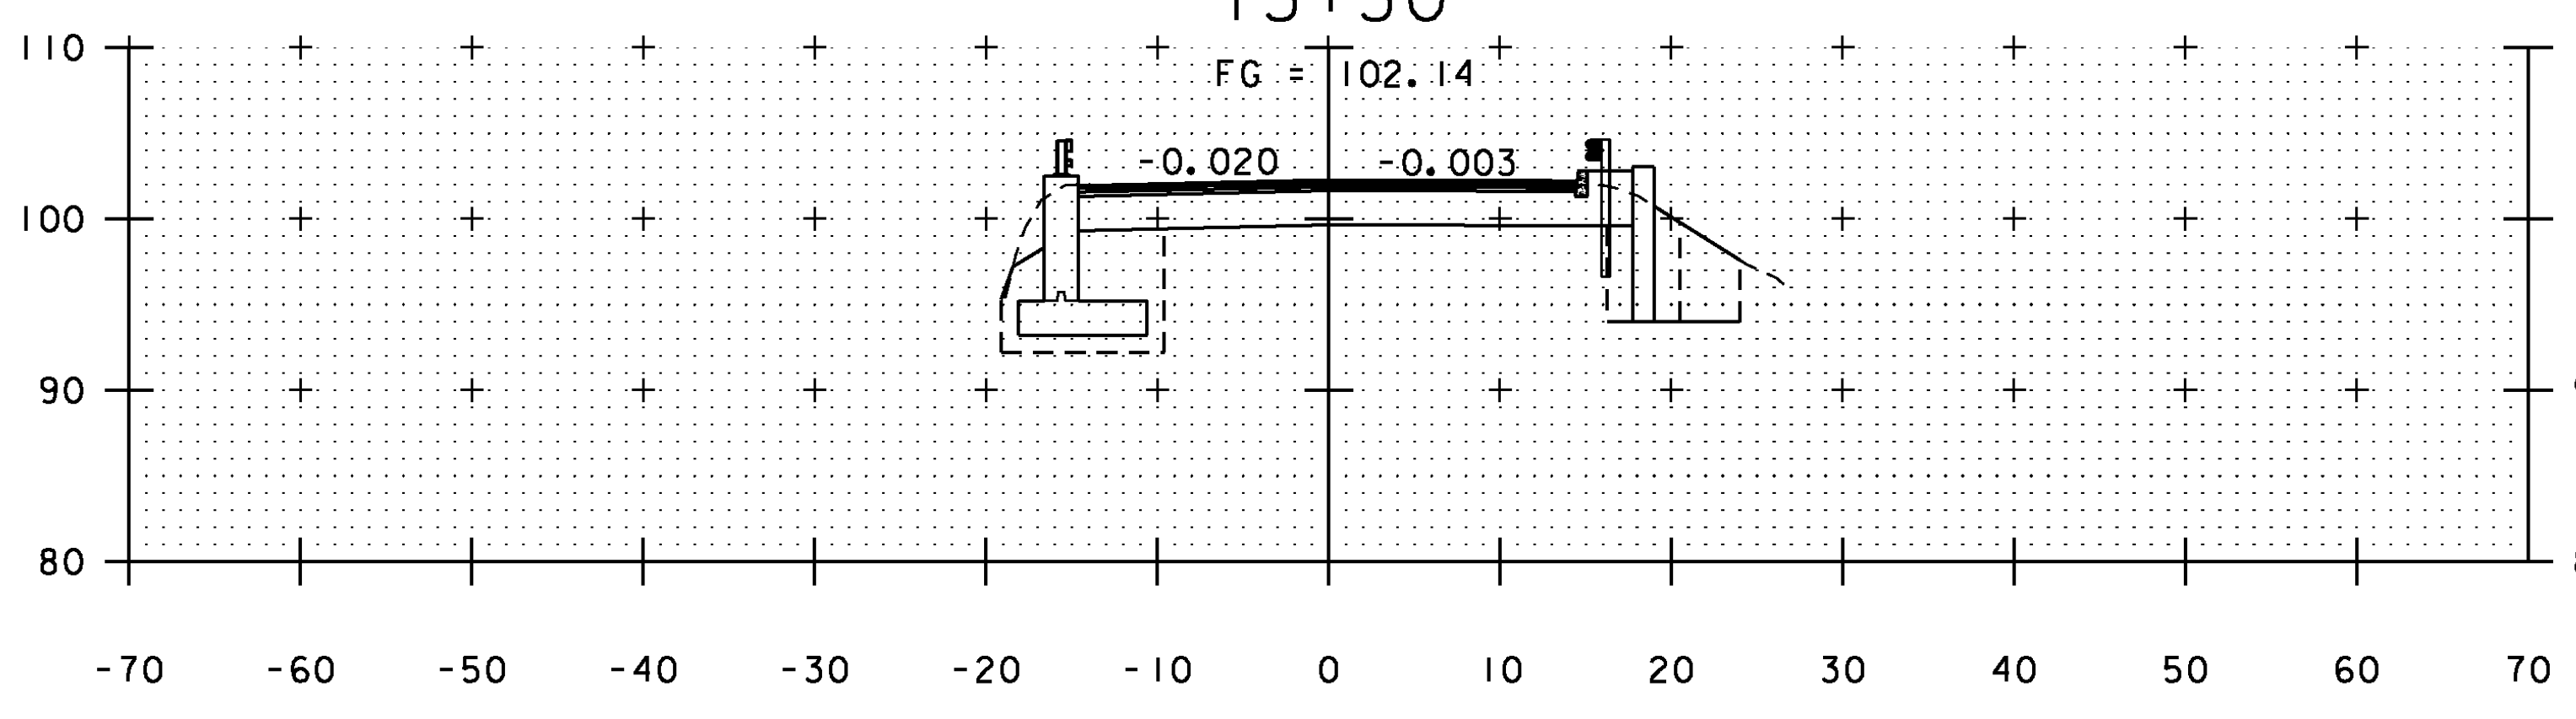

13+20

US RT 5 ROADWAY CROSS SECTIONS  
STA. 13+20 THRU STA. 14+00

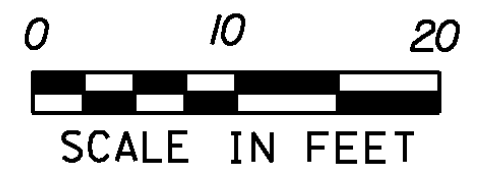

PROJECT NAME: HARTLAND	PLOT DATE: 12/17/2013
PROJECT NUMBER: BHF BPNT(12)	DRAWN BY: A.J. GOUDREAU
FILE NAME: zllc260xs.dgn	CHECKED BY: S.E. BURBANK
PROJECT LEADER: M.A. COLGAN	SHEET 39 OF 55
DESIGNED BY: S.G. FARNSWORTH	
BR 62A US 5 CROSS SECTIONS (3 OF 3)	

## EPSC PLAN NARRATIVE

### 1.1 PROJECT DESCRIPTION

THE PROJECT INVOLVES THE REMOVAL AND REPLACEMENT OF THE EXISTING CONCRETE DECK AND NEW WINGWALLS WITH RELATED APPROACH WORK. DURING CONSTRUCTION, TRAFFIC WILL BE DETOURED OFFSITE. THIS PROJECT IS LOCATED ON US ROUTE 5 LOCATED NORTH OF I-91 AND PASSES OVER THE NEW ENGLAND CENTRAL RAILROAD IN THE TOWN OF HARTLAND, VT. THE EXISTING BRIDGE IS APPROXIMATELY 99 FEET LONG WITH A 33 FOOT WIDE CONCRETE DECK. THE EXISTING SUBSTRUCTURE CONSISTS OF CONCRETE ABUTMENTS AND WINGWALLS.

THE BRIDGE REPLACEMENT INCLUDES THE REMOVAL OF THE EXISTING CONCRETE DECK IN ITS ENTIRETY AND THE CONSTRUCTION OF A NEW 99 FOOT SINGLE SPAN CONCRETE SLAB TO CREATE A NEW BRIDGE WIDTH OF 33 FEET. NEW CONCRETE ABUTMENTS AND WINGWALLS WILL BE FORMED IN PLACE AND ASSOCIATED APPROACH WORK INCLUDES THREE NEW APPROACH PRECAST RETAINING WALLS AND NEW GUARDRAIL.

THE SITE IS LOCATED AT LATITUDE N 43 DEGREES 34 MINUTES, LONGITUDE W 72 DEGREES 23 MINUTES.

NOTE: AREA OF DISTURBANCE INCLUDES LIMITS OF EARTH DISTURBANCE WITHIN THE PROJECT AREA, AND OTHER EARTH DISTURBING ACTIVITIES WITHIN OR DIRECTLY ADJACENT TO THE PROJECT LIMITS AS SHOWN ON THE ATTACHED EPSC PLAN.

TOTAL AREA OF DISTURBANCE AS SHOWN ON THE ATTACHED EPSC PLAN IS APPROXIMATELY 0.21 ACRES.

IT IS ANTICIPATED THAT THIS PROJECT WILL LAST ONE CONSTRUCTION SEASON.

### 1.2 SITE INVENTORY

#### 1.2.1 TOPOGRAPHY

THE ROAD IN THIS PROJECT AREA IS RELATIVELY FLAT IN A FOREST WITH OCCASIONAL OPEN AREAS AND FOLLOWS THE LAY OF THE SURROUNDING TOPOGRAPHY. US ROUTE 5 OVERPASSES INTERSTATE 89 JUST WEST OF THE PROJECT AND A RESIDENTIAL HOME IS JUST TO THE NORTH AND LEFT OF THE PROJECT AREA BUT NEITHER IS WITHIN THE PROJECT AREA.

#### 1.2.2 DRAINAGE, WATERWAYS, BODIES OF WATER, AND PROXIMITY TO NATURAL OR MAN-MADE WATER FEATURES

NO SOILS NEAR NATURAL OR MAN-MADE WATERWAYS WILL BE DISTURBED. THE NEAREST WATERWAY, CONNECTICUT RIVER, IS APPROXIMATELY 0.2 MILES AWAY.

#### 1.2.3 VEGETATION

THE VEGETATION IN THE PROJECT AREA CONSISTS OF HARDWOOD TREES AND UNDERGROWTH. THE IMPACT TO VEGETATION WILL BE LIMITED TO THAT WHICH IS AFFECTED BY THE EXCAVATION REQUIRED TO INSTALL THE NEW PRECAST CONCRETE WINGWALLS.

#### 1.2.4 SOILS

ALL SOIL DATA CAME FROM THE U.S. DEPARTMENT OF AGRICULTURE SOIL CONSERVATION SERVICE FOR THE COUNTY OF WINDSOR, VERMONT. SOILS ON THE PROJECT SITE ARE WINDSOR, LOAMY FINE SAND, 8% TO 15% SLOPES, "K FACTOR" = 0.17. THE SOIL IS CONSIDERED TO HAVE LOW EROSION POTENTIAL.

NOTE: K-VALUES GENERALLY INDICATE THE FOLLOWING:

0.0-0.23 = LOW EROSION POTENTIAL  
0.24-0.36 = MODERATE EROSION POTENTIAL  
0.37 AND HIGHER = HIGH EROSION POTENTIAL

#### 1.2.5 SENSITIVE RESOURCE AREAS

CRITICAL HABITATS: NO  
HISTORICAL OR ARCHEOLOGICAL AREAS: NO  
PRIME AGRICULTURAL LAND: NO  
THREATENED AND ENDANGERED SPECIES: NO  
WATER RESOURCE: NO  
WETLANDS: NO

### 1.3 RISK EVALUATION

THIS PROJECT DOES NOT FALL UNDER THE JURISDICTION OF GENERAL PERMIT 3-9020 FOR STORMWATER RUNOFF FROM CONSTRUCTION SITES. SHOULD CHANGES PRIOR TO OR DURING CONSTRUCTION RESULT IN ONE OR MORE ACRES OF EARTH DISTURBANCE OR SHOULD THE PROJECT BECOME PART OF A LARGER PLAN OF DEVELOPMENT, THE CONTRACTOR WILL BE RESPONSIBLE FOR ANY ADDITIONAL PERMITTING.

### 1.4 EROSION PREVENTION AND SEDIMENT CONTROL

THE EROSION CONTROL PLANS ARE MEANT AS A GUIDELINE FOR PREVENTING EROSION AND CONTROLLING SEDIMENT TRANSPORT. THE PRINCIPLES OUTLINED IN THIS NARRATIVE CONSIST OF APPLYING MEASURES THROUGHOUT CONSTRUCTION OF THE PROJECT IN ORDER TO MINIMIZE SEDIMENT TRANSPORT TO THE RECEIVING WATERS. THE MEASURES INCLUDE STABILIZATION AND STRUCTURAL PRACTICES, STORM WATER CONTROLS AND OTHER POLLUTION PREVENTION PRACTICES. THEY HAVE BEEN PROPOSED BY THE DESIGNER AS A BASIS FOR PROTECTING RESOURCES AND WILL NEED TO BE BUILT UPON BASED ON THE SPECIFIC MEANS AND METHODS OF THE CONTRACTOR. REFER TO THE LOW RISK SITE HANDBOOK AND APPROPRIATE DETAIL SHEETS FOR SPECIFIC GUIDANCE AND CONSTRUCTION DETAILING.

ALL MEASURES SHALL BE REGULARLY MAINTAINED AND SHALL BE CHECKED FOR SEDIMENT BUILD-UP. SEDIMENT SHALL BE DISPOSED OF AT AN APPROVED SITE WHERE IT WILL NOT BE SUBJECT TO EROSION.

#### 1.4.1 MARK SITE BOUNDARIES

SITE BOUNDARIES AND AREAS CONSTRUCTION EQUIPMENT CAN ACCESS SHALL BE DELINEATED.

PROJECT DEMARCATION FENCING (PDF) SHALL BE USED TO PHYSICALLY MARK SITE BOUNDARIES.

#### 1.4.2 LIMIT DISTURBANCE AREA

PREVENTING INITIAL SOIL EROSION BY MINIMIZING THE EXPOSED AREA IS MUCH MORE EFFECTIVE THAN TREATING ERODED SEDIMENT. EARTH DISTURBANCE CAN BE MINIMIZED THROUGH CONSTRUCTION PHASING BY ONLY OPENING UP EARTH AS NECESSARY. THIS CAN LIMIT THE AREA THAT WILL BE DISTURBED AND EXPOSED TO EROSION. EMPLOY TEMPORARY CONSTRUCTION STABILIZATION PRACTICES IN INCREMENTAL STAGES AS PHASES CHANGE. FOR PROJECTS WHICH FALL UNDER THE CONSTRUCTION GENERAL PERMIT, ONLY THE ACREAGE LISTED ON THE PERMIT AUTHORIZATION MAY BE EXPOSED AT ANY GIVEN TIME.

MAINTAINING VEGETATED BUFFERS ALONG STREAM BANKS, WETLANDS OR OTHER SENSITIVE AREAS IS A CRUCIAL EROSION AND SEDIMENT CONTROL MEASURE THAT SHOULD BE ESTABLISHED WHEREVER POSSIBLE.

#### 1.4.3 SITE ENTRANCE/EXIT STABILIZATION

TRACKING OF SEDIMENT ONTO PUBLIC HIGHWAYS SHALL BE MINIMIZED TO REDUCE THE POTENTIAL FOR RUNOFF ENTERING RECEIVING WATERS. INSTALLATION SHALL COINCIDE WITH THE CONTRACTOR'S PROGRESS SCHEDULE.

STABILIZED CONSTRUCTION ENTRANCES SHALL BE INSTALLED AS PROPOSED ON THE EPSC PLAN AND ANYWHERE EQUIPMENT WILL BE GOING FROM AREAS OF EXPOSED SOILS TO PAVED SURFACES.

#### 1.4.4 INSTALL SEDIMENT BARRIERS

SEDIMENT BARRIERS SHALL BE UTILIZED TO INTERCEPT RUNOFF AND ALLOW SUSPENDED SEDIMENT TO SETTLE OUT. THEY SHALL BE INSTALLED PRIOR TO ANY UP SLOPE WORK.

SILT FENCE WILL BE INSTALLED AS PROPOSED ON THE EPSC PLAN.

#### 1.4.5 DIVERT UPLAND RUNOFF

DIVERSIONARY MEASURES SHALL BE USED TO INTERCEPT RUNOFF FROM ABOVE THE CONSTRUCTION AND DIRECT IT AROUND THE DISTURBED AREA SO THAT CLEAN WATER DOES NOT BECOME MUDDIED WHILE TRAVELING OVER EXPOSED SOILS ON THE CONSTRUCTION SITE.

THE PROJECT AREA IS RELATIVELY NARROW. THEREFORE IT IS NOT ANTICIPATED THAT DIVERSION MEASURES WILL BE NECESSARY.

#### 1.4.6 SLOW DOWN CHANNELIZED RUNOFF

CHECK STRUCTURES SHALL BE UTILIZED TO REDUCE THE VELOCITY, AND THUS THE EROSION POTENTIAL, OF CONCENTRATED FLOW IN CHANNELS.

CHECK STRUCTURES ARE NOT ANTICIPATED FOR THIS PROJECT.

#### 1.4.7 CONSTRUCT PERMANENT CONTROLS

PERMANENT STORMWATER TREATMENT DEVICES SHALL BE INSTALLED AS SHOWN ON THE PLANS AND IN ACCORDANCE WITH PERMIT CONDITIONS.

PERMANENT EROSION CONTROL STRUCTURES ARE NOT ANTICIPATED FOR THIS PROJECT.

#### 1.4.8 STABILIZE EXPOSED SOILS DURING CONSTRUCTION

ALL AREAS OF DISTURBANCE MUST HAVE TEMPORARY STABILIZATION IN PLACE WITHIN 48 HOURS OF DISTURBANCE OR IN ACCORDANCE WITH THE CONSTRUCTION GENERAL PERMIT 3-9020 AUTHORIZATION.

SURFACE ROUGHENING OF ALL EXPOSED SLOPES, COMBINED WITH TEMPORARY MULCHING, SHALL BE UTILIZED ON A REGULAR BASIS. BIODEGRADABLE TEMPORARY EROSION MATTING OR AN EQUIVALENT SHALL BE USED TO STABILIZE ALL SLOPES STEEPER THAN 1:3.

THE FORECAST OF RAINFALL EVENTS SHALL TRIGGER IMMEDIATE PROTECTION OF EXPOSED SOILS.

#### 1.4.9 WINTER STABILIZATION

VARIOUS MEASURES SPECIFIC TO WINTER MAY BE NECESSARY SHOULD THE PROJECT EXTEND INTO WINTER (OCTOBER 15 THROUGH APRIL 15). REFER TO THE LOW RISK SITE HANDBOOK FOR GUIDANCE.

#### 1.4.10 STABILIZE SOIL AT FINAL GRADE

EXPOSED SOIL MUST BE STABILIZED WITHIN 48 HOURS OF REACHING FINAL GRADE.

SEED, MULCH, FERTILIZER AND LIME SHALL BE USED TO ESTABLISH PERMANENT VEGETATION. FOR SLOPES STEEPER THAN 1:3, BIODEGRADABLE TEMPORARY EROSION MATTING OR AN EQUIVALENT SHALL BE USED INSTEAD OF MULCH.

#### 1.4.11 DE-WATERING ACTIVITIES

DISCHARGE FROM DEWATERING ACTIVITIES THAT FLOWS OFF OF THE CONSTRUCTION SITE MUST NOT CAUSE OR CONTRIBUTE TO A VIOLATION OF THE VERMONT WATER QUALITY STANDARDS.

DEWATERING IS NOT ANTICIPATED FOR THIS PROJECT.

#### 1.4.12 INSPECT YOUR SITE

INSPECT THE PROJECT SITE BASED ON SPECIAL PROVISION REQUIREMENTS OR CONSTRUCTION GENERAL PERMIT AUTHORIZATION STIPULATIONS.

### 1.5 SEQUENCE AND STAGING

THIS SECTION WILL BE DEVELOPED BY THE CONTRACTOR USING THE GUIDANCE OUTLINED IN THE VTRANS EPSC PLAN CONTRACTOR CHECKLIST.

#### 1.5.1 CONSTRUCTION SEQUENCE


#### 1.5.2 OFF-SITE ACTIVITIES

IN ADDITION TO THE CONTRACTOR CHECKLIST ANY ACTIVITIES OUTSIDE THE CONSTRUCTION LIMITS SHALL FOLLOW SUBSECTIONS 105.25- 105.29 OF THE STANDARD SPECIFICATIONS FOR CONSTRUCTION.


PROJECT NAME: HARTLAND  
PROJECT NUMBER: BHF BPNT(12)

FILE NAME: zllc260ero.narrative.dgn  
PROJECT LEADER: M.A. COLGAN  
DESIGNED BY: M.C. SCOTT  
BR 62A EPSC NARRATIVE


PLOT DATE: 1/2/2014  
DRAWN BY: M.C. SCOTT  
CHECKED BY: S.E. BURBANK  
SHEET 40 OF 55

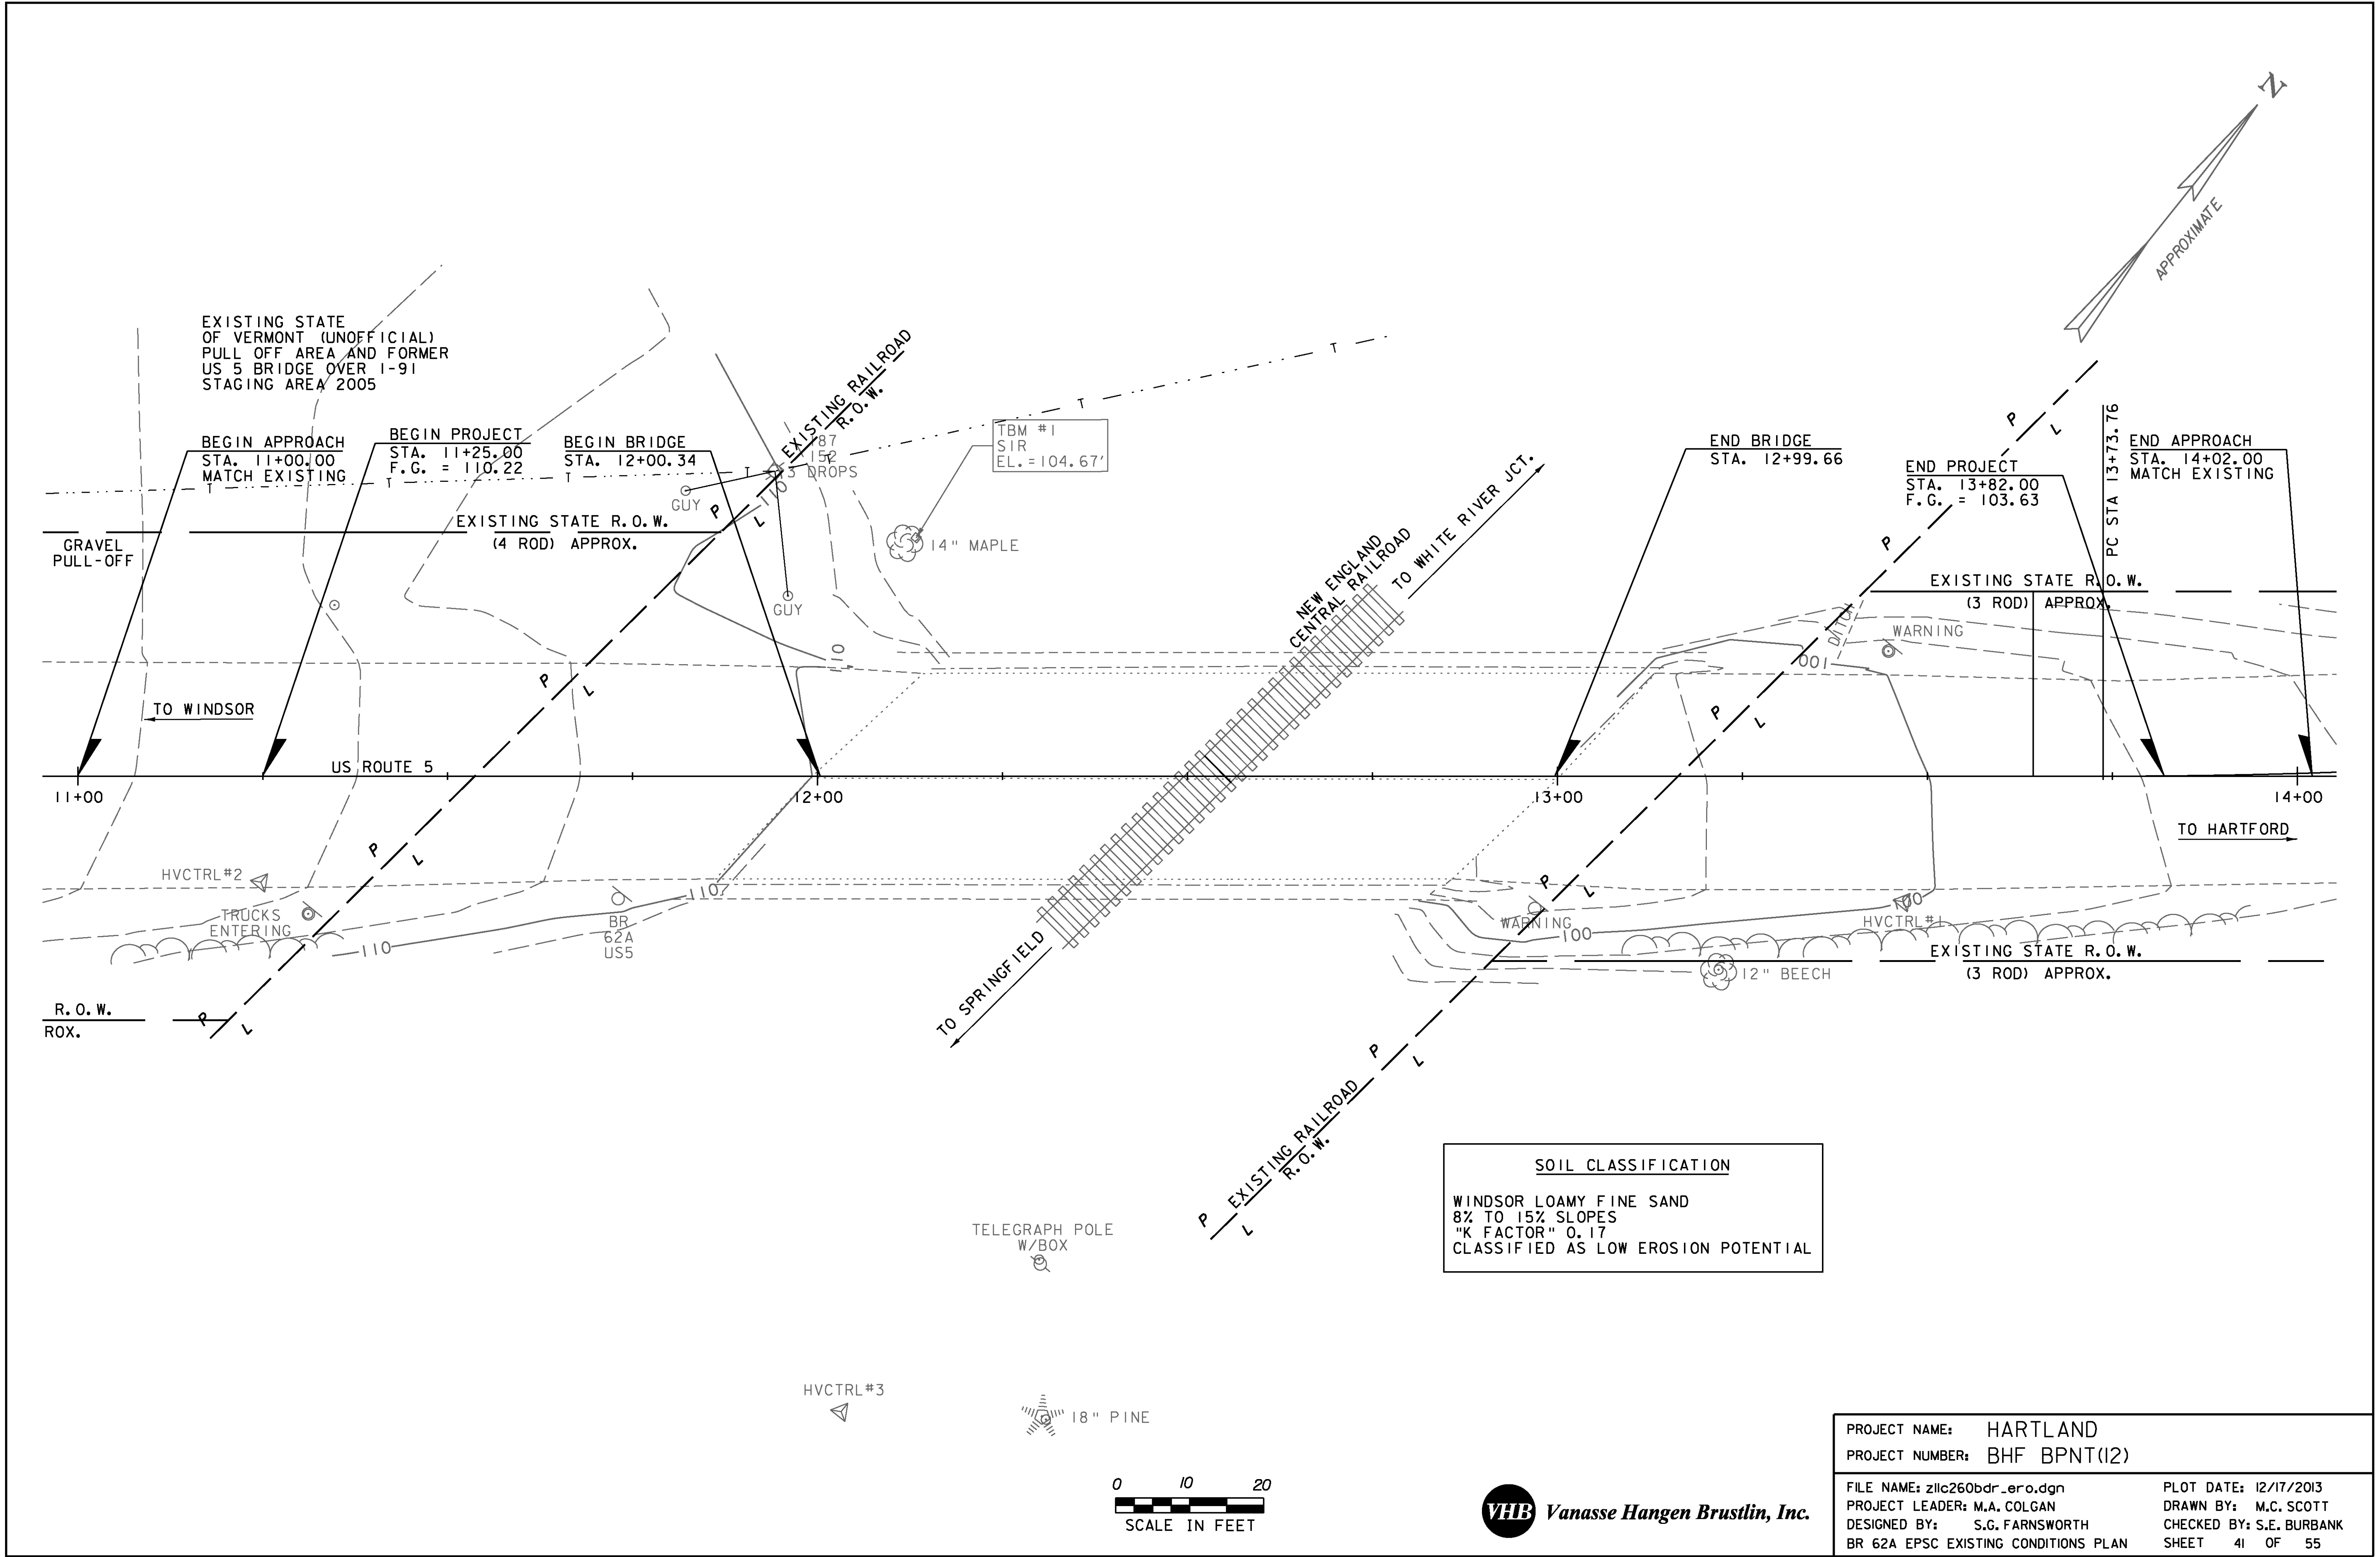

**SOIL CLASSIFICATION**  
 WINDSOR LOAMY FINE SAND  
 8% TO 15% SLOPES  
 "K FACTOR" 0.17  
 CLASSIFIED AS LOW EROSION POTENTIAL

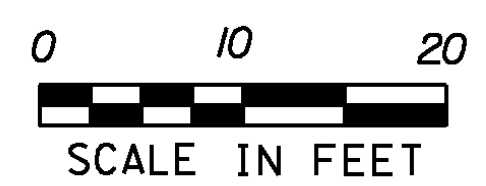

PROJECT NAME: HARTLAND	
PROJECT NUMBER: BHF BPNT(12)	
FILE NAME: zllc260bdr_ero.dgn	PLOT DATE: 12/17/2013
PROJECT LEADER: M.A. COLGAN	DRAWN BY: M.C. SCOTT
DESIGNED BY: S.G. FARNSWORTH	CHECKED BY: S.E. BURBANK
BR 62A EPSC EXISTING CONDITIONS PLAN	SHEET 41 OF 55

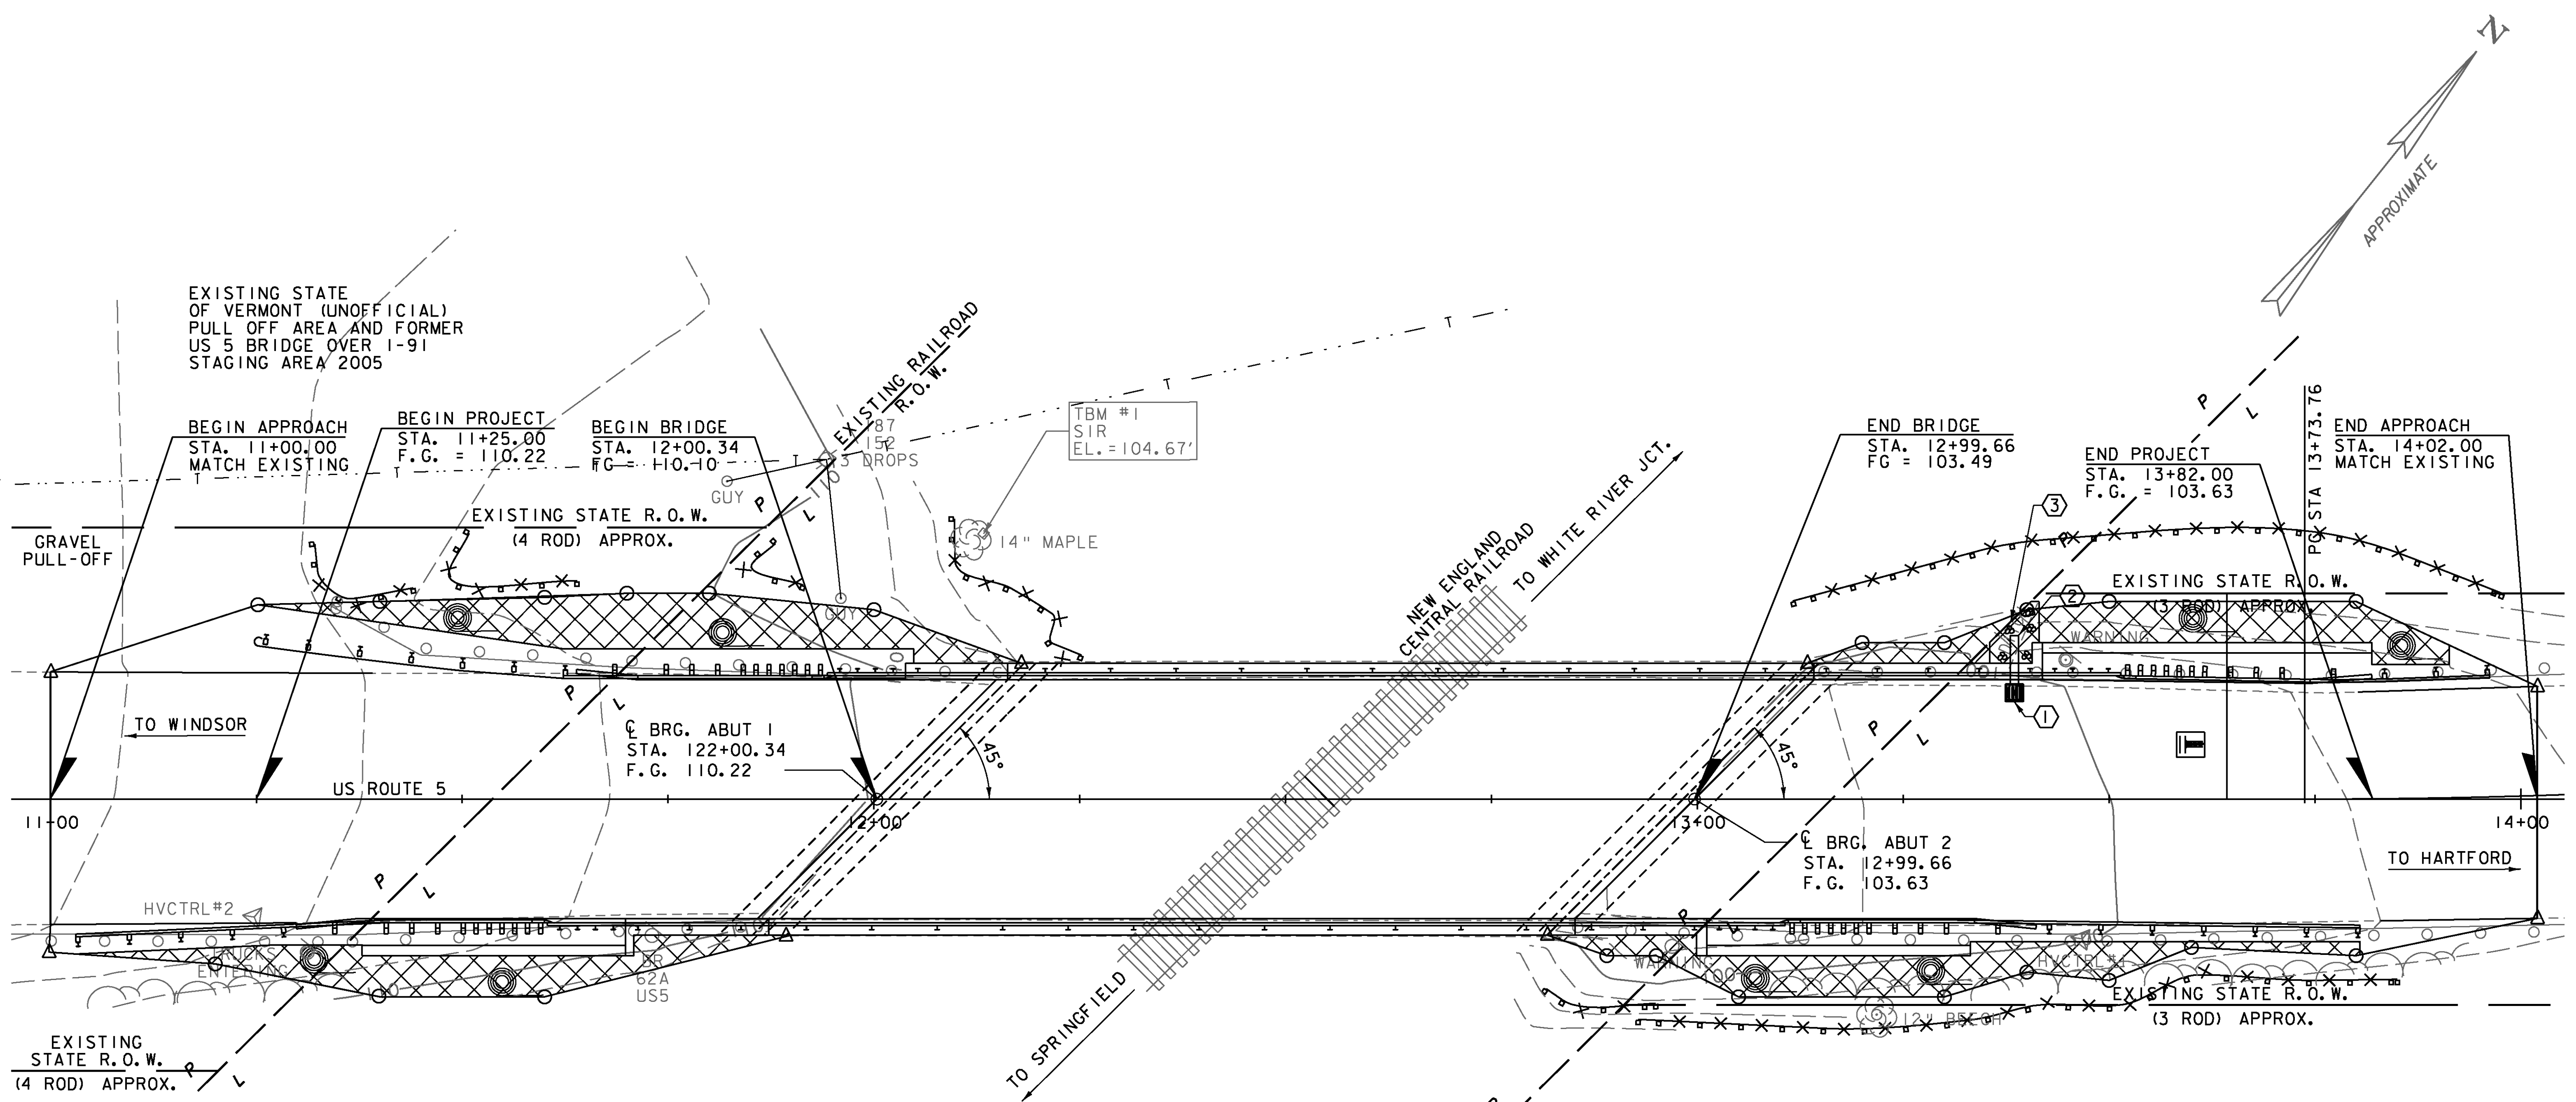


- EROSION PREVENTION AND SEDIMENT CONTROL NOTES:**
1. THE TOTAL DISTURBED AREA WITHIN THE PROJECT IS 0.21 ACRES (INCLUDING US RTE. 5).
  2. THE TOTAL AREA REQUIRING RE-VEGETATION IS 0.04 ACRES.
  3. TEMPORARY EROSION CONTROL MEASURES ARE CONCEPTUALLY SHOWN. THE CONTRACTOR MAY RELOCATE TEMPORARY MEASURES TO IMPROVE EROSION CONTROL WITH APPROVAL OF THE RESIDENT ENGINEER. SILT FENCE SHALL NOT BE INSTALLED ACROSS CONTOURS.
  4. THE CONTRACTOR SHALL USE OTHER TEMPORARY EROSION CONTROL MEASURES AS NECESSITATED BY THE SEQUENCE OF CONSTRUCTION OR AS DIRECTED BY THE RESIDENT ENGINEER.
  5. REFER TO EPSC DETAILS SHEETS FOR ADDITIONAL DETAILS.
  6. SEE SHEET 9 FOR EPSC LAYOUT PLAN SYMBLOGY.

**EROSION CONTROL PLAN**


**SOIL CLASSIFICATION**  
 WINDSOR LOAMY FINE SAND  
 8% TO 15% SLOPES  
 "K FACTOR" 0.17  
 CLASSIFIED AS LOW EROSION POTENTIAL

TELEGRAPH POLE  
 W/BOX

18" PINE

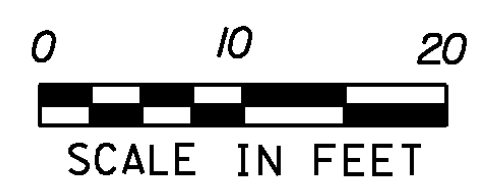


PROJECT NAME: HARTLAND	PLOT DATE: 1/2/2014
PROJECT NUMBER: BHF BPNT(12)	DRAWN BY: M.C. SCOTT
FILE NAME: zllc260bdr_ero.dgn	CHECKED BY: S.E. BURBANK
PROJECT LEADER: M.A. COLGAN	SHEET 42 OF 55
DESIGNED BY: S.G. FARNSWORTH	
BR 62A EPSC CONSTRUCTION CONDIT. PLAN	

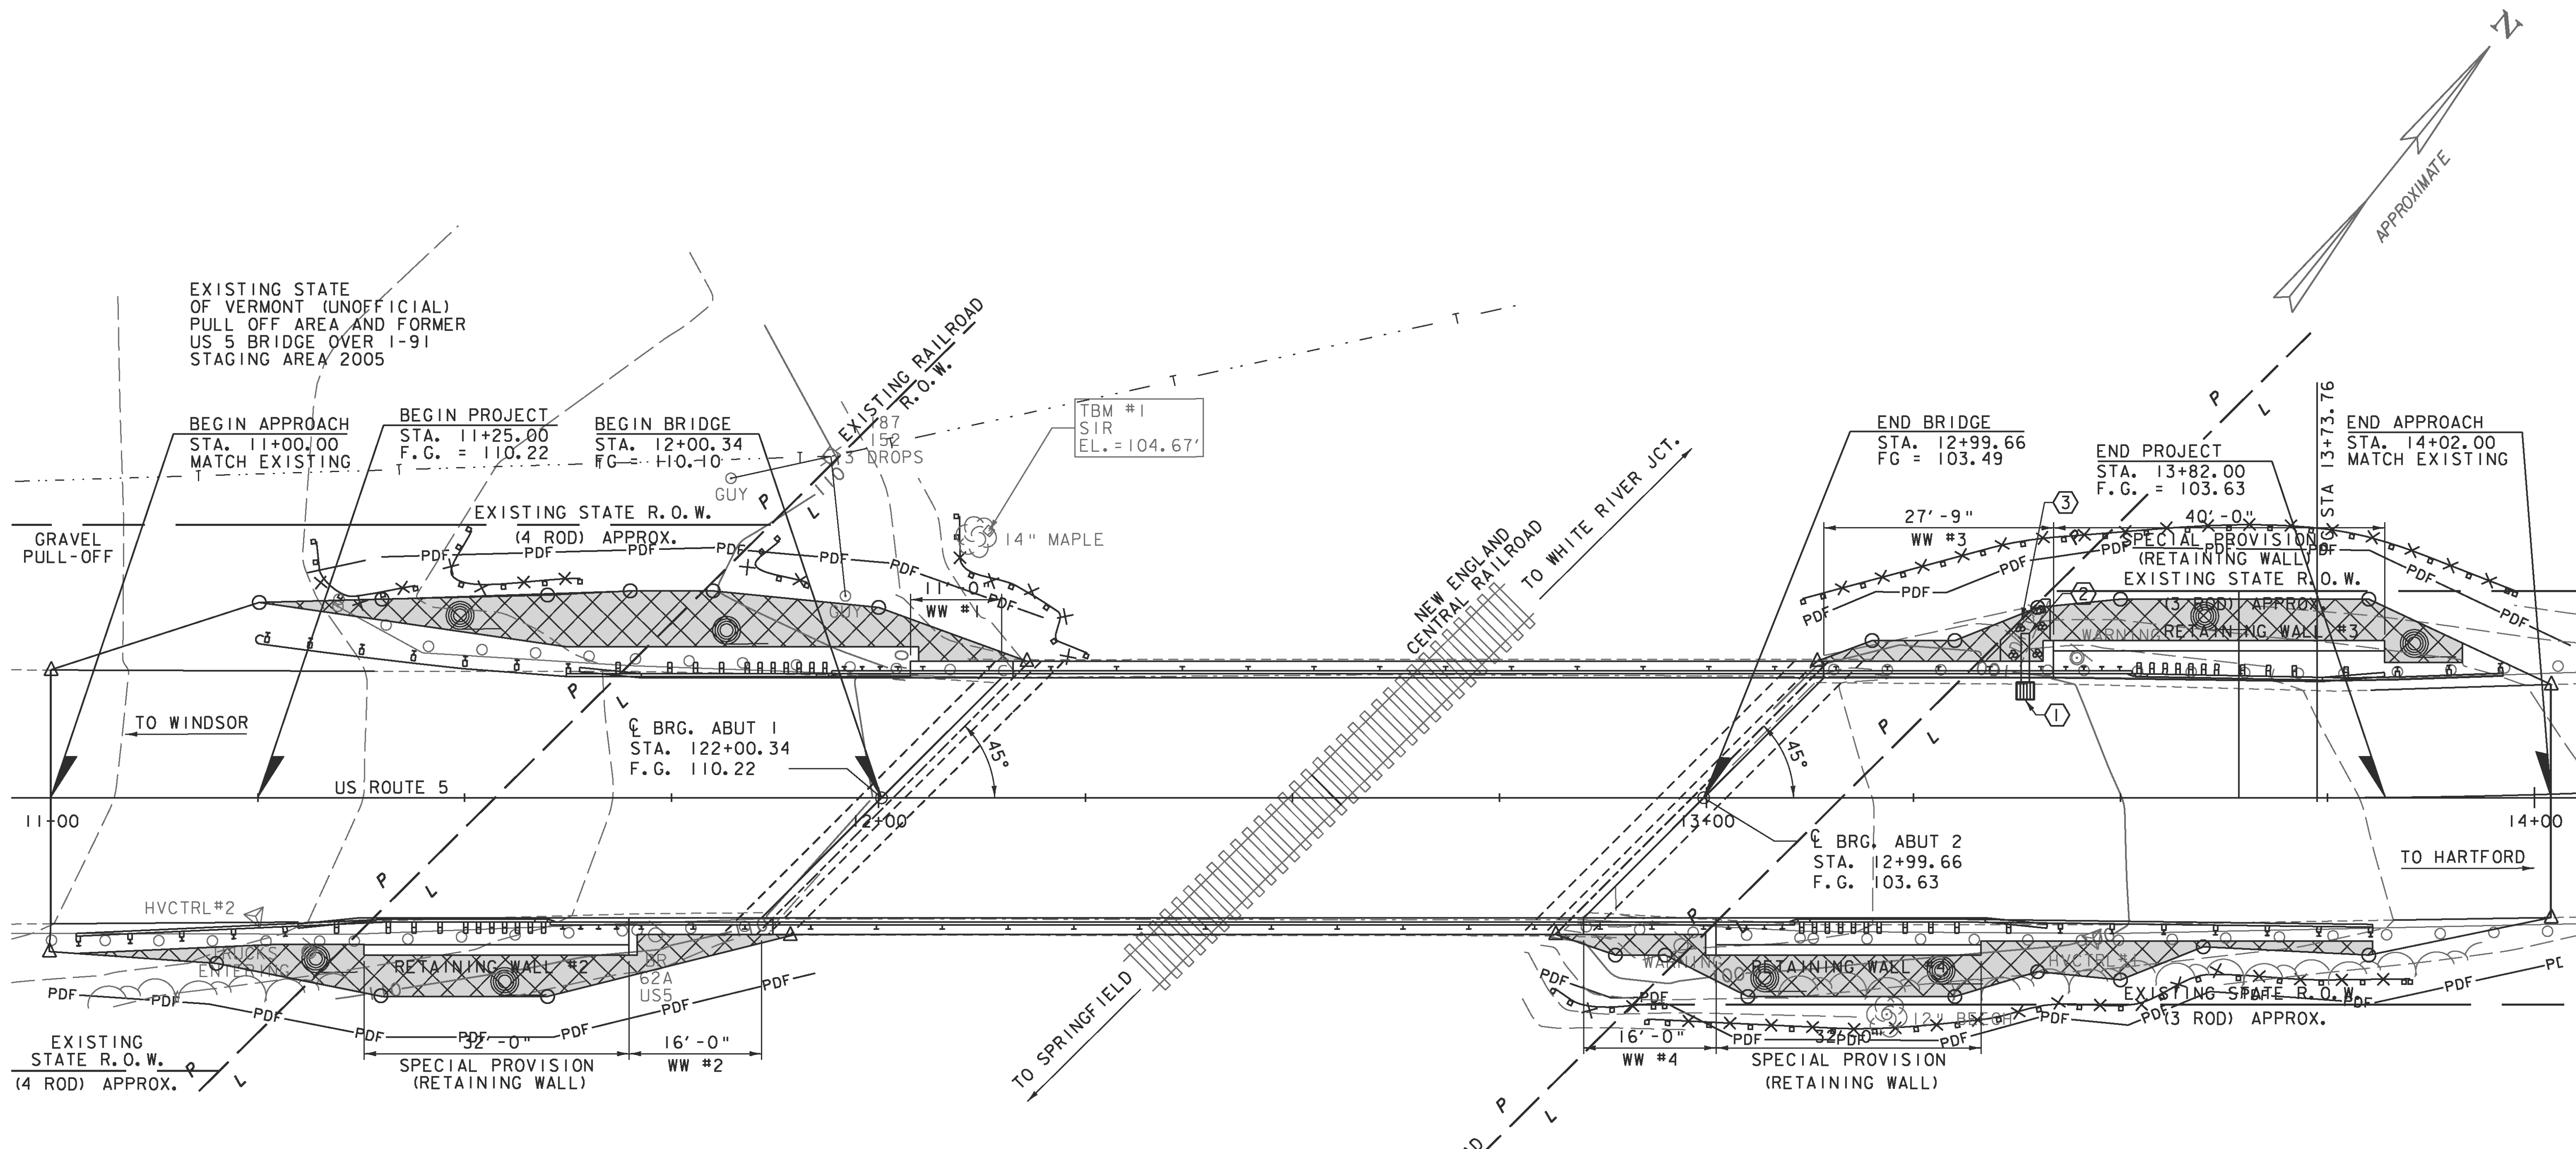


**NOTE:**  
SEE PREVIOUS SHEET FOR EROSION PREVENTION AND SEDIMENT CONTROL NOTES.

**EROSION CONTROL PLAN**

**SOIL CLASSIFICATION**  
WINDSOR LOAMY FINE SAND  
8% TO 15% SLOPES  
"K FACTOR" 0.17  
CLASSIFIED AS LOW EROSION POTENTIAL

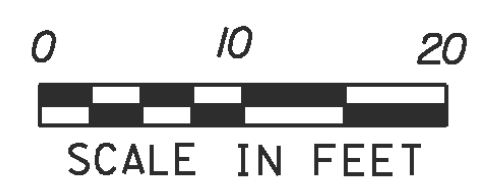

PROJECT NAME: HARTLAND	PLOT DATE: 1/2/2014
PROJECT NUMBER: BHF BPNT(12)	DRAWN BY: M.C. SCOTT
FILE NAME: zllc260bdr_ero.dgn	CHECKED BY: S.E. BURBANK
PROJECT LEADER: M.A. COLGAN	SHEET 43 OF 55
DESIGNED BY: S.G. FARNSWORTH	
BR 62A EPSC FINAL CONDITIONS PLAN	

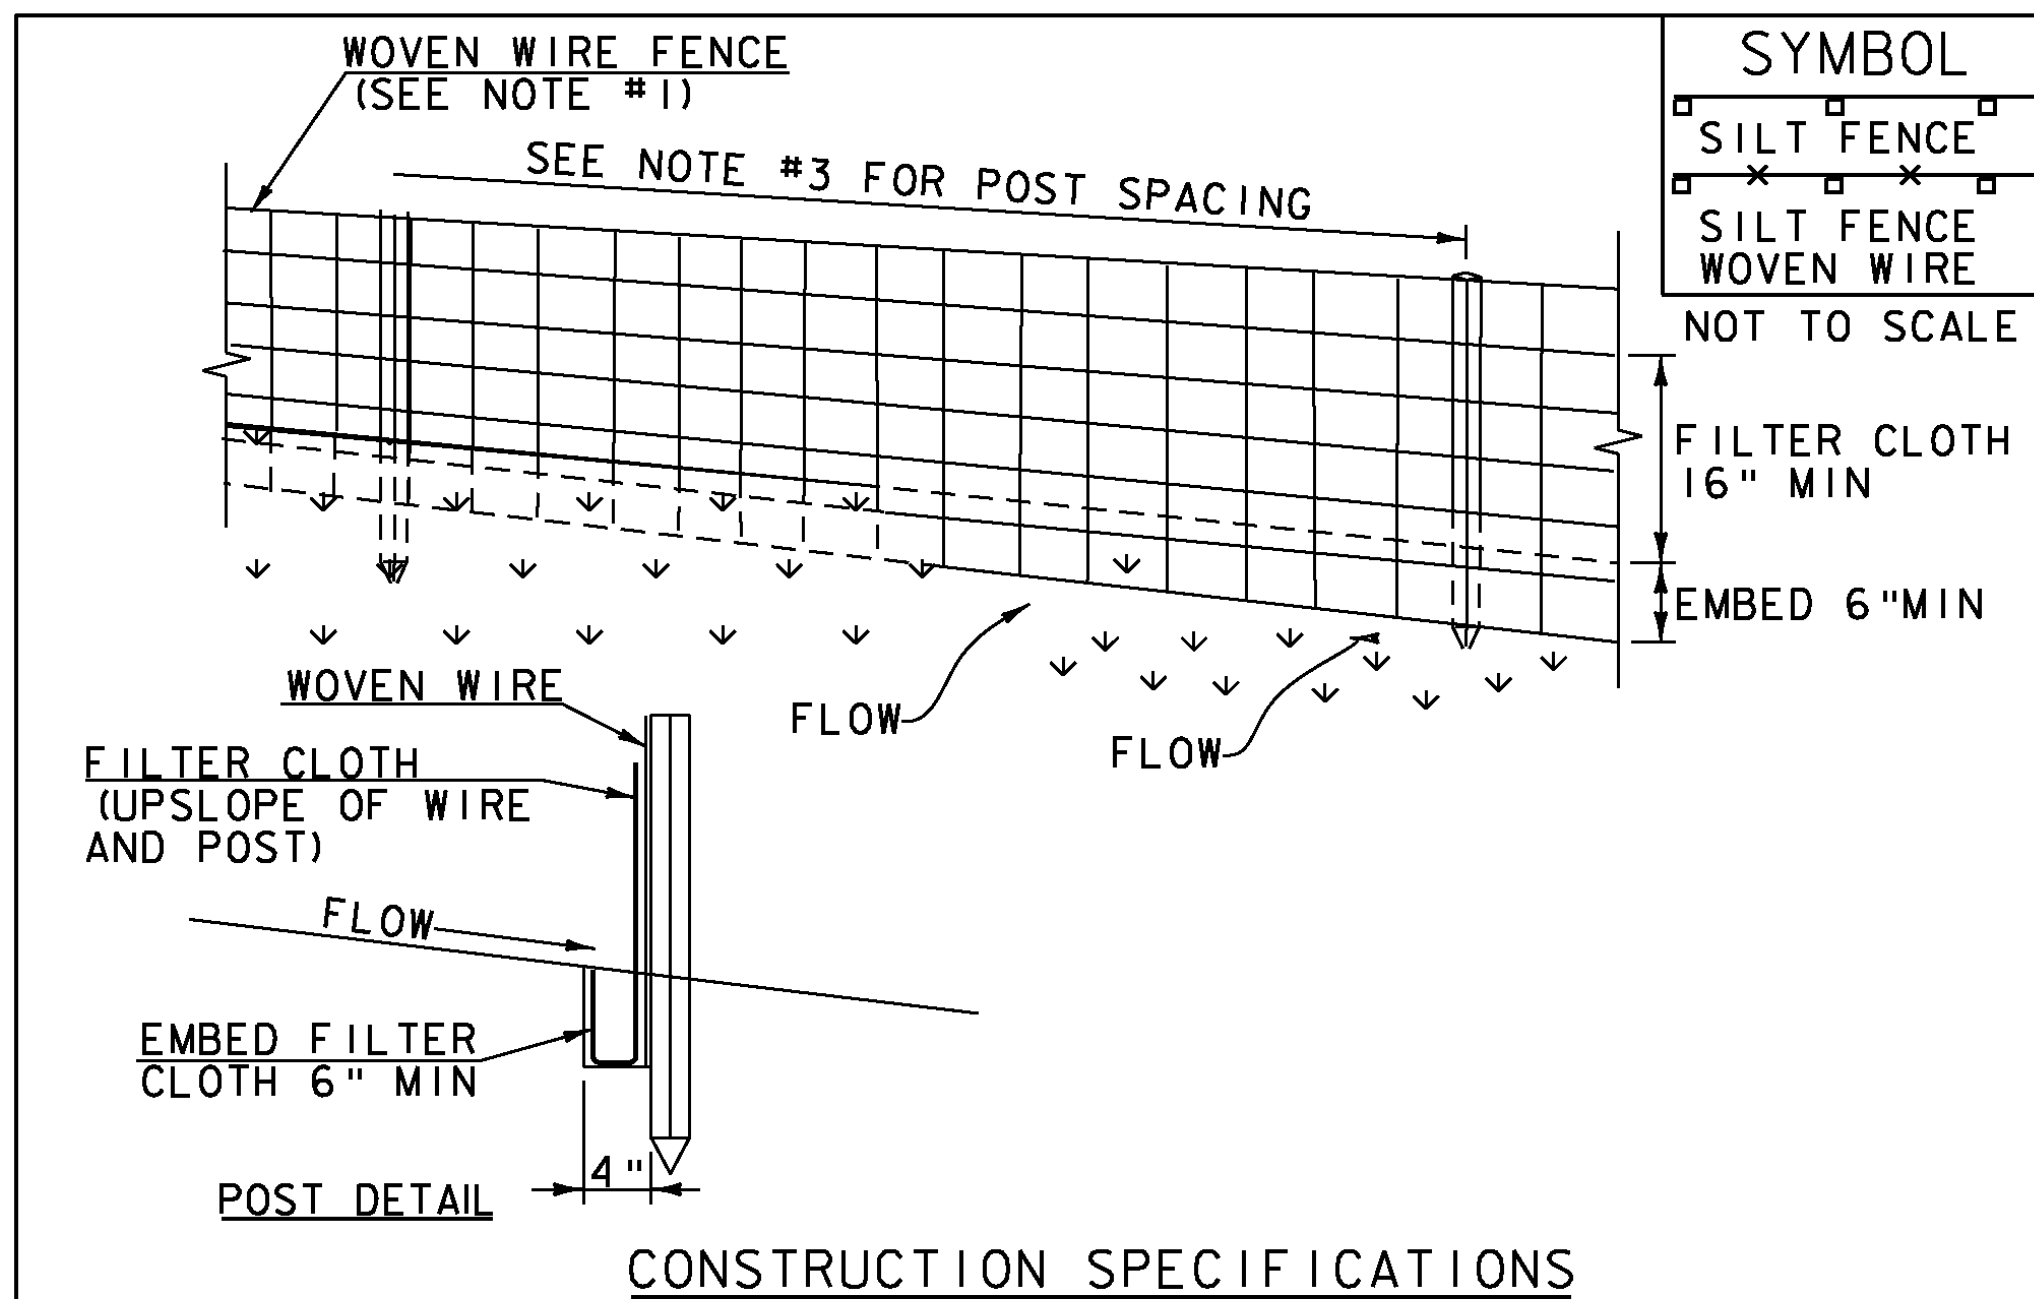

- CONSTRUCTION SPECIFICATIONS**
- WOVEN WIRE REINFORCED FENCE IS REQUIRED WITHIN 50' UPSLOPE OF RECEIVING WATERS WHEN THE PROJECT FALLS UNDER A CONSTRUCTION STORMWATER PERMIT. WOVEN WIRE SHALL BE A MIN. 14 GAUGE WITH A 6" MAX. MESH OPENING.
  - FILTER CLOTH SHALL BE EITHER FILTER X, MIRAF1100X, STABILINKA T140N OR APPROVED EQUIVALENT.
  - POST SPACING FOR WIRE-BACKED FENCE SHALL BE 10' MAXIMUM. FOR FILTER-CLOTH FENCE, WHEN ELONGATION IS >50%, POST SPACING SHALL NOT EXCEED 4' AND WHEN ELONGATION IS <50%, POST SPACING SHALL NOT EXCEED 6'.
  - WOVEN WIRE FENCE IS TO BE FASTENED SECURELY TO FENCE POSTS WITH WIRE TIES. FILTER CLOTH IS TO BE FASTENED SECURELY TO WOVEN WIRE FENCE WITH TIES SPACED EVERY 24" AT TOP AND MID SECTION.
  - WHEN TWO SECTIONS OF FILTER CLOTH ADJOIN EACH OTHER THEY SHALL BE OVER-LAPPED BY 6" AND FOLDED.
  - MAINTENANCE SHALL BE PERFORMED AS NEEDED AND MATERIAL REMOVED WHEN SEDIMENT REACHES HALF OF FABRIC HEIGHT.


ADAPTED FROM DETAILS PROVIDED BY: NEW YORK STATE DEC  
ORIGINALLY DEVELOPED BY USDA-NRCS  
VERMONT DEPARTMENT OF ENVIRONMENTAL CONSERVATION

**SILT FENCE**

NOTES:  
REFER TO "THE VERMONT STANDARDS & SPECIFICATIONS FOR EROSION PREVENTION & SEDIMENT CONTROL -2006-" FROM THE VT AGENCY OF NATURAL RESOURCES FOR ADDITIONAL GUIDANCE.

THIS WORK SHALL BE PERFORMED IN ACCORDANCE WITH SECTION 649 AND AS SHOWN IN THE PLANS FOR GEOTEXTILE FOR SILT FENCE (PAY ITEM 649.51) OR GEOTEXTILE FOR SILT FENCE, WOVEN WIRE REINFORCED (PAY ITEM 649.515).

REVISIONS	
MARCH 21, 2008	WHF
DECEMBER 11, 2008	WHF
JANUARY 13, 2009	WHF

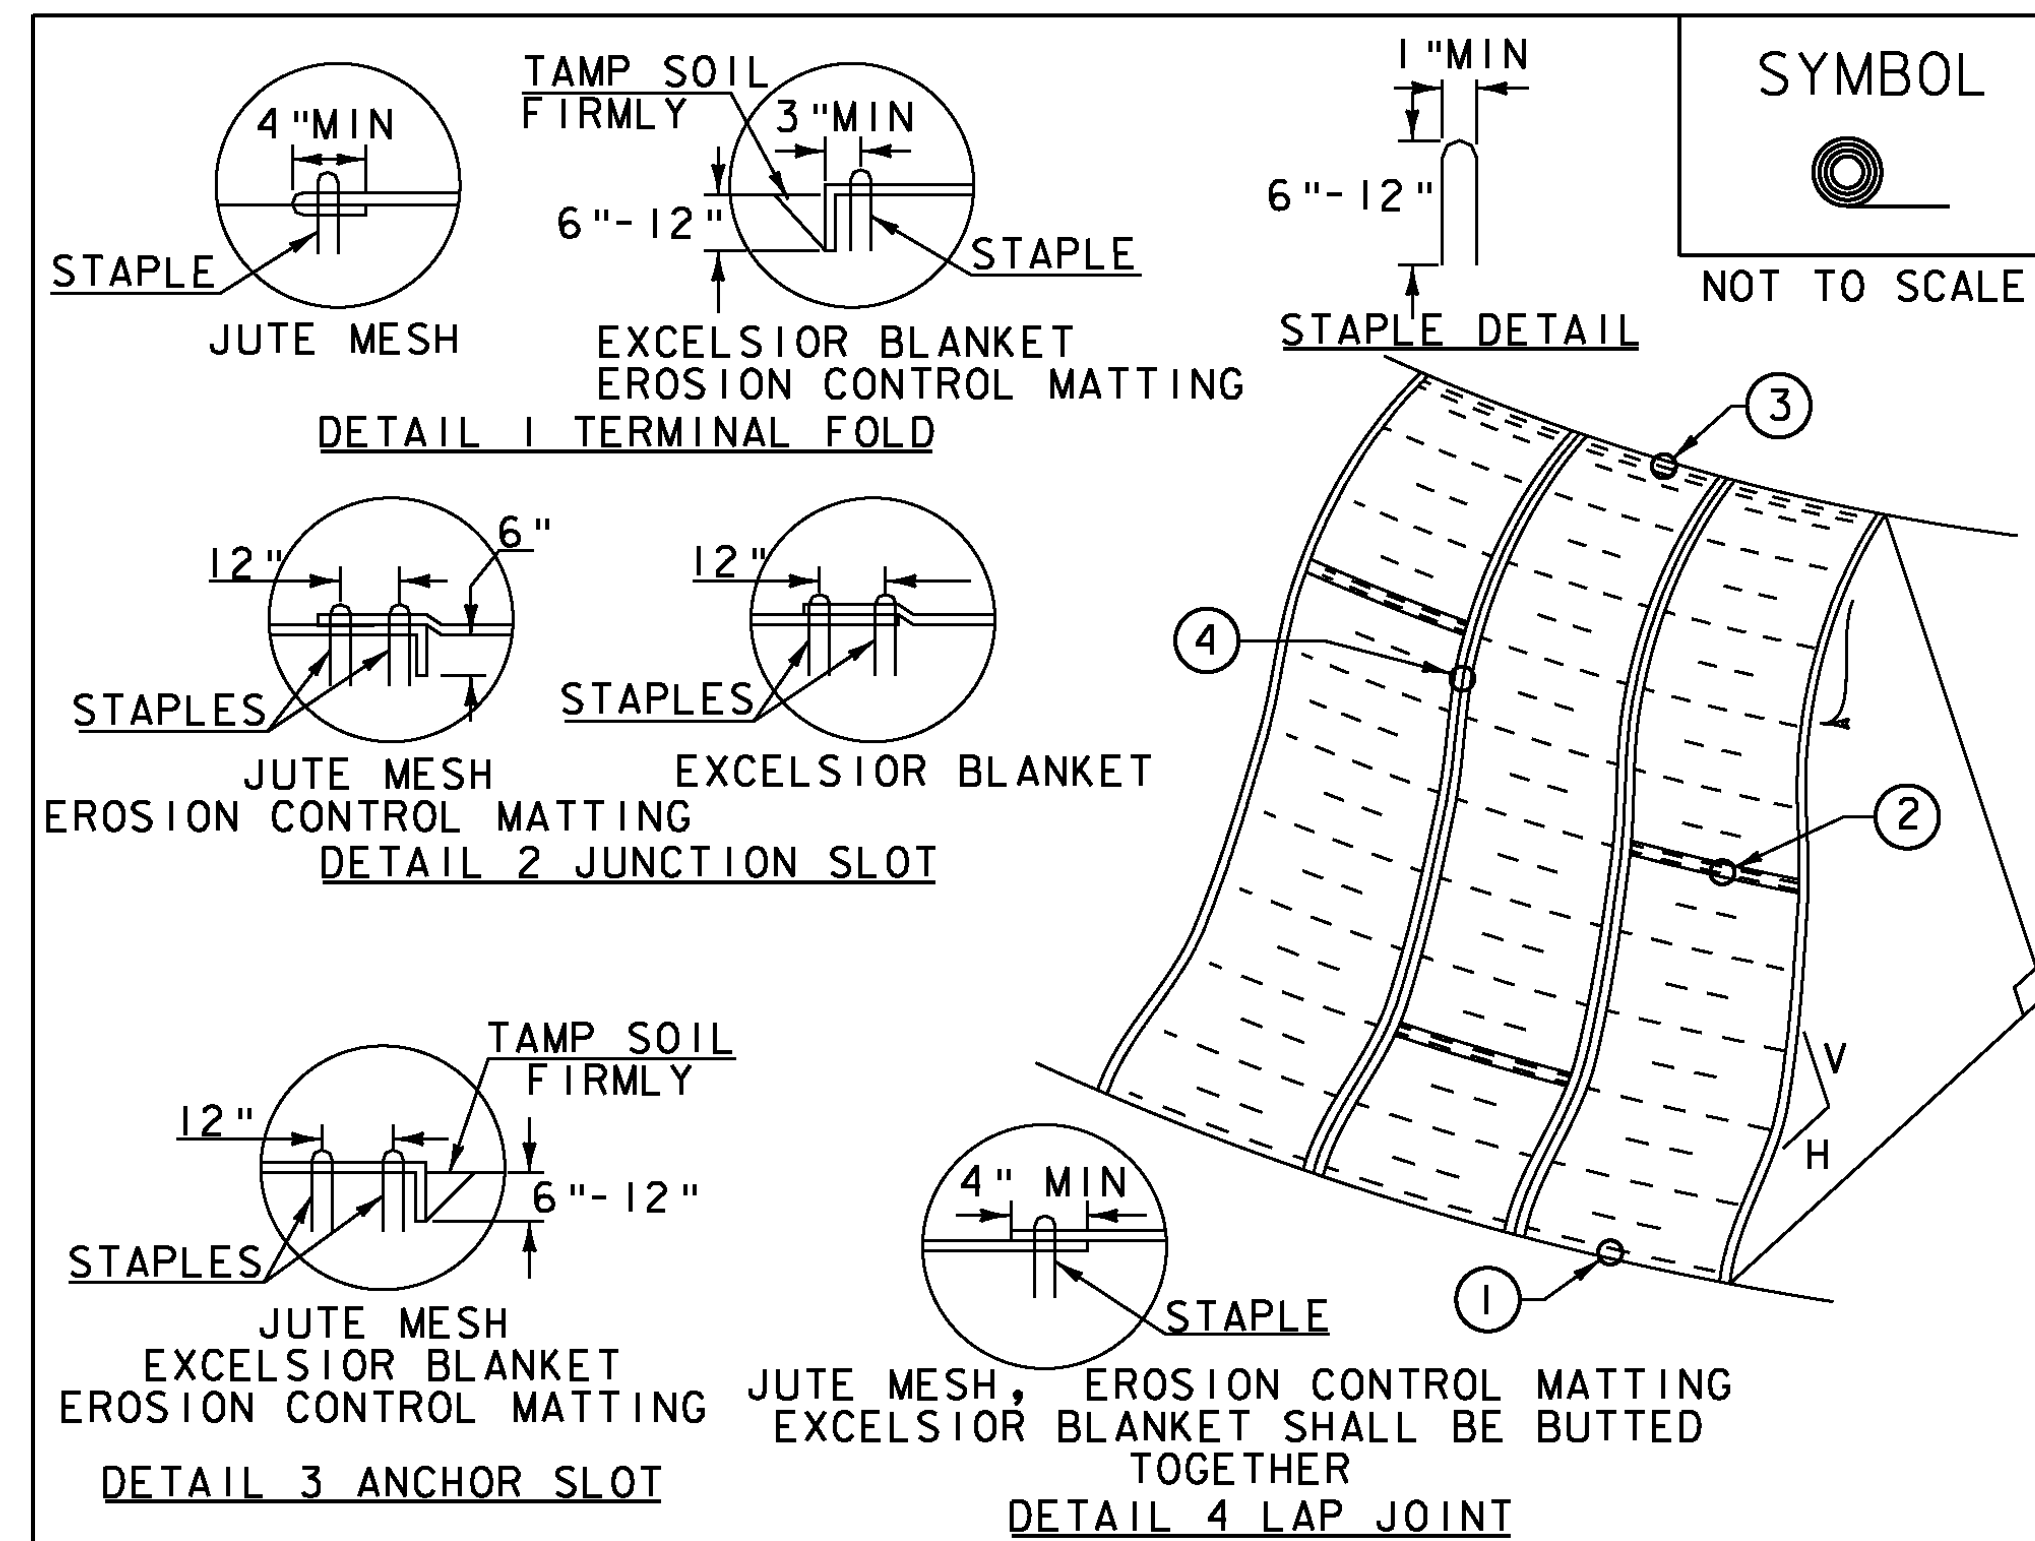


- CONSTRUCTION SPECIFICATIONS**
- APPLY TO SLOPES GREATER THAN 3H:1V OR WHERE NECESSARY TO AID IN ESTABLISHING VEGETATION.
  - APPLY FERTILIZER, LIME AND SEED PRIOR TO PLACING MATTING.
  - STAPLES ARE TO BE PLACED ALTERNATELY, IN COLUMNS APPROXIMATELY 2' APART AND IN ROWS APPROXIMATELY 3' APART. APPROXIMATELY 175 STAPLES ARE REQUIRED PER 4'X225' ROLL OF MATERIAL AND 125 STAPLES ARE REQUIRED PER 4'X150' ROLL OF MATERIAL.
  - DISTURBED AREAS SHALL BE SMOOTHLY GRADED. EROSION CONTROL MATERIAL SHALL BE PLACED LOOSELY OVER GROUND SURFACE. DO NOT STRETCH.
  - ALL TERMINAL ENDS AND TRANSVERSE LAPS SHALL BE STAPLED AT APPROXIMATELY 12" INTERVALS.

ADAPTED FROM DETAILS PROVIDED BY: NEW YORK STATE DEC  
ORIGINALLY DEVELOPED BY USDA-NRCS  
VERMONT DEPARTMENT OF ENVIRONMENTAL CONSERVATION

**ROLLED EROSION CONTROL PRODUCT (RECP) SIDE SLOPE**

NOTES:  
REFER TO "THE VERMONT STANDARDS & SPECIFICATIONS FOR EROSION PREVENTION & SEDIMENT CONTROL -2006-" FROM THE VT AGENCY OF NATURAL RESOURCES FOR ADDITIONAL GUIDANCE.  
THIS WORK SHALL BE PERFORMED IN ACCORDANCE WITH SECTION 653 AND AS SHOWN IN THE PLANS FOR TEMPORARY EROSION MATTING (PAY ITEM 653.20) OR PERMANENT EROSION MATTING (PAY ITEM 653.21).

REVISIONS	
APRIL 16, 2007	JMF
JANUARY 13, 2009	WHF

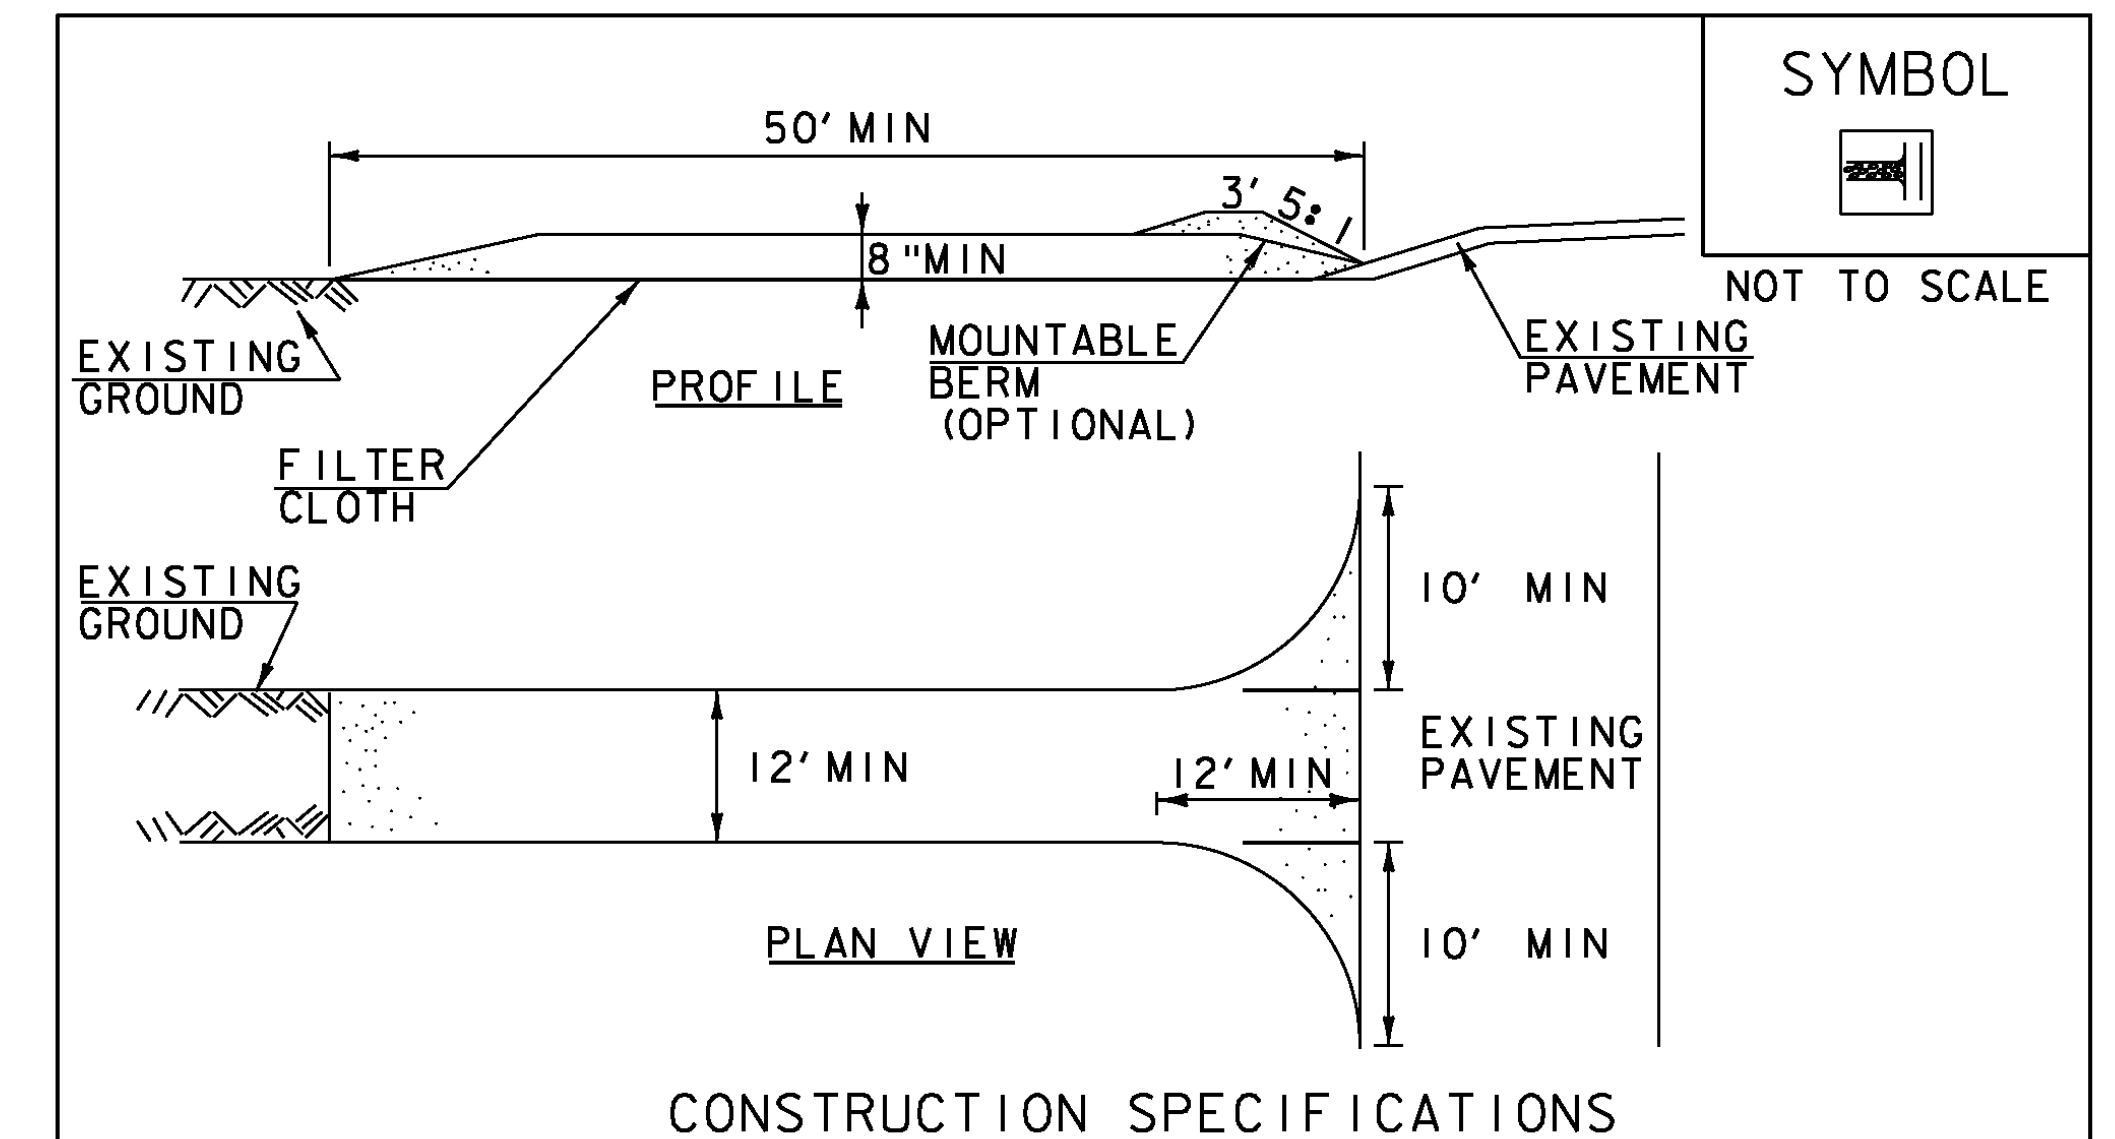

- CONSTRUCTION SPECIFICATIONS**
- STONE SIZE- USE 1-4" STONE, RECLAIMED OR RECYCLED CONCRETE EQUIVALENT.
  - LENGTH- NOT LESS THAN 50' (EXCEPT ON A SINGLE RESIDENCE LOT WHERE A 30' MINIMUM LENGTH APPLIES).
  - THICKNESS- NOT LESS THAN 8".
  - WIDTH- 12' MINIMUM, BUT NOT LESS THAN THE FULL WIDTH AT POINTS WHERE INGRESS OR EGRESS OCCURS. 24' IF SINGLE ENTRANCE TO SITE.
  - GEOTEXTILE MUST BE PLACED OVER THE ENTIRE AREA PRIOR TO PLACING STONE.
  - SURFACE WATER- ALL SURFACE WATER FLOWING OR DIVERTED TOWARD CONSTRUCTION ENTRANCES SHALL BE PIPED BENEATH THE ENTRANCE. IF PIPING IS IMPRACTICAL, A MOUNTABLE BERM WITH 5:1 SLOPES WILL BE PERMITTED.
  - MAINTENANCE- THE ENTRANCE SHALL BE MAINTAINED IN A CONDITION WHICH WILL PREVENT TRACKING OR FLOWING OF SEDIMENT ONTO PUBLIC RIGHTS-OF-WAY, ALL SEDIMENT SPILLED, DROPPED, WASHED OR TRACKED ONTO PUBLIC RIGHTS-OF-WAY MUST BE REMOVED IMMEDIATELY.
  - WHEN WASHING IS REQUIRED, IT SHALL BE DONE ON AN AREA STABILIZED WITH STONE AND WHICH DRAINS INTO AN APPROVED SEDIMENT TRAPPING DEVICE.
  - PERIODIC INSPECTION AND NEEDED MAINTENANCE SHALL BE PROVIDED ACCORDING TO PERMIT REQUIREMENTS.

ADAPTED FROM DETAILS PROVIDED BY: NEW YORK STATE DEC  
ORIGINALLY DEVELOPED BY USDA-NRCS  
VERMONT DEPARTMENT OF ENVIRONMENTAL CONSERVATION

**STABILIZED CONSTRUCTION ENTRANCE**

NOTES:  
REFER TO "THE VERMONT STANDARDS & SPECIFICATIONS FOR EROSION PREVENTION & SEDIMENT CONTROL -2006-" FROM THE VT AGENCY OF NATURAL RESOURCES FOR ADDITIONAL GUIDANCE.  
THIS WORK SHALL BE PERFORMED IN ACCORDANCE WITH SECTION 653 FOR VEHICLE TRACKING PAD (PAY ITEM 653.35) OR AS SPECIFIED IN THE CONTRACT.

REVISIONS	
MARCH 24, 2008	WHF
JANUARY 13, 2009	WHF

PROJECT NAME: HARTLAND  
PROJECT NUMBER: BHF BPNT (12)

FILE NAME: z11c260epsc.dgn  
PROJECT LEADER: M.A. COLGAN  
DESIGNED BY: S. FARNSWORTH  
EPSC DETAILS (1 OF 2)

PLOT DATE: 12/17/2013  
DRAWN BY: J.L. LEMIEUX  
CHECKED BY: S. FARNSWORTH  
SHEET 44 OF 55

VAOT RURAL AREA MIX					
% WEIGHT	LBS/AC		NAME	GERM %	PURITY %
	BROADCAST	HYDROSEED			
37.5%	22.5	45	CREEPING RED FESCUE	85%	98%
37.5%	22.5	45	TALL FESCUE	90%	95%
5.0%	3	6	RED TOP	90%	95%
15.0%	9	18	BIRDSFOOT TREFOIL	85%	98%
5.0%	3	6	ANNUAL RYE GRASS	85%	95%
100%	60	120			

VAOT URBAN AREA MIX					
% WEIGHT	LBS/AC		NAME	GERM %	PURITY %
	BROADCAST	HYDROSEED			
42.5%	34	68	CREEPING RED FESCUE	85%	98%
10.0%	8	16	PERENNIAL RYE GRASS	90%	95%
42.5%	34	68	KENTUCKY BLUE GRASS	85%	85%
5.0%	4	8	ANNUAL RYE GRASS	85%	95%
100%	80	160			

GENERAL GUIDANCE			
FERTILIZER		LIME	
BROADCAST	HYDROSEED	BROADCAST	HYDROSEED
10-20-10	19-19-19	PELLETIZED	LIQUID
500 LBS/AC		2 TONS/AC	4.4 GAL/AC

#### CONSTRUCTION GUIDANCE

1. RURAL SEED MIX: USE AS INDICATED IN THE PLANS AND/OR FOR ALL ESTABLISHED UPLAND (NON WETLAND) AREAS DISTURBED BY THE CONTRACTOR.
2. URBAN SEED MIX: USE AS INDICATED IN THE PLANS AND/OR FOR ALL ESTABLISHED LAWN AREAS DISTURBED BY THE CONTRACTOR.
3. ALL SEED MIXTURES: SHALL NOT HAVE A WEED CONTENT EXCEEDING 0.40% BY WEIGHT AND SHALL BE FREE OF ALL NOXIOUS SEED.
4. FERTILIZER AND LIMESTONE: SHALL FOLLOW RATES SHOWN ON PLAN OR AS DIRECTED BY THE ENGINEER
5. HAY MULCH: TO BE PLACED ON EARTH SLOPES AT THE RATE OF 2 TONS/ACRE, ACHIEVE 90% GROUND COVER OR AS DIRECTED BY THE ENGINEER.
6. TOPSOIL: TO BE USED WITH SEED AS INDICATED ON THE PLANS, OR AS DIRECTED BY THE ENGINEER.
7. HYDROSEEDING: ALTHOUGH GUIDANCE IS GIVEN ABOVE THE SITE CONDITIONS AND THE TYPE OF HYDROSEED WILL ULTIMATELY DICTATE THE AMOUNTS AND TYPES OF SOIL AMENDMENTS TO BE APPLIED
8. TURF ESTABLISHMENT: PLACING SEED, FERTILIZER, LIME AND MULCH PRIOR TO SEPTEMBER 15 AND AFTER APRIL 15 CAN BETTER ENSURE A VIGOROUS GROWTH OF GRASS.

ADAPTED FROM VTRANS TECHNICAL LANDSCAPE MANUAL FOR ROADWAYS AND TRANSPORTATION FACILITIES


#### TURF ESTABLISHMENT

REVISIONS	
JUNE 23, 2009	WHF
JANUARY 15, 2010	WHF


PROJECT NAME: HARTLAND  
PROJECT NUMBER: BHF BPNT (12)

FILE NAME: z11c260epsc.dgn  
PROJECT LEADER: M.A. COLGAN  
DESIGNED BY: S. FARNSWORTH  
EPSC DETAILS (2 OF 2)


PLOT DATE: 12/17/2013  
DRAWN BY: J.L. LEMIEUX  
CHECKED BY: S. FARNSWORTH  
SHEET 45 OF 55

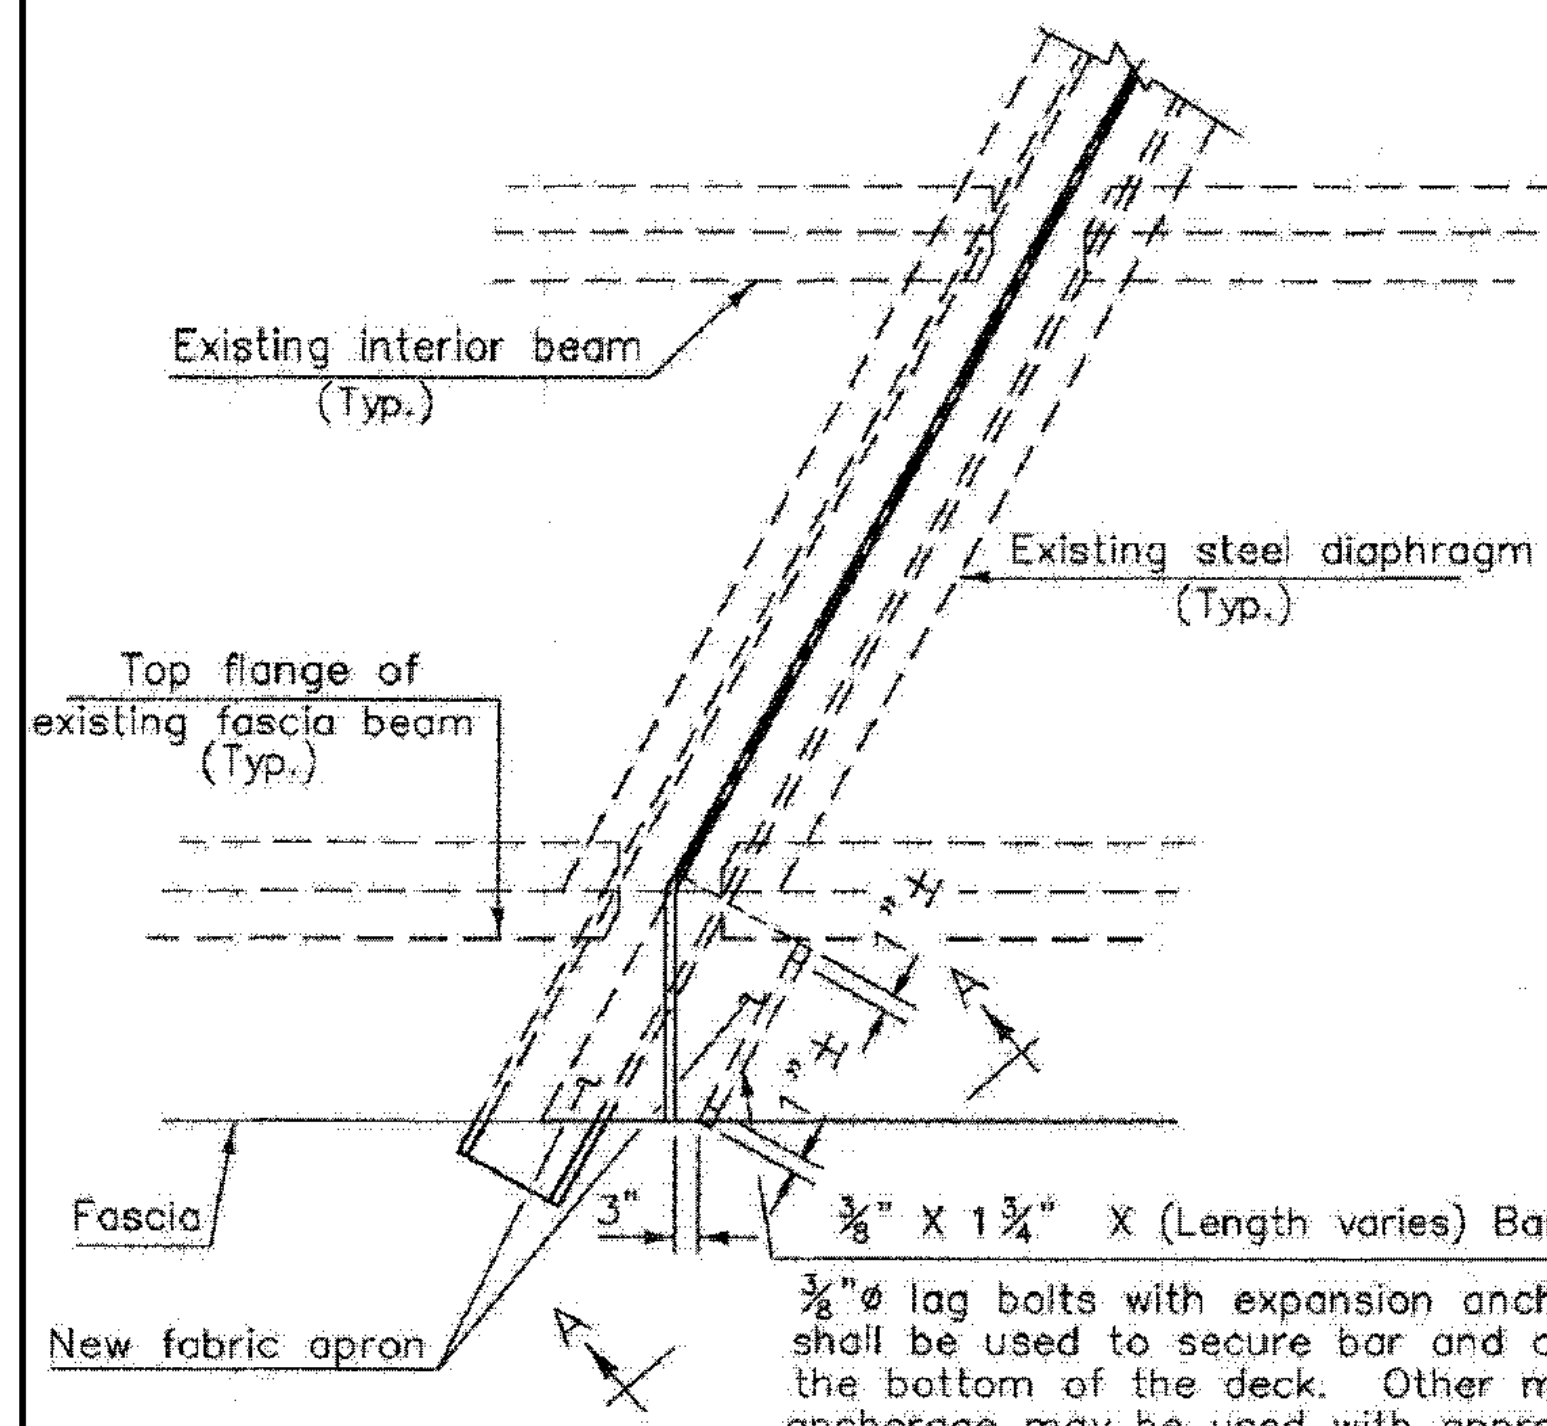

**TYPICAL PARTIAL PLAN VIEW AT PIER**  
N.T.S.

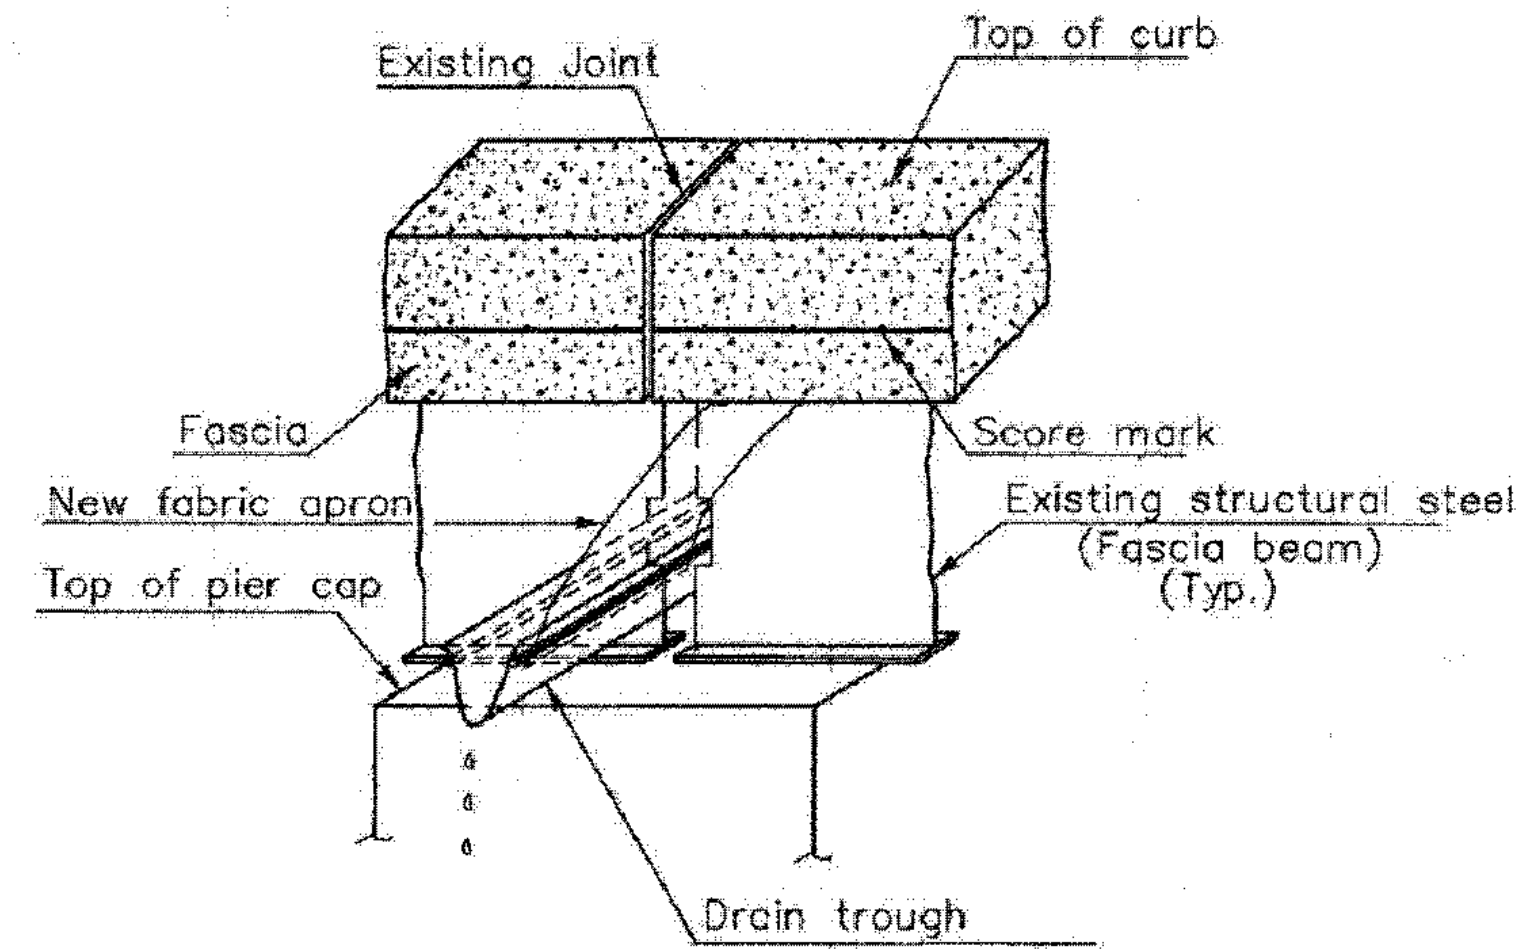


**VIEW A-A**  
N.T.S.

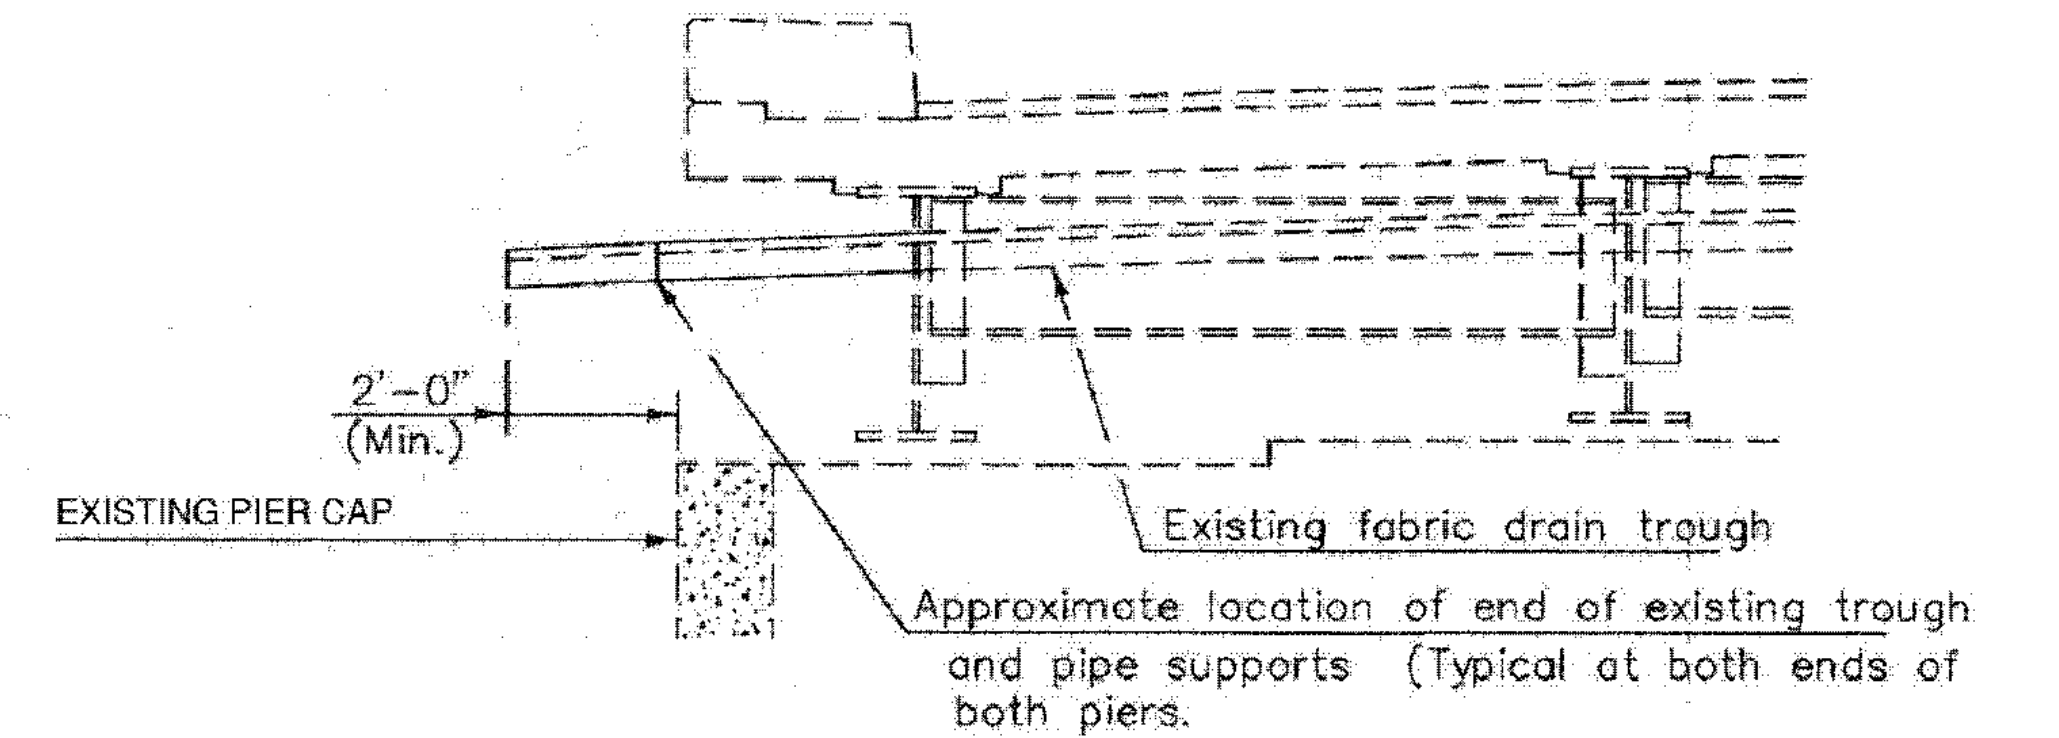

**DETAILS FOR EXTENDING DRAIN TROUGH AND SUPPORT PIPES**  
N.T.S.

THE COST OF THE 3/8 INCH BAR, ADHESIVE, AND ANCHORAGE BOLTS SHALL BE INCIDENTAL TO THE ITEM 900.640 SPECIAL PROVISION (REMOVE AND REPLACE DRAIN TROUGH).

	"X"	"Y"	"Z"	NO. OF HOLES REQ'D	NO. OF BARS REQ'D
PIER 1	2'-6"	3'	8'	4	2
PIER 2	2'-6"	3'	8'	4	2

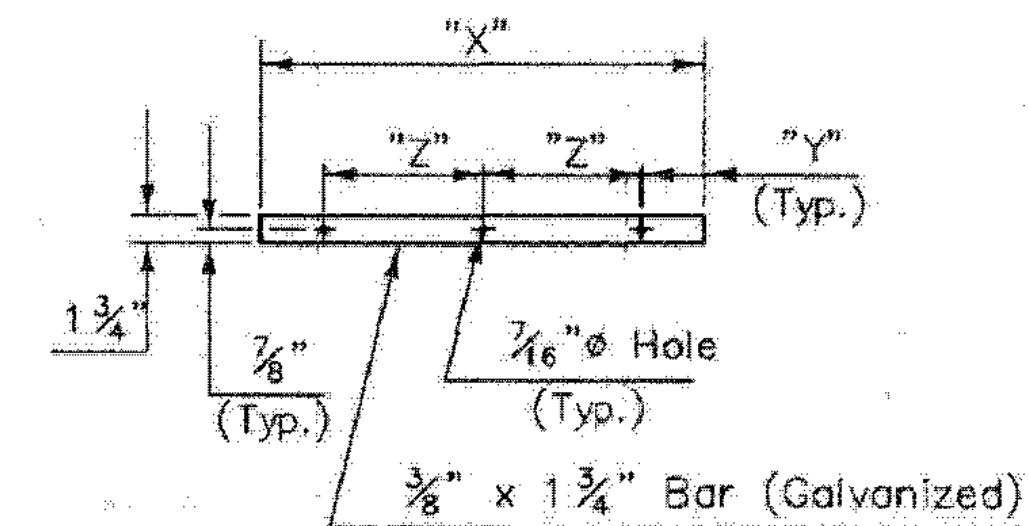


**BAR DETAILS**  
SCALE: 1' = 1'-0"


NOTES:

1. THE CONTRACTOR SHOULD BID ON THE COMPLETE REMOVAL AND TOTAL REPLACEMENT OF THE ENTIRE EXISTING DRAIN TROUGHS AND ALL RELATED HARDWARE AND COMPONENTS. THE ENGINEER WILL ONLY EVALUATE THE EXISTING CONDITIONS OF THE DRAIN TROUGH SUPPORTS ATTACHED TO THE BEAMS INCLUDING THE 1/2" X 4" CRADLES FOR POSSIBLE REUSE.
2. FABRIC USED IN THE CONSTRUCTION OF THE DRAIN TROUGHS SHALL BE A THREE PLY PREFORMED FABRIC MATERIAL AS SPECIFIED IN SUBSECTION 707.07. IT WILL BE ONE CONTINUOUS STRIP. THE APPROXIMATE WIDTH FOR A 5" DEEP TROUGH IS ABOUT 16". HOWEVER A VARYING WIDTH MAY BE REQUIRED TO MAINTAIN A MINIMUM FLOW LINE GRADE OF 1/2" PER FOOT. A STEEPER GRADE IS DESIRABLE. THE ENGINEER WILL DETERMINE THE GRADE FOR EACH TROUGH BASED ON FIELD CONDITIONS.
3. 1/4" (NOMINAL DIAMETER) STANDARD WEIGHT GALVANIZED PIPE SHALL BE CONTINUOUS FOR THE ENTIRE LENGTH OF TROUGH. ALL COSTS FOR THE PIPE AND COUPLINGS, SUPPORTS, CRADLES, SCREWS AND RELATED HARDWARE SHALL BE INCLUDED IN THE UNIT BID PRICE FOR THE APPROPRIATE CONTRACT 900.640 DRAIN TROUGH ITEM.
4. THE ENGINEER WILL DETERMINE THE CROSS SLOPE OF EACH DRAIN AND REQUIRED TOTAL LENGTH OF EACH NEW DRAIN TROUGH LOCATION PRIOR TO REMOVAL OF THE EXISTING TROUGH.


The Contractor shall field verify that the "X" dimension is correct prior to fabricating the bars

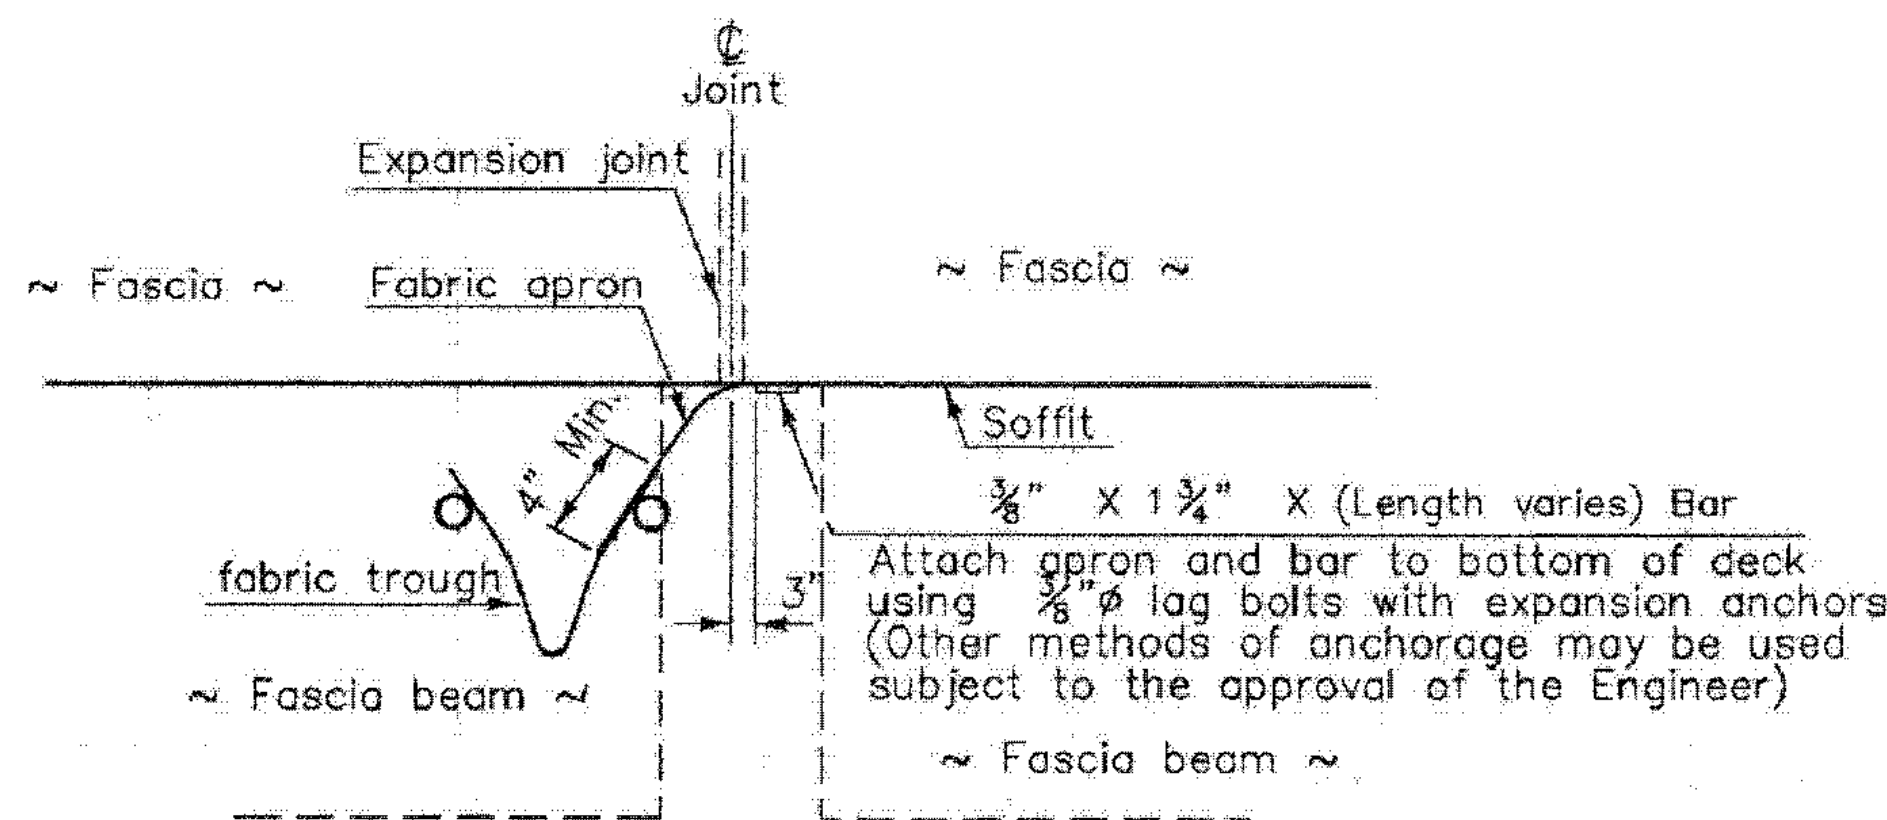

**ELEVATION VIEW OF APRON AT FASCIA**  
N.T.S.

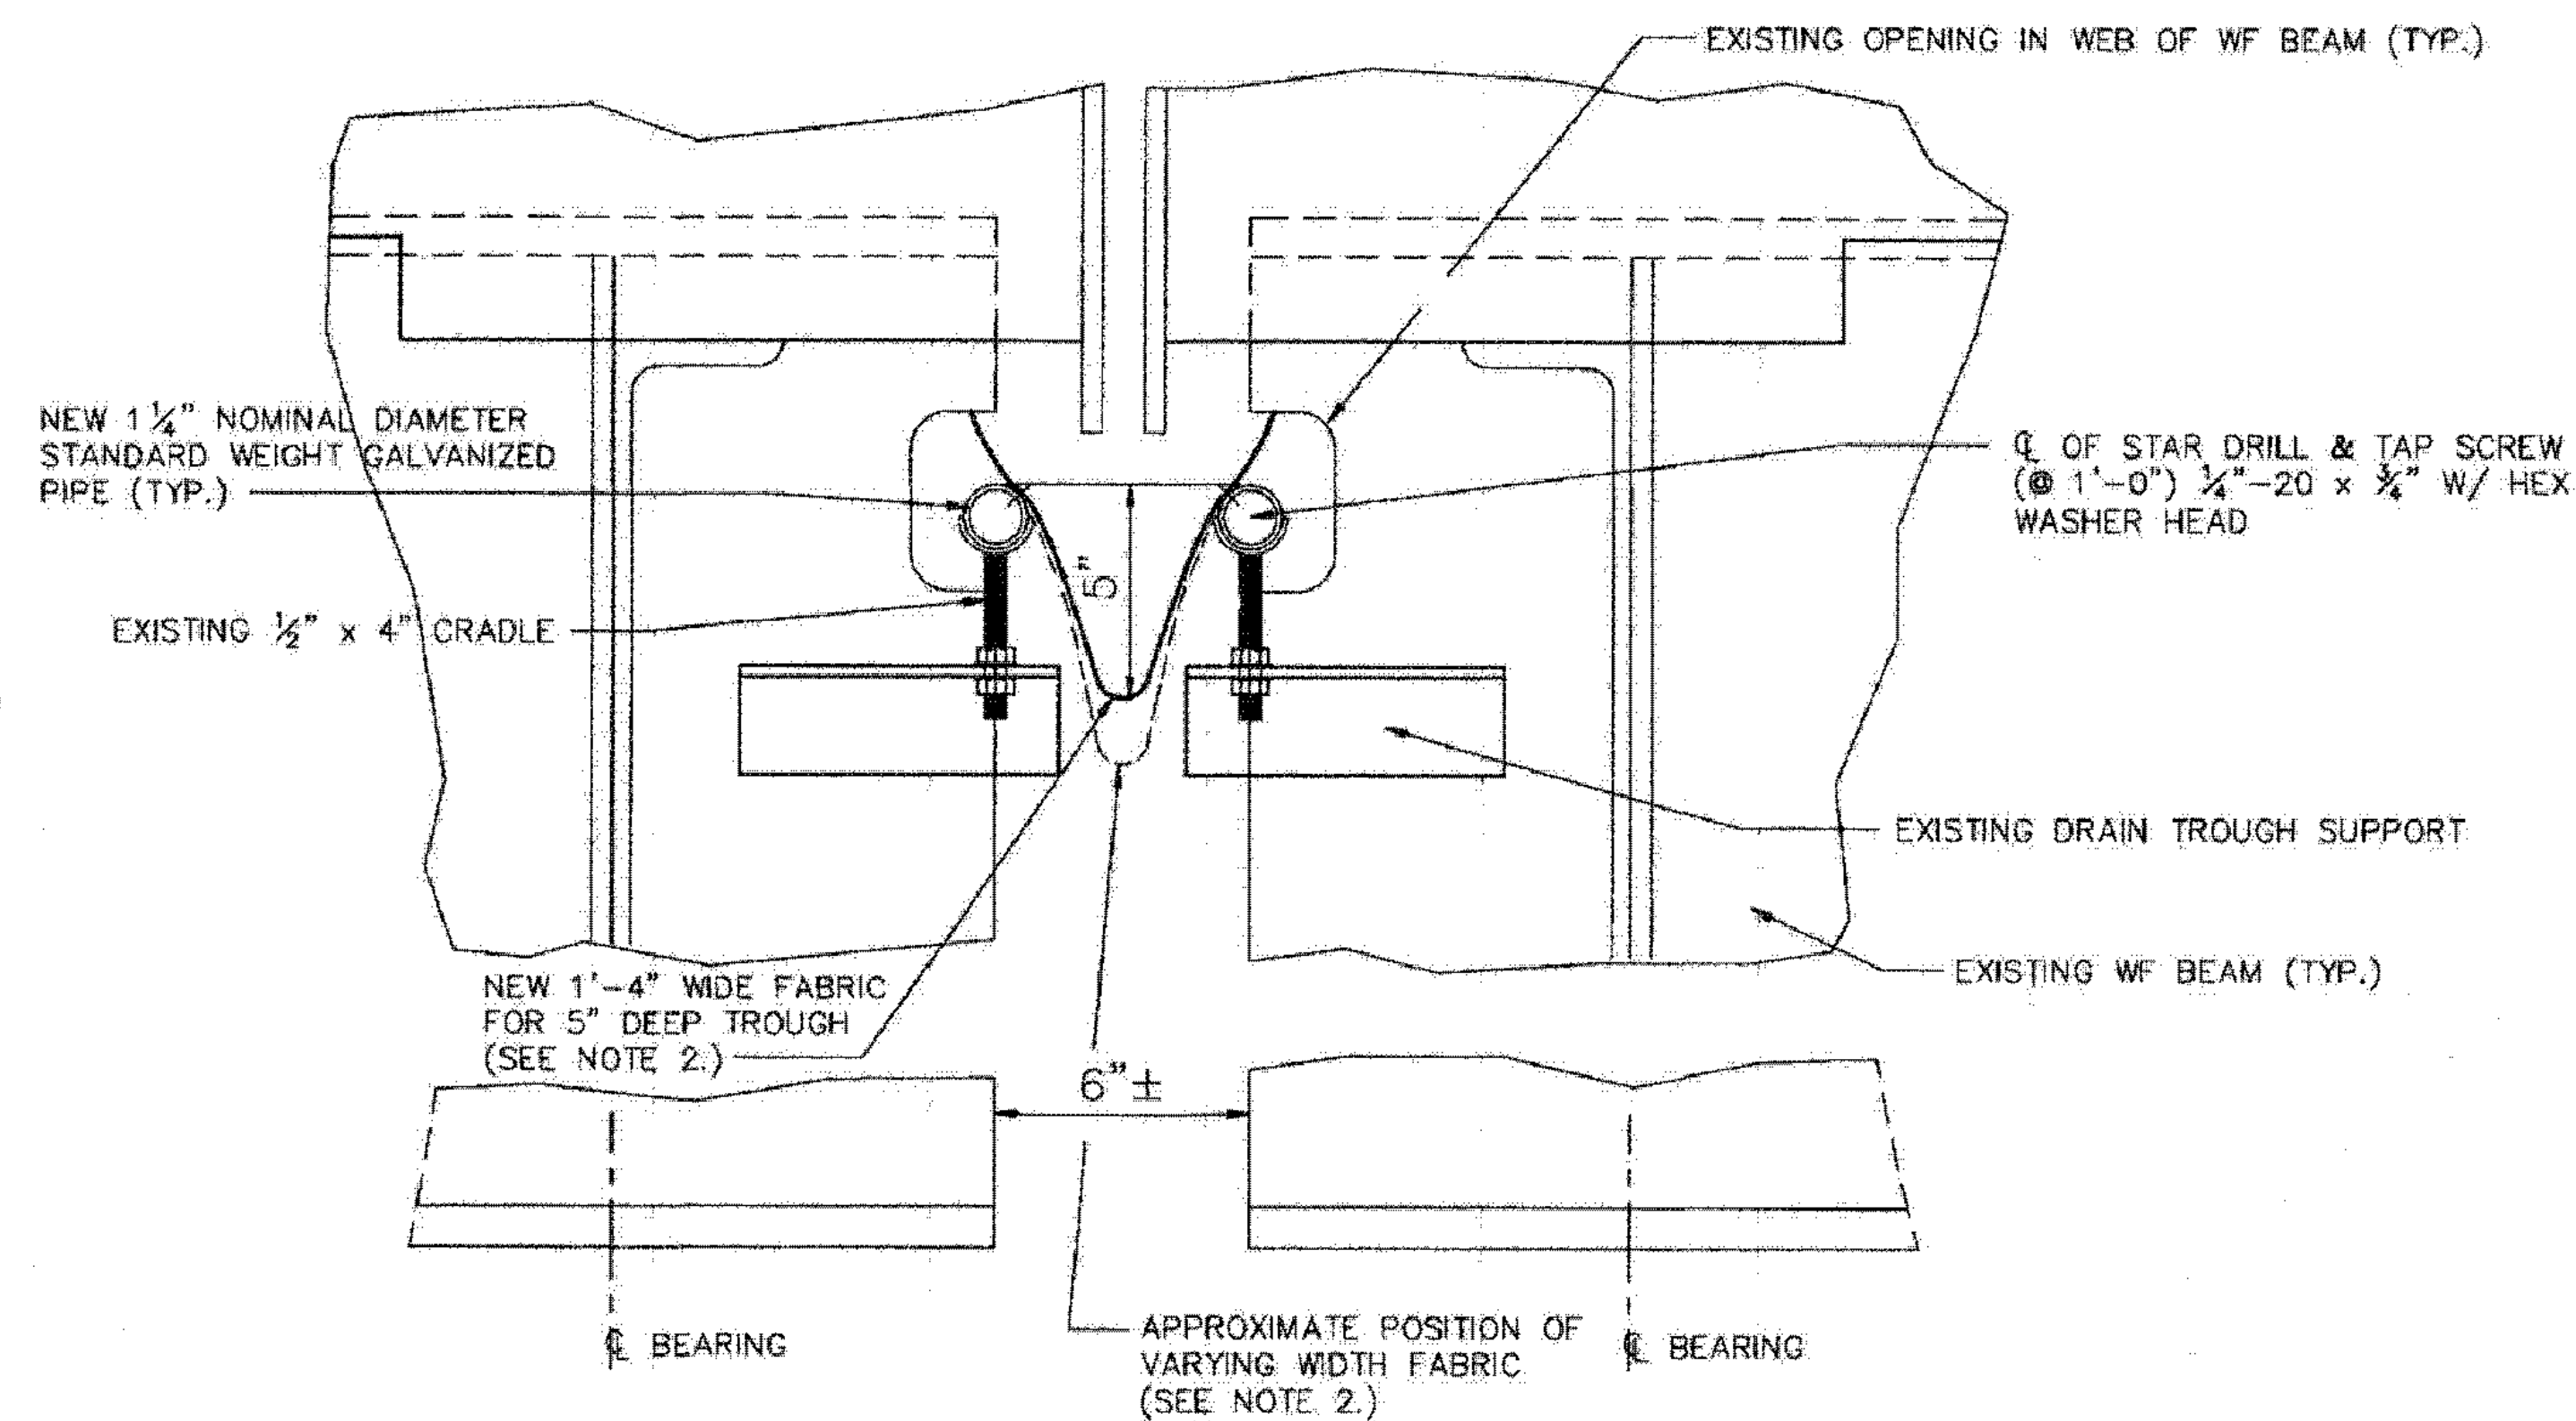

**DRAIN TROUGH REPLACEMENT DETAIL**  
N.T.S.

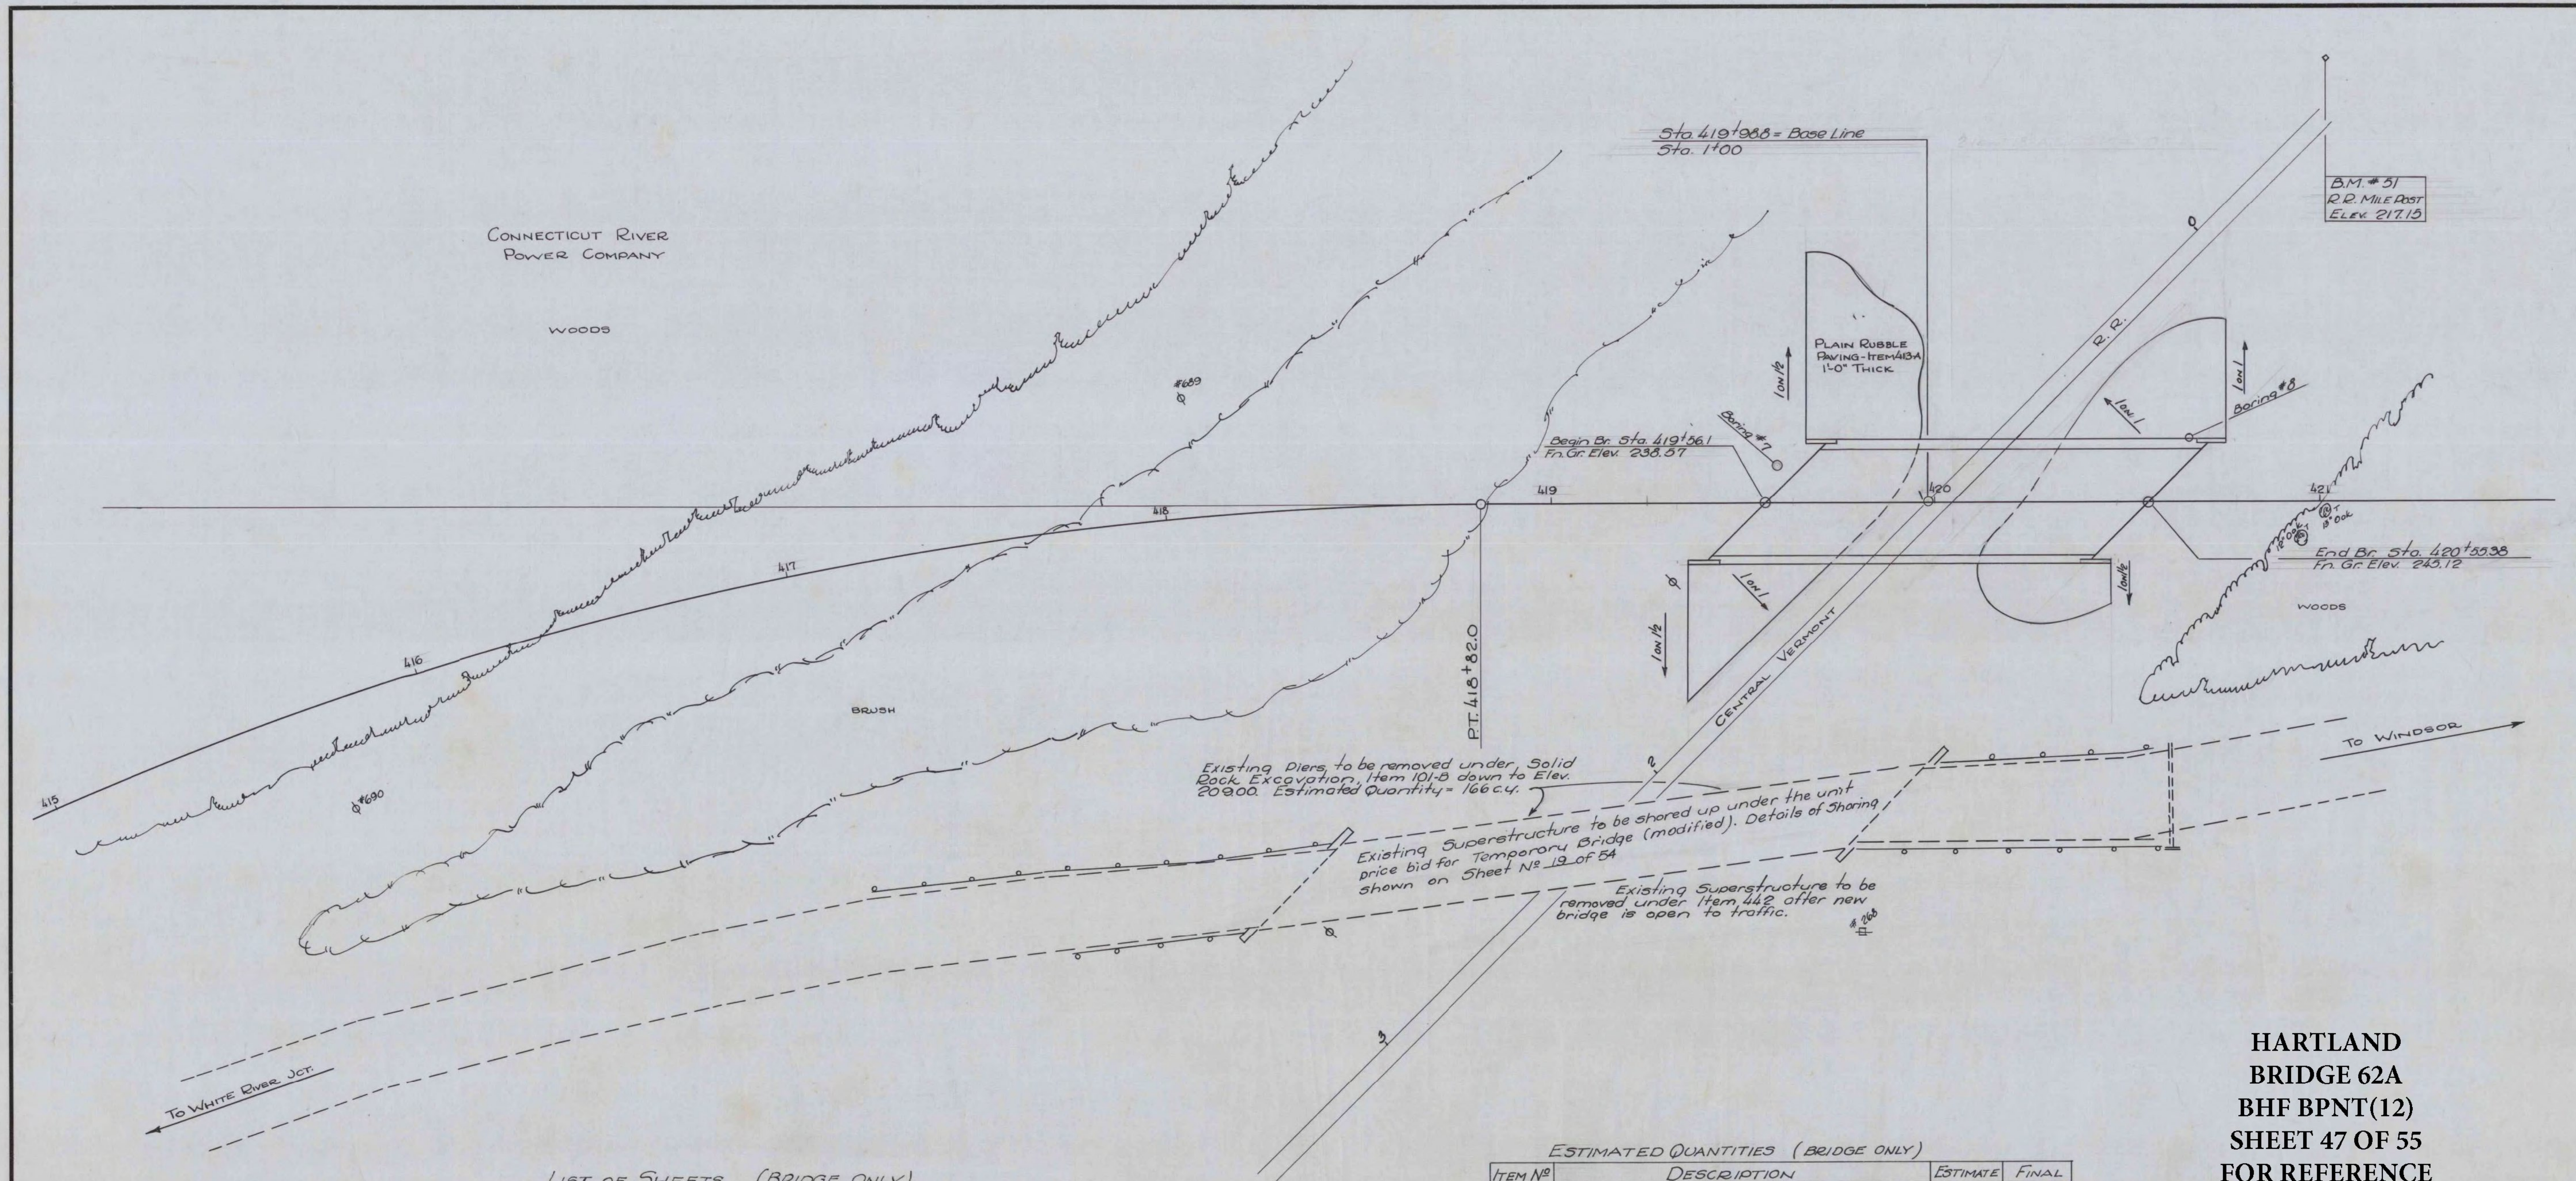

LIST OF SHEETS (BRIDGE ONLY)

11	Plan Sheet (1"=20'-0")
12	Profile & Boring Sheet (1"=20'-0")
13	Earthwork Sheet
14	Superstructure Details
15	Bridge Railing & Spiral Welding Details
16	Abutment No. 1 Details
17	Abutment No. 2 Details
18	Reinforcing Steel Details
19	Temporary Shoring - Overpass over C.V.R.R.
20	Std. Dwg. 5B 20 (Det. D, E, H, J, K, & L)
21	Std. Dwg. 5B 11 (Barricades, Signs & Lights)
22-23	Structure Sections



ESTIMATED QUANTITIES (BRIDGE ONLY)

ITEM NO	DESCRIPTION	ESTIMATE	FINAL
101-B	Solid Rock Excavation	183 cy	168'
102	Borrow	1428 cy	1380'
106-C	Unclass. Channel Excavation	123 cy	728'
107	Structure Excavation	45 cy	42'
361-B	Bituminous Conc. Pavement (Class I)	41 tons	40'
401-B	Concrete Class "B" (modified)	232 cy	223'
402	Reinforcing Steel	28455 lbs	28,508
402-A	Spiral Reinforcement	1120 lbs	995
403-A	Structural Steel	158000 lbs	155,842
413-A	Plain Rubble Paving	281 cy	517'
441	Temporary Bridge (modified)	1 ls	1'
442	Removal of Present Superstructure	1 ls	1'
501	Furn. Equipment for Driving Piles	1 ls	1'
502-B	Treated Timber Piling	1830 lf	1843'
502-B1	Cutoffs, Treated Timber Piling	180 lf	403'
502-C	Metal Shoes for Timber Piling	60 ea	60'
556-C	Granite Bridge Curb	199 lf	199'
572	Bridge Railing	188 lf	188'


HARTLAND  
 BRIDGE 62A  
 BHF BPNT(12)  
 SHEET 47 OF 55  
 FOR REFERENCE  
 ONLY

HARTLAND  
 Project FG. 77(11)  
 Sheet 11 of 54 Sheets


Weight of Hammer 350# - Thickness of Shell = 3/8"  
 Drop of Hammer = 24" - Diameter of Casing = 2 1/2"

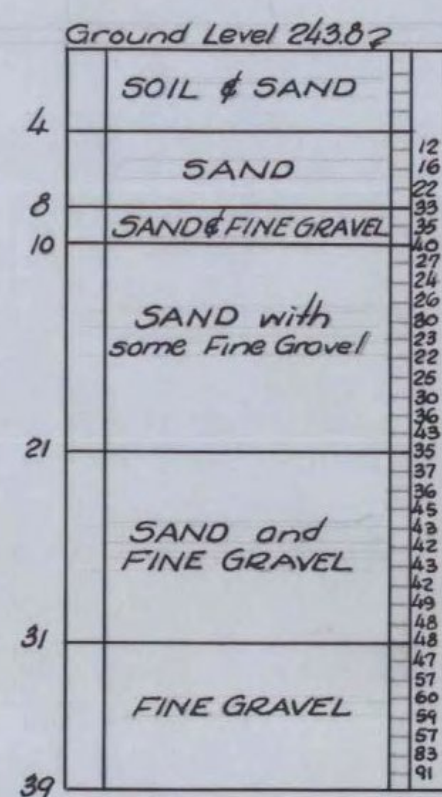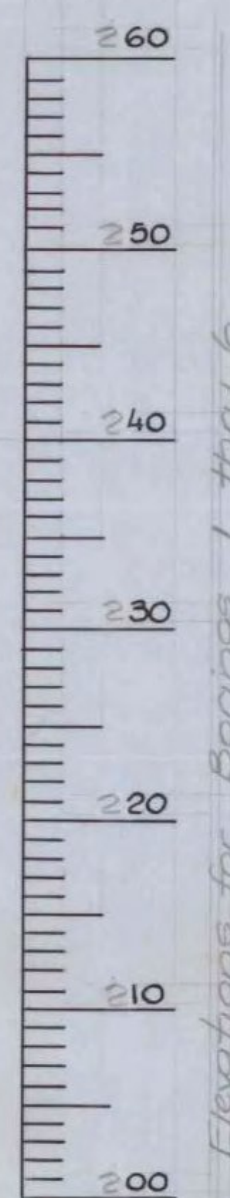


BORING #1

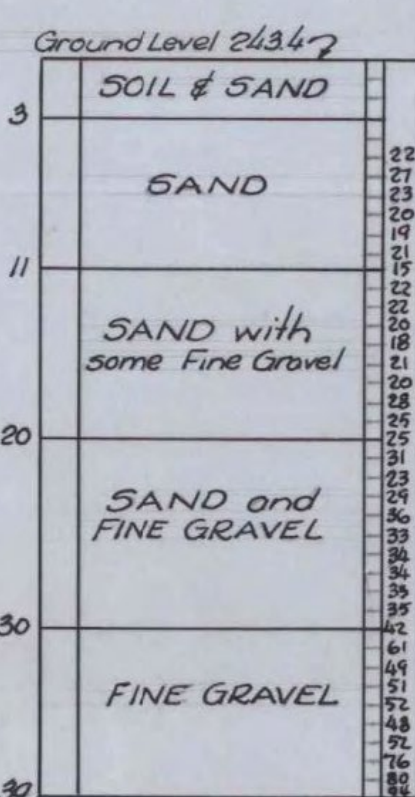


BORING #2

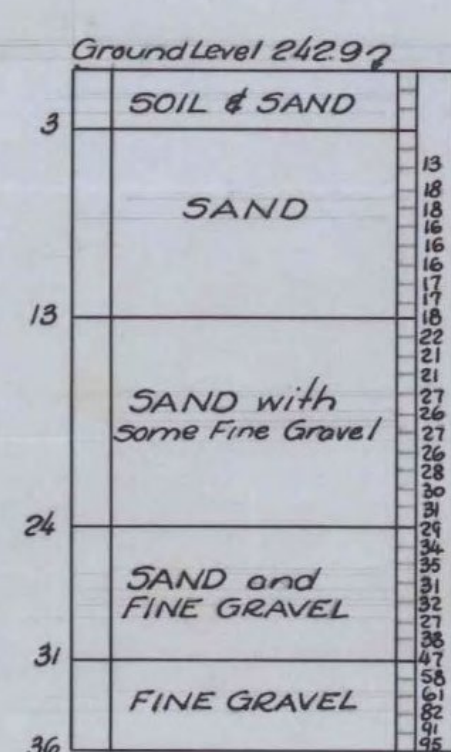


BORING #3

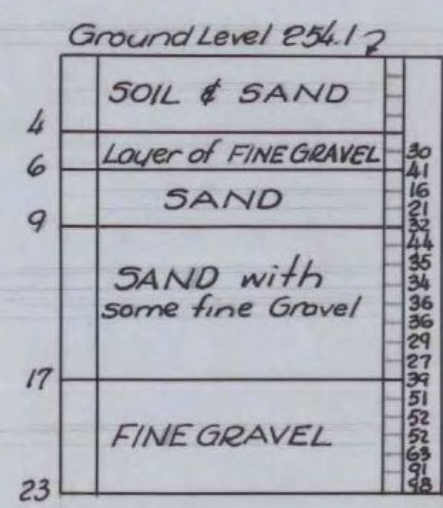

BORING #4


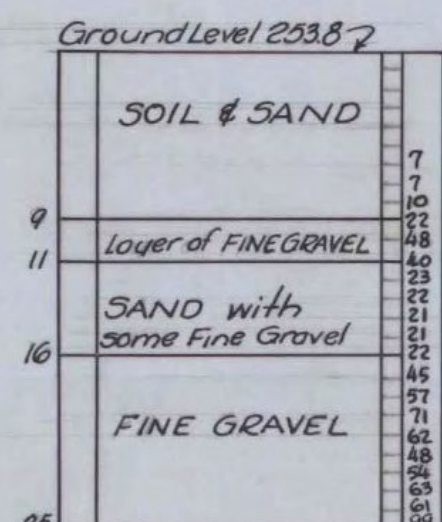


BORING #5

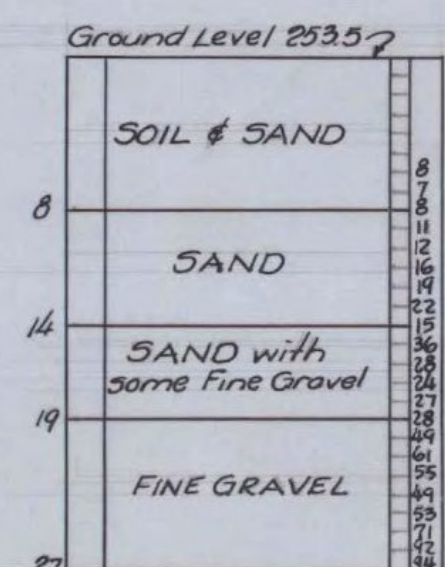


BORING #6

BORINGS 1 TO 6 NOT USED

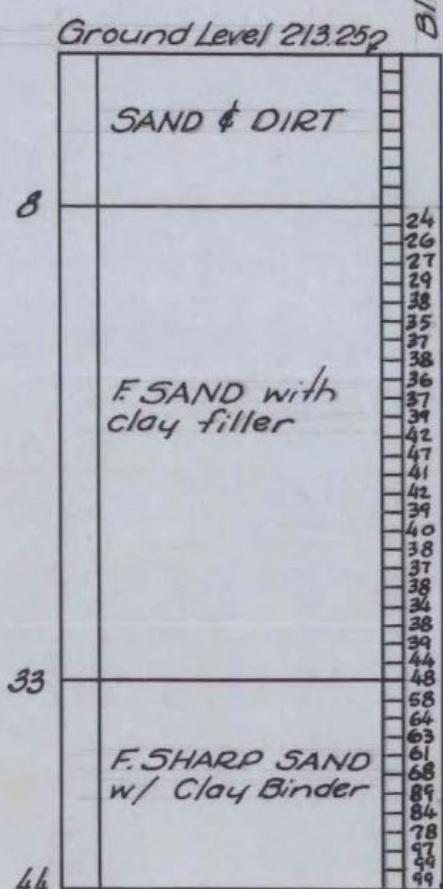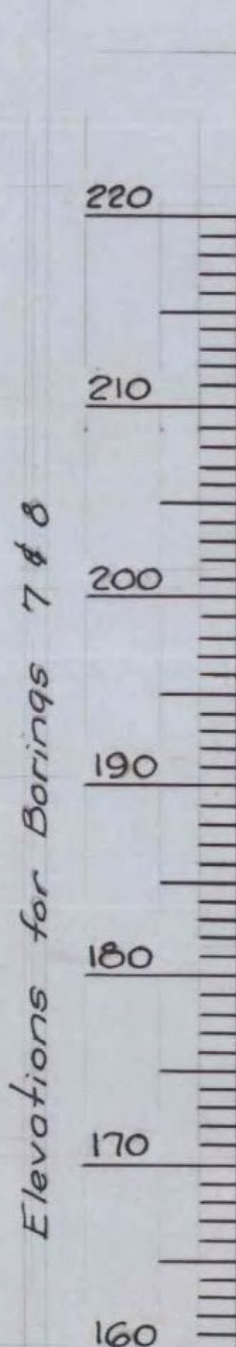


BORING #7

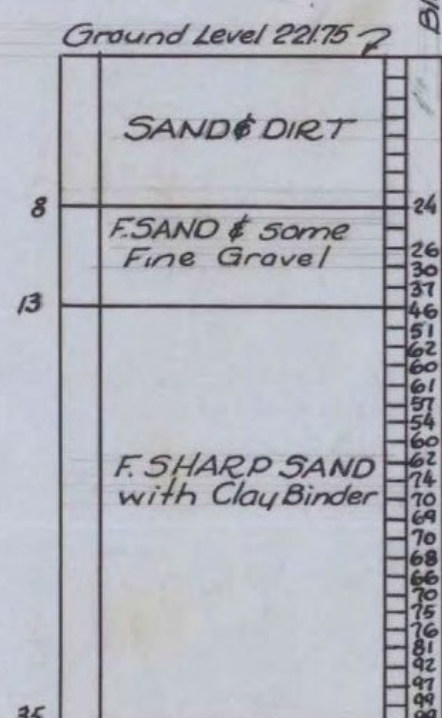

BORING #8

FOR LOCATION OF BORINGS 7 & 8 SEE SHEET N# 11 OF 54


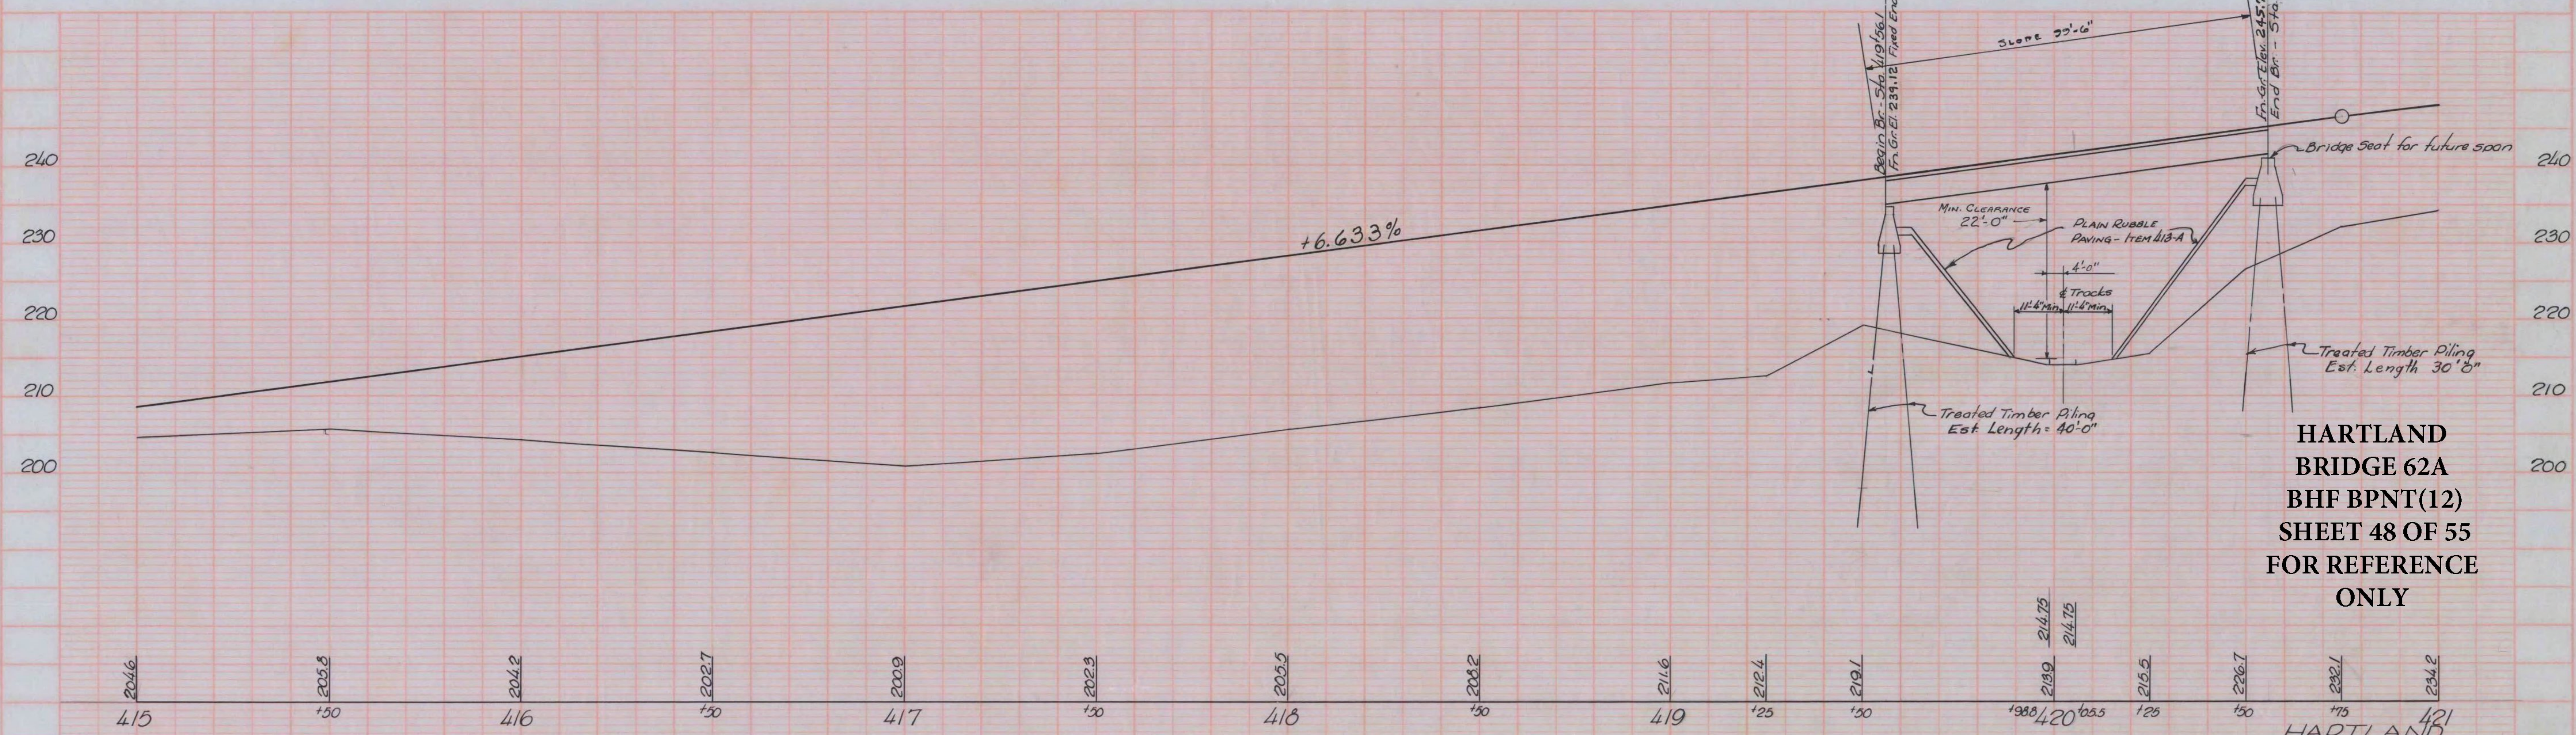


HARTLAND  
 BRIDGE 62A  
 BHF BPNT(12)  
 SHEET 48 OF 55  
 FOR REFERENCE  
 ONLY


HARTLAND  
 F.G. 77 (11)  
 Sheet 12 of 54

SCALE  
 1" = 10'  
 1/4" = 1'


DATE  
 4/30  
 5/30

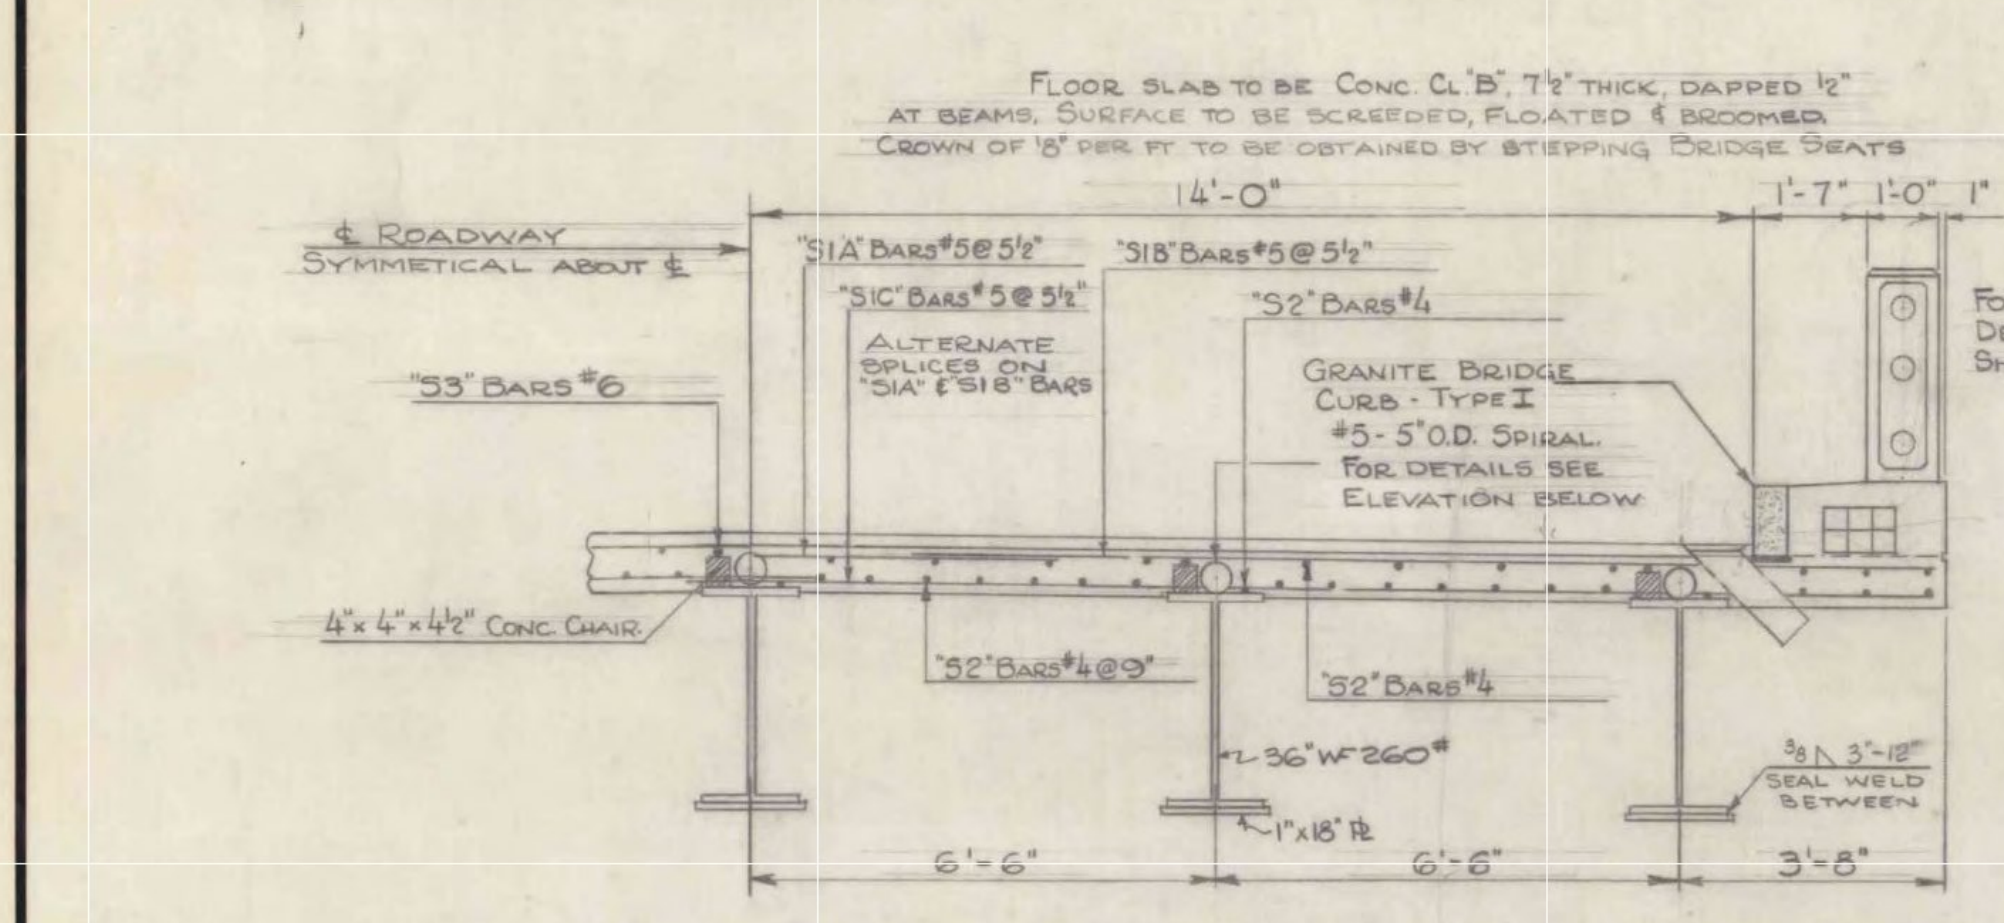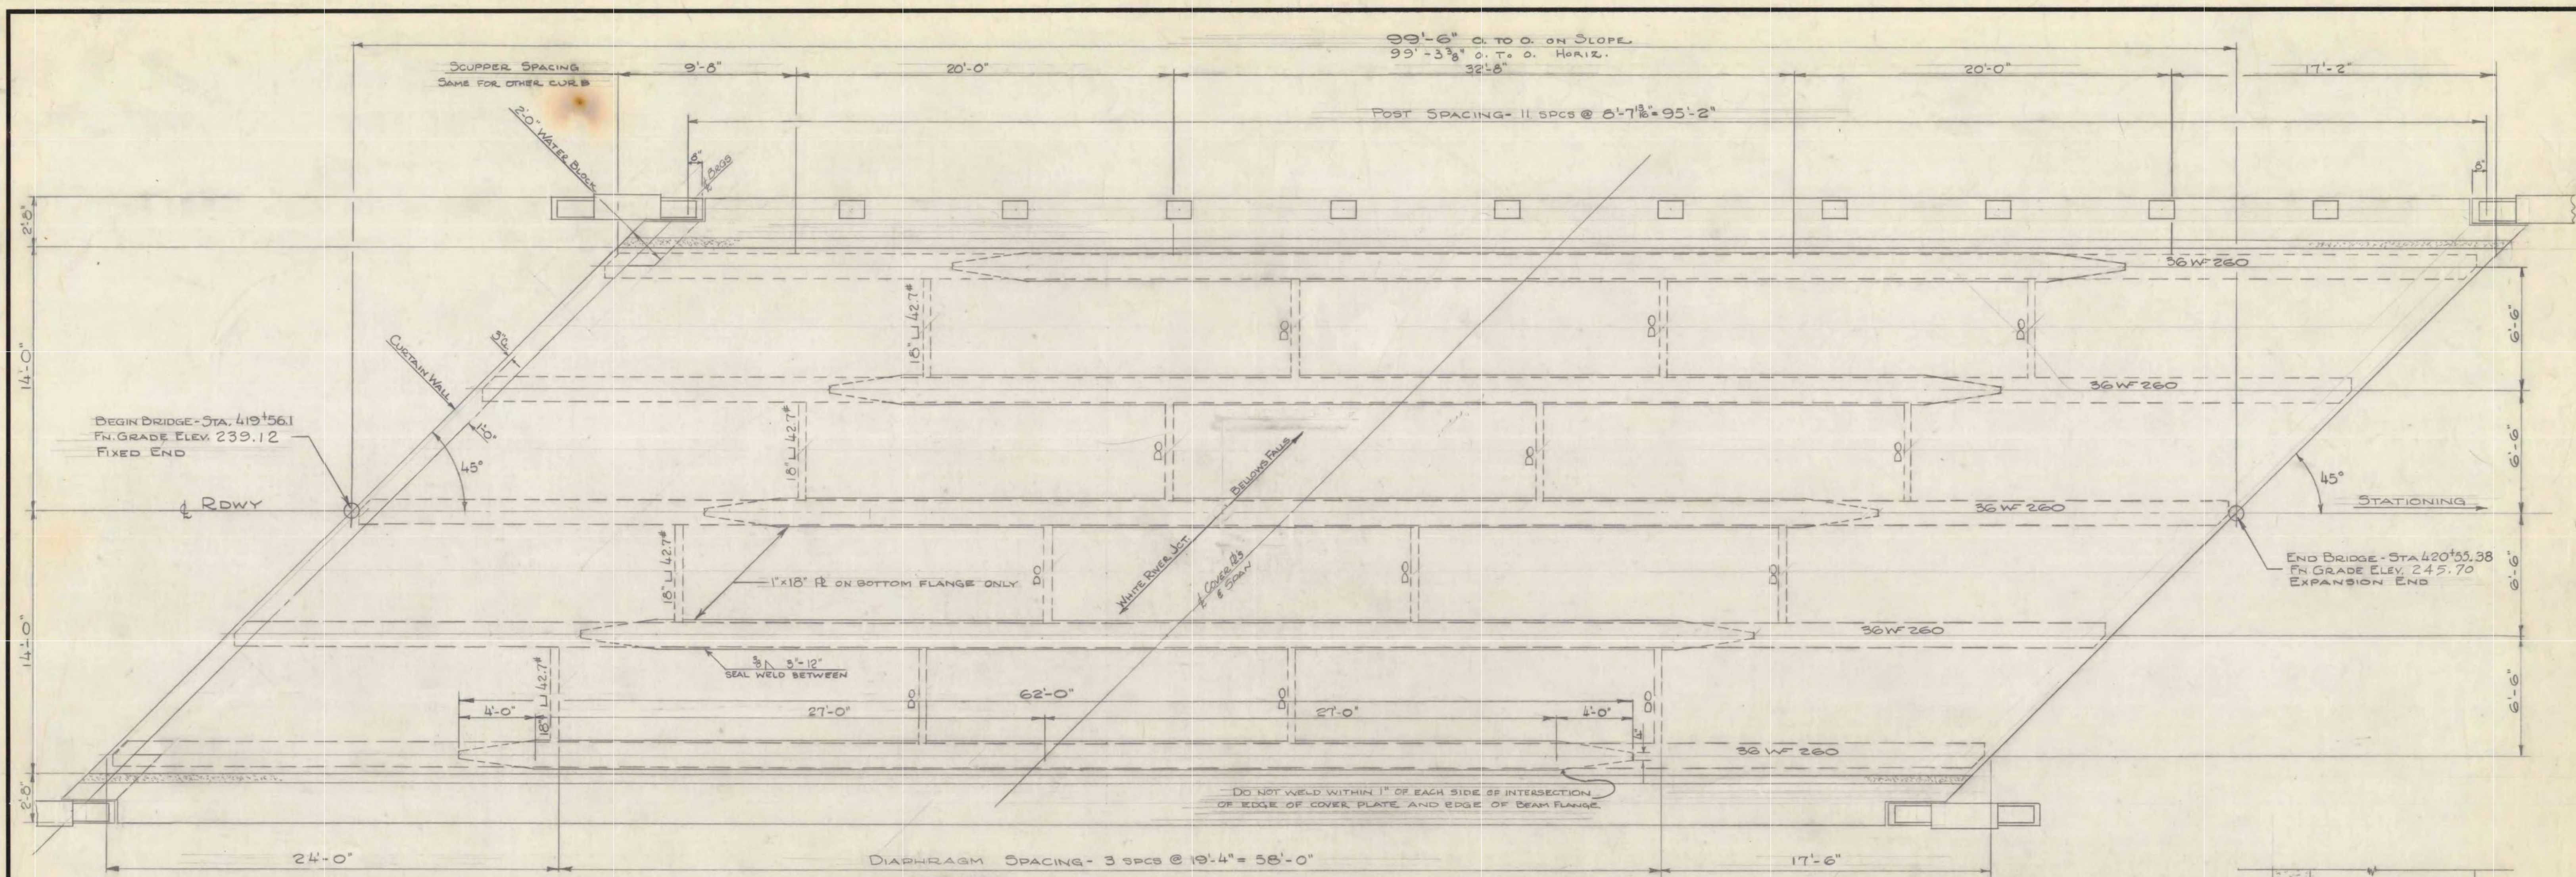


TYPICAL HALF SECTION  
Scale 3/8" = 1'-0"

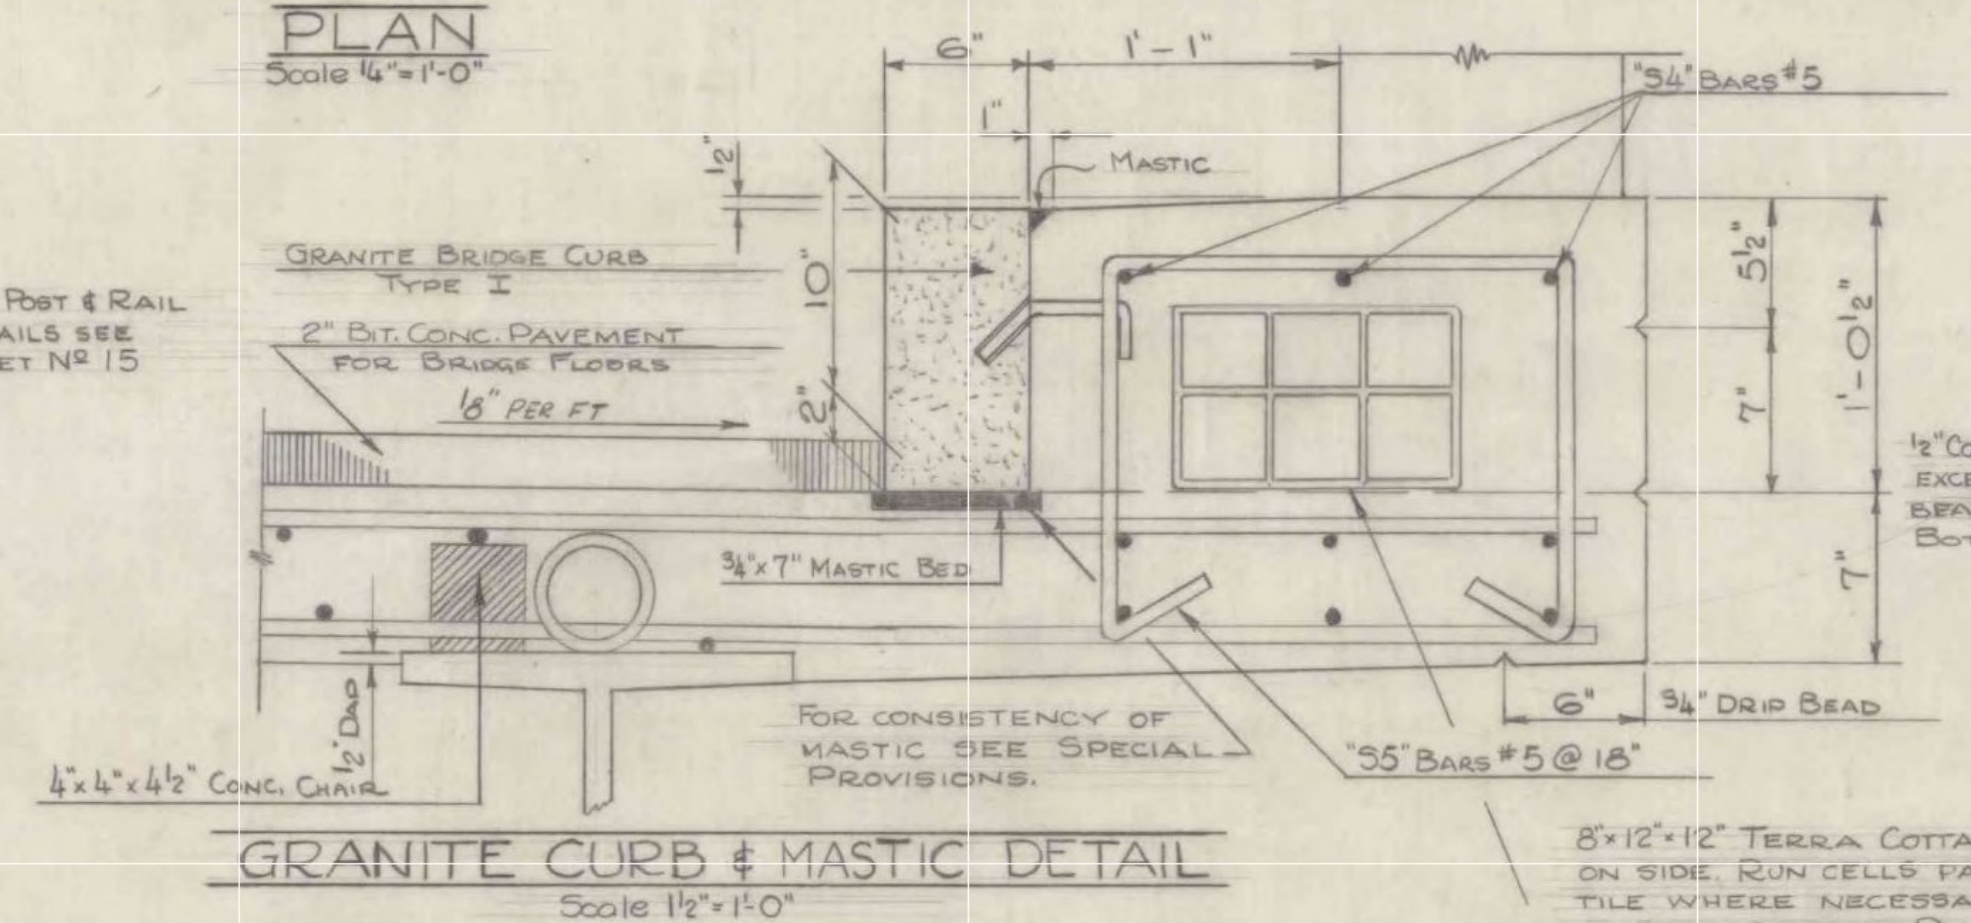


GRANITE CURB & MASTIC DETAIL  
Scale 1/2" = 1'-0"

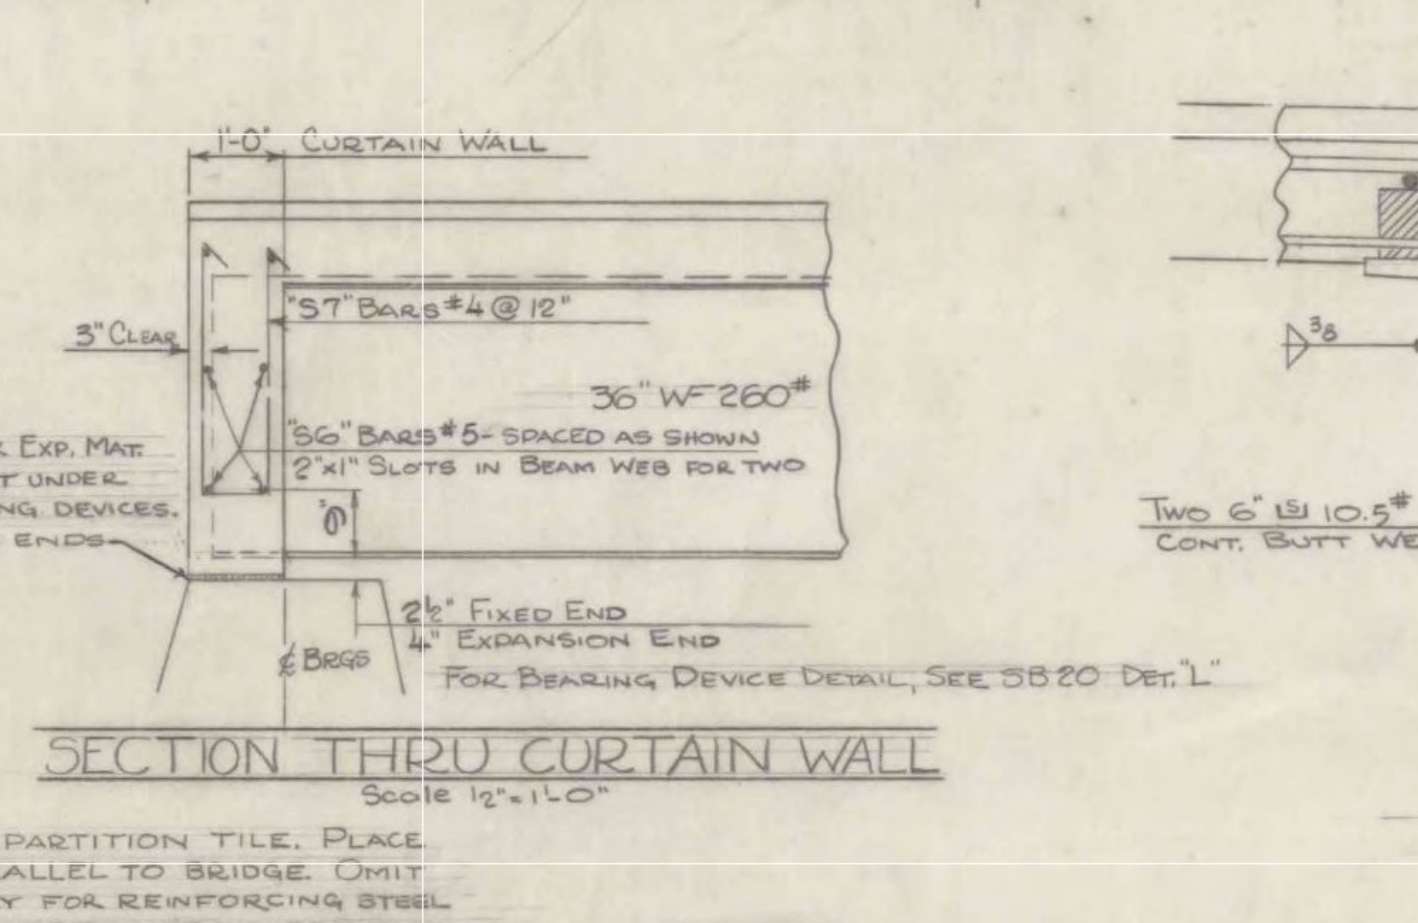

SECTION THRU CURTAIN WALL  
Scale 1/2" = 1'-0"

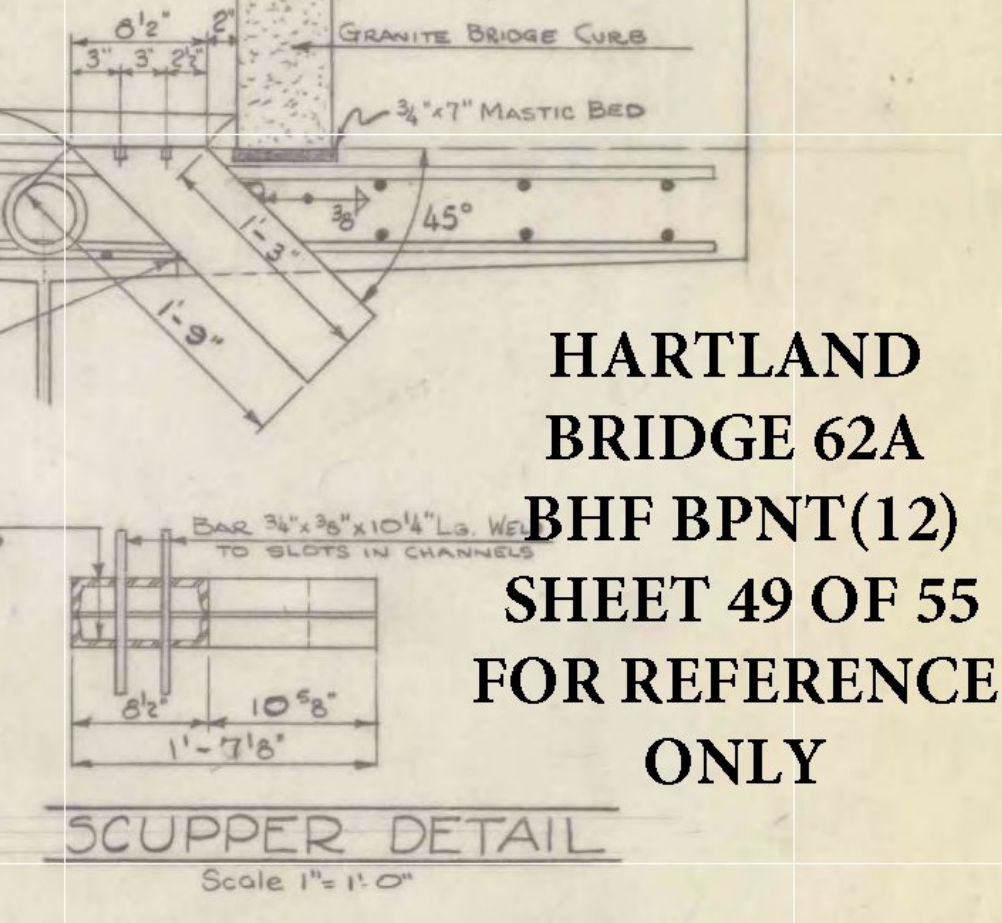


SCUPPER DETAIL  
Scale 1/2" = 1'-0"

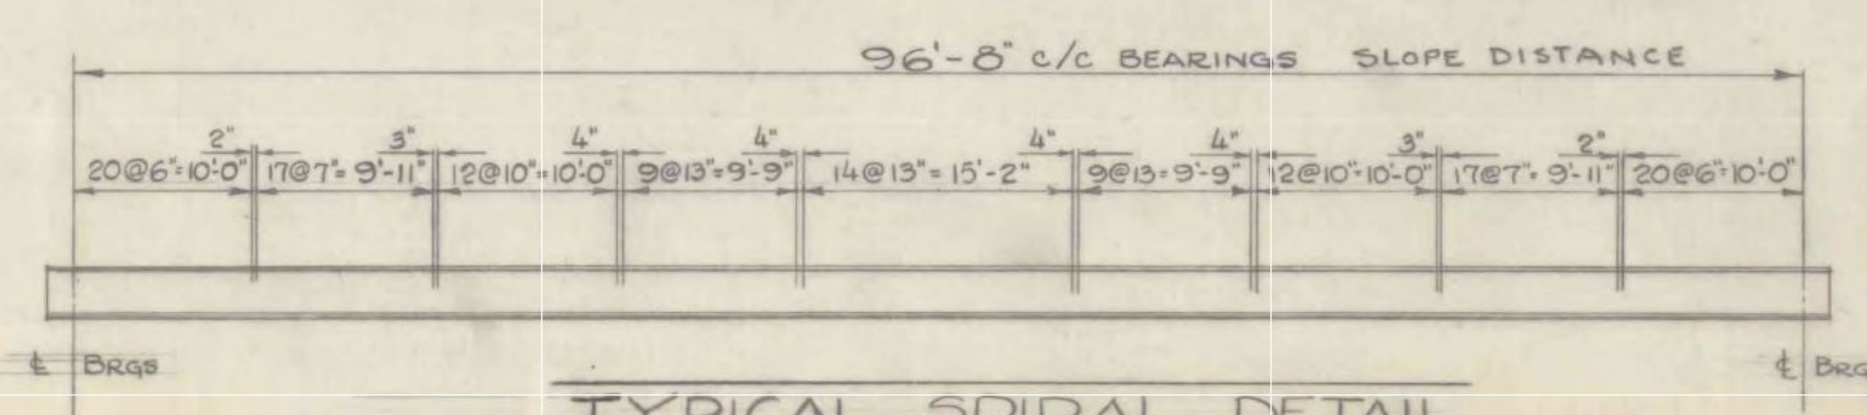

TYPICAL SPIRAL DETAIL  
Scale 3/32" = 1'-0"

NOTE: - FOR SPIRAL WELDING DETAILS SEE BRIDGE RAILING DETAIL SHEET # 15

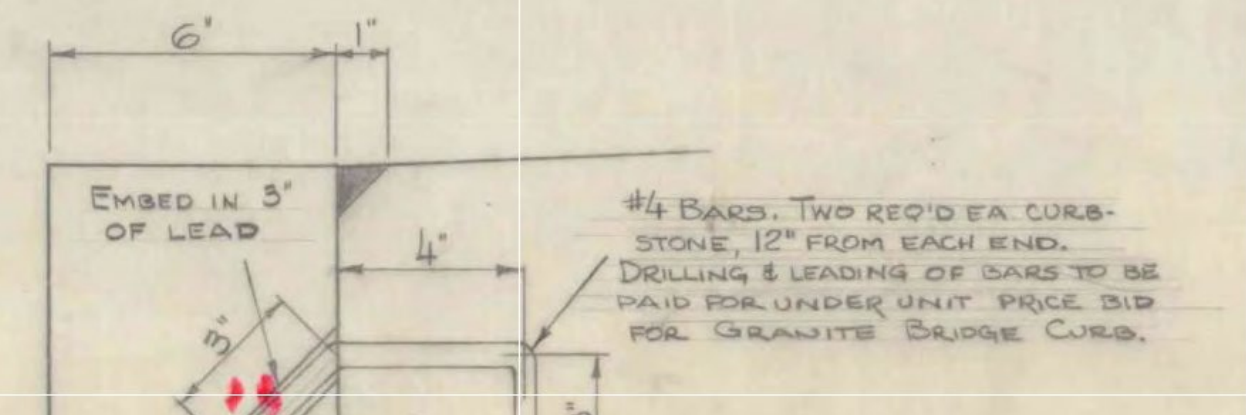

CURB DETAIL  
Scale 3/8" = 1'-0"

8" x 12" x 12" TERRA COTTA PARTITION TILE. PLACE ON SIDE RUN CELLS PARALLEL TO BRIDGE. OMIT TILE WHERE NECESSARY FOR REINFORCING STEEL IN RAILING POSTS. PLUG OPENINGS TO PREVENT HOLLOW TILE FROM FILLING WITH CONCRETE. TILE TO BE PAID FOR UNDER UNIT PRICE BID FOR CONG. CL. #5. ITEM 401-B. IN COMPUTING THE VOLUME OF CONCRETE, NO DEDUCTION SHALL BE MADE FOR THE VOLUME DISPLACED BY THE TILE.

NOTES:-

ALL BEAMS TO BE ROLLED TO A TRUE CIRCULAR CAMBER THE FULL LENGTH OF BEAM. THE MIDDLE ORDINATE SHALL BE 3 3/8". CONCRETE SHALL BE CLASS B MODIFIED.  
ONE HALF BAG ADDITIONAL CEMENT OVER AND ABOVE THE AMOUNT SHOWN IN STATE OF VERMONT DEPT. OF HIGHWAYS, STD. SPECIFICATIONS FOR ROAD AND BRIDGE CONSTRUCTION DATED NOV. 1948, SHALL BE ADDED TO EACH CUBIC YARD OF CLASS B, C, & D CONCRETE.  
SEE SPECIAL PROVISIONS FOR CURING CONCRETE.

FINAL QUANT.

40	361-B BITUMINOUS CONC. PAVEMENT (CLASS I)	41 TONS
105	401-B CONCRETE, CLASS "B" (MOD.)	112 C.Y.
995	402-A SPIRAL REINFORCEMENT	1120 LBS.
153,842	403-A STRUCTURAL STEEL	158,000 LBS.
199	556-C GRANITE BRIDGE CURB	199 LF.
188	572 BRIDGE RAILING (MOD.)	188 LF.



STATE OF VERMONT  
DEPARTMENT OF HIGHWAYS

TOWN OF HARTLAND  
ROUTE No. US 5 ^{B67A} LOG STA. 204+82  
SUPERSTRUCTURE DETAILS

SCALE AS NOTED  
SURVEYED BY FUNK  
DRAWN BY JI CHECKED BY J.L.H.  
PROJECT No. FG 77 (11)  
SHEET 14 OF 54


HARTLAND  
BRIDGE 62A  
BHF BPNT(12)  
SHEET 49 OF 55  
FOR REFERENCE  
ONLY



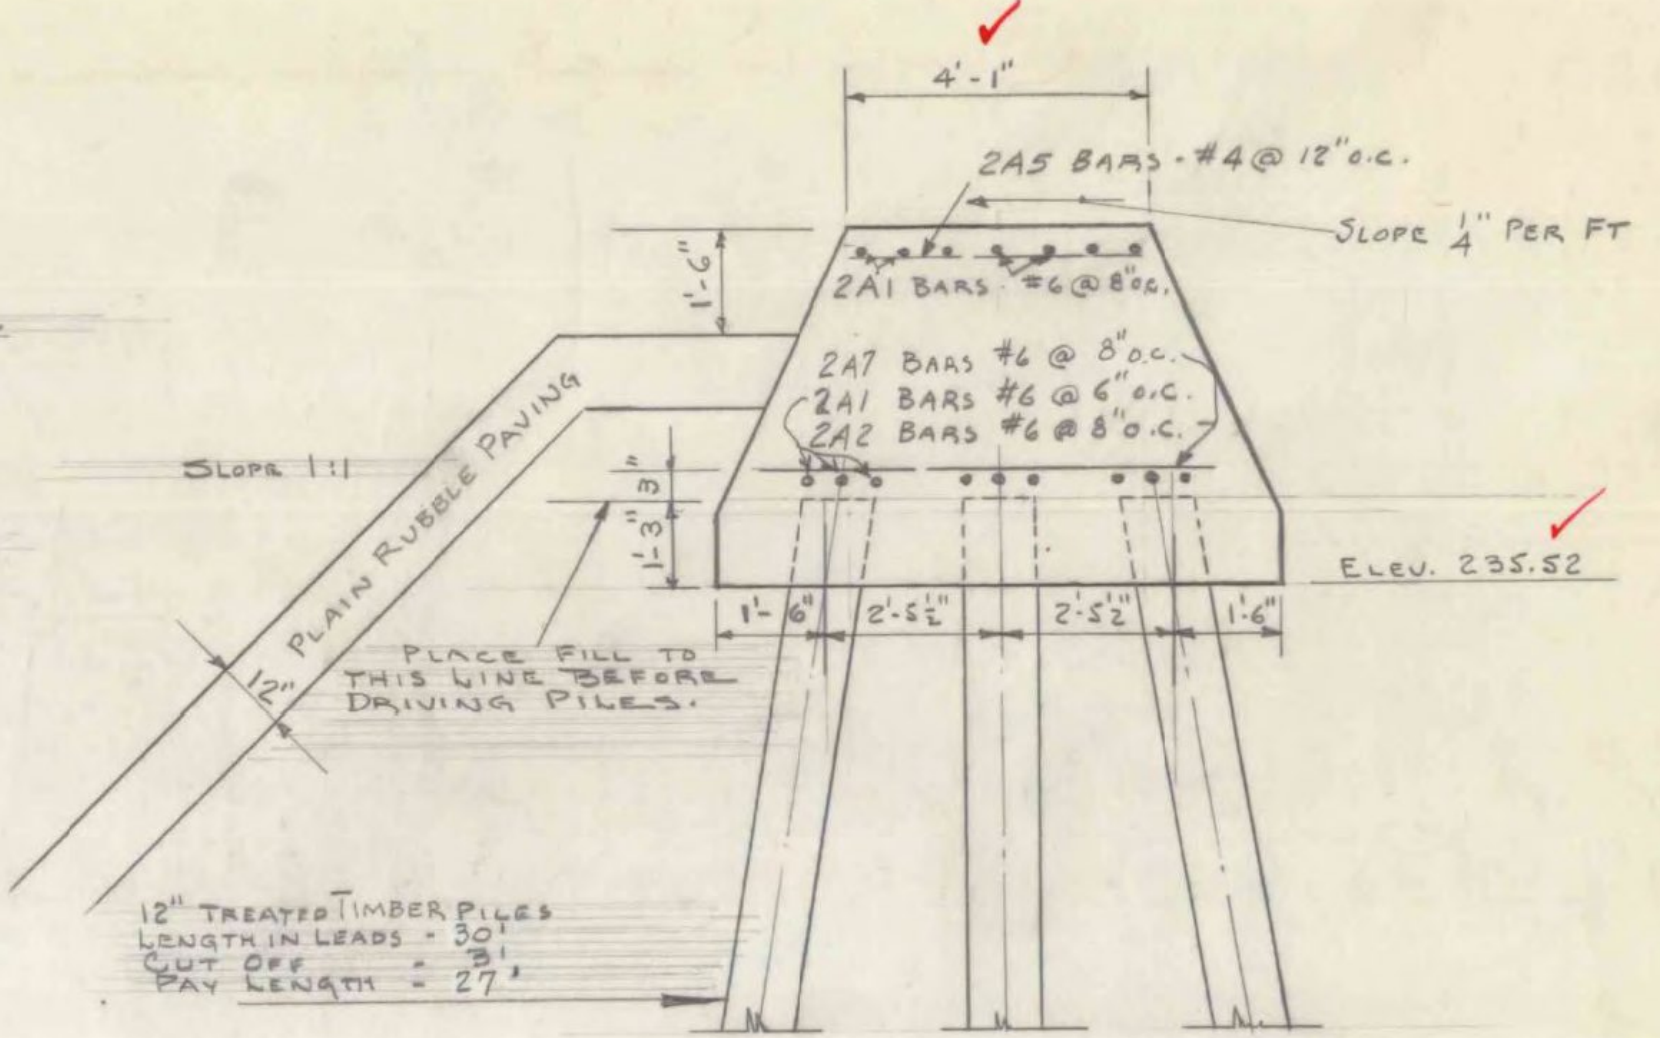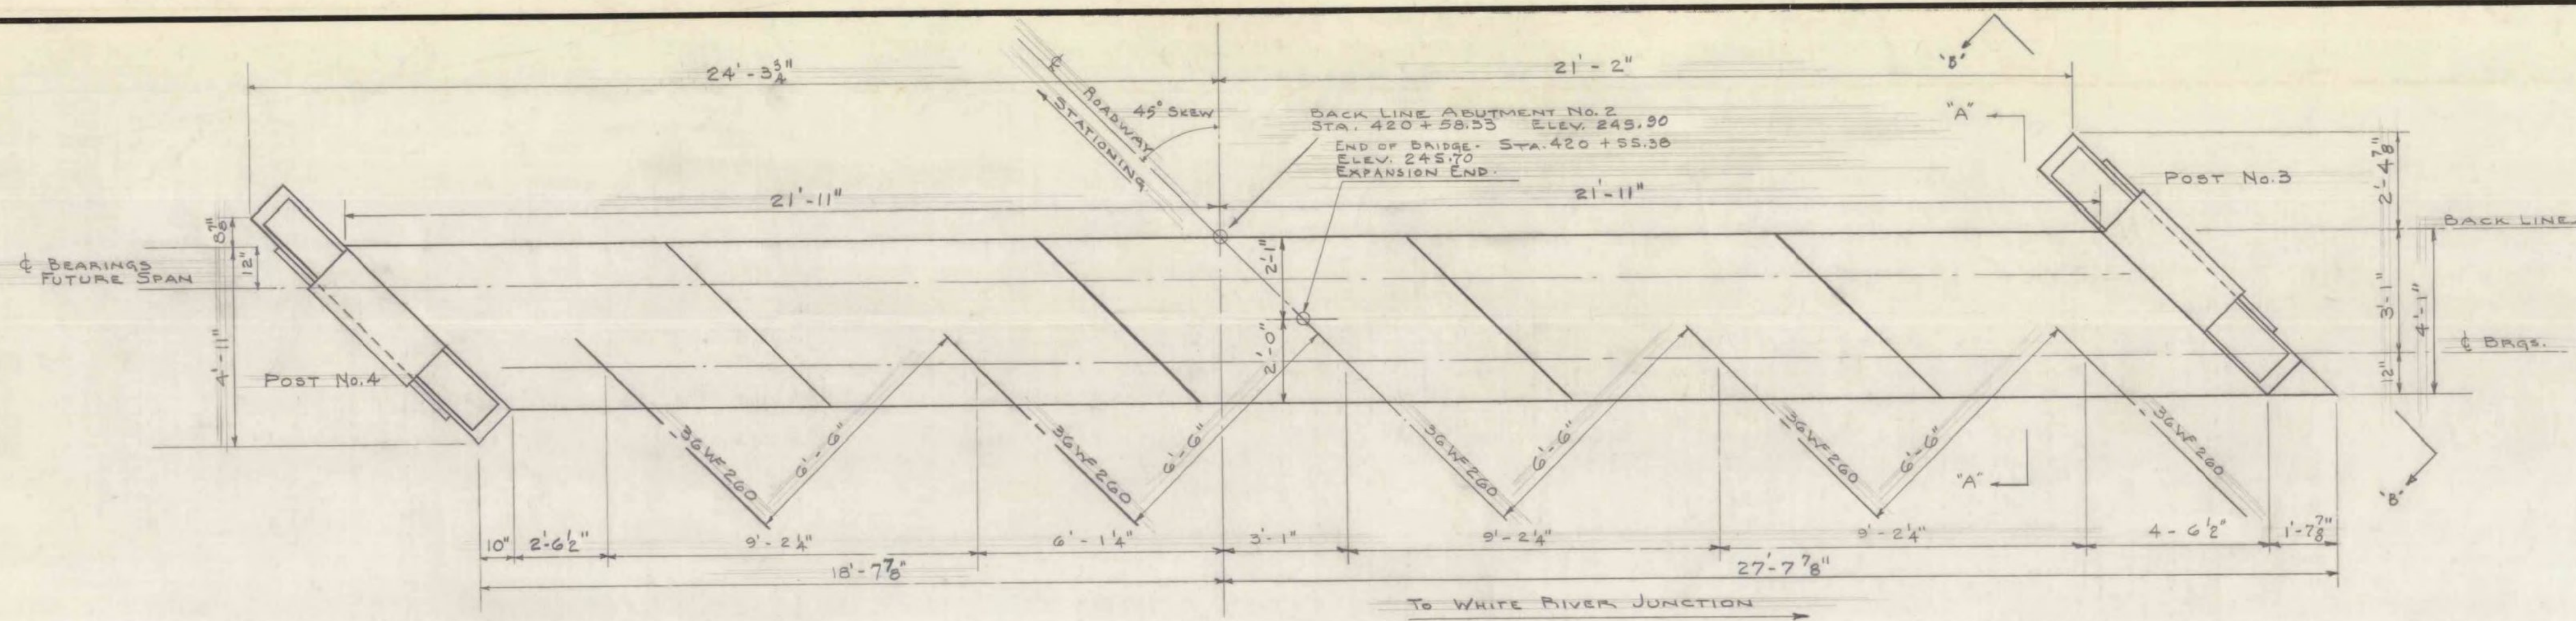


PLAN  
SCALE 3/8" = 1'-0"


SECTION A-A  
SCALE 3/8" = 1'-0"

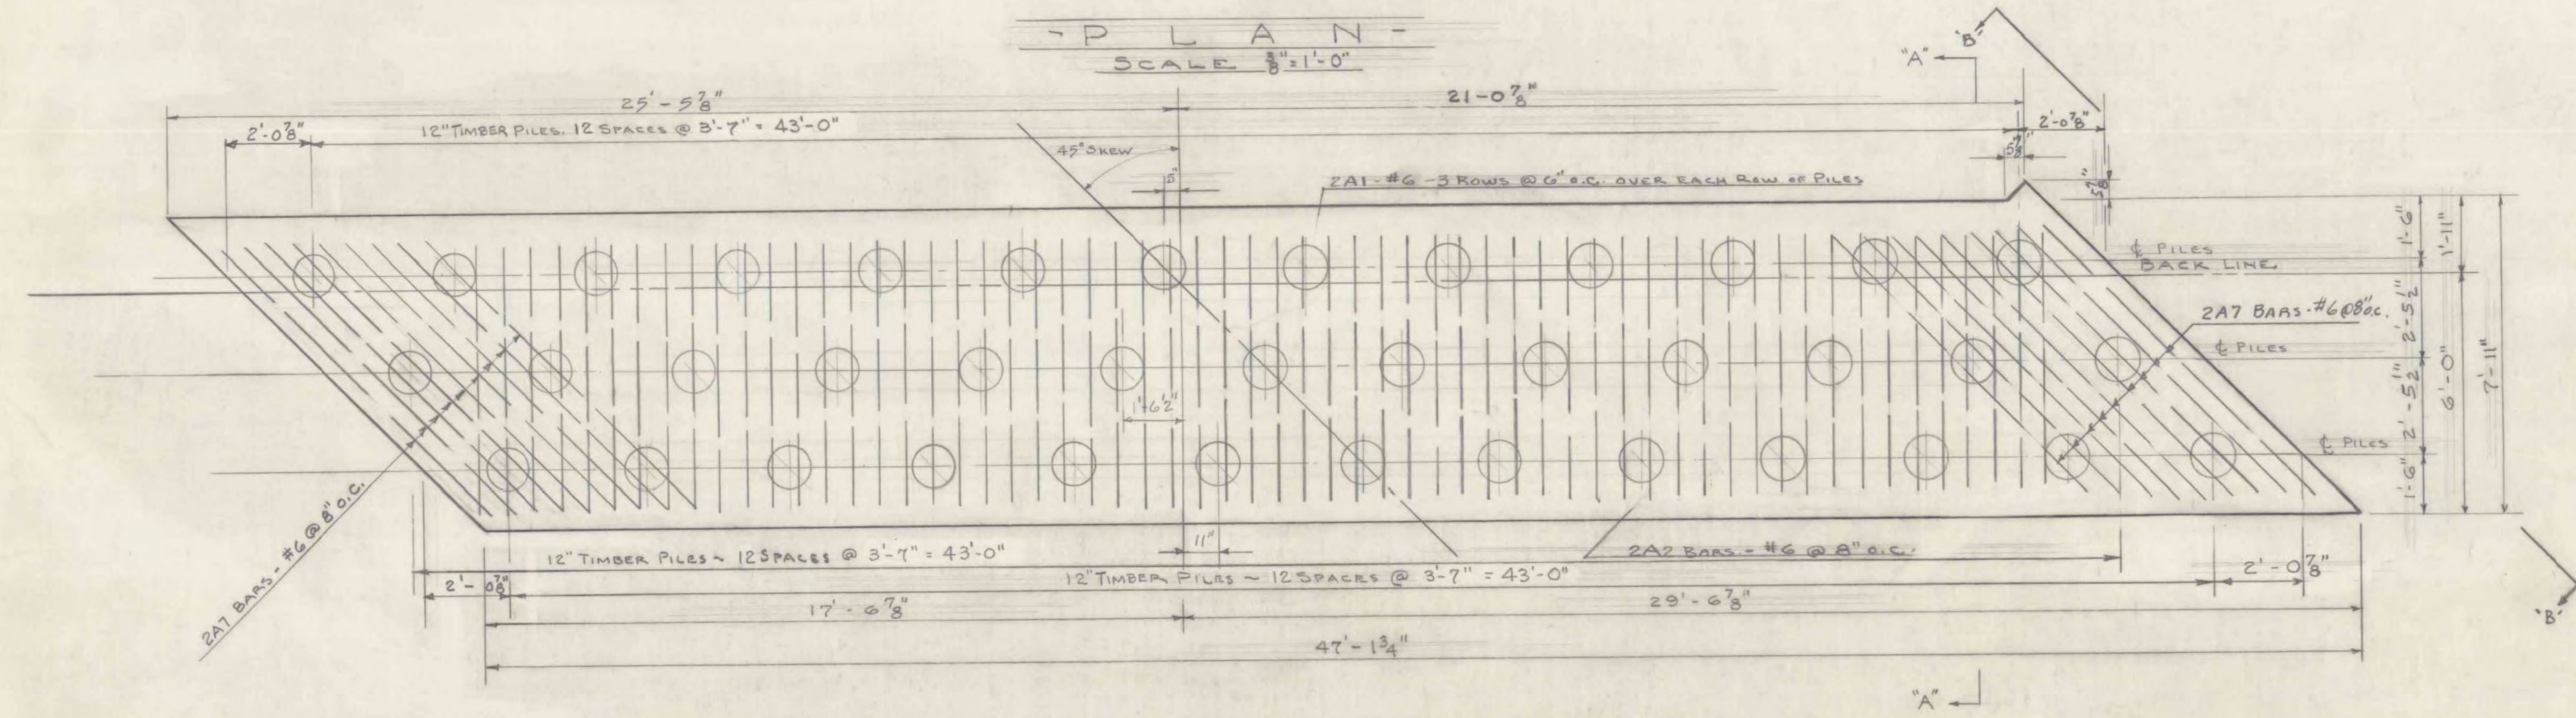

FOUNDATION PLAN  
SCALE 3/8" = 1'-0"

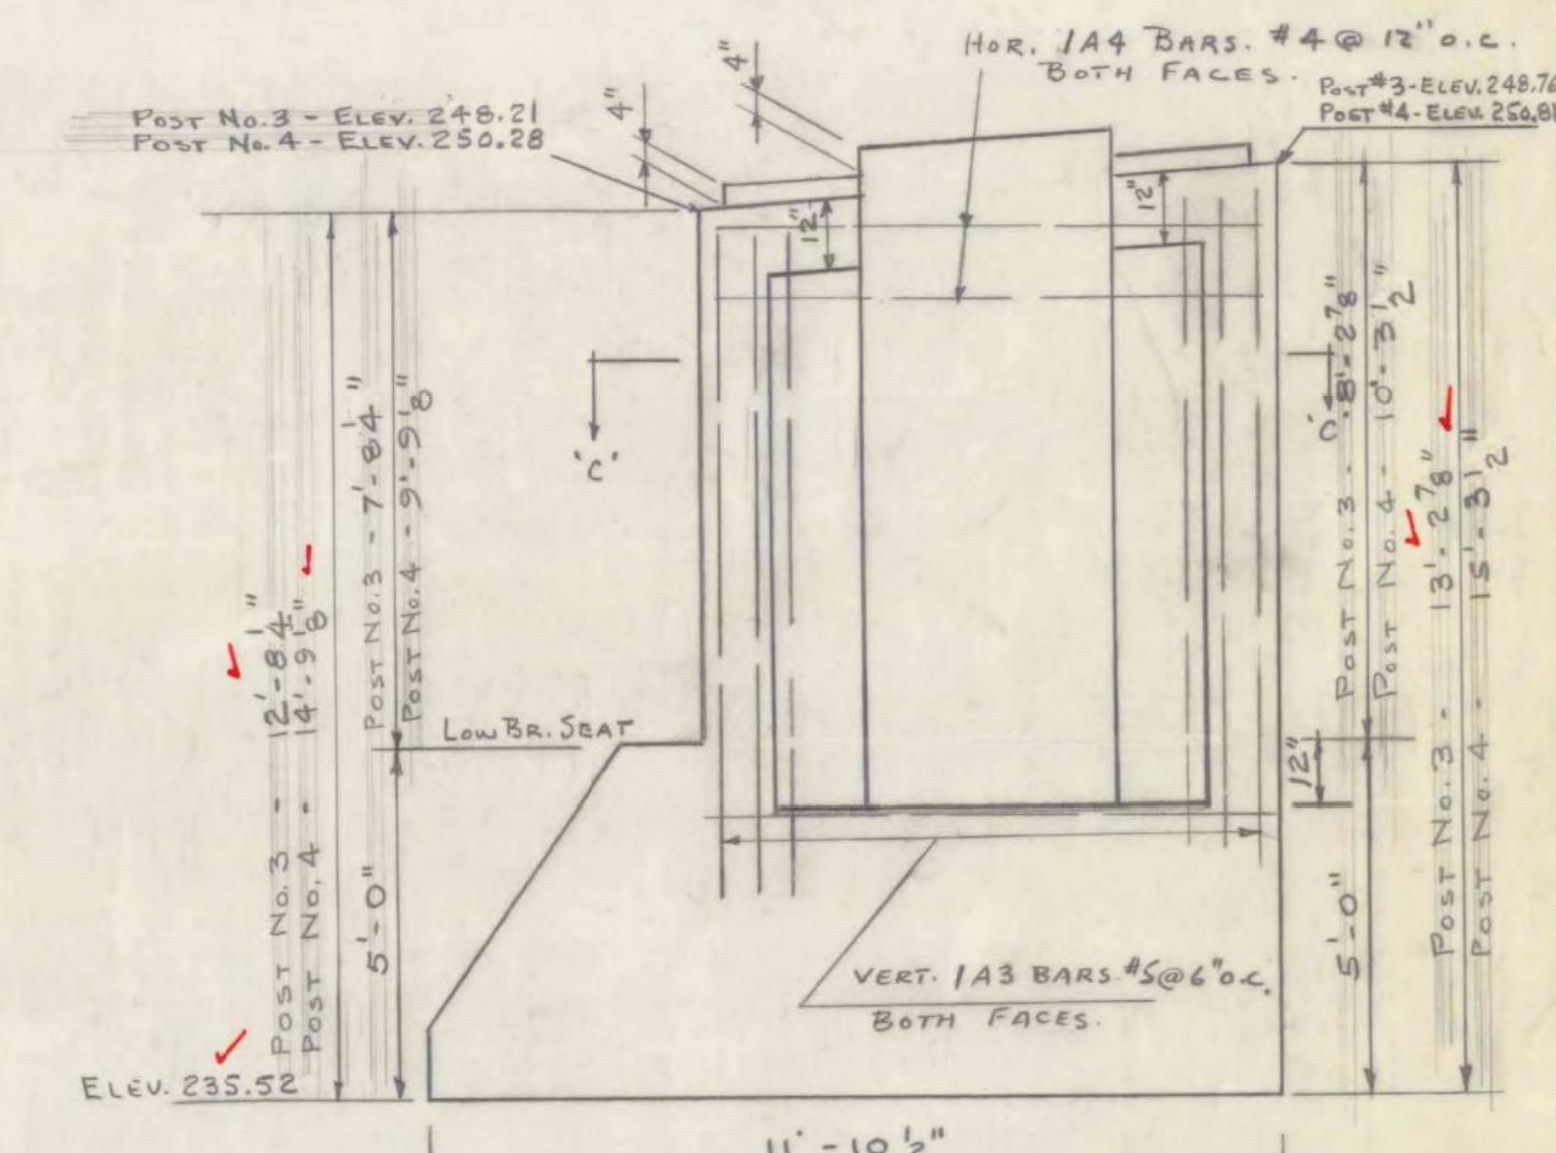

ELEVATION B-B  
SCALE 3/8" = 1'-0"

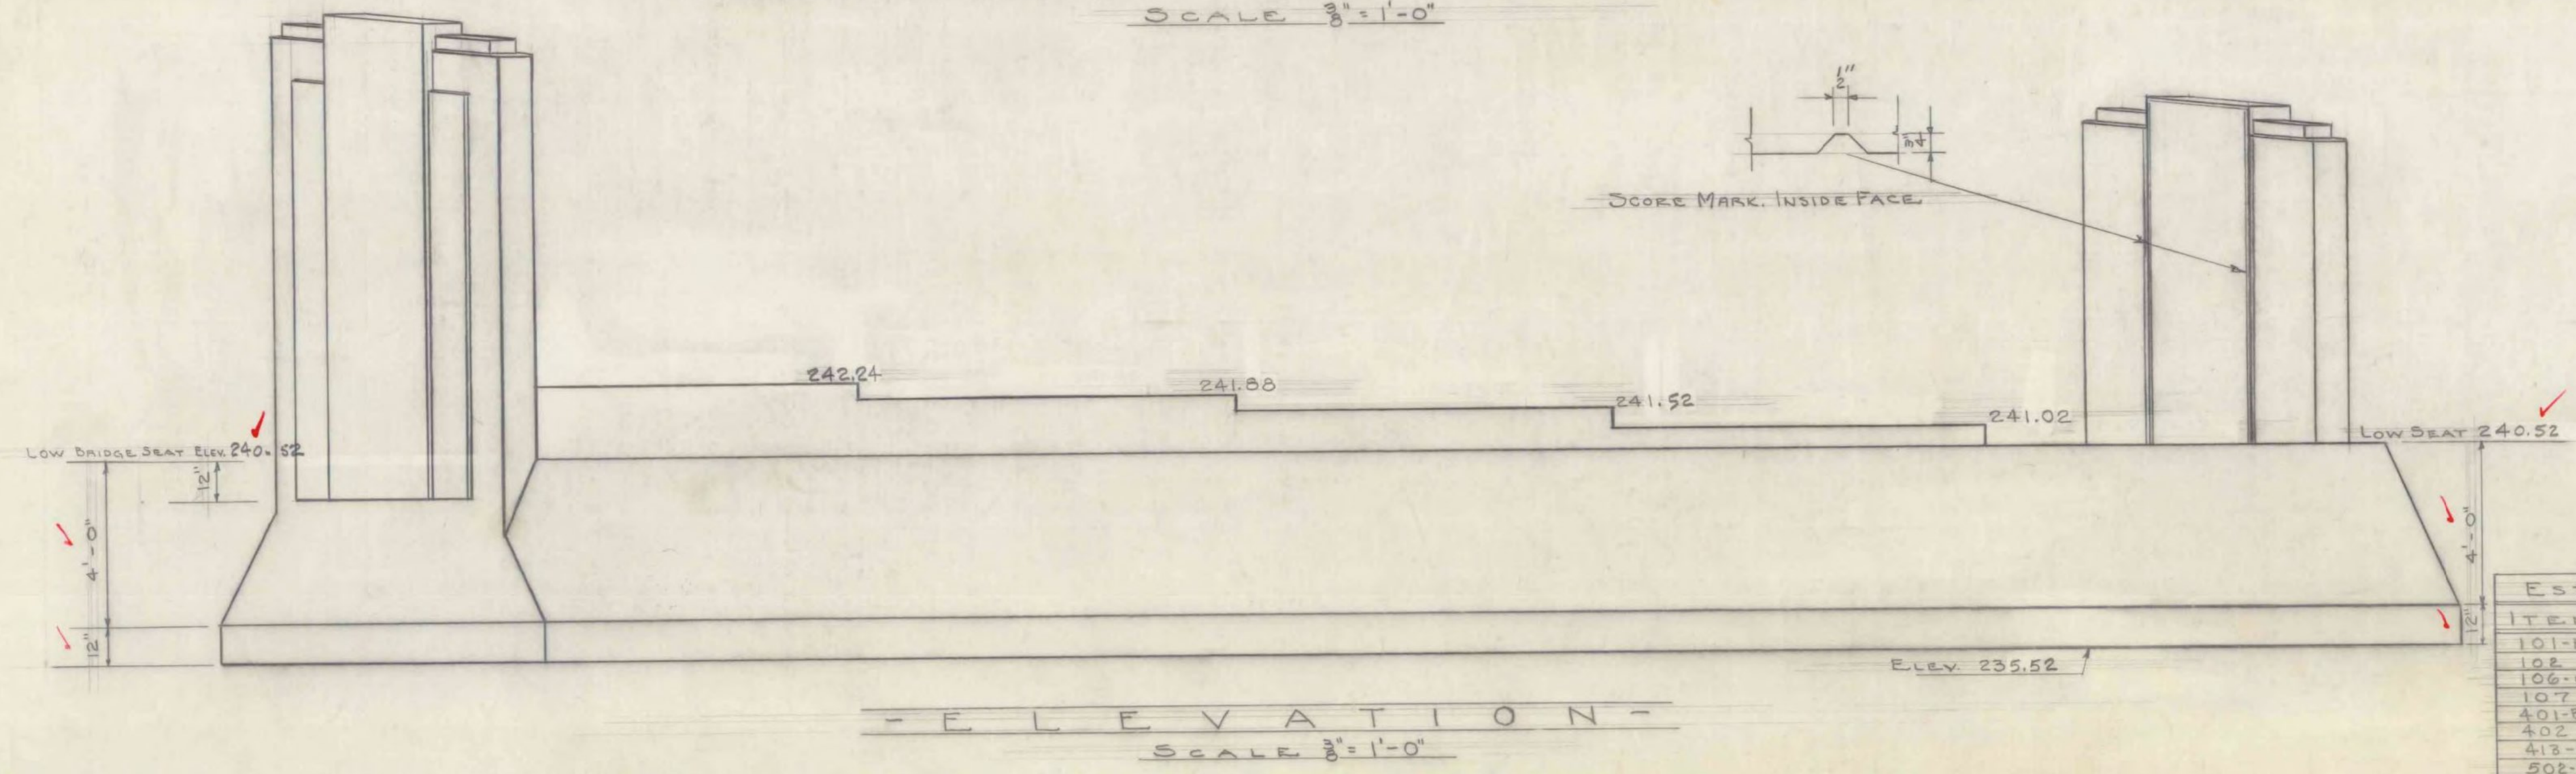

ELEVATION  
SCALE 3/8" = 1'-0"

HARTLAND  
BRIDGE 62A  
BHF BPNT(12)  
SHEET 51 OF 55  
FOR REFERENCE  
ONLY



FOR SECTION 'C-C', SEE ABUT. NO. 1  
FOR GENERAL NOTES SEE ABUTMENT NO. 1.

STATE OF VERMONT  
DEPARTMENT OF HIGHWAYS

TOWN OF HARTLAND  
ROUTE No. 105-5 LOG STA.  
ABUTMENT NO. 2

ITEM	DESCRIPTION	QUANTITY	FINAL
101-B	SOLID ROOF EXCAV.	26 C.Y.	88
102	BORROW	662 C.Y.	640
106-C	UNCL. CHANNEL EXCAVATION	89 C.Y.	540
107	STRUCTURE EXCAV. MODIFIED	25 C.Y.	23
401-B	CONCRETE CLASS. MODIFIED	70 C.Y.	69
402	REIN. STEEL	DEE SHEET	
413-A	PLAIN RUBBLE PAVING	136 C.Y.	256
502-B	TREATED TIMBER PILING	1053 C.F.	106
502-B1	CUT OFFS - TREATED TIMBER PILING	117 C.F.	228
502-C	METAL SHIPS FOR TIMBER PILING	39	39

SCALE 3/8" = 1'-0"  
SURVEYED BY FUNK  
DRAWN BY R.B.M. CHECKED BY J.L.H.  
PROJECT NO. FG-77(11)  
SHEET 17 OF 54

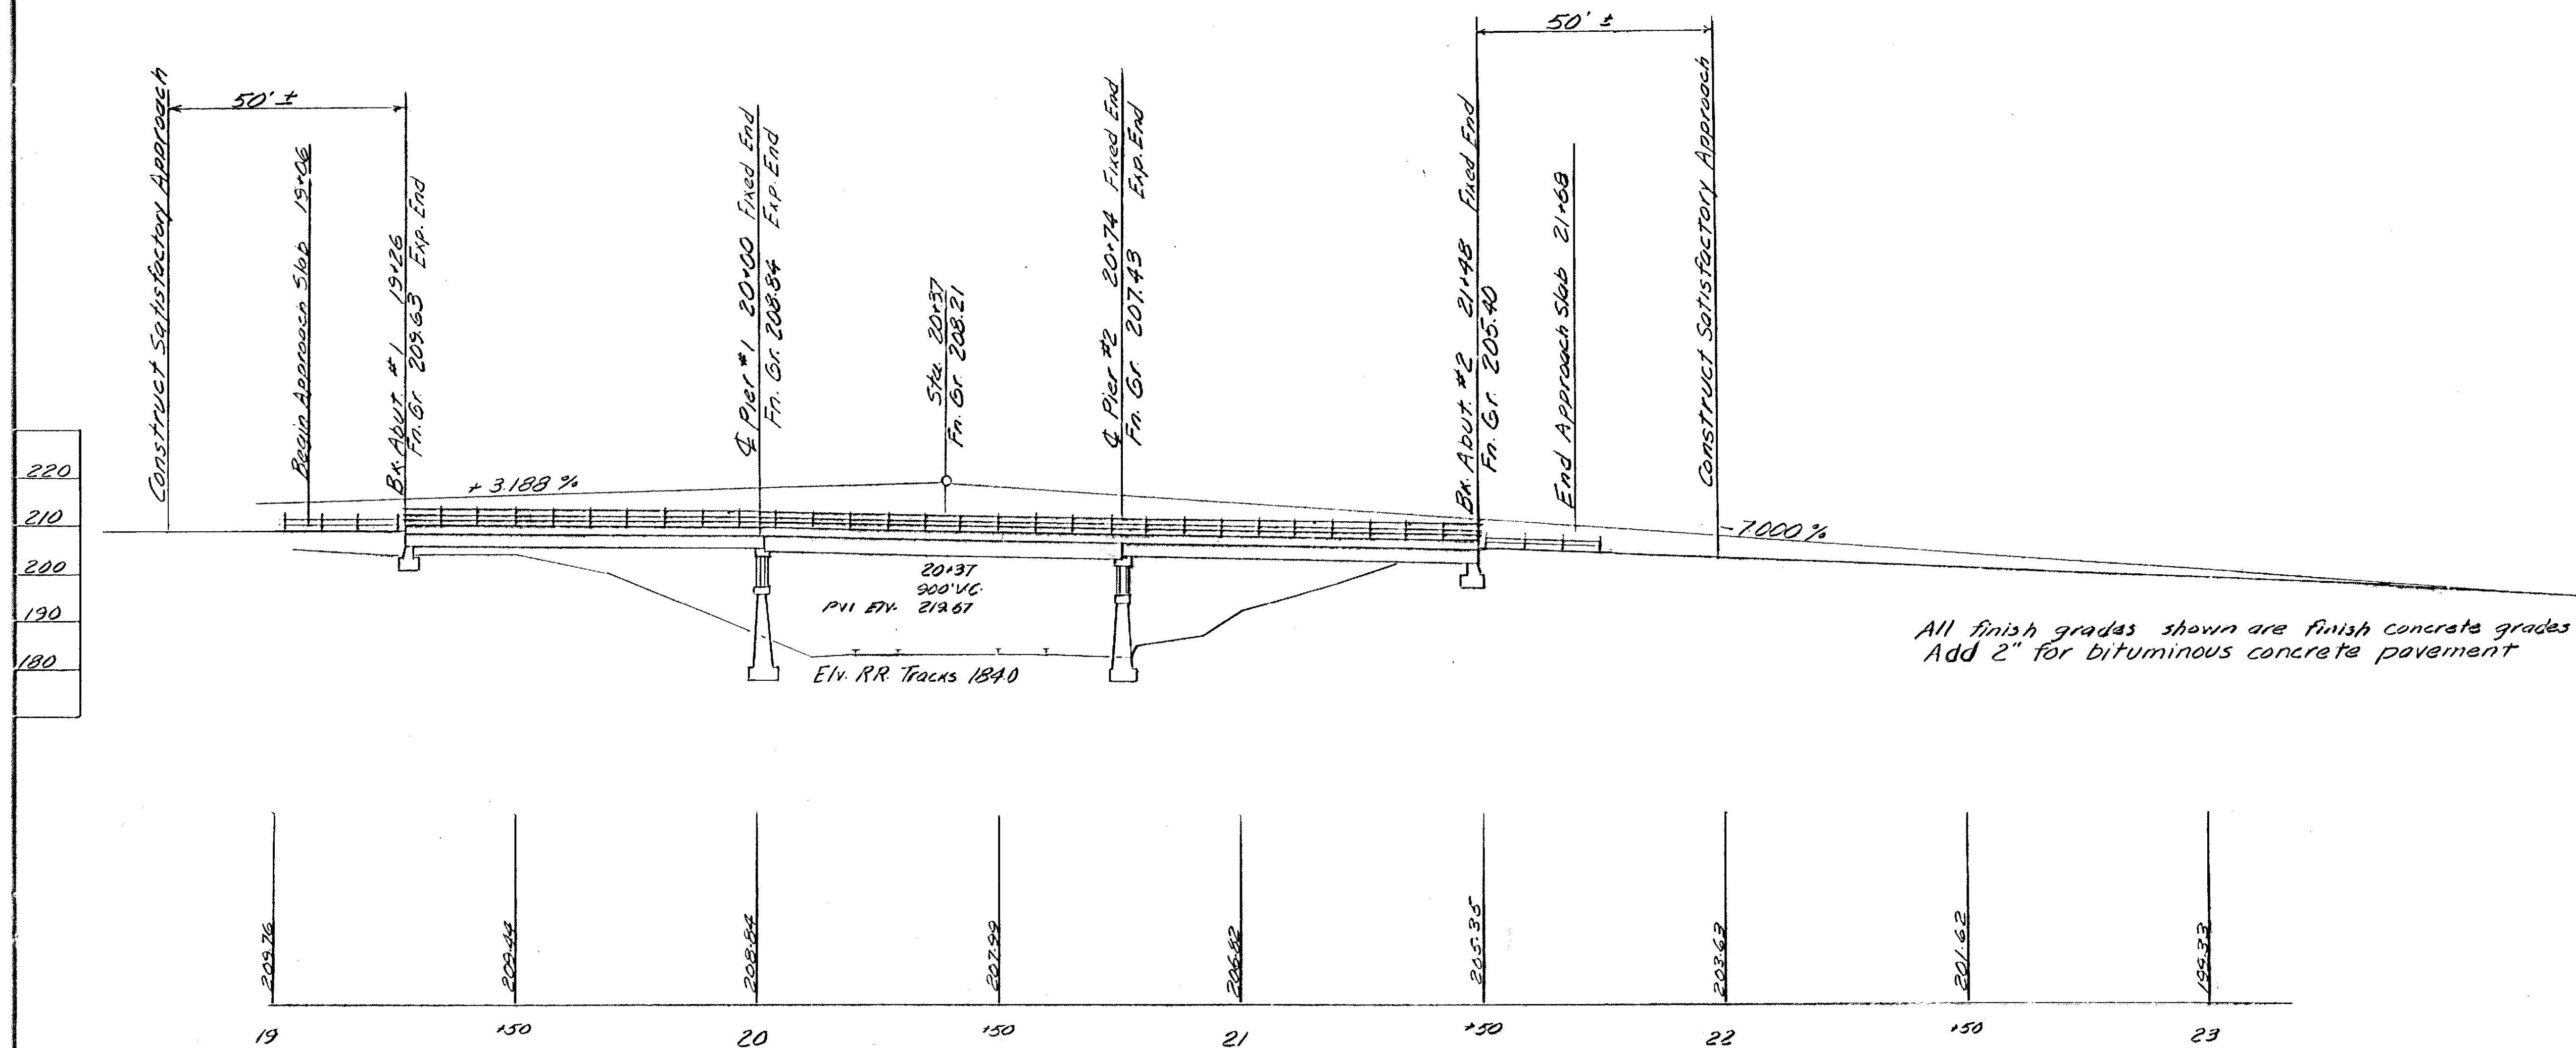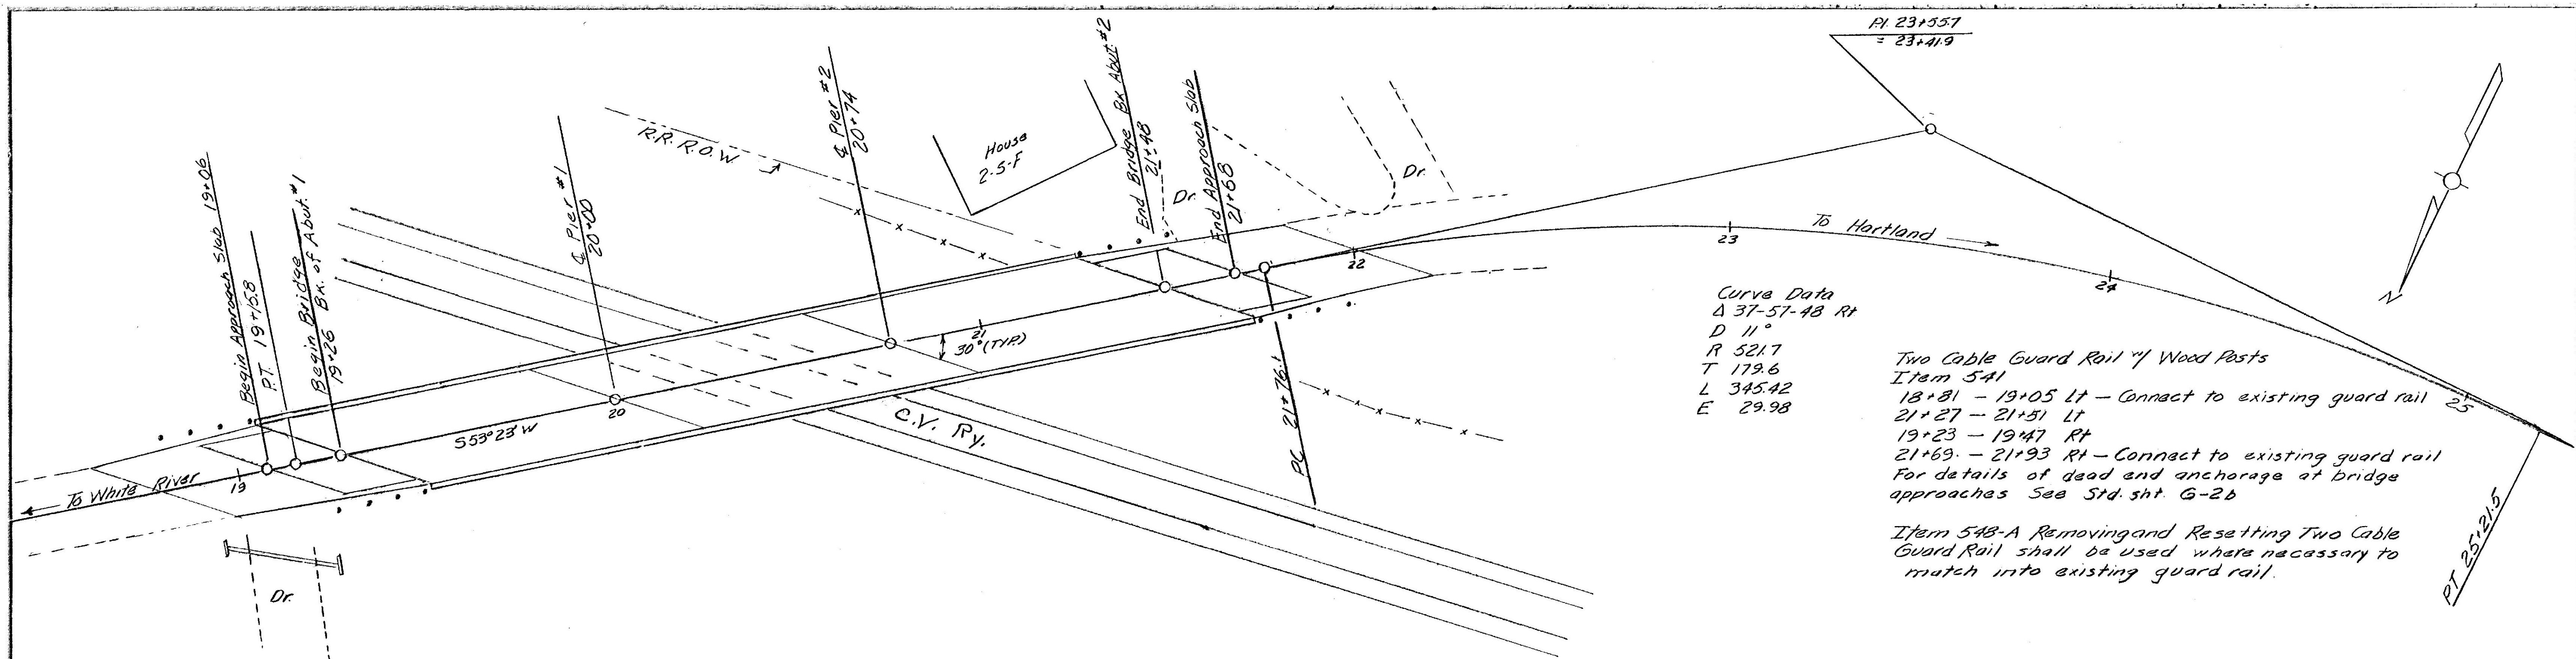

**HARTLAND  
BRIDGE 66  
BHF BPNT(12)  
SHEET 52 OF 55  
FOR  
REFERENCE  
ONLY**

STATE OF VERMONT  
DEPARTMENT OF HIGHWAYS

TOWN OF Hartland

ROUTE NO. U.S. 5 LOG STA. 313+85  
Route 5 Bridge over C.V. Ry.

Plan and Profile


SCALE 1" = 20'-0"

In Charge R.H. Watson

DRAWN BY MWR CHECKED BY D. Mayo

PROJECT NO. SP.041-2-6533

SHEET 3 OF 24

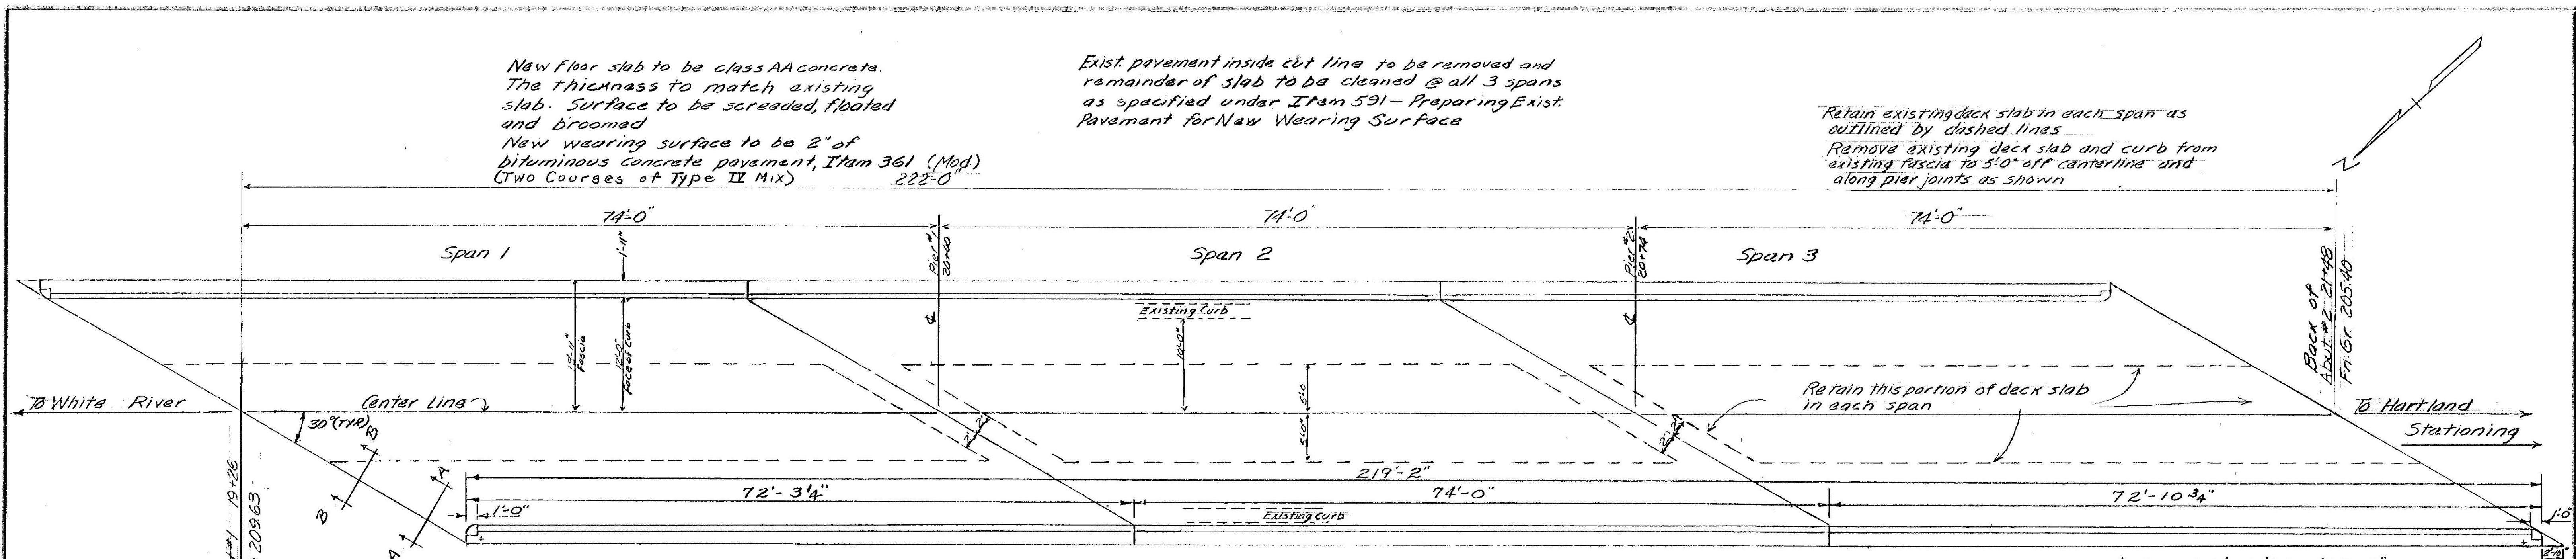

New floor slab to be class AA concrete. The thickness to match existing slab. Surface to be screeded, floated and broomed.  
 New wearing surface to be 2" of bituminous concrete pavement, Item 361 (Mod) Two Courses of Type II Mix 222-0

Exist. pavement inside cut line to be removed and remainder of slab to be cleaned @ all 3 spans as specified under Item 591 - Preparing Exist. Pavement for New Wearing Surface


Retain existing deck slab in each span as outlined by dashed lines.  
 Remove existing deck slab and curb from existing fascia to 5'-0" off centerline and along pier joints as shown

Note:  
 Remove existing approach slab curbs to top of existing approach slab concrete as Item 103-B. (Typical Both ends of bridge).  
 Item 372-A Joint sealer Hot Poured  
 For details not shown see SB-AS-65 Section B-B


PLAN  
 Scale: 1/8" = 1'-0"

Remove existing blast plates & gunite haunching from span 2 fascia beams. Payment for this work to be made under Item 575 - Preparing Superstructure for Widening

A saw cut along top of slab to existing reinforcing steel shall be made along all indicated lines where concrete is to be removed to provide a vertical breaking edge. At the contractor's option the joint may be sawed along the top of slab and line drilled @ uniform spacing to provide vertical breaking edge. Payment for this work to be included under Item 575, Preparing Superstructure for Widening.

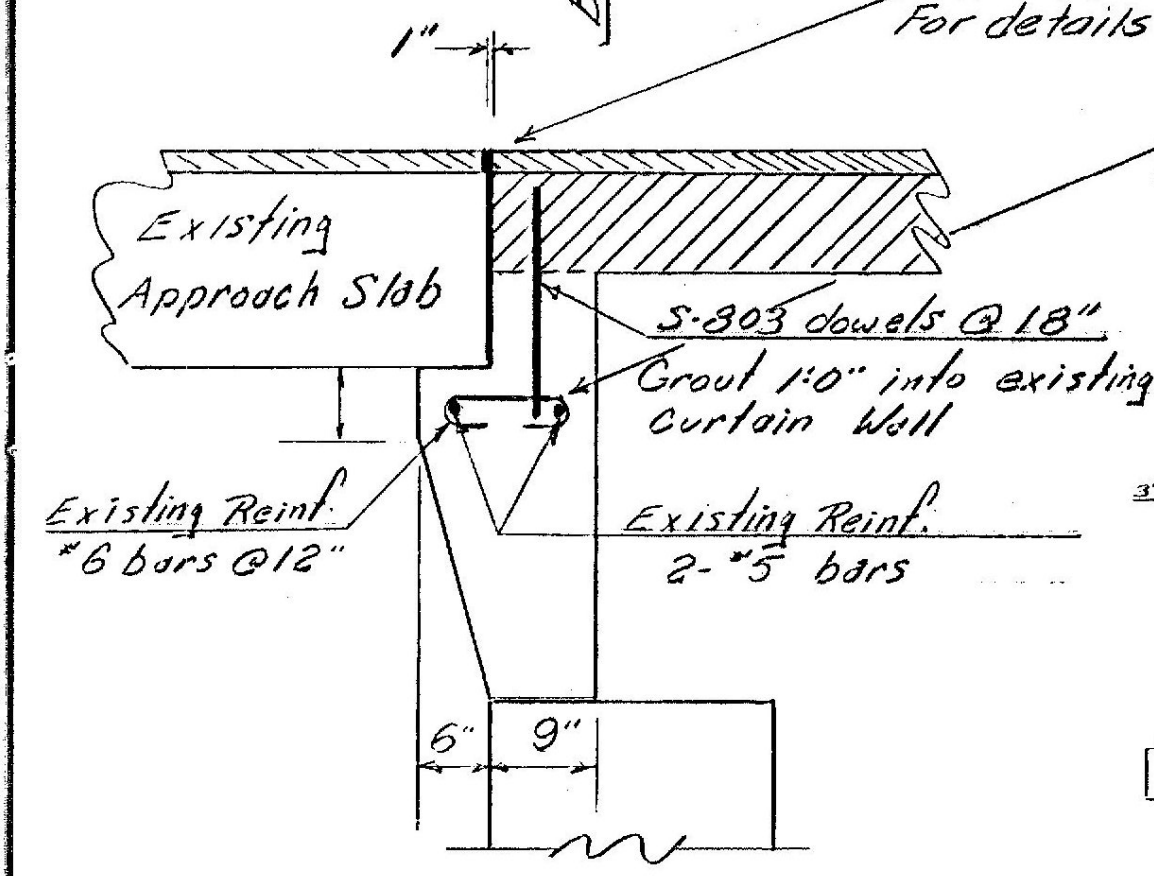


Retain existing curtain wall and approach slab bracket

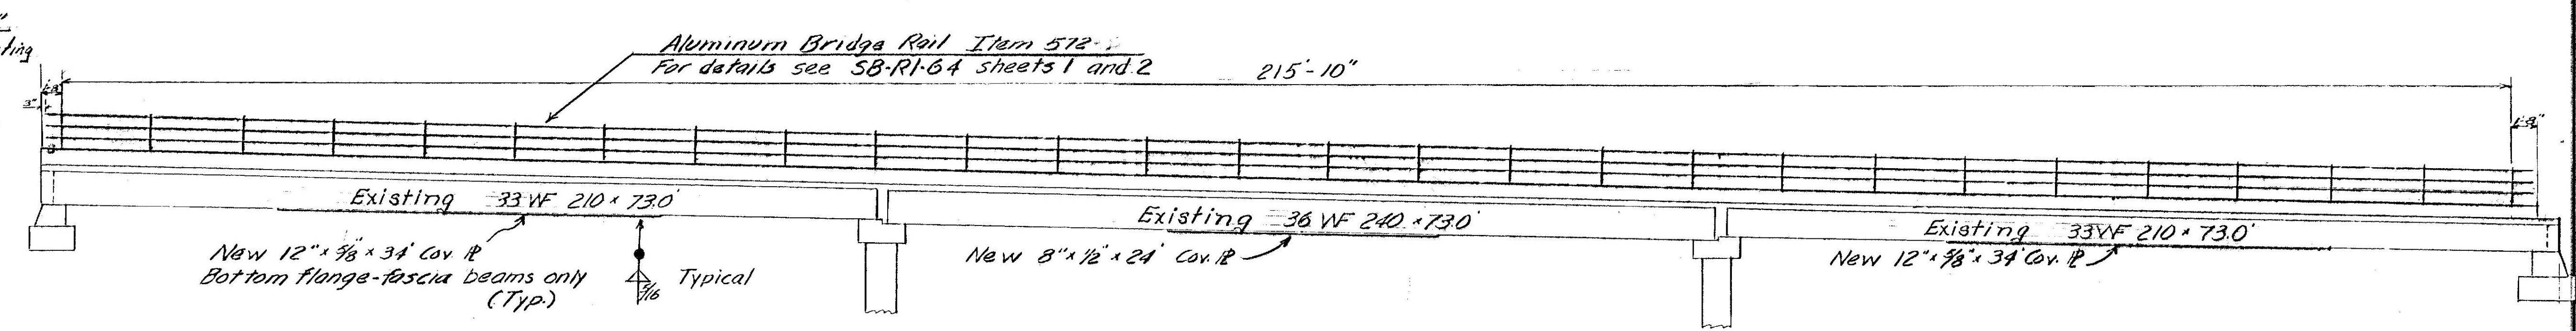

Spans 1 and 3  
 12" x 9/8" x 34" Cov. R to be welded to bot flange of fascia beams. Center of Cov. R to be positioned at center of span. For details not shown see SCB-D7-65 Detail C


Span 2  
 8" x 1/2" x 24" Cov. R to be welded to bot flange of fascia beams. Center of Cov. R to be positioned at center of span. For details not shown see SCB-D7-65 Detail C

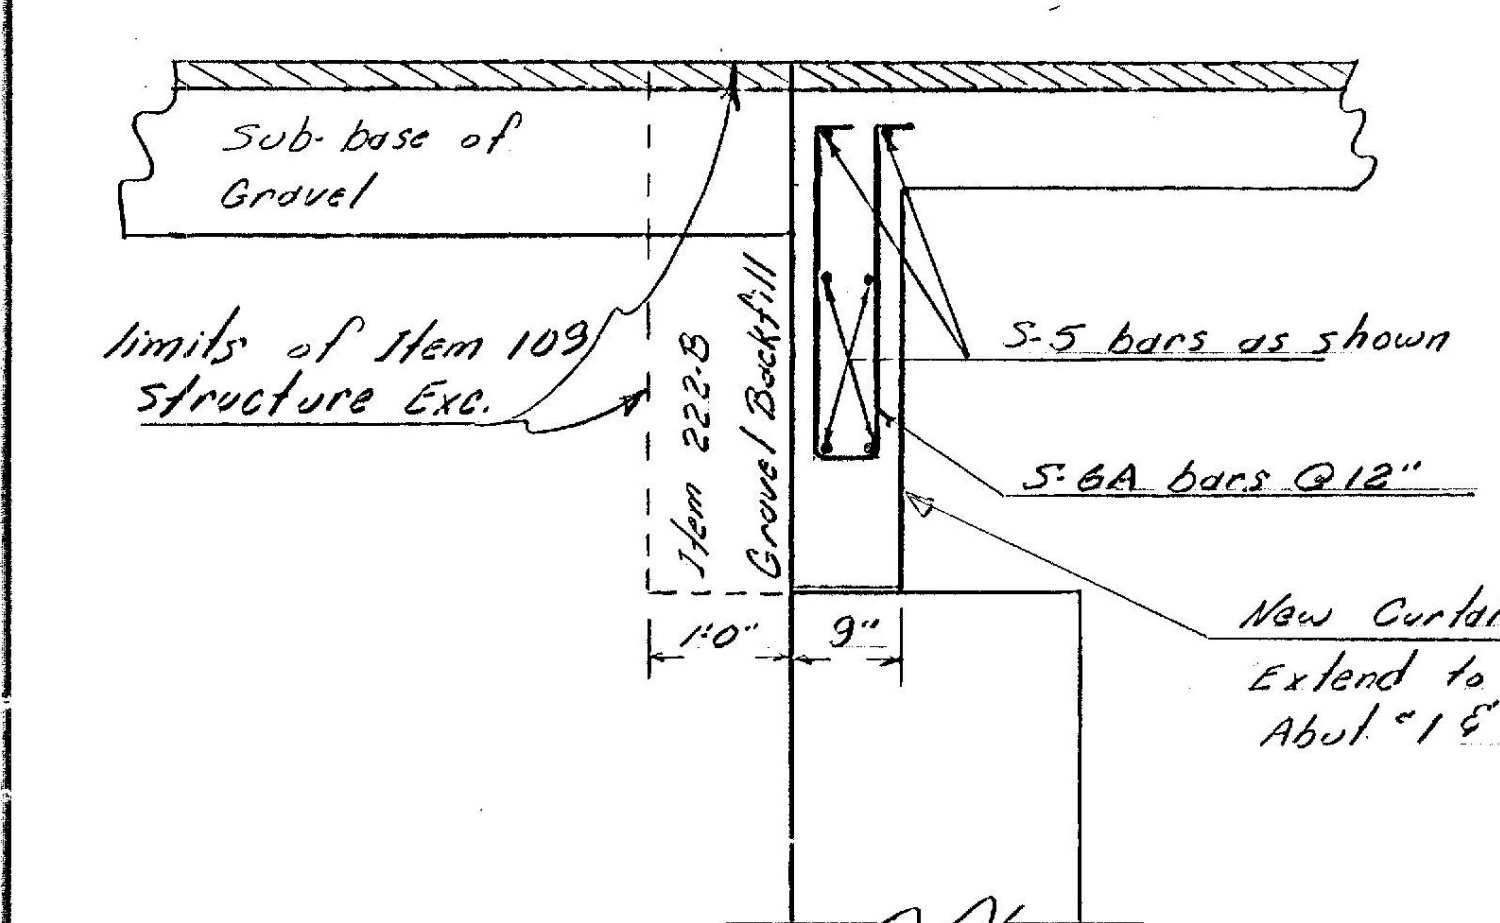

New Curtain Wall - Typical  
 Extend to existing Curtain Wall, About 1' 4"

**HARTLAND  
 BRIDGE 66  
 BHF BPNT(12)  
 SHEET 53 OF 55  
 FOR  
 REFERENCE  
 ONLY**

STATE OF VERMONT DEPARTMENT OF HIGHWAYS	
TOWN OF	Hartland
ROAD NO.	US 5 Log STA. 313+85
	Route 5 Bridge over C.V. Ry.
Plan and Elevation	
SCALE	1/8" = 1'-0"
In Charge	R.H. Watson
DRAWN BY	M. Raymond
CHECKED BY	D. Mayo
PROJECT NO.	SP-OAL-2-6333
SHEET	4 OF 24



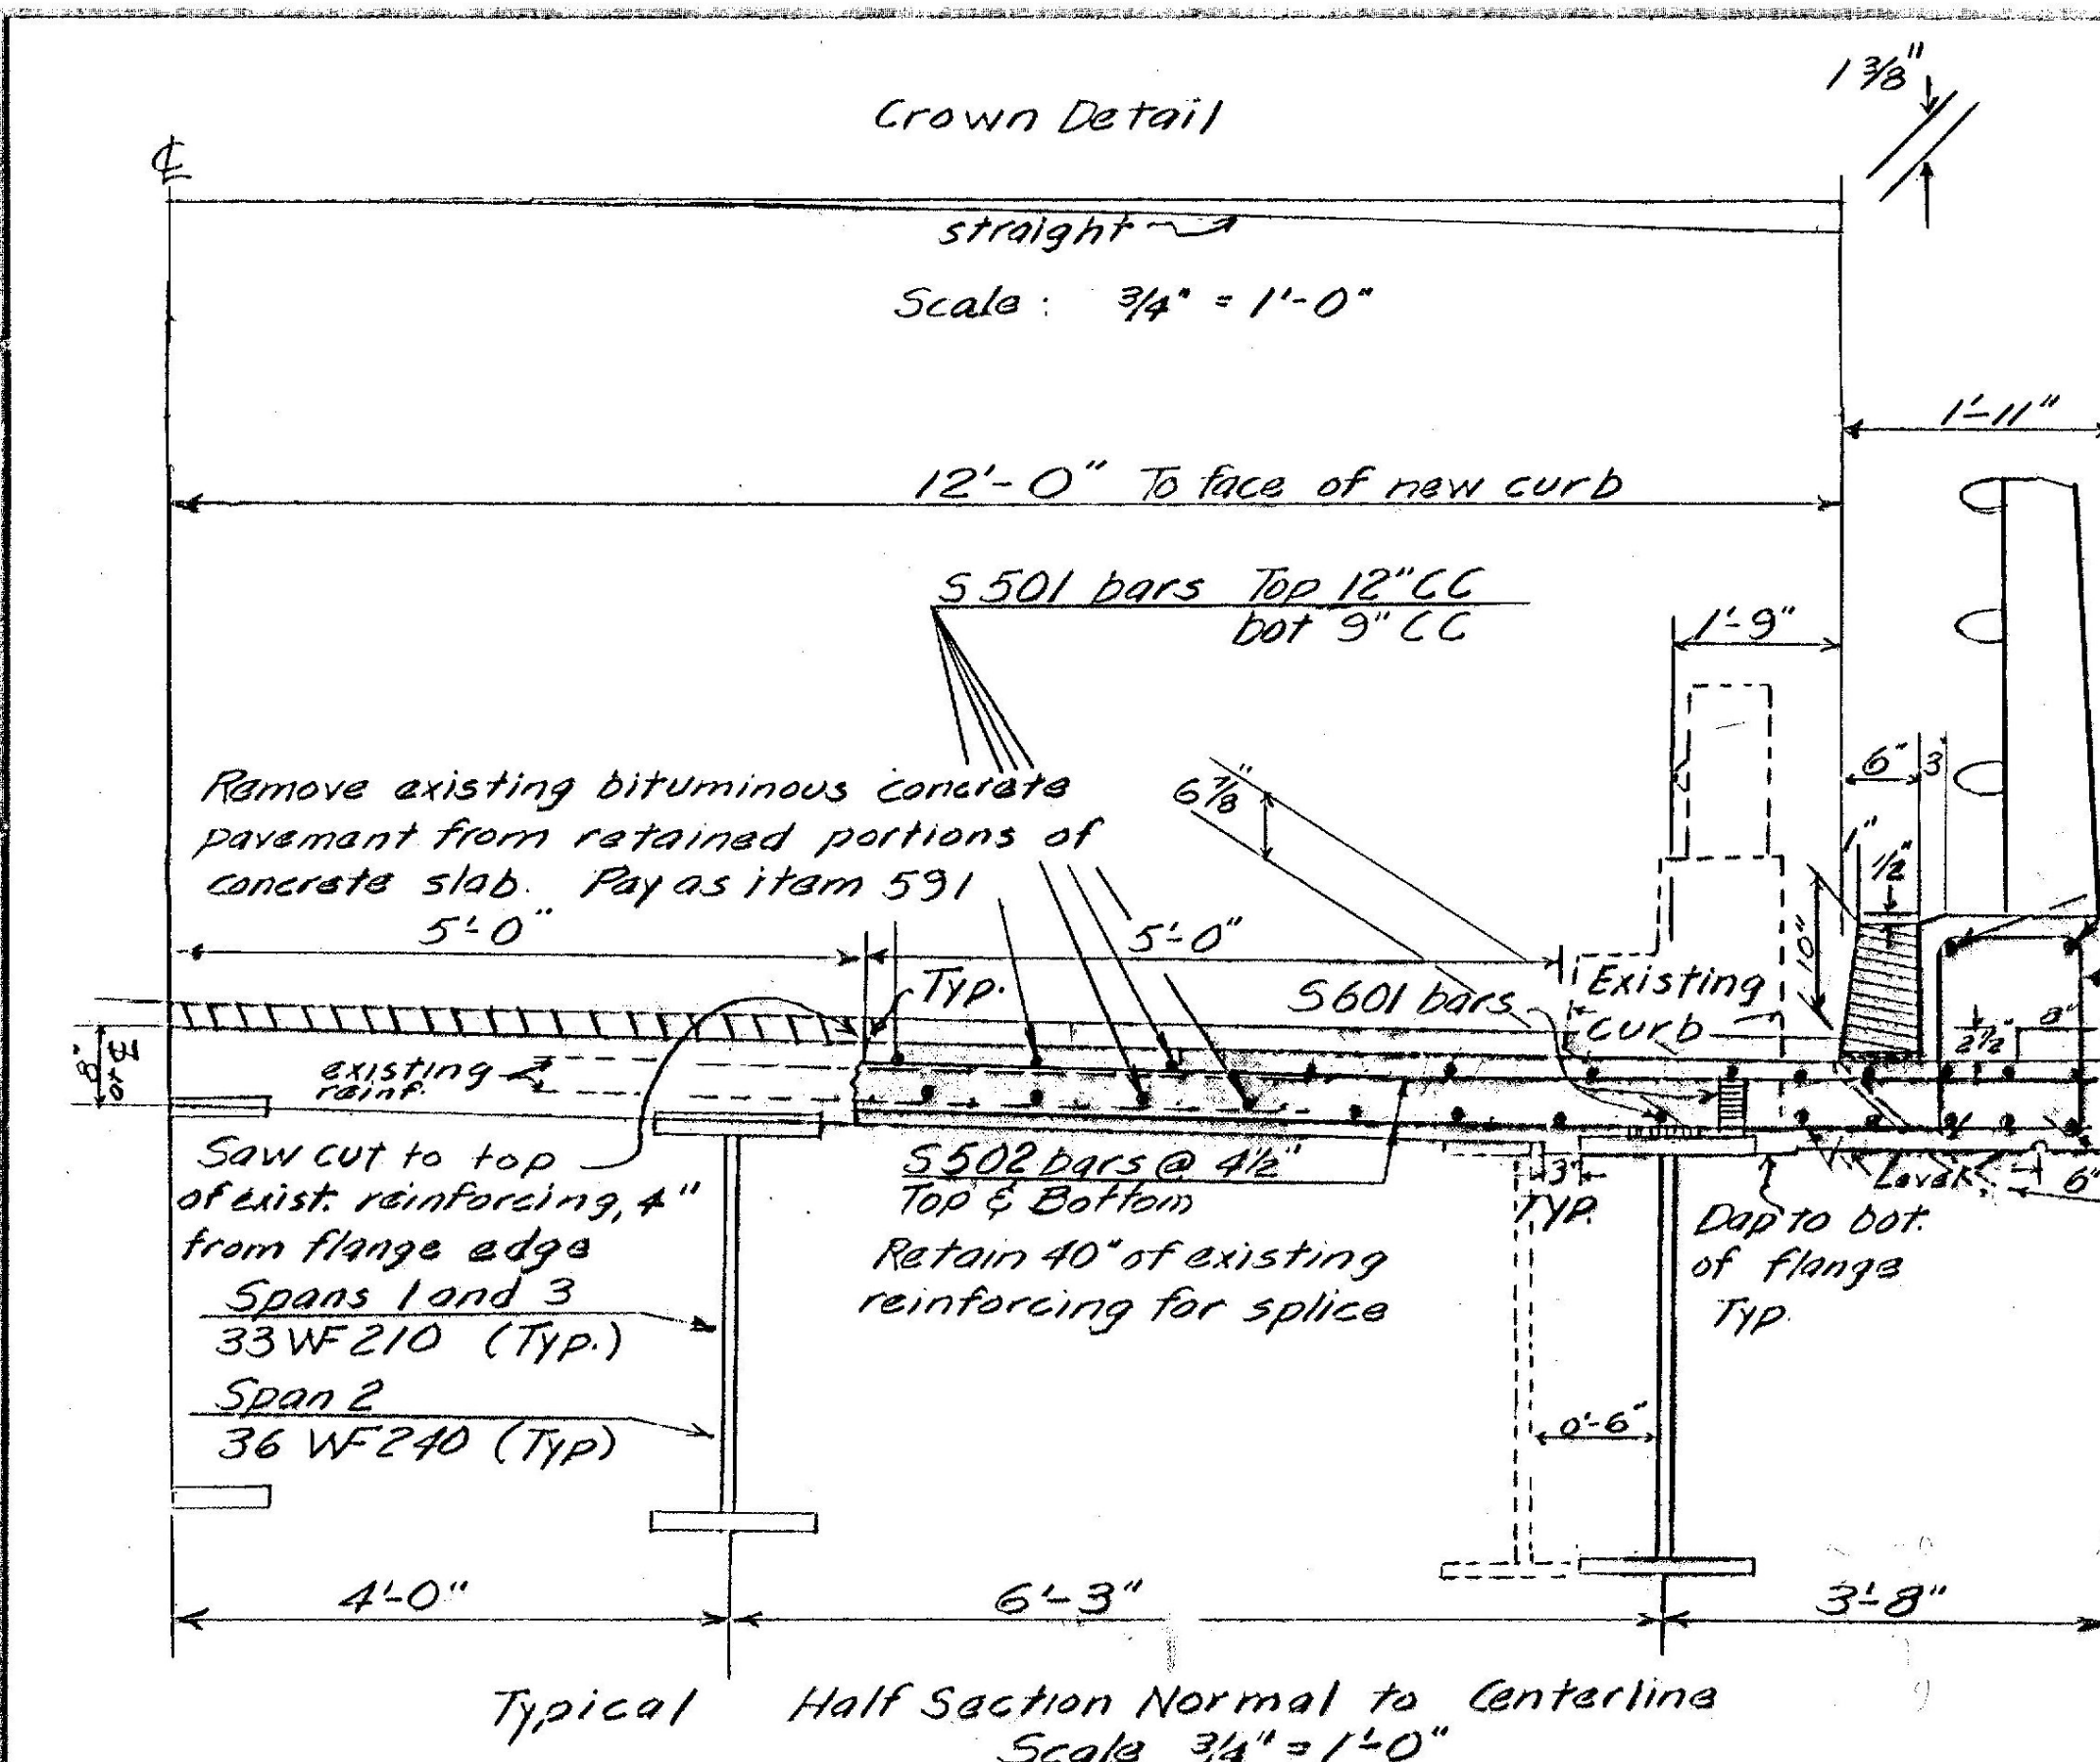


For railing details see SB-R1-64  
 Sheets 1 and 2  
 For details of Granite Bridge curb  
 Item 556-C, See SCB-D6-65  
 Detail A


Existing guard rail cable and  
 fittings on bridge shall become  
 the property of the State of Vt.  
 See General Note #12.

For additional curb details  
 not shown see 1'-11" curb  
 of SCB-3725-65

Construct Drain troughs at Piers #1 and #2  
 For details see SCB-D3-65  
 If necessary cut ends of beams to obtain  
 clearance for installation of troughs

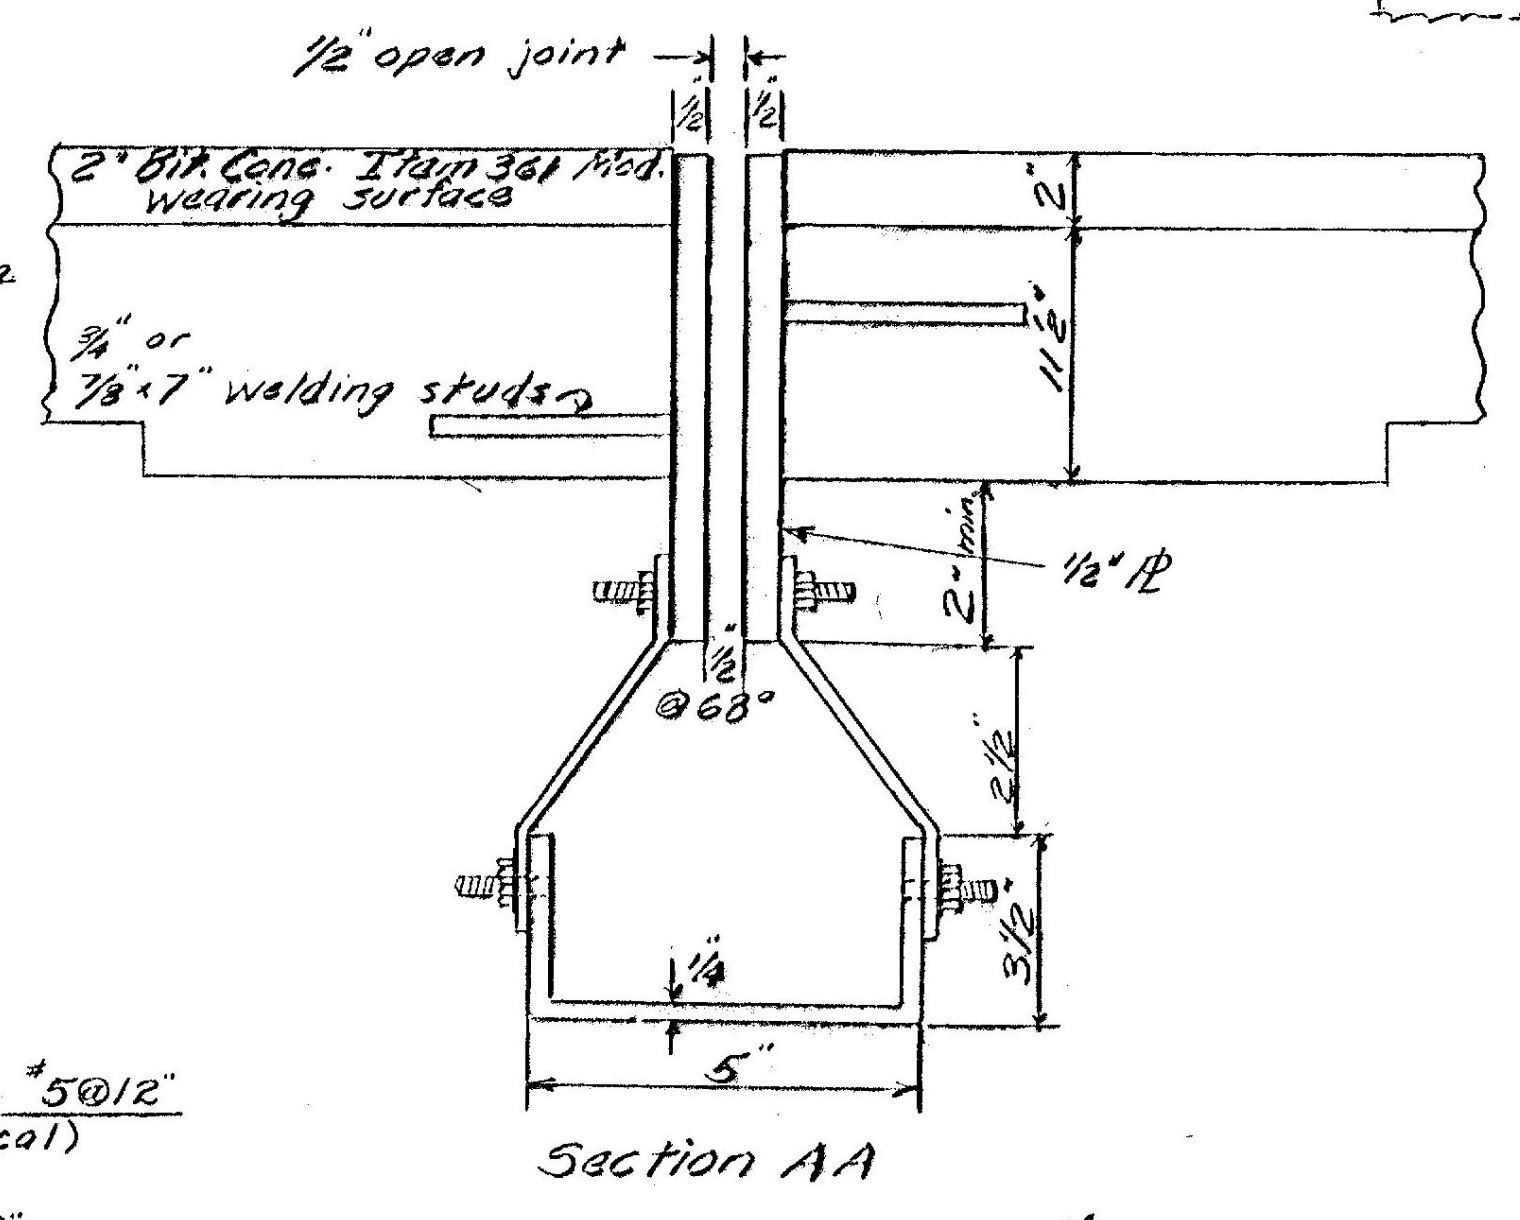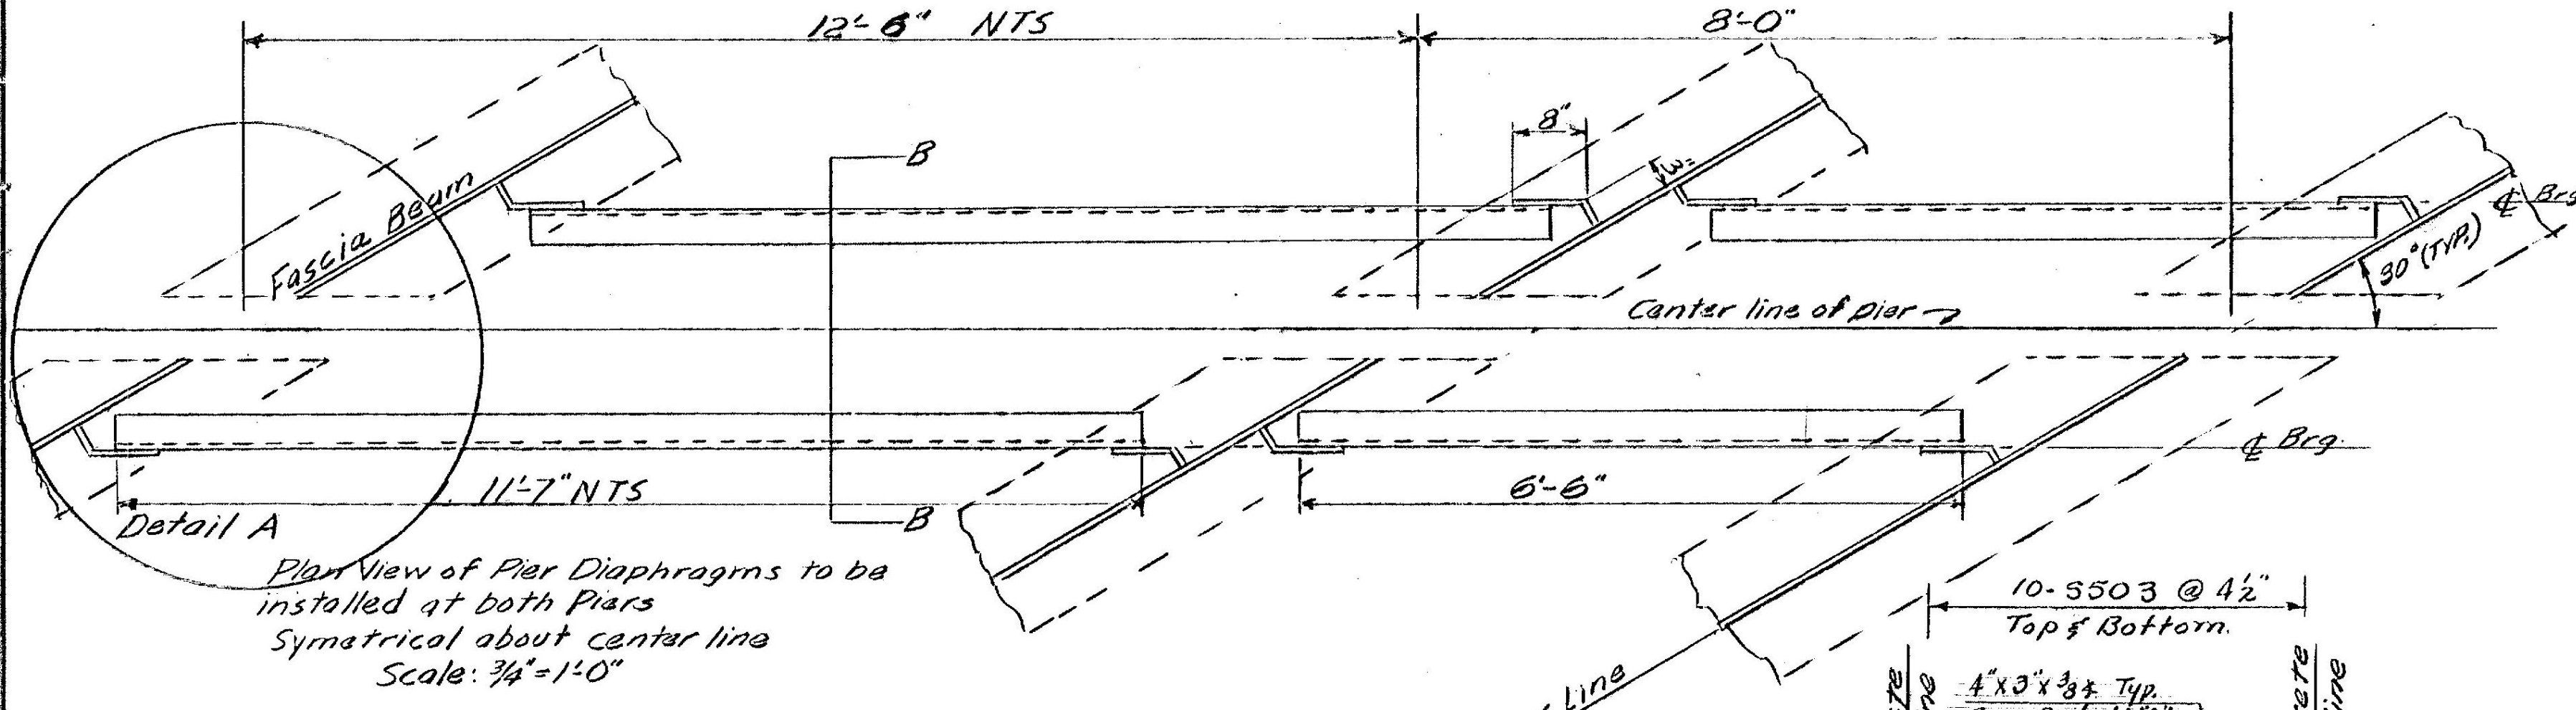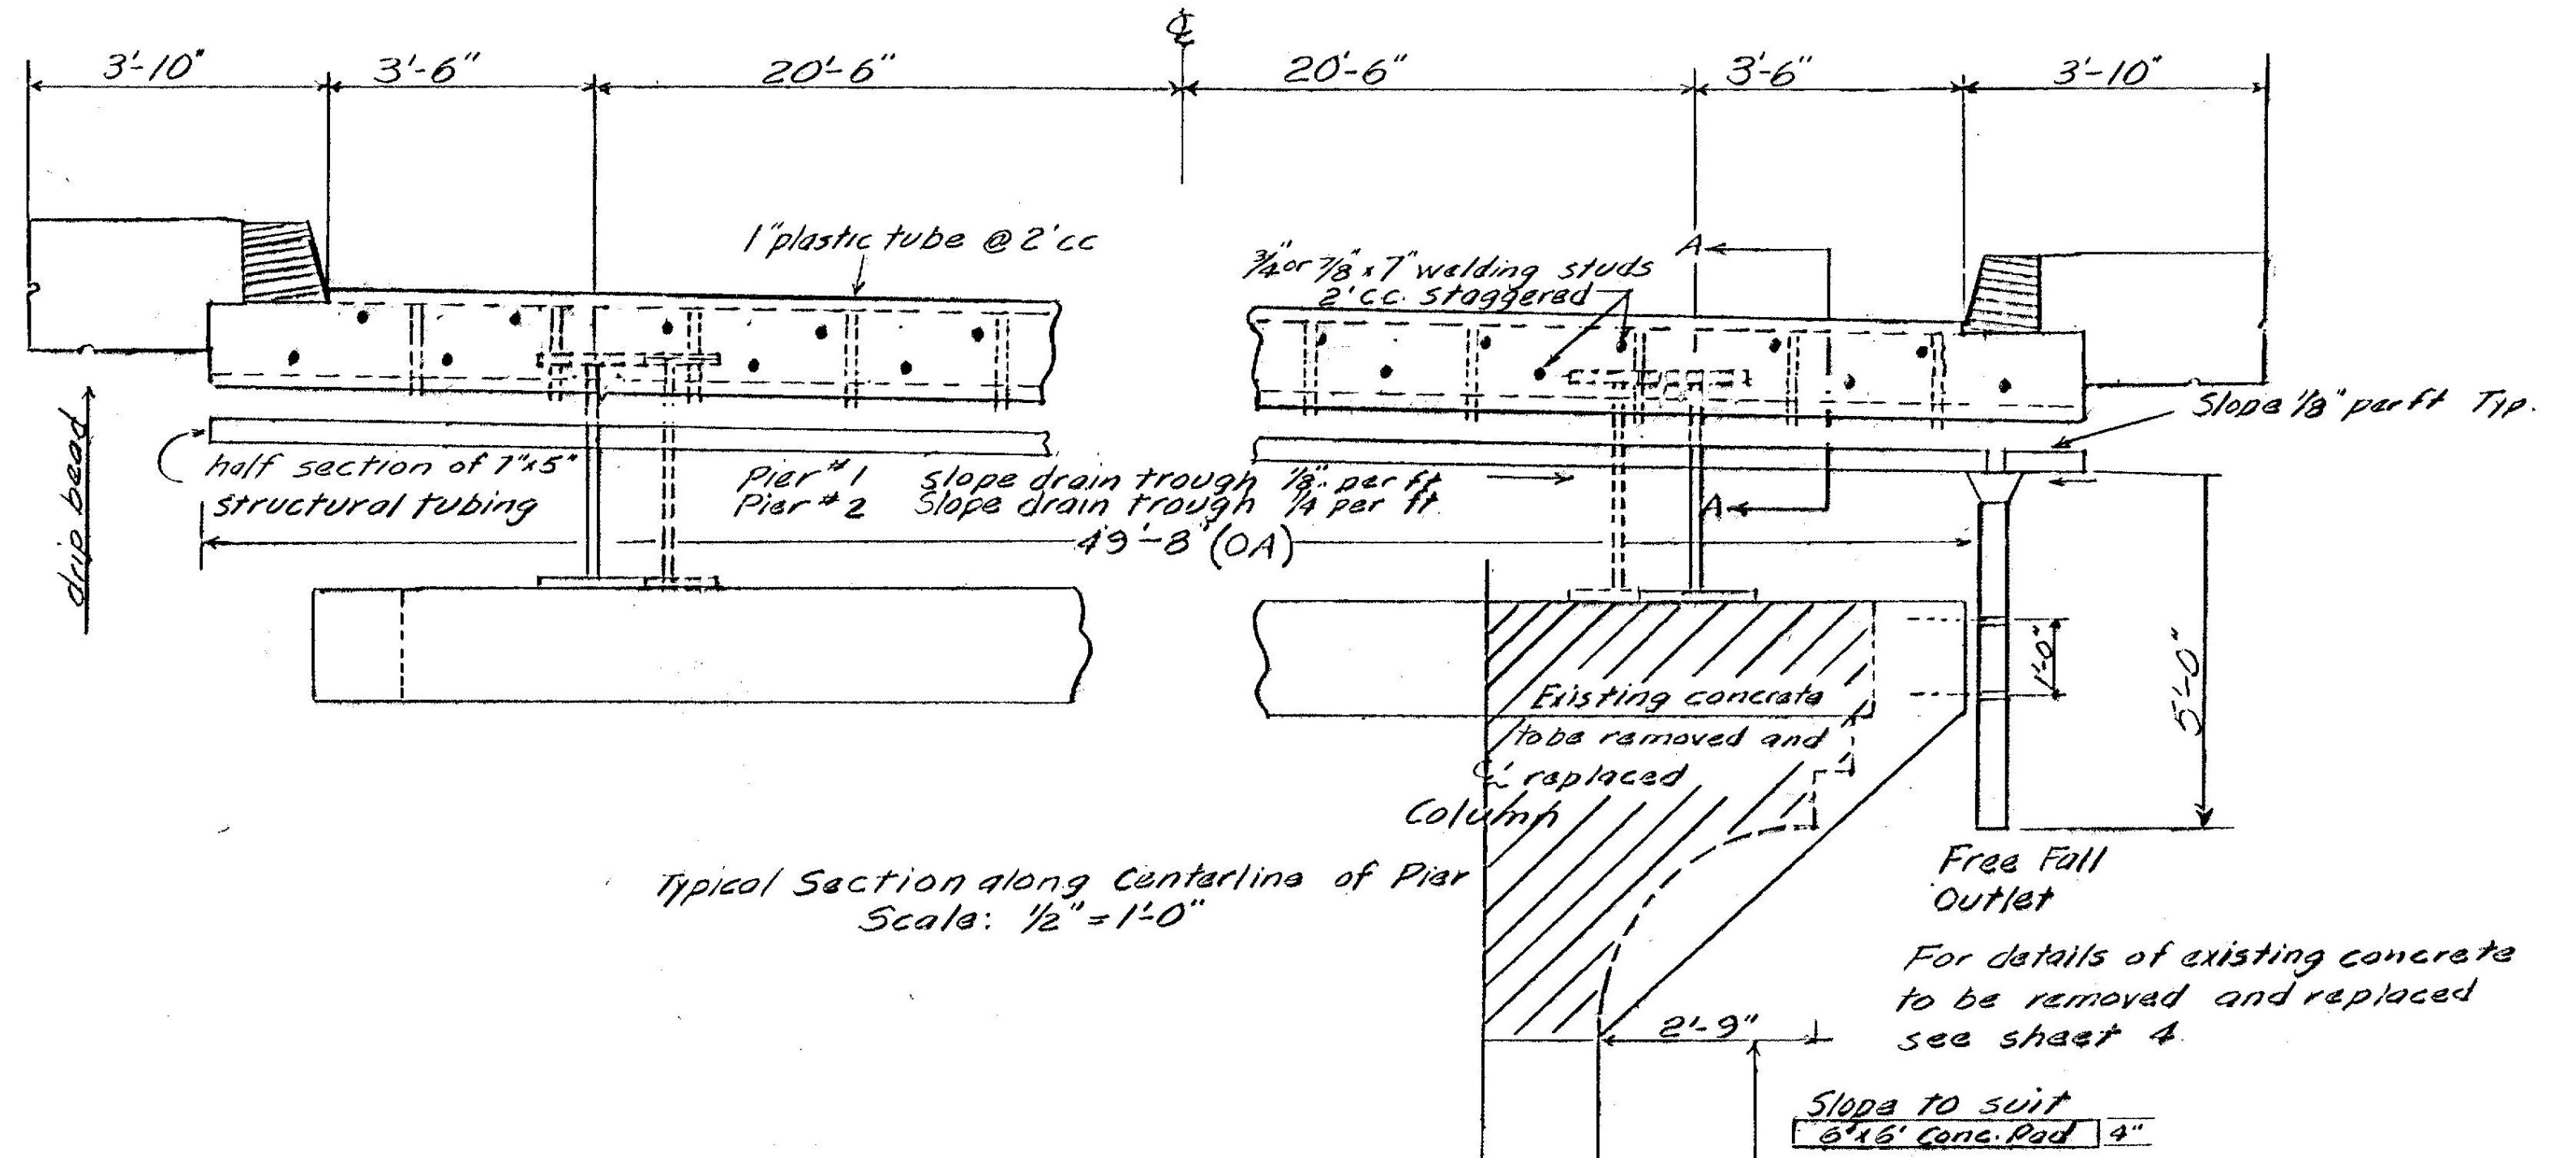


Steel for and dam plates shall  
 conform to A.S.T.M. Dastg A-242.  
 The top of plate shall be placed 1/2"  
 below finished grade  
 All new structural steel to be  
 painted as specified under  
 Item 404-A

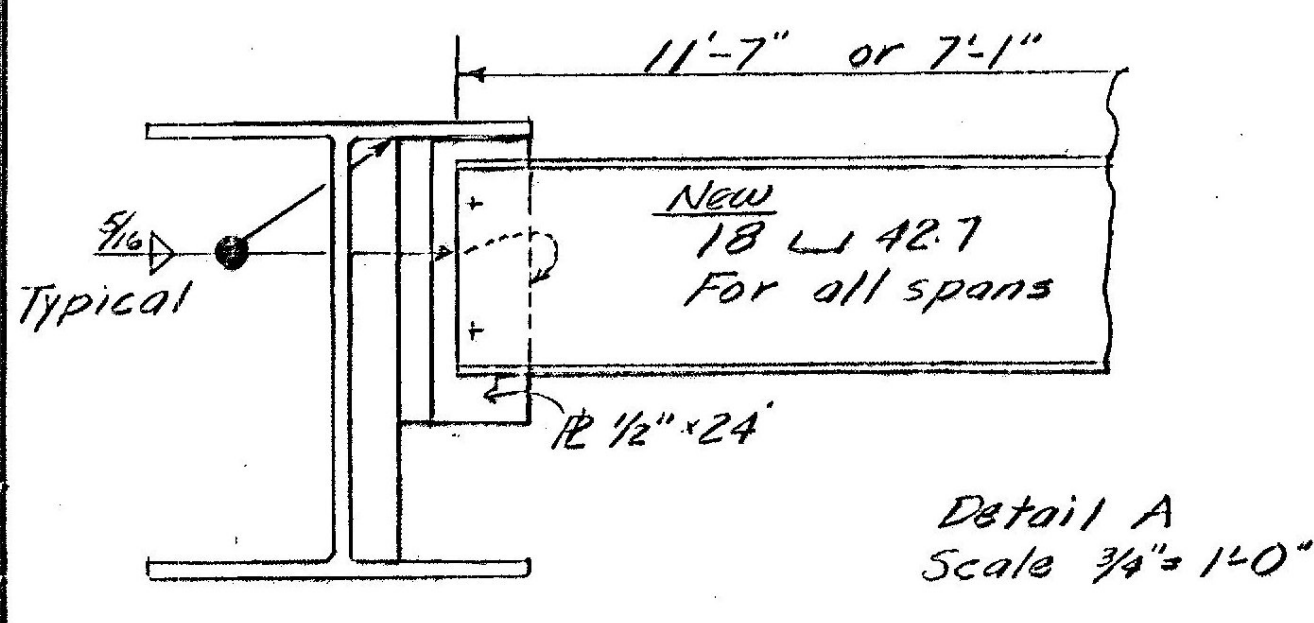


Detail A  
 Scale 3/4" = 1'-0"

For details of pier diaphragm connections  
 see SCB-D7-65 (A) and (B) All connections to be  
 welded. Two 7/8" bolts at each end may be used  
 for erection purposes

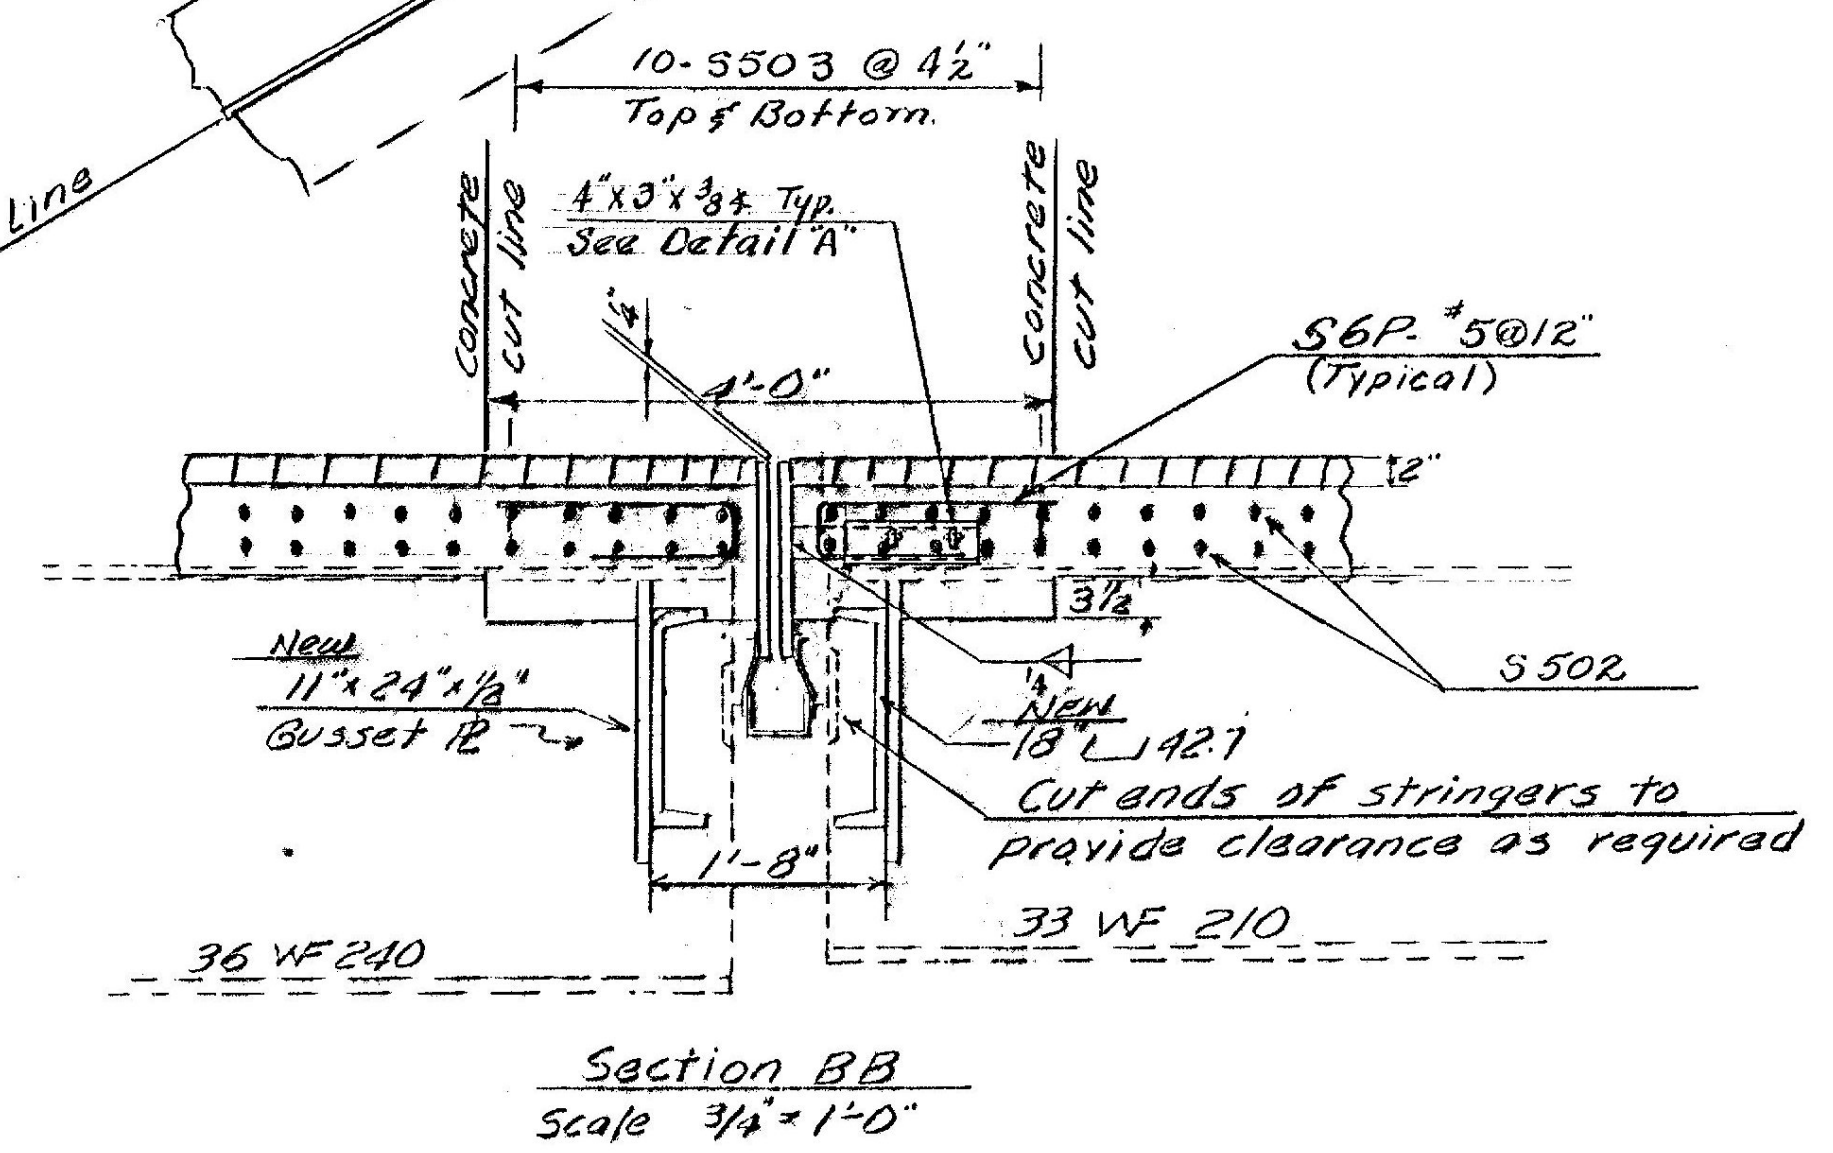


Section BB  
 Scale 3/4" = 1'-0"

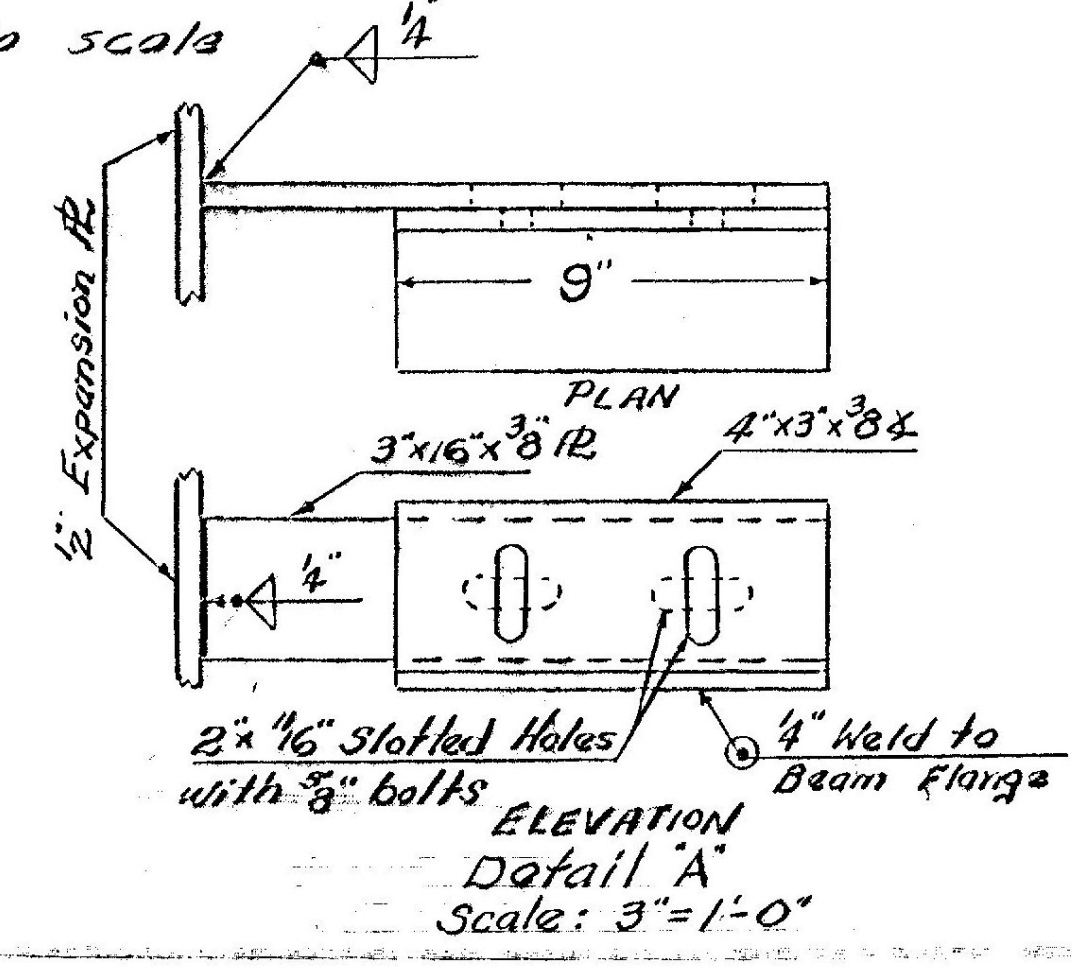

Elevation  
 Detail A  
 Scale: 3" = 1'-0"

**HARTLAND  
 BRIDGE 66  
 BHF BPNT(12)  
 SHEET 54 OF 55  
 FOR  
 REFERENCE  
 ONLY**


STATE OF VERMONT DEPARTMENT OF HIGHWAYS	
TOWN OF <u>Hartland</u>	
ROUTE NO. <u>U.S. 5</u>	LOG STA. <u>313+85</u>
<u>Route 5 Bridge over C.V. Ry.</u>	
Curb-End Dams and Drain Details	
SCALE <u>As Noted</u>	
In Charge <u>R.H. Watson</u>	
DRAWN BY <u>MWR</u> CHECKED BY <u>D. Mayo</u>	
PROJECT NO. <u>SP-041-2-6593</u>	
SHEET <u>5</u> OF <u>24</u>	

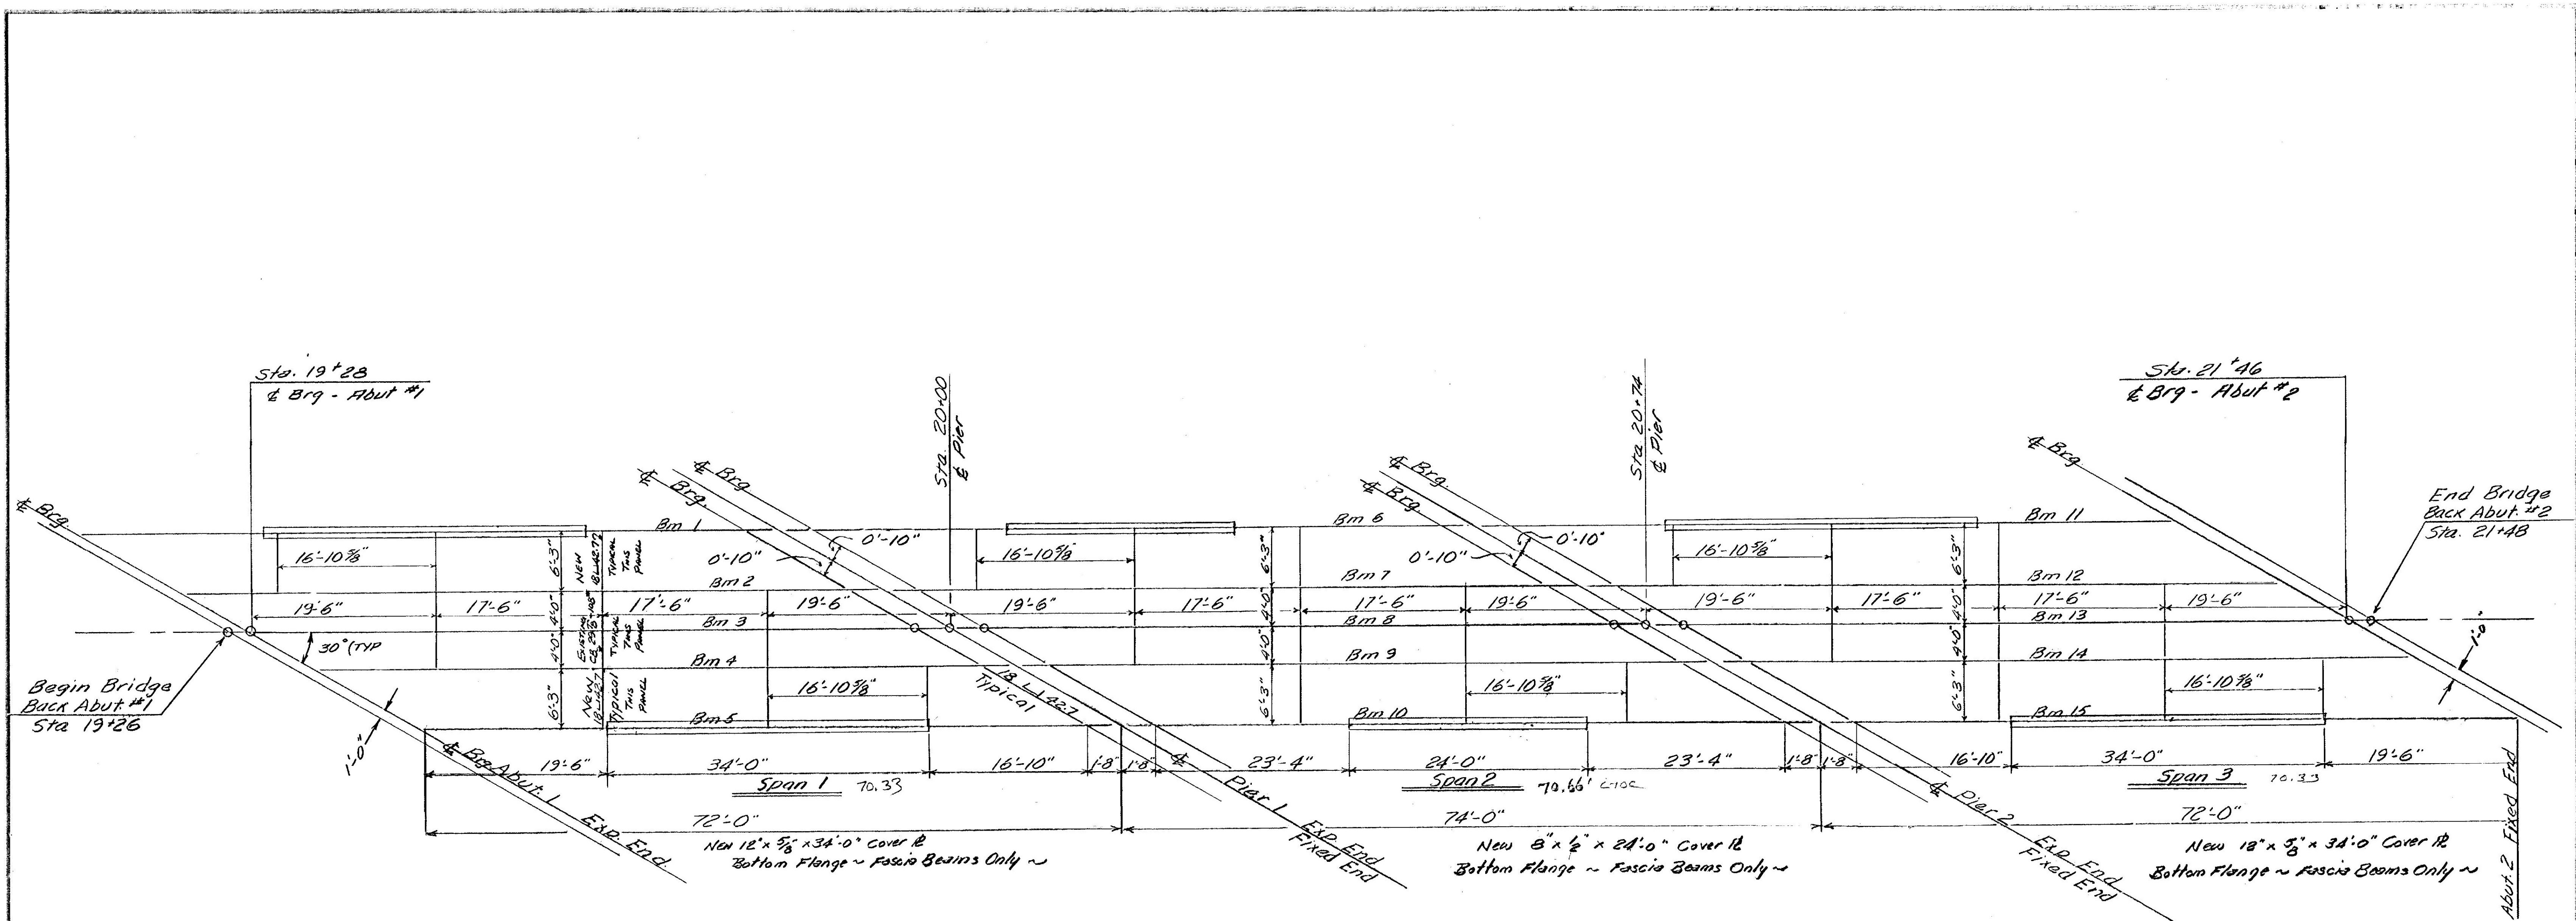

Framing Plan

Existing intermediate diaphragms between fascia beams and adjacent beam to be removed and replaced with new 18" L 42.7. All connections to be welded. Two 1/2" bolts may be used at each end for erection purposes.

For Pier diaphragm details see sheet #5

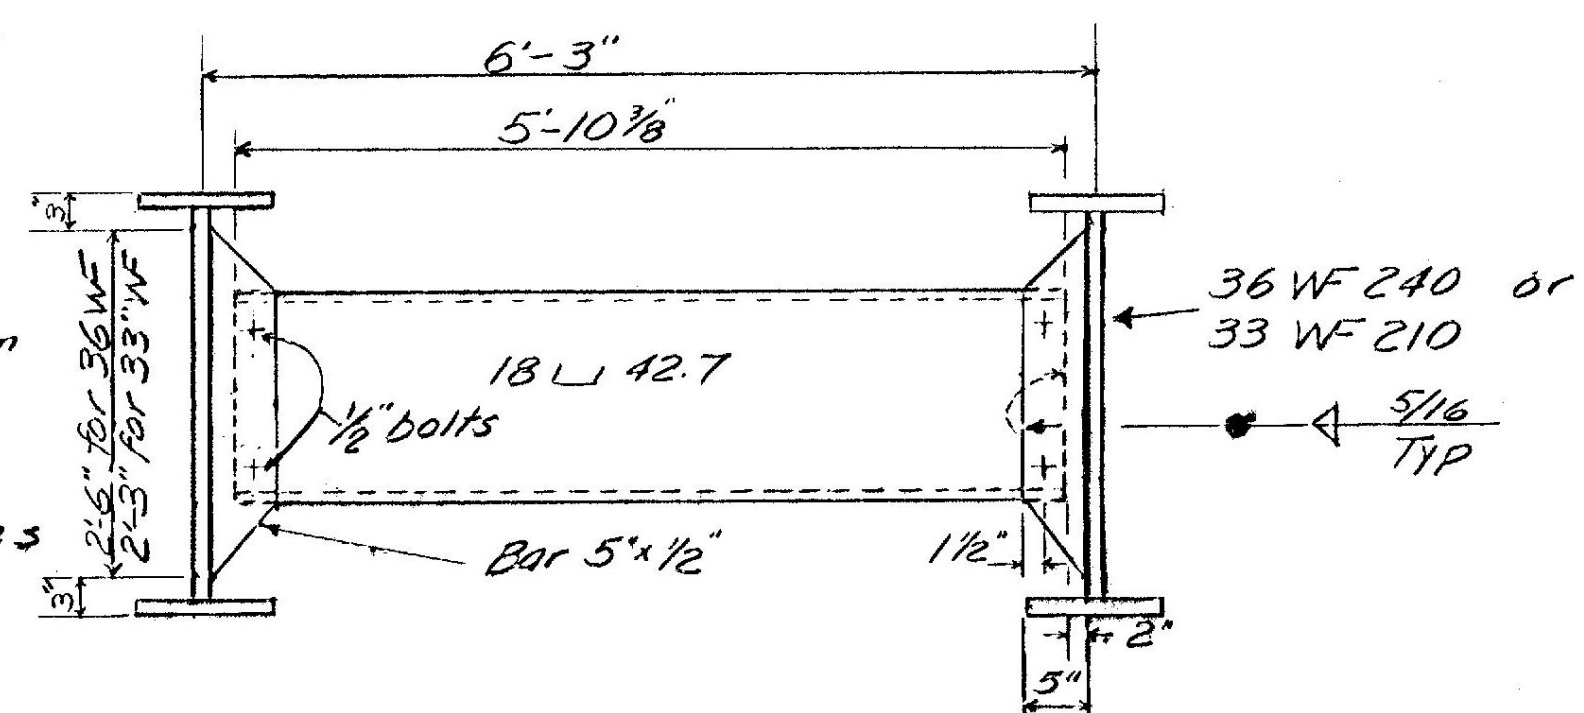

Intermediate Diaphragms Typical  
For details not shown see SCB-D7-65

HARTLAND  
BRIDGE 66  
BHF BPNT(12)  
SHEET 55 OF 55  
FOR  
REFERENCE  
ONLY

STATE OF VERMONT  
DEPARTMENT OF HIGHWAYS

TOWN OF Hartland  
ROUTE NO. U.S. 5 LOG STA. 313+85  
U.S. 5 Bridge over C.V. RY.  
Framing Plan  
SCALE 1/8" = 1'-0"  
In Charge R.H. Watson  
DRAWN BY M. Radmond CHECKED BY D. Mayo  
PROJECT NO. SP041-2-6533  
SHEET 6 OF 24