




26+25

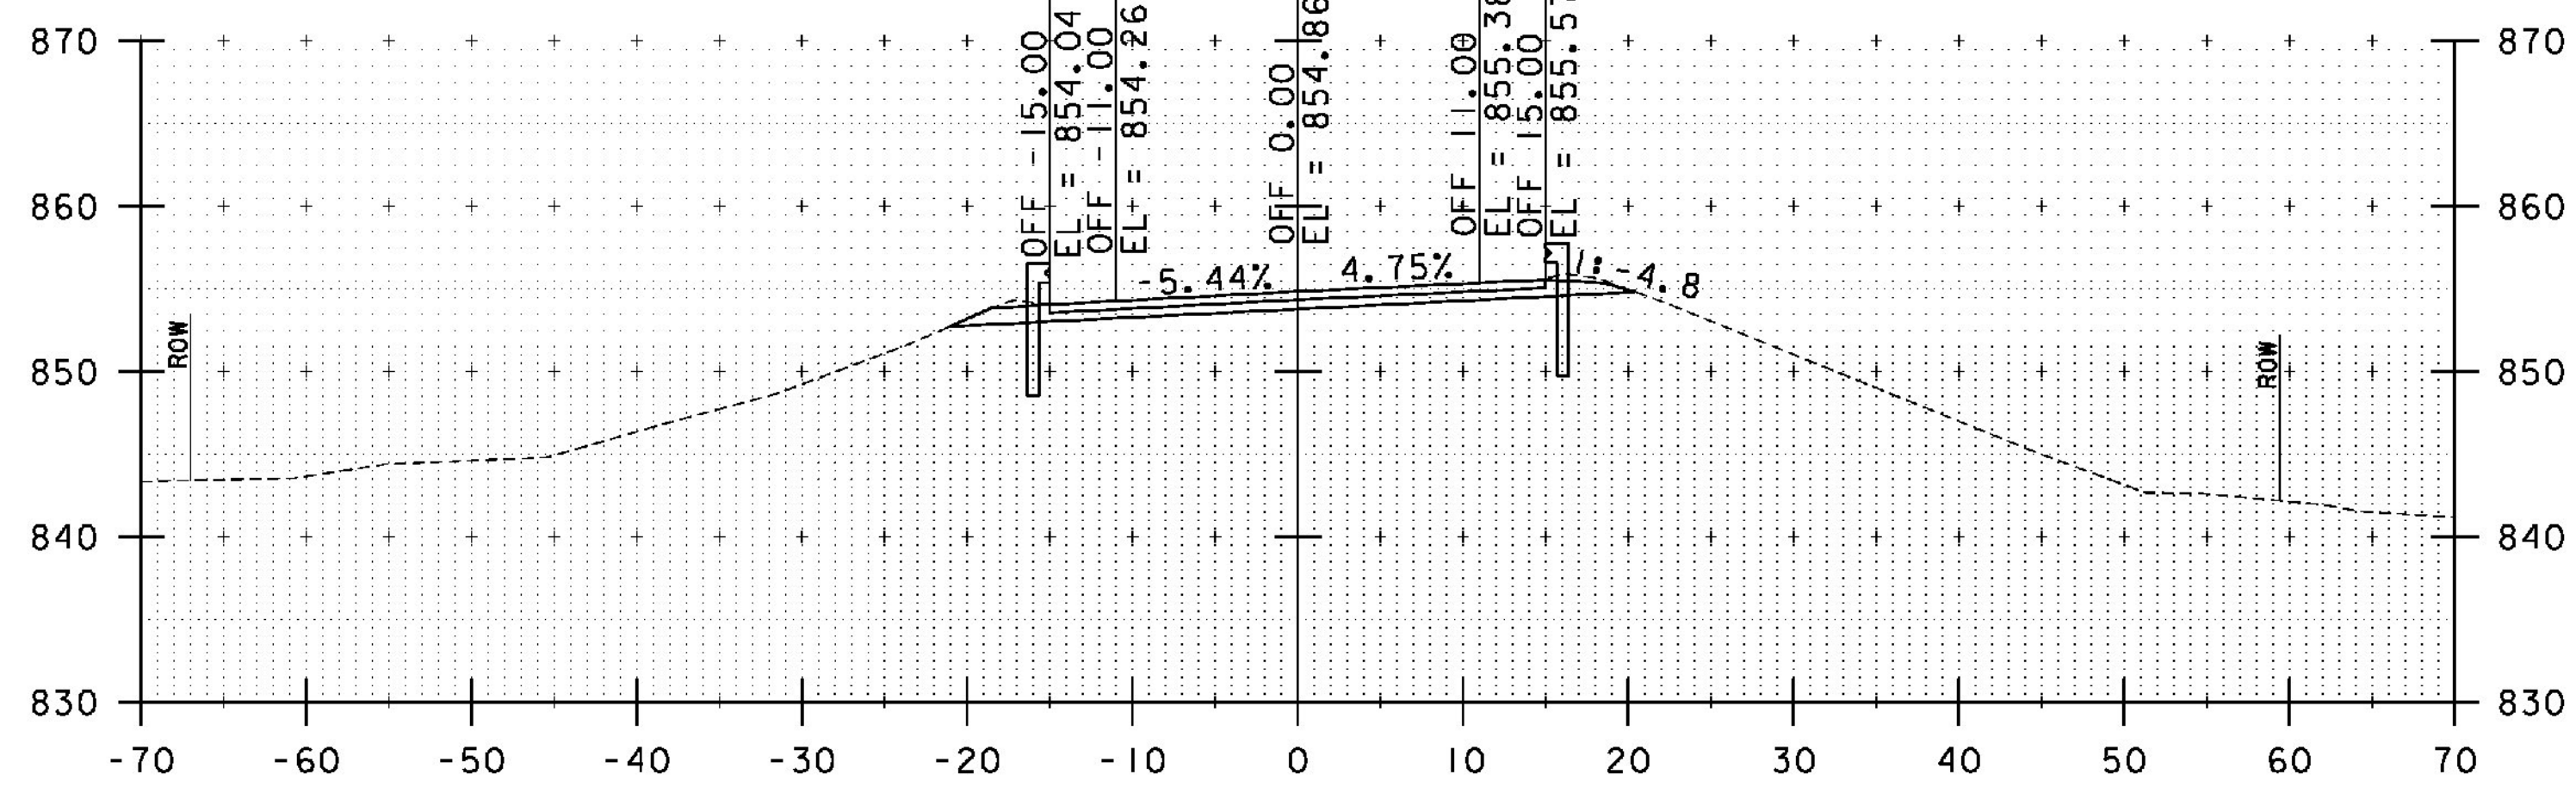

26+00

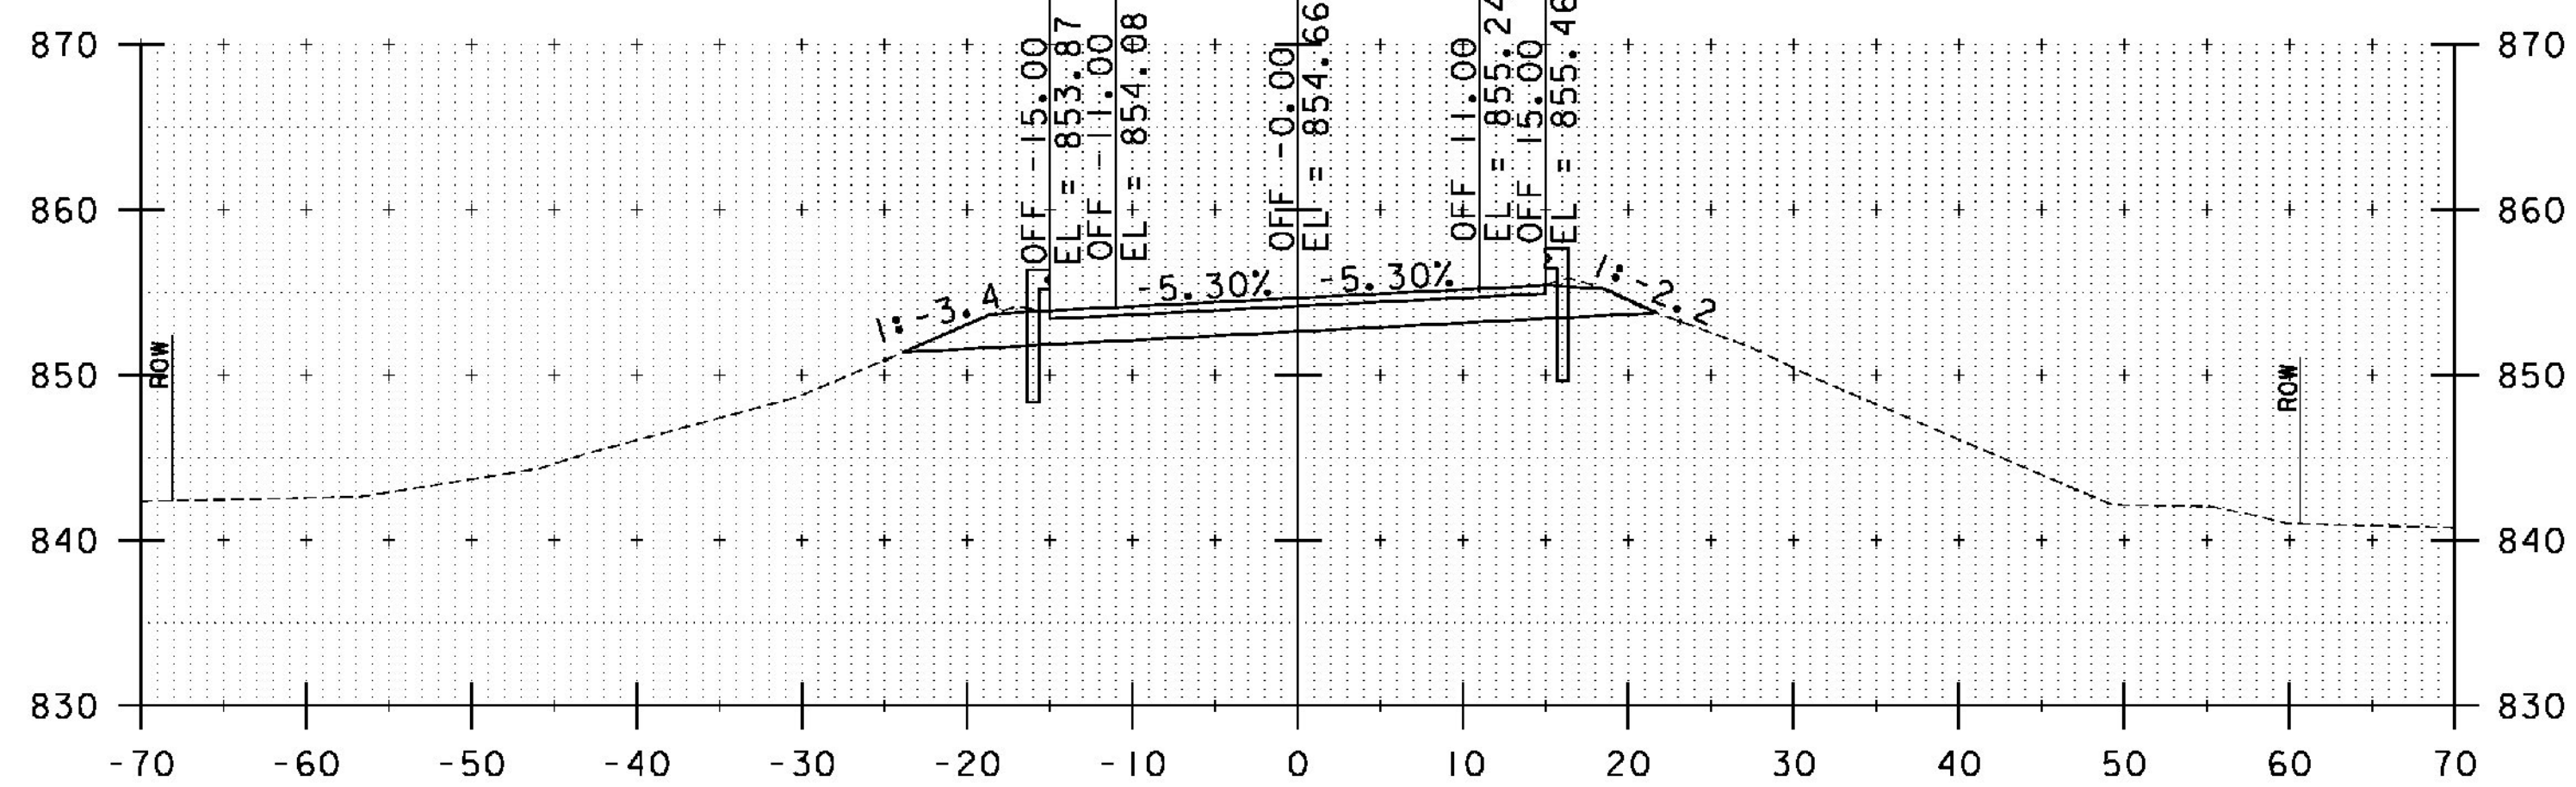


25+75

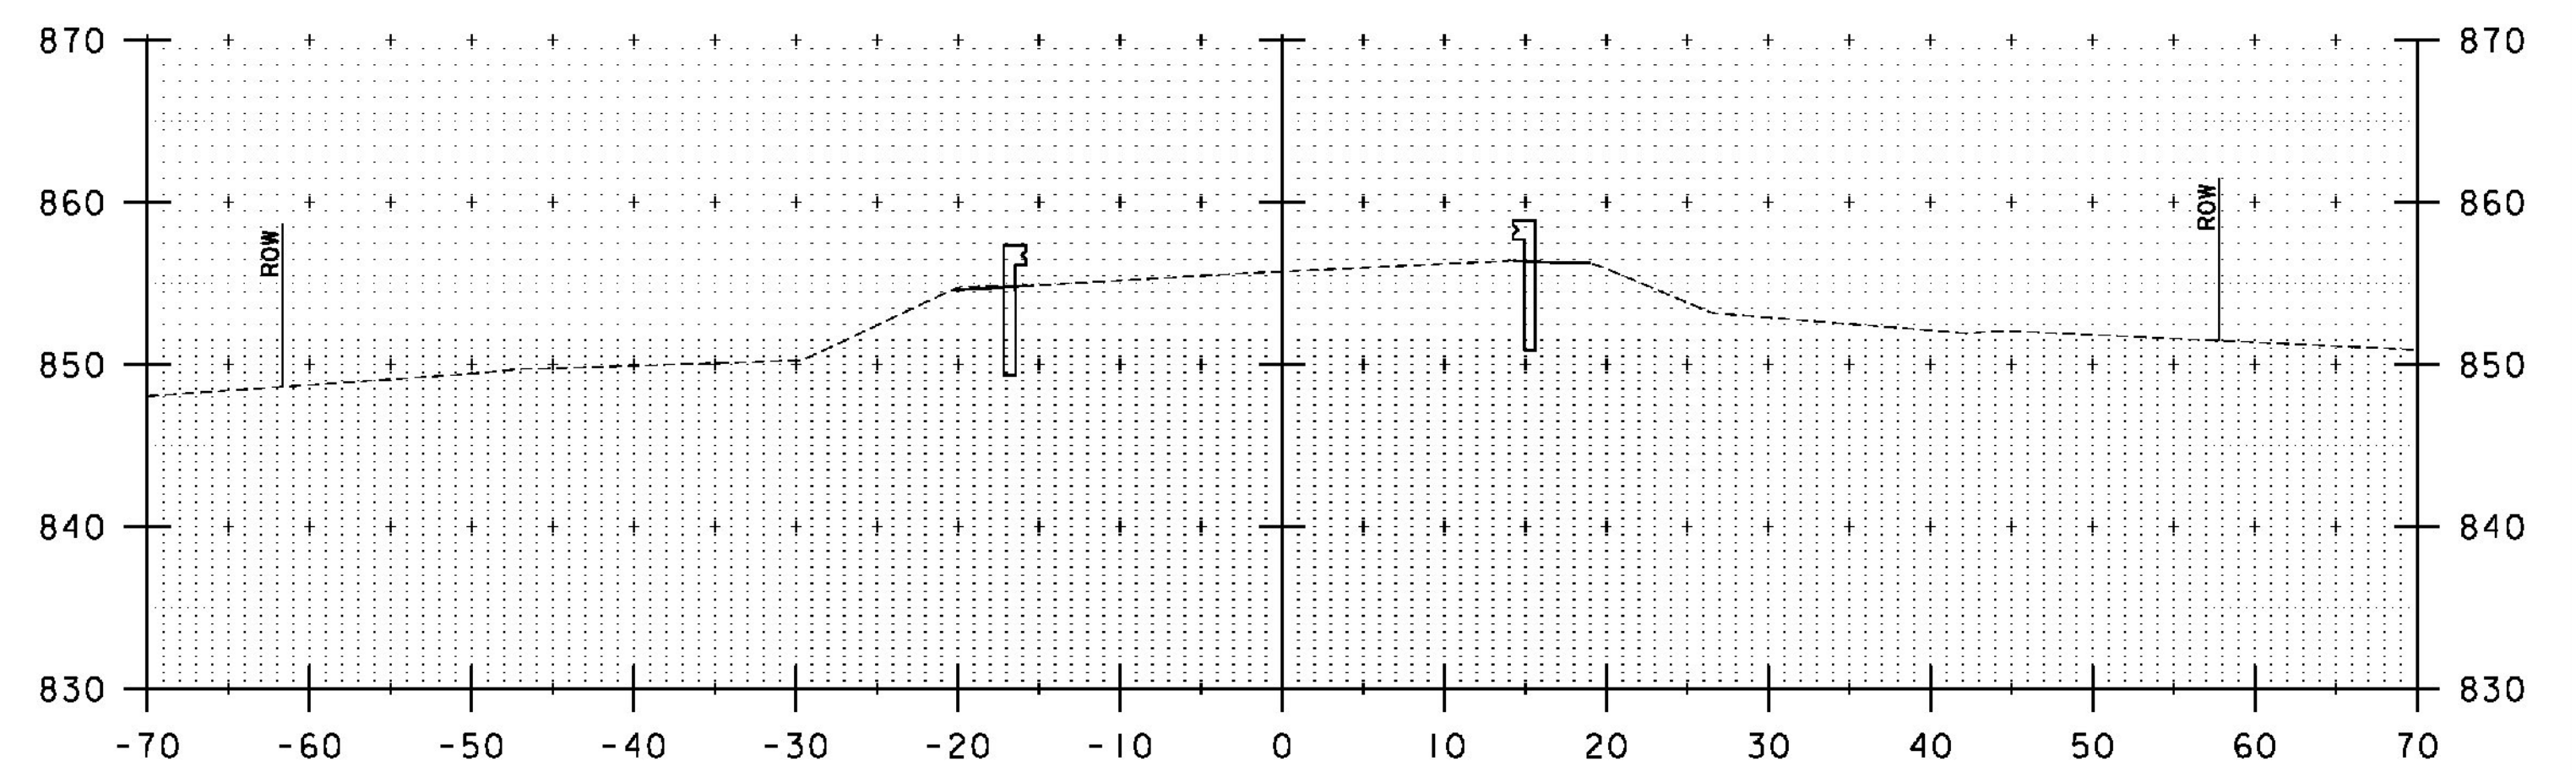

26+63
END APPROACH

26+75

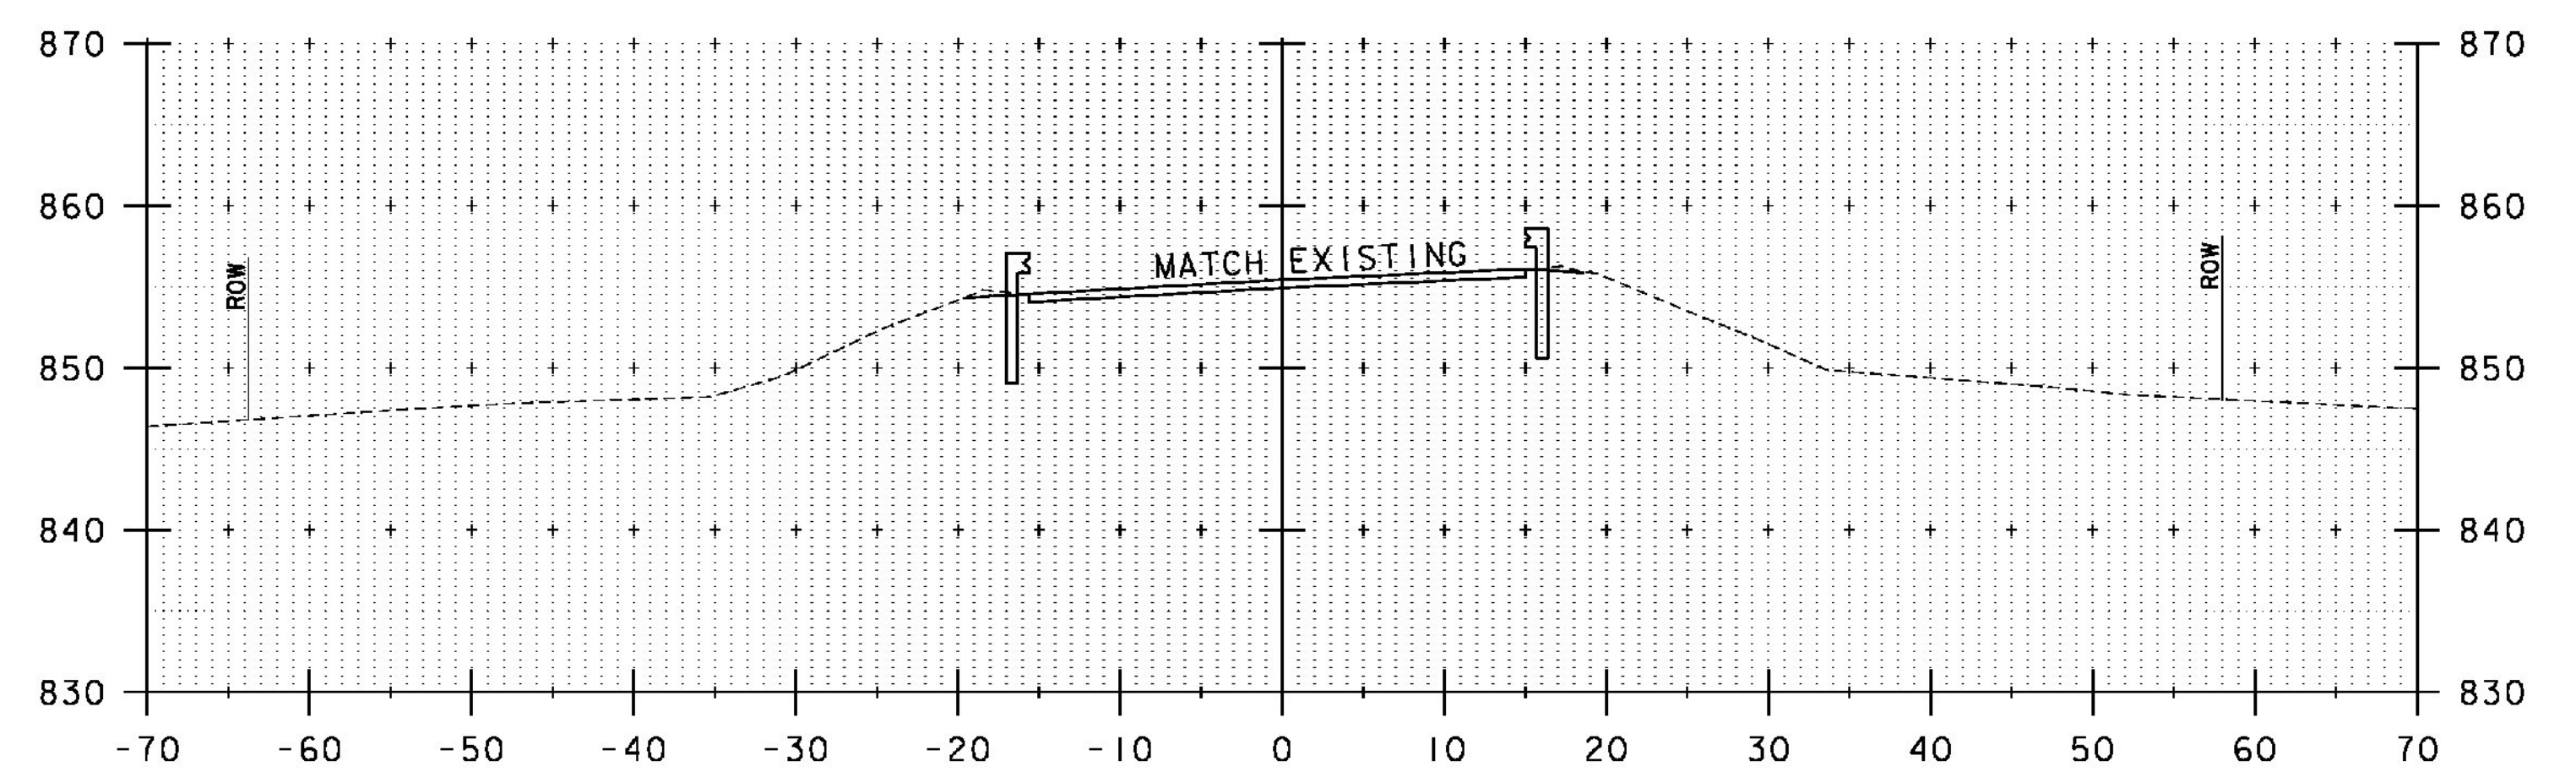

26+50

STA. 25+75 TO STA. 26+75

PROJECT NAME: IRASBURG
PROJECT NUMBER: STP CULV(30)

FILE NAME: z1lc266xs.dgn
PROJECT LEADER: M. CHENETTE
DESIGNED BY: J. HUNGERFORD
ROADWAY CROSS SECTIONS - RXS3 - BR6

PLOT DATE: 9/26/2014
DRAWN BY: L. BUXTON
CHECKED BY: M. CHENETTE
SHEET 23 OF 55

