




11+10

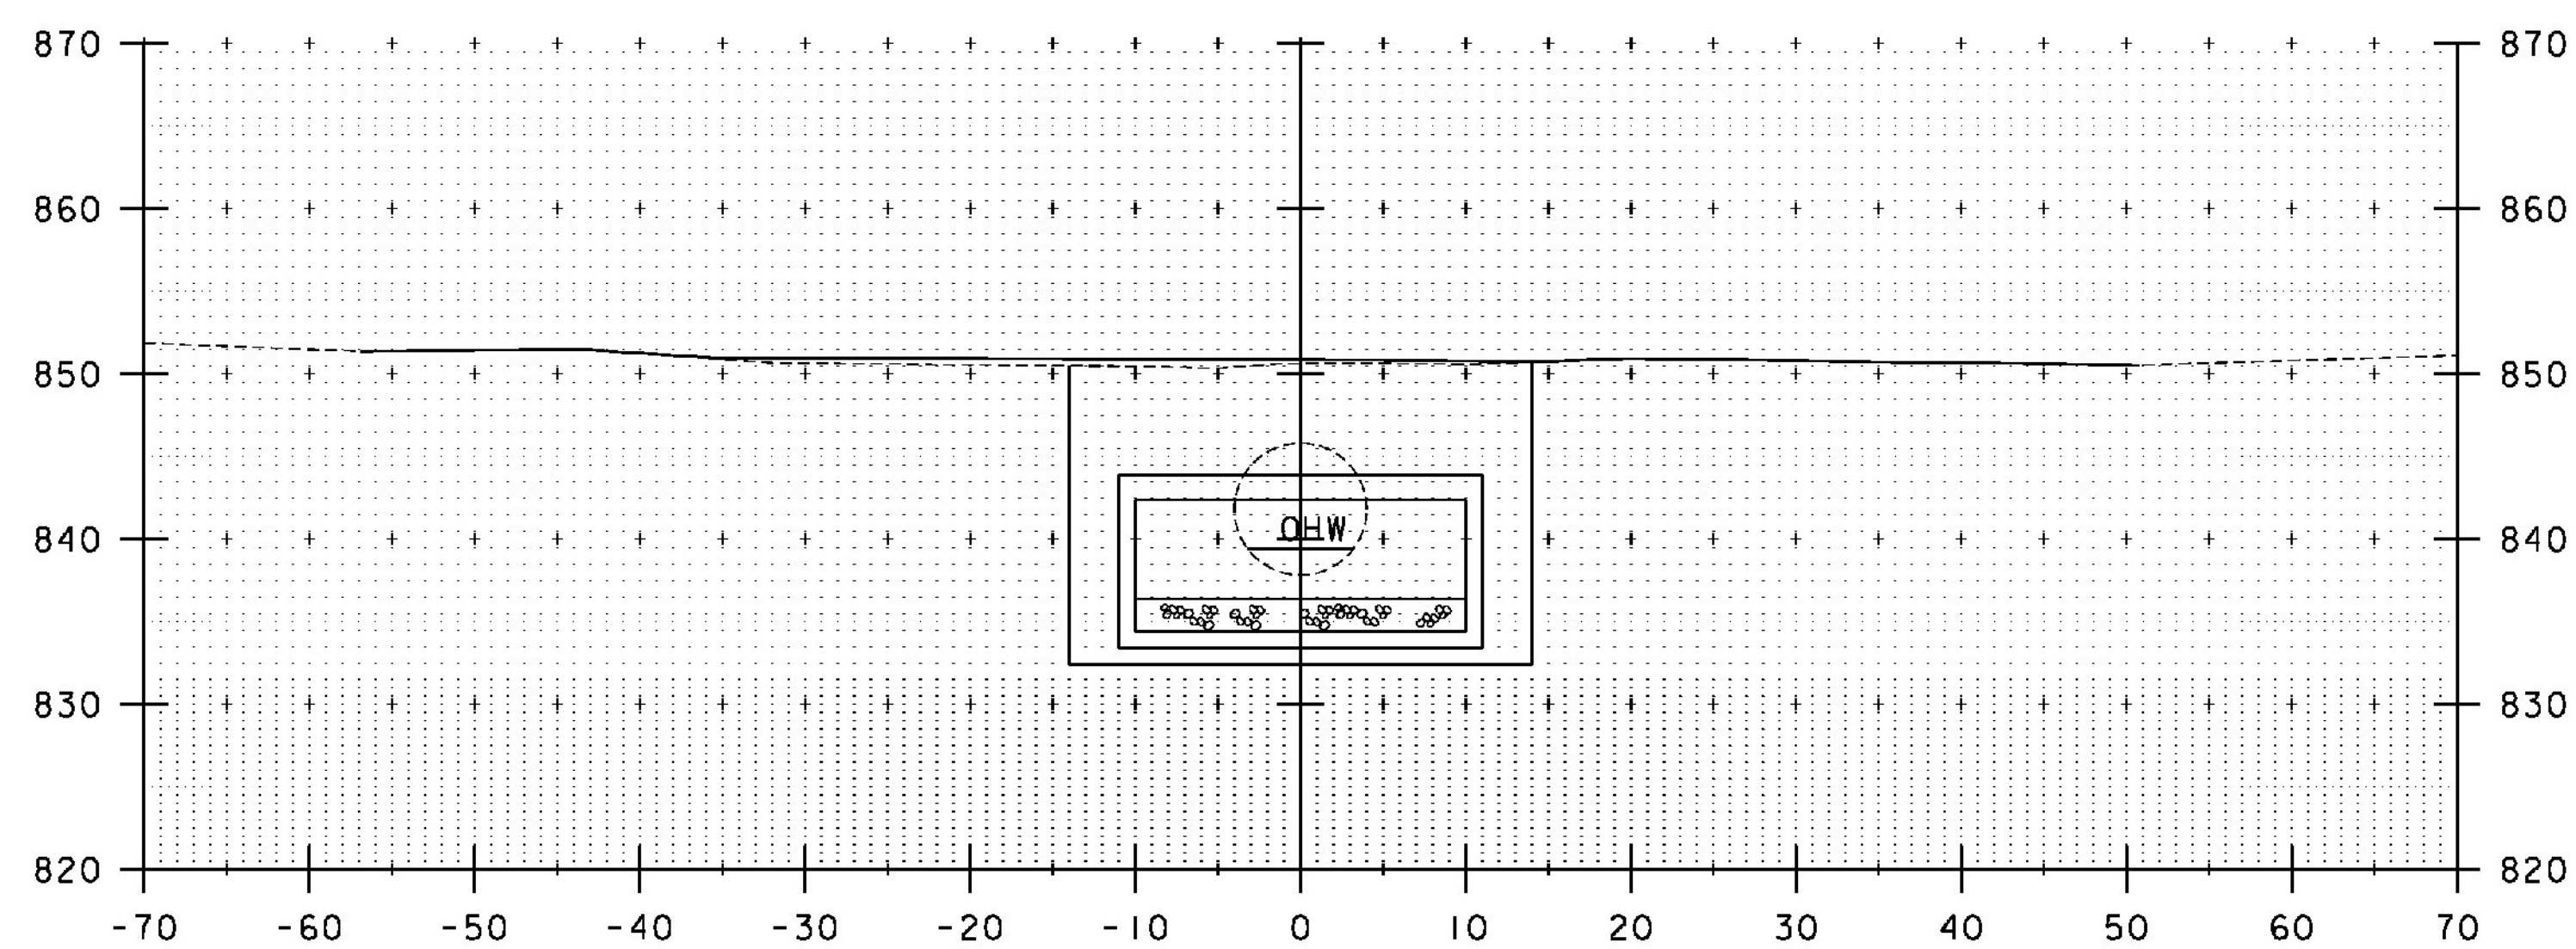

11+30

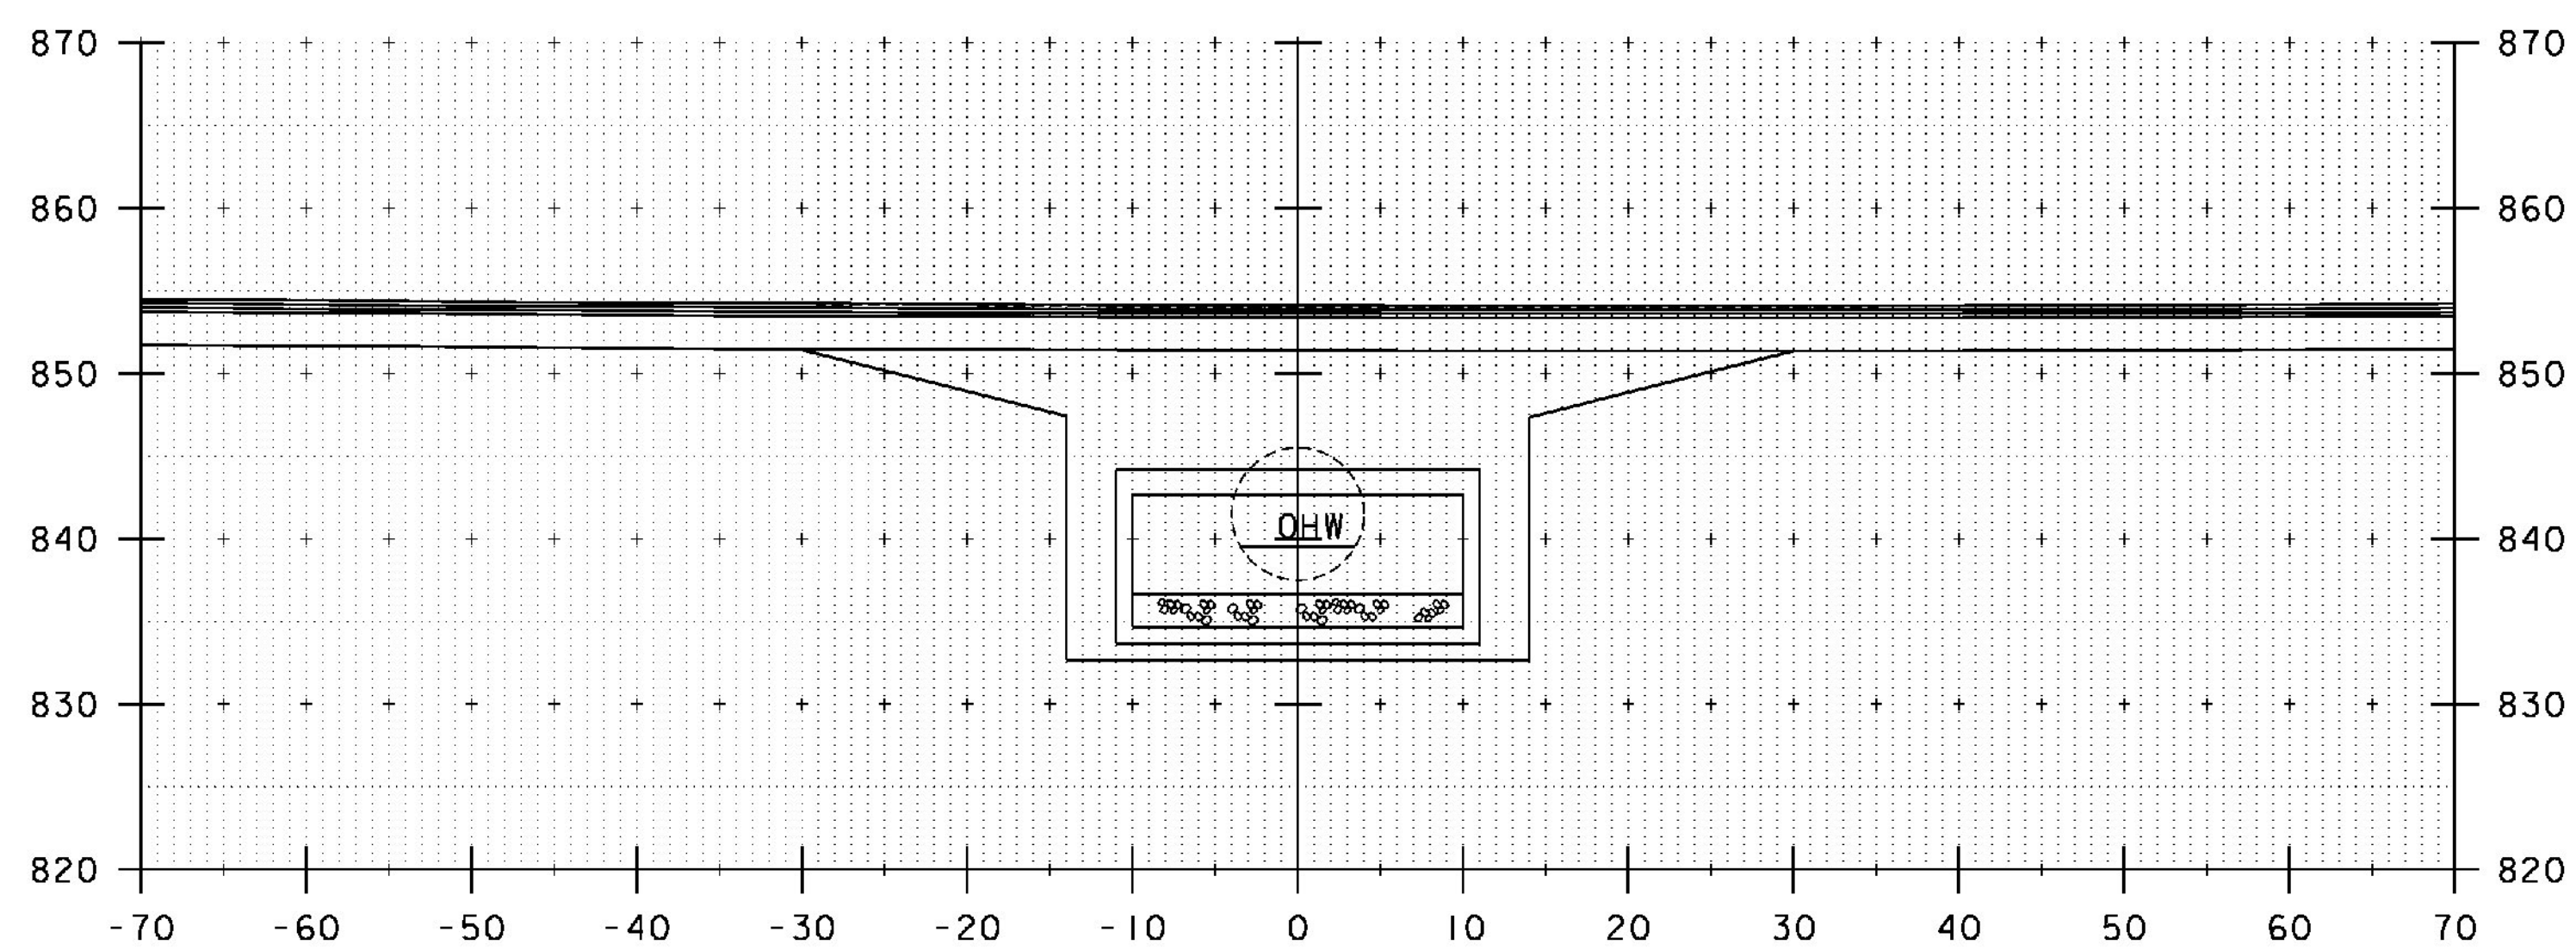

11+00

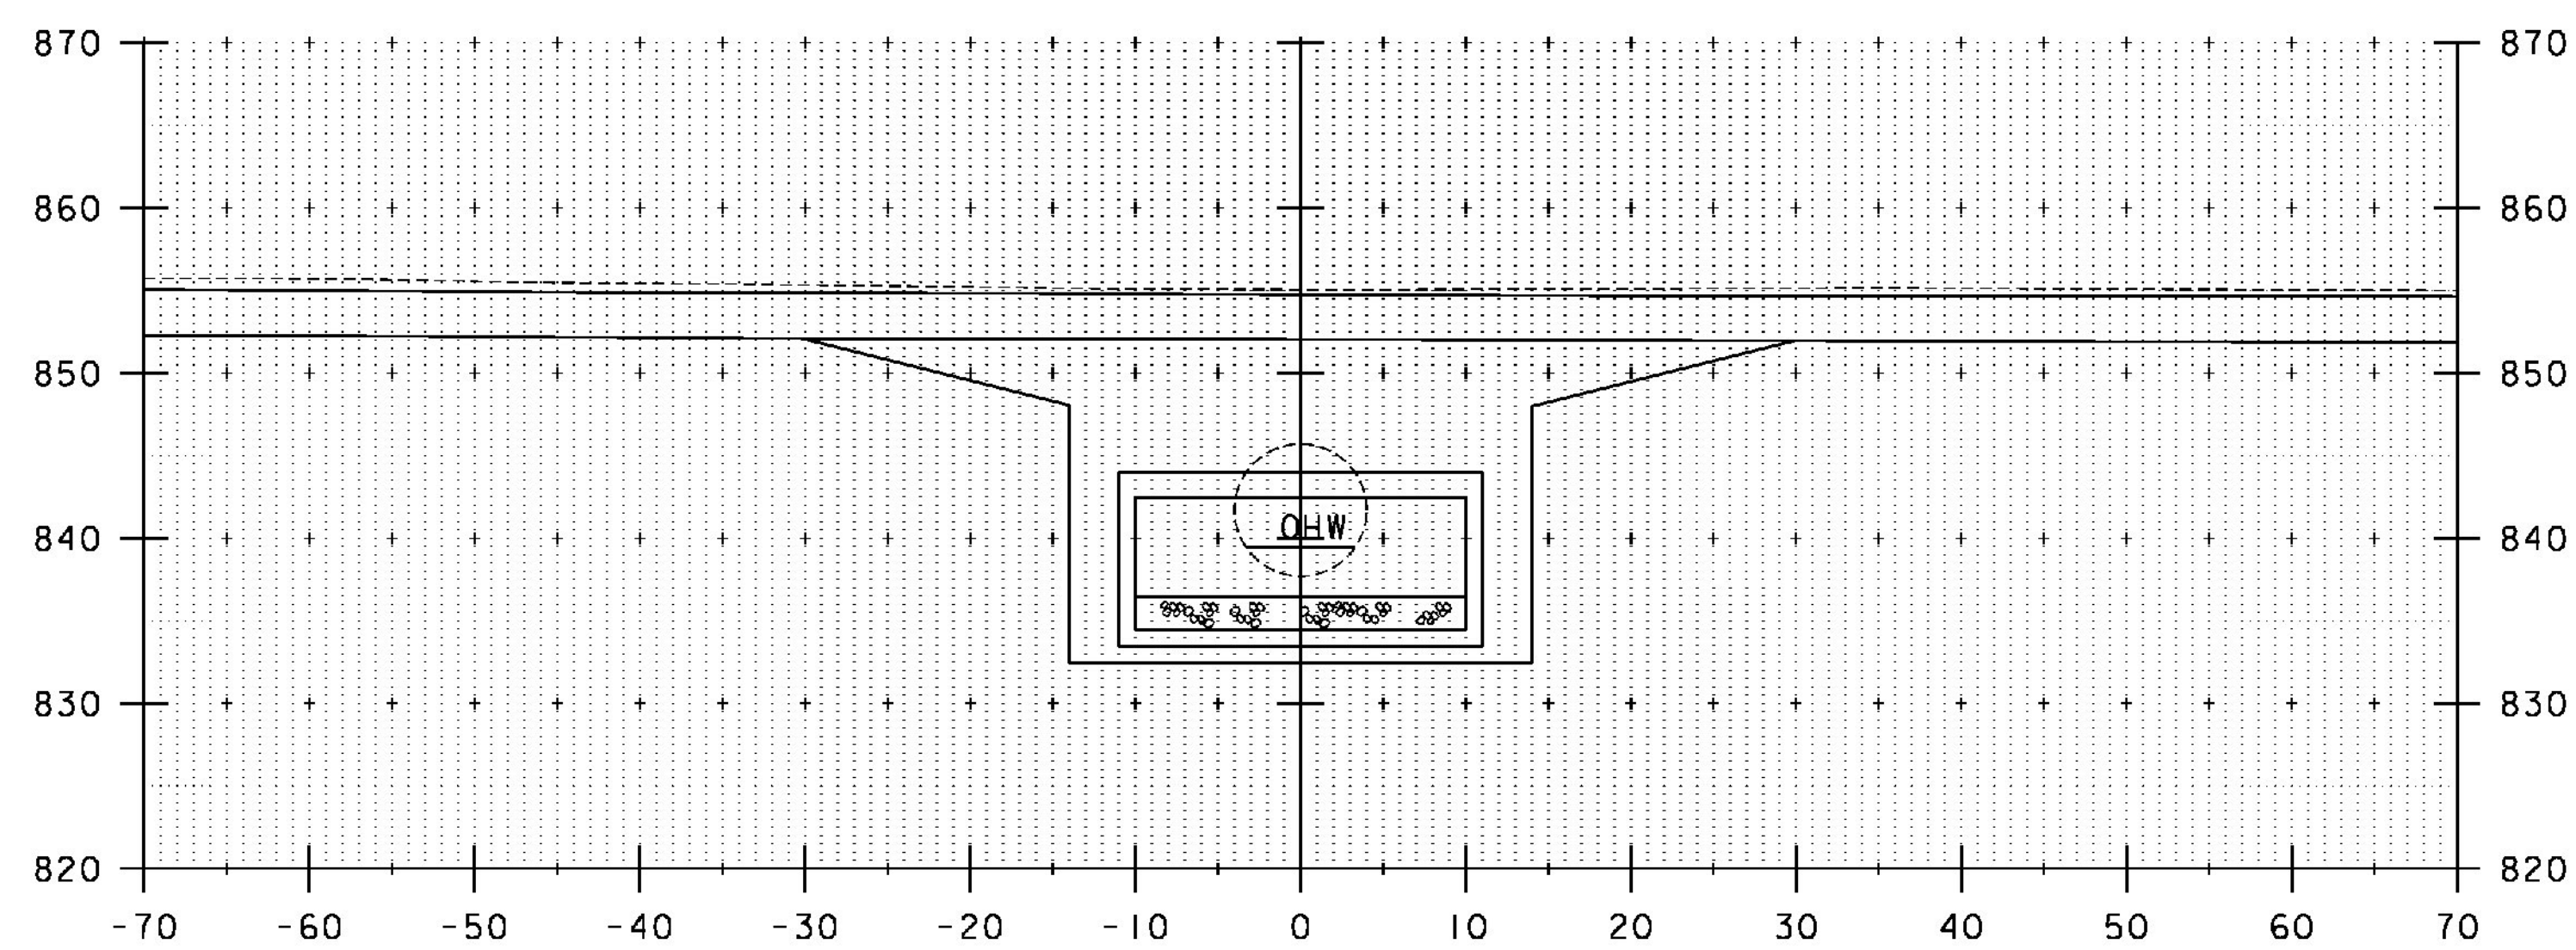

11+20

STA. 11+00 TO STA. 11+30

PROJECT NAME: IRASBURG
PROJECT NUMBER: STP CULV(30)

FILE NAME: z11c266xs.dgn
PROJECT LEADER: M. CHENETTE
DESIGNED BY: J. HUNGERFORD
CHANNEL CROSS SECTIONS - CXS2 - BR6

PLOT DATE: 9/26/2014
DRAWN BY: L. BUXTON
CHECKED BY: M. CHENETTE
SHEET 25 OF 55

