



33+55
BEGIN APPROACH


33+75

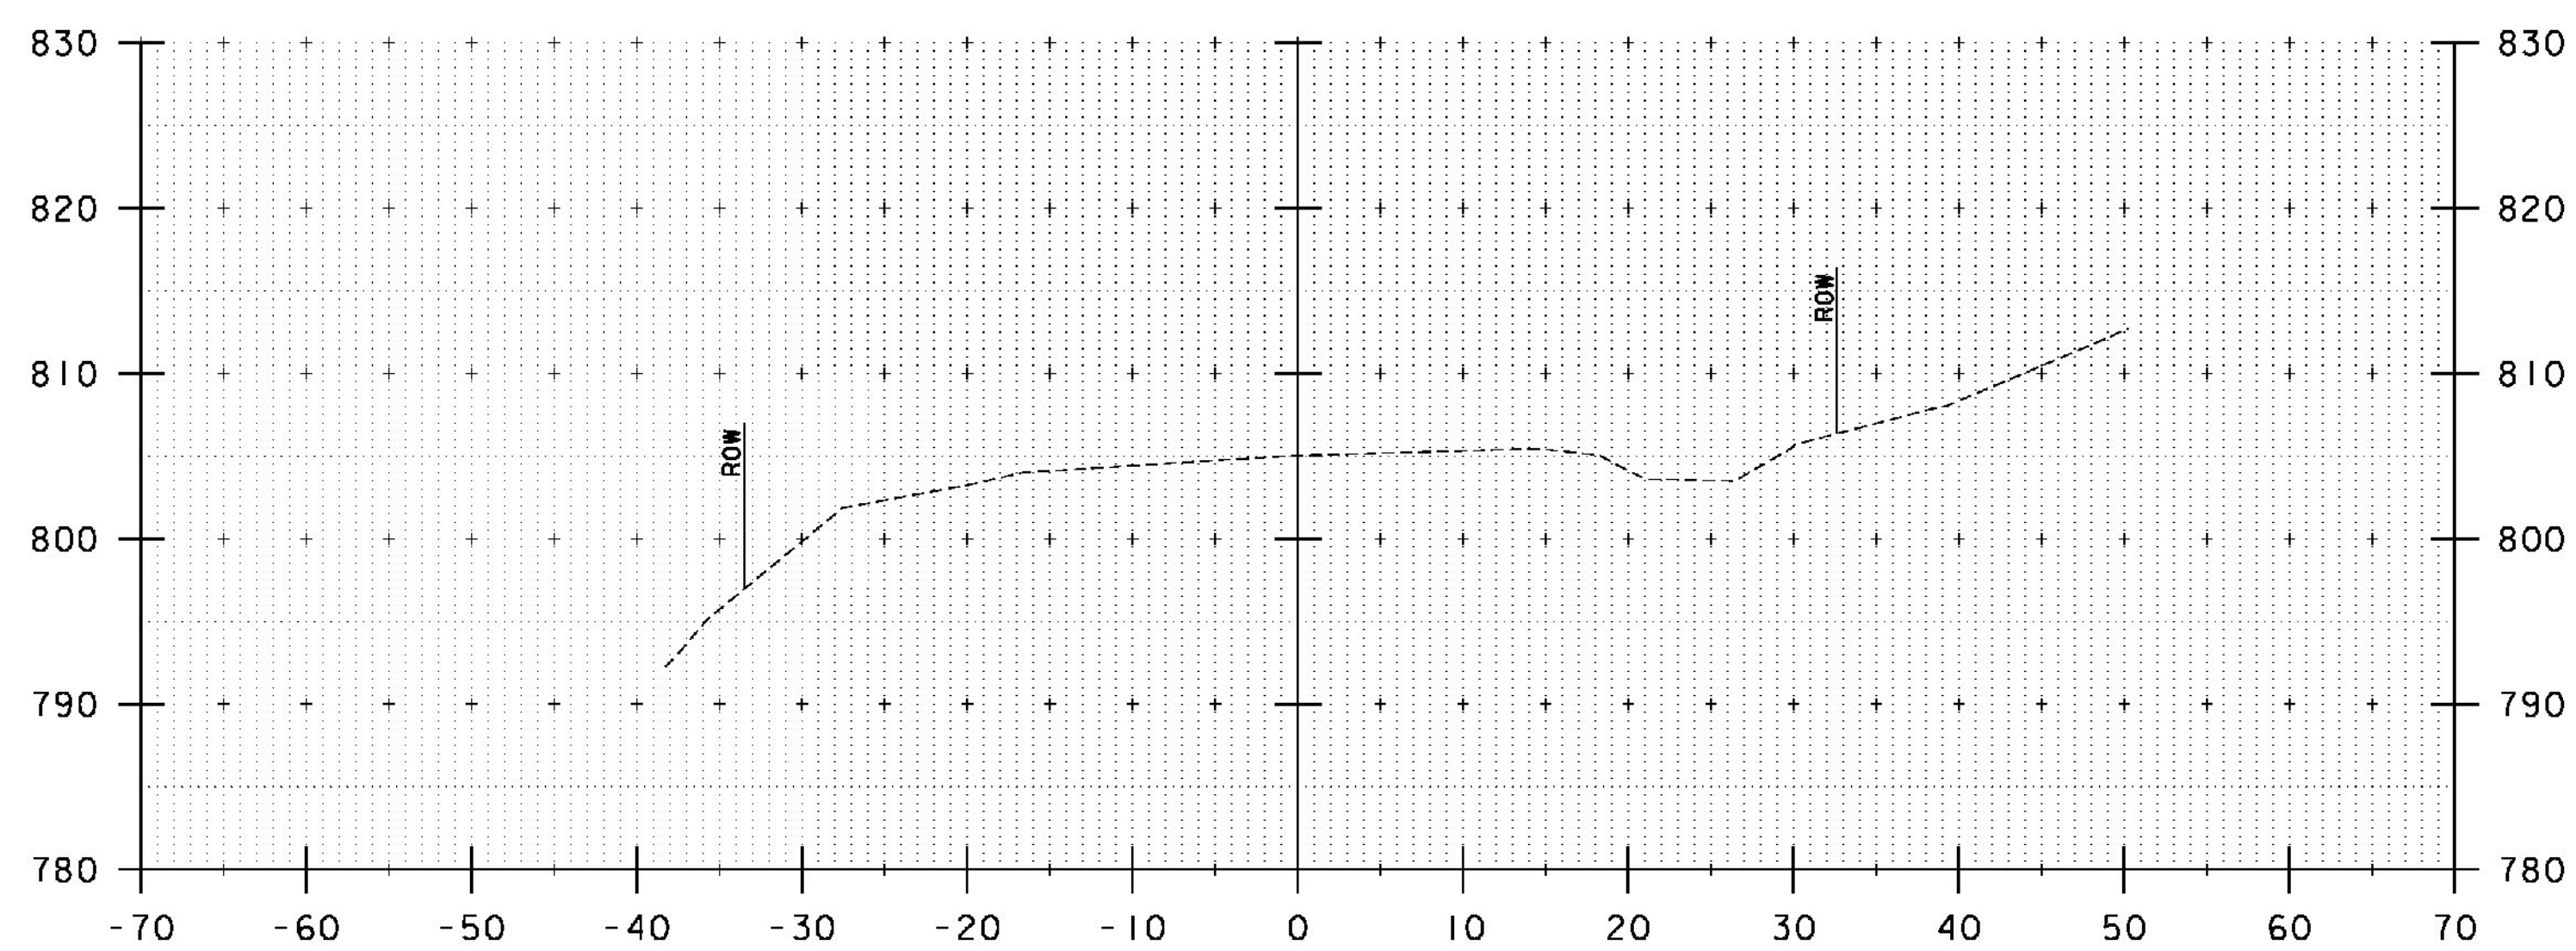

33+50

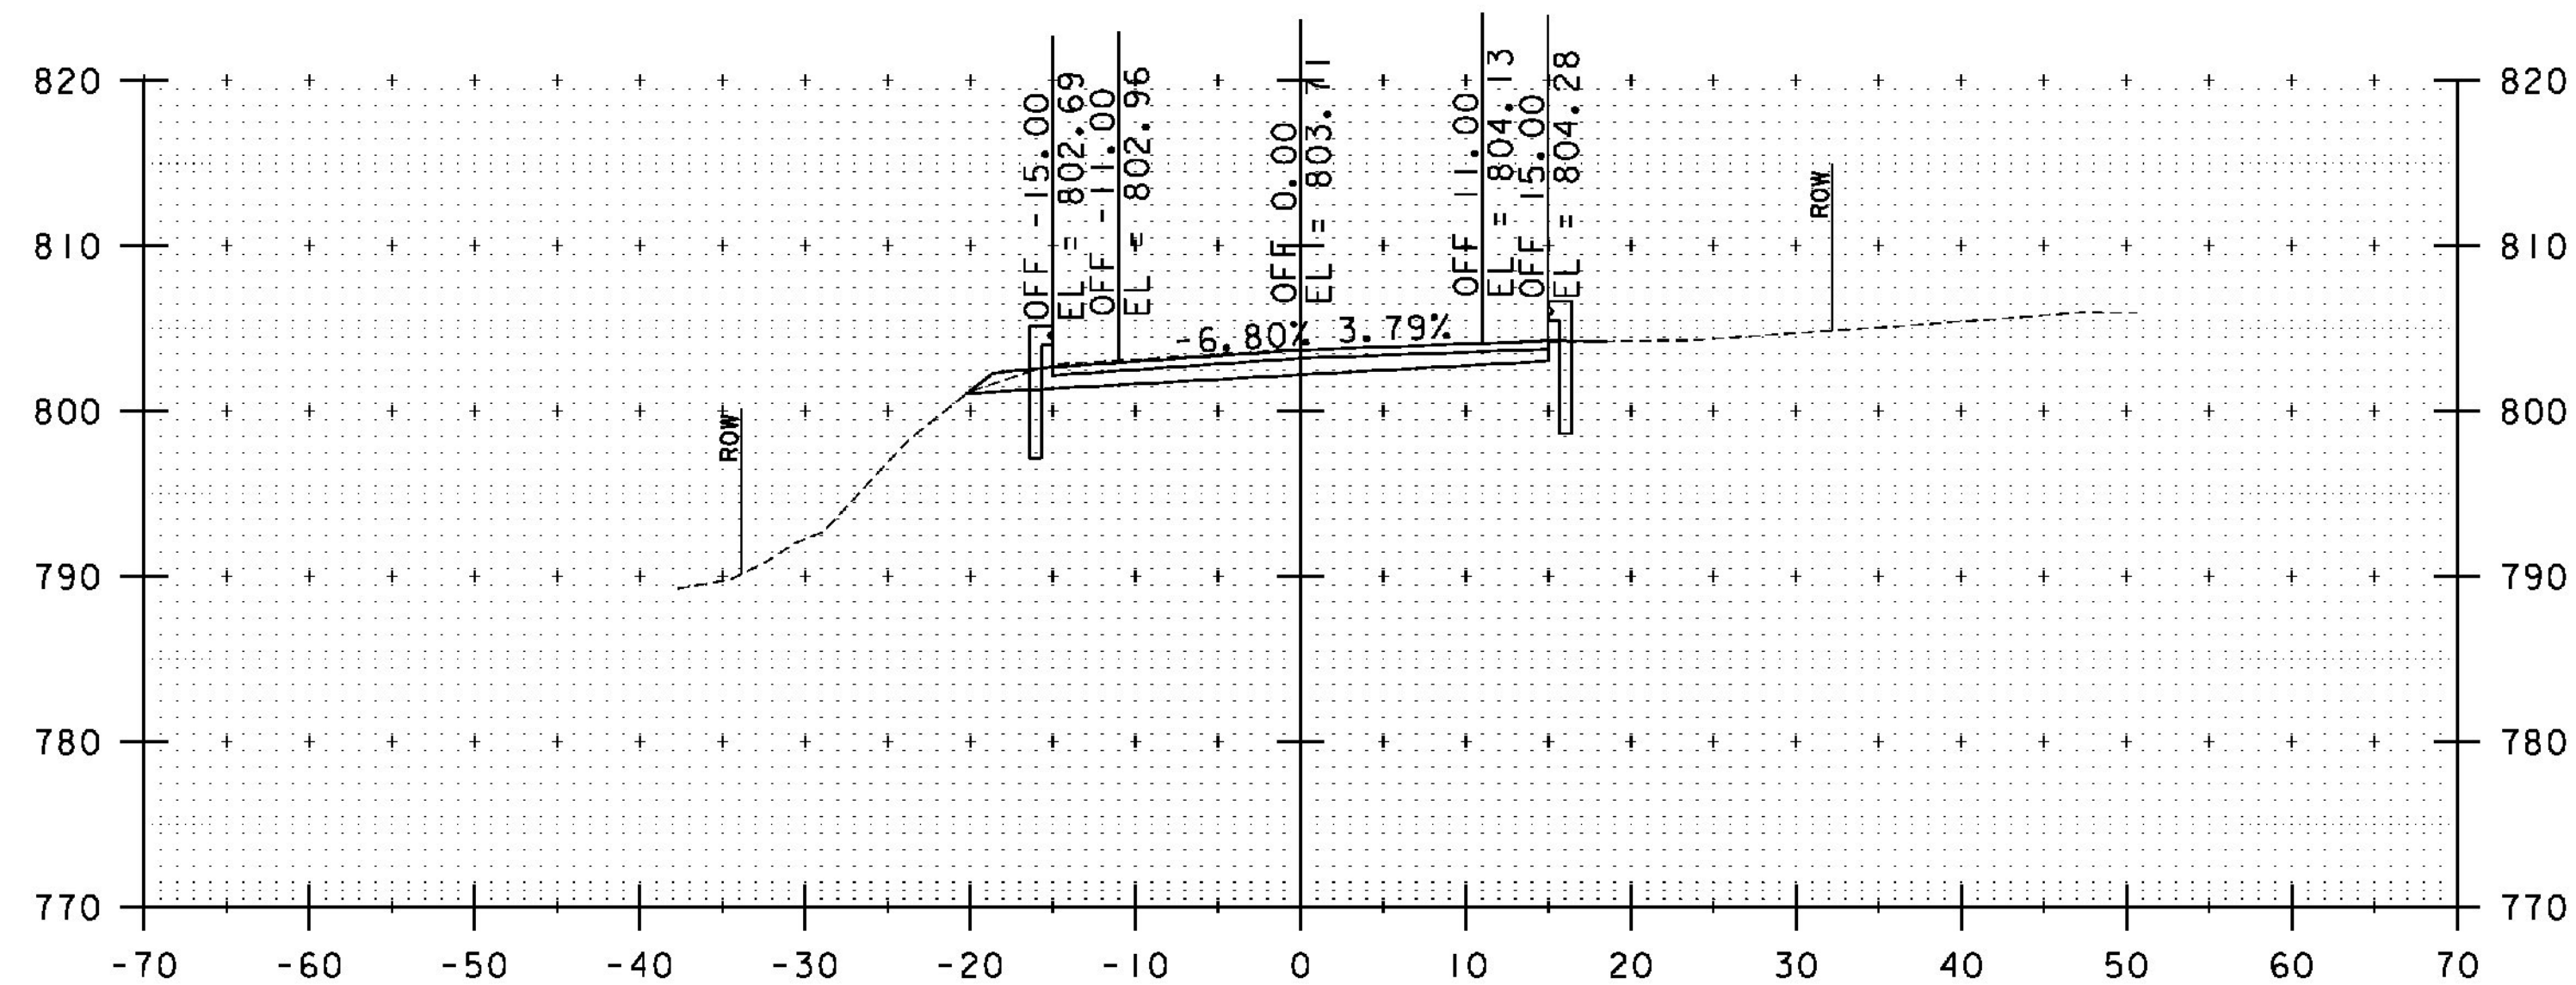

34+25

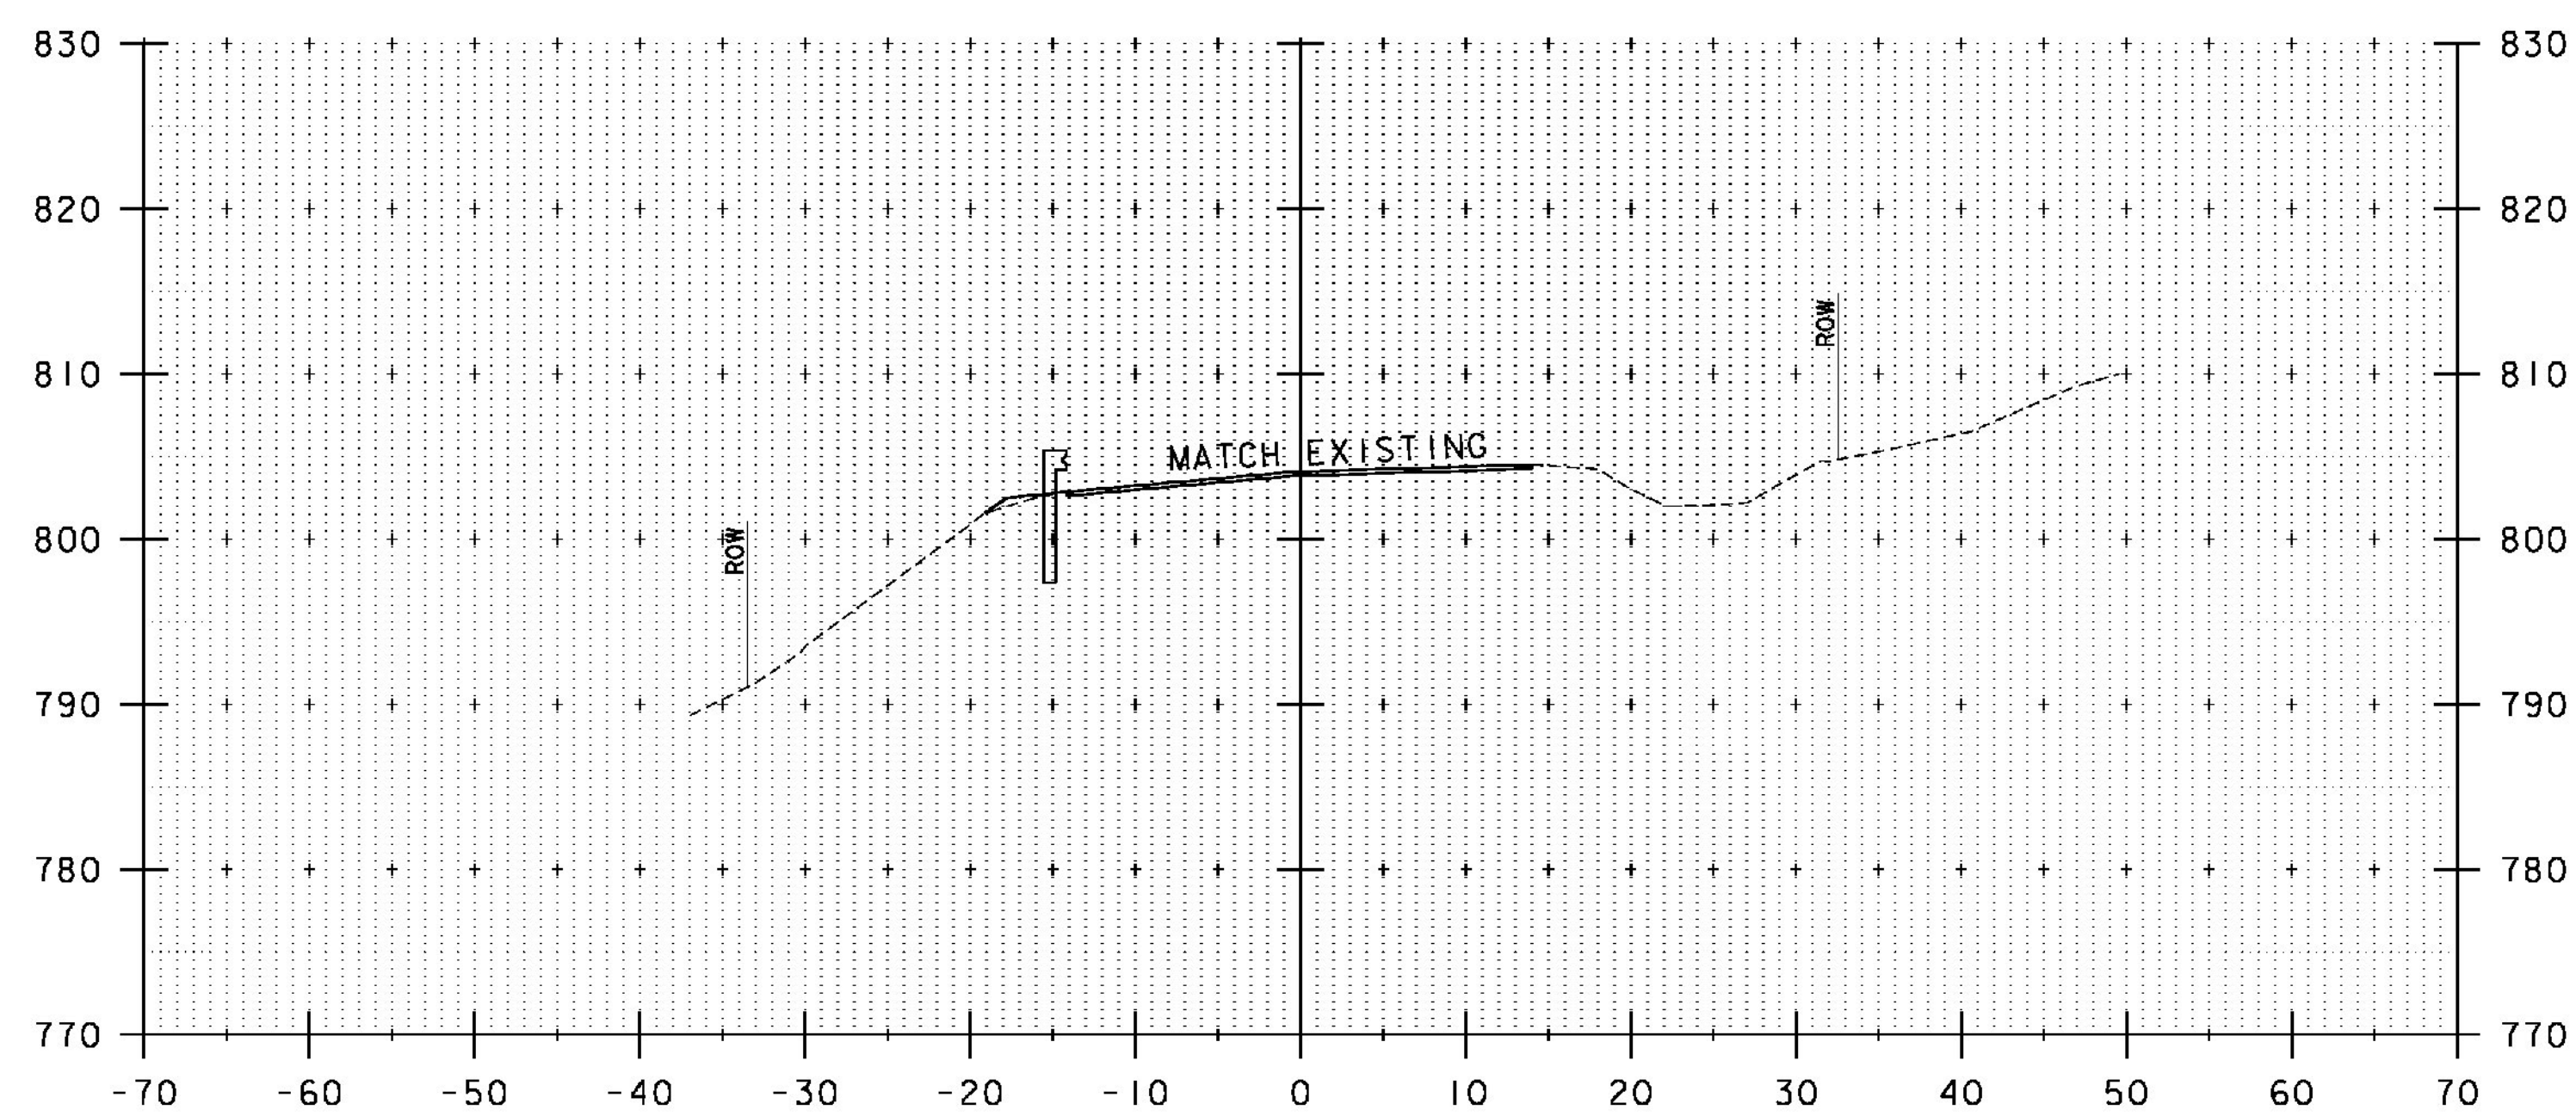

34+00

STA. 33+50 TO STA. 34+25

PROJECT NAME: IRASBURG
PROJECT NUMBER: STP CULV(30)

FILE NAME: z11c266xs.dgn
PROJECT LEADER: M. CHENETTE
DESIGNED BY: J. HUNGERFORD
ROADWAY CROSS SECTIONS - RXSI - BR7

PLOT DATE: 9/26/2014
DRAWN BY: L. BUXTON
CHECKED BY: M. CHENETTE
SHEET 42 OF 55

