




34+89.07  
BEGIN BRIDGE

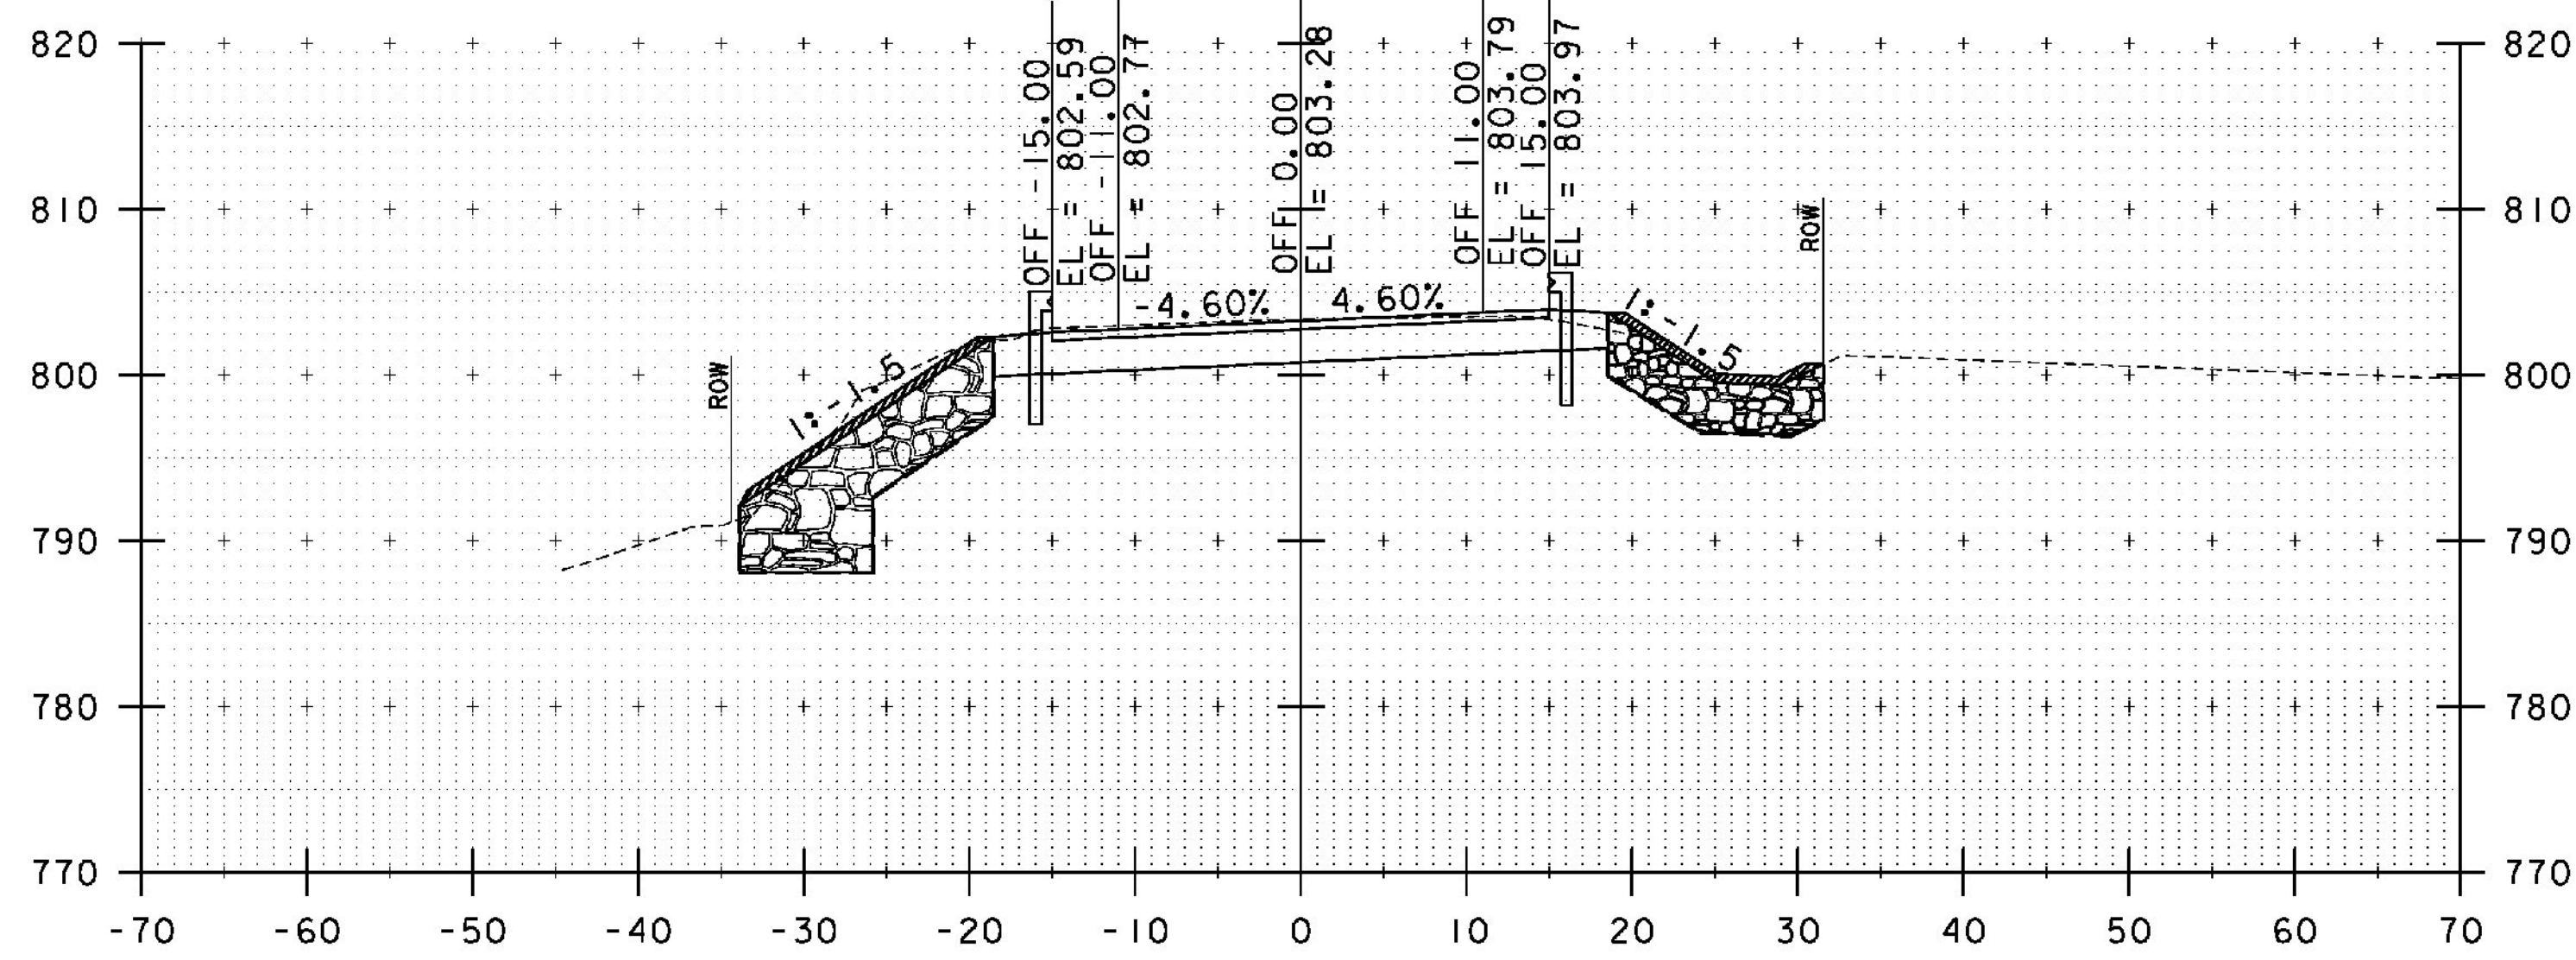


35+47  
END PROJECT

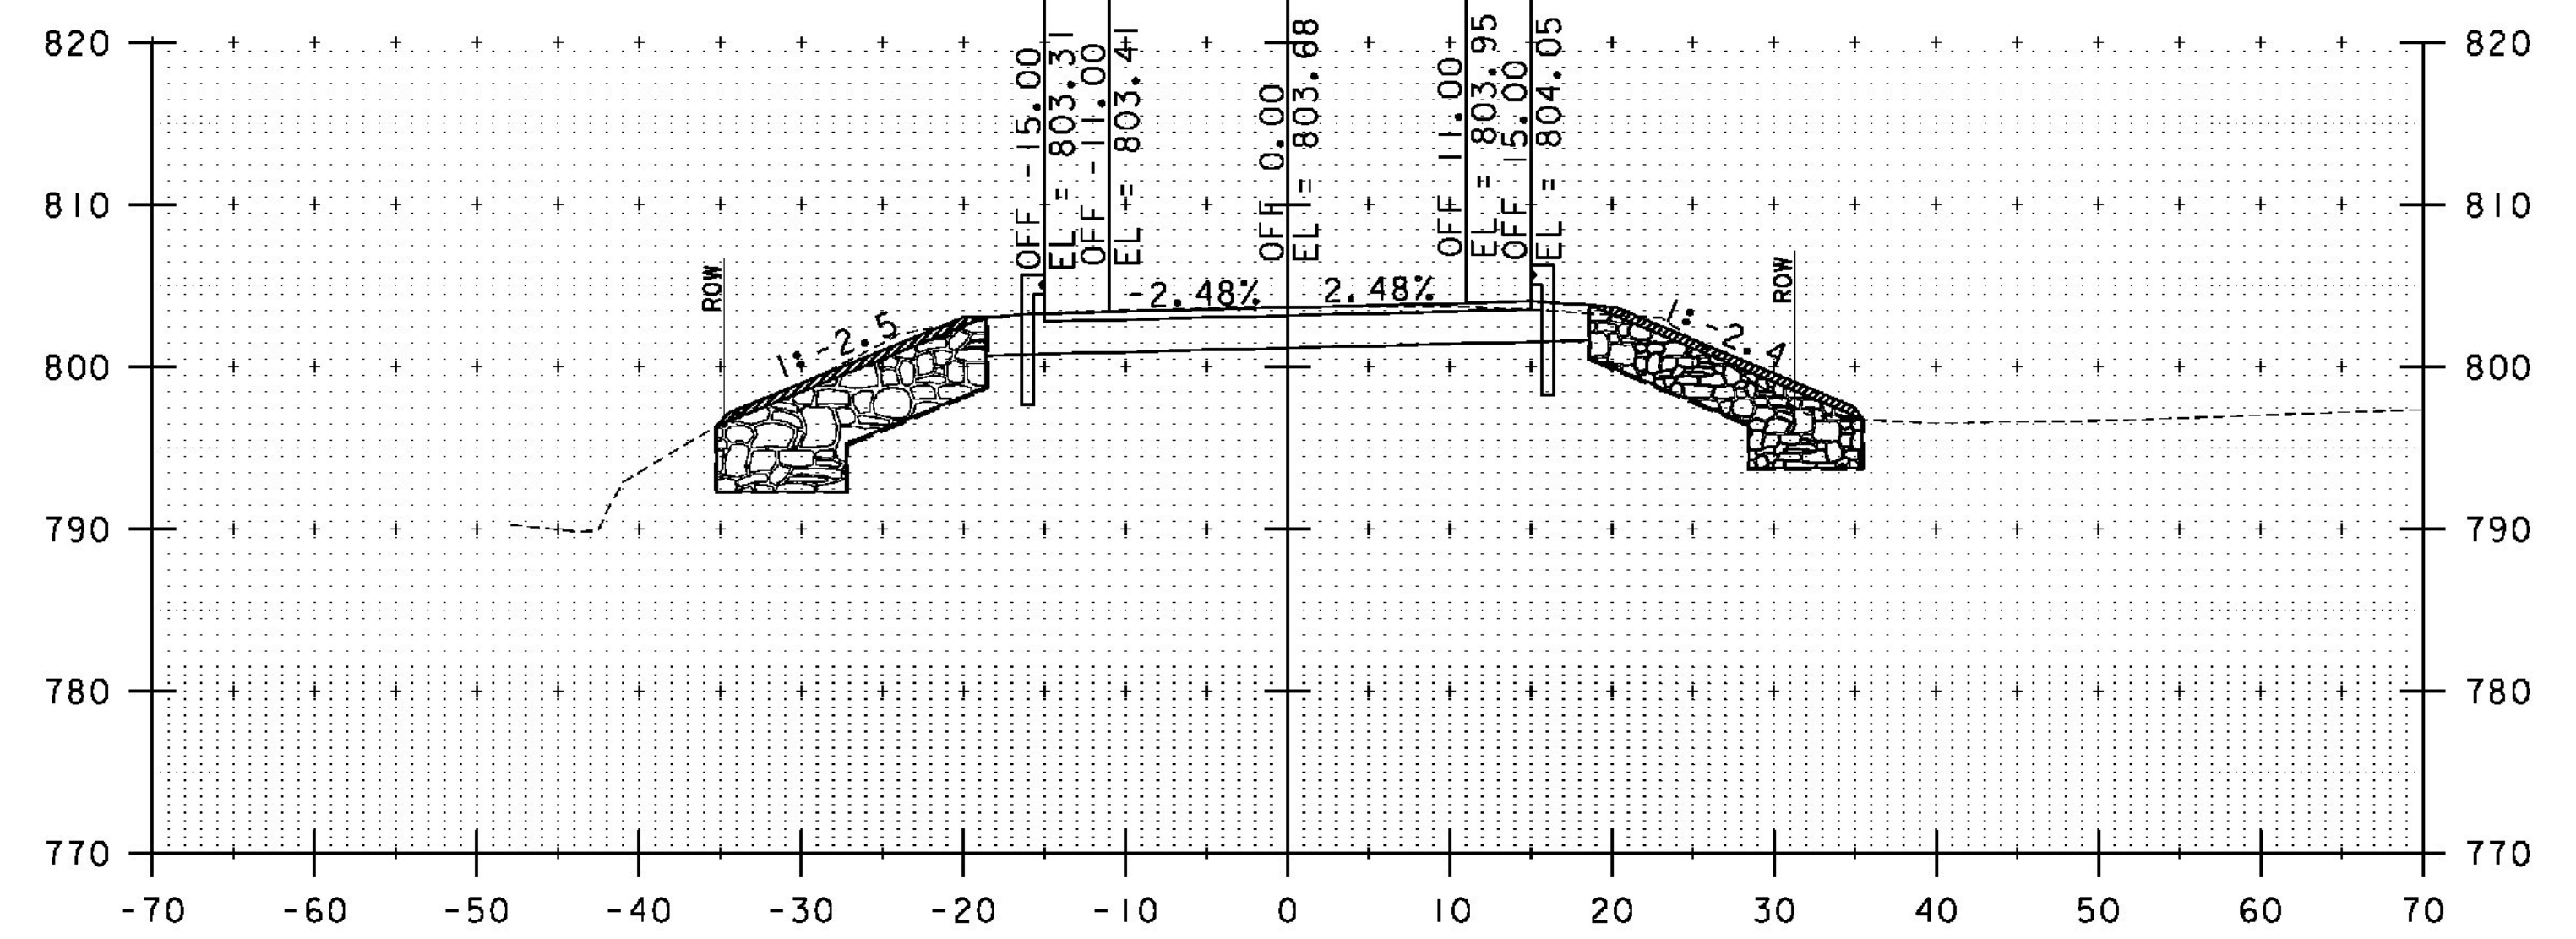

34+55  
RESUME PROJECT

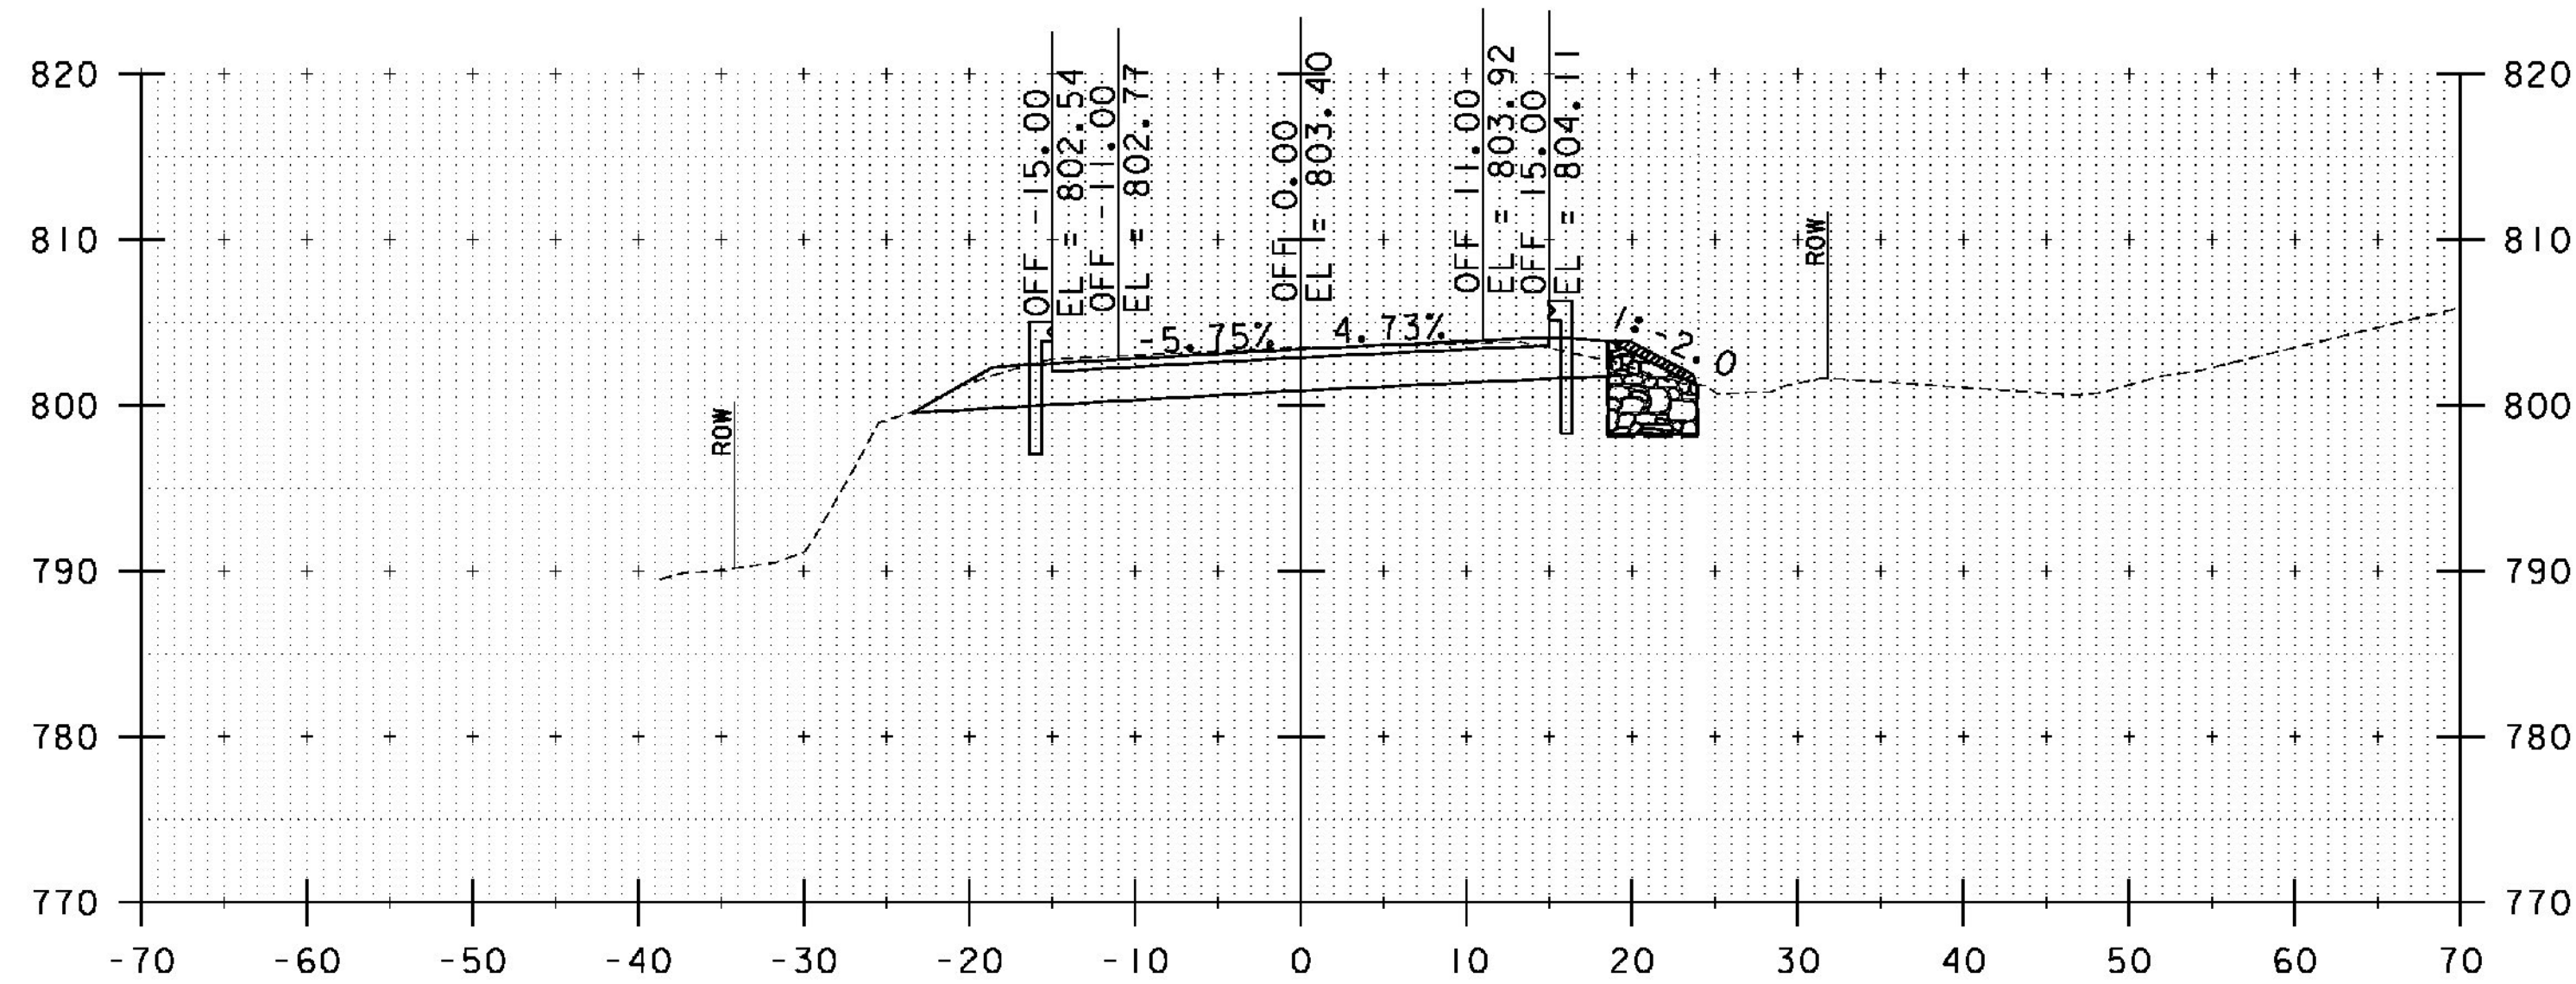

35+11.07  
END BRIDGE

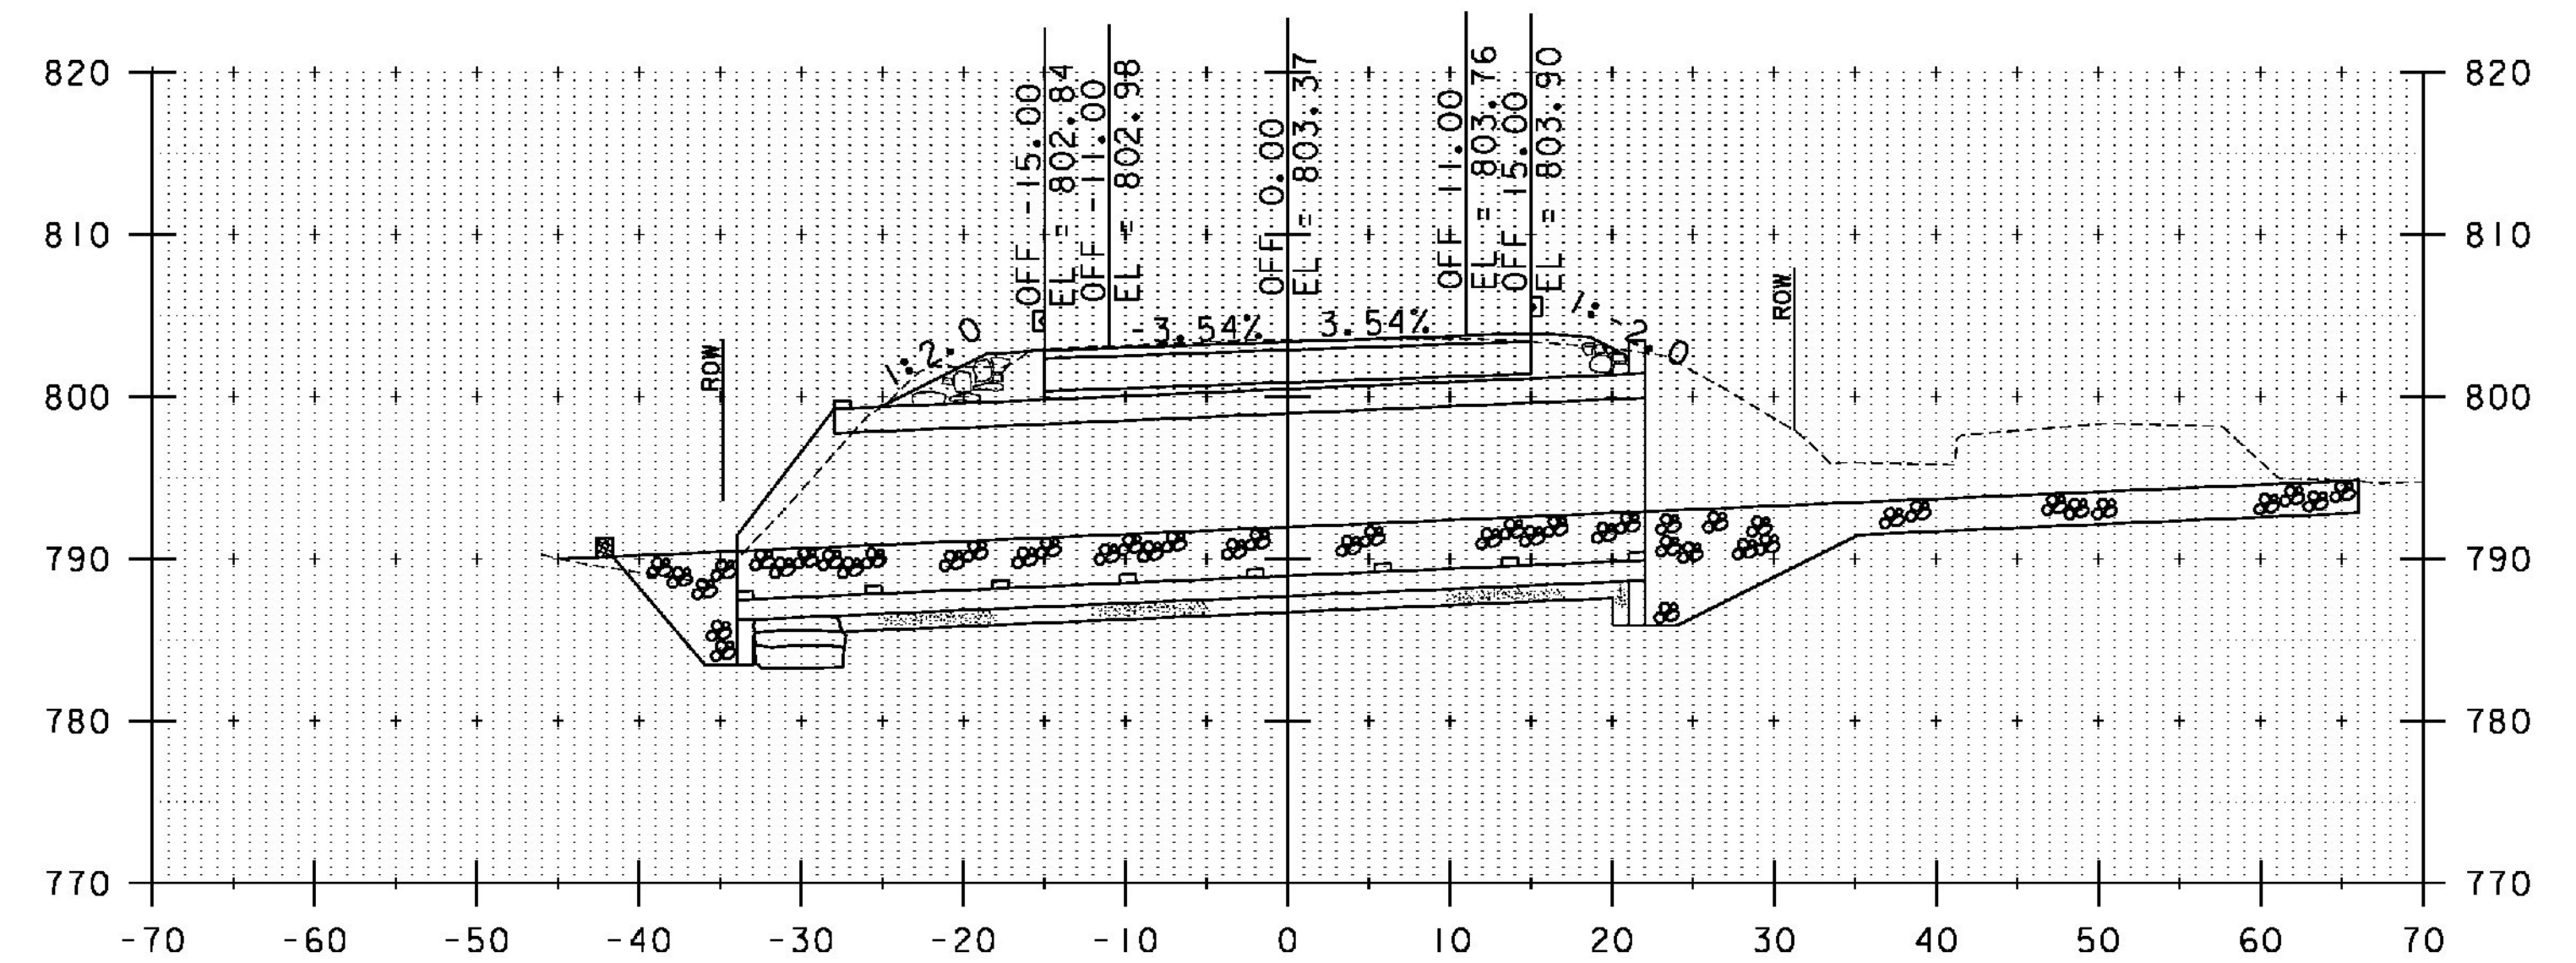

34+50

35+00

STA. 34+50 TO STA. 35+47

PROJECT NAME: IRASBURG  
PROJECT NUMBER: STP CULV(30)

FILE NAME: z1lc266xs.dgn  
PROJECT LEADER: M. CHENETTE  
DESIGNED BY: J. HUNGERFORD  
ROADWAY CROSS SECTIONS - RXS2 - BR7

PLOT DATE: 9/26/2014  
DRAWN BY: L. BUXTON  
CHECKED BY: M. CHENETTE  
SHEET 43 OF 55

