

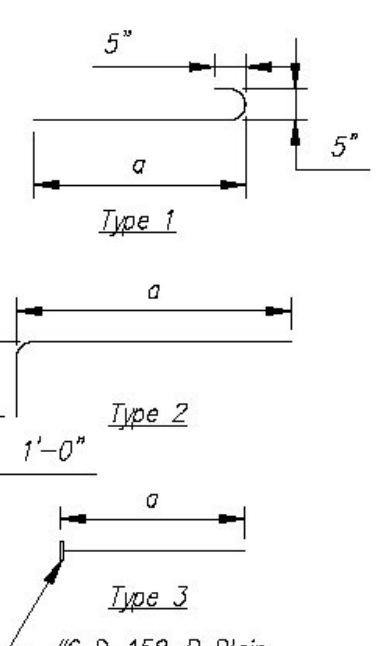
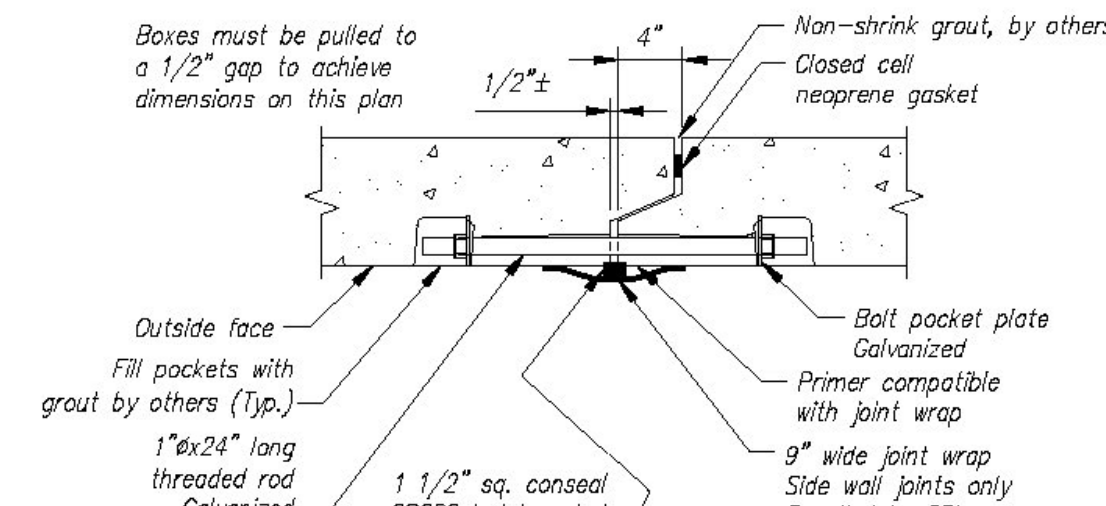
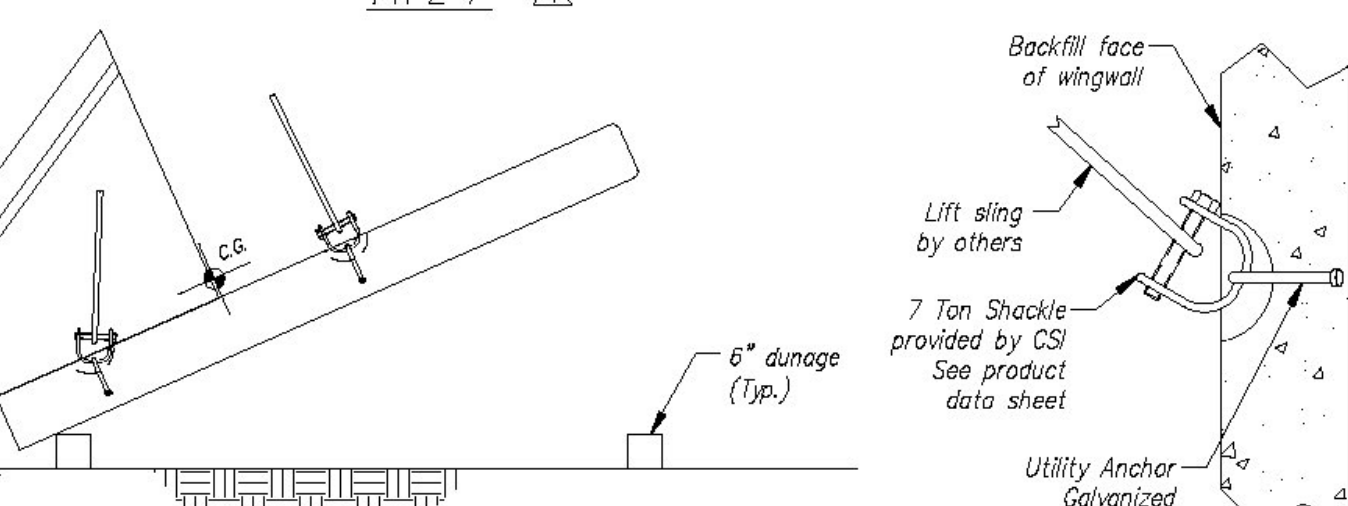


| BAR LIST | | | | | |
|----------|------|------|--------|------|--------|
| MARK | QTY. | SIZE | a | TYPE | LENGTH |
| B1 | 8 | #6 | 3'-0" | 3 | --- |
| B2 | 4 | #5 | --- | Str. | 3'-2" |
| B3 | 4 | #5 | --- | Str. | 4'-3" |
| B4 | 11 | #5 | --- | Str. | 2'-2" |
| B5 | 2 | #5 | 3'-8" | 2 | --- |
| B6 | 1 | #5 | 6'-2" | 1 | --- |
| B7 | 1 | #5 | 6'-9" | 1 | --- |
| B8 | 1 | #5 | 6'-11" | 1 | --- |
| B9 | 1 | #5 | 7'-1" | 1 | --- |
| B10 | 1 | #5 | 7'-3" | 1 | --- |
| B11 | 1 | #5 | 7'-5" | 1 | --- |
| B12 | 1 | #5 | 7'-6" | 1 | --- |
| B13 | 1 | #5 | 7'-8" | 1 | --- |

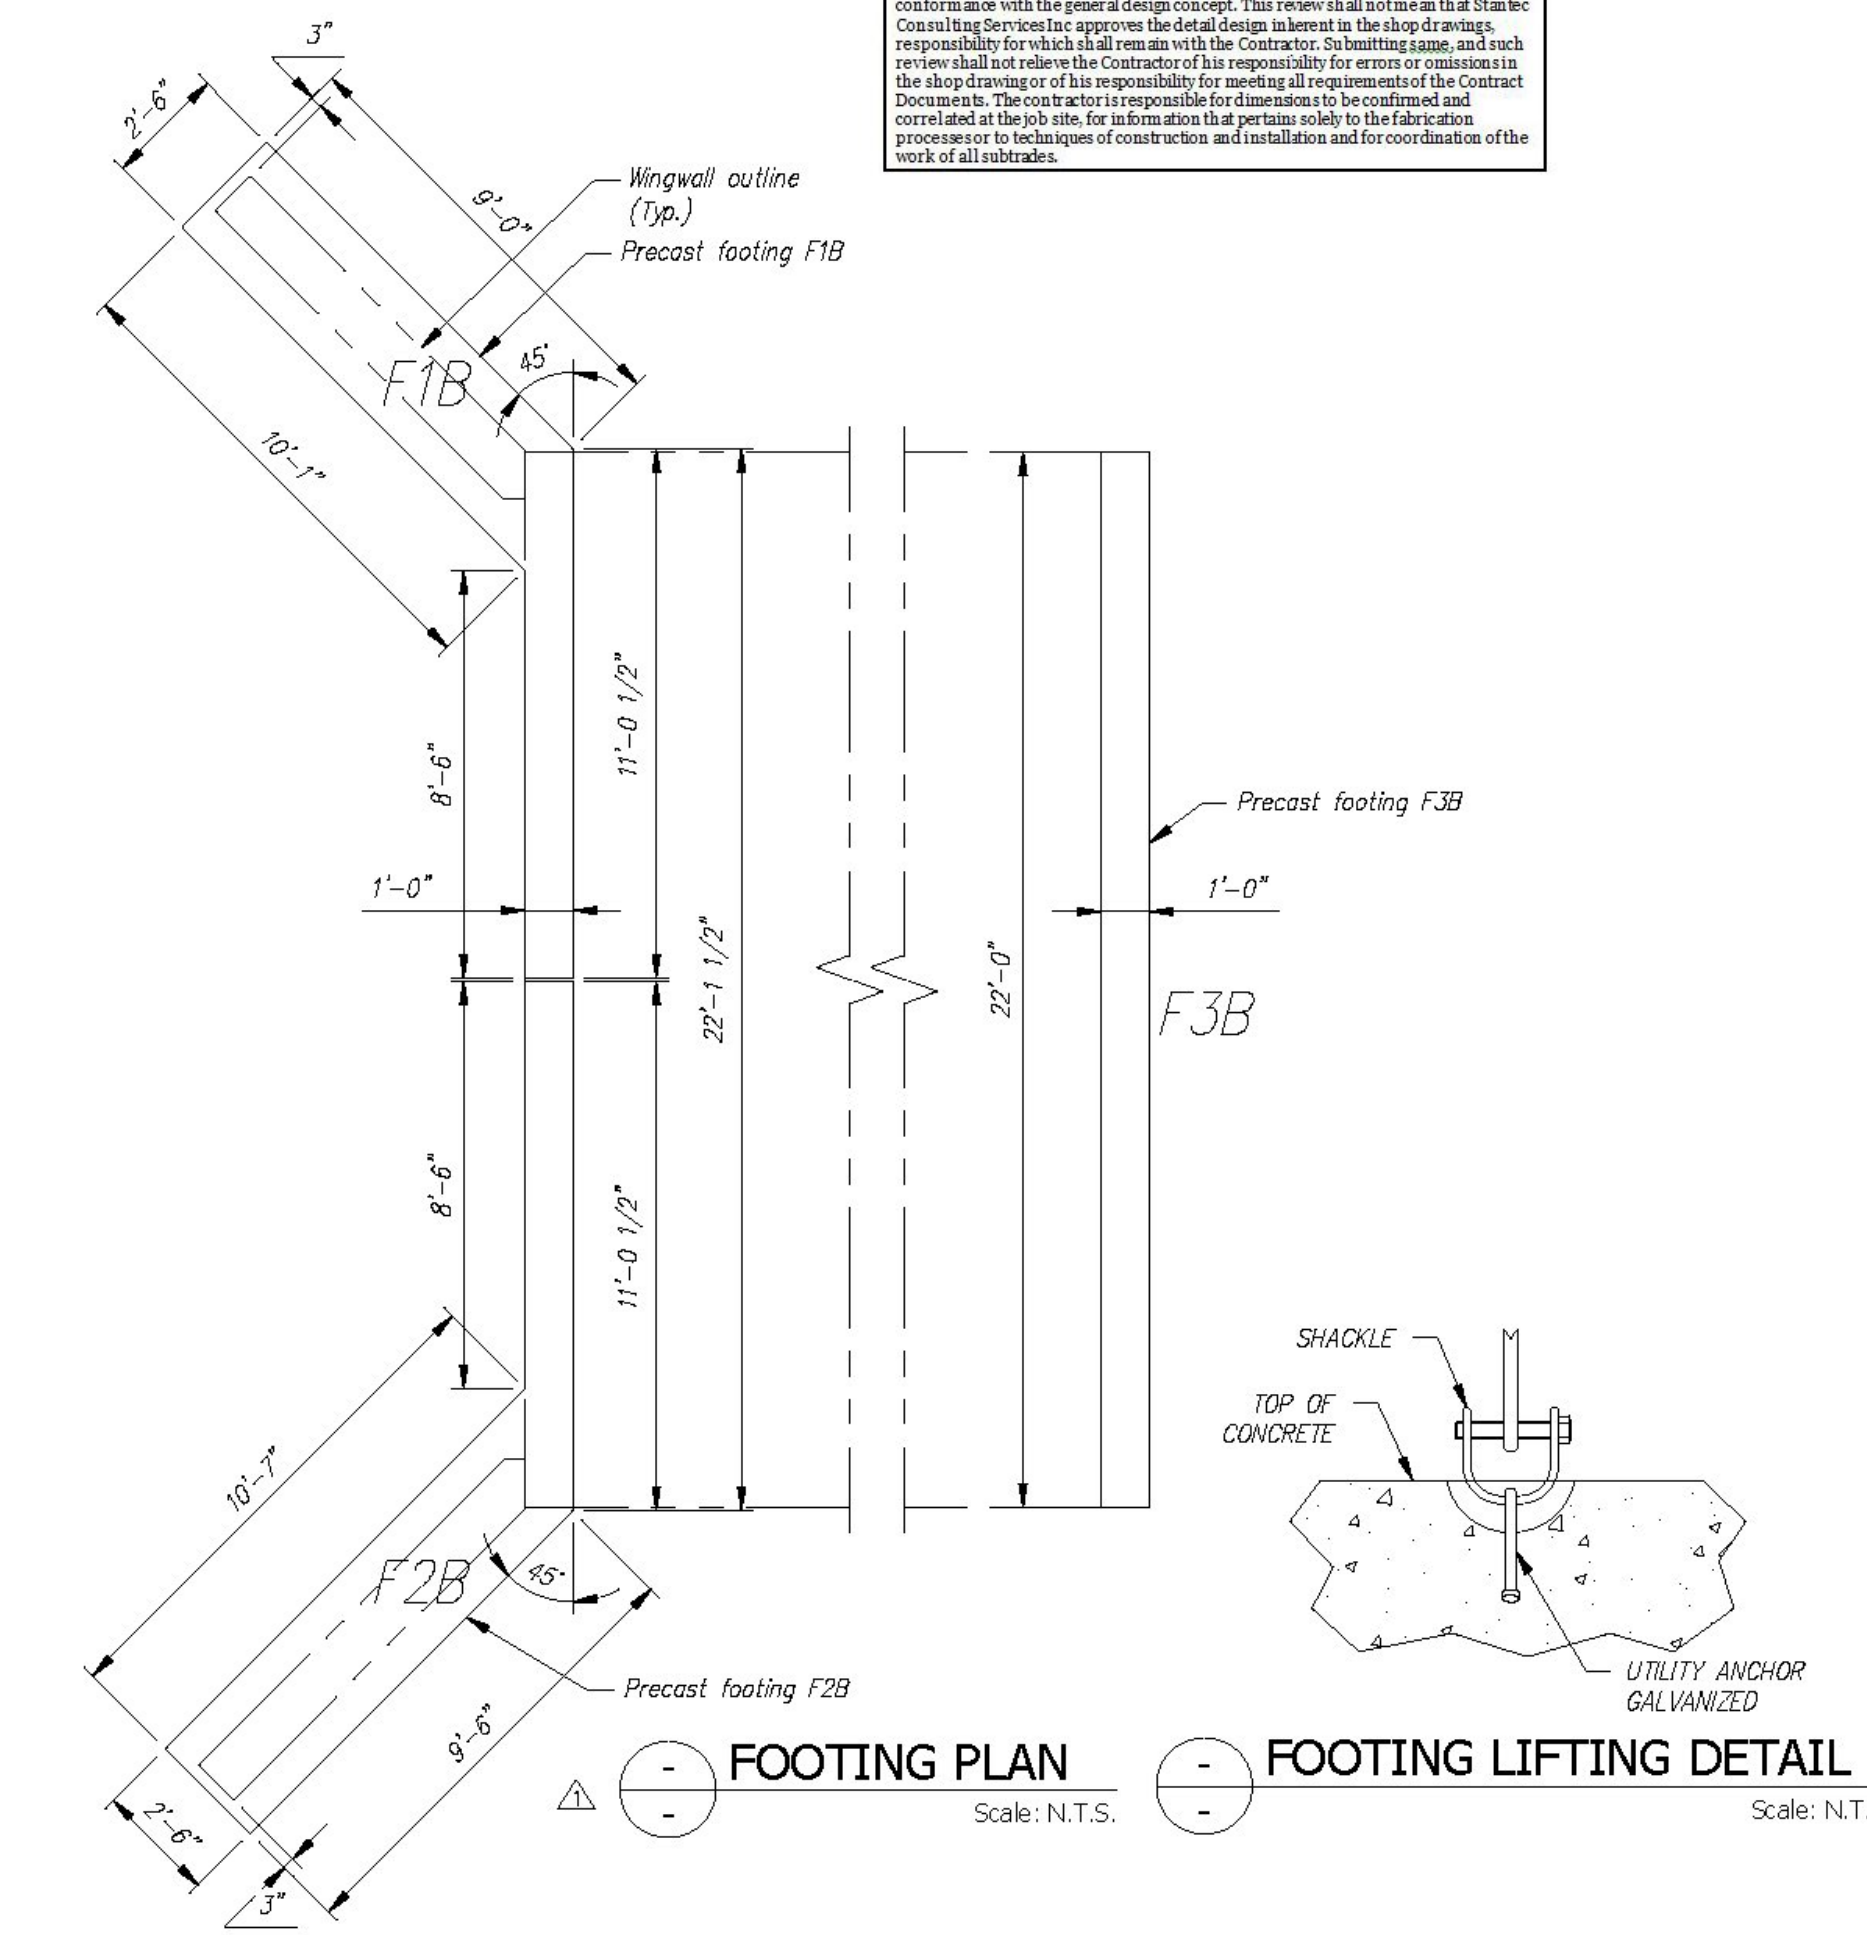

| Group Classification | BACKFILL DESCRIPTION | | | | | | |
|--|----------------------|---------|------------------|---------|---------------------------------|---------|---------|
| | A-1 | A-3 | A-2 | A-2-4 | A-2-5 | A-2-6 | A-2-7 |
| Sieve Analysis, Percent Passing | A-1-a | A-1-b | A-2 | A-2-4 | A-2-5 | A-2-6 | A-2-7 |
| No. 10 | 50 max. | 50 max. | 51 min. | 35 max. | 35 max. | 35 max. | 35 max. |
| No. 40 | 30 max. | 50 max. | 51 min. | 35 max. | 35 max. | 35 max. | 35 max. |
| No. 200 | 15 max. | 25 max. | 10 max. | 35 max. | 35 max. | 35 max. | 35 max. |
| Characteristics of Fraction Passing | | | | | | | |
| No. 40 | | | 40 max. | 41 min. | 40 max. | 41 min. | |
| Liquid Limit | | | 6 max. | N.P. | 10 max. | 11 min. | |
| Plasticity Index | | | 6 max. | N.P. | 10 max. | 11 min. | |
| Usual Types of Significant Constituent Materials | | | Stone Fragments, | Fine | Silty or Clayey Gravel and Sand | | |
| General Rating as Subgrade | | | Gravel & Sand | Sand | Excellent to Good | | |

- NOTES**
- BACKFILLING OPERATIONS WITHIN THE C.B.Z. SHALL BE PERFORMED IN LIFTS OF 8" OR LESS (LOOSE DEPTH).
 - MAXIMUM DRY DENSITY SHALL BE DETERMINED BY AASHTO T-99 OR OTHER APPROVED METHODS.
 - BACKFILL SHALL BE COMPACTED IN LAYERS UNTIL THE DENSITY IS NOT LESS THAN 95% OF THE MAXIMUM DRY DENSITY.

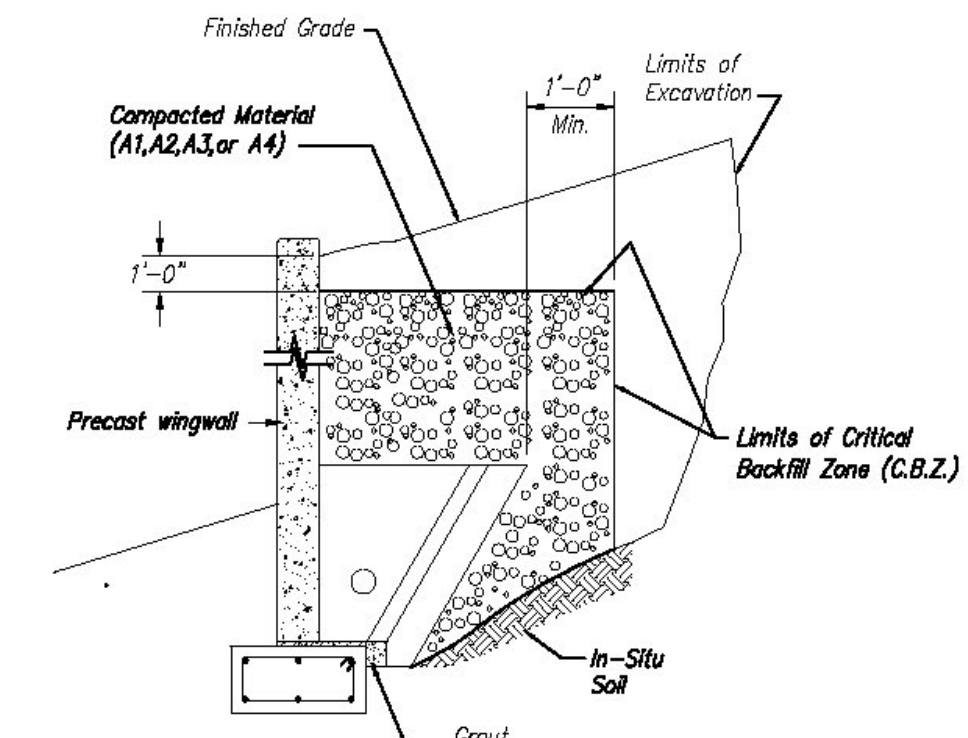

Vermont Agency of Transportation
RECEIVED
ON: April 30, 2015
and Checked for CONFORMANCE
BY: Mark Sargent DATE: 5/7/2015

REVIEWED: []
REVISED AS MODIFIED: []
REVISED AND RESUBMIT: []
NOT REVIEWED: []

Date: 4/24/2015

By: Nathan Tirk

THIS REVIEW BY STANTEC CONSULTING SERVICES INC. IS FOR THE SOLE PURPOSE OF ASCERTAINING CONFORMANCE WITH THE GENERAL DESIGN CONCEPT. THE REVIEWER SHALL NOT BE RESPONSIBLE FOR THE DESIGN OR CONSTRUCTION OF THE PROJECT. THE CONTRACTOR SHALL BE RESPONSIBLE FOR THE DESIGN AND CONSTRUCTION OF THE PROJECT. THE CONTRACTOR SHALL BE RESPONSIBLE FOR THE DESIGN AND CONSTRUCTION OF THE PROJECT.

Contractor is to verify that all information shown on drawings has been thoroughly checked, complies with the contract documents and is adequate to meet the field conditions. Some dimensions and details may differ slightly from contract drawings to accommodate the manufacturing or design process. Approval of this drawing indicates that any deviation from the contract documents has been reviewed and found to be acceptable. Production will not commence until receipt of signed, approved shop drawings.

This drawing contains information proprietary to CONCRETE SYSTEMS, INC. This drawing is disclosed with the understanding that it will be retained in confidence and its use limited solely to the purpose for which it is disclosed. It is understood that no reproduction of this drawing is authorized without permission from CONCRETE SYSTEMS, INC. and that it will be returned to CONCRETE SYSTEMS, INC. upon request.

| Rev. | Date | DESCRIPTION | By |
|------|-----------|--|----|
| 5 | | | |
| 4 | | | |
| 3 | | | |
| 2 | | | |
| 1 | 01APR2015 | WINGWALL ANCHORS WERE TYPE 'D', WINGWALLS WERE 10" THK | RY |

This drawing is based upon information provided from the following documents and/or sources:

Engineer: STATE OF VT AOT PROGRAM DEVELOPMENT
Project No: STPCULV30
Drawings: VT/AOT PROPOSED IMPROVEMENT BRIDGE PROJECT SHEETS 1 THRU 24 & 32 OF 55

Specifications: ----
Other Sources: ----

CSI
Concrete Systems Inc.
9 Commercial St., Hudson, NH 03051
Phone 603-889-4169
Fax 603-889-2417

STATE AGENCY
VTrans
Vermont Agency of Transportation

Drawn By: R. YEAGER
Reviewed By: []
Date: 09MAR2015

J A MCDONALD, INC.
VT/AOT BRIDGE - STEEL CULVERT REPLACEMENT
BRIDGE #7, VT ROUTE 58, IRASBURG, VT

20' SPAN x 10' RISE BOX CULVERT LAYOUT
C22283-LQ2B

Quantity: 1
Project: STPCULV30
SHEET 2B OF 2B