

REMOVAL AND DISPOSAL OF GUARDRAIL

STA 11+47.8 - 12+86.8 LT
 STA 11+88.3 - 12+64.8 RT

BRIDGE RAILING, GALVANIZED 2 RAIL BOX BEAM

STA 12+07.4 - 12+42.6 LT
 STA 12+07.4 - 12+42.6 RT

GUARDRAIL APPROACH SECTION, GALVANIZED 2 RAIL BOX BEAM

STA 11+78.3 - 12+07.4 LT
 STA 12+42.6 - 12+71.7 LT
 STA 11+78.3 - 12+07.4 RT
 STA 12+42.6 - 12+67.7 RT

ANCHOR FOR STEEL BEAM RAIL

12+65.7
 STA 12+66.2 RT

MANUFACTURED TERMINAL SECTION, TANGENT


STA. 11+28.3 - 11+78.3 LT & RT

MANUFACTURED TERMINAL SECTION, FLARED

STA. 12+71.7 - 13+09.1 LT

STEEL BEAM GUARDRAIL, GALVANIZED

12+66.3
 STA 12+65.7 RT - 12+66.8 RT

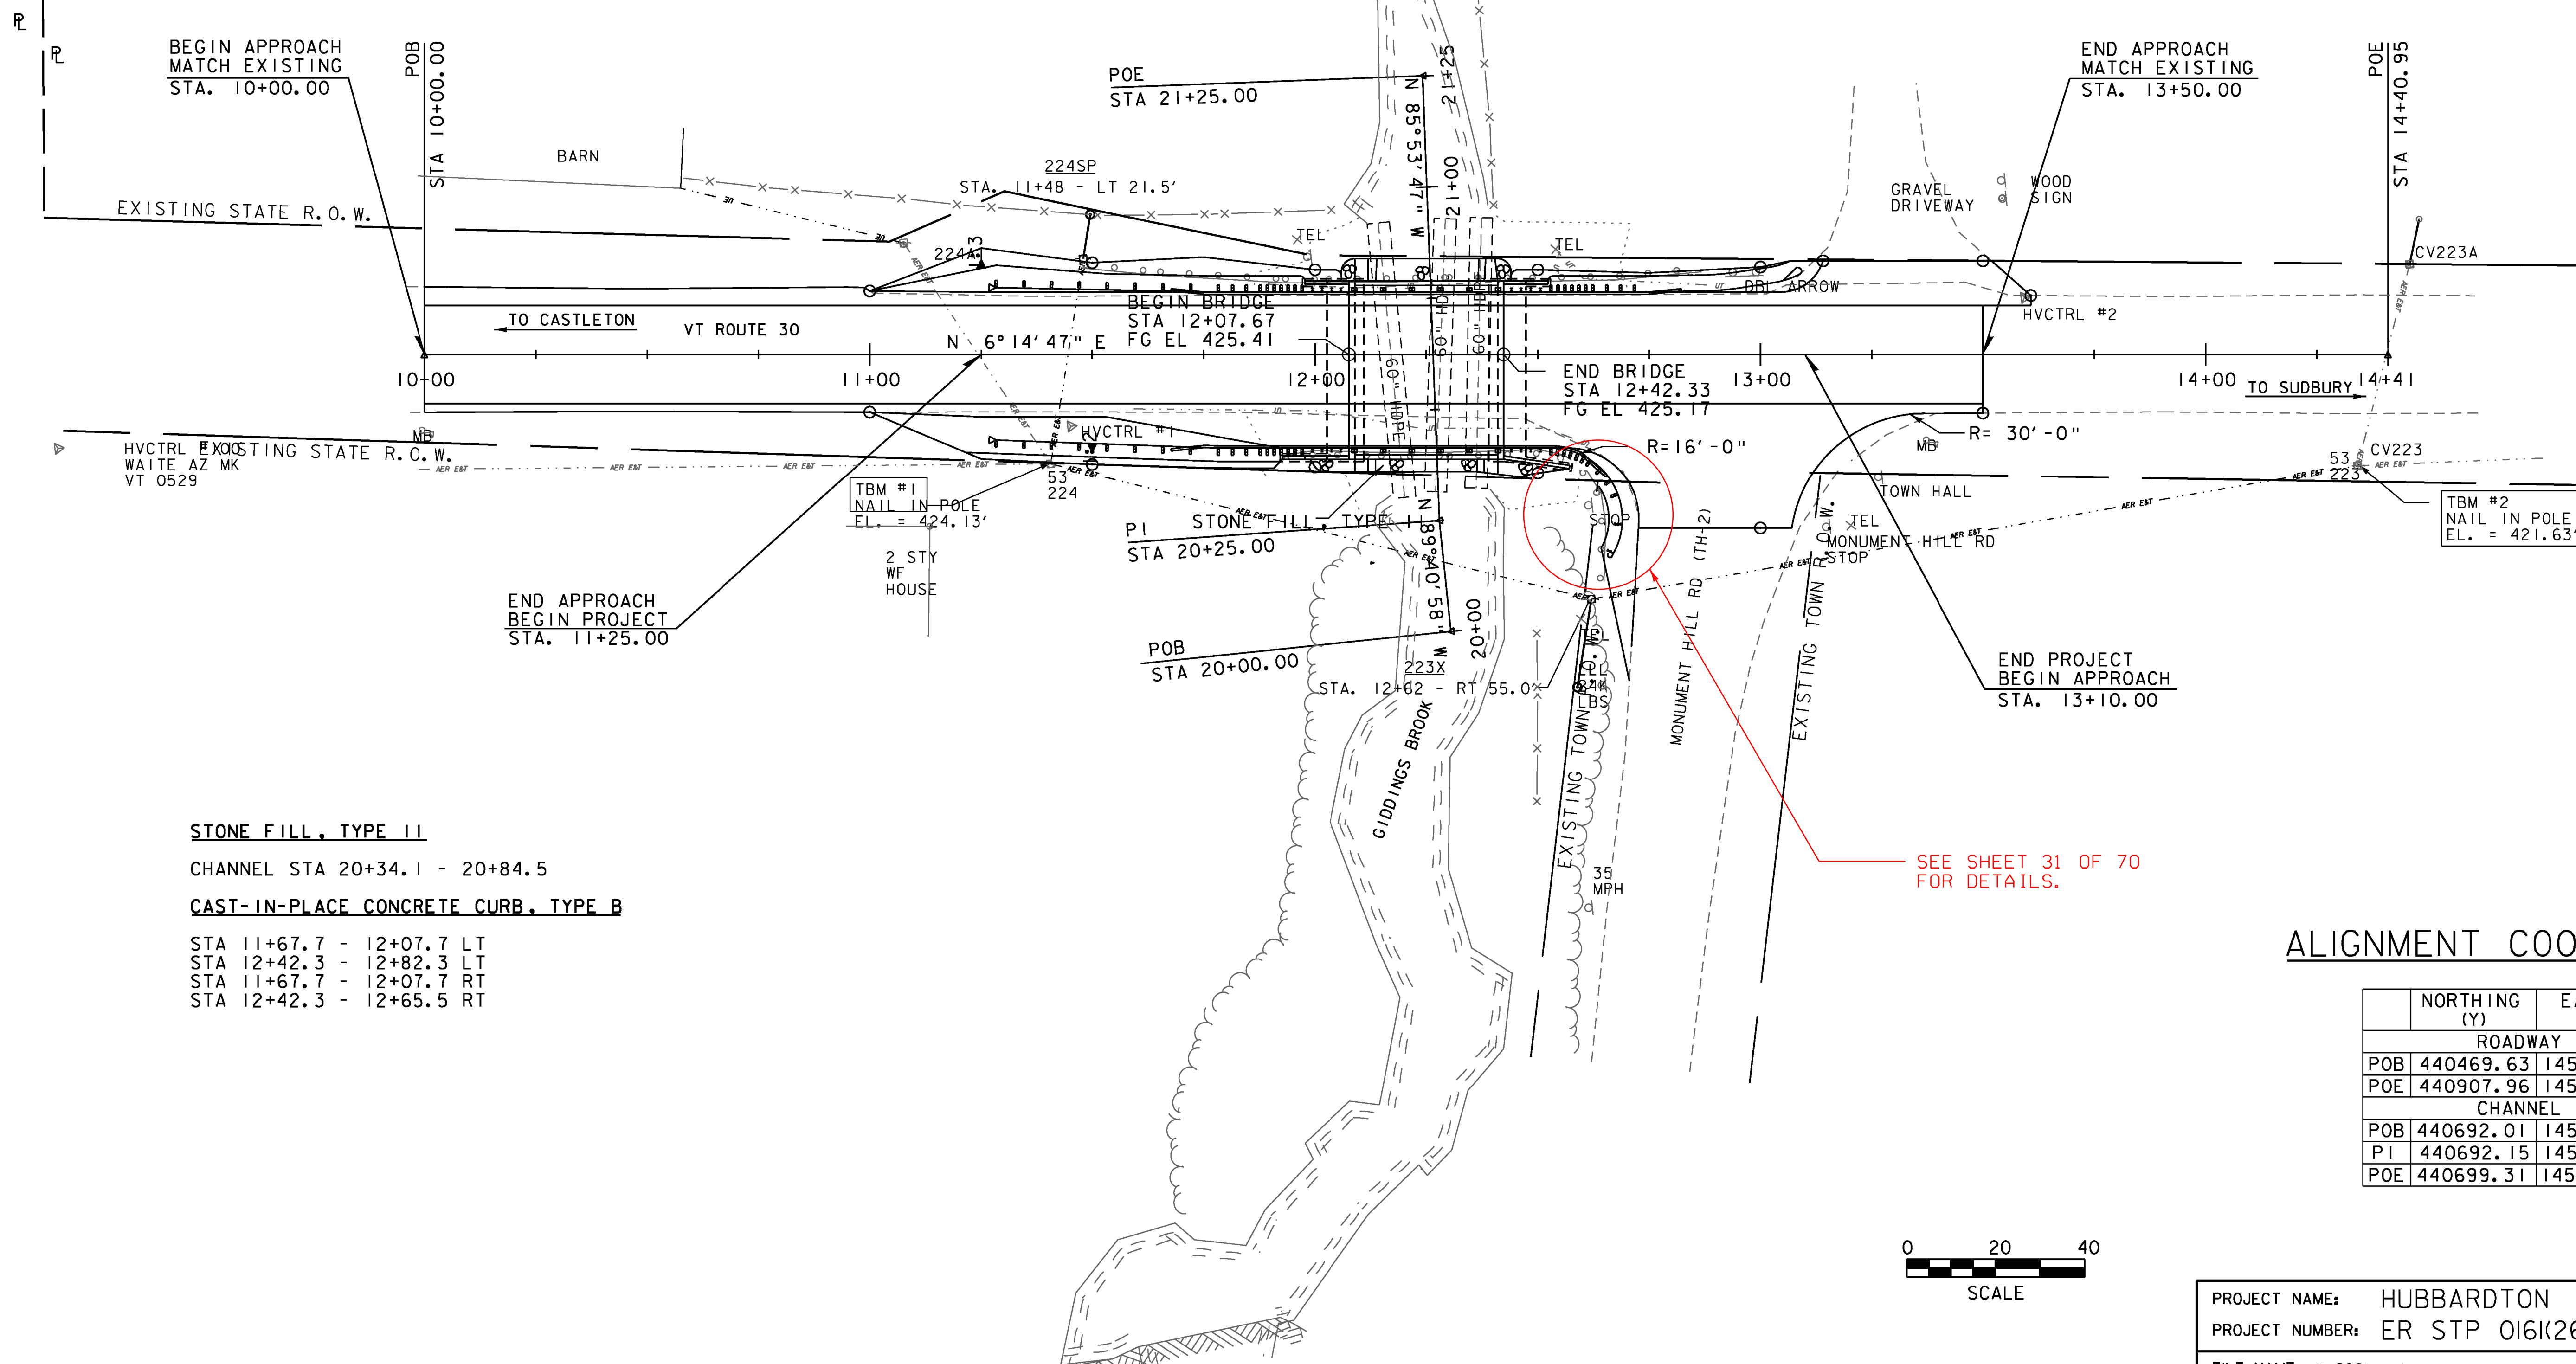

STONE FILL, TYPE II


CHANNEL STA 20+34.1 - 20+84.5

CAST-IN-PLACE CONCRETE CURB, TYPE B

STA 11+67.7 - 12+07.7 LT
 STA 12+42.3 - 12+82.3 LT
 STA 11+67.7 - 12+07.7 RT
 STA 12+42.3 - 12+65.5 RT

ALIGNMENT COORDINATES

	NORTHING (Y)	EASTING (N)
ROADWAY		
POB	440469.63	1459339.82
POE	440907.96	1459387.80
CHANNEL		
POB	440692.01	1459426.76
P1	440692.15	1459401.76
POE	440699.31	1459302.01

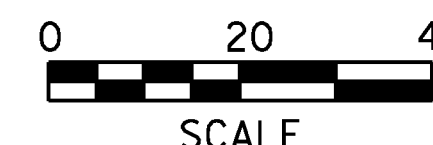

PROJECT NAME: HUBBARDTON
 PROJECT NUMBER: ER STP 016126)

FILE NAME: zllc288lay.dgn
 PROJECT LEADER: M.A. COLGAN
 DESIGNED BY: S.G. FARNSWORTH
 LAYOUT SHEET

PLOT DATE: 7/16/2012
 DRAWN BY: C.L. CILLEY
 CHECKED BY: S.G. FARNSWORTH
 SHEET 15 OF 70