


LEGEND

- EXISTING CONTOUR
- UNDERGROUND BURIED CABLE/TEL
- AERIAL ELECTRIC & TELEPHONE
- FILTER CURTAIN
- WOVEN WIRE SILT FENCE
- PROJECT DEMARCATION FENCE
- LIMITS OF SOIL DISTURBANCE
- TEMPORARY EROSION MATTING
- FILTER BAG

SOIL CLASSIFICATION

CASTILE GRAVELLY FINE SANDY LOAM (71A)
 "K FACTOR" = 0.24
 CLASSIFIED MODERATE EROSION POTENTIAL

WARWICK-QUONSET COMPLEX (97B)
 "K FACTOR" = 0.24
 CLASSIFIED MODERATE EROSION POTENTIAL

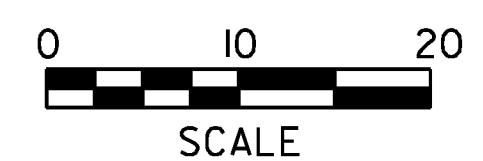

PROJECT NAME: HUBBARDTON
 PROJECT NUMBER: ER STP 0161(26)

FILE NAME: z1lc288ero.dgn
 PROJECT LEADER: M.A. COLGAN
 DESIGNED BY: S.G. FARNSWORTH
 EPSC CONSTRUCTION CONDITIONS SITE PLAN

PLOT DATE: 7/16/2012
 DRAWN BY: C.L. CILLEY
 CHECKED BY: S.G. FARNSWORTH
 SHEET 20 OF 70

