


PLAN
SCALE 1" = 10'-0"

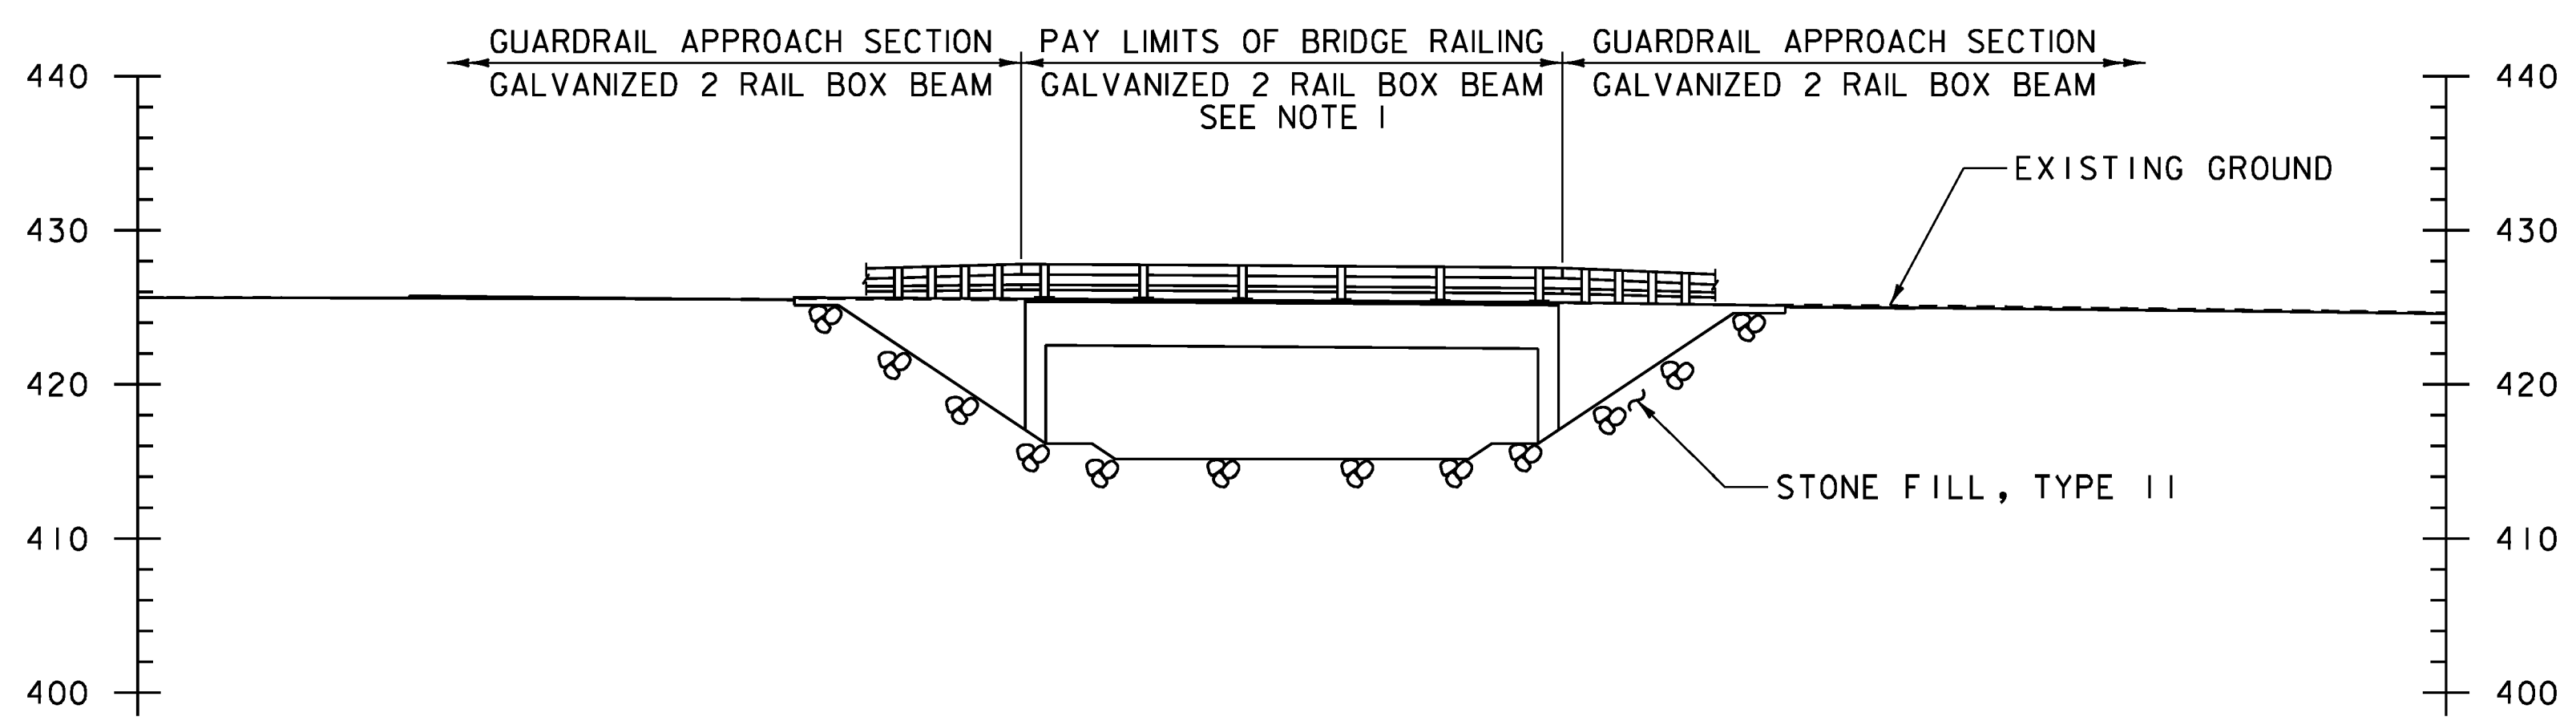

ELEVATION AT UPSTREAM FASCIA
SCALE 1" = 10'-0"

** - T-WALL PRECAST CONCRETE RETAINING WALL SYSTEM SHOWN. SEE NOTE 6 ON THE PROJECT NOTES SHEET FOR ALTERNATE PRECAST CONCRETE RETAINING WALL SYSTEM.

NOTE:

- SEE "BRIDGE AND APPROACH RAILING" SHEET FOR BRIDGE RAIL LAYOUT.

PROJECT NAME:	HUBBARDTON
PROJECT NUMBER:	ER STP 0161(26)
FILE NAME:	z1lc288plan.dgn
PROJECT LEADER:	M.A. COLGAN
DESIGNED BY:	S.G. FARNSWORTH
PLANNED AND ELEVATION	
PLOT DATE:	7/16/2012
DRAWN BY:	C.L. CILLEY
CHECKED BY:	S.G. FARNSWORTH
SHEET	27 OF 70

