




10+50

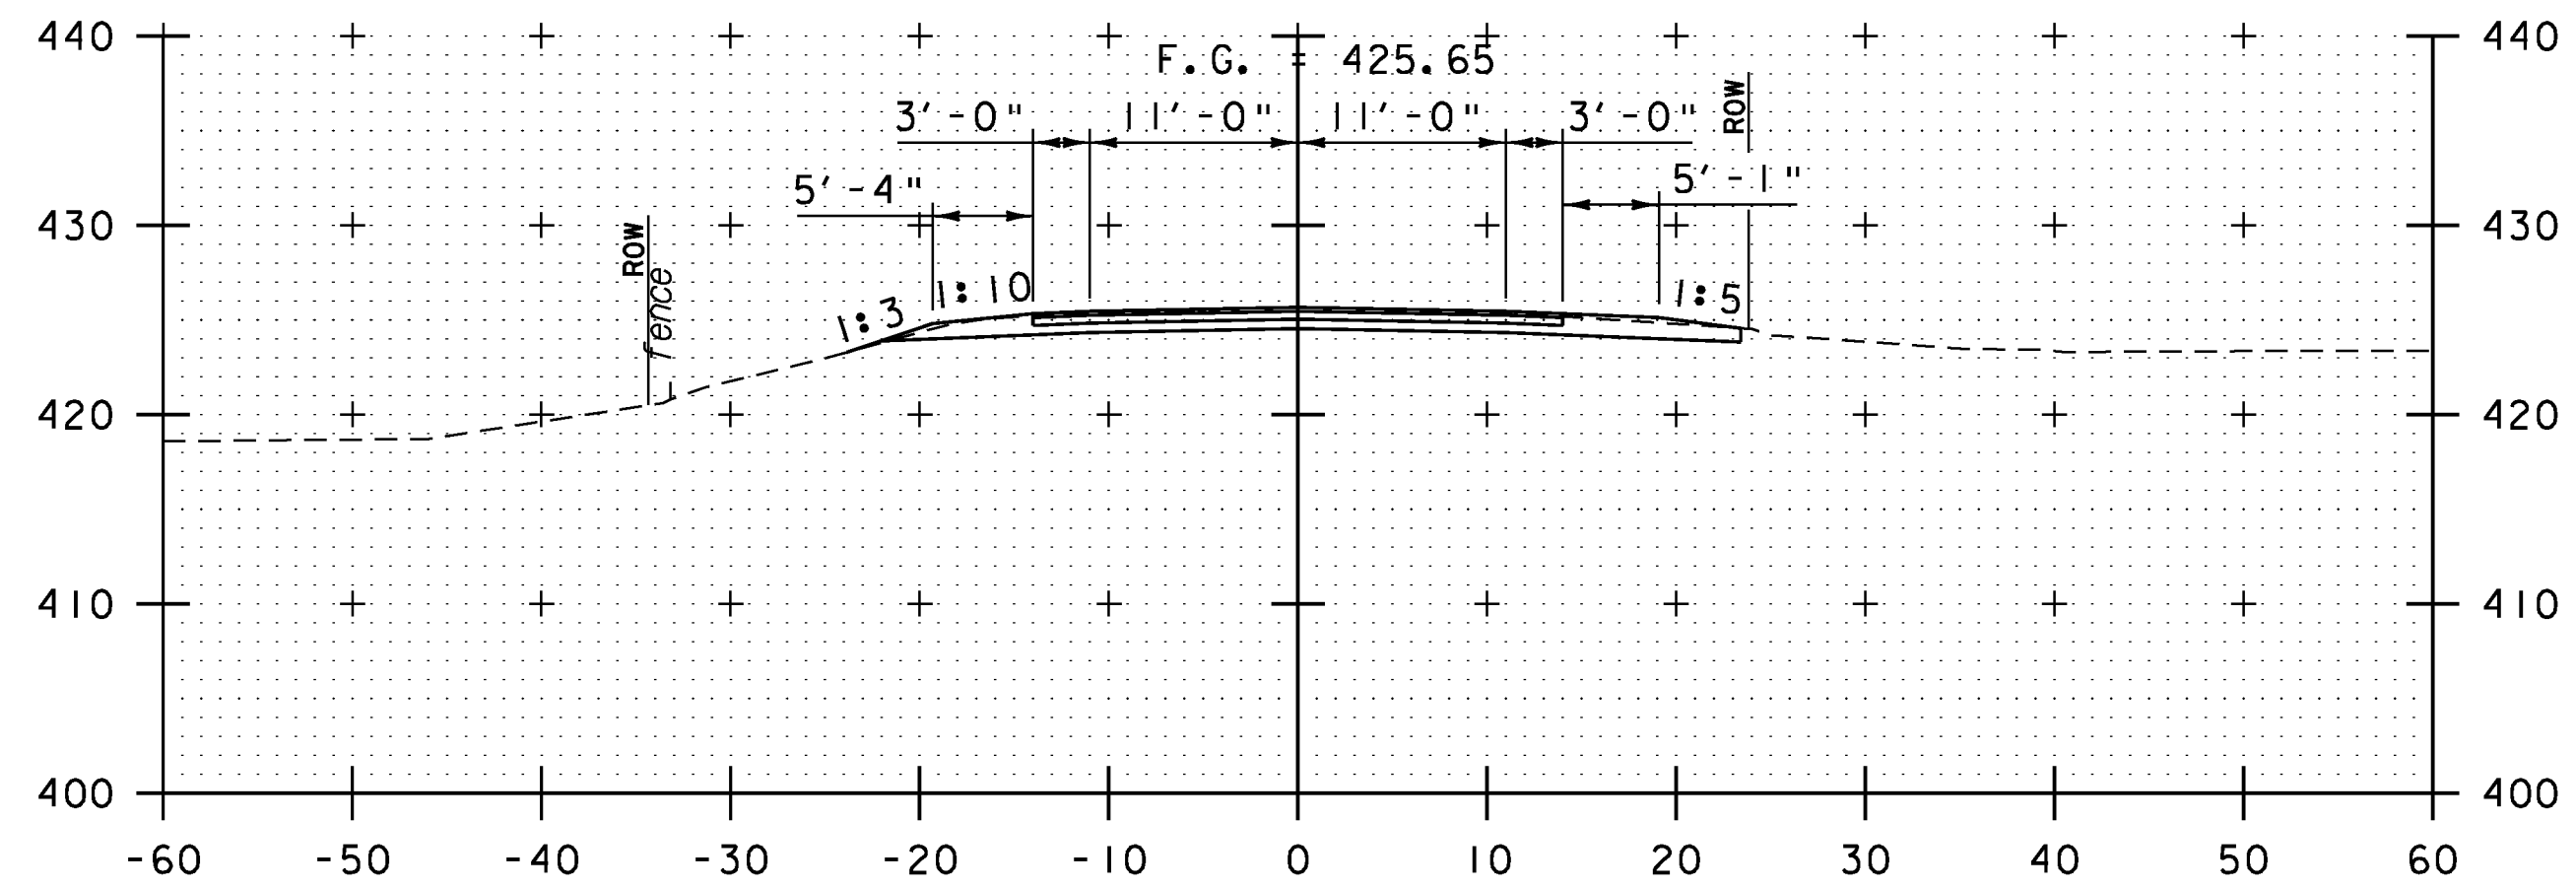


BEGIN PROJECT
11+25

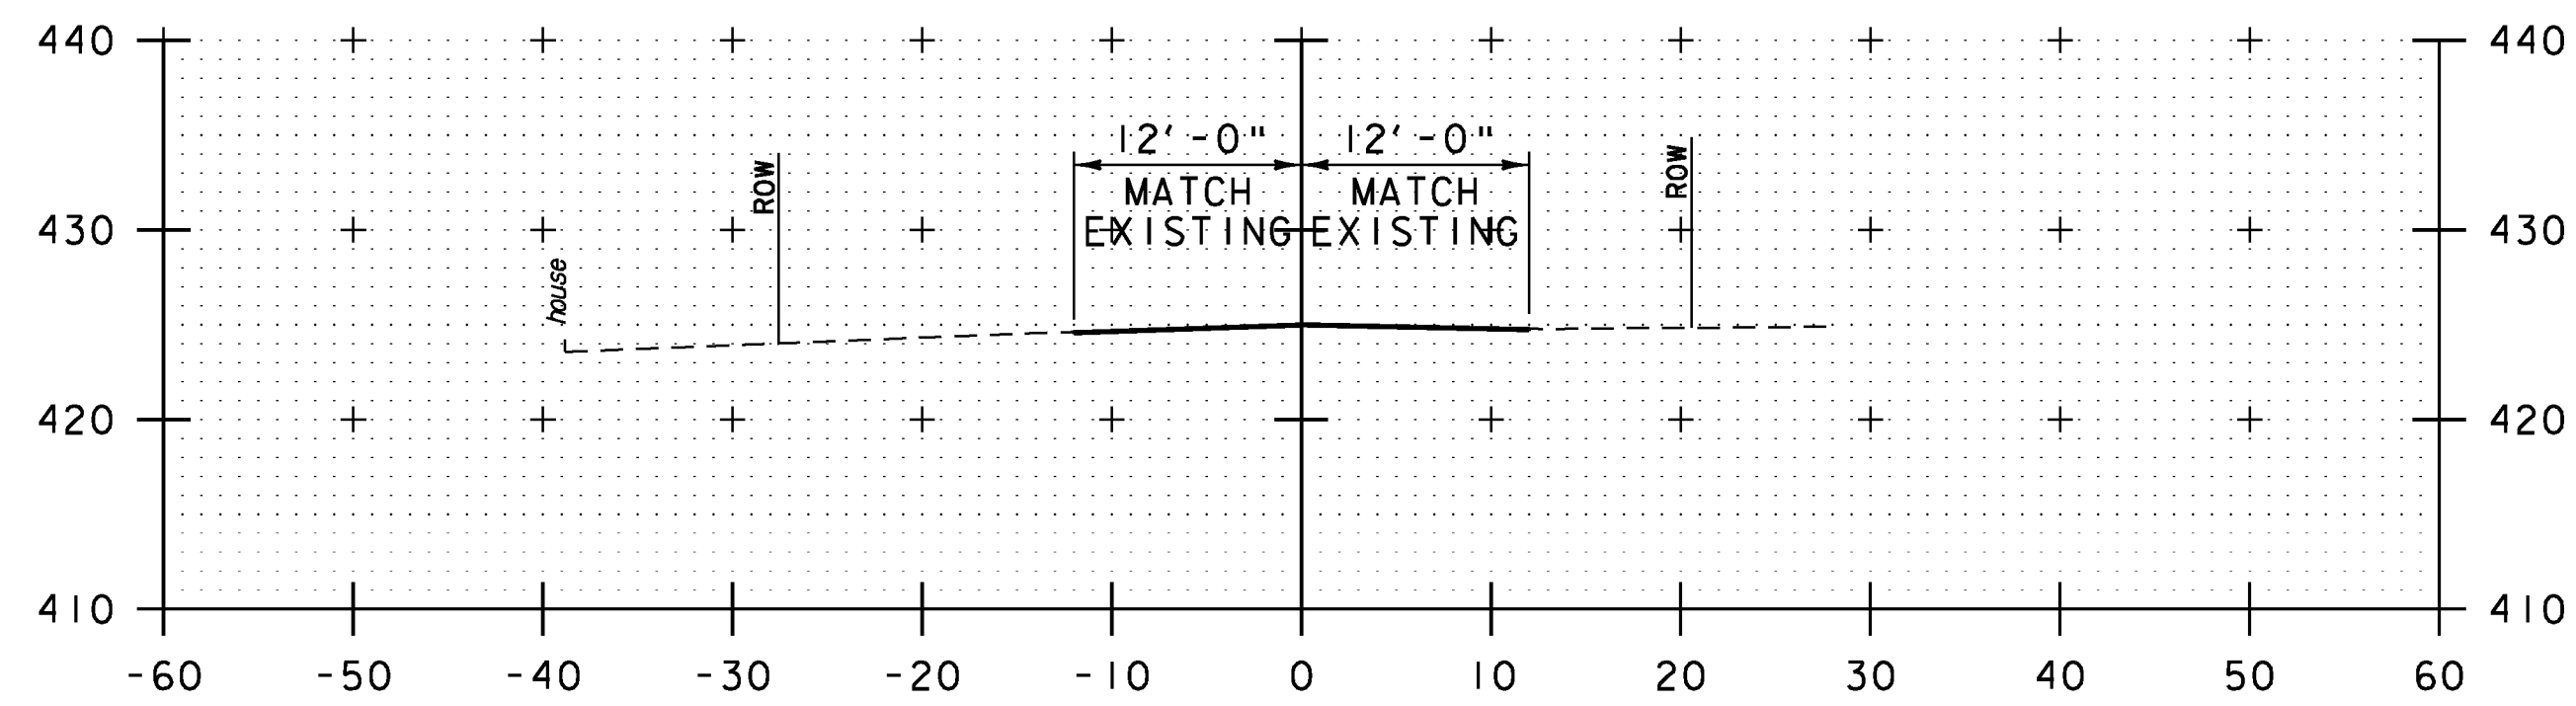


10+25

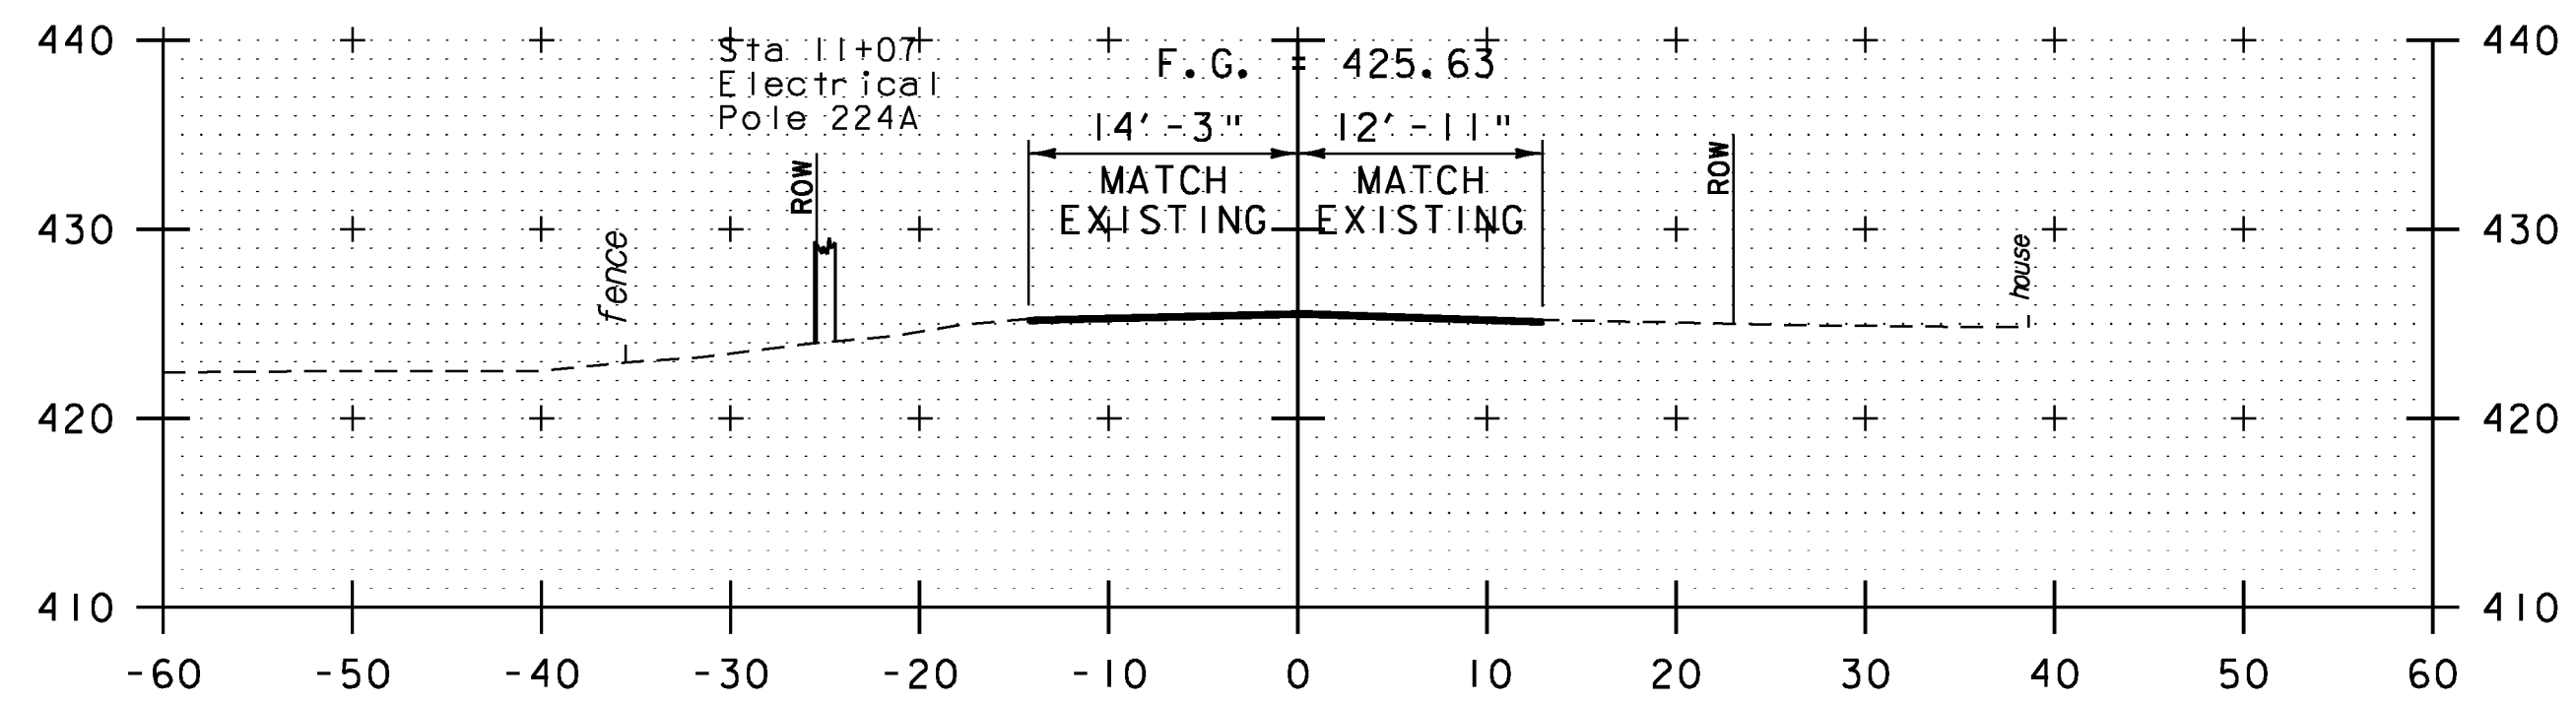

11+00

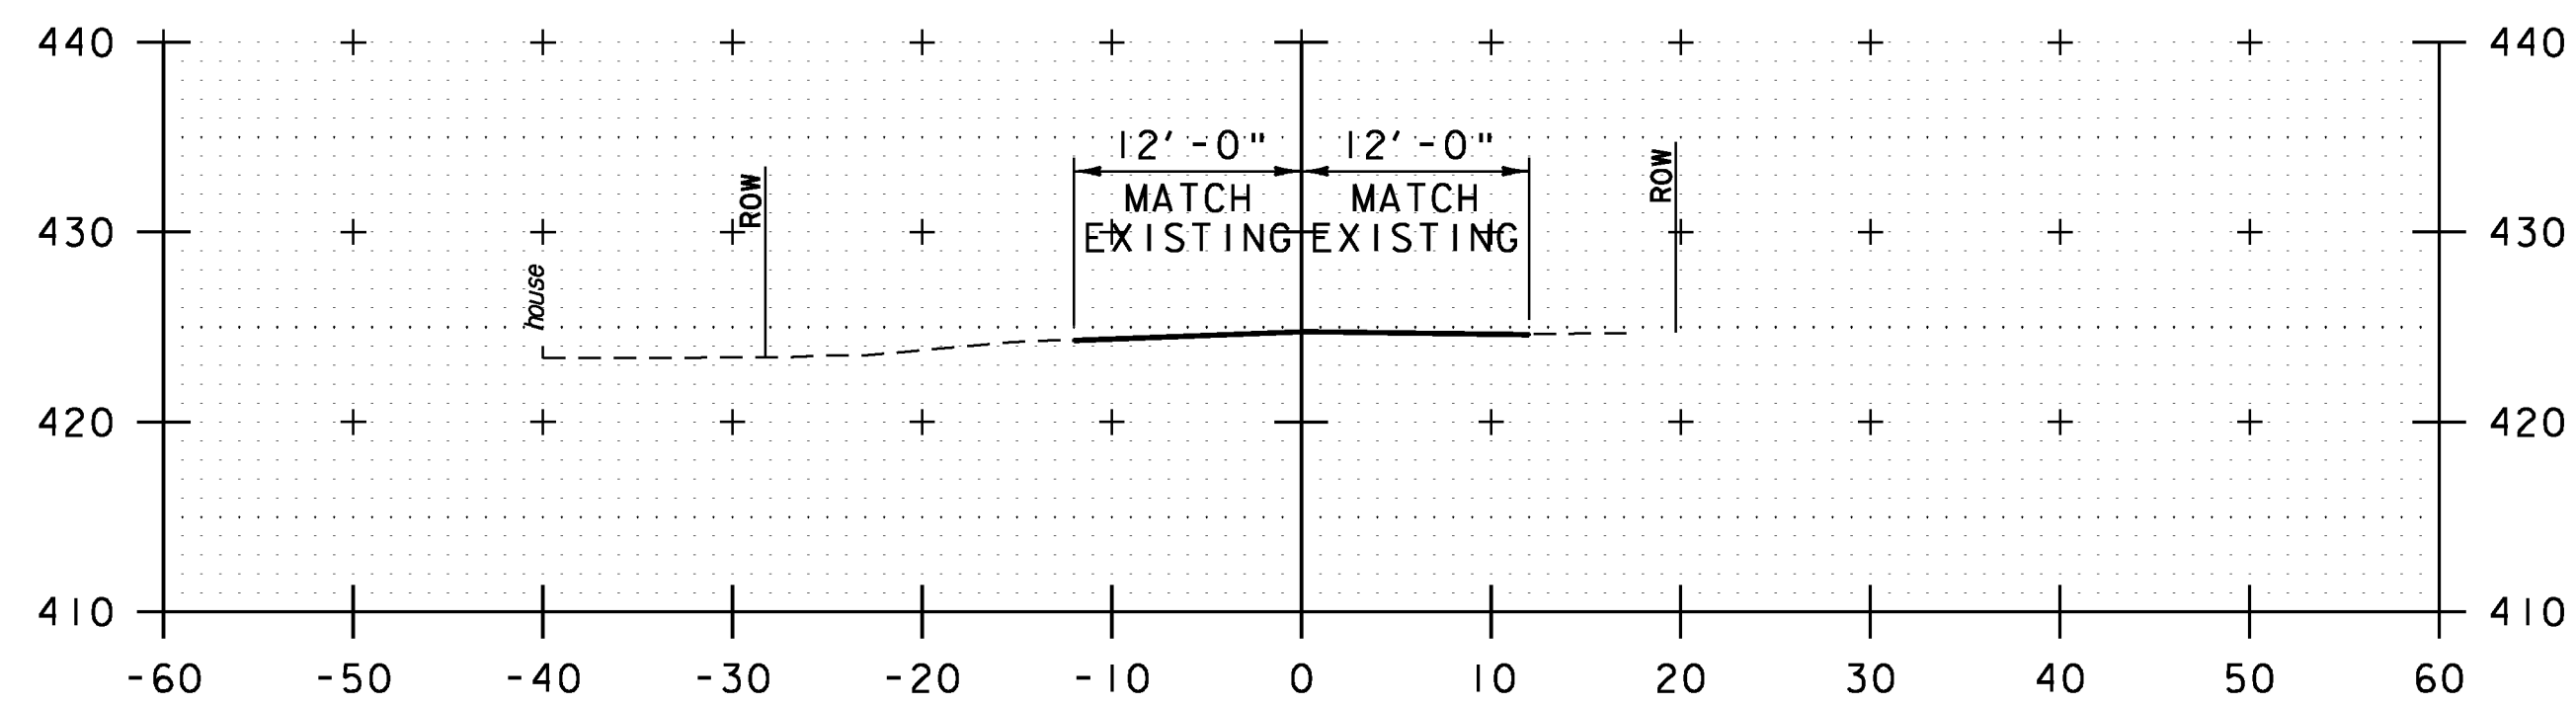

BEGIN APPROACH
10+00

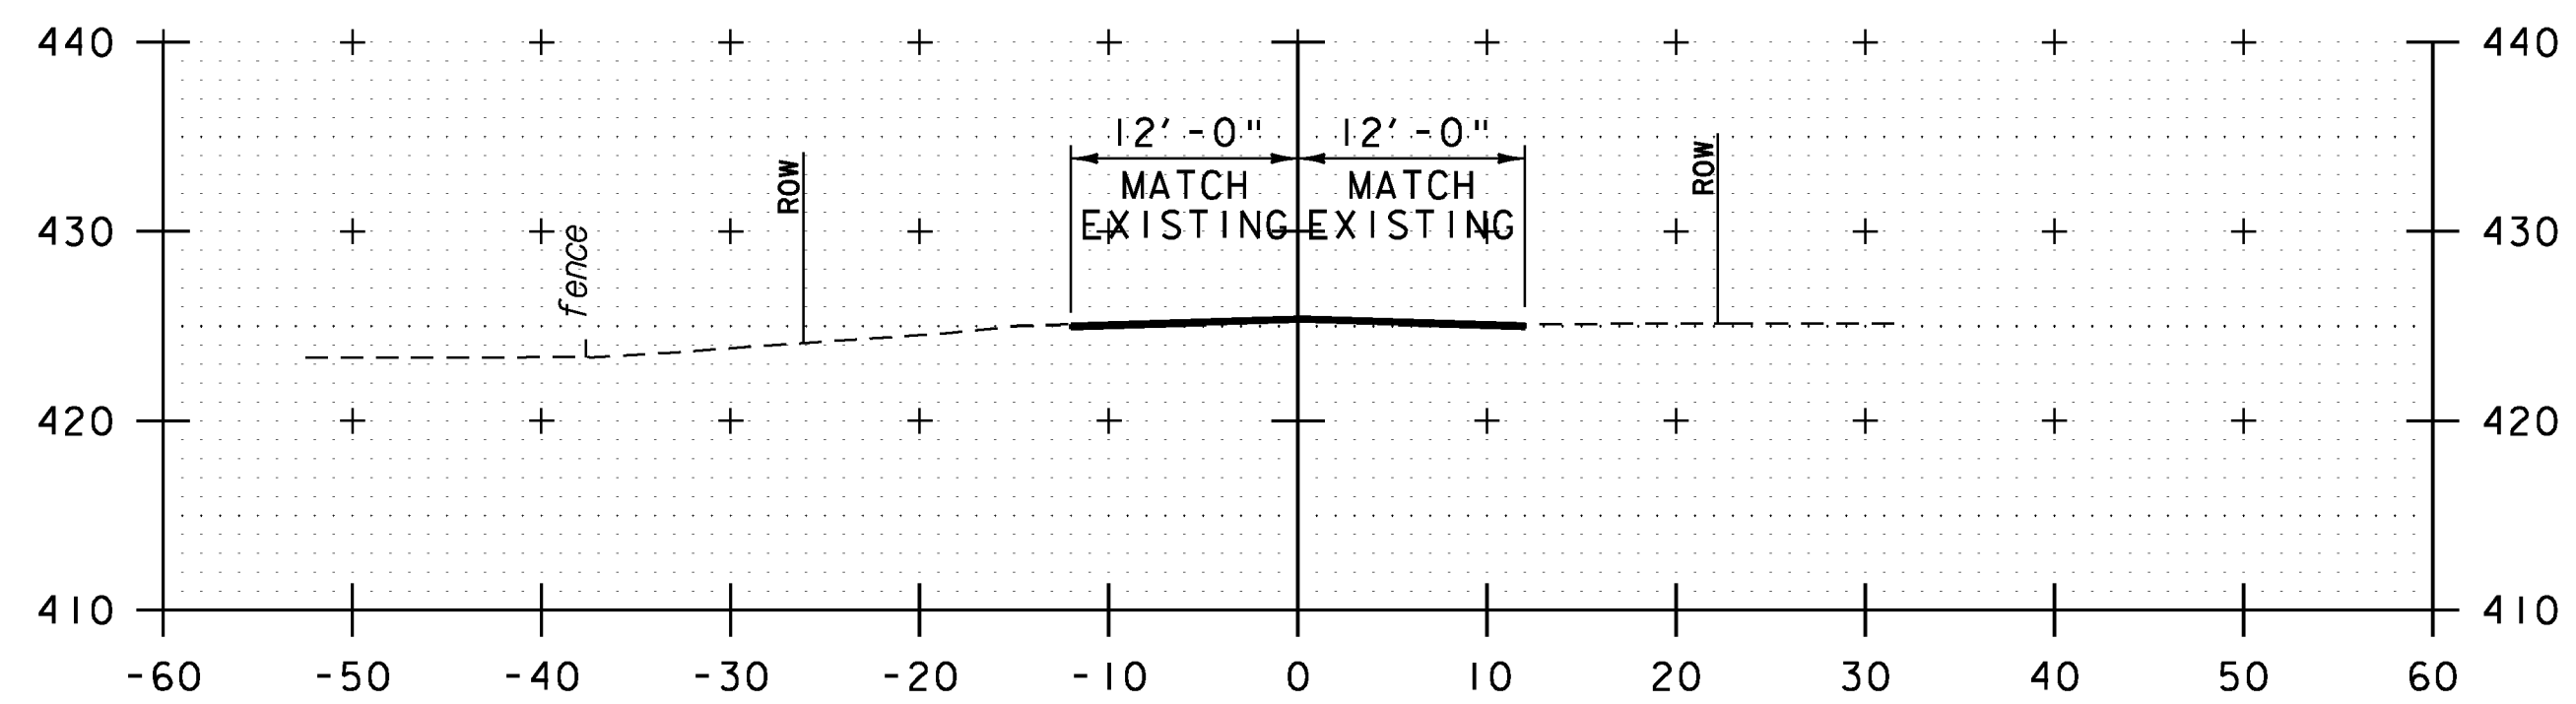

10+75

ROADWAY CROSS SECTIONS
SCALE 1"=10'-0"
STA. 10+00 TO STA. 11+25



PROJECT NAME: HUBBARDTON	PLOT DATE: 7/16/2012
PROJECT NUMBER: ER STP 016(26)	DRAWN BY: C.L. CILLEY
FILE NAME: zllc288xs_01.dgn	CHECKED BY: S.G. FARNSWORTH
PROJECT LEADER: M.A. COLGAN	SHEET 33 OF 70
DESIGNED BY: S.G. FARNSWORTH	
ROADWAY CROSS SECTIONS (1 OF 3)	