



END APPROACH
13+50

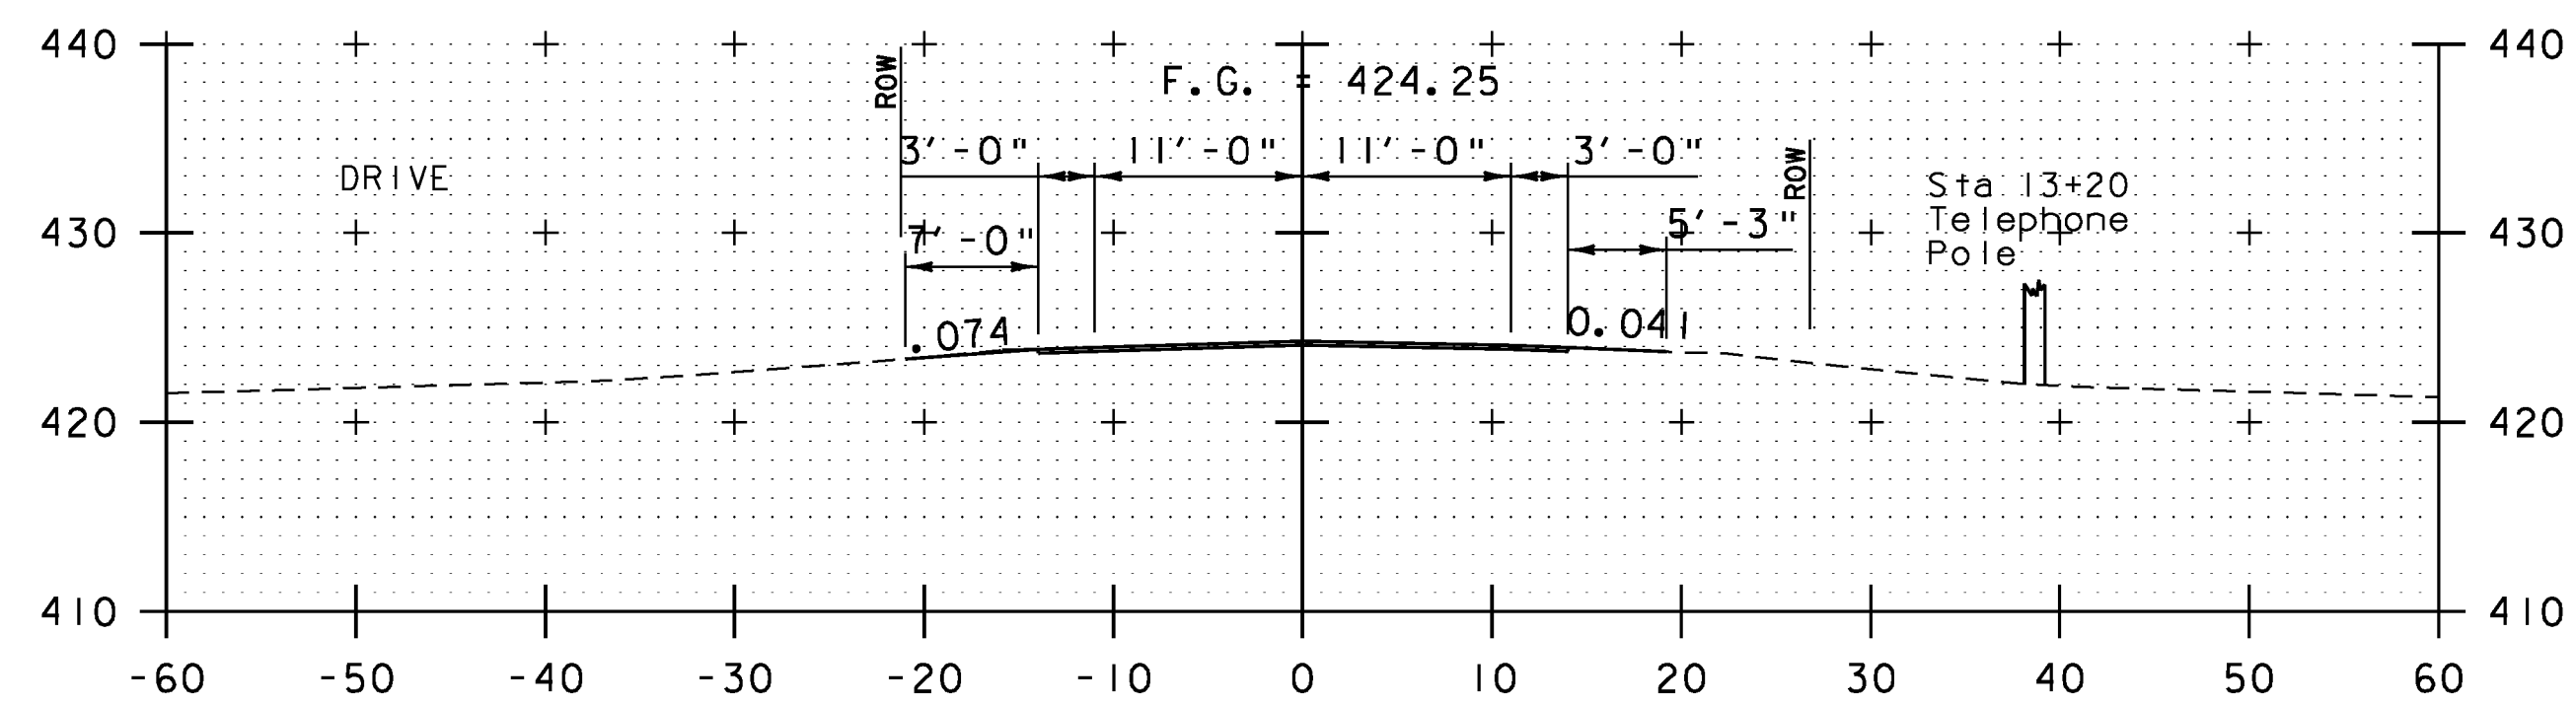


13+25
STA 13+10 END PROJECT

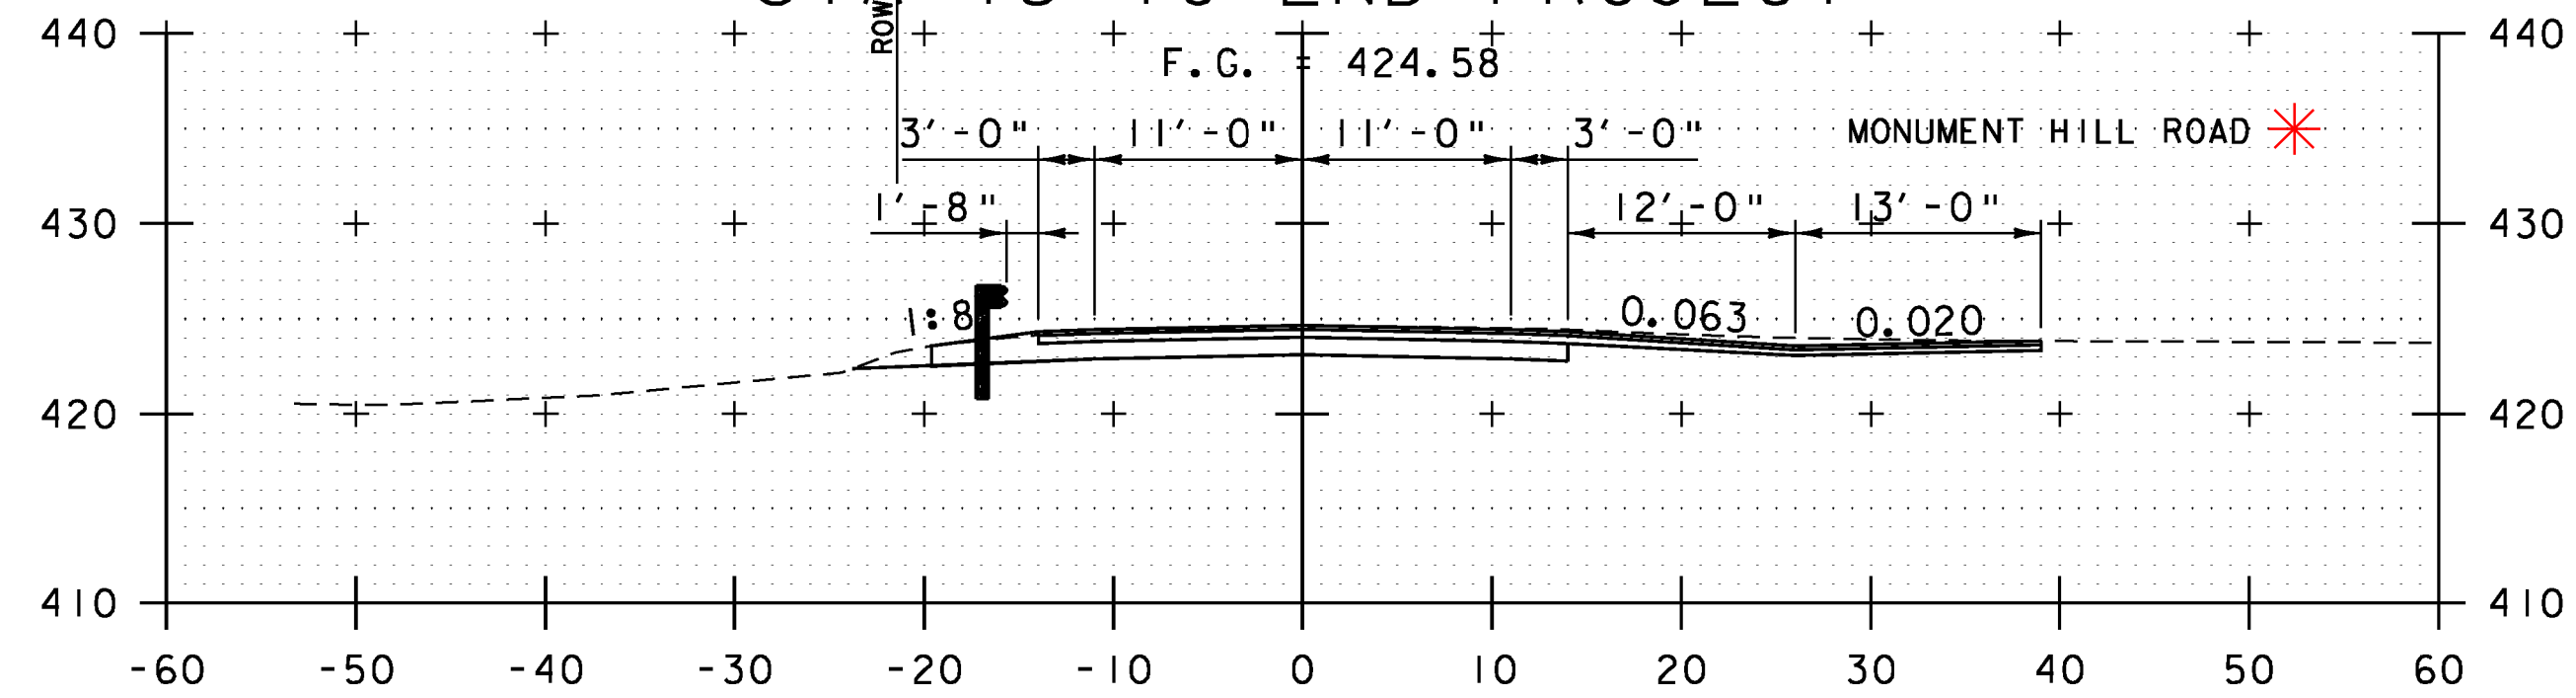


13+00


• SEE NOTE ON
X-SECTION 12+75
FOR DETAILS ON
MILLING

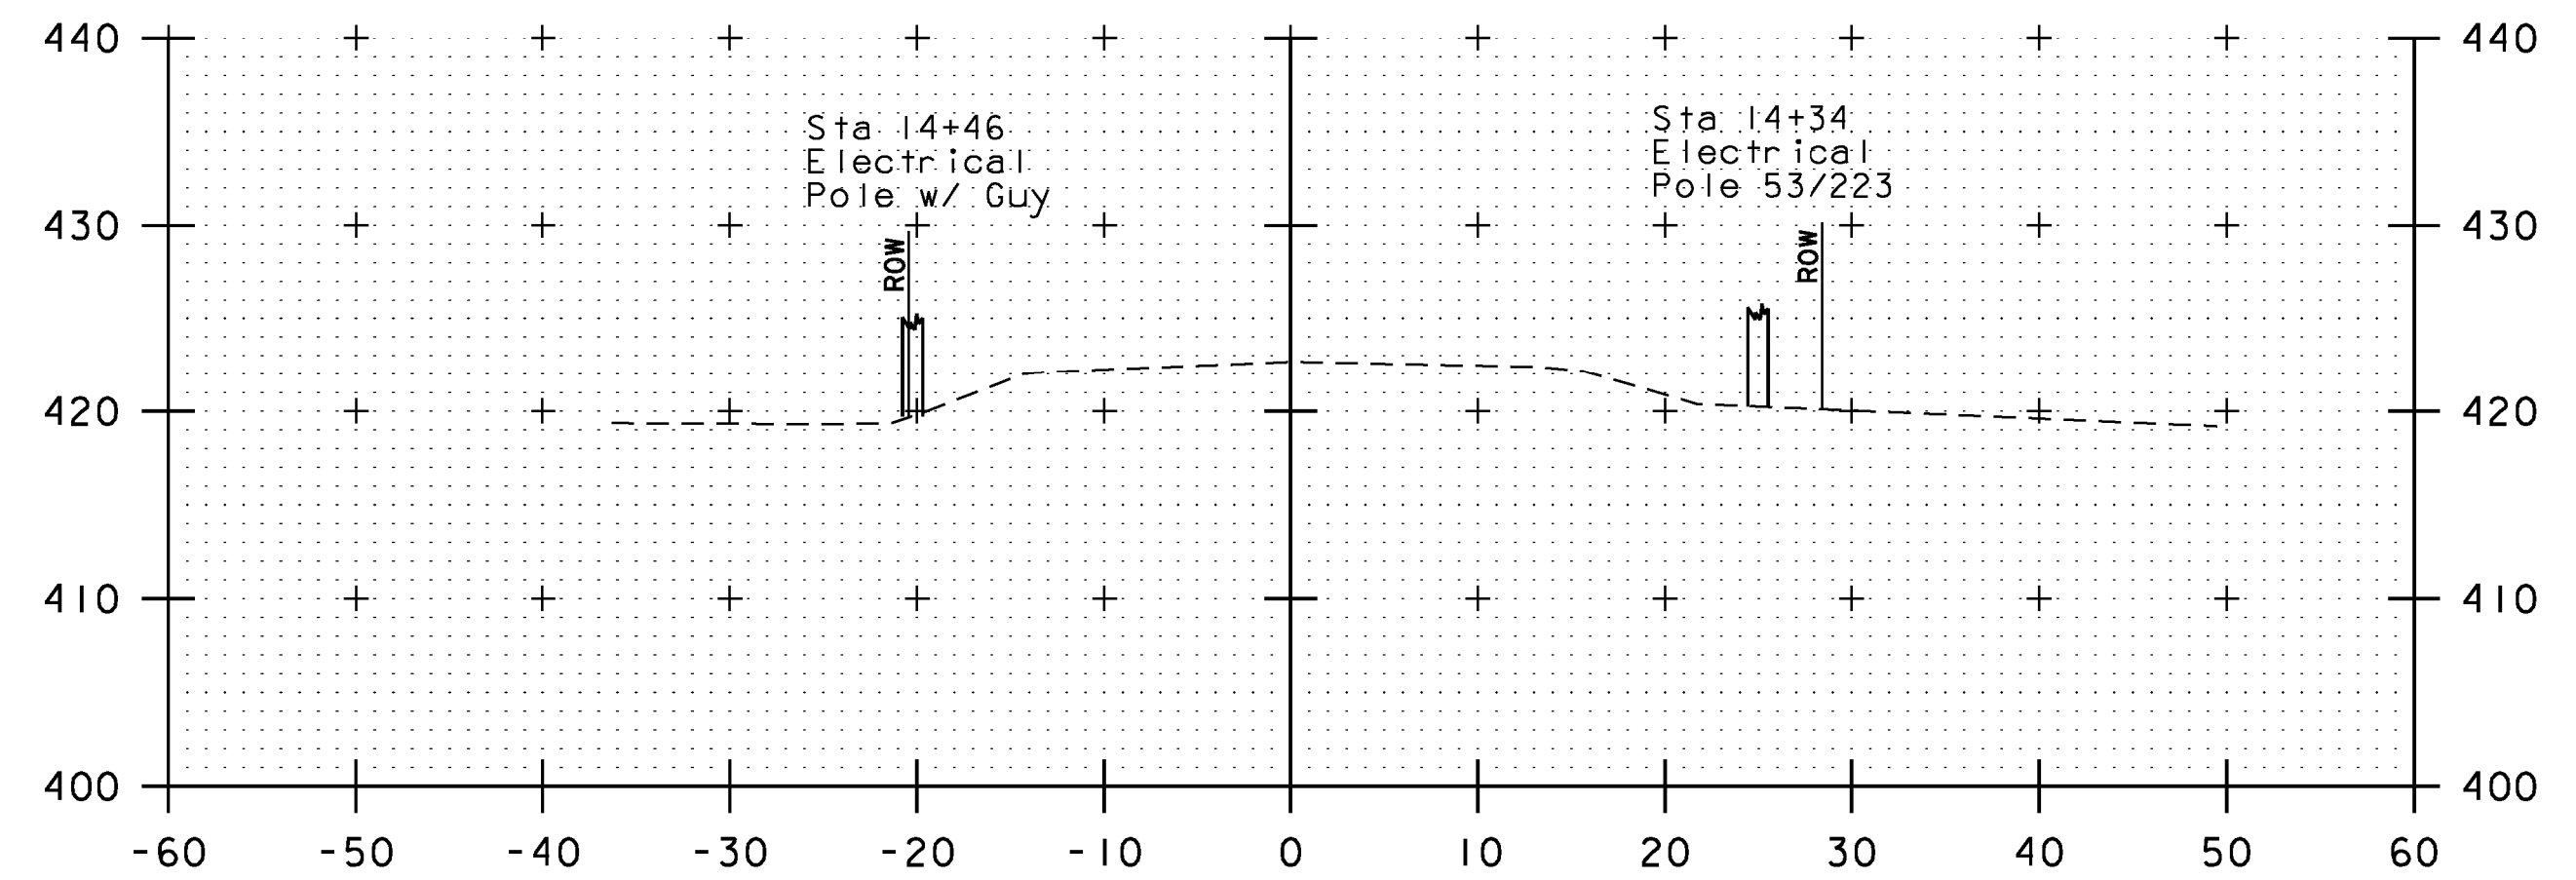

14+25

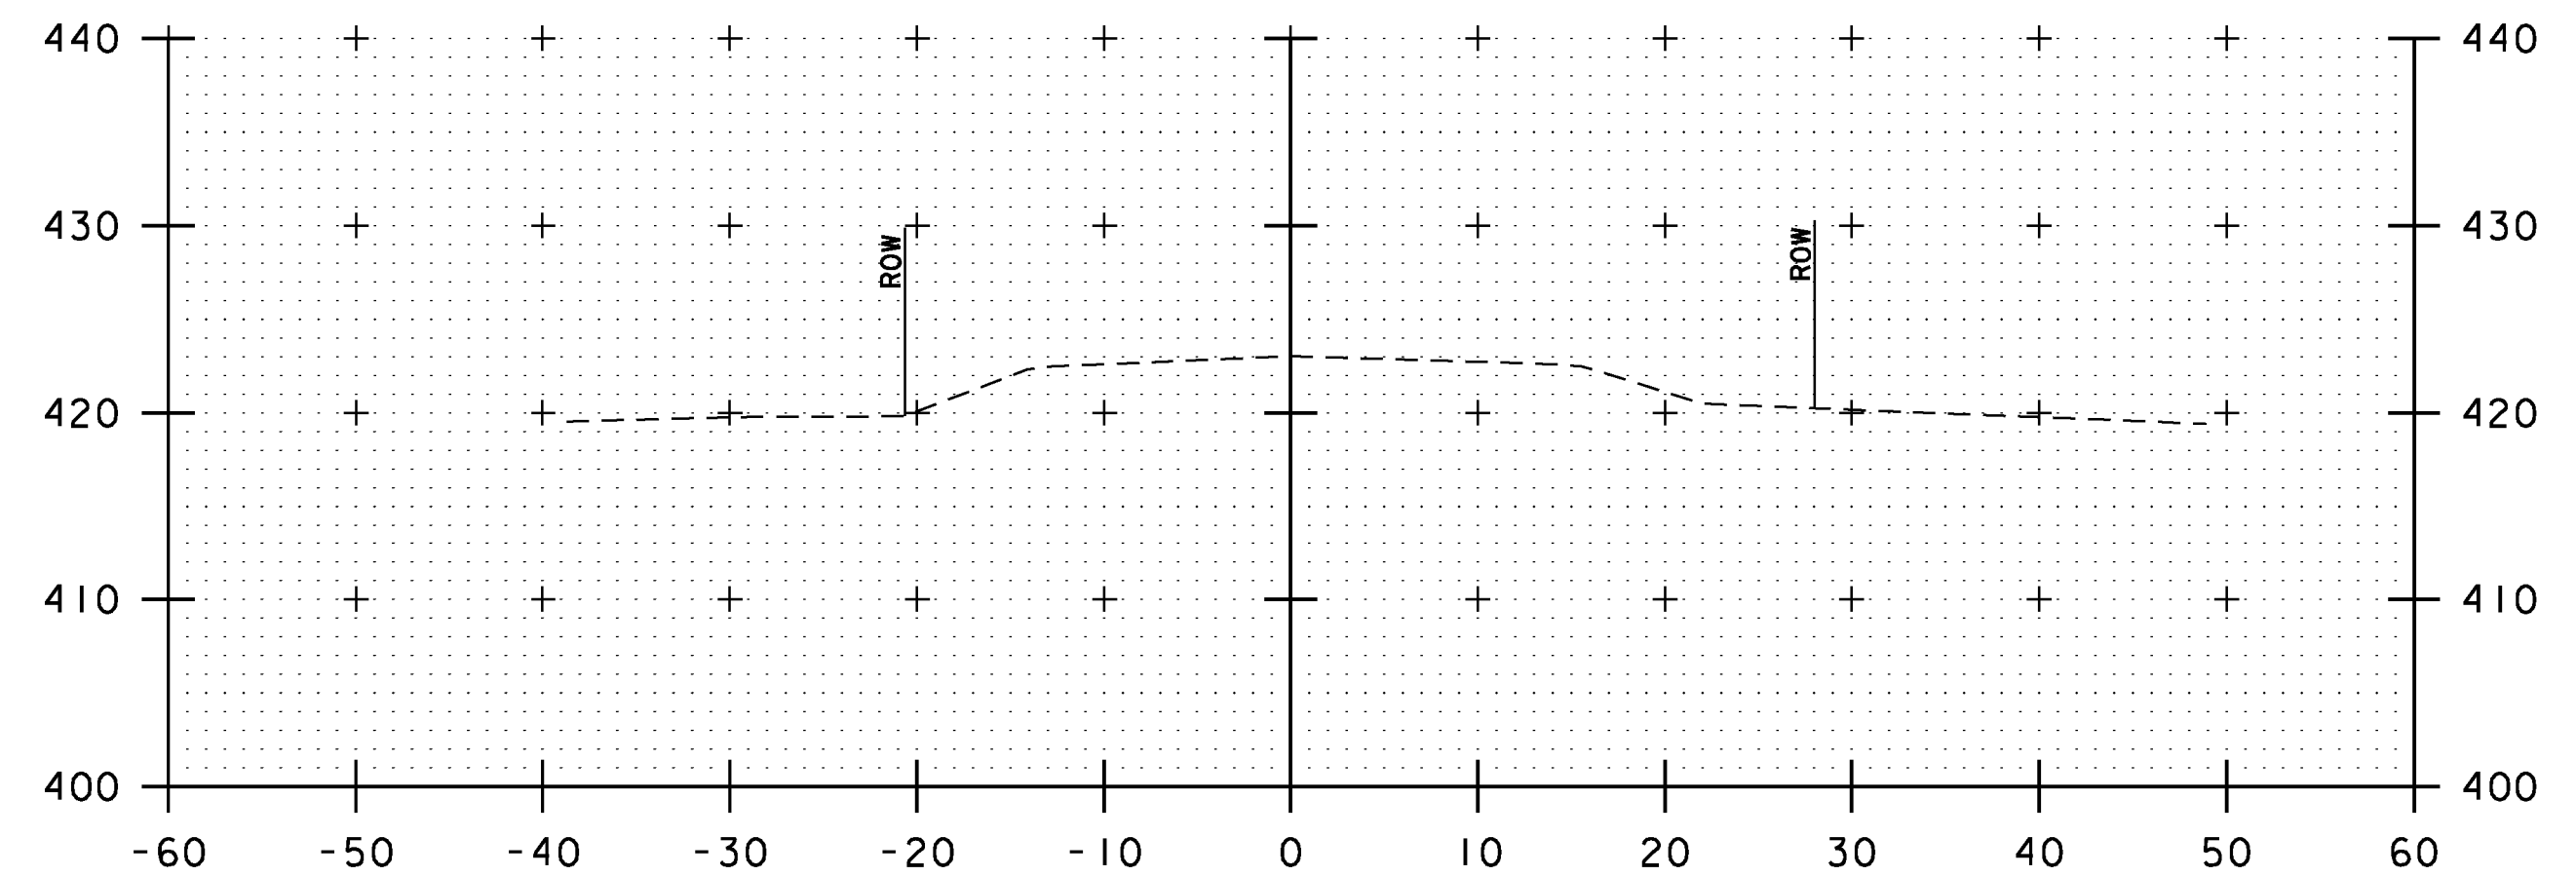

14+00

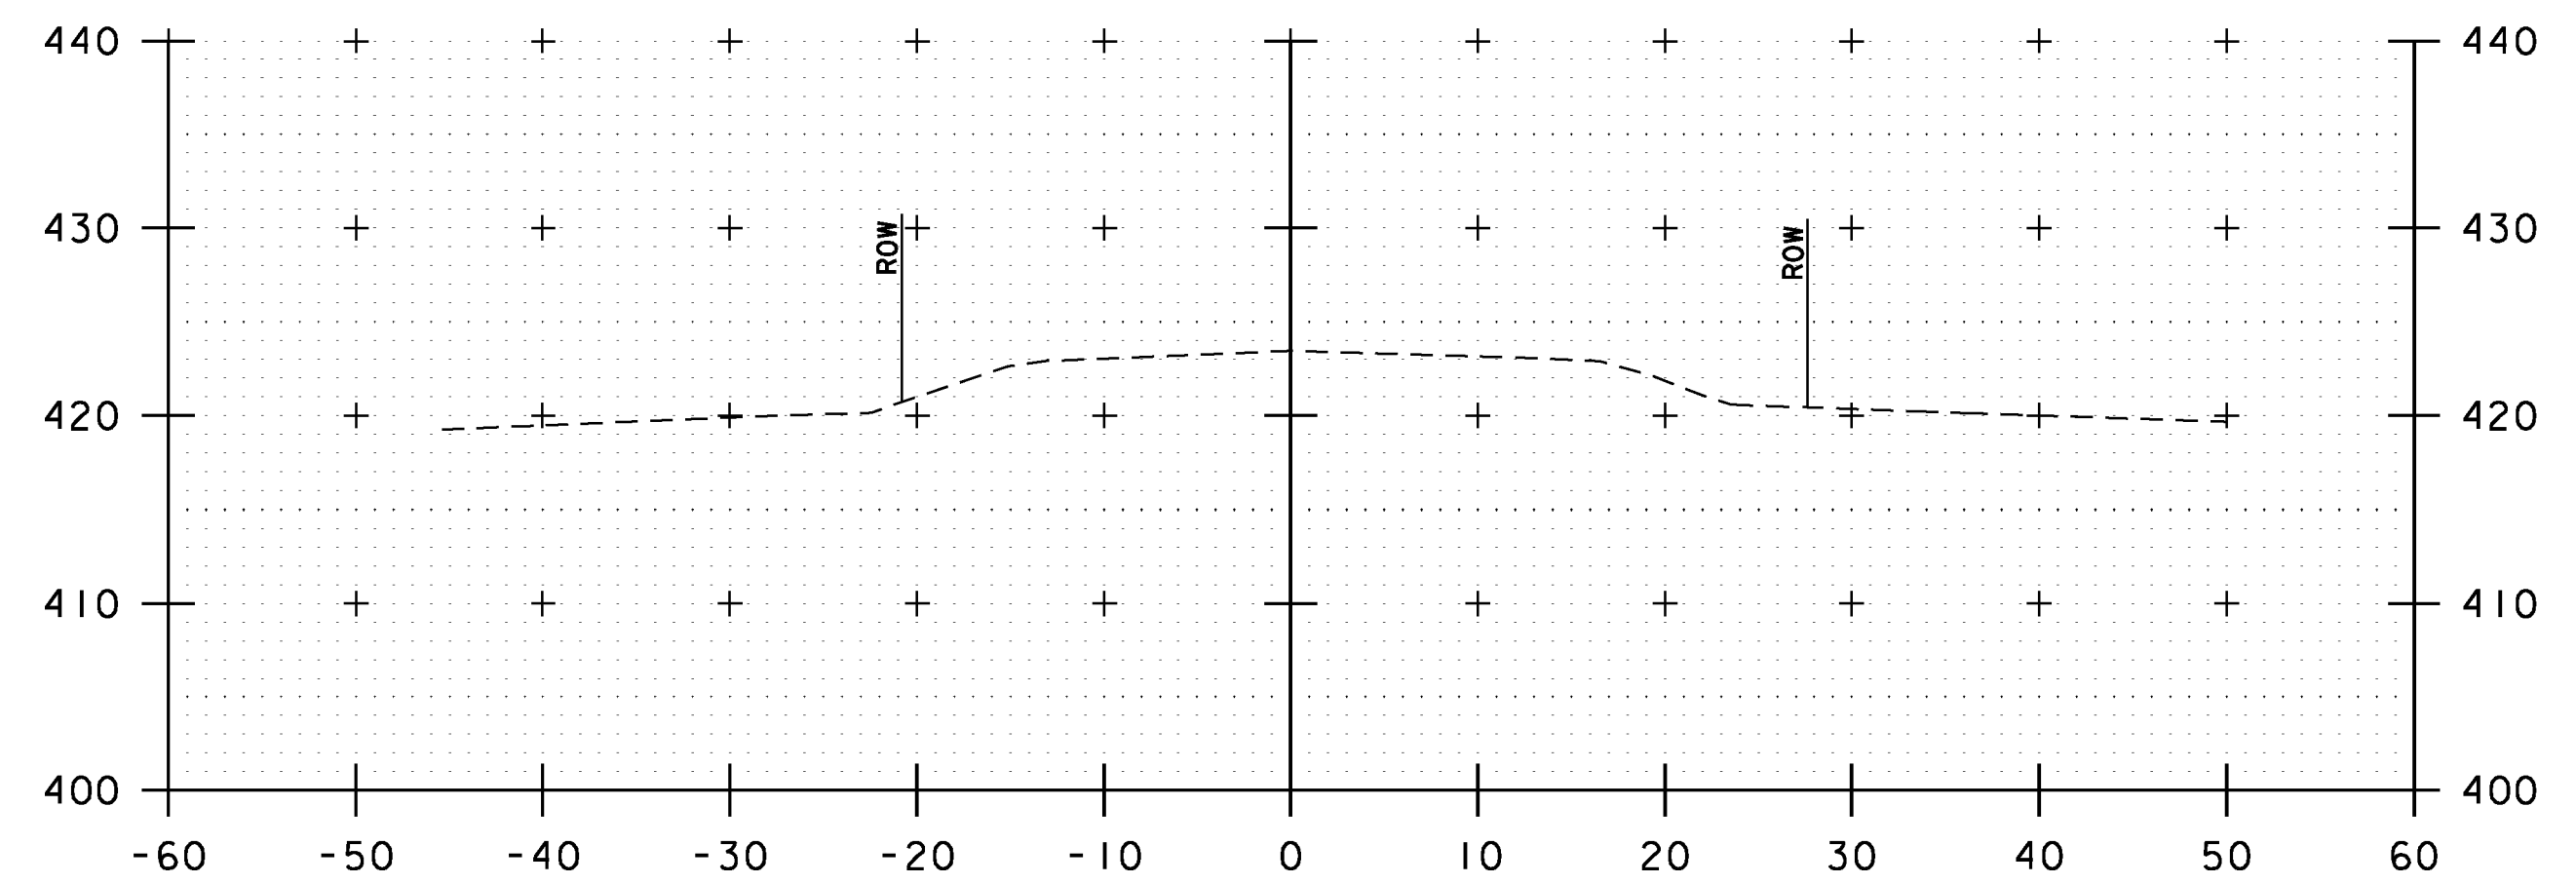

13+75

ROADWAY CROSS SECTIONS
SCALE 1"=10'-0"

STA. 13+00 TO STA. 14+25



PROJECT NAME: HUBBARDTON
PROJECT NUMBER: ER STP 0161(26)

FILE NAME: zllc288xs_03.dgn
PROJECT LEADER: M.A. COLGAN
DESIGNED BY: S.G. FARNSWORTH
ROADWAY CROSS SECTIONS (3 OF 3)

PLOT DATE: 7/16/2012
DRAWN BY: C.L. CILLEY
CHECKED BY: S.G. FARNSWORTH
SHEET 35 OF 70