


21+00

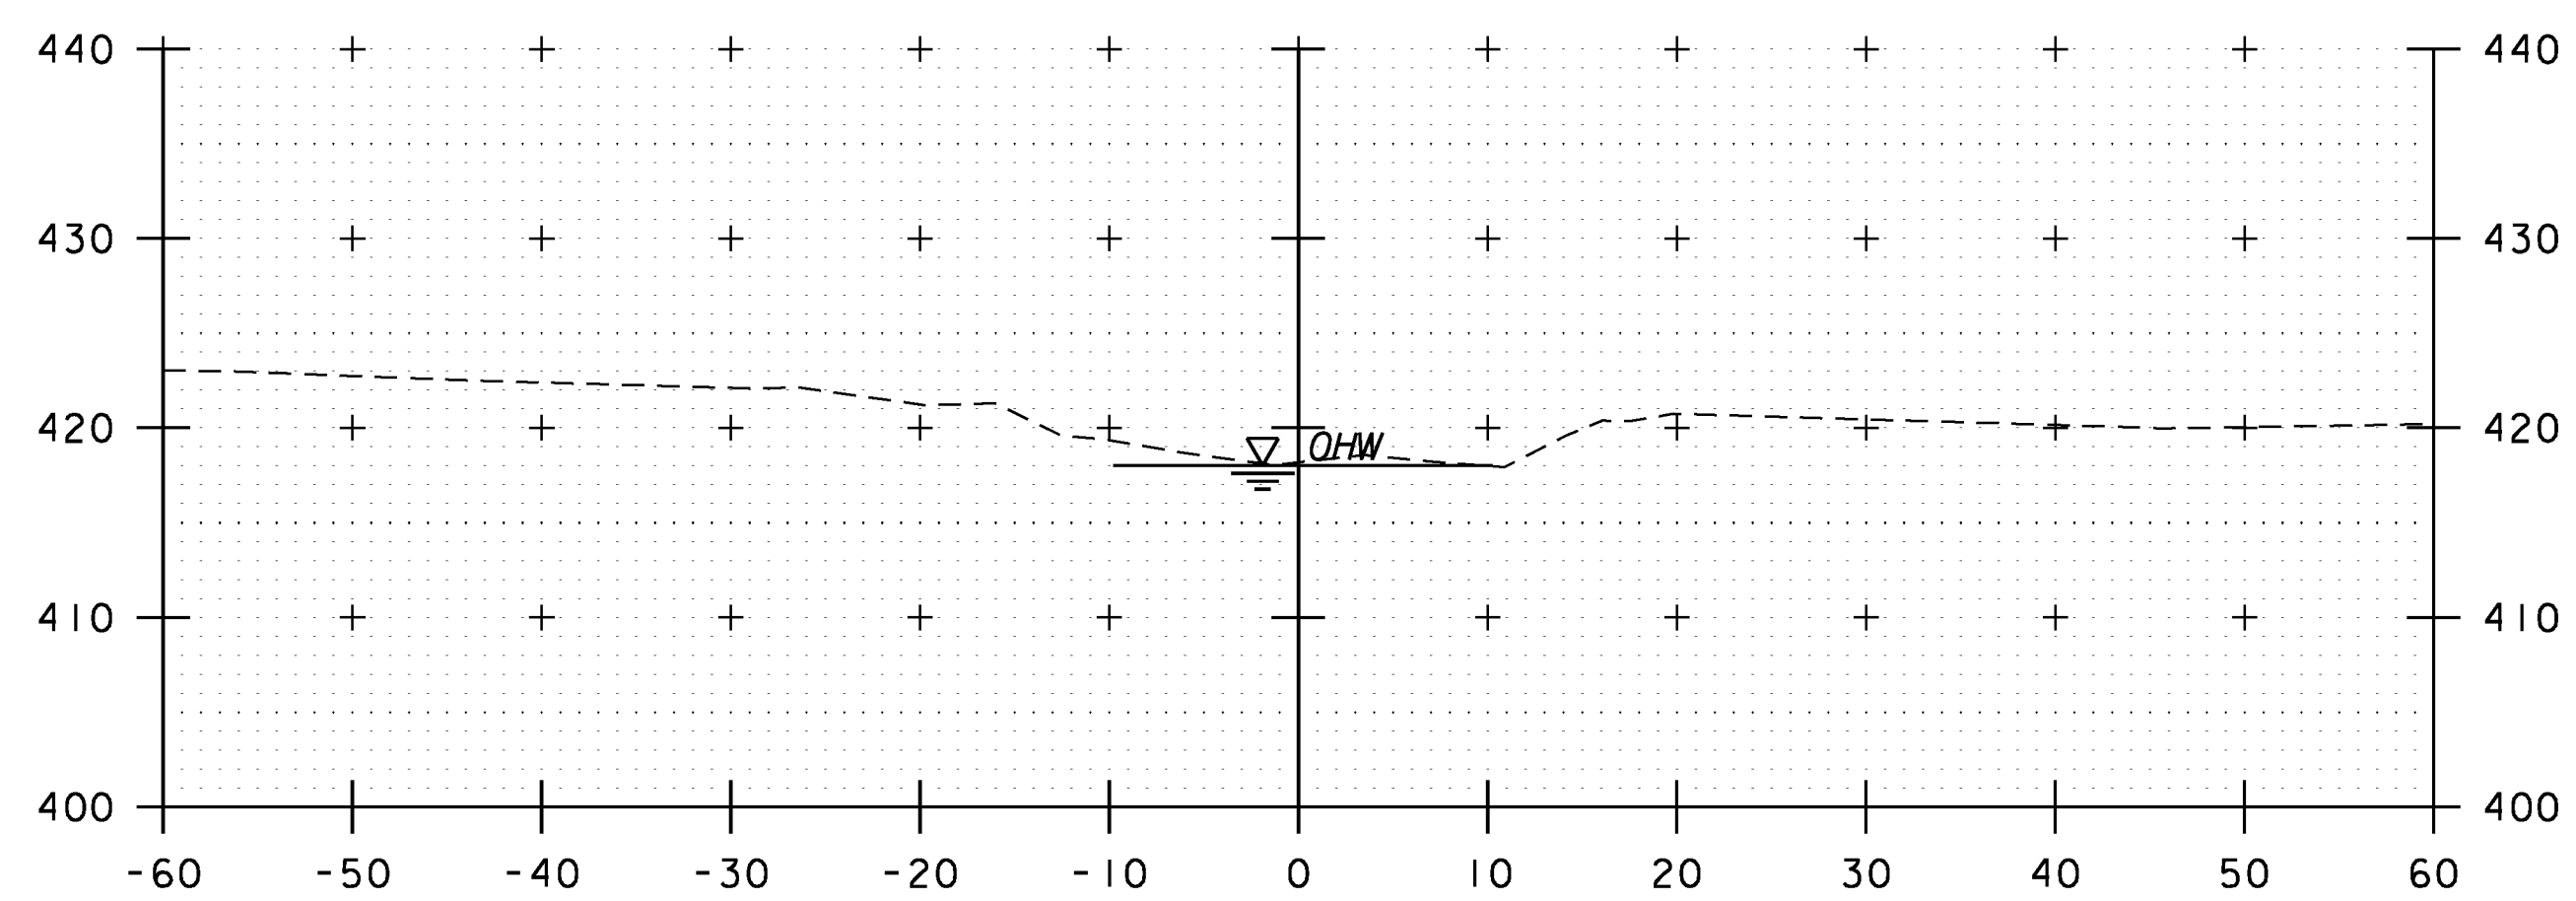

20+90

CHANNEL CROSS SECTIONS

SCALE 1"=10'-0"

STA. 20+90 TO STA. 21+00



PROJECT NAME: HUBBARDTON	PLOT DATE: 7/16/2012
PROJECT NUMBER: ER STP 0161(26)	DRAWN BY: C.L. CILLEY
FILE NAME: z1lc288chxs_02.dgn	CHECKED BY: S.G. FARNSWORTH
PROJECT LEADER: M.A. COLGAN	SHEET 37 OF 70
DESIGNED BY: S.G. FARNSWORTH	
<b>CHANNEL CROSS SECTIONS (2 OF 2)</b>	