



PLAN
 DRAWING NO. 1188
 PROJECT: Hubbardton
 DATE: 1/15/59
 DRAWN BY: [unclear]
 CHECKED BY: [unclear]
 IN CHARGE: [unclear]

PLAN
 DRAWING NO. 1188
 PROJECT: Hubbardton
 DATE: 1/15/59
 DRAWN BY: [unclear]
 CHECKED BY: [unclear]
 IN CHARGE: [unclear]

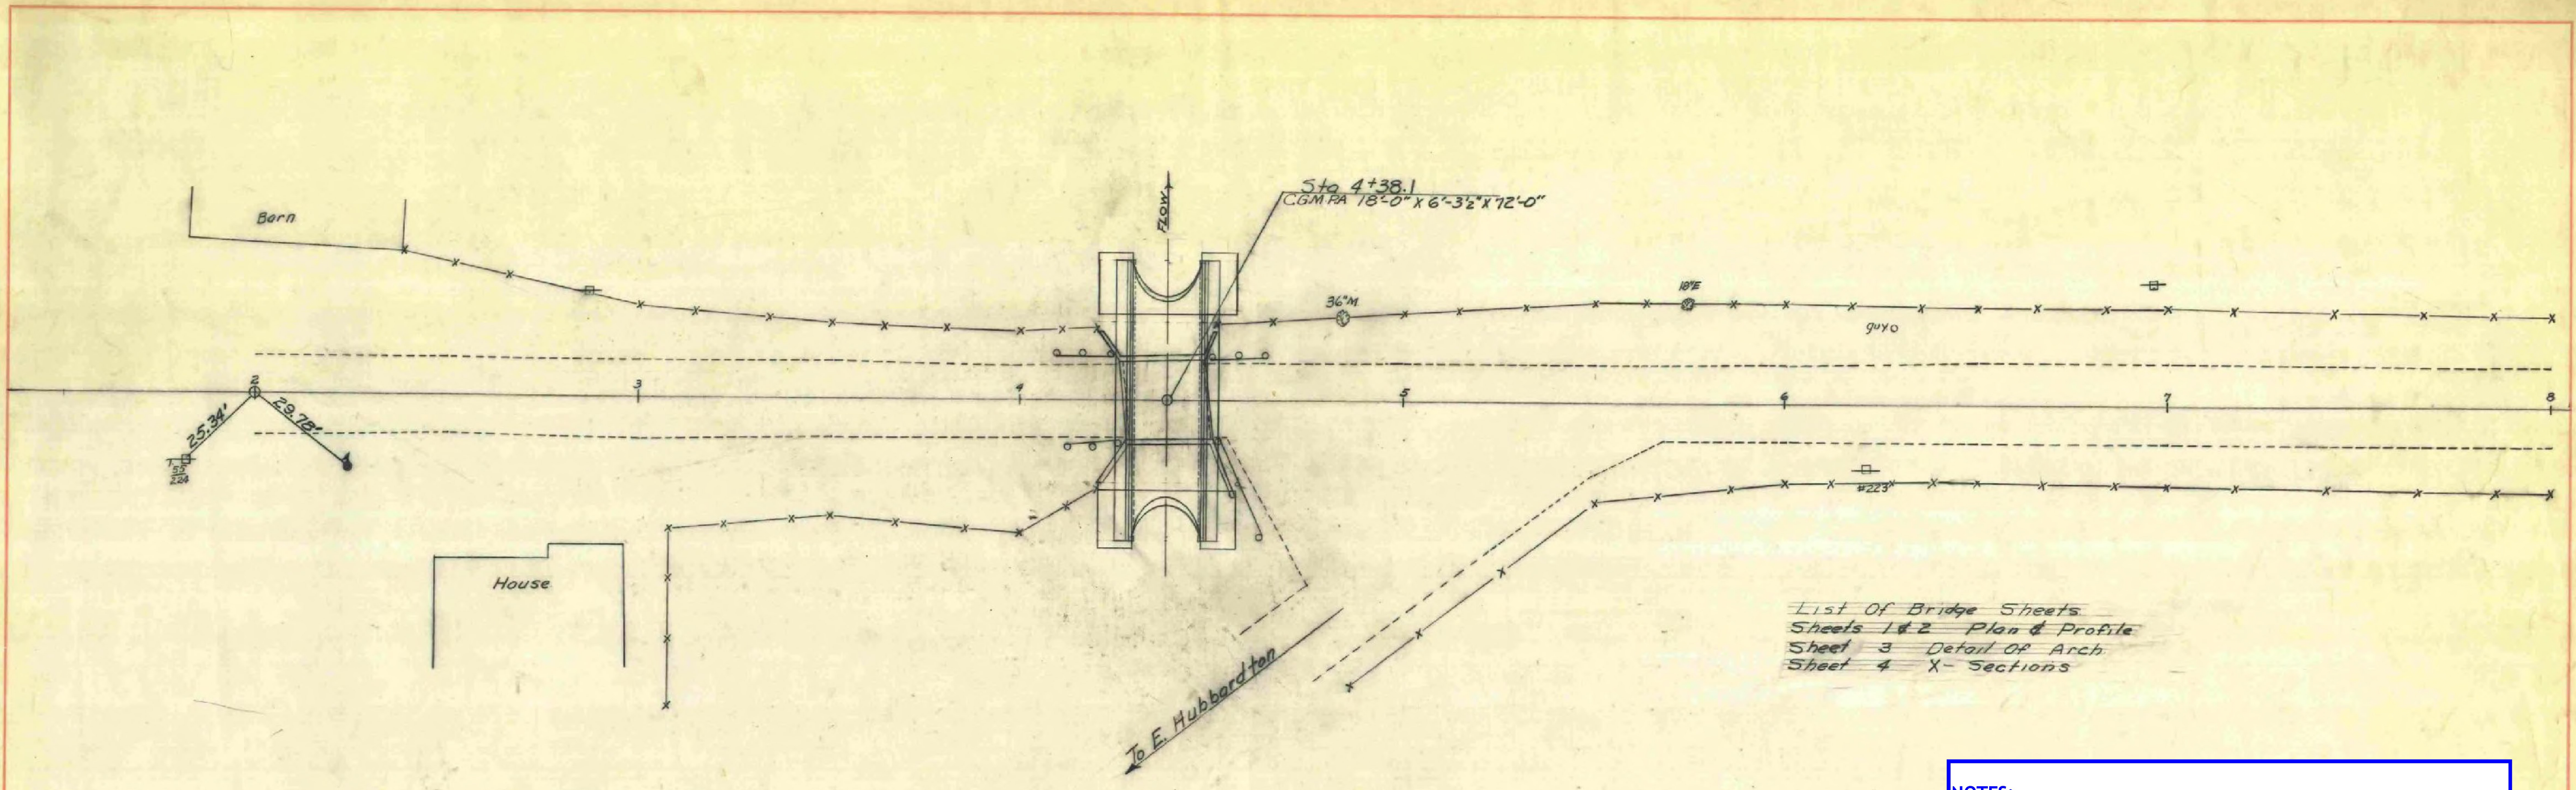

List of Bridge Sheets
 Sheets 1 & 2 Plan & Profile
 Sheet 3 Detail of Arch
 Sheet 4 X-Sections

NOTES:
 1. IN 1960 WHEN THIS ARCH WAS INSTALLED, THE ROADWAY PROFILE GRADE OVER THE ARCH WAS ONLY RAISED THREE FEET AND NOT THE SIX FEET AS SHOWN IN THIS PROFILE.
 2. IN SEPTEMBER 2011 WHEN VTRANS REMOVED THE STEEL ARCH THE TWO 1960 CONCRETE FOOTINGS WERE LEFT IN PLACE.

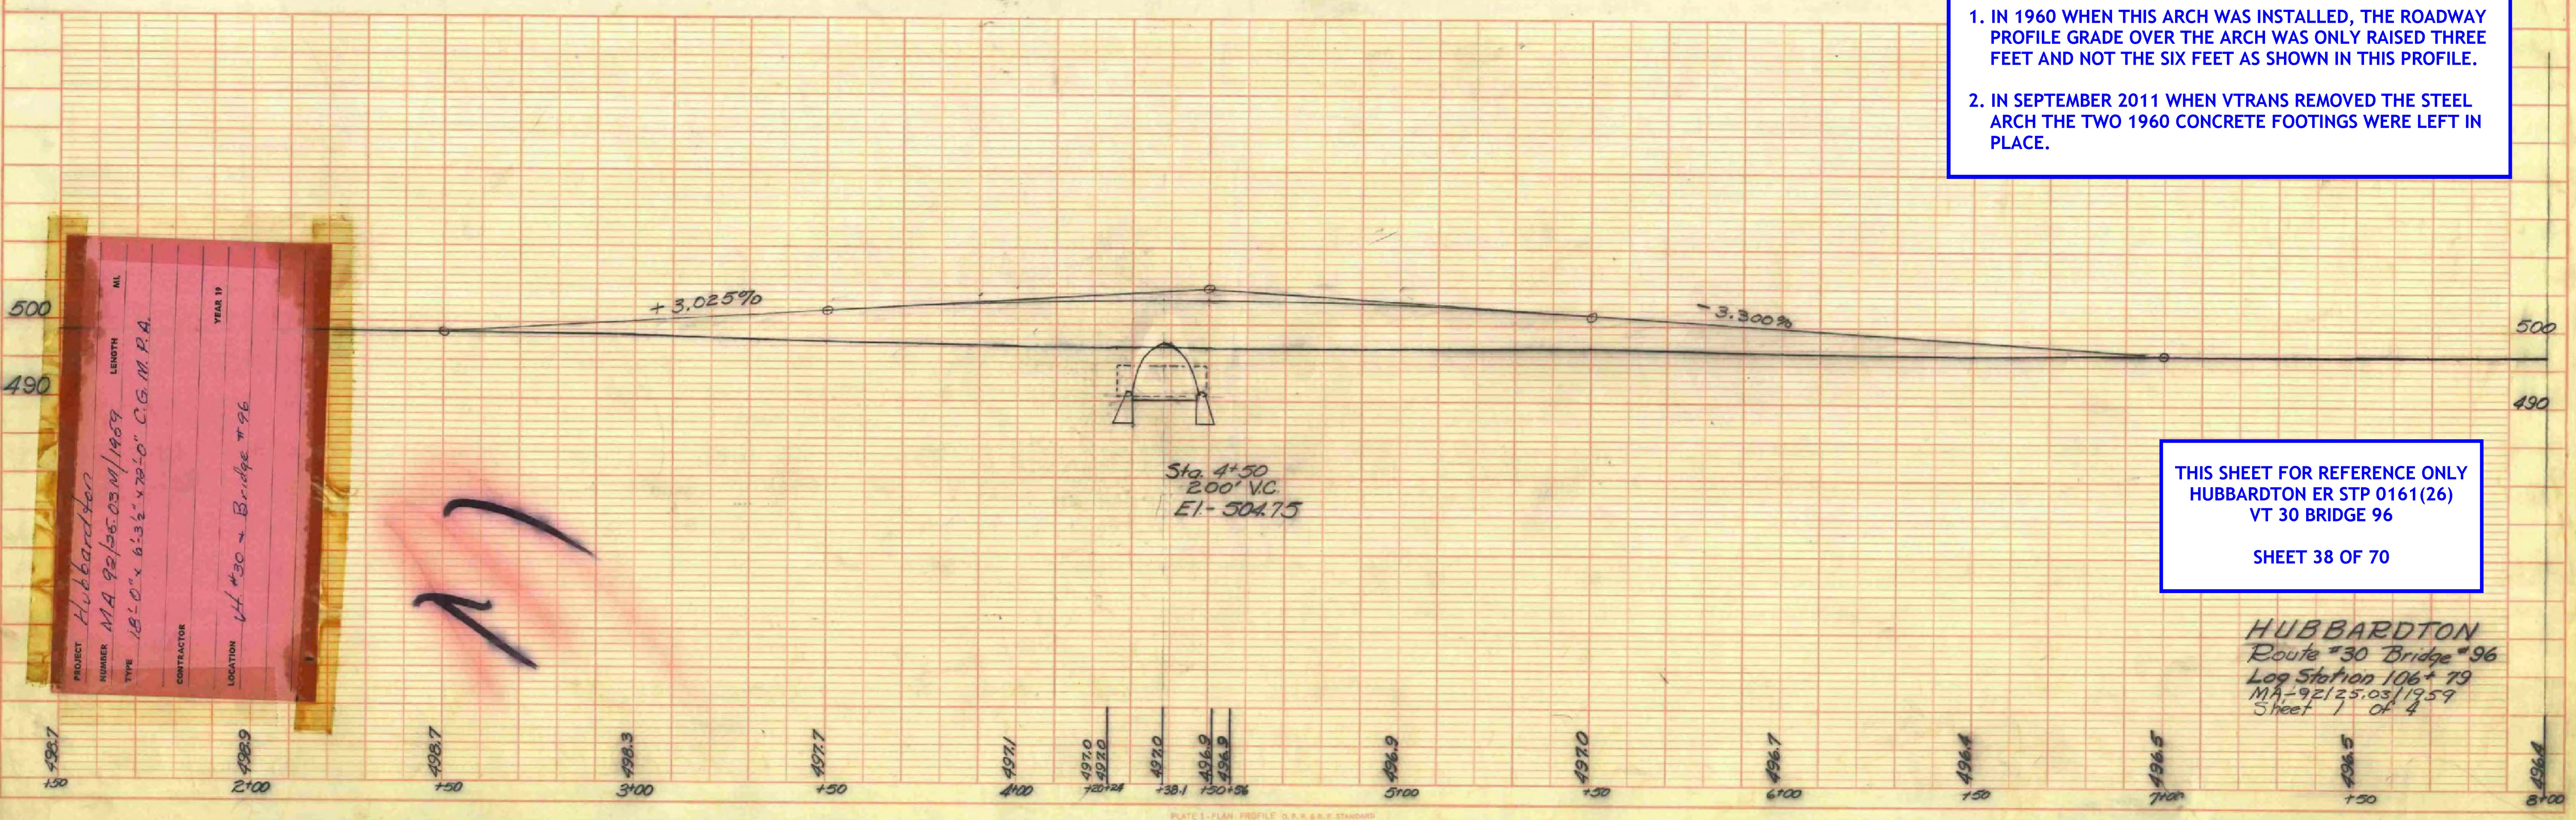

THIS SHEET FOR REFERENCE ONLY
 HUBBARDTON ER STP 0161(26)
 VT 30 BRIDGE 96
 SHEET 38 OF 70

PROJECT: Hubbardton
 NUMBER: MA 92/25.03M/1959
 TYPE: 18'-0" x 6'-3 1/2" x 12'-0" C.G.M.P.A.
 CONTRACTOR: [unclear]
 LOCATION: Vt. #30 - Bridge #96
 YEAR: 1959

HUBBARDTON
 Route #30 Bridge #96
 Log Station 106+79
 MA-92/25.03/1959
 Sheet 1 of 4