


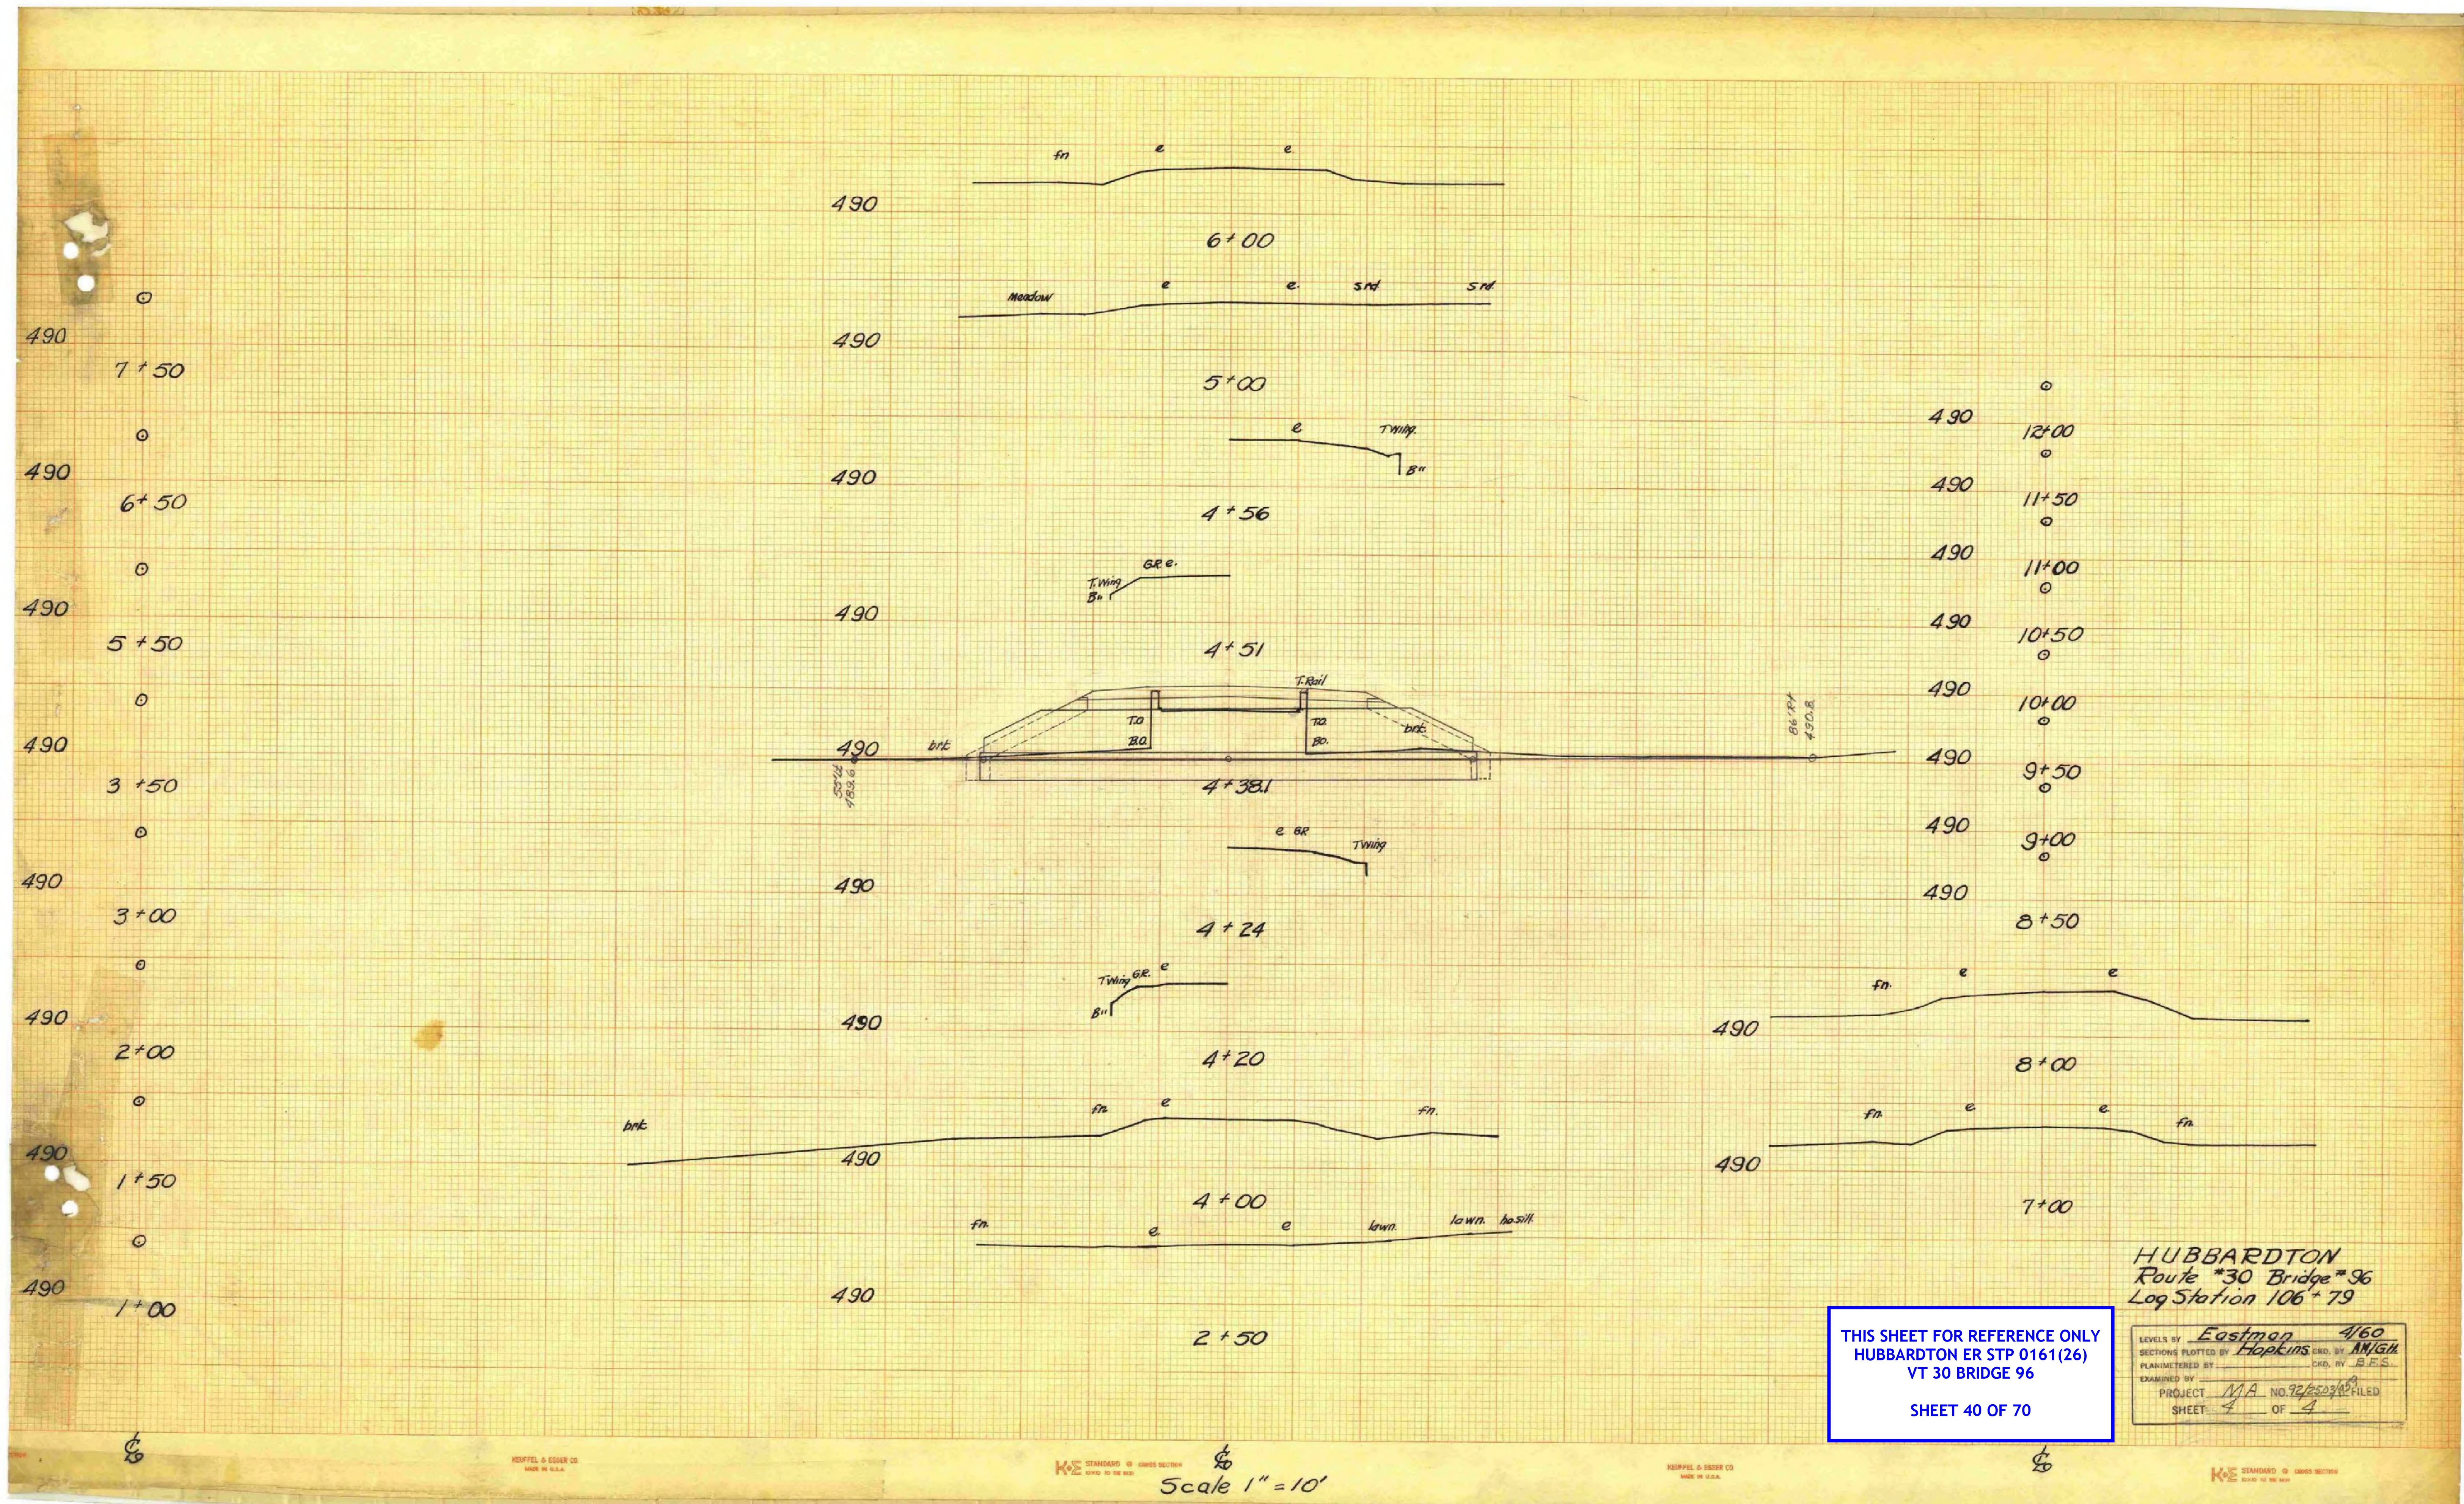

HUBBARDTON
Route #30 Bridge #96
Log Station 106+79

THIS SHEET FOR REFERENCE ONLY
HUBBARDTON ER STP 0161(26)
VT 30 BRIDGE 96
SHEET 40 OF 70

LEVELS BY Eastman 4/60
SECTIONS PLOTTED BY Hopkins CRD. BY AN/AM
PLANIMETERED BY B.E.S. CRD. BY B.E.S.
EXAMINED BY
PROJECT MA NO. 92-2503 FILED
SHEET 4 OF 4

Scale 1" = 10'