




32+75

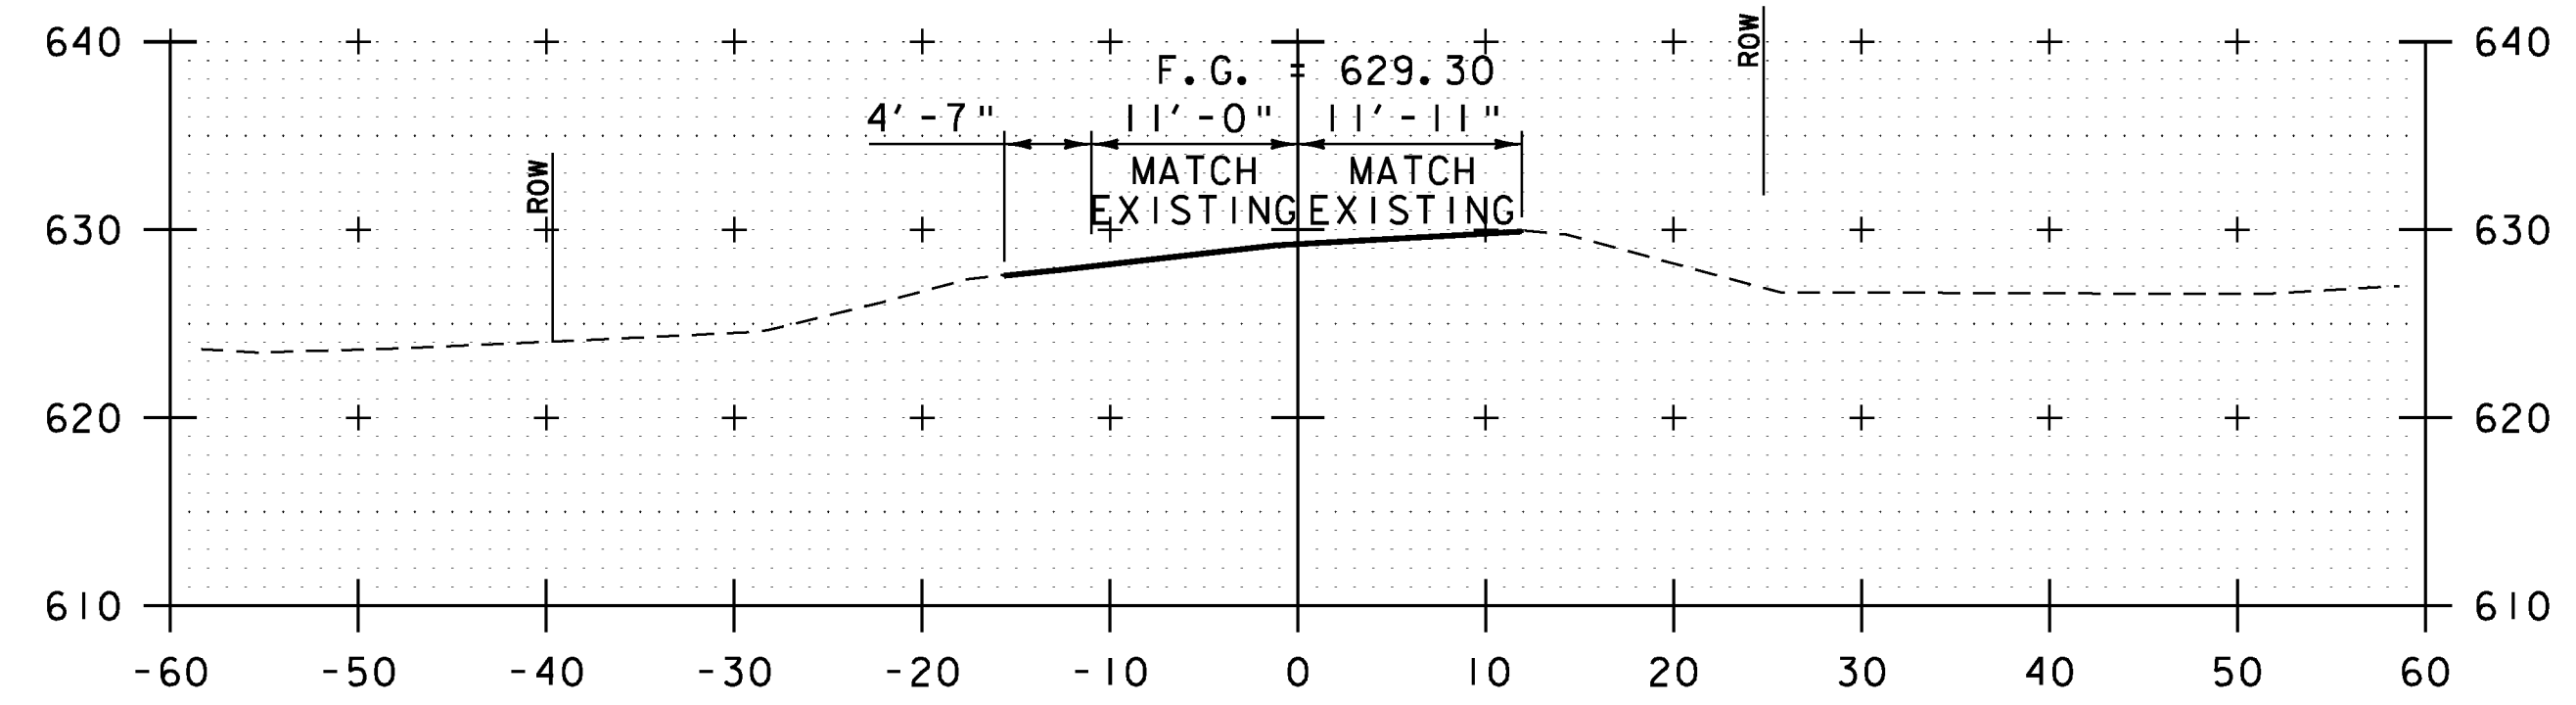


33+50

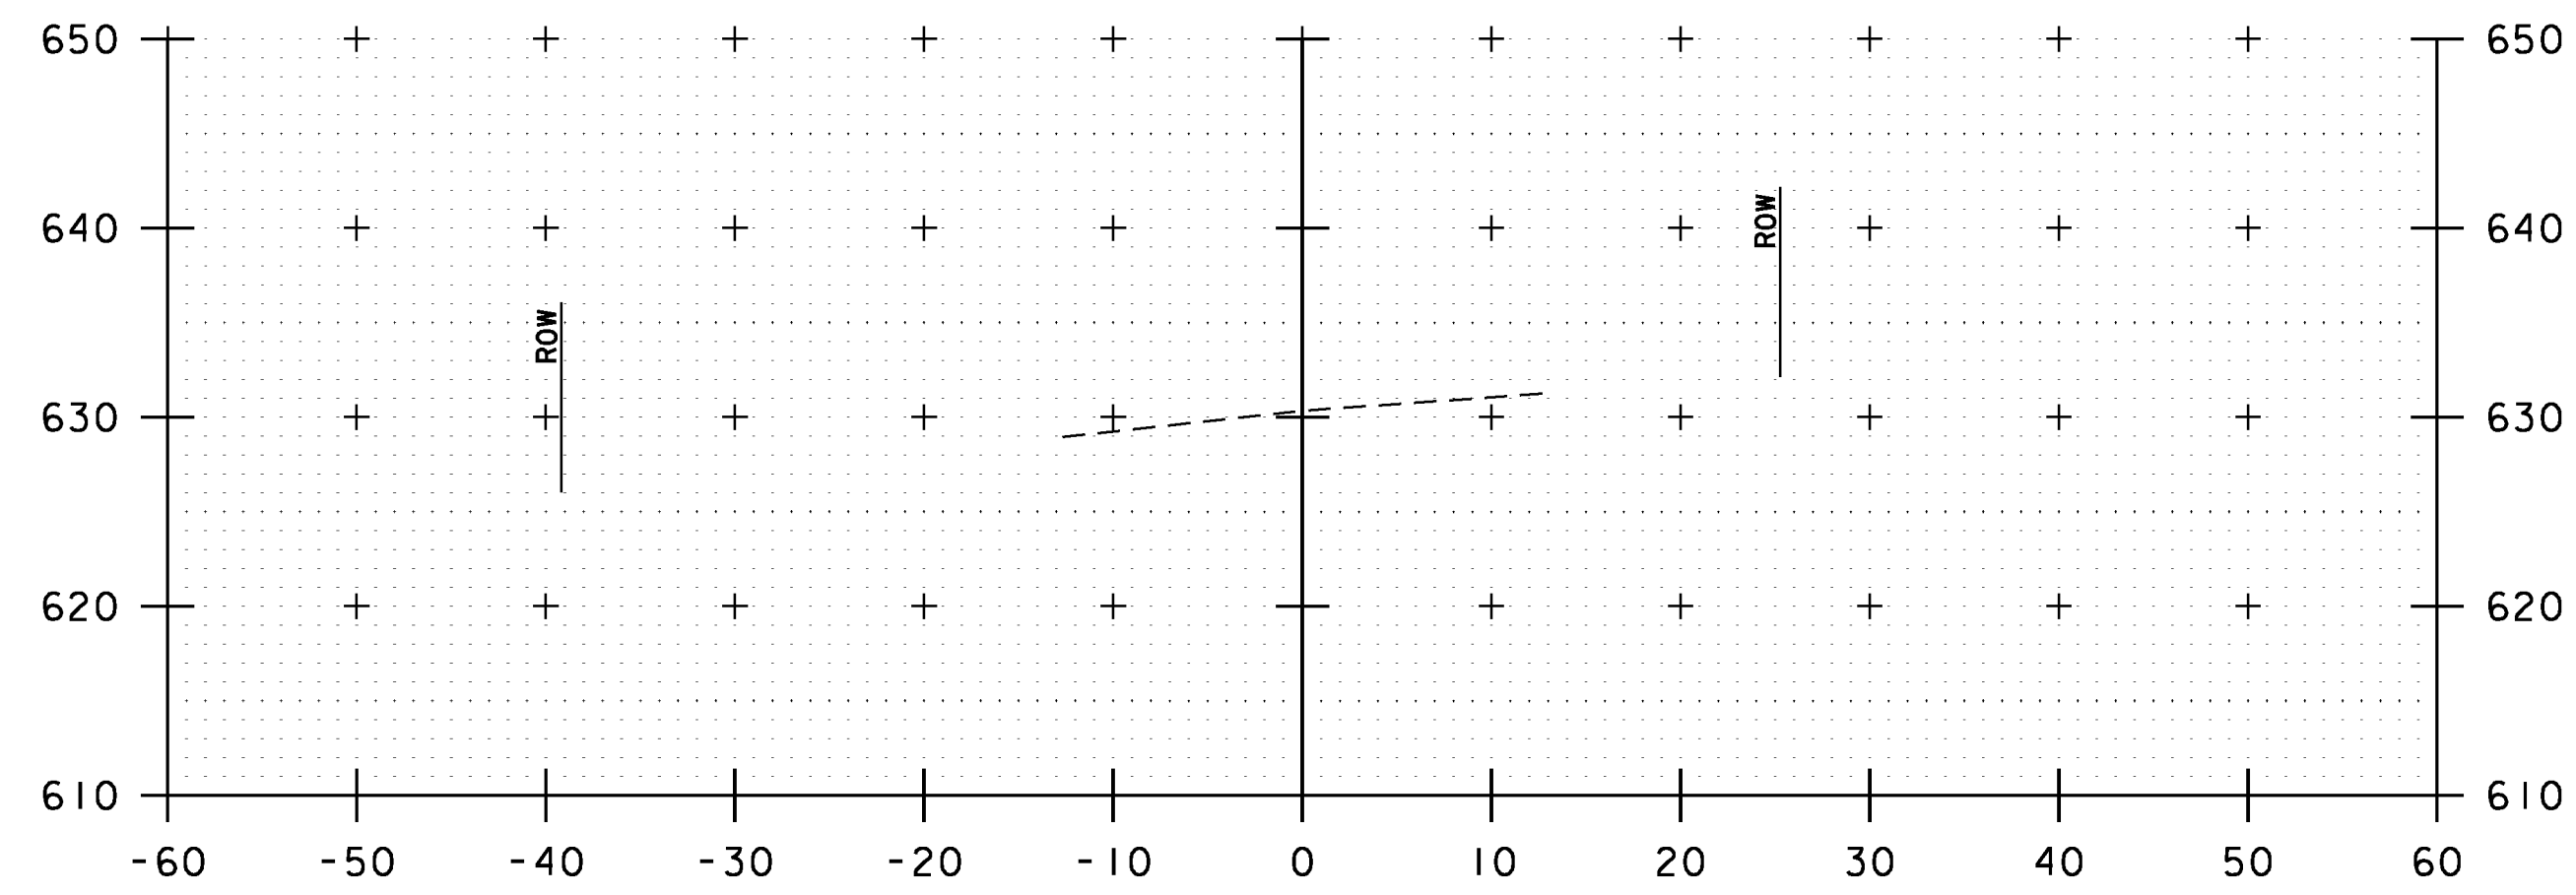


32+50

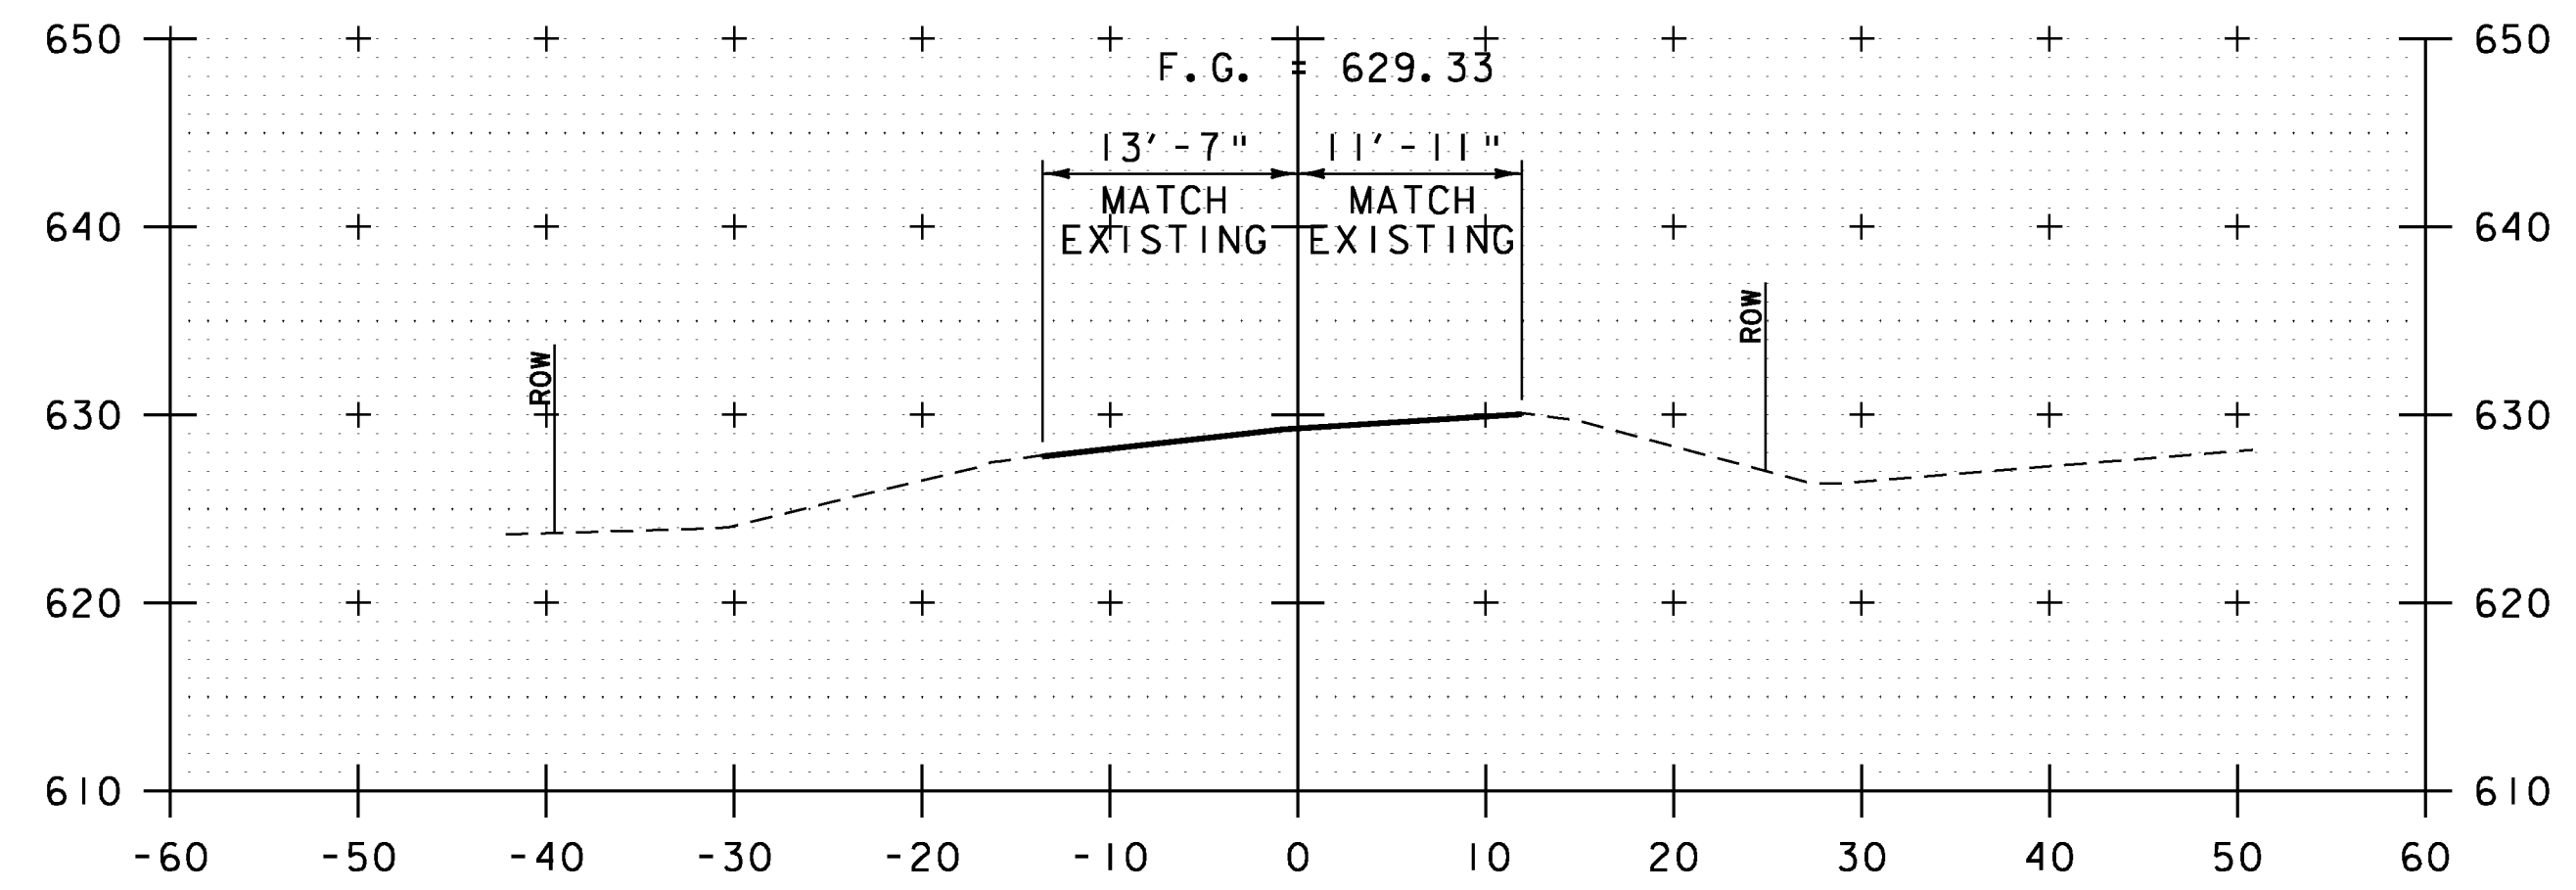

BEGIN APPROACH
33+25

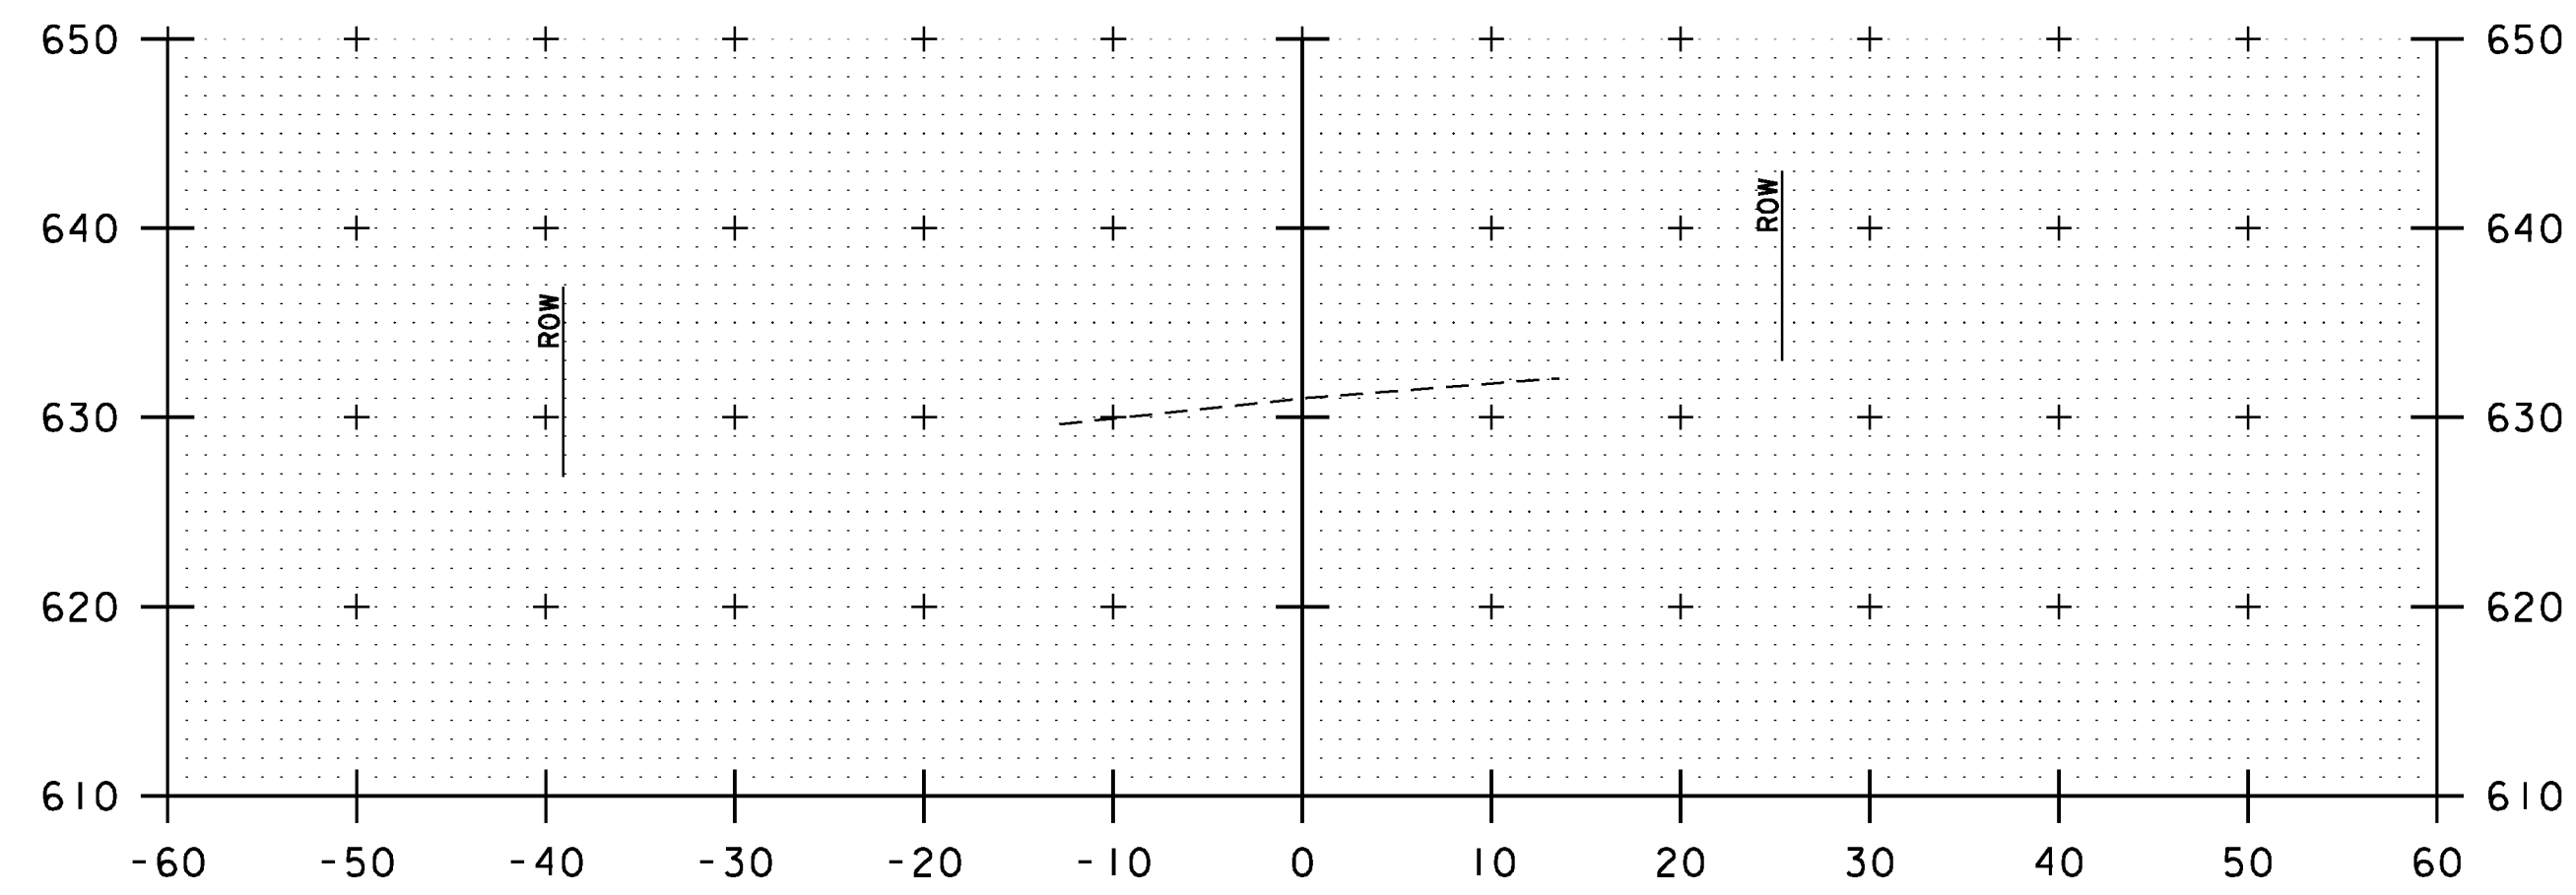


32+25

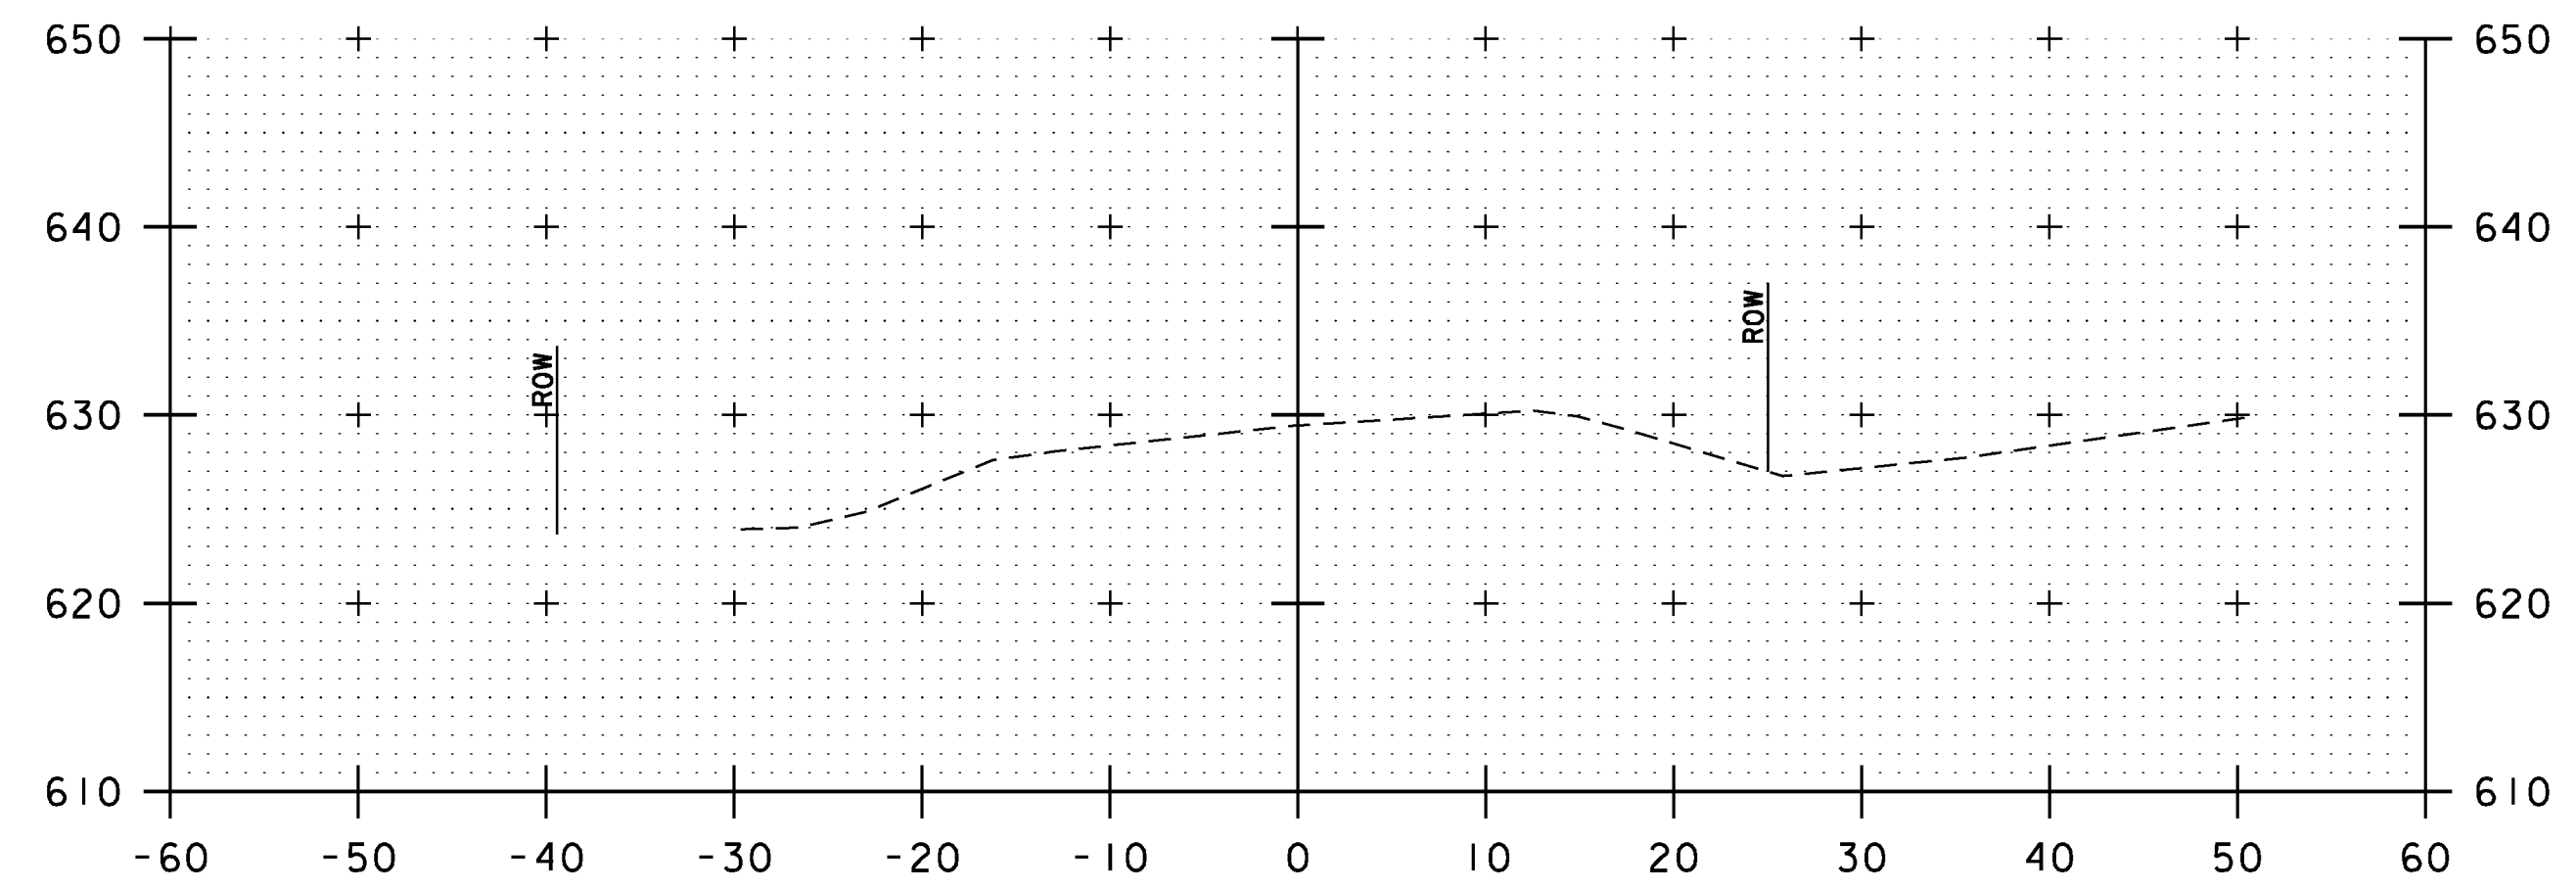

33+00

ROADWAY CROSS SECTIONS
SCALE 1" = 10' - 0"

STA. 32+25 TO STA. 33+50

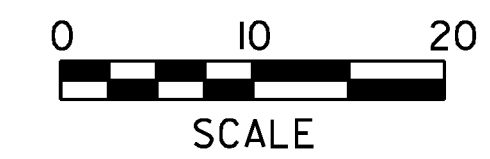

PROJECT NAME: HUBBARDTON
PROJECT NUMBER: ER STP 0161(27)

FILE NAME: zllc290xs_01.dgn
PROJECT LEADER: M.A. COLGAN
DESIGNED BY: S.G. FARNSWORTH
ROADWAY CROSS SECTIONS (1 OF 3)

PLOT DATE: 7/16/2012
DRAWN BY: C.L. CILLEY
CHECKED BY: S.G. FARNSWORTH
SHEET 67 OF 70

