




35+75

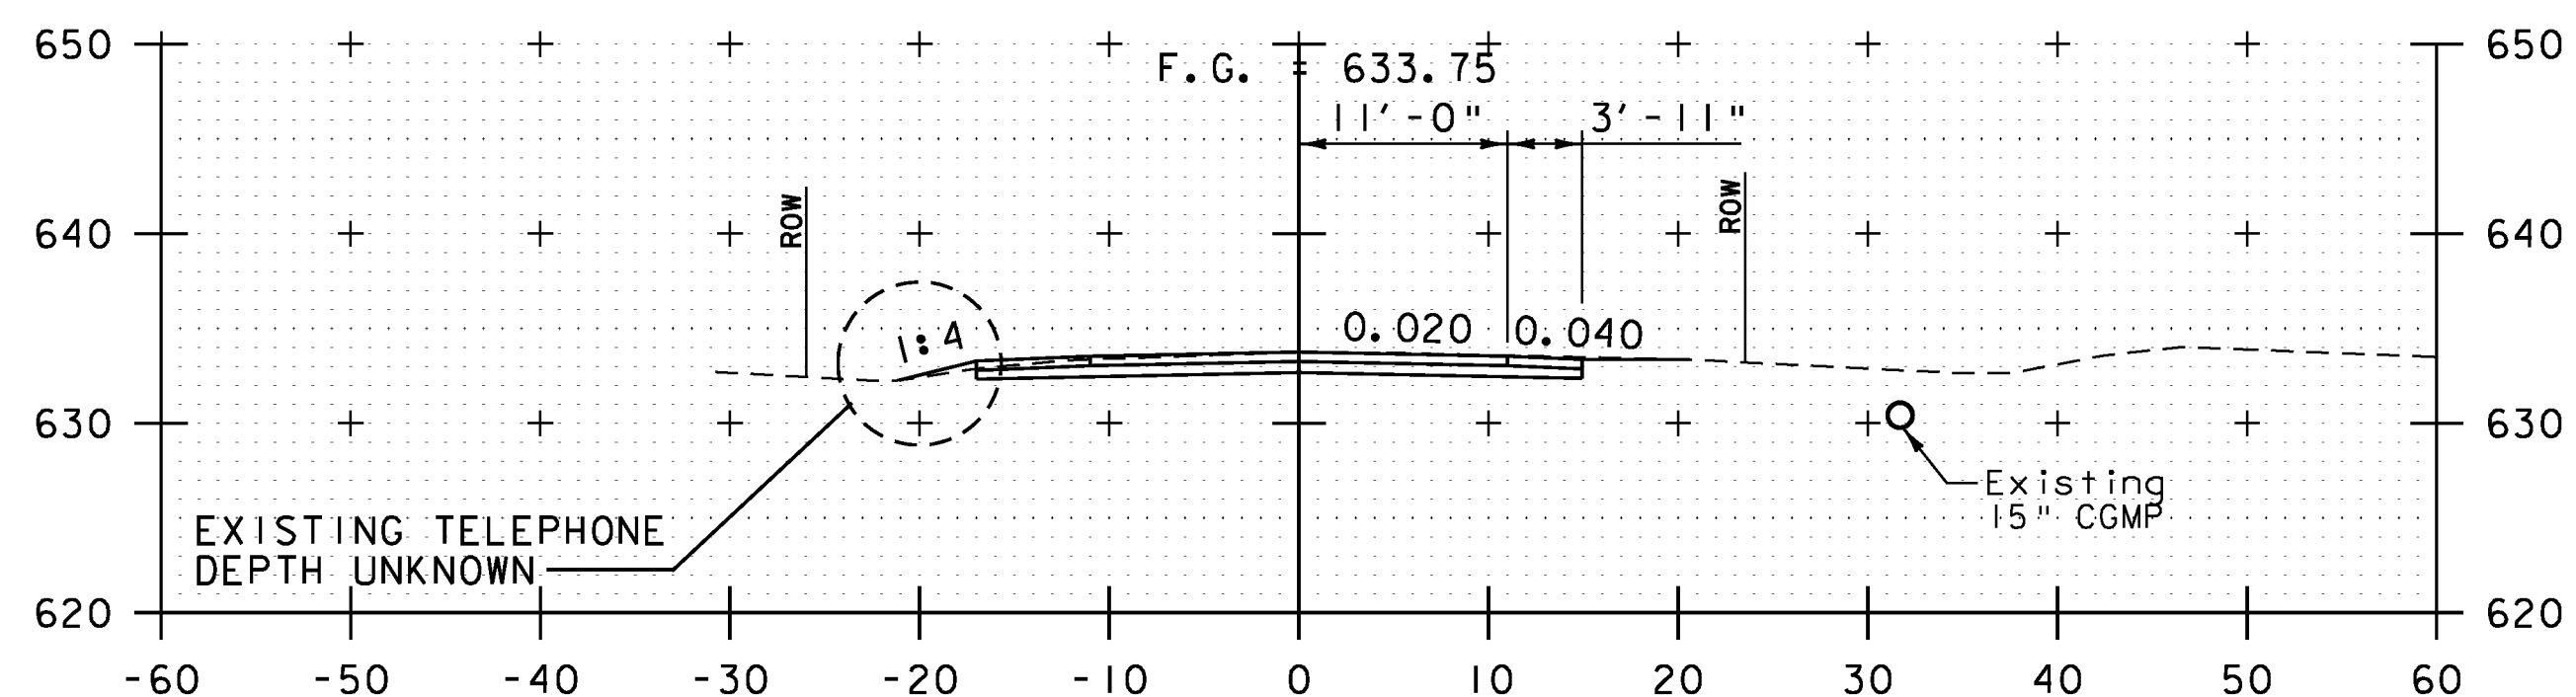

END PROJECT  
35+50

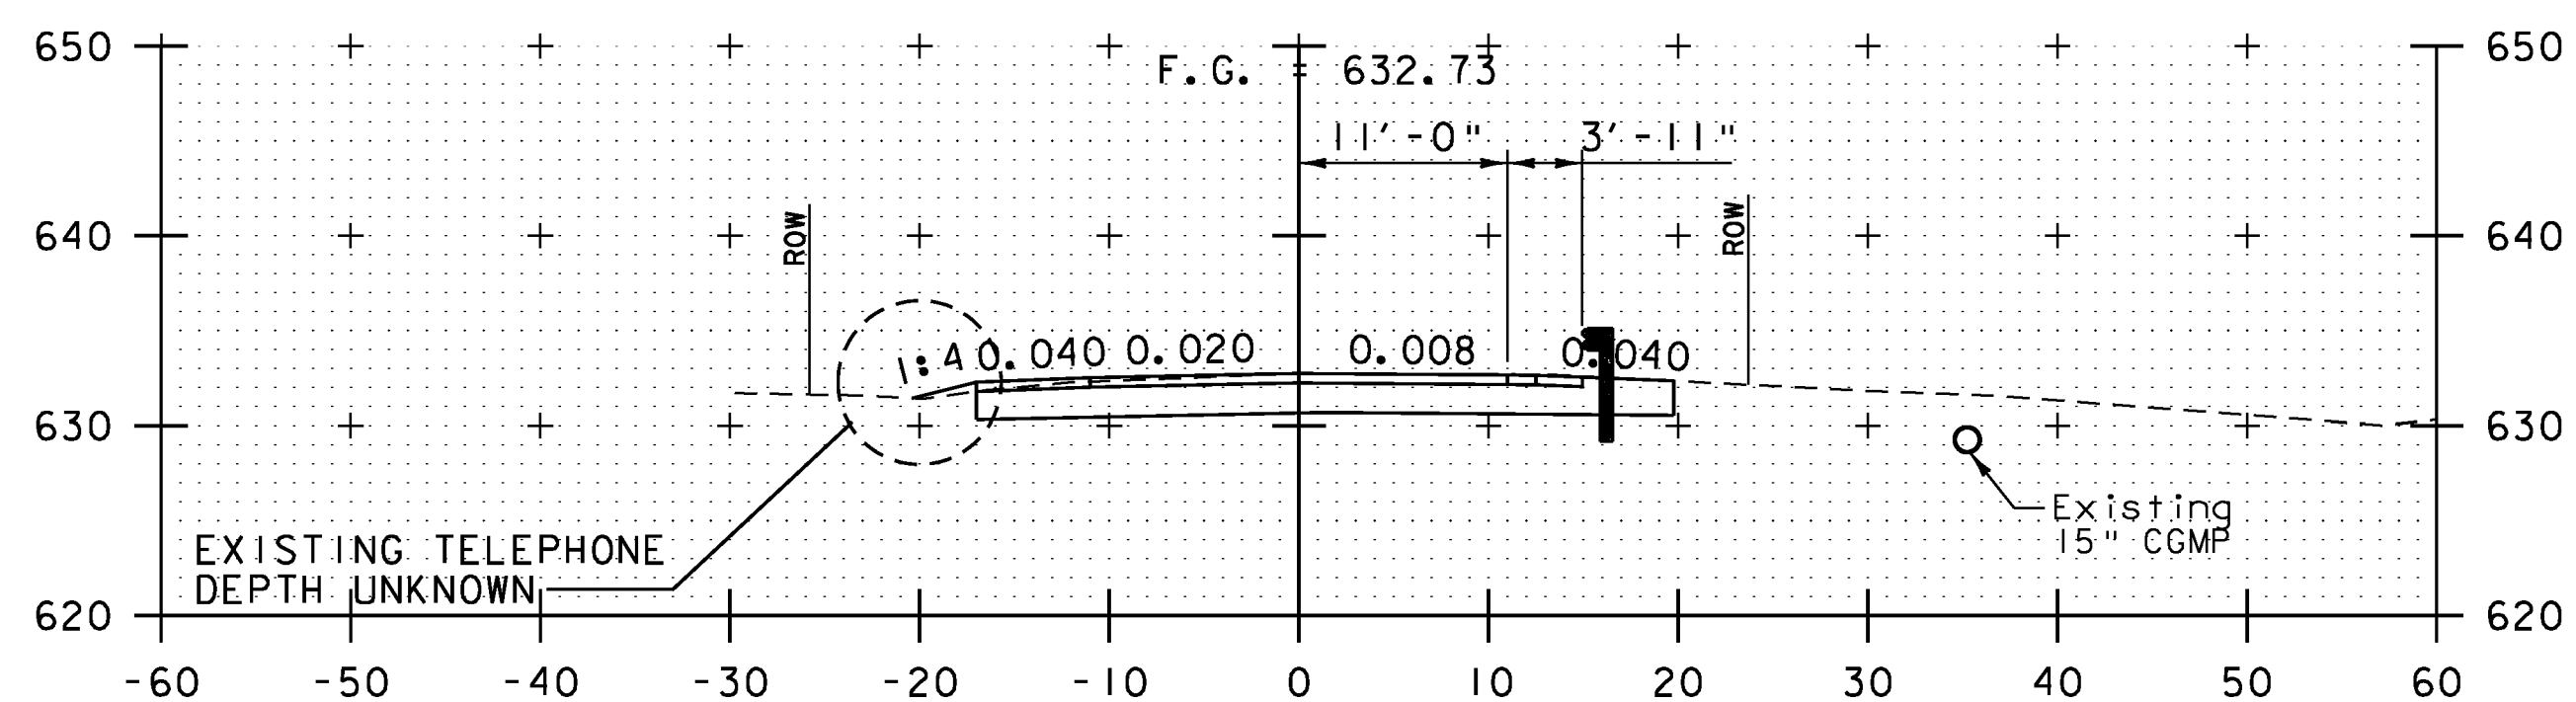


35+25

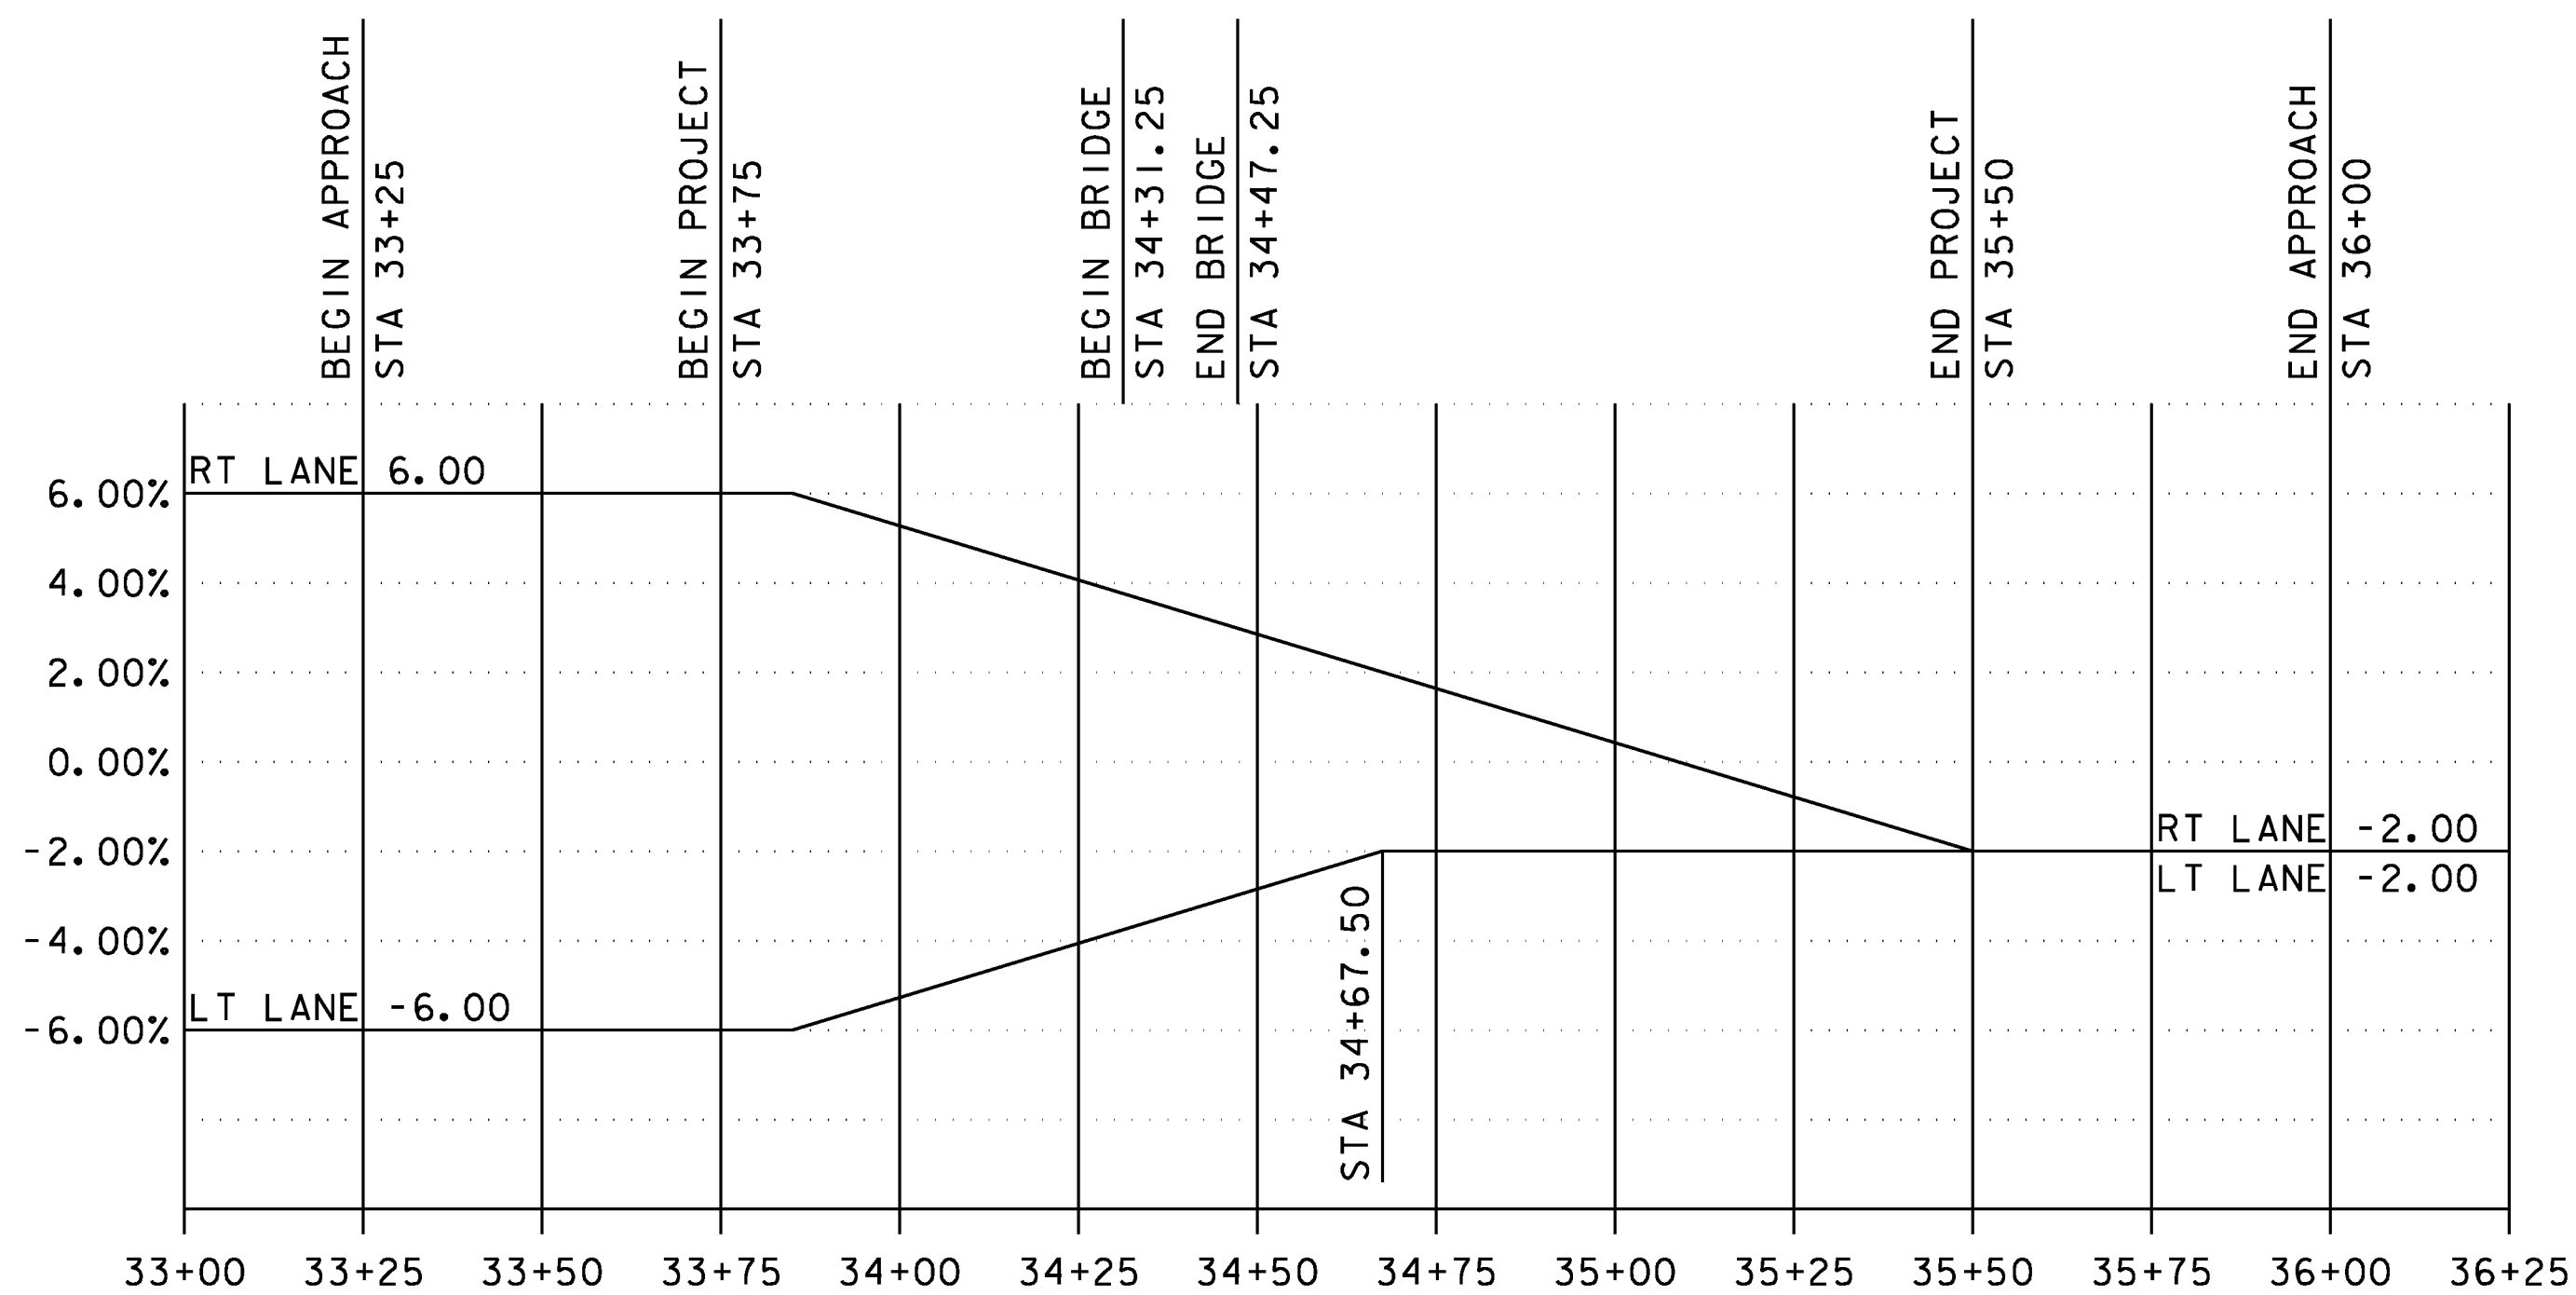


SUPERELEVATION DIAGRAM

NOT TO SCALE

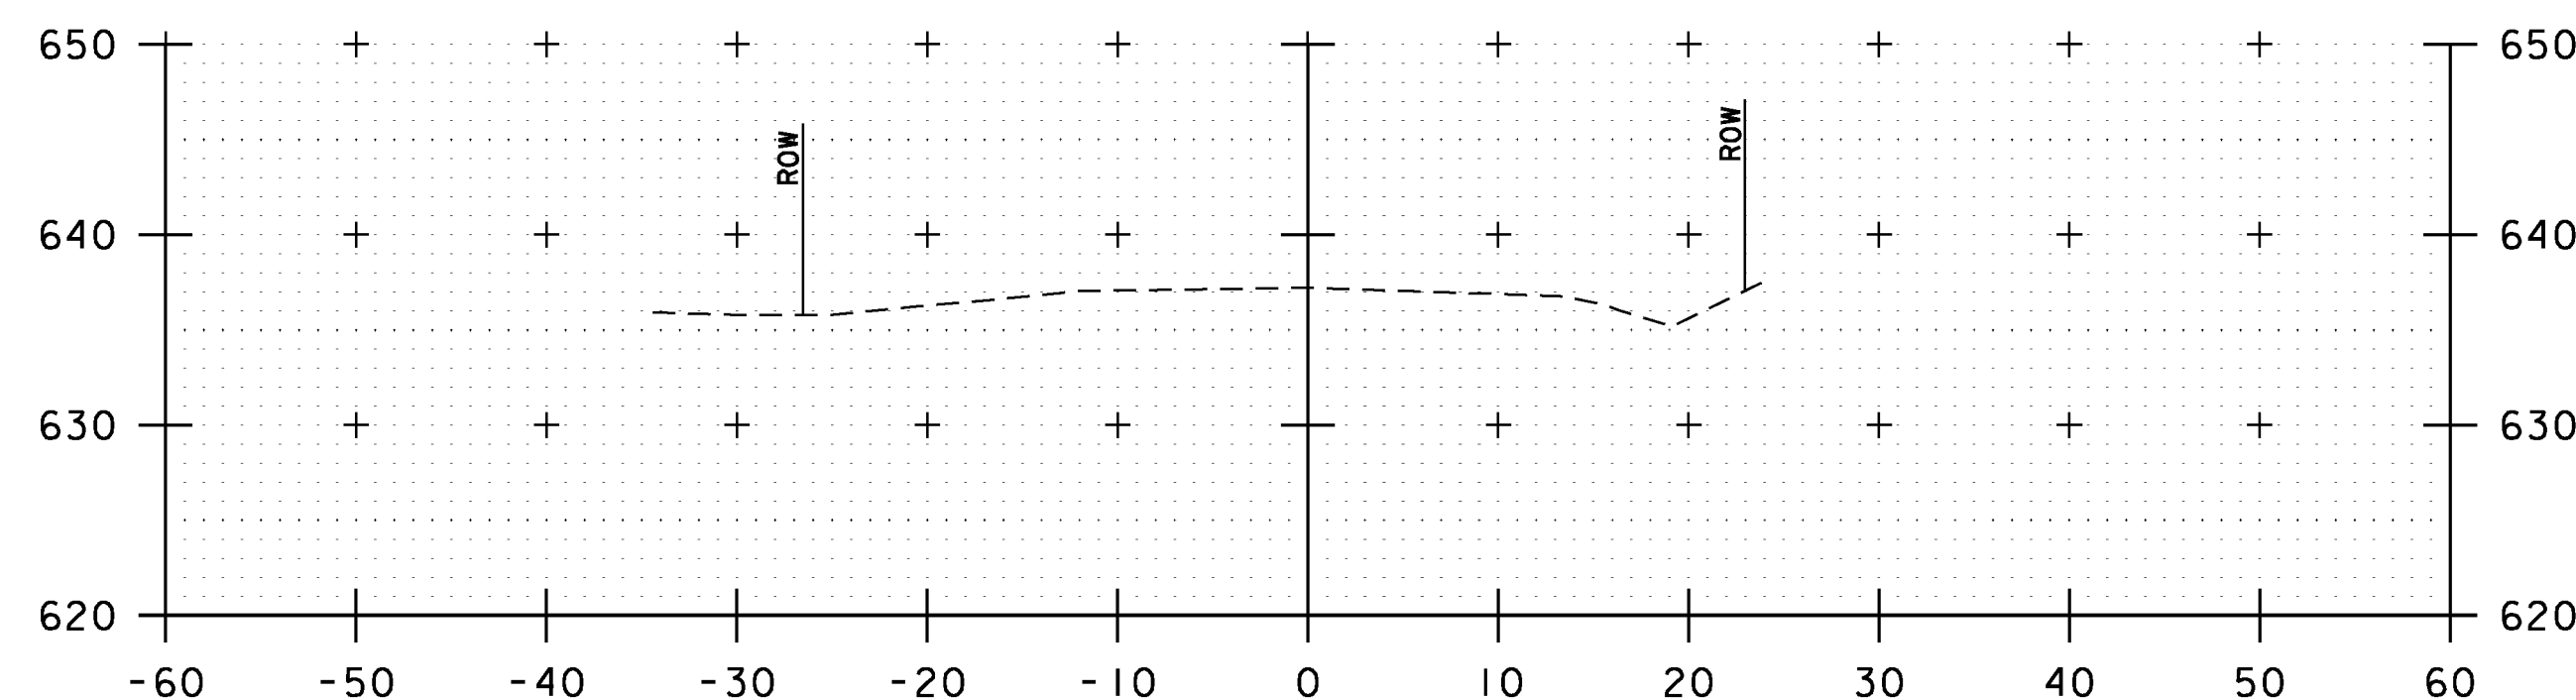

36+25

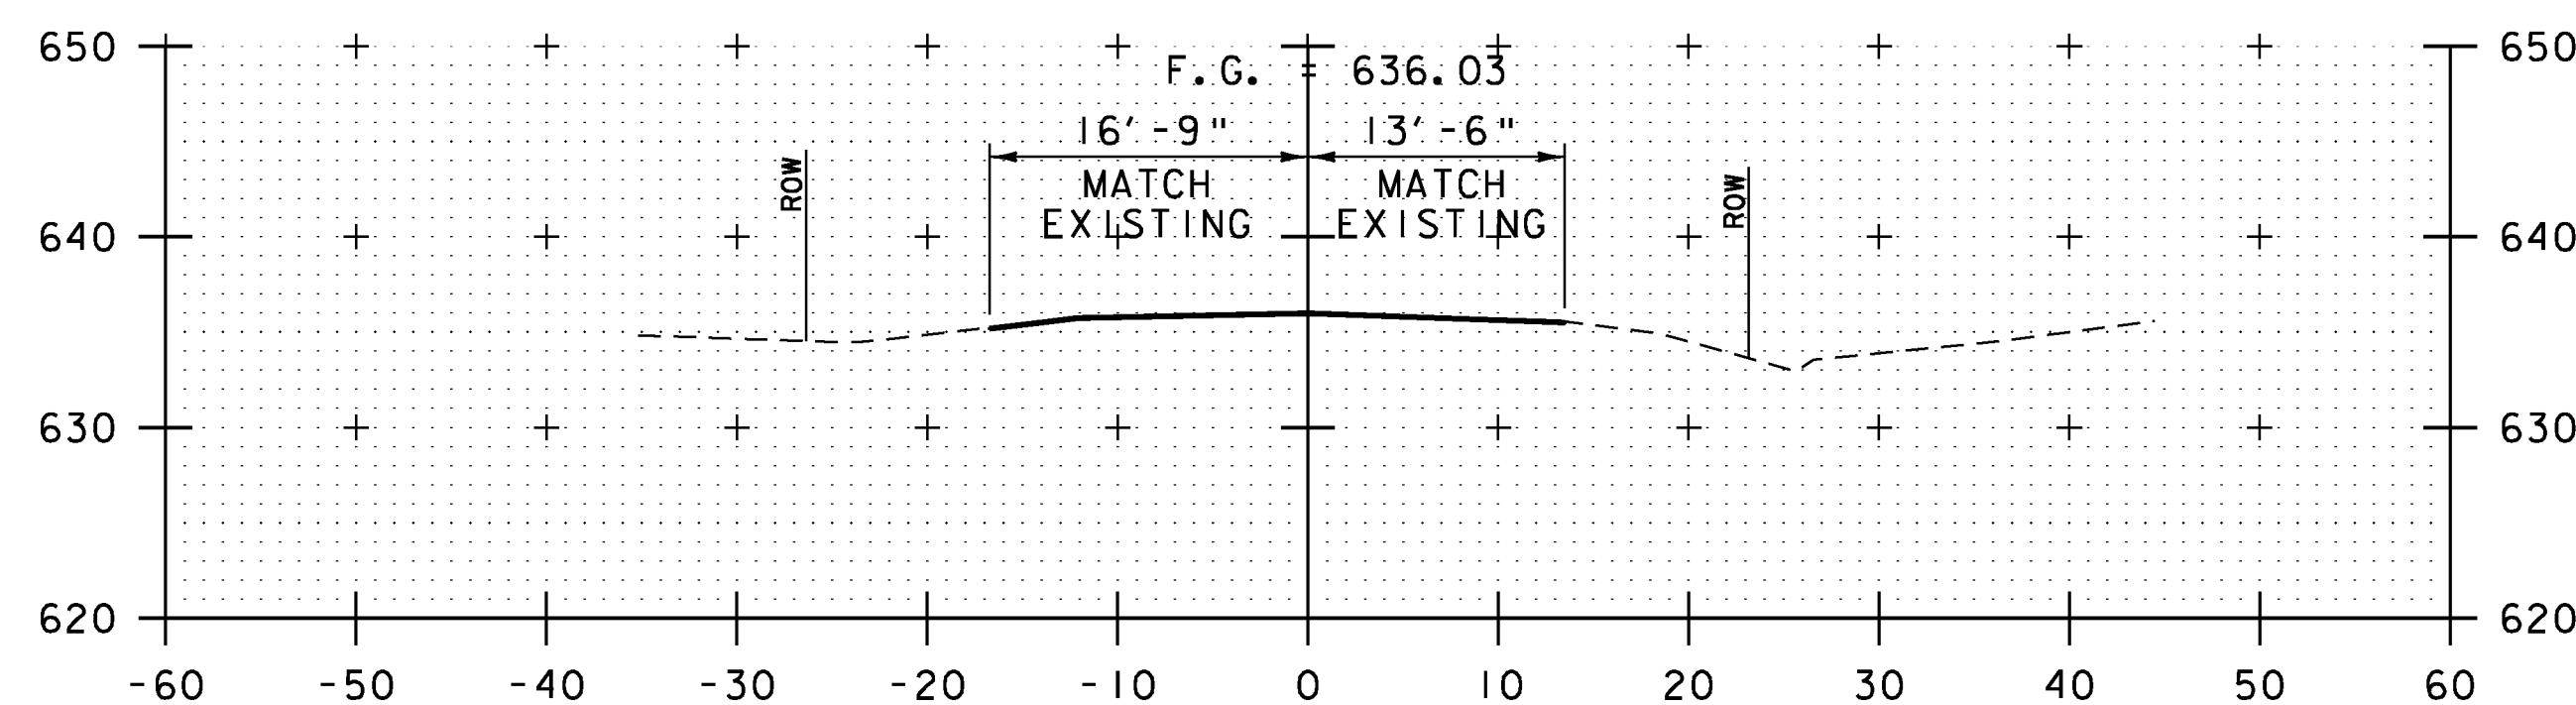


END APPROACH  
36+00

ROADWAY CROSS SECTIONS

SCALE 1"=10'-0"

STA. 35+25 TO STA. 36+25

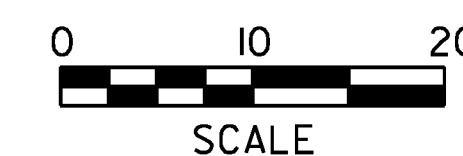

PROJECT NAME:	HUBBARDTON
PROJECT NUMBER:	ER STP 016(27)
FILE NAME:	z1lc290xs_03.dgn
PROJECT LEADER:	M.A. COLGAN
DESIGNED BY:	S.G. FARNSWORTH
ROADWAY CROSS SECTIONS (3 OF 3)	
PLOT DATE:	7/16/2012
DRAWN BY:	C.L. CILLEY
CHECKED BY:	S.G. FARNSWORTH
SHEET	69 OF 70

