

CHANGING ELEVATION OF DIS., CBS OR MHS  
SEE SHEET 27

REHAB.  
DIS., CBS OR MHS, CLASS I, II OR III  
SEE SHEETS 27-28

CHANGING ELEVATION OF SEWER MANHOLES  
SEE SHEET 28

PORTLAND CEMENT  
CONCRETE SIDEWALK, 5 INCH  
STA. 153+23, LT  
STA. 153+23, RT

DETECTABLE WARNING SURFACE  
STA. 153+23, LT  
STA. 153+23, RT

VERTICAL GRANITE CURB  
STA. 153+23, LT

REMOVING AND RESETTING CURB  
STA. 153+23, LT  
STA. 153+23, RT

ADJUST ELEVATION OF VALVE BOX  
SEE SHEETS 28-29

DURABLE & TEMPORARY 4 INCH WHITE LINE  
(ALL LINES WILL INCLUDE EDGE LINE BREAKS  
AND RADII FOR SIDE ROADS)  
STA. 150+00 TO 155+00, SOLID LT & RT  
STA. 150+00 TO 150+15, DOTTED LT  
STA. 150+00 TO 152+83, SOLID RT (DIAGONALS)  
STA. 154+55 TO 155+00, SOLID LT (LANE LINE)

DURABLE & TEMPORARY 4 INCH YELLOW LINE  
(ALL LINES WILL INCLUDE 1/2 BREAKS FOR  
SIDE ROADS & CROSSWALKS)  
STA. 150+00 TO 150+88, DOUBLE SOLID LT (ISLAND)  
STA. 150+88 TO 153+43, DOUBLE SOLID LT (2)  
STA. 153+76, DOUBLE SOLID LT (SUMMER ST. TH-306)  
STA. 153+82 TO 154+34, DOUBLE SOLID LT & RT  
STA. 154+12, DOUBLE SOLID LT (FOREST AVE. TH-354)  
STA. 154+72 TO 155+00, SOLID LT & RT

DURABLE & TEMPORARY 8 INCH YELLOW LINE  
STA. 150+88 TO 154+20, LT (DIAGONALS)  
SEE SHEET 55

DURABLE & TEMPORARY 24 INCH STOP BAR  
STA. 153+76, LT (SUMMER ST. TH-306)  
STA. 154+12, LT (FOREST AVE. TH-354)












DURABLE LETTER OR SYMBOL, TYPE D TAPE  
STA. 153+76, LT "STOP" (SUMMER ST. TH-306)  
STA. 154+12, LT "STOP" (FOREST AVE. TH-354)  
STA. 154+76, LT ARROW

DURABLE CROSSWALK MARKING, TYPE A TAPE  
STA. 153+23, LT - RT  
STA. 153+29 TO 153+96, LT  
SEE SHEET 55 (TYP.)

TEMPORARY LETTER OR SYMBOL, PAINT  
STA. 153+76, LT "STOP" (SUMMER ST. TH-306)  
STA. 154+12, LT "STOP" (FOREST AVE. TH-354)  
STA. 154+76, LT ARROW

TEMPORARY CROSSWALK MARKING, PAINT  
STA. 153+23, LT - RT  
STA. 153+29 TO 153+96, LT  
SEE SHEET 55 (TYP.)

REMOVING SIGNS  
AS SHOWN - 8

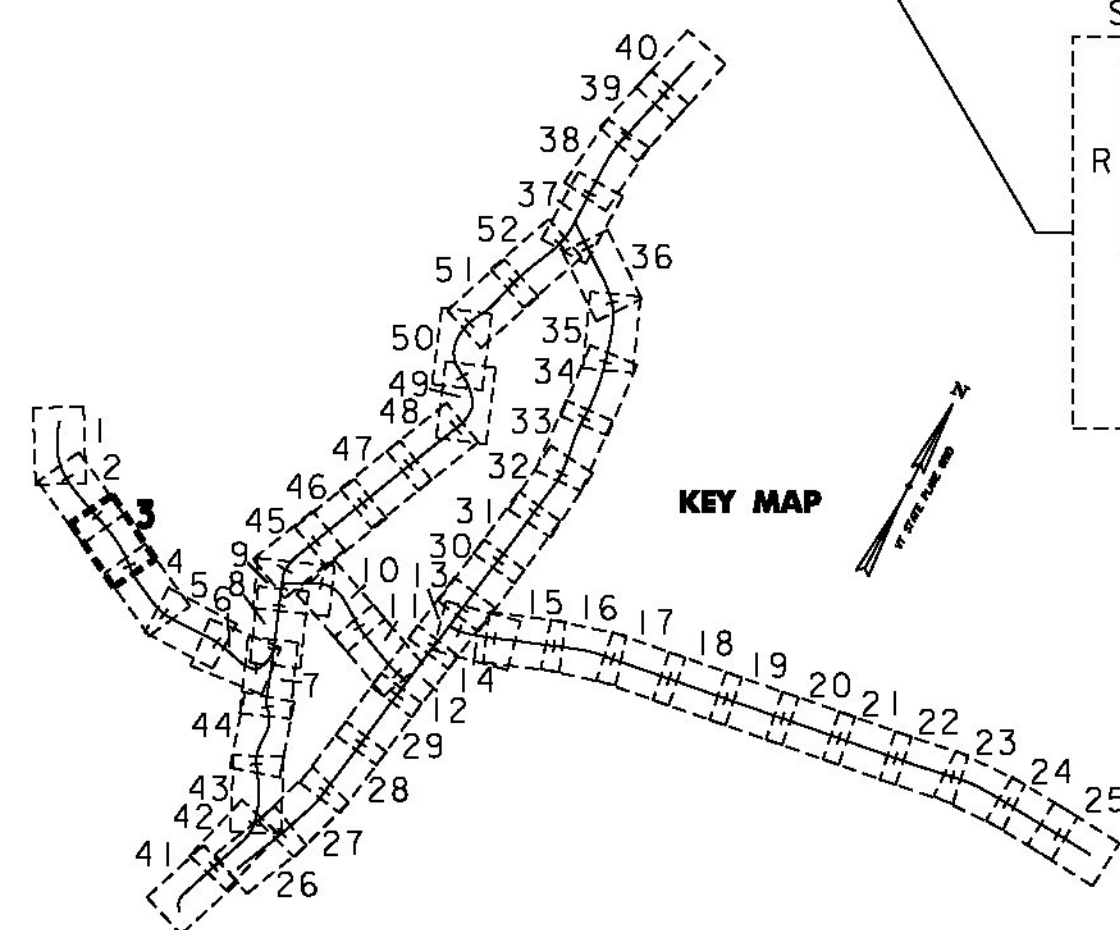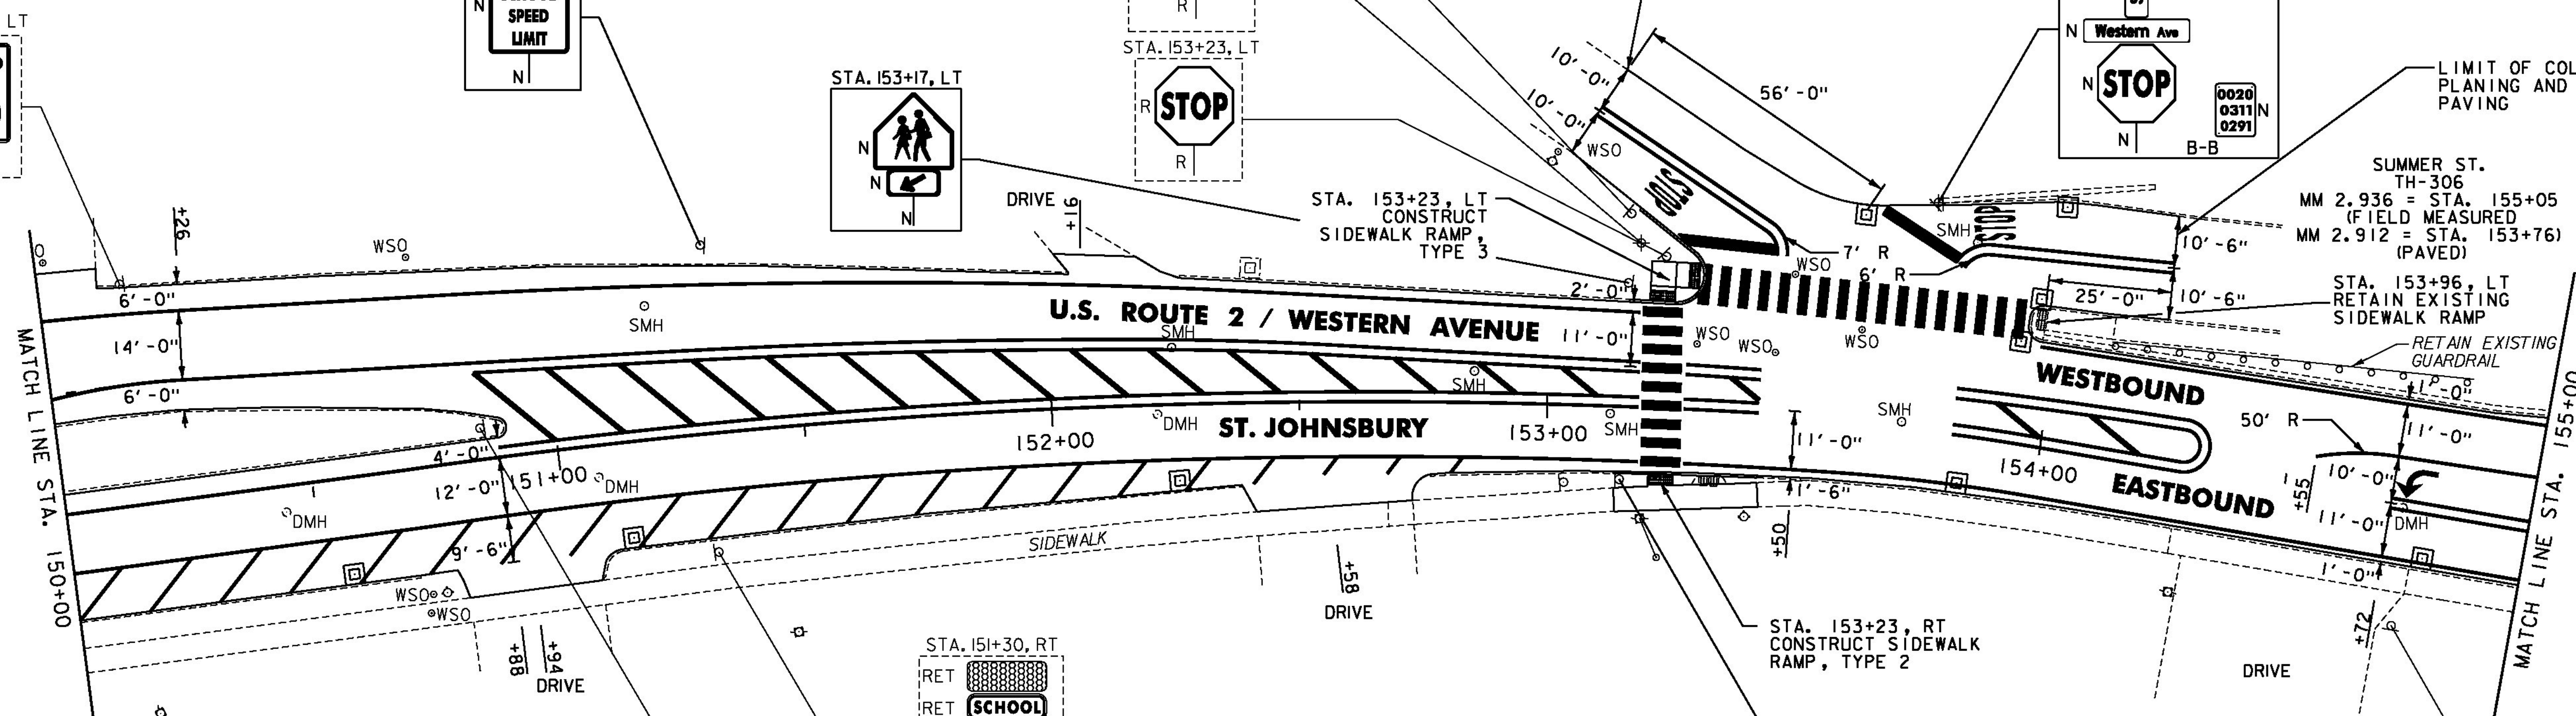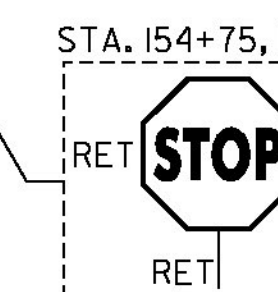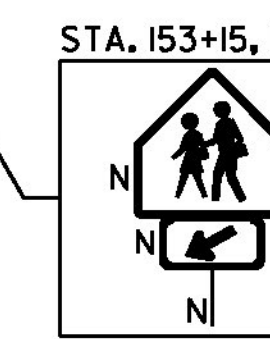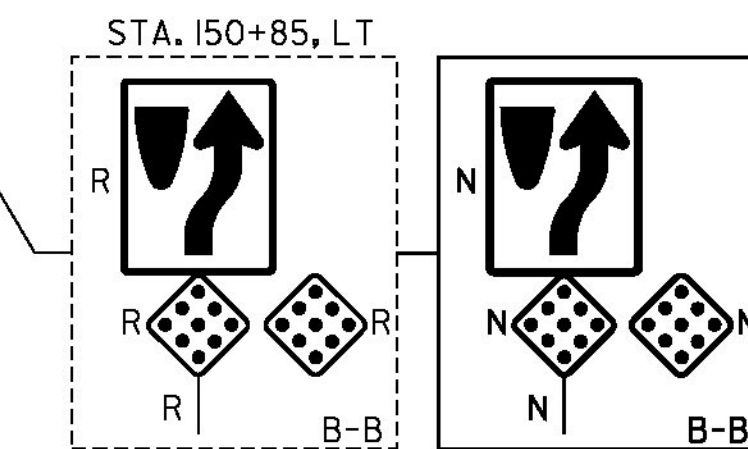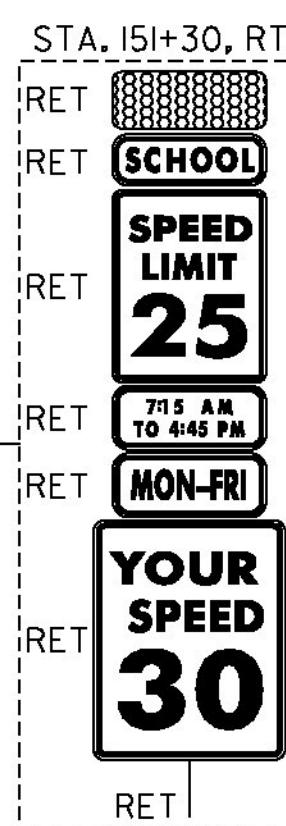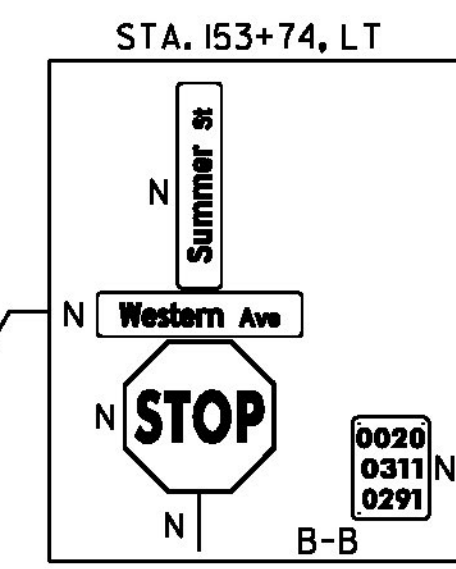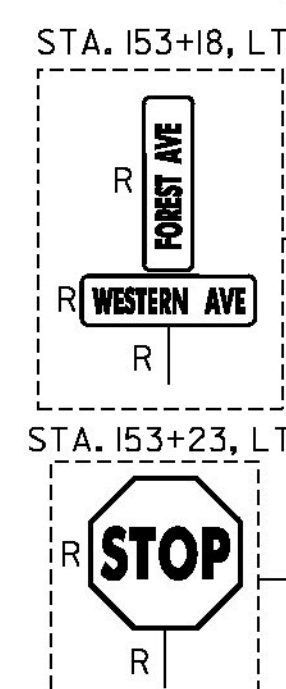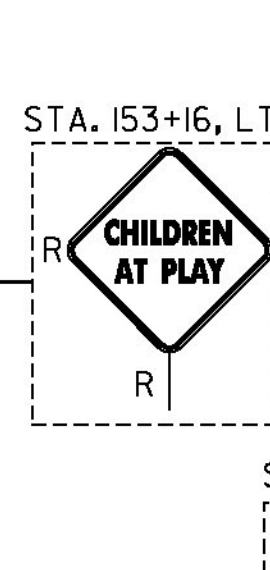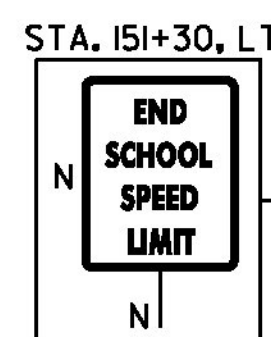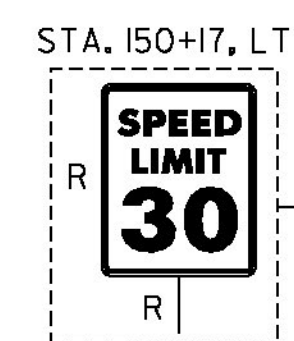

- NOTES:
- FOR LEGENDS, SEE SHEET 3.
  - ALL EXISTING SIGNS NOT SHOWN ON THE PLANS SHALL BE RETAINED.

NOT TO SCALE

**PROJECT LAYOUT SHEET #3**



PROJECT NAME: ST JOHNSBURY - LYNDON  
PROJECT NUMBER: STP 2936(I)

FILE NAME: pllc308.dgn  
PROJECT LEADER: G. EDWARDS  
DESIGNED BY: D. DRAPER

PLOT DATE: 7/17/2014  
DRAWN BY: D. DRAPER  
CHECKED BY: J. LITTLE  
SHEET 62 OF 250